


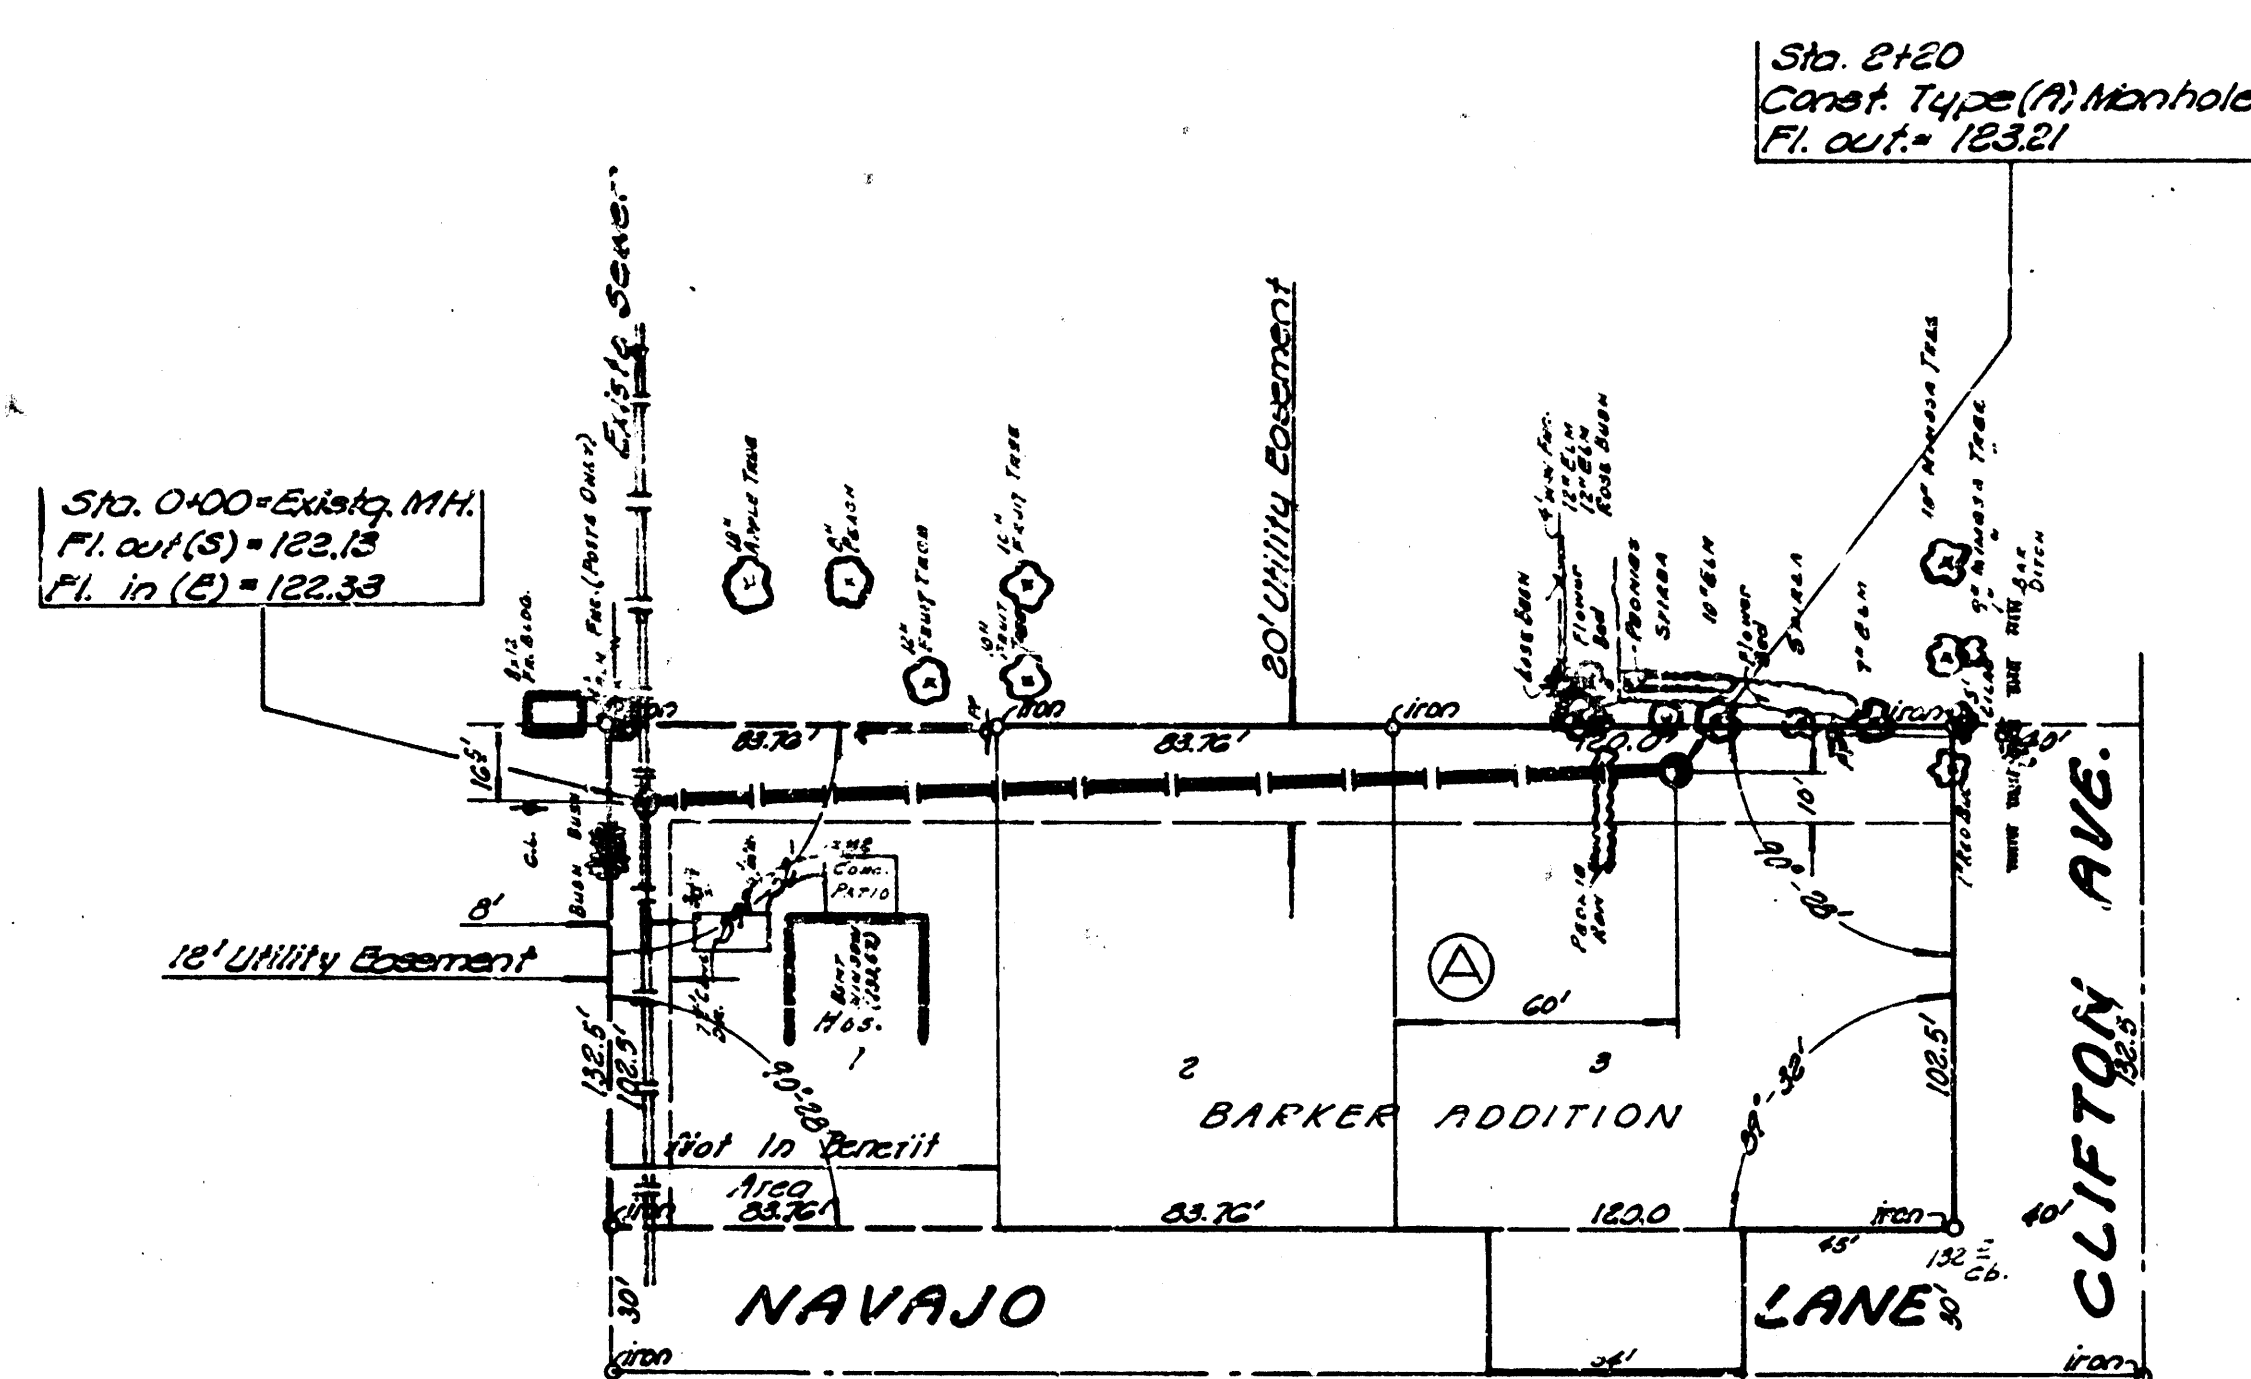


1" = 40'

 B.M. 134.595 MM Cor. Bdr'n Conc. Step

 on N.S. Has. T 3482 Navajo Lane

Profile = 1" = 20' Horiz.

 1" = 5' Vert.

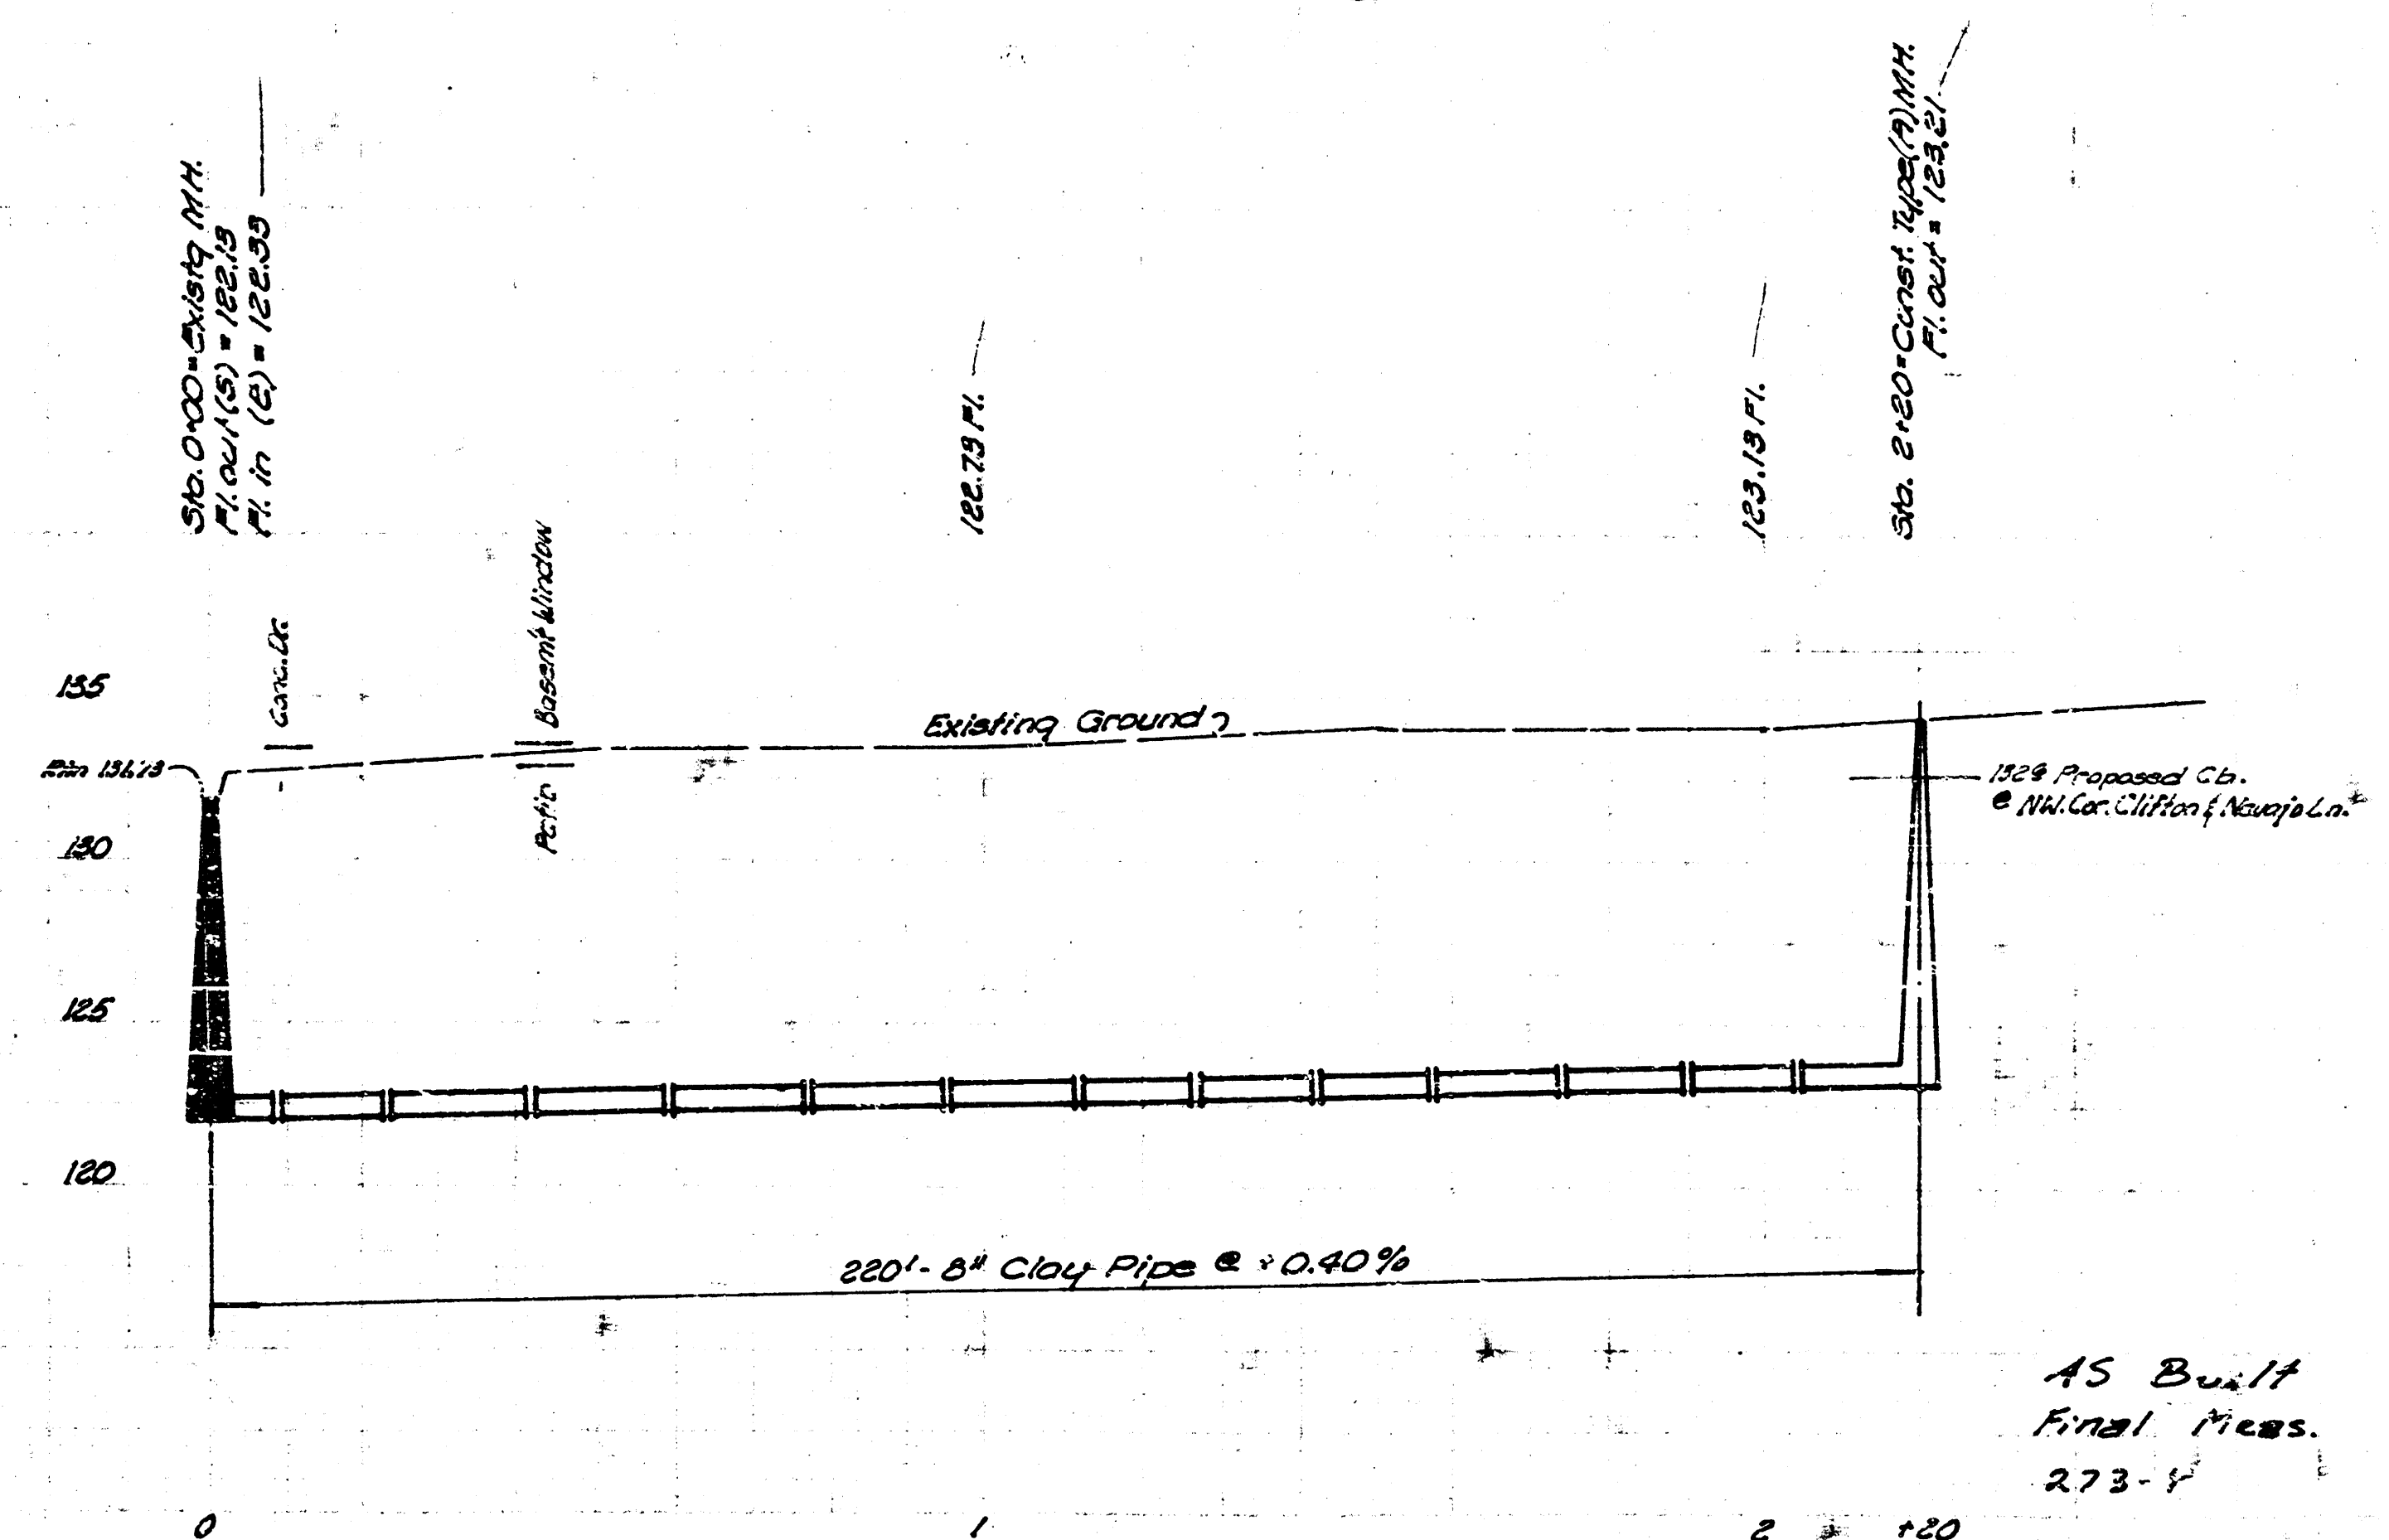

AS BUILT

 Final Meas.



 273 - V

LAT. 5, SUBMAIN 14, M.I.S.

 City Of Wichita, Kansas

 R.W. Linn City Engineer

 Date - Jan, 1974 DBK 2 570057

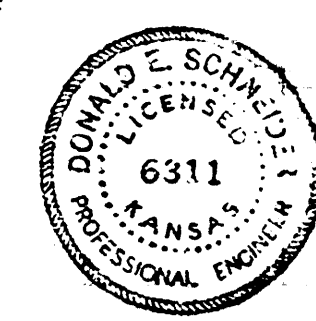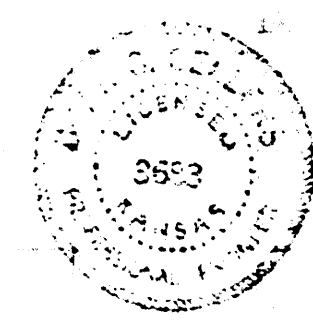

10- Engr 5

 1- W.L.L.