
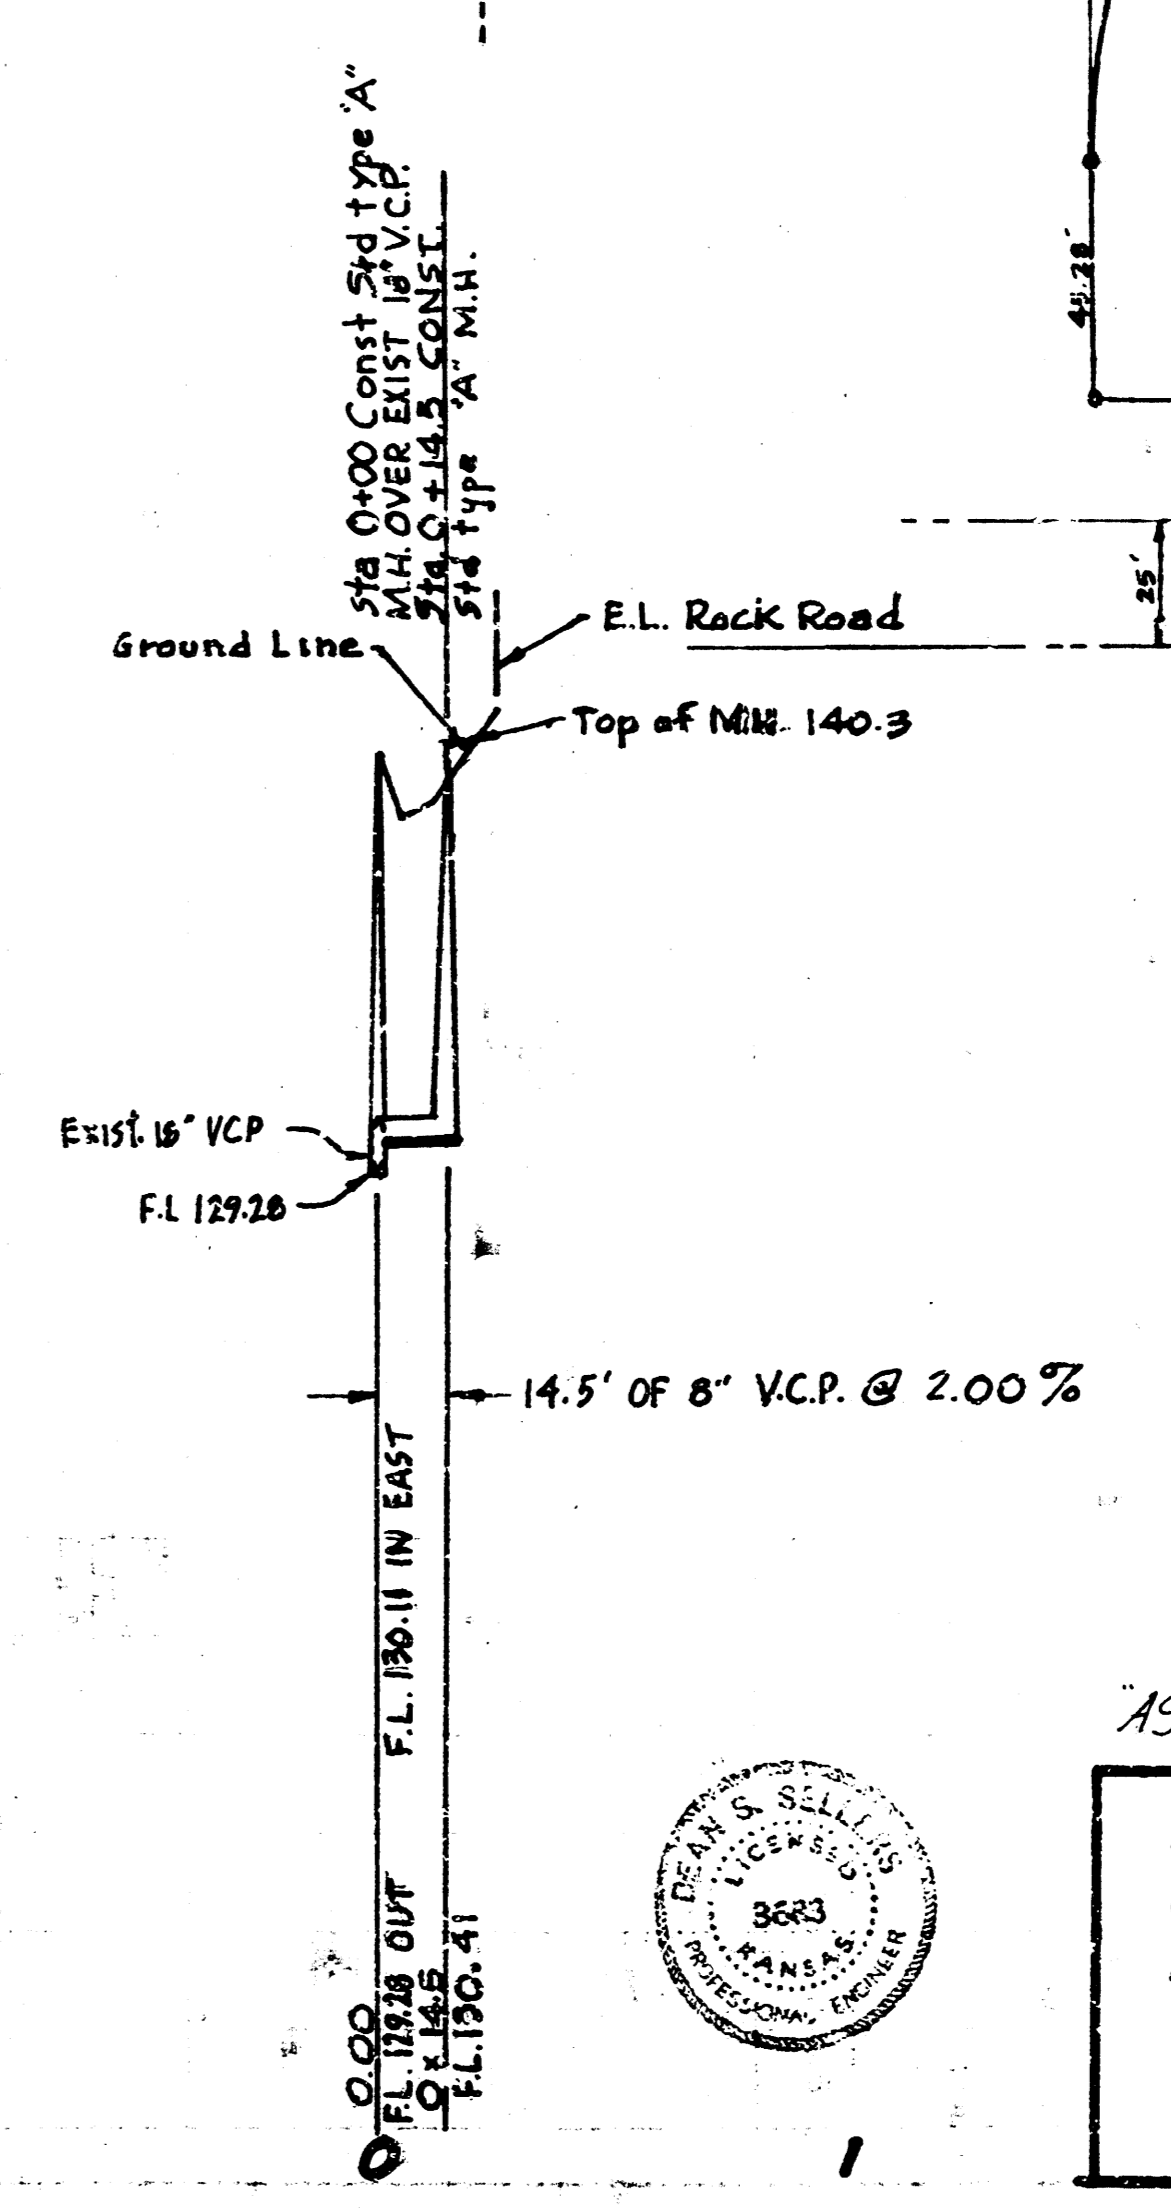
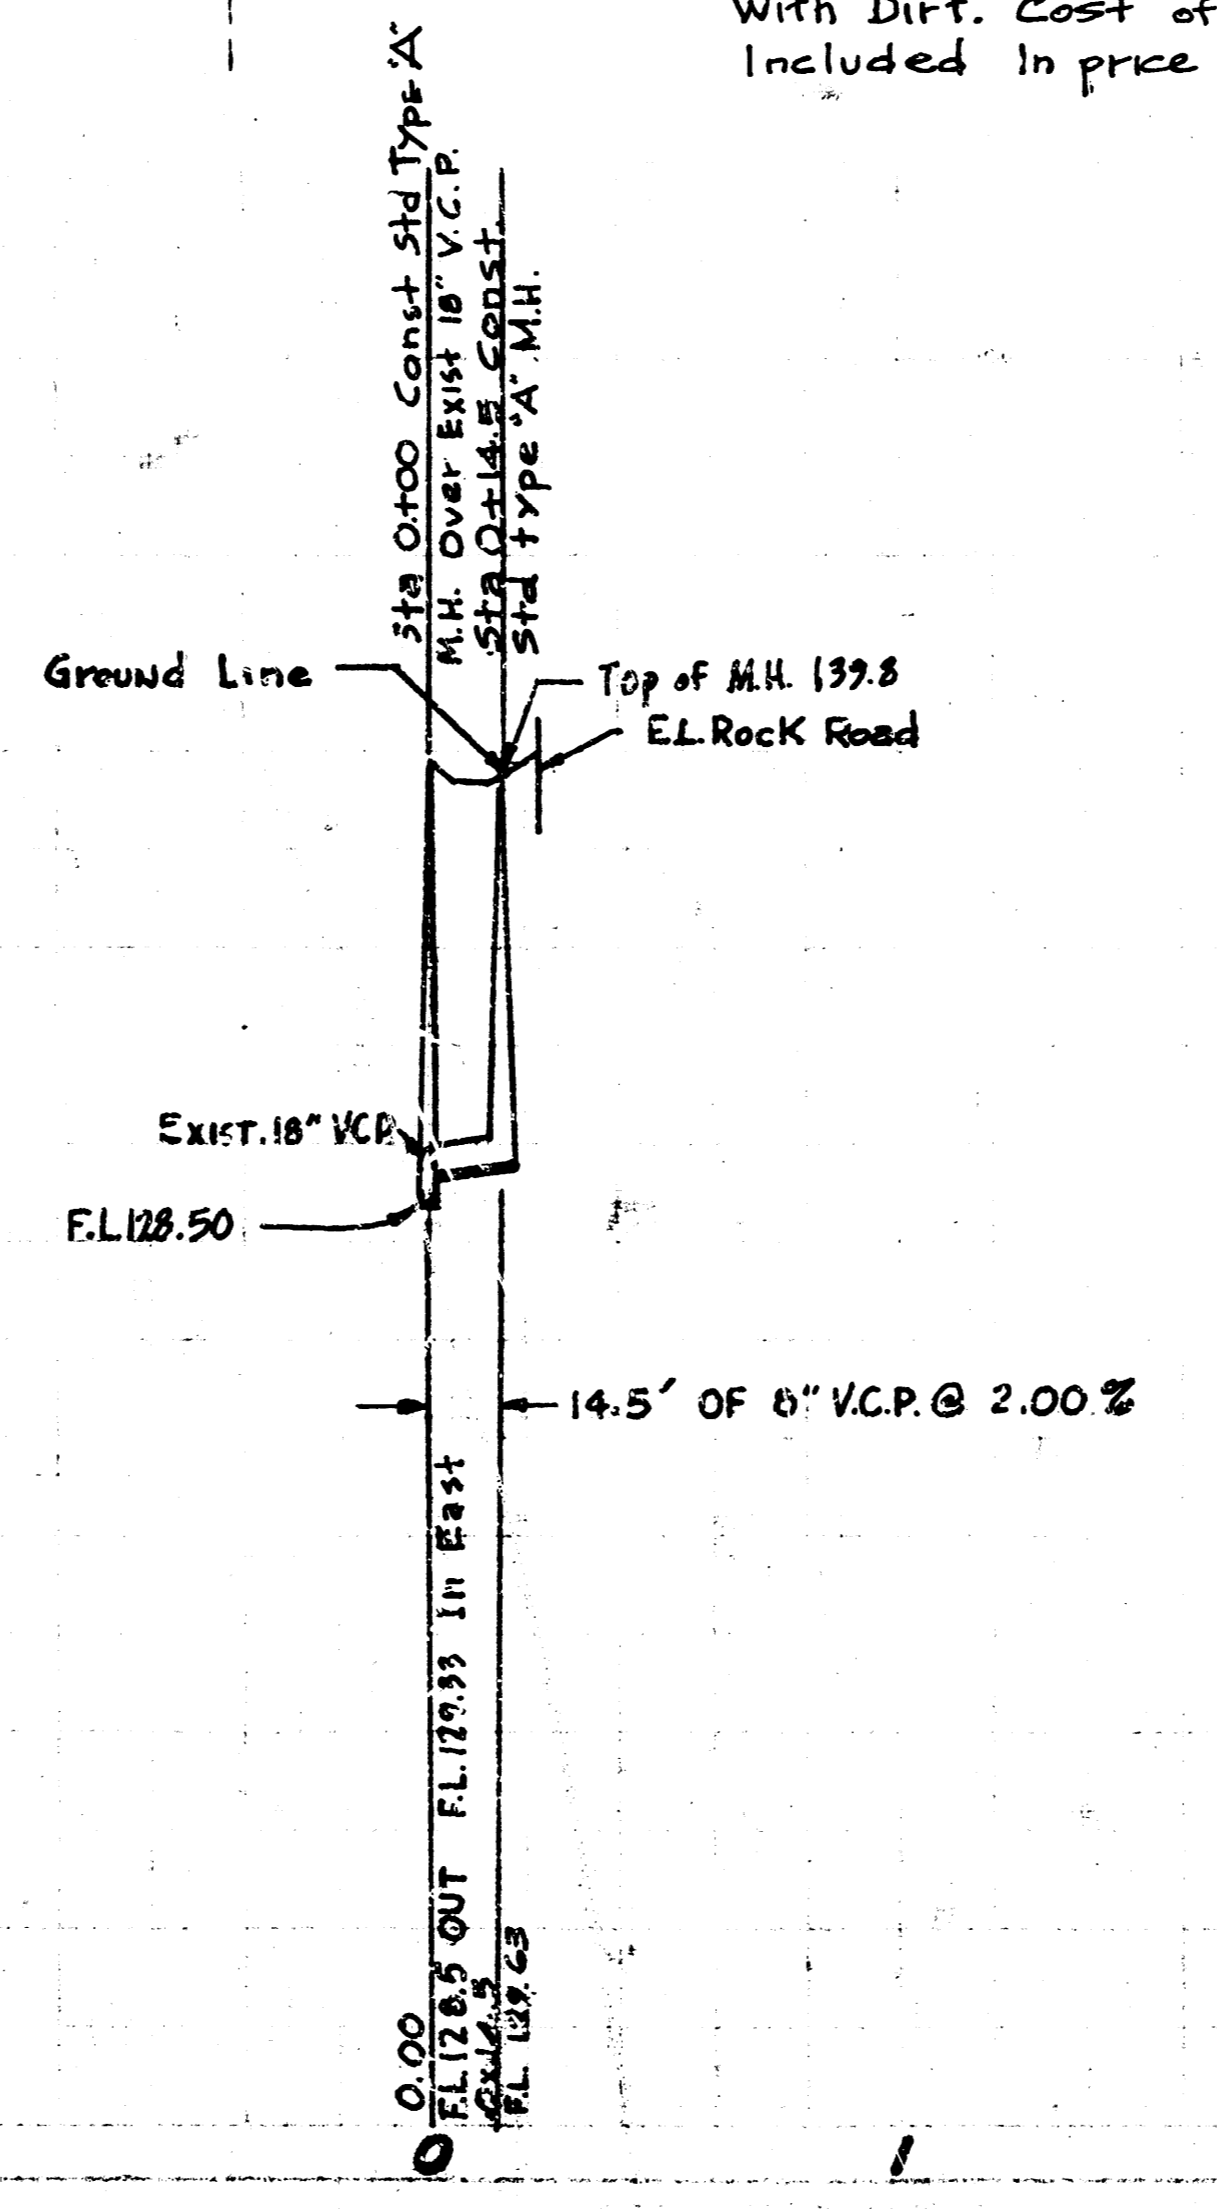


Scale:
Plan: 1" = 40'
Profile: Horiz. 1" = 40'
Vert. 1" = 5'

Note to Contractors:
Mech. Compact top 2' of Ditch Excavation
With Dirt. Cost of Compaction to be
Included in price bid per LIN. Ft of Pipe.

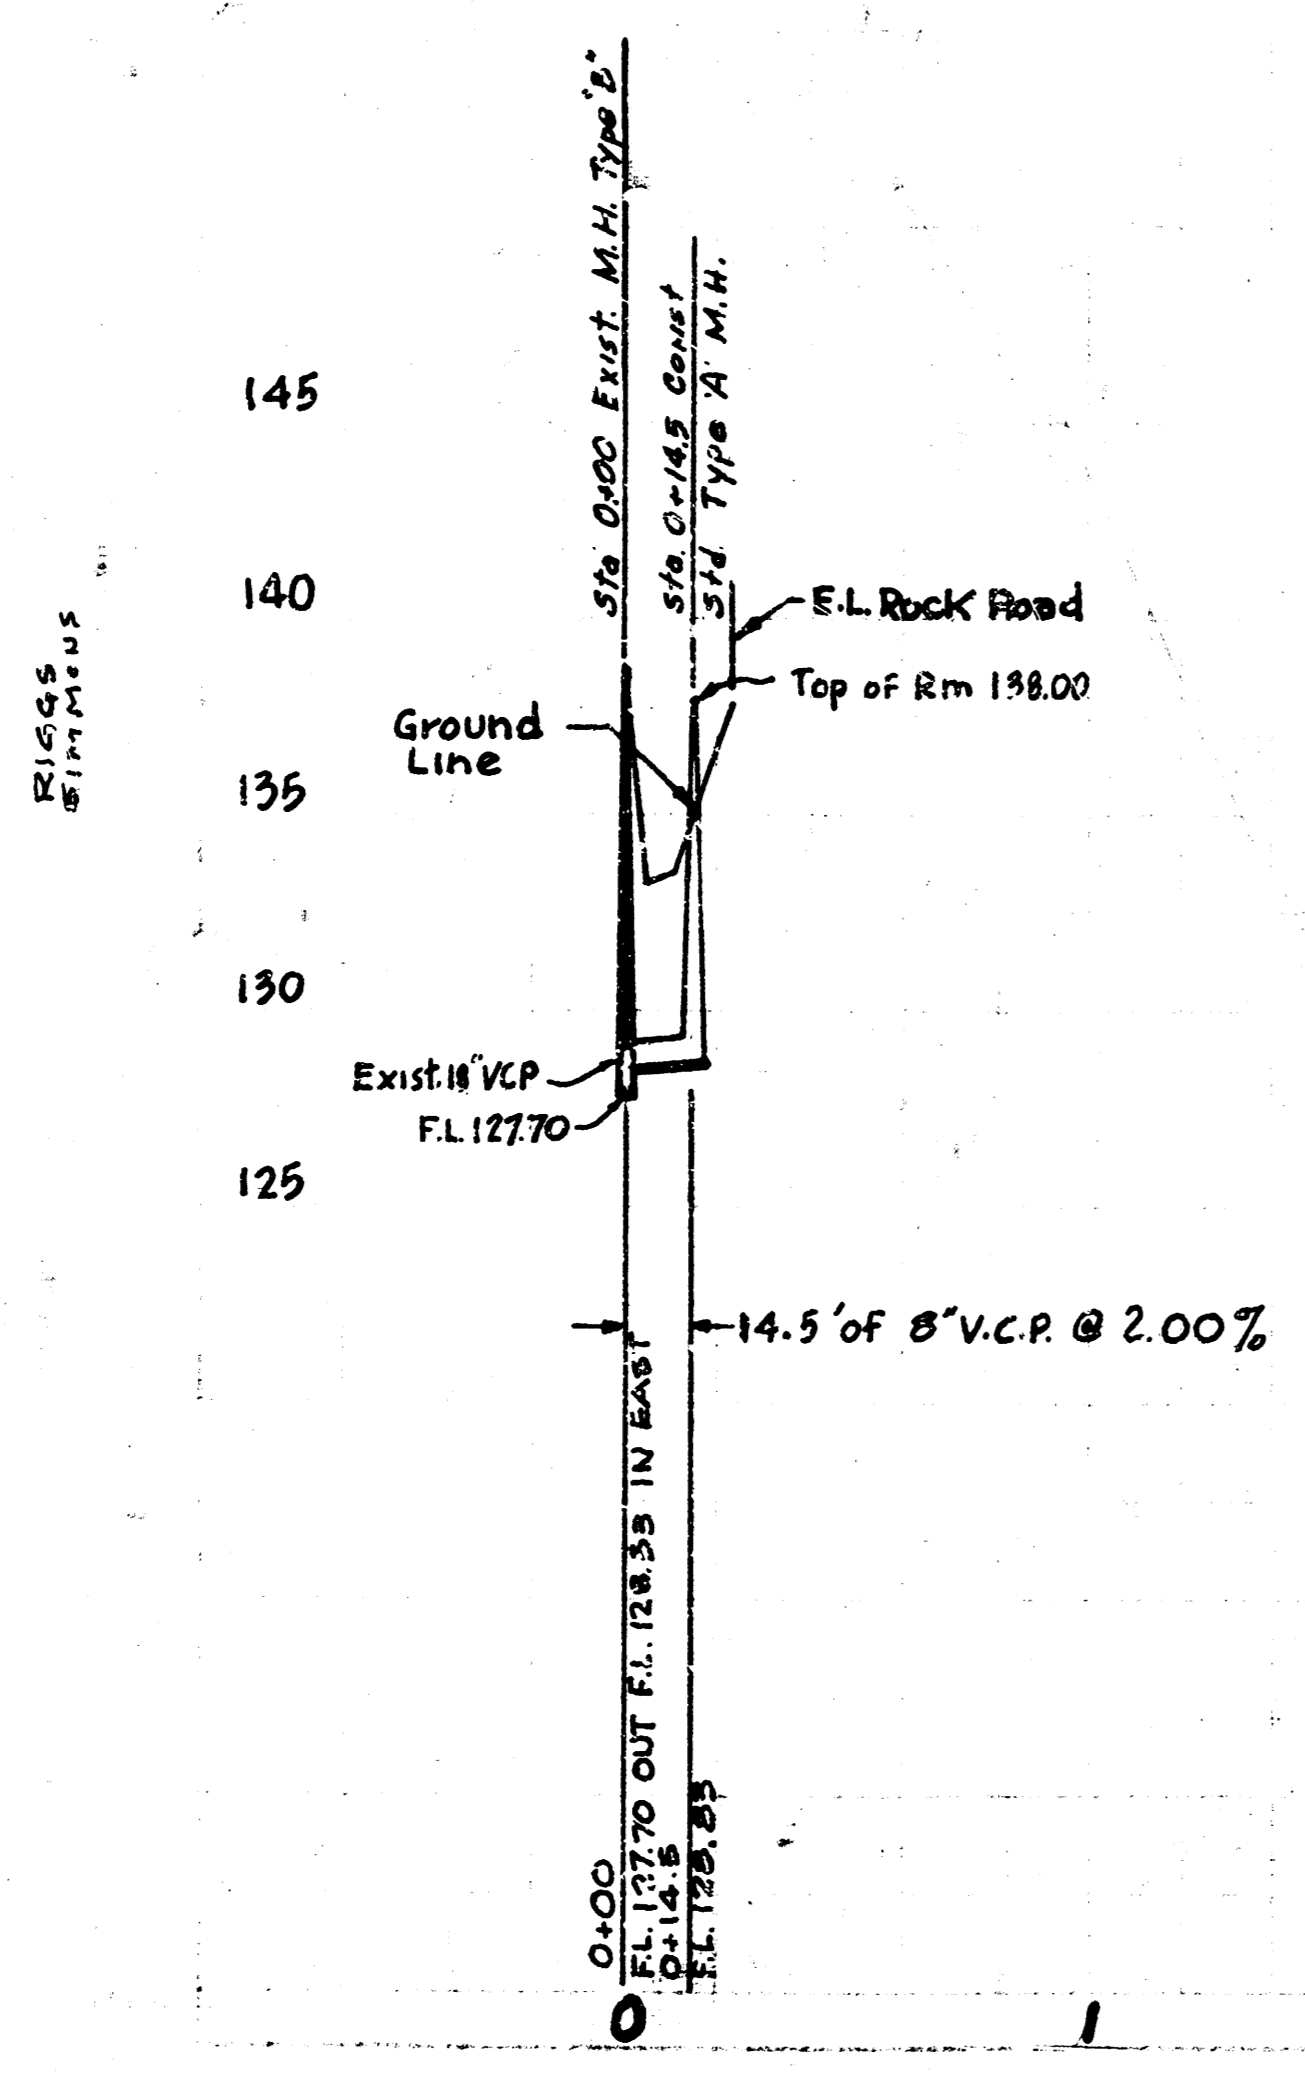

AS BUILT Final Man. 277-Y
LAT. 9, MAIN 16, W. 1. S.
CITY OF WICHITA, KANSAS
R.W. LINN, CITY ENGINEER
PROJECT NO. DBK L 573079
DATE: FEB. 1974