



BM 145.41 Chiseled "+" in center on top West end handrail on North Side of triple 8x8 RCBC 250 ft. East of Rock Rd. on Hart.

BM 139.64 Chiseled "□" in N.E. corner of top of Concrete Inlet at West edge of Rock Rd. between Zimmerly and Grail St.

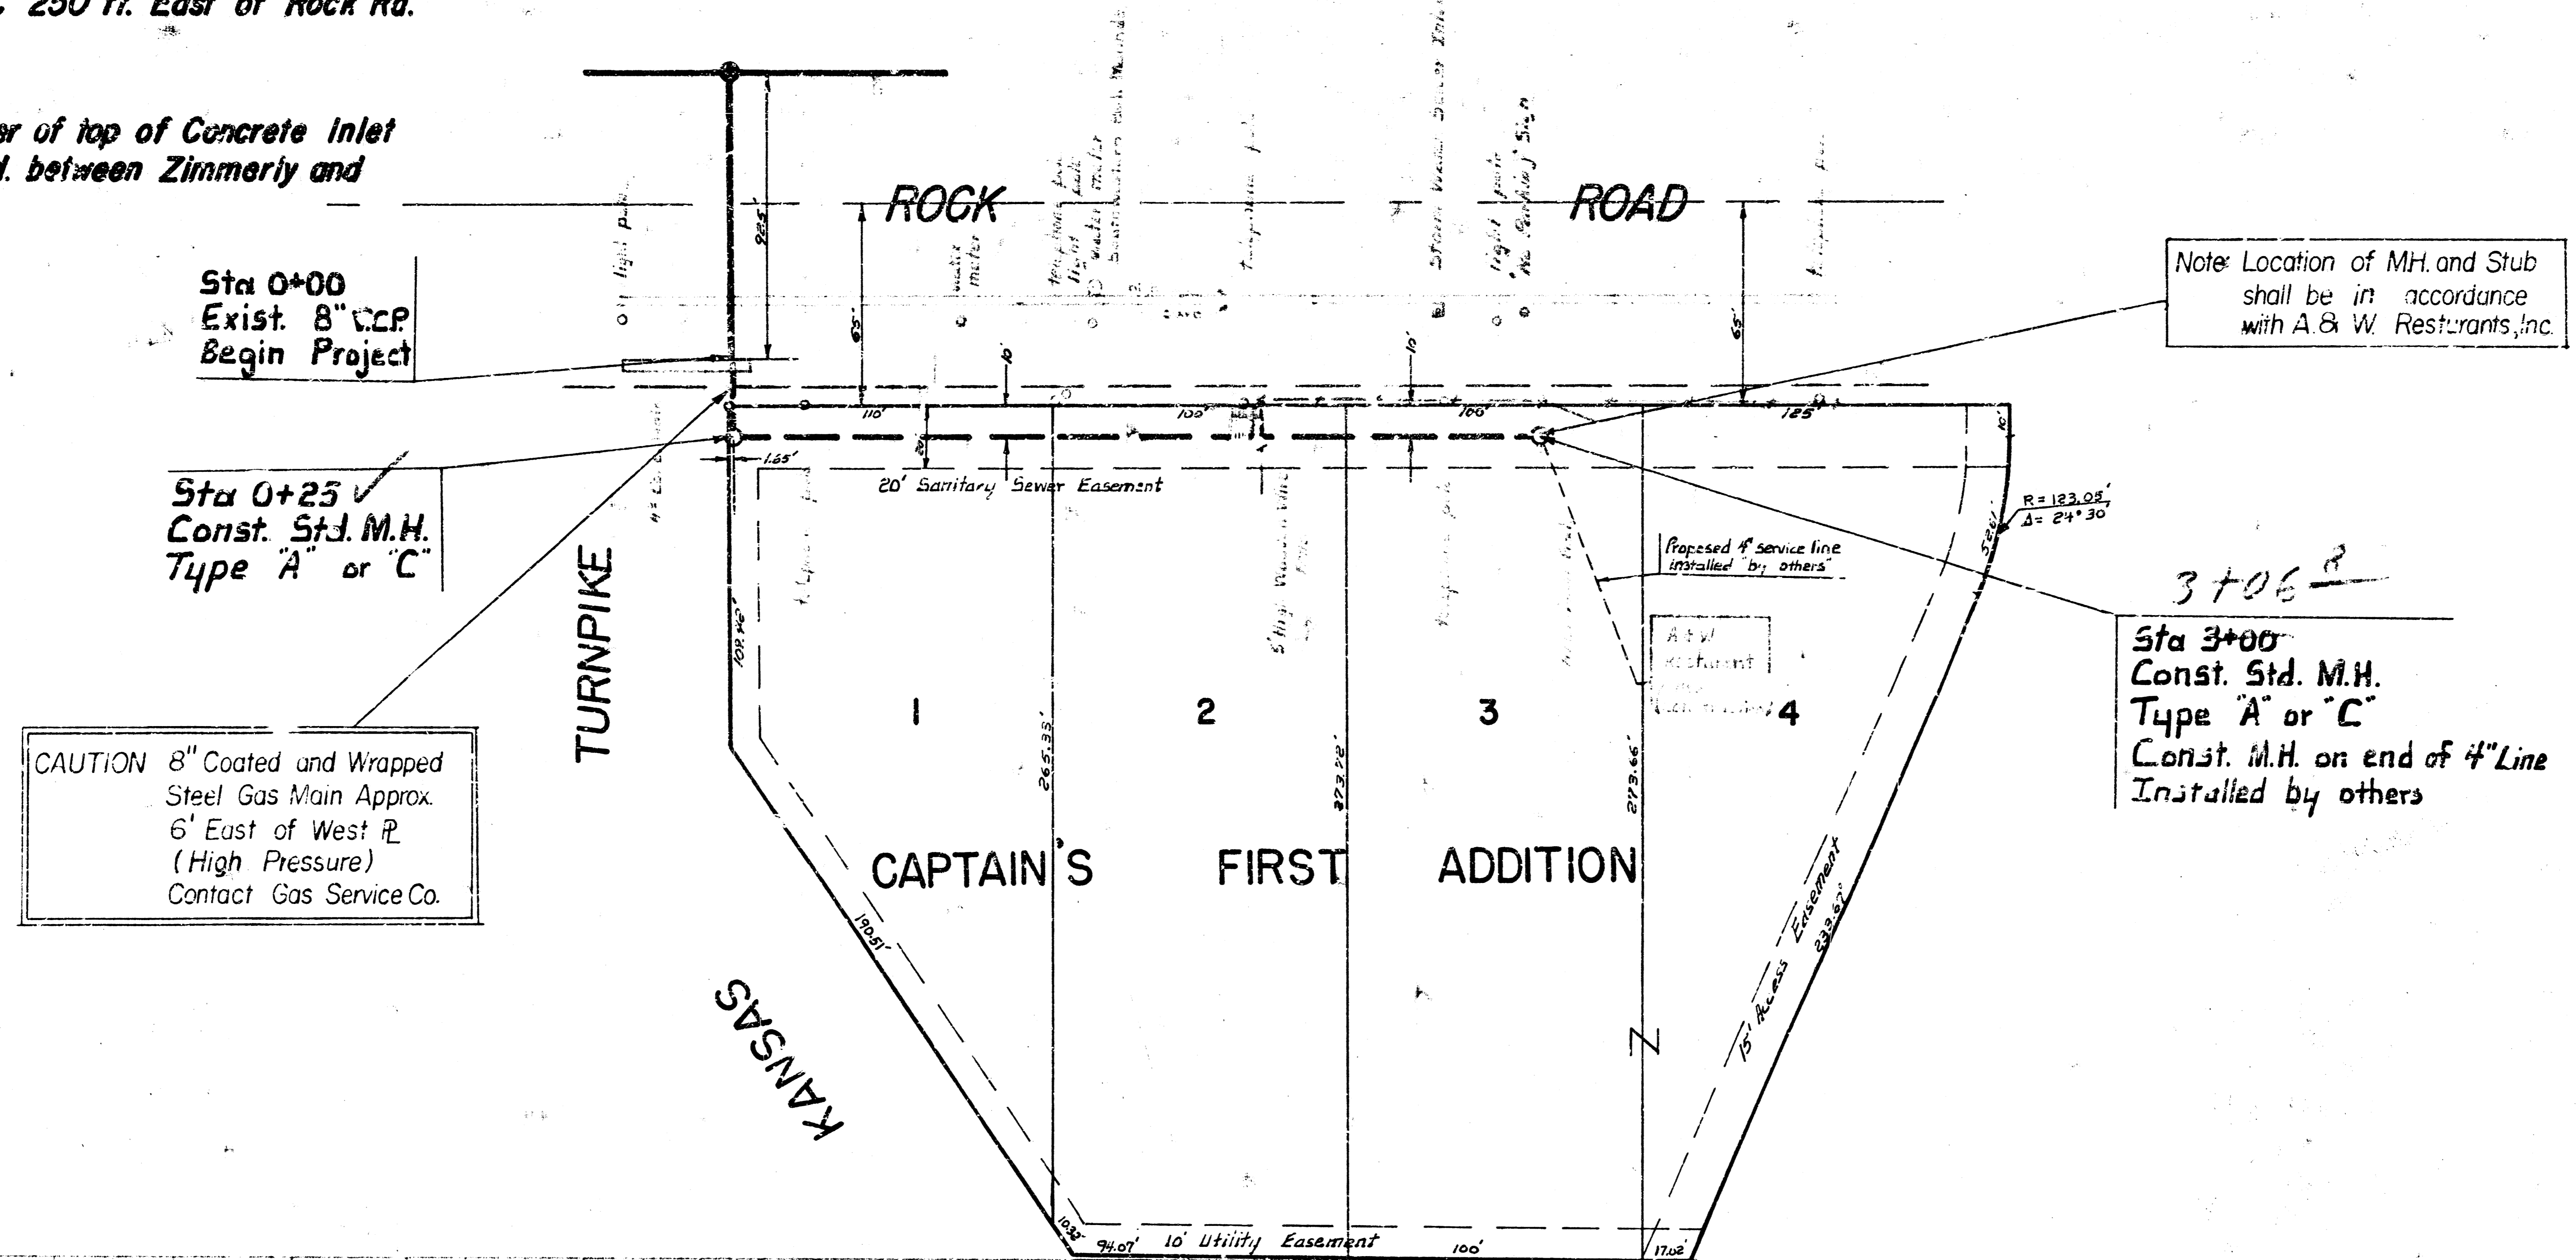


Plan Scale 1" = 40'
 Profile Scale 1" = 40' vert
 1" = 5' vert

CAUTION 8" Coated and Wrapped Steel Gas Main Approx. 6' East of West R (High Pressure) Contact Gas Service Co.

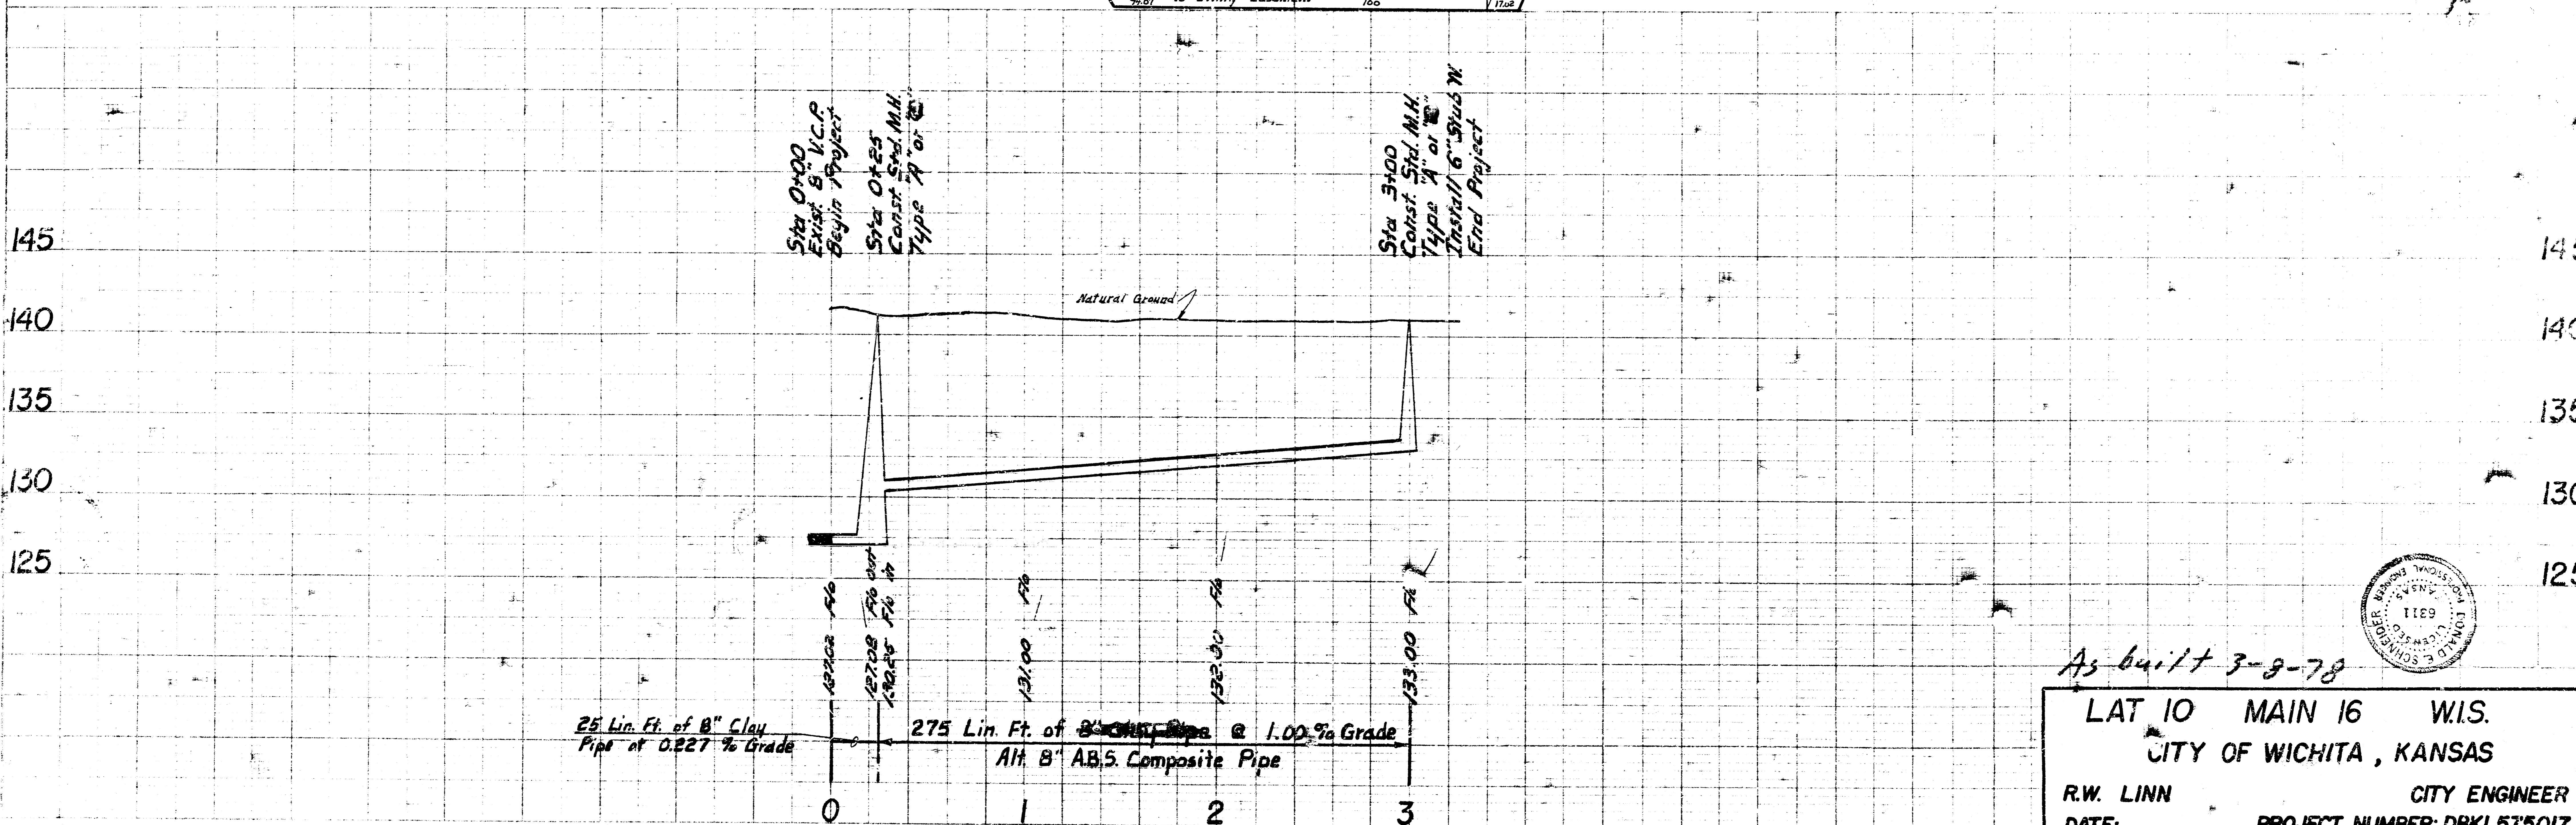

As built 3-9-78

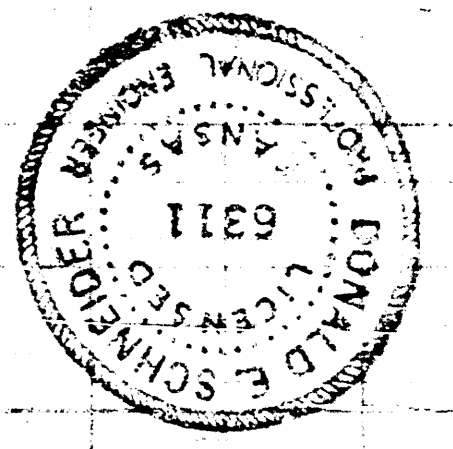

LAT 10 MAIN 16 W.I.S.
 CITY OF WICHITA, KANSAS
 R.W. LINN CITY ENGINEER
 DATE: PROJECT NUMBER: DBKL575017