




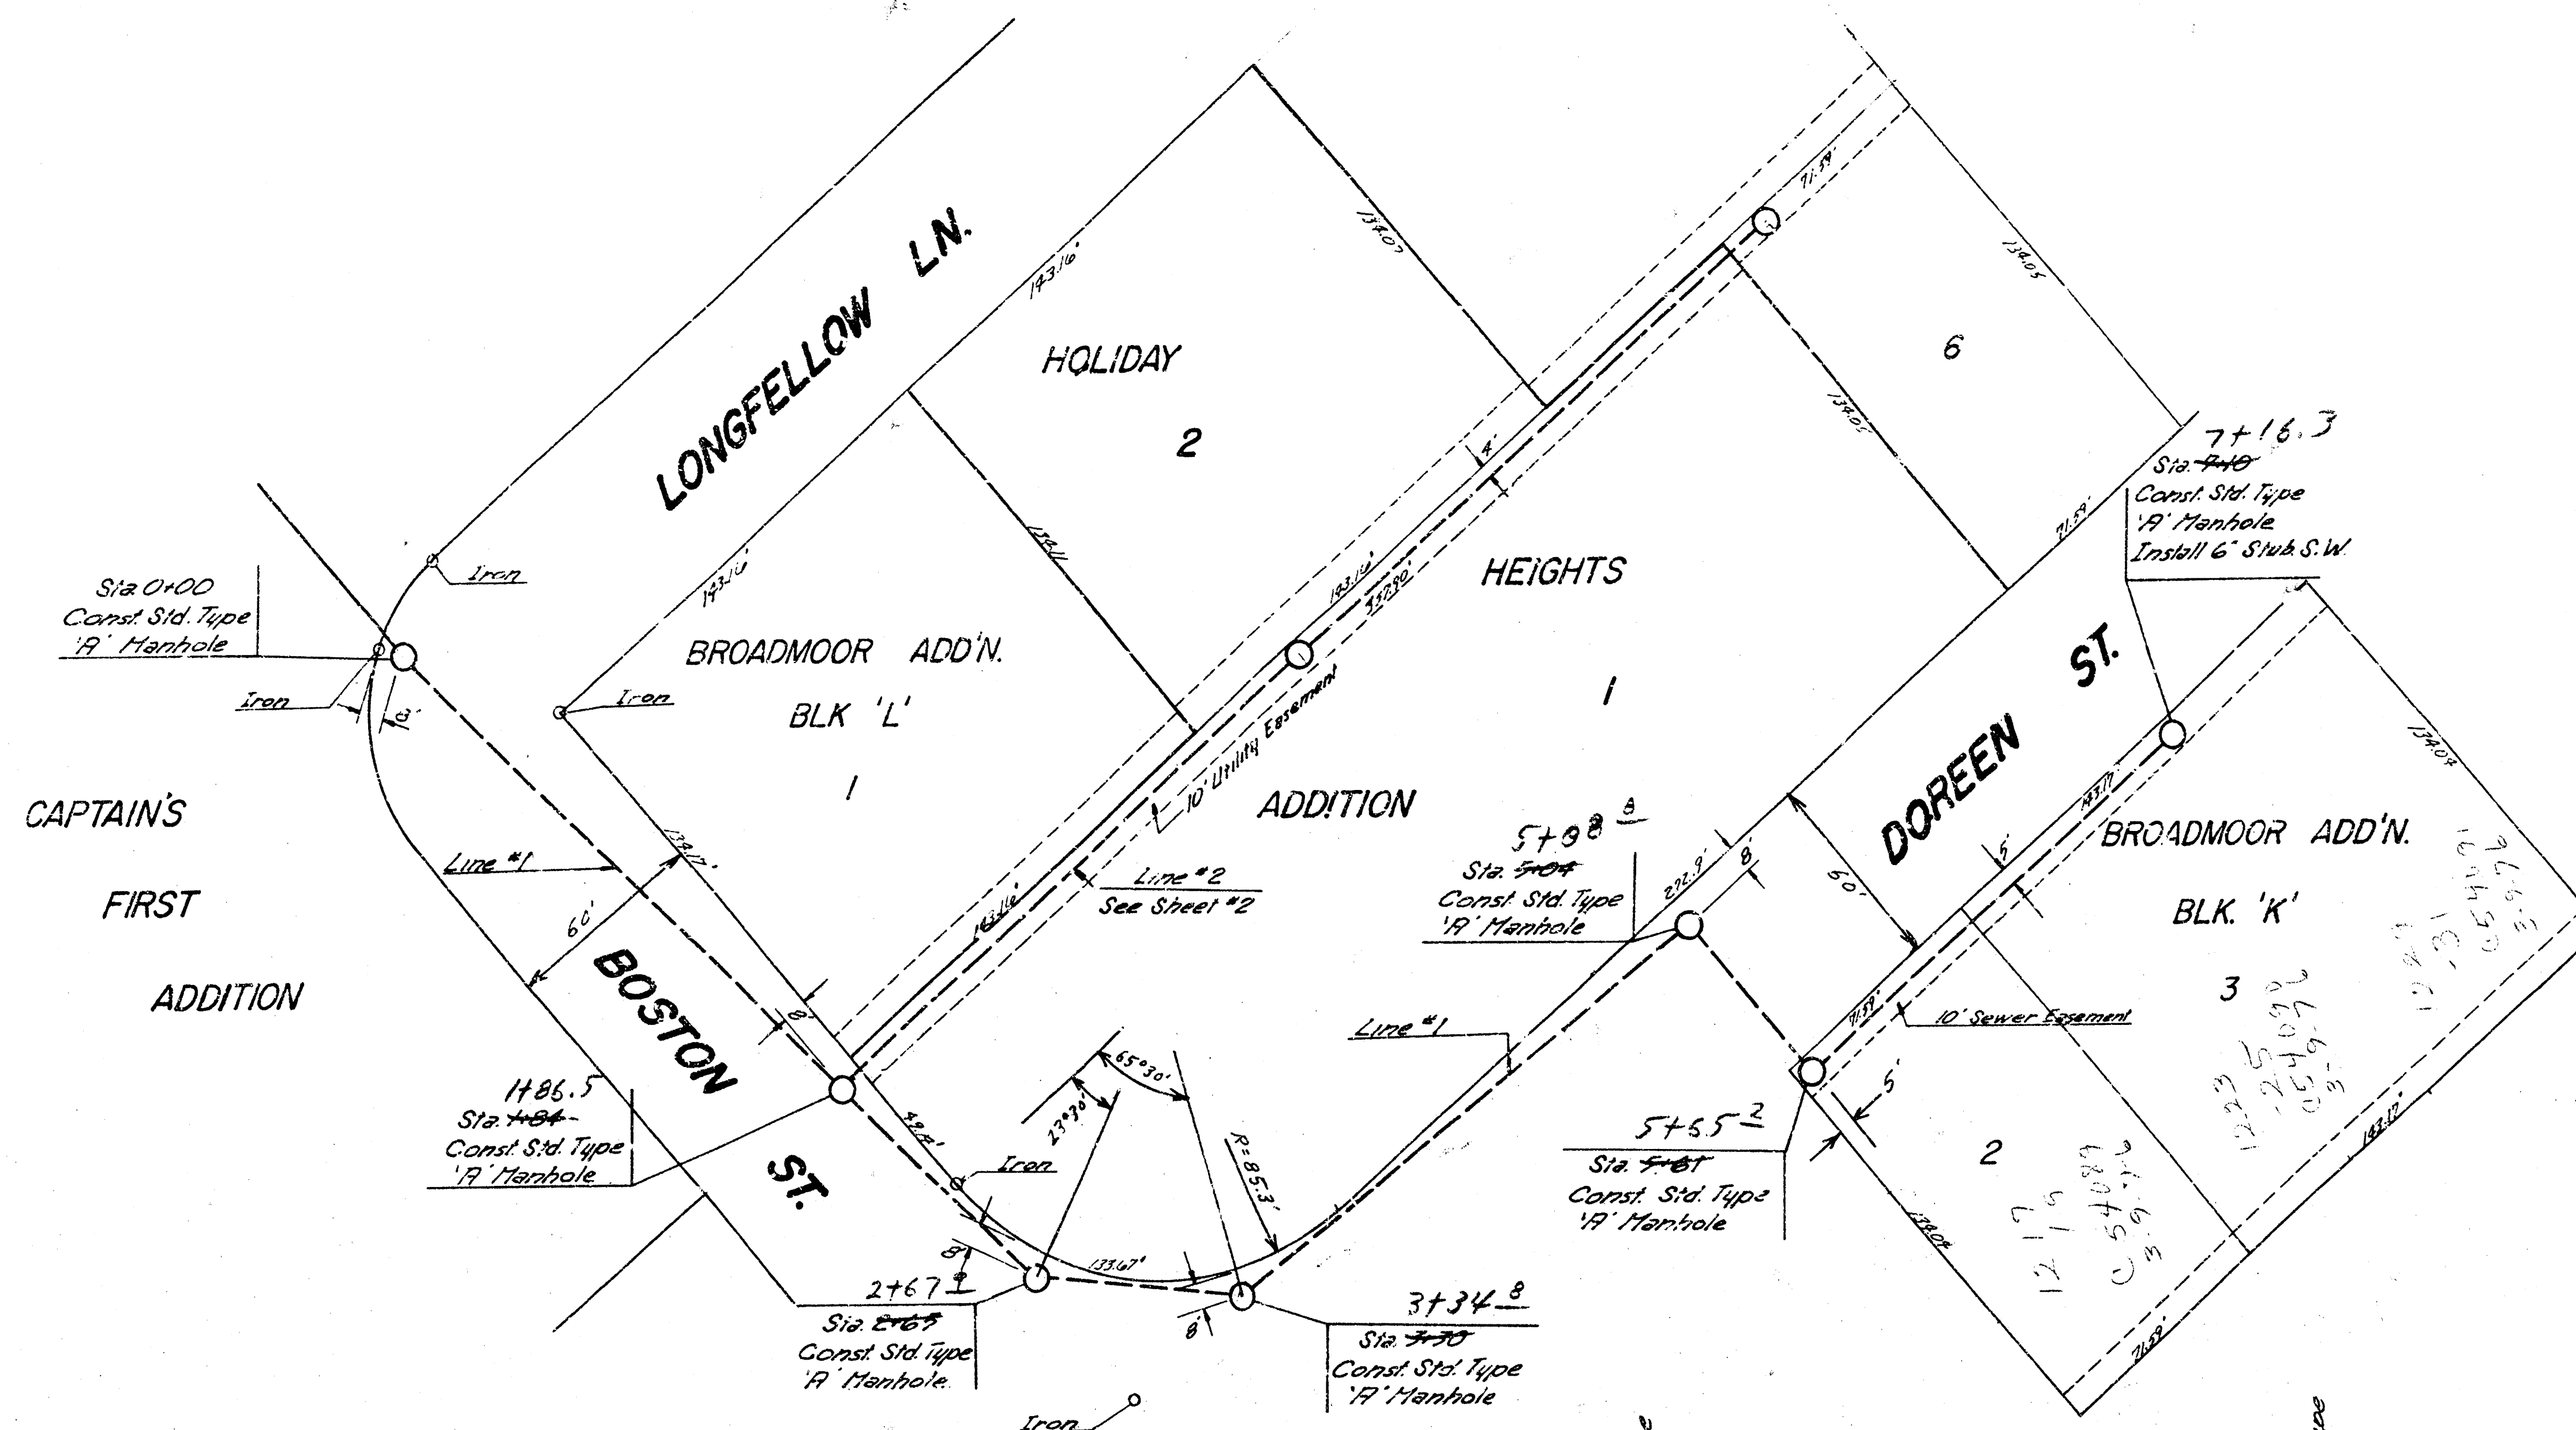

B.M. 145.4' Chiseled "X" in Ctr. of top W. End Handrail N.S. Triple 8x8 R.C.B. 250' East of Rock Rd. on Harry

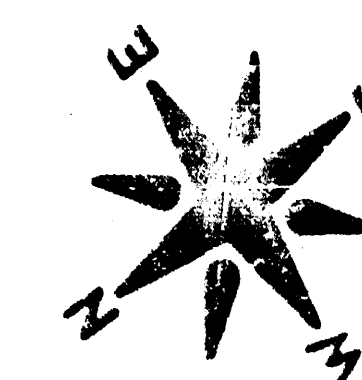

SCALES:
PLAN: 1"=40'
PROFILE: 1"=40'
VERT. 1"=5'

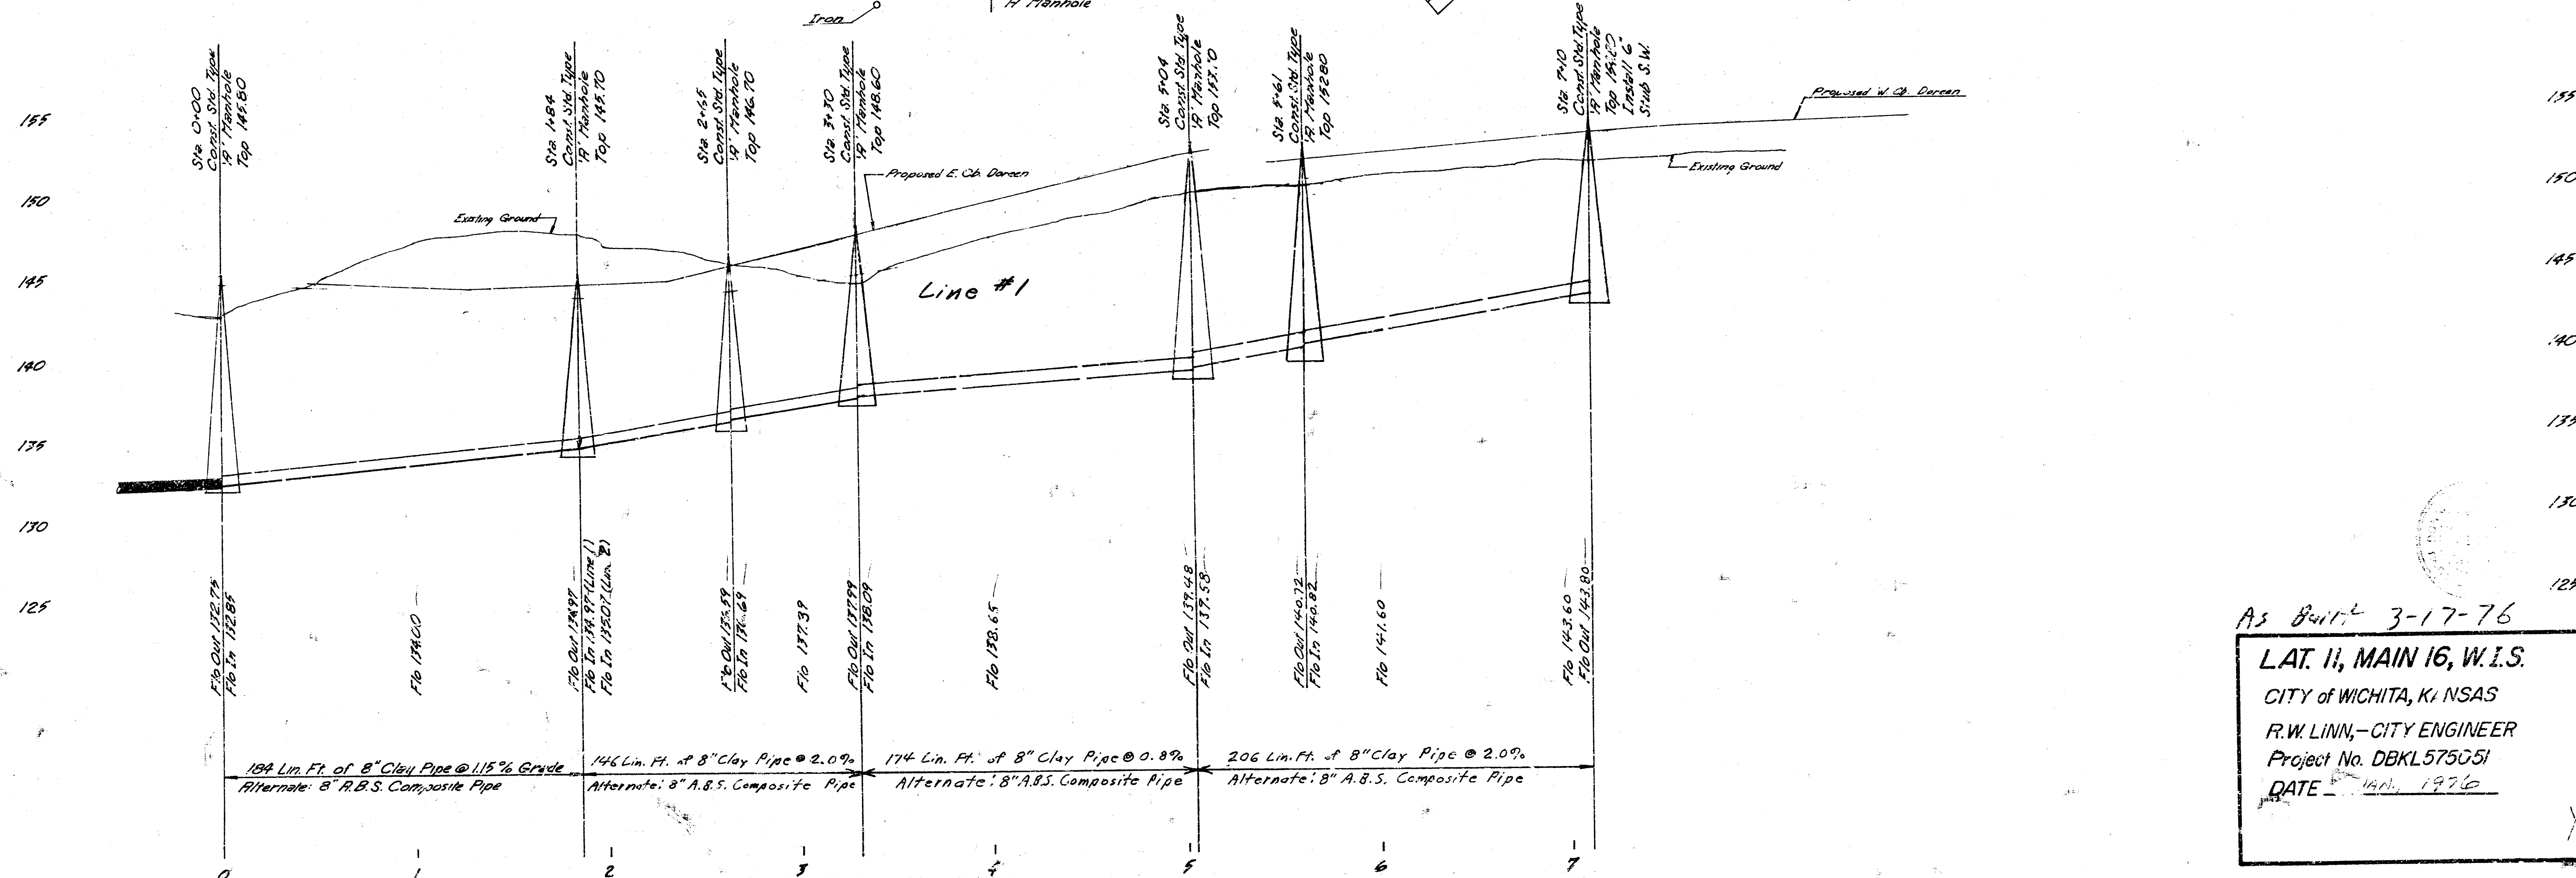

As Built 3-17-76

L.A.T. II, MAIN 16, W.I.S.
CITY OF WICHITA, KANSAS
R.W. LINN, CITY ENGINEER
Project No. DBKL575051
DATE: JAN. 1976

