

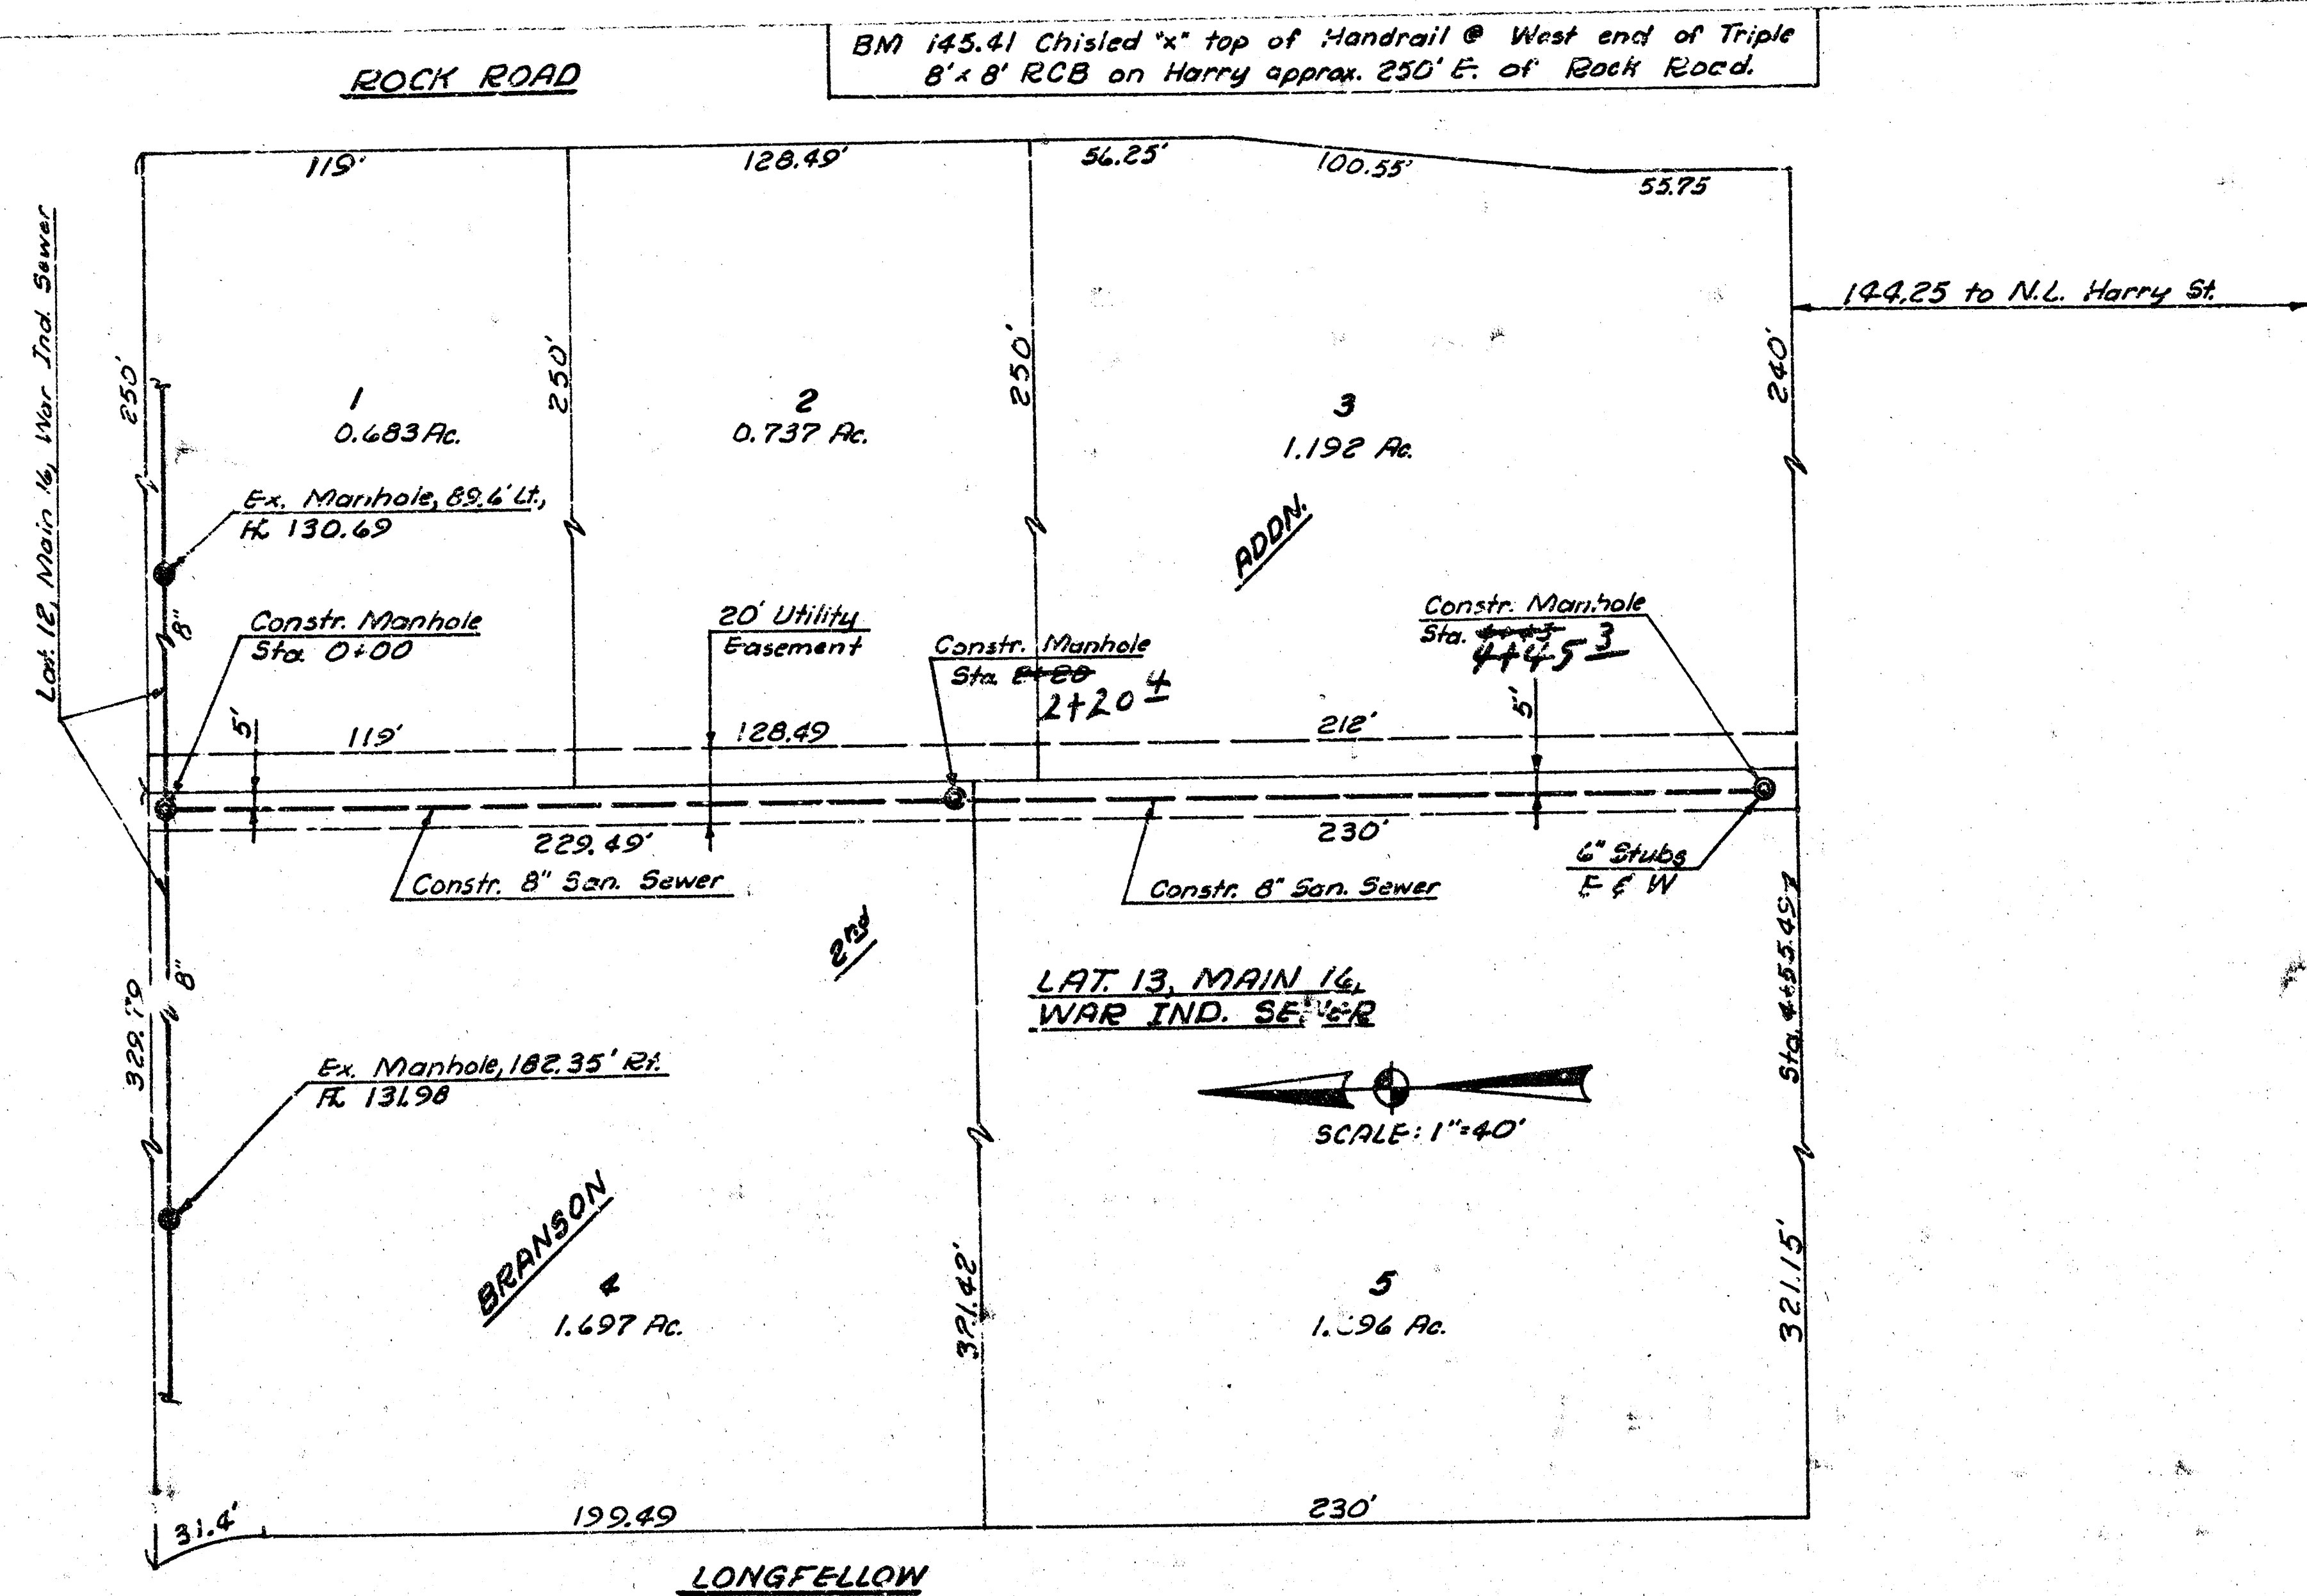


PLAN
 000-1/2 (4413)
 1/2" = 10' (4413)
 1/2" = 10' (4413)

Res. p. 199, Bk 23

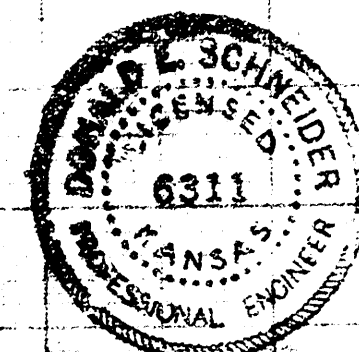

PROFILE
 000-1/2 (4413)
 1/2" = 10' (4413)
 1/2" = 10' (4413)

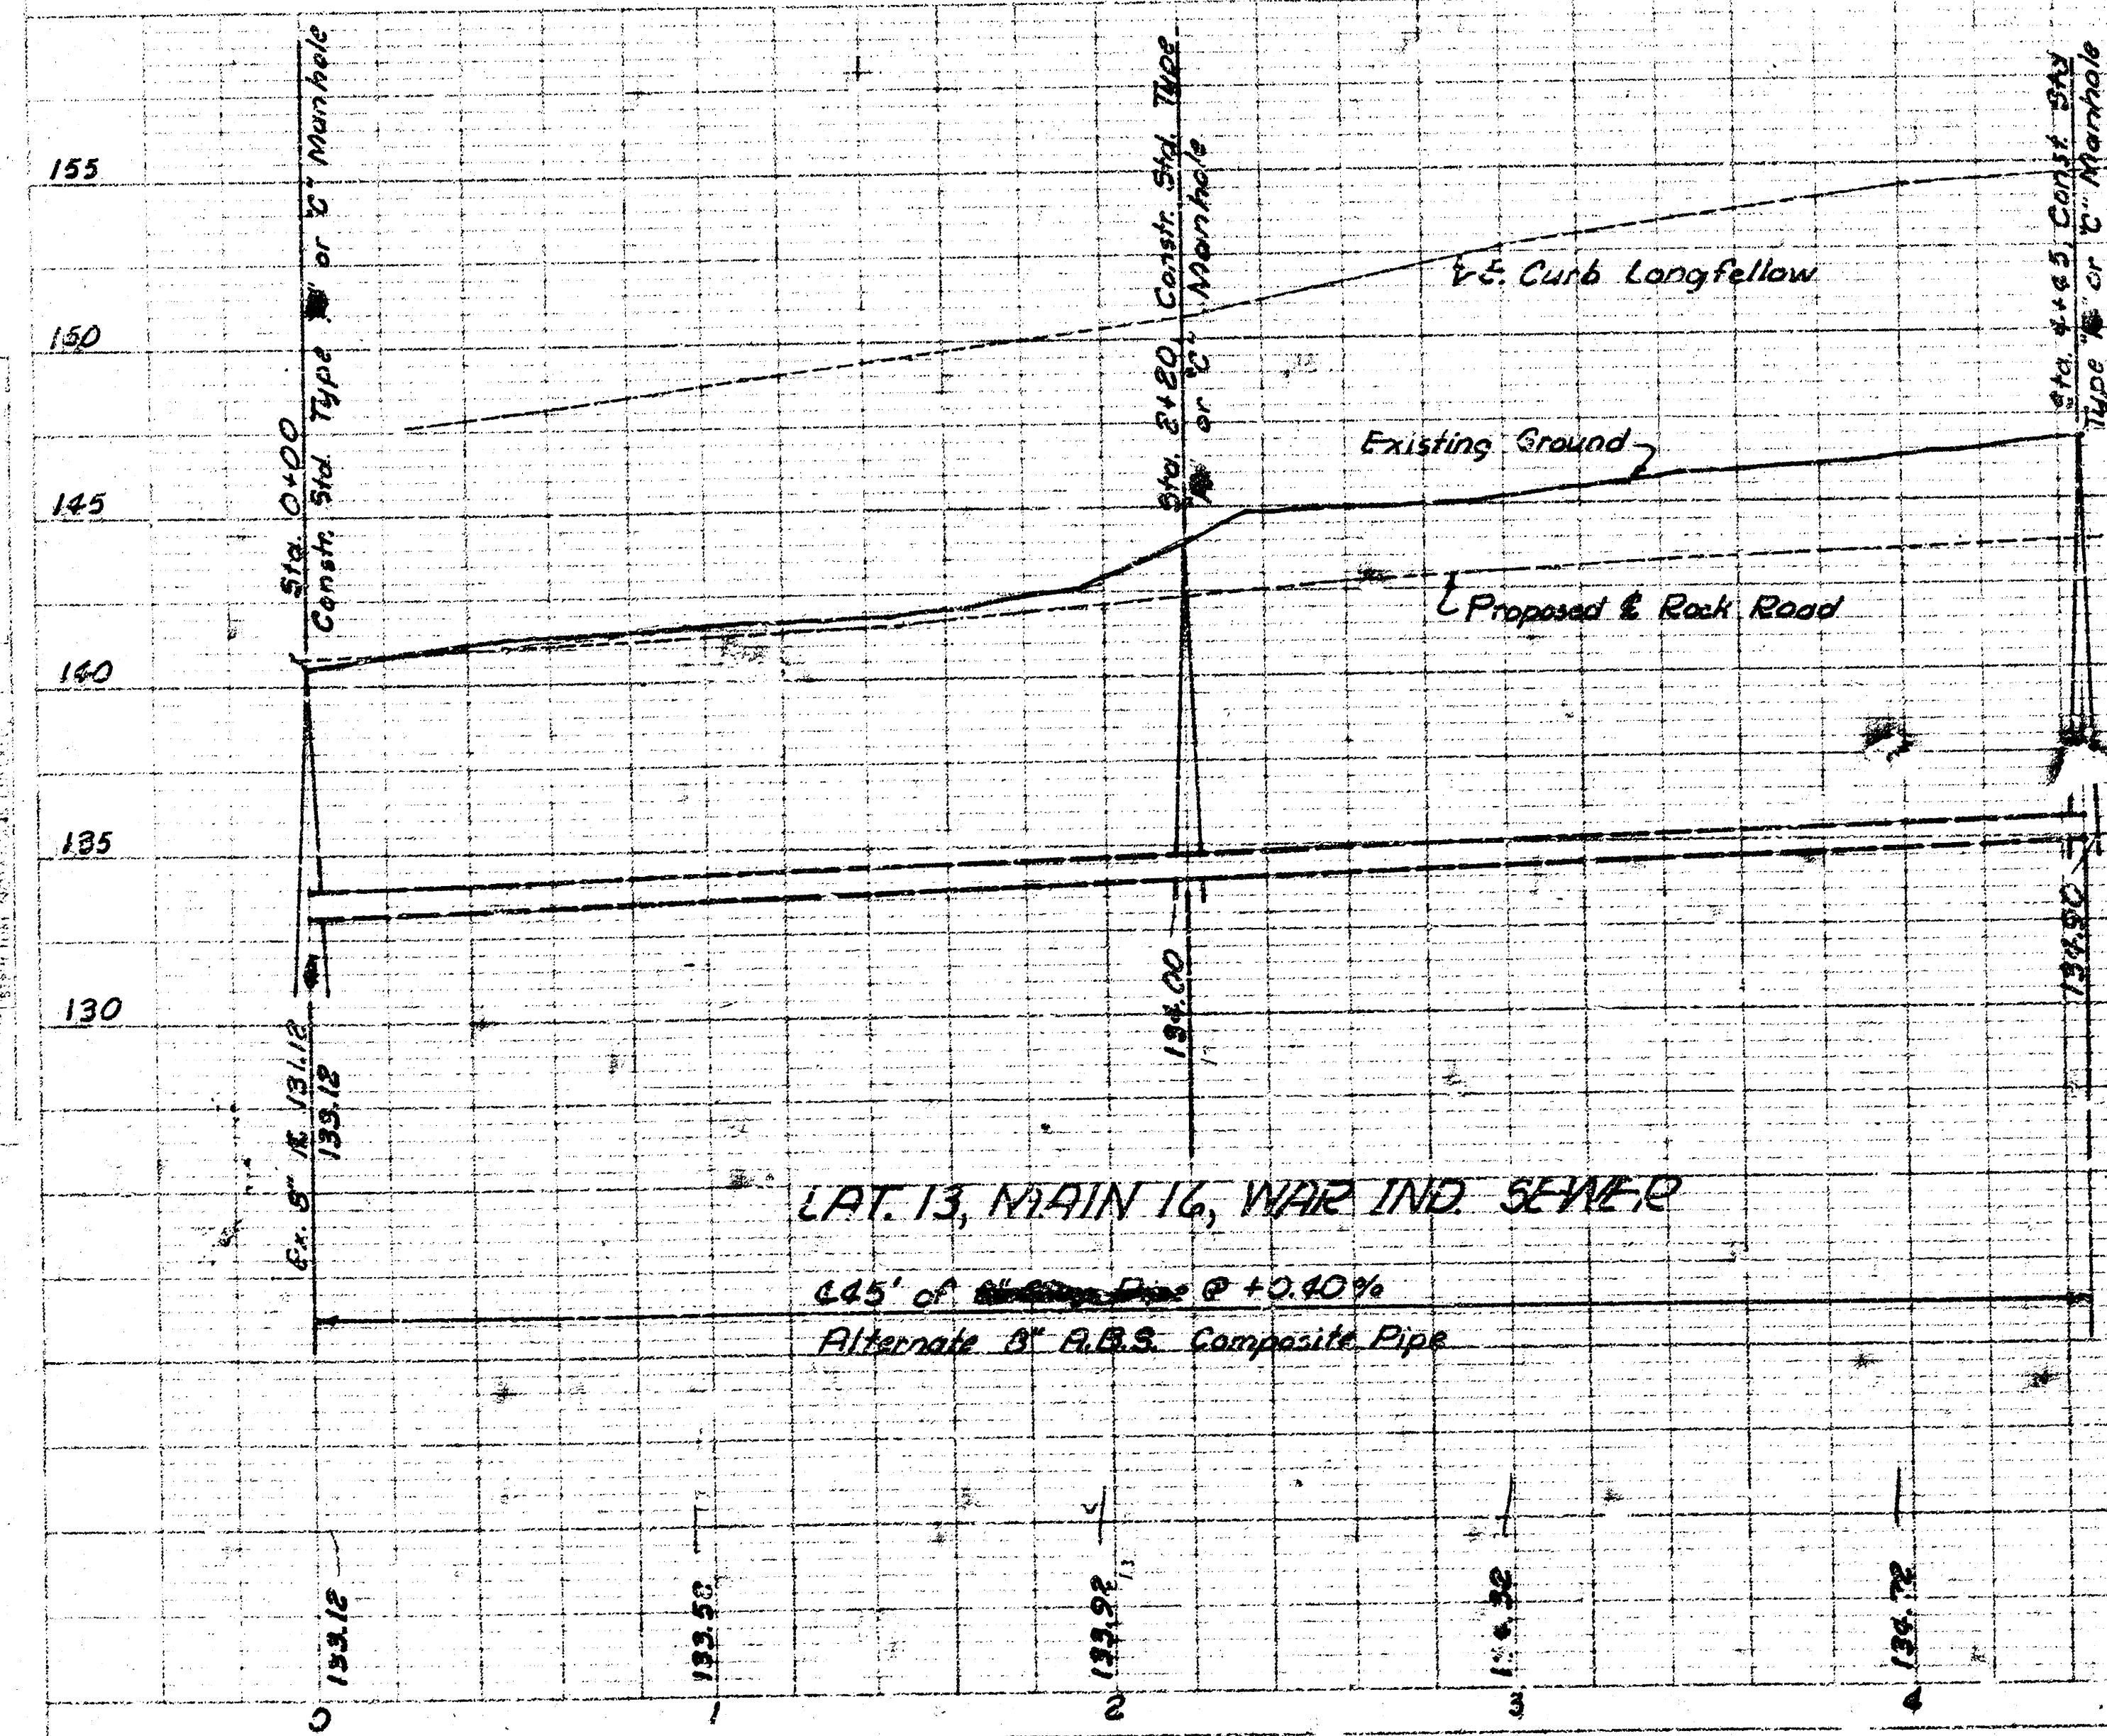

As built 6-28-77

LAT 13, MAIN 16, W.I.S.
 CITY OF WICHITA, KANSAS
 R.W. LININ - CITY ENGINEER
 Project DBKL 575080
 DATE 6-28-77 Sheet 1 of 1