




Scale Plan 1" = 40'
 Profile 1" = 40' Horiz.
 1" = 5' Vert.

B.M. 154.55 N.W. Corner of conc. walk @
 N. face of building on S.E. corner
 of Harry & Broadmoor.

Sta 0+00 Existing M.H.
 Sta 0+80 Const Std.
 M.H. Type A or B
 6" stub W.

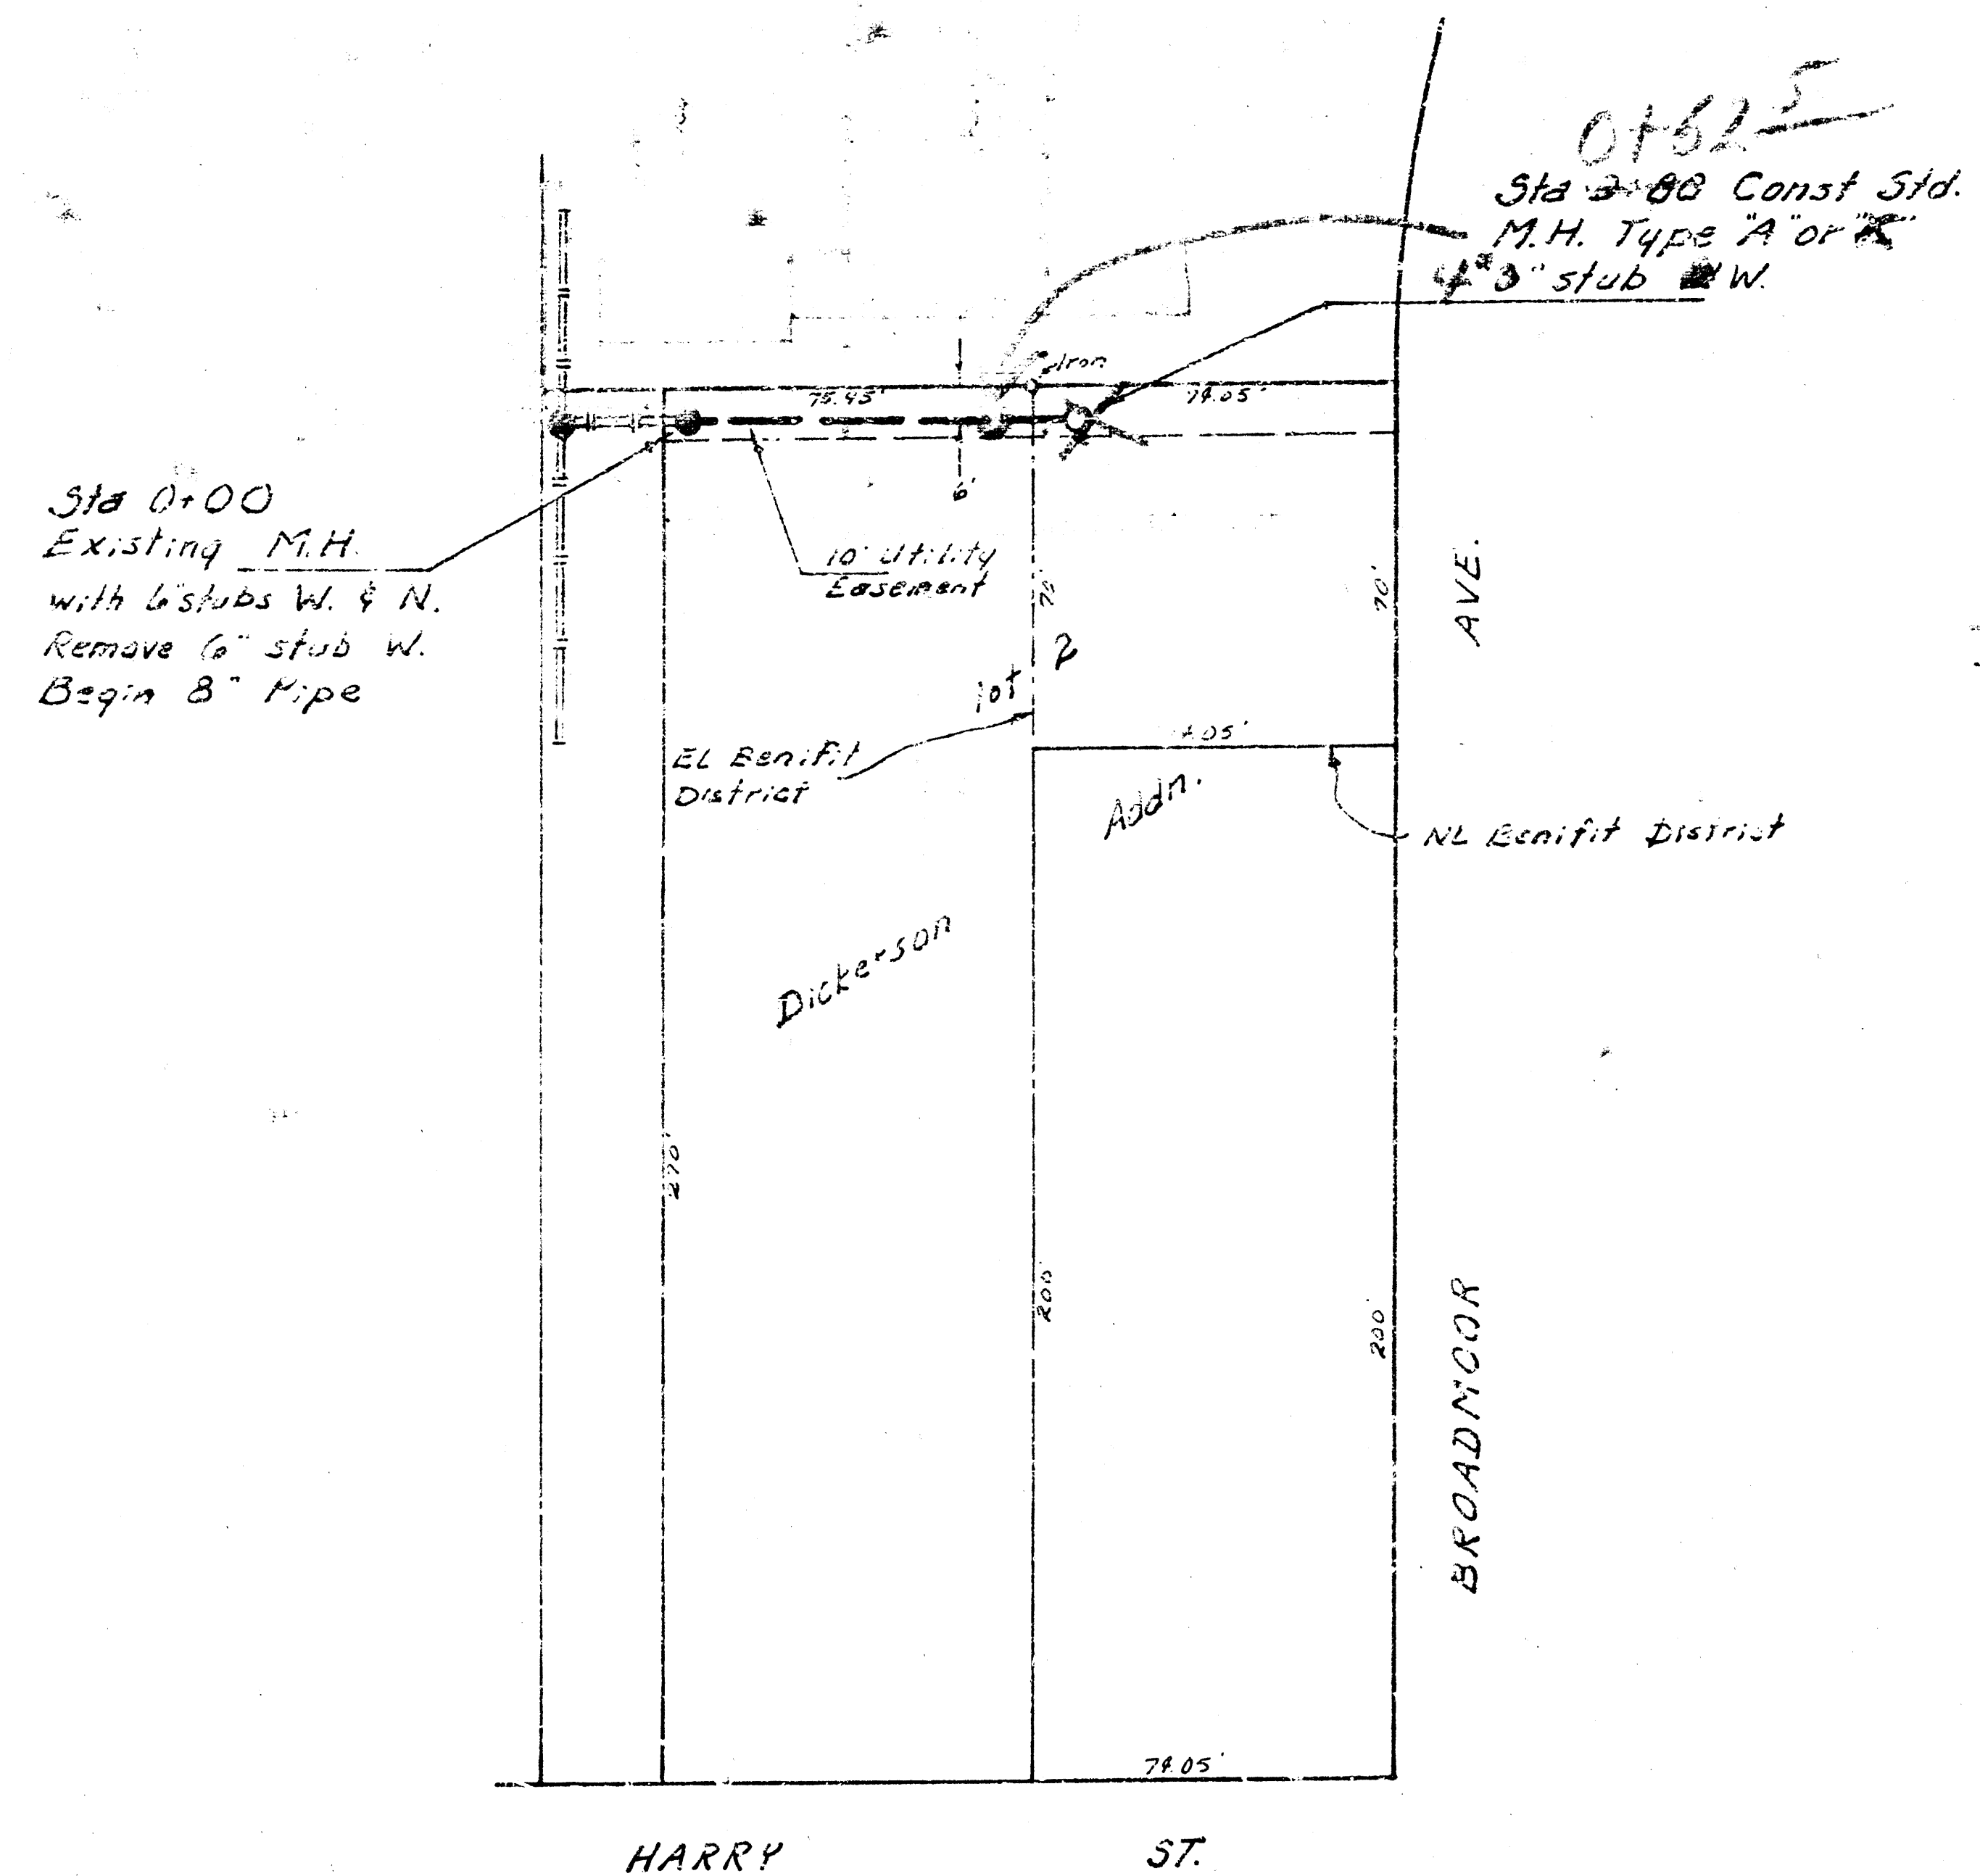

80 Lin. Ft. 8" ~~8\"/>~~

Alternate A.B.S. Composite Pipe

As built 5-9-78

LAT 14, MAIN 16, WAR INDUSTRIES

CITY OF WICHITA, KANSAS

R. W. LINN — CITY ENGINEER

March 1978 PROJECT NO. DBK1577078

