



NOTE. CONTRACTOR SHALL GIVE OWNERS AND/OR TENANTS OF DEVELOPED PROPERTY AFFECTED BY THE CONSTRUCTION OF THIS PROJECT A MINIMUM ADVANCE NOTICE OF 48 HOURS PRIOR TO START OF CONSTRUCTION. CONTRACTOR SHALL MAKE PROVISIONS TO PROVIDE VEHICULAR ACCESS TO THE DEVELOPED PROPERTY NORMAL OF FUNCTION DURING THE TIME OF THEIR NORMAL BUSINESS OPERATION.

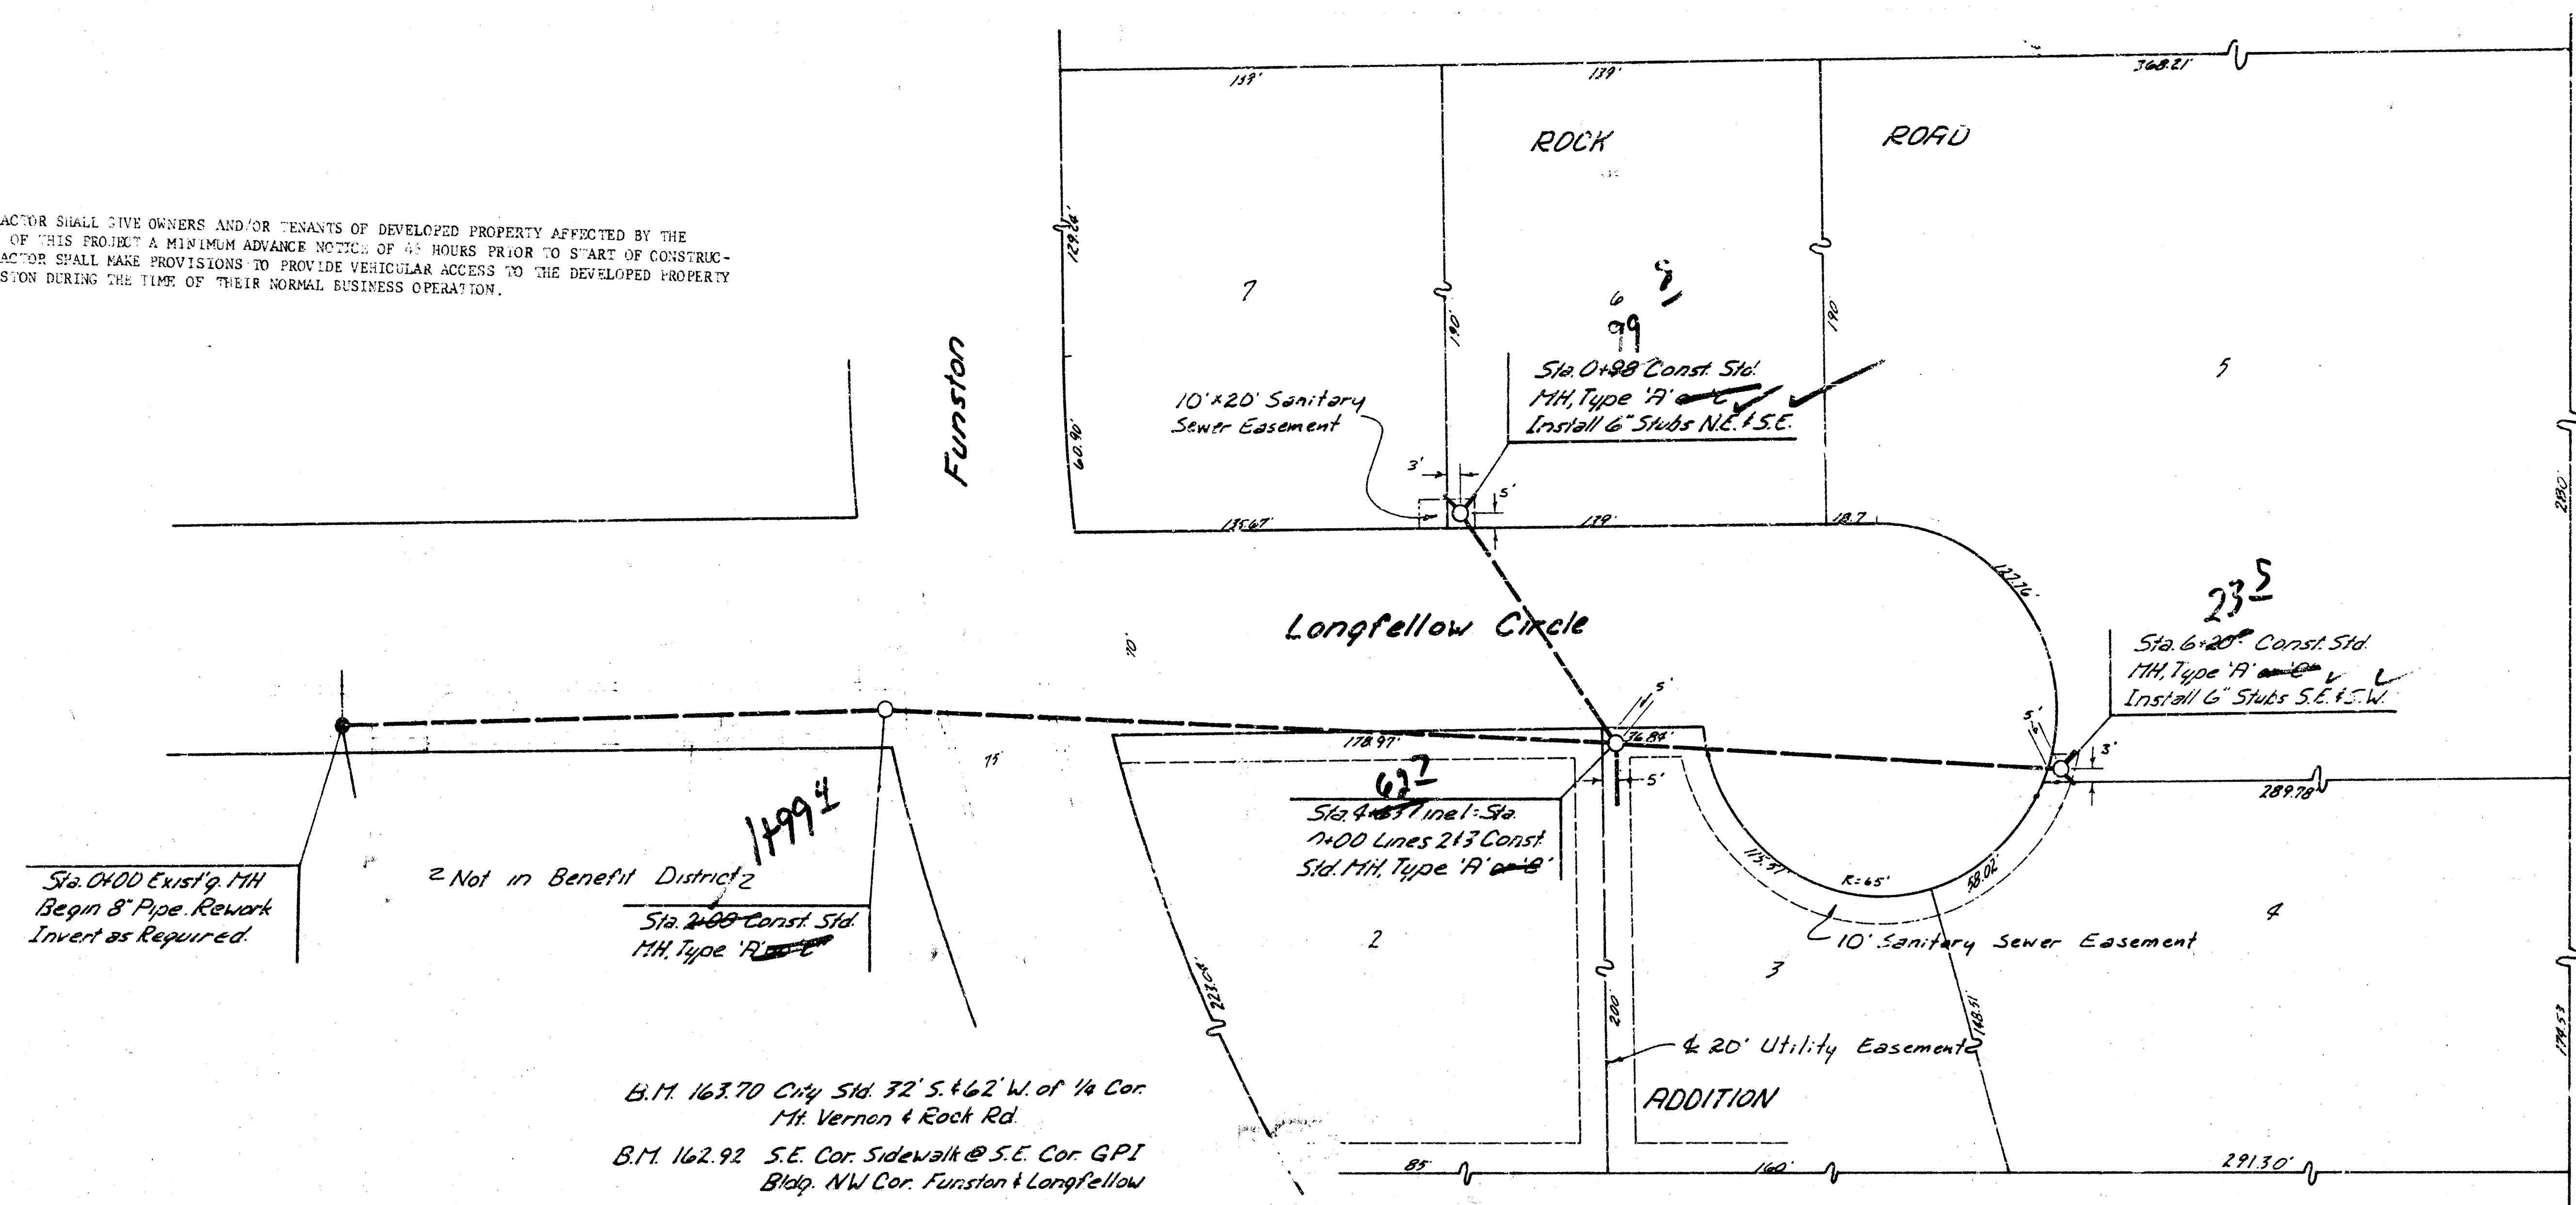


GENERAL NOTES

1. Contractor to Contact Gas Service Co. a Min. of 2 Days in Advance of Starting Project.
2. Connections between Clay Pipe & Ductile Iron Pipe to be Reinf. Conc Encased a Minimum of 2" either Side of the Joint.
3. Field Engineer to Set Top of Manholes to Finish Grade as Determined by the Developer Unless Otherwise Noted on Plans.

SCALE  
Plan 1"=40'  
Profile Horz. 1"=40'  
Vert. 1"=5'

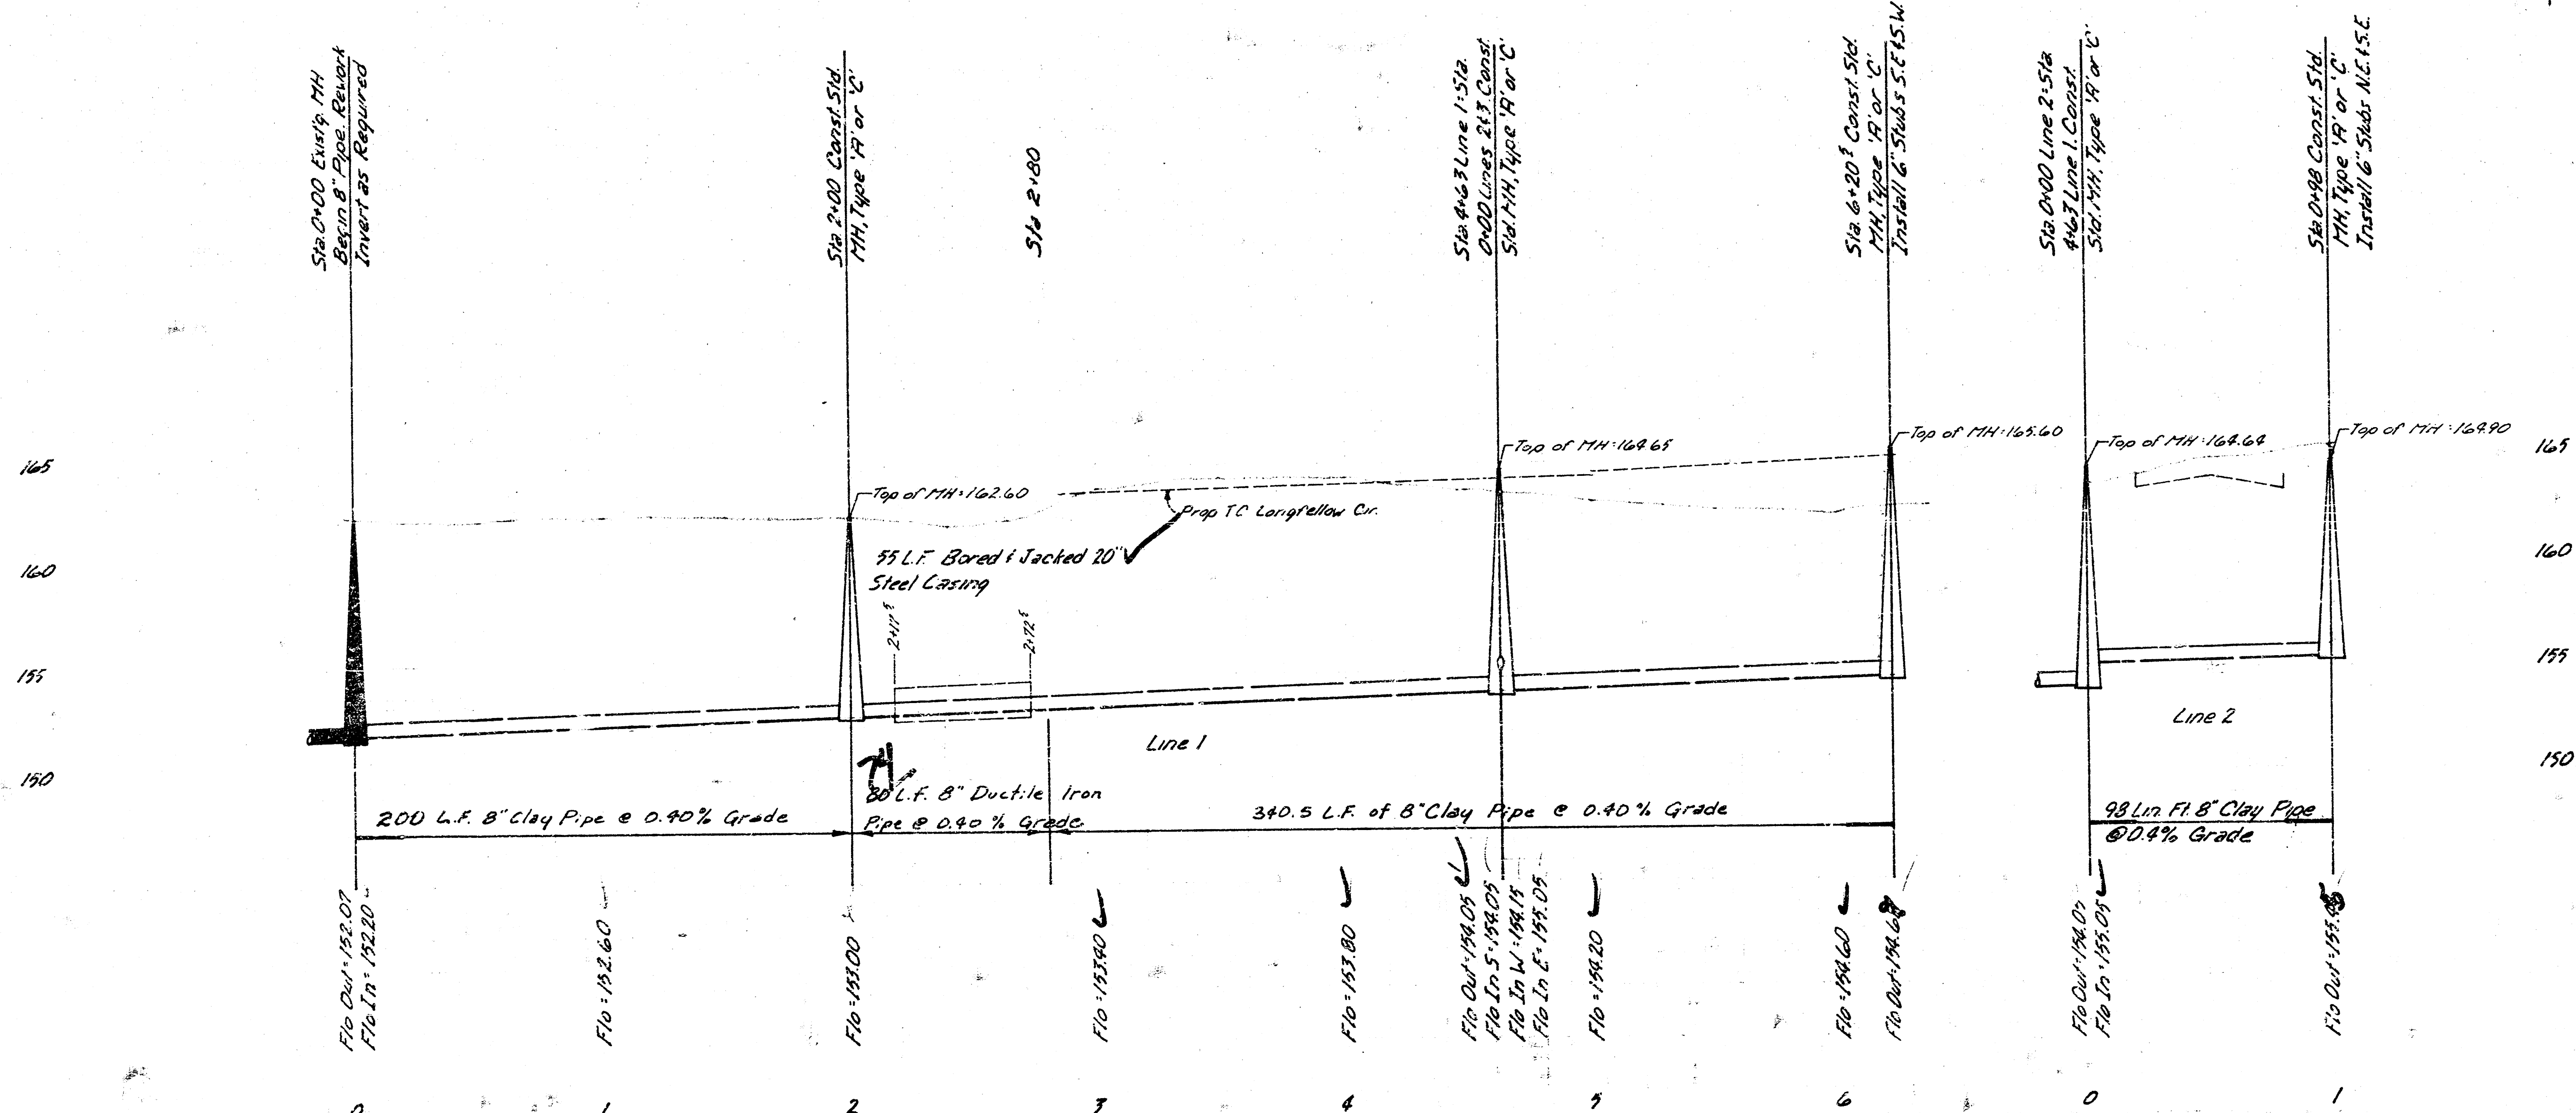

As Built  
Y82  
11/81

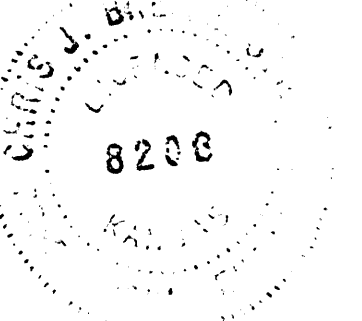

Lat. 15, Mainville, W.I.S.  
468-76-245-80743-000-000-001  
City of Wichita, Kansas  
Dept. of Public Works-Eng. Div  
Dean S. Sellers-Acting City Engineer

