

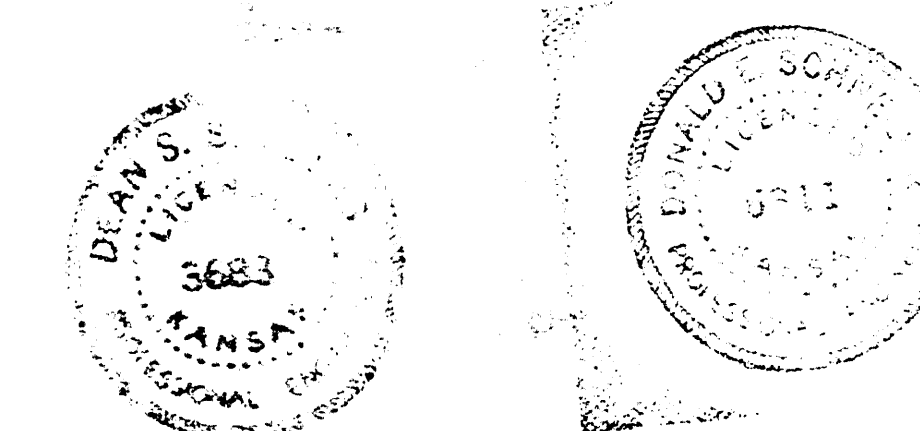


MAIN 17, WAR INDUSTRIES SEWER
CITY OF WICHITA, KANSAS
R. W. LINN — CITY ENGINEER
JULY 1973, PROJECT NO. DBKM 573034

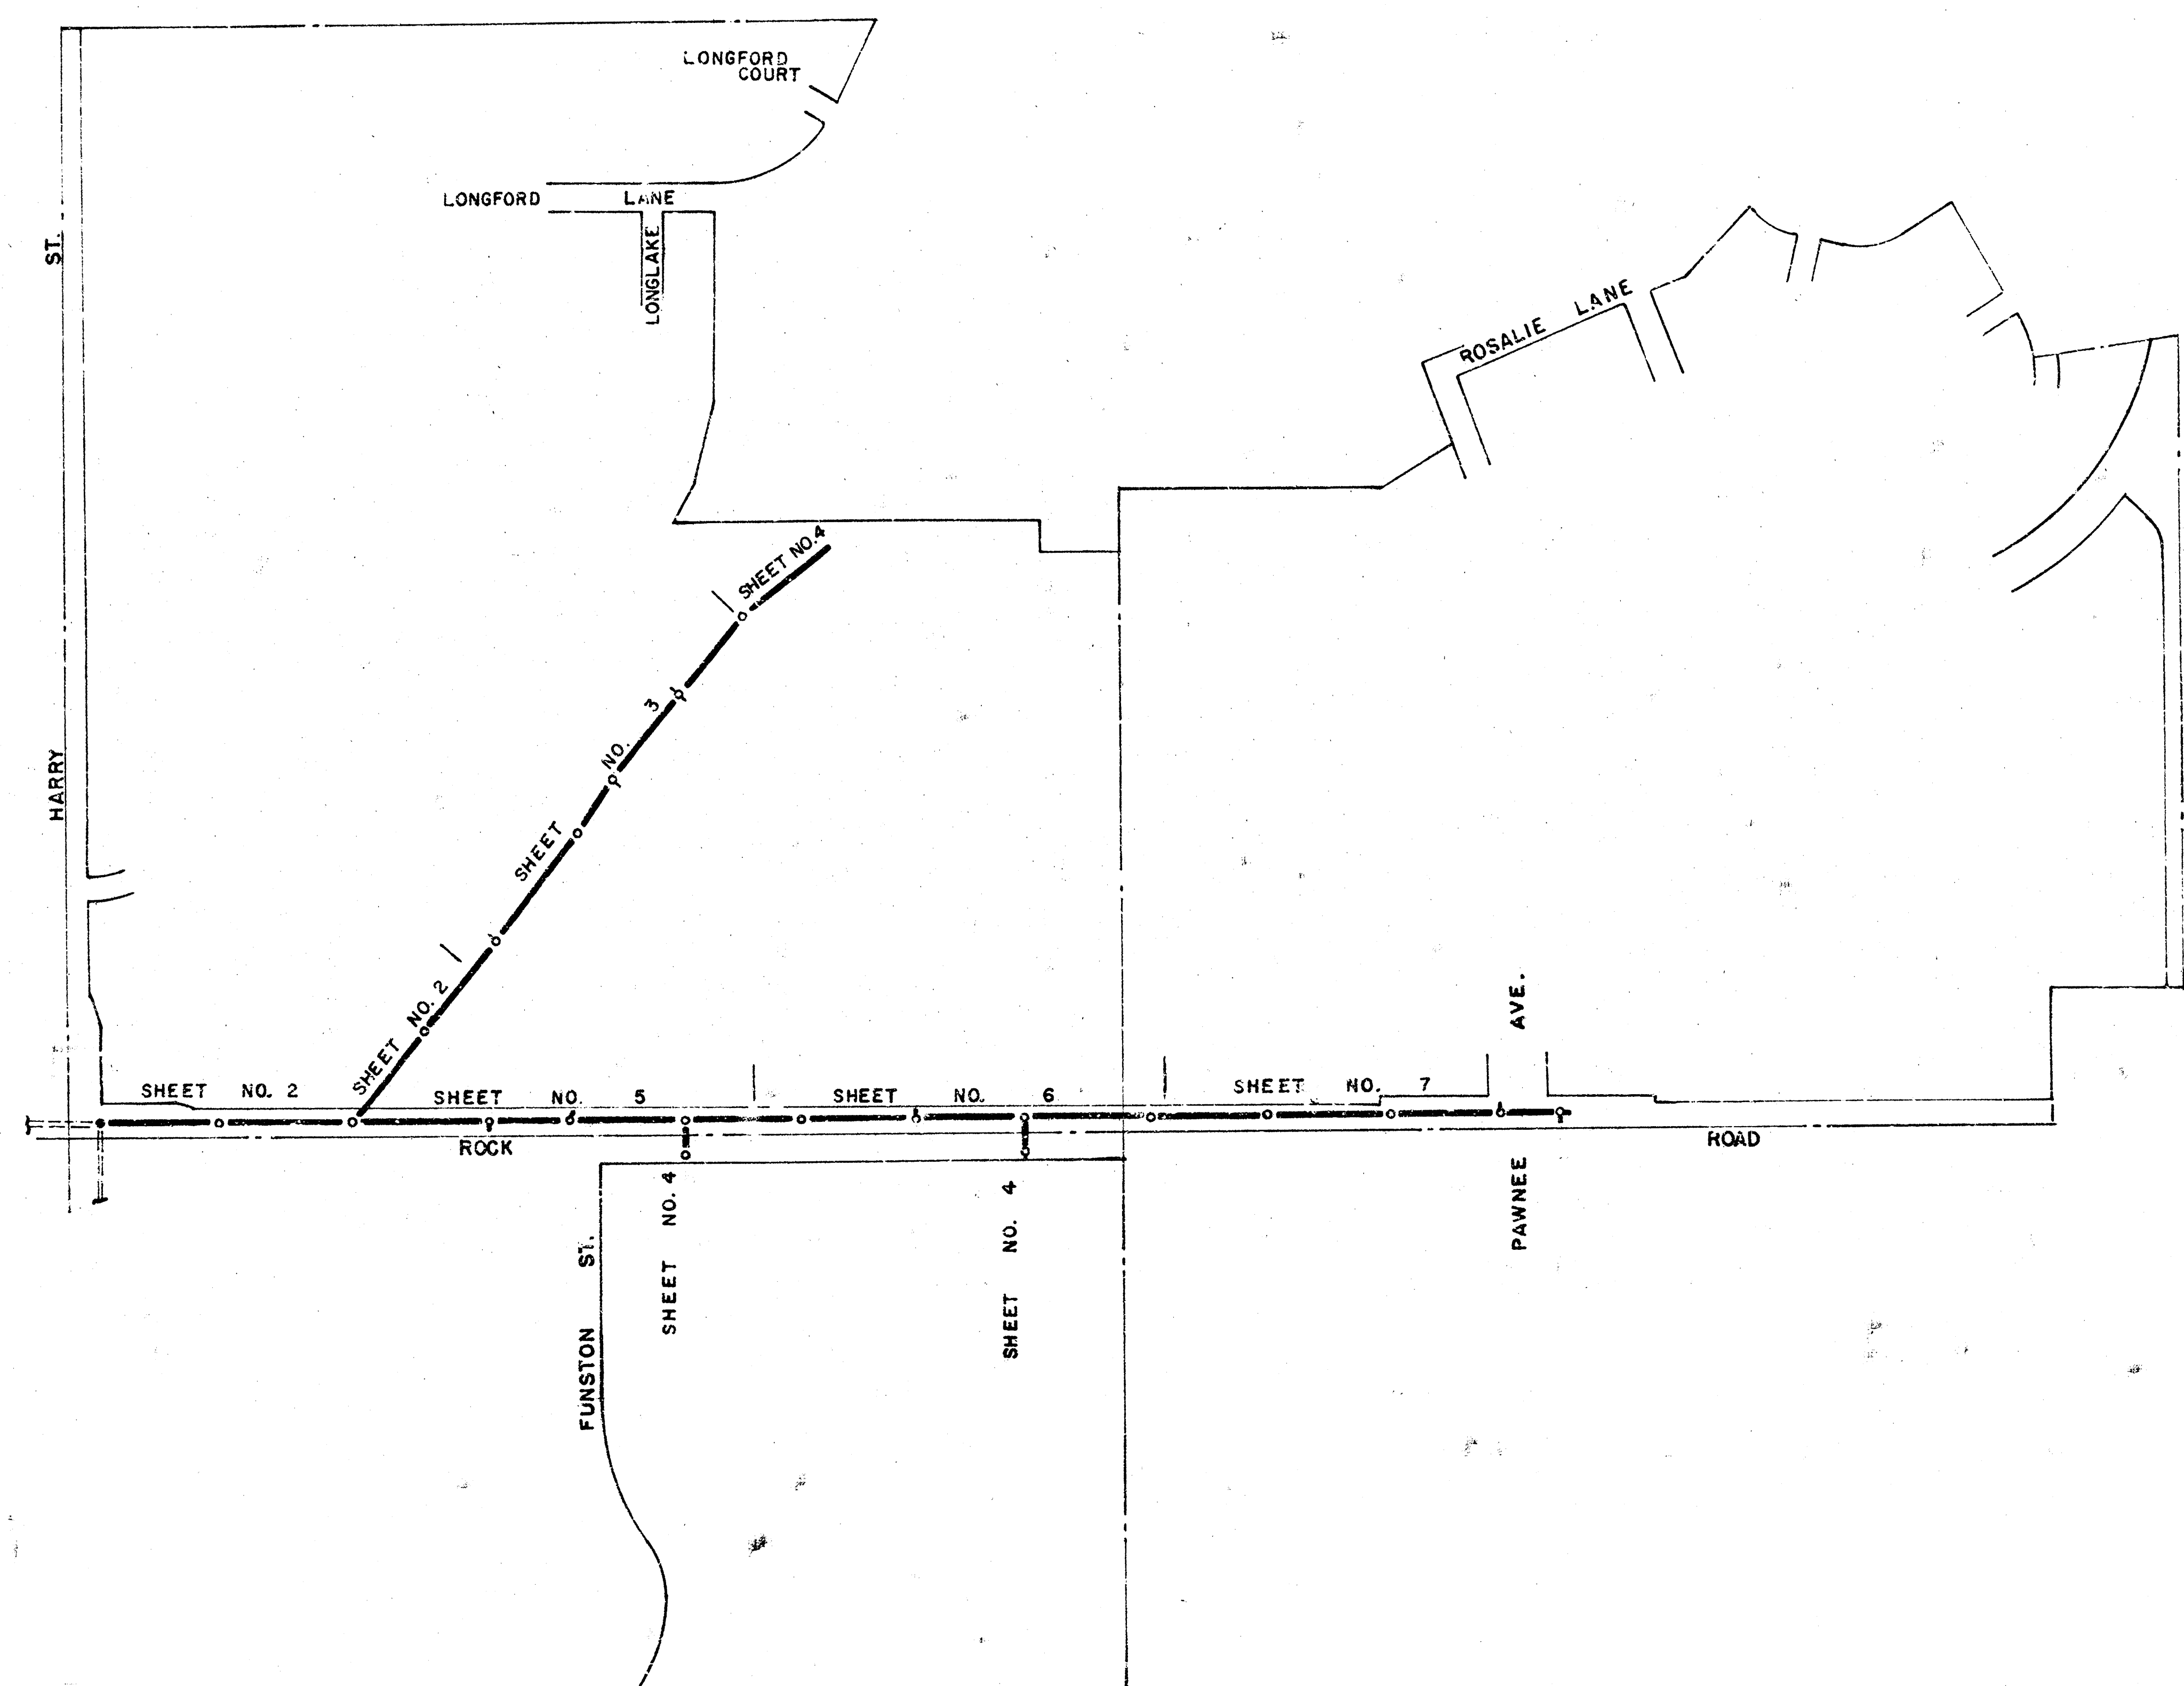



As Built Final Meas. 280-9


MAIN 17, WAR INDUSTRIES SEWER
PROJECT NO. DBK M573034

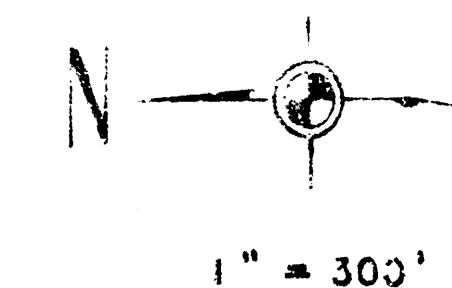



Plan Scale 1" = 40'
Profile Scale 1" = 40' Horiz.
1" = 5' Vert.

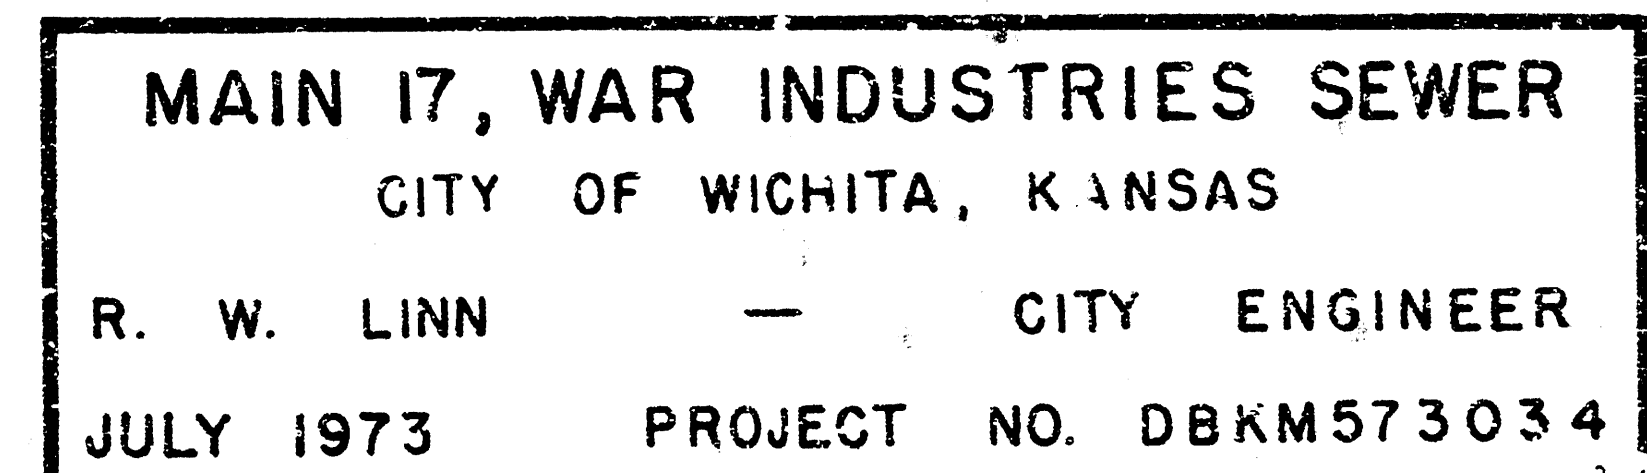


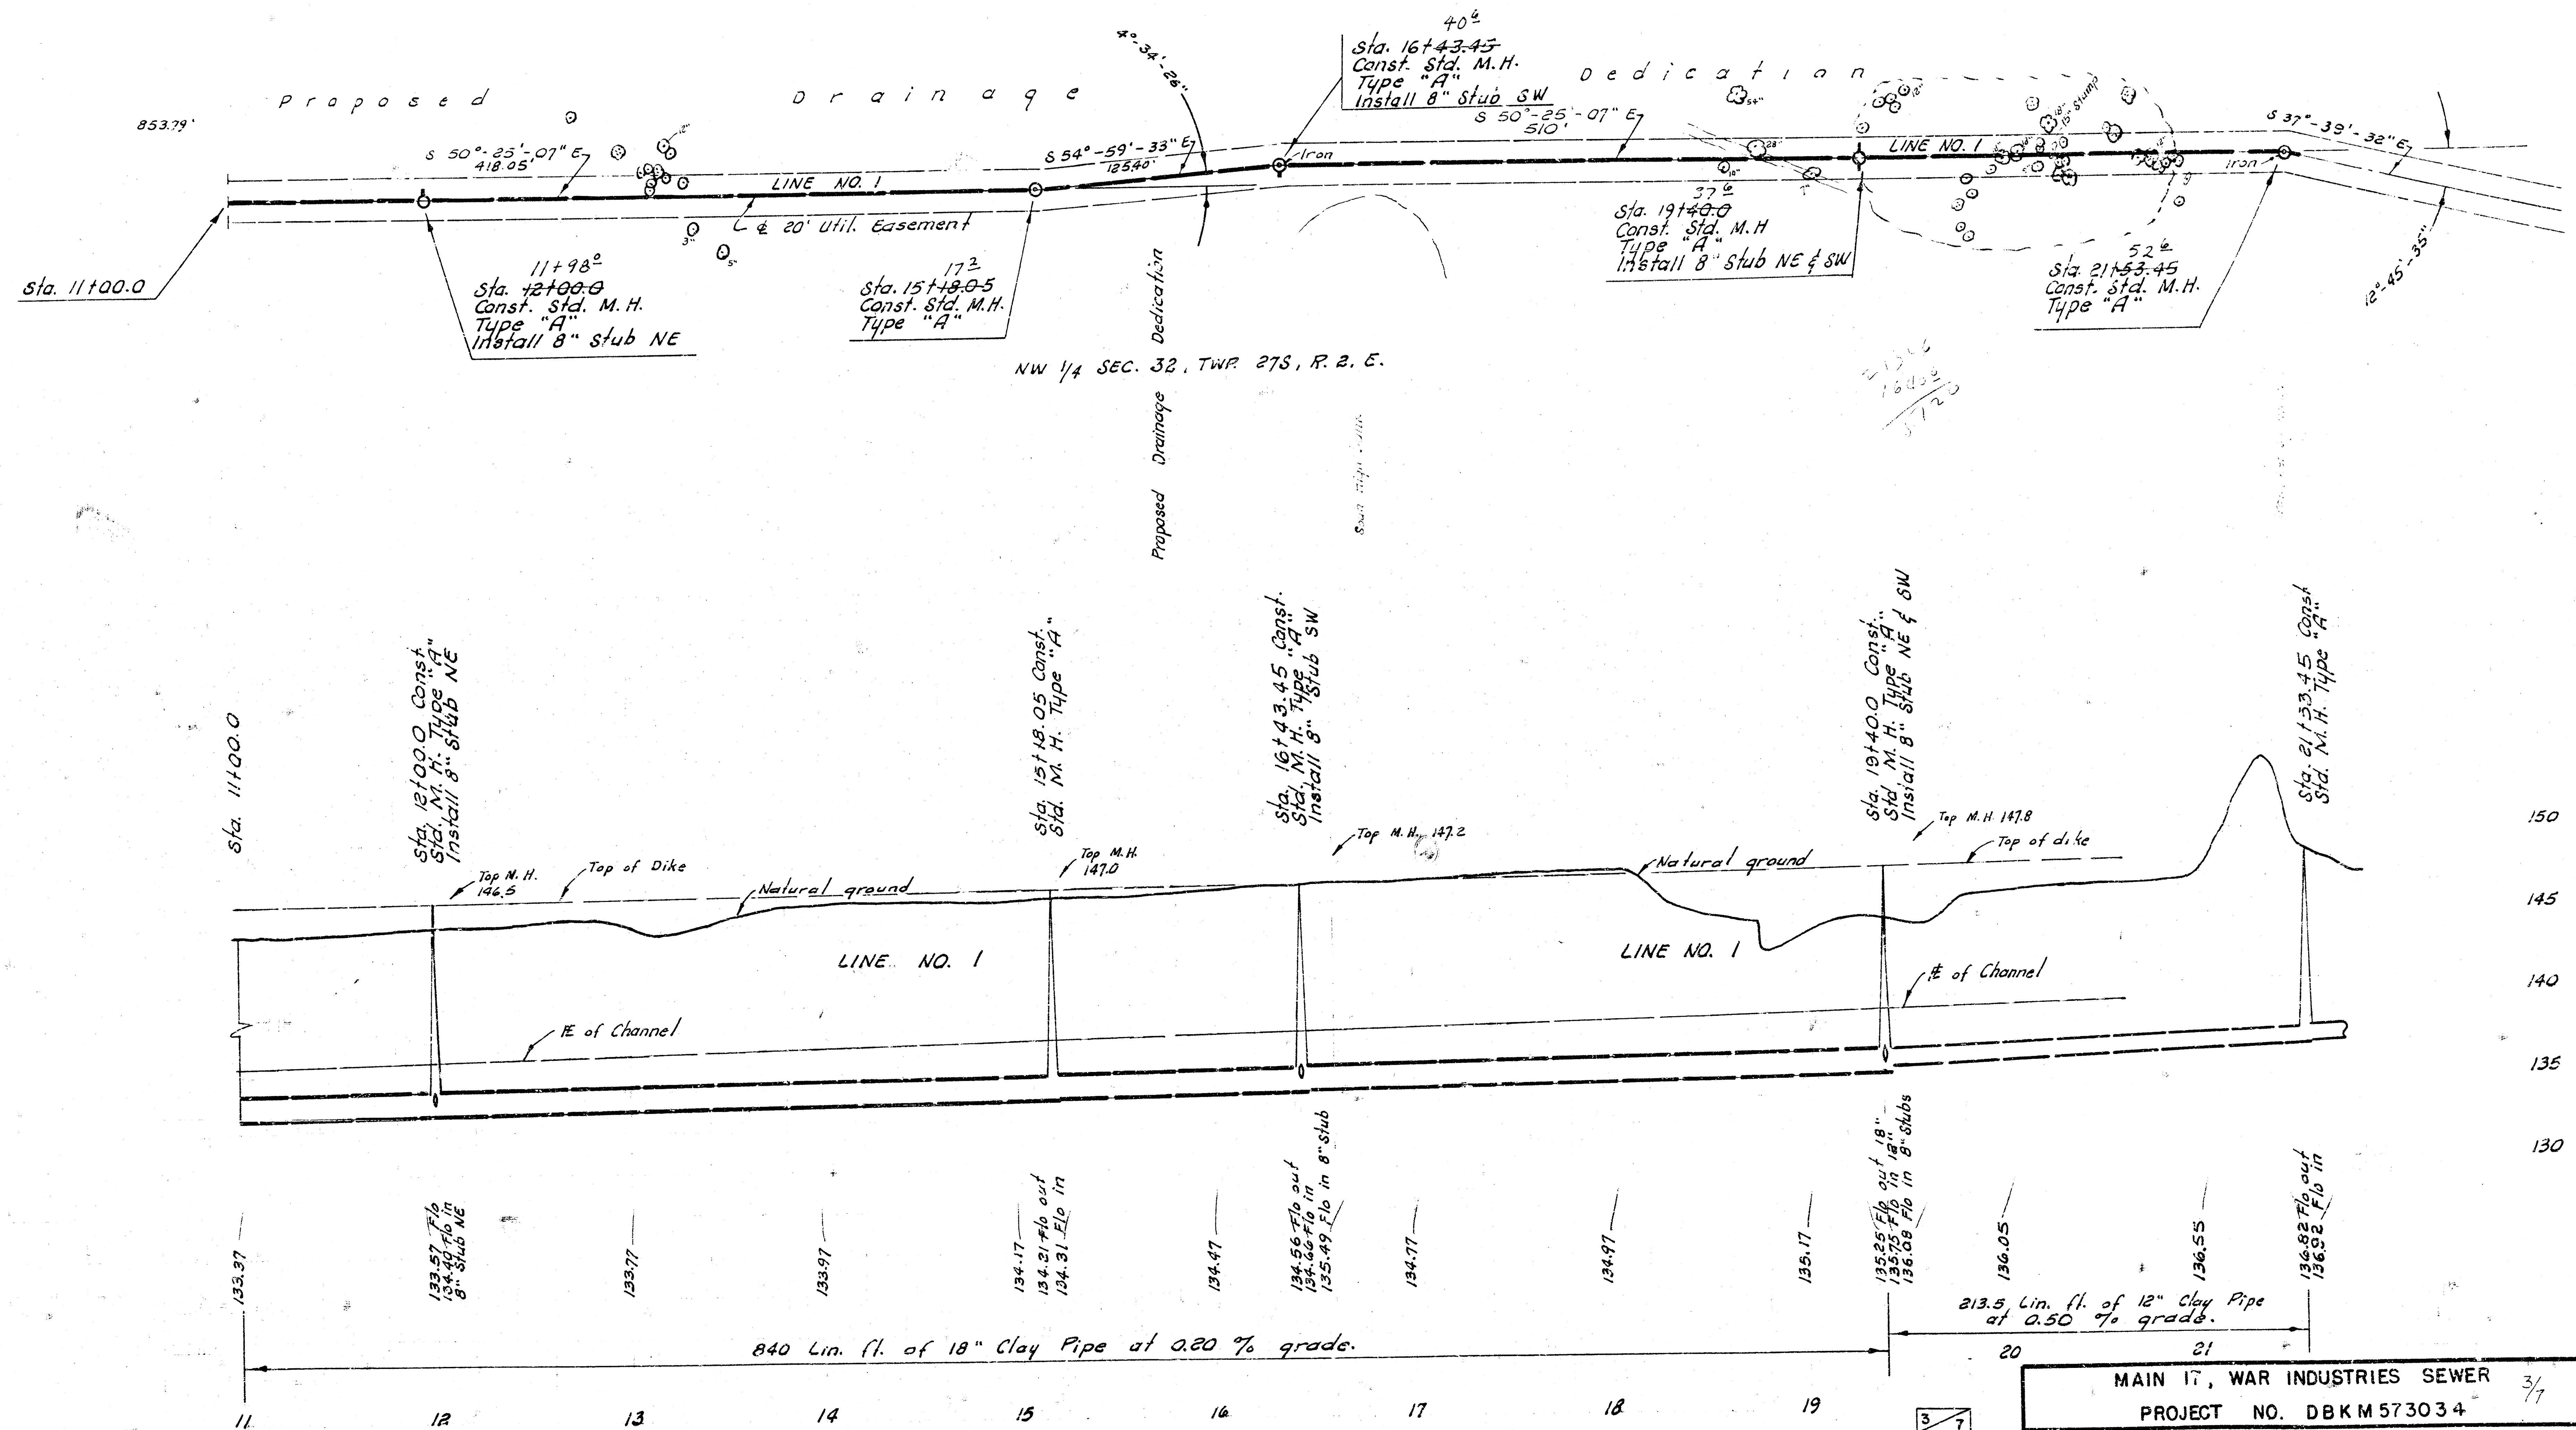


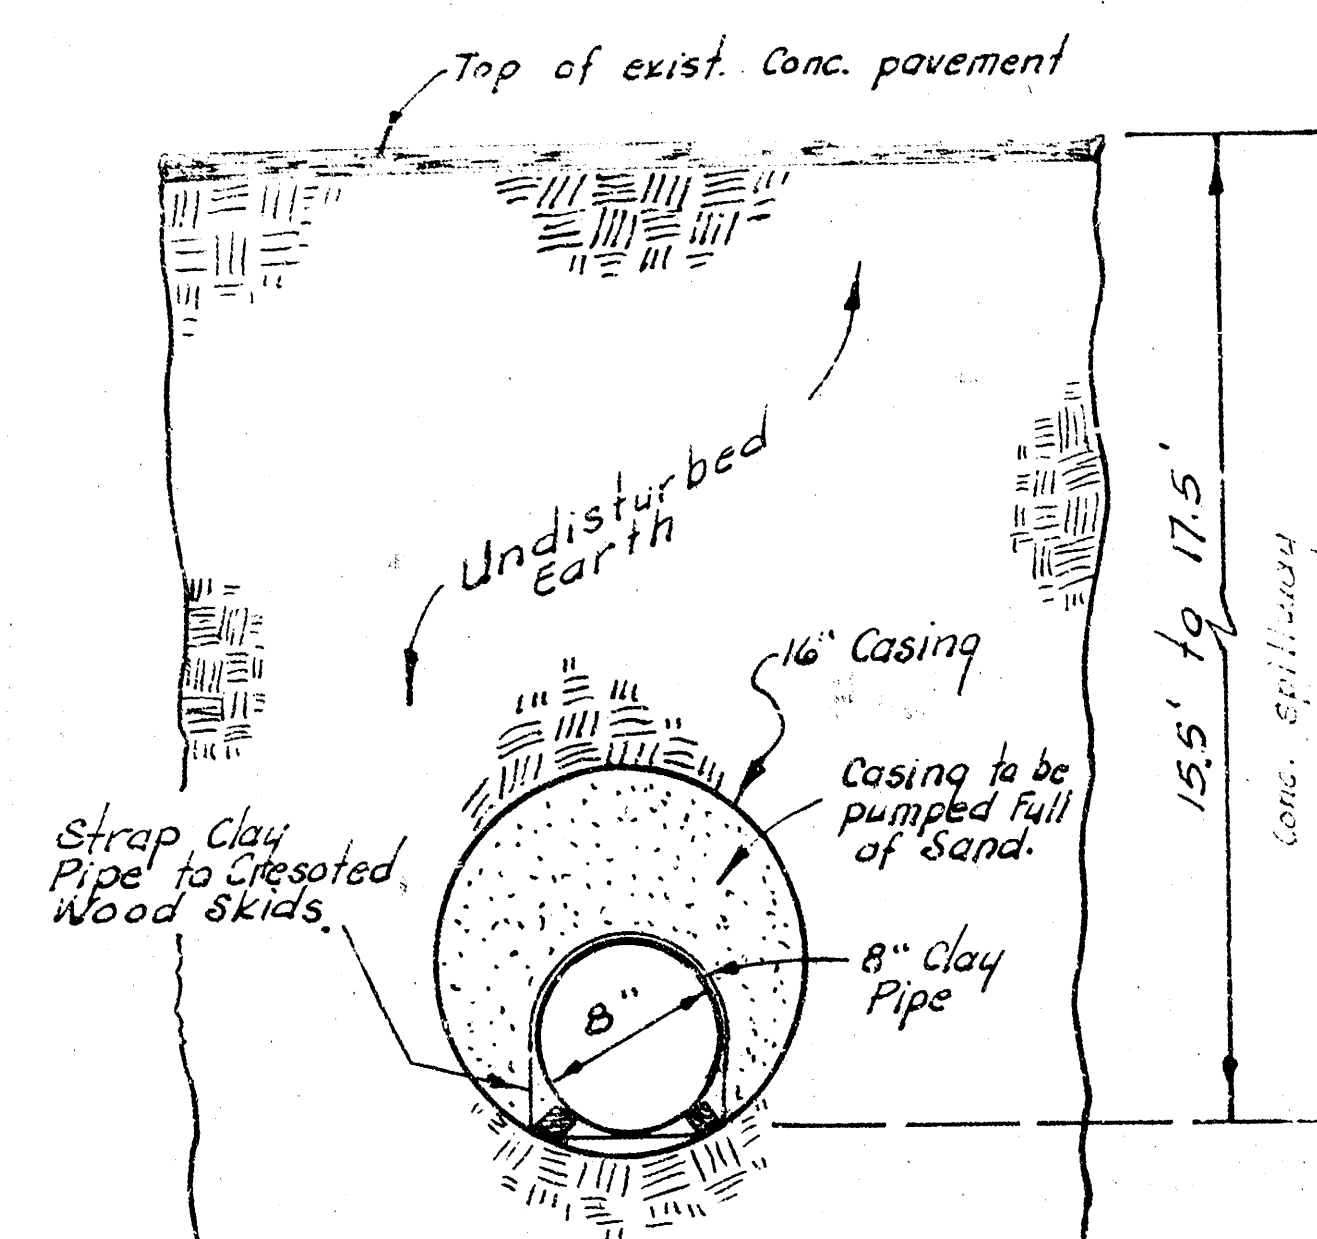


NOTE:
The bid price of Lin. ft.
of casing shall include
the coupling, wood skids,
straps and the pumping
of sand.

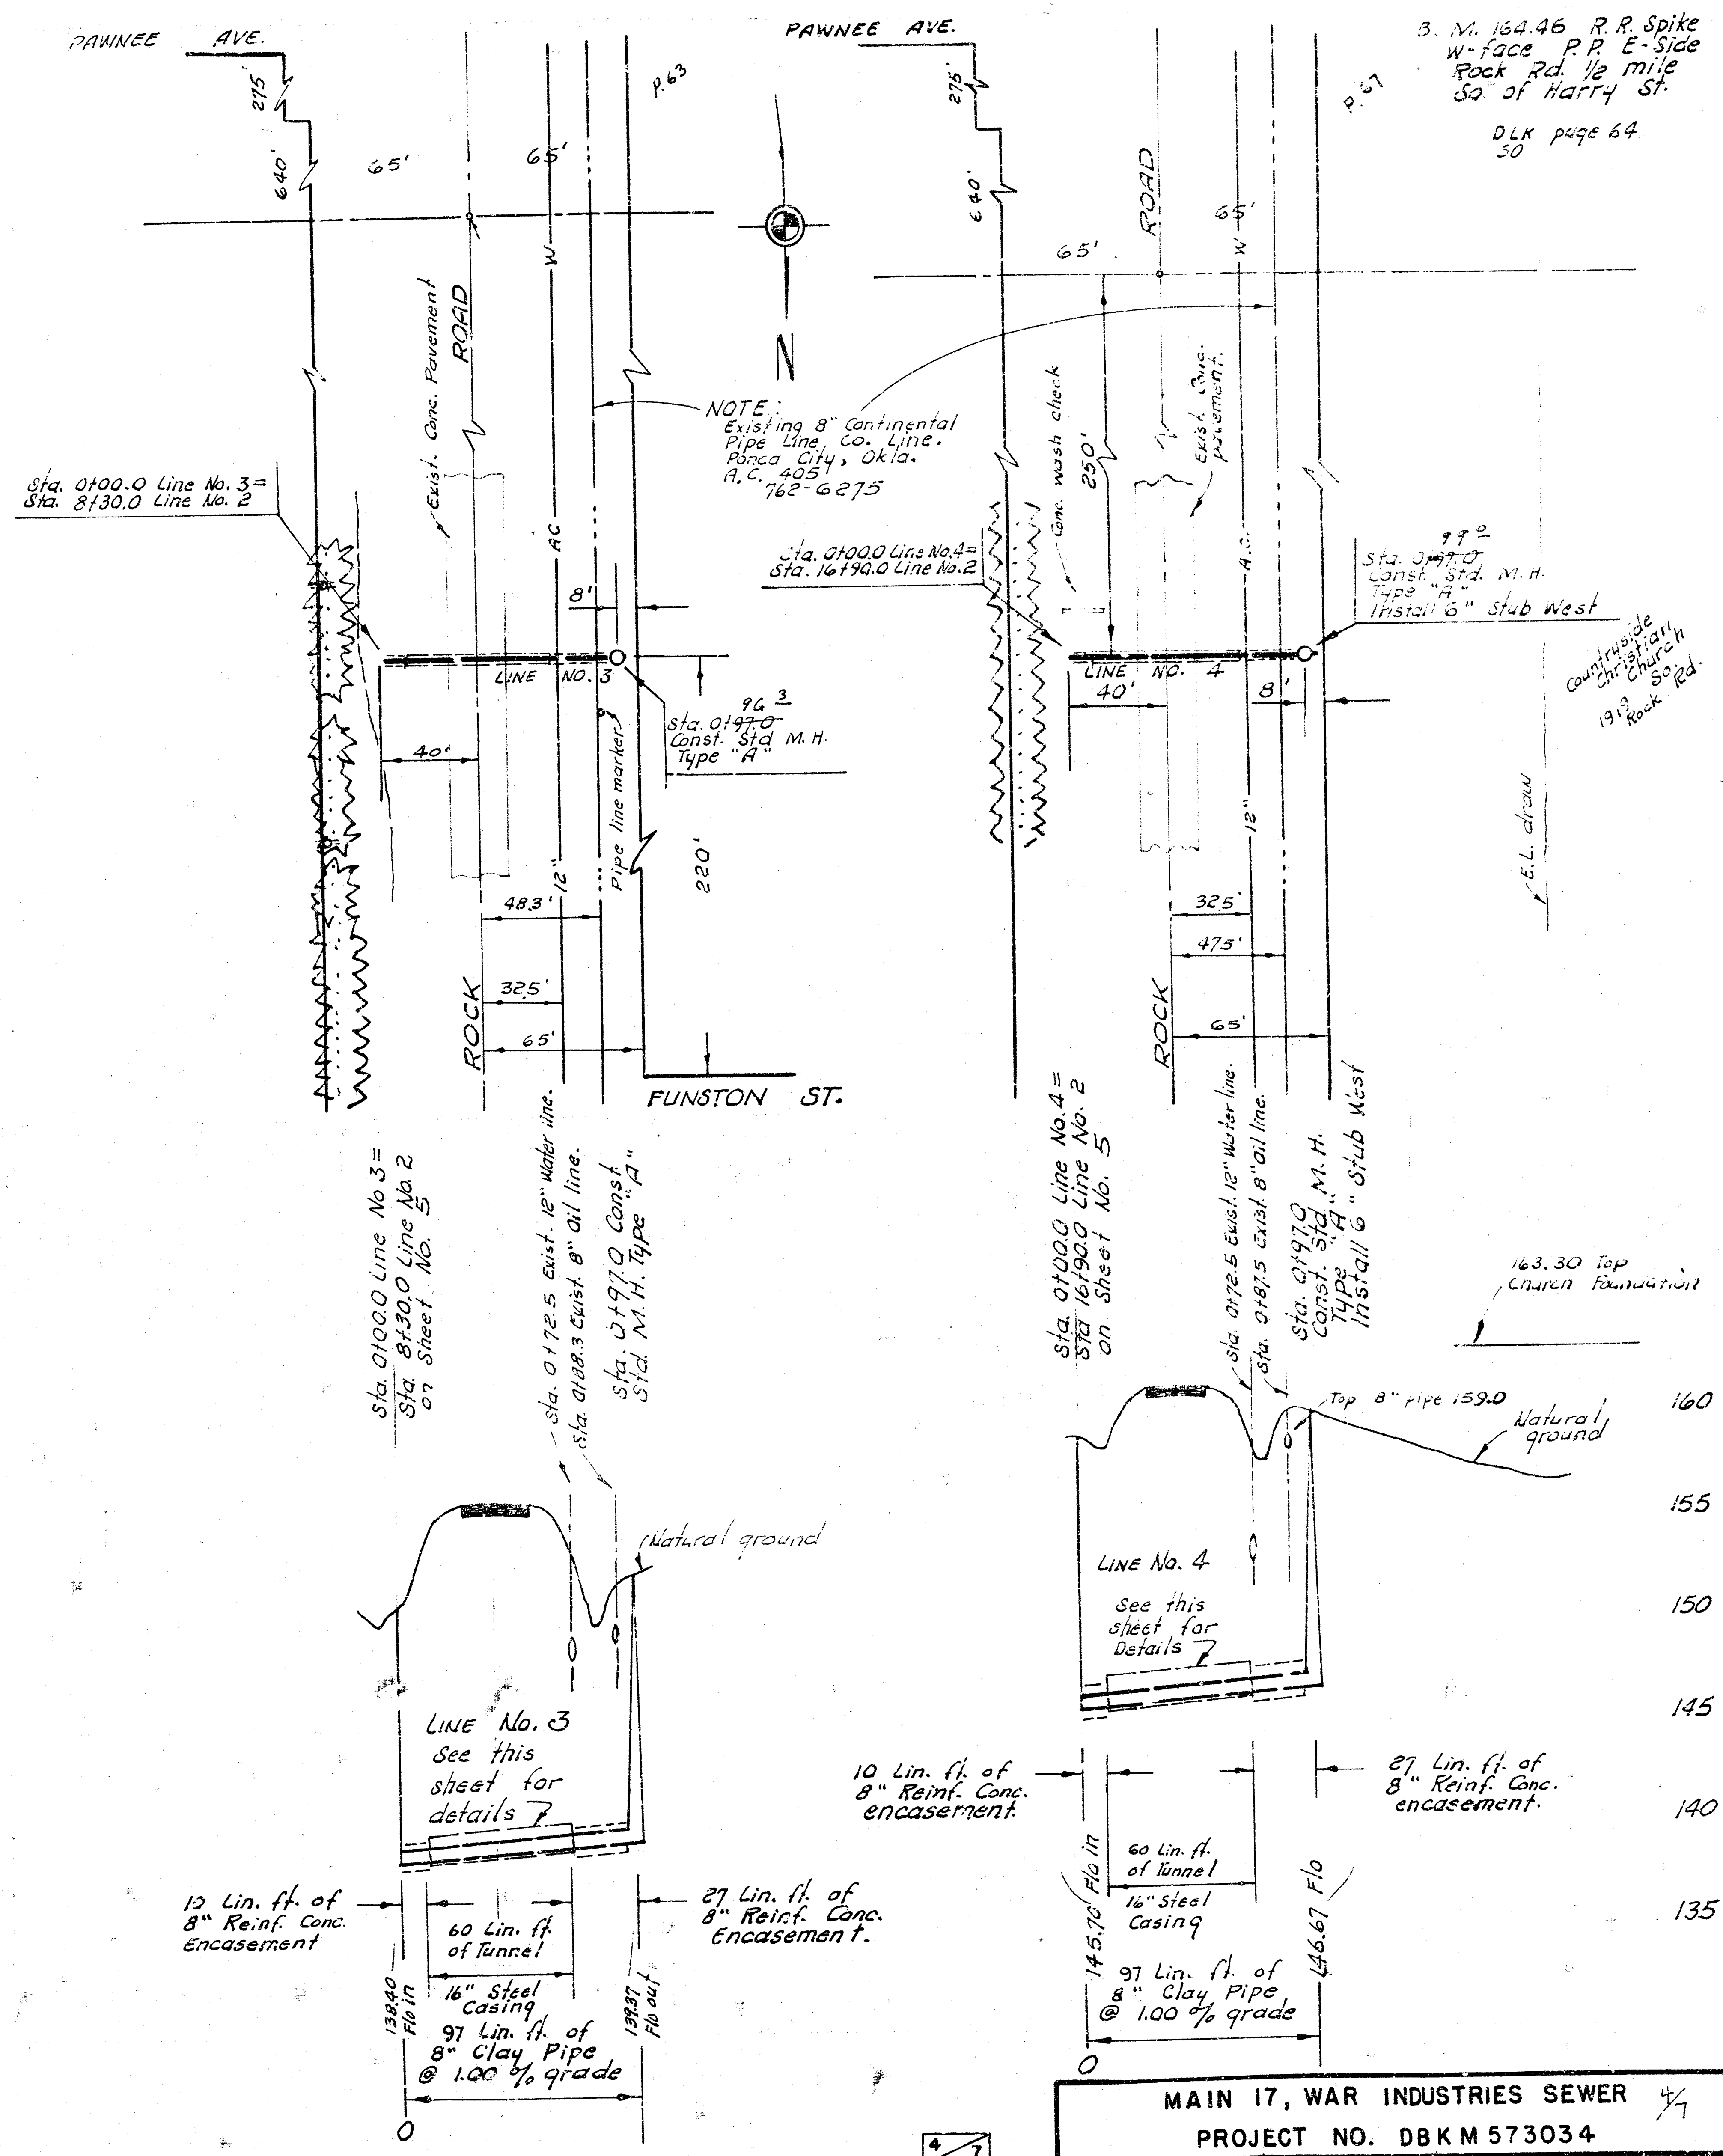
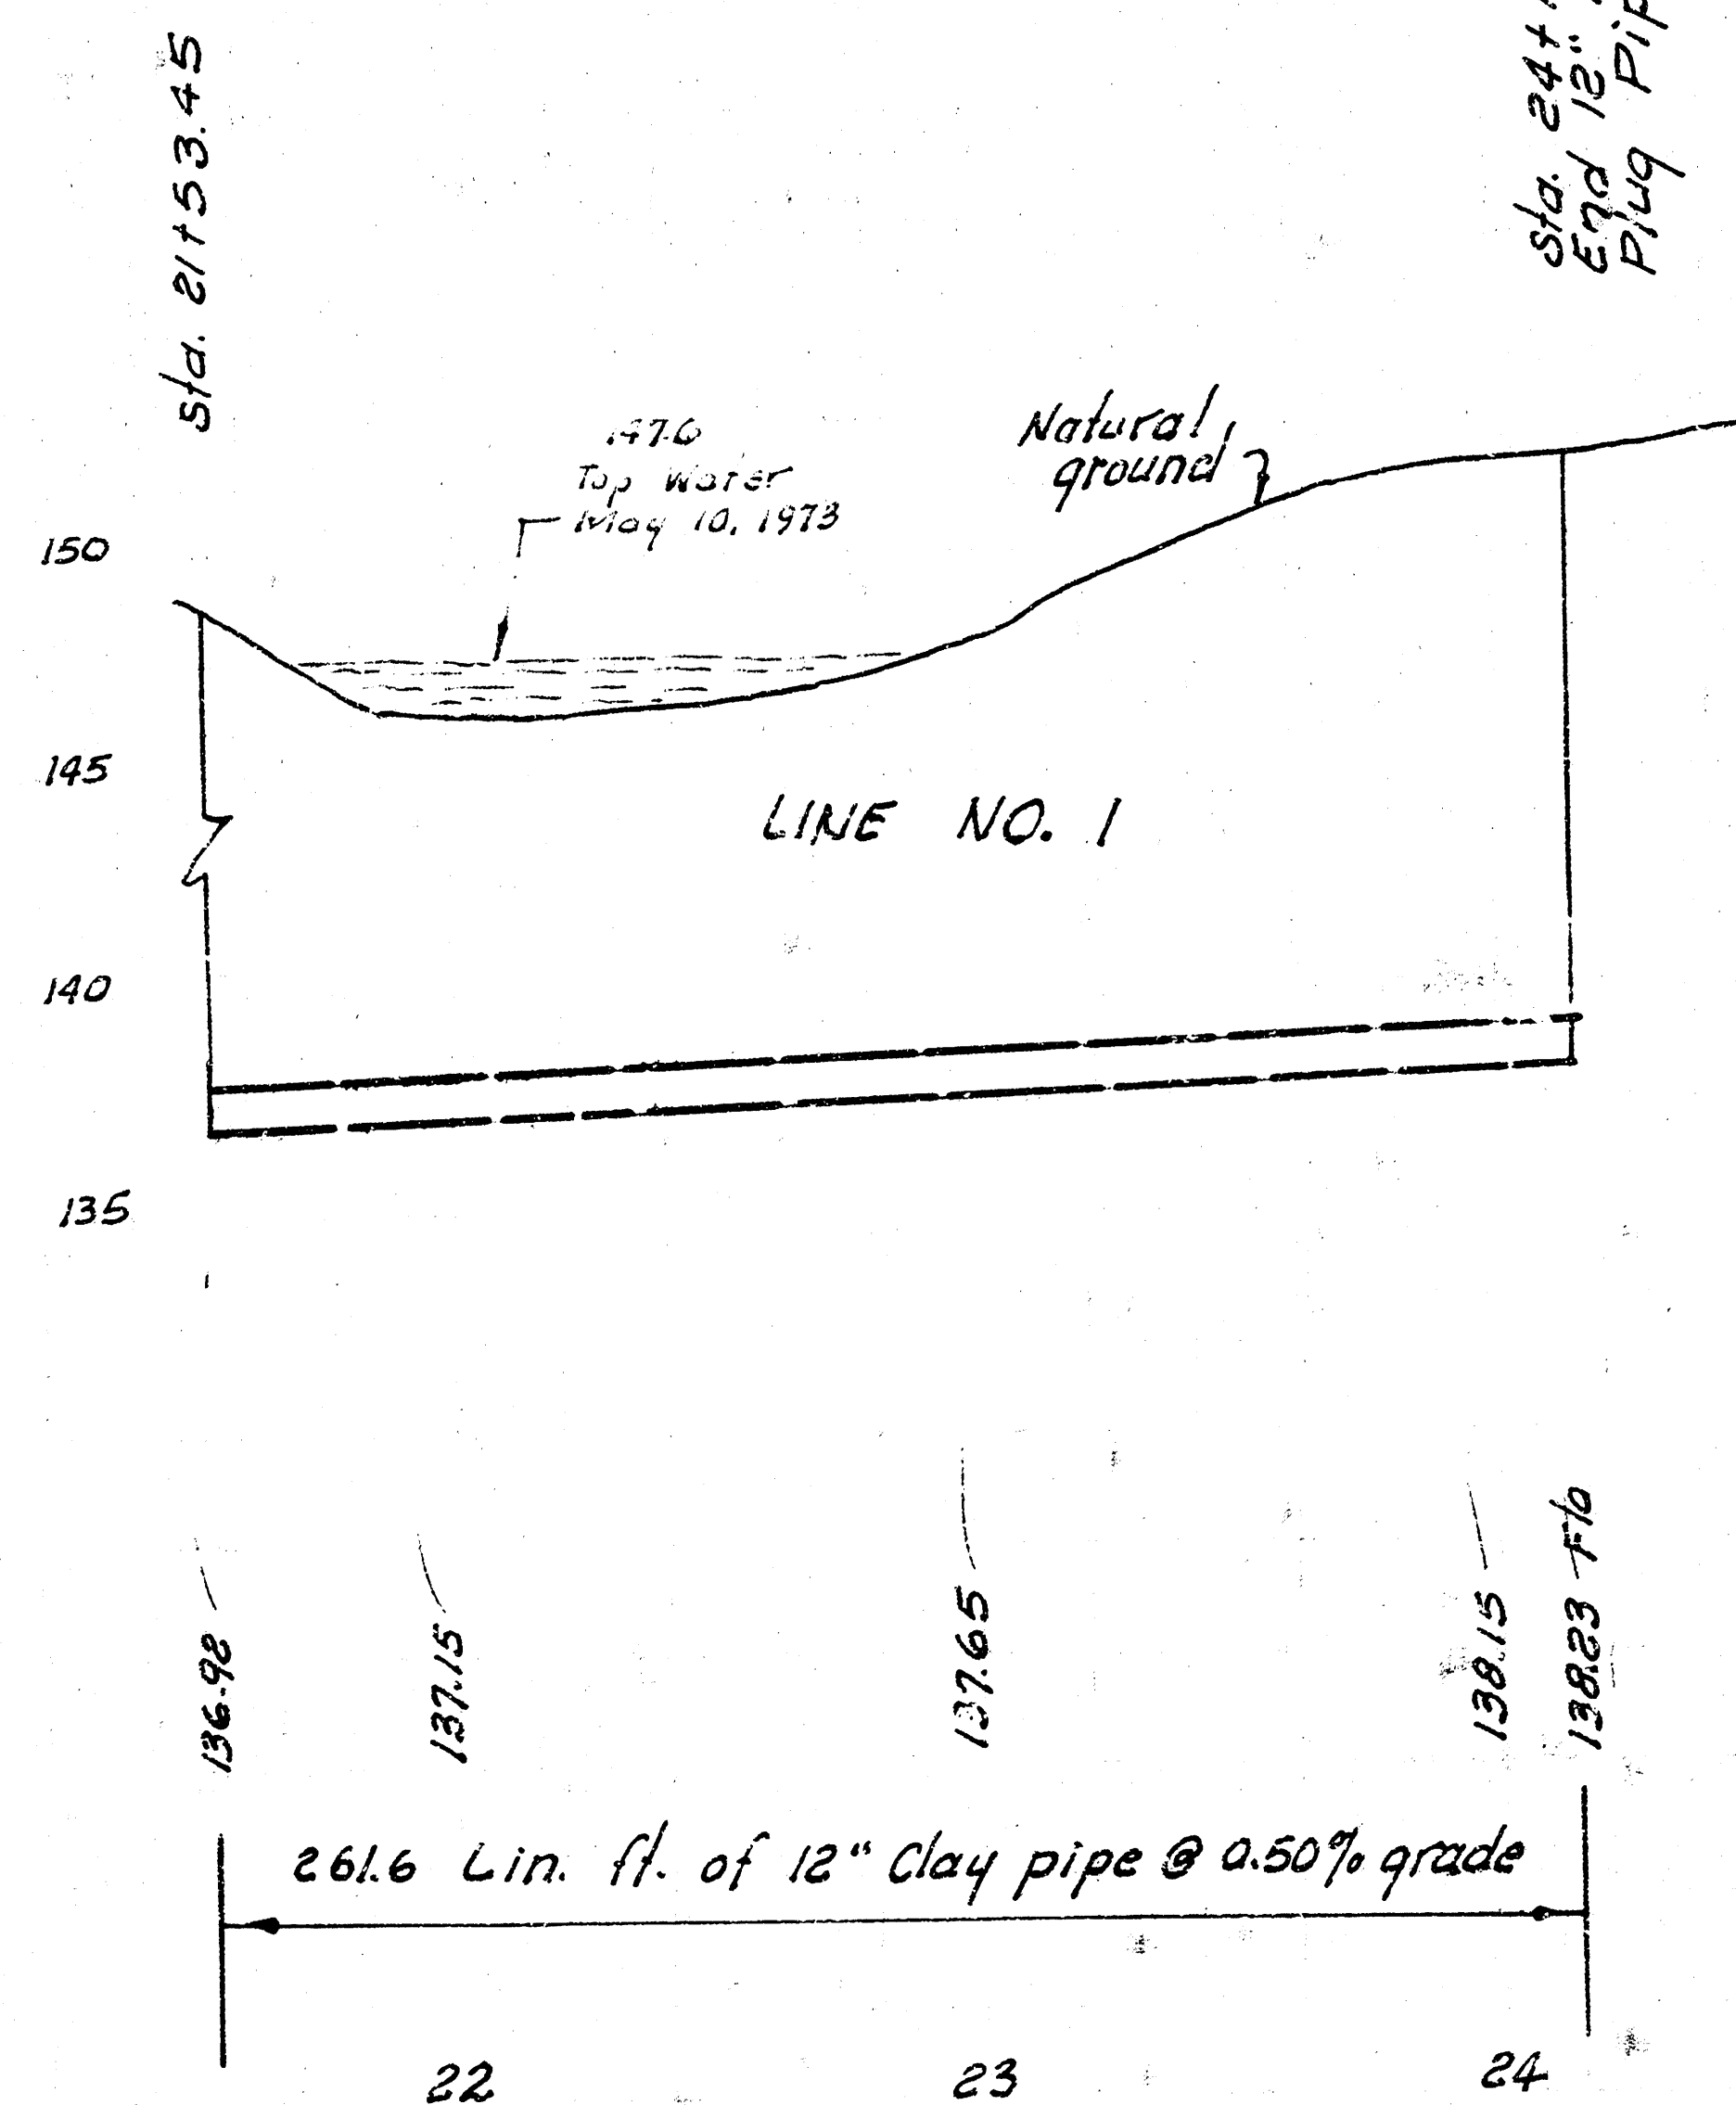


B.M. 154.49 R.R. Spk. W-face P.P. E.L. Rock Rd.
S.L. Funston extended.

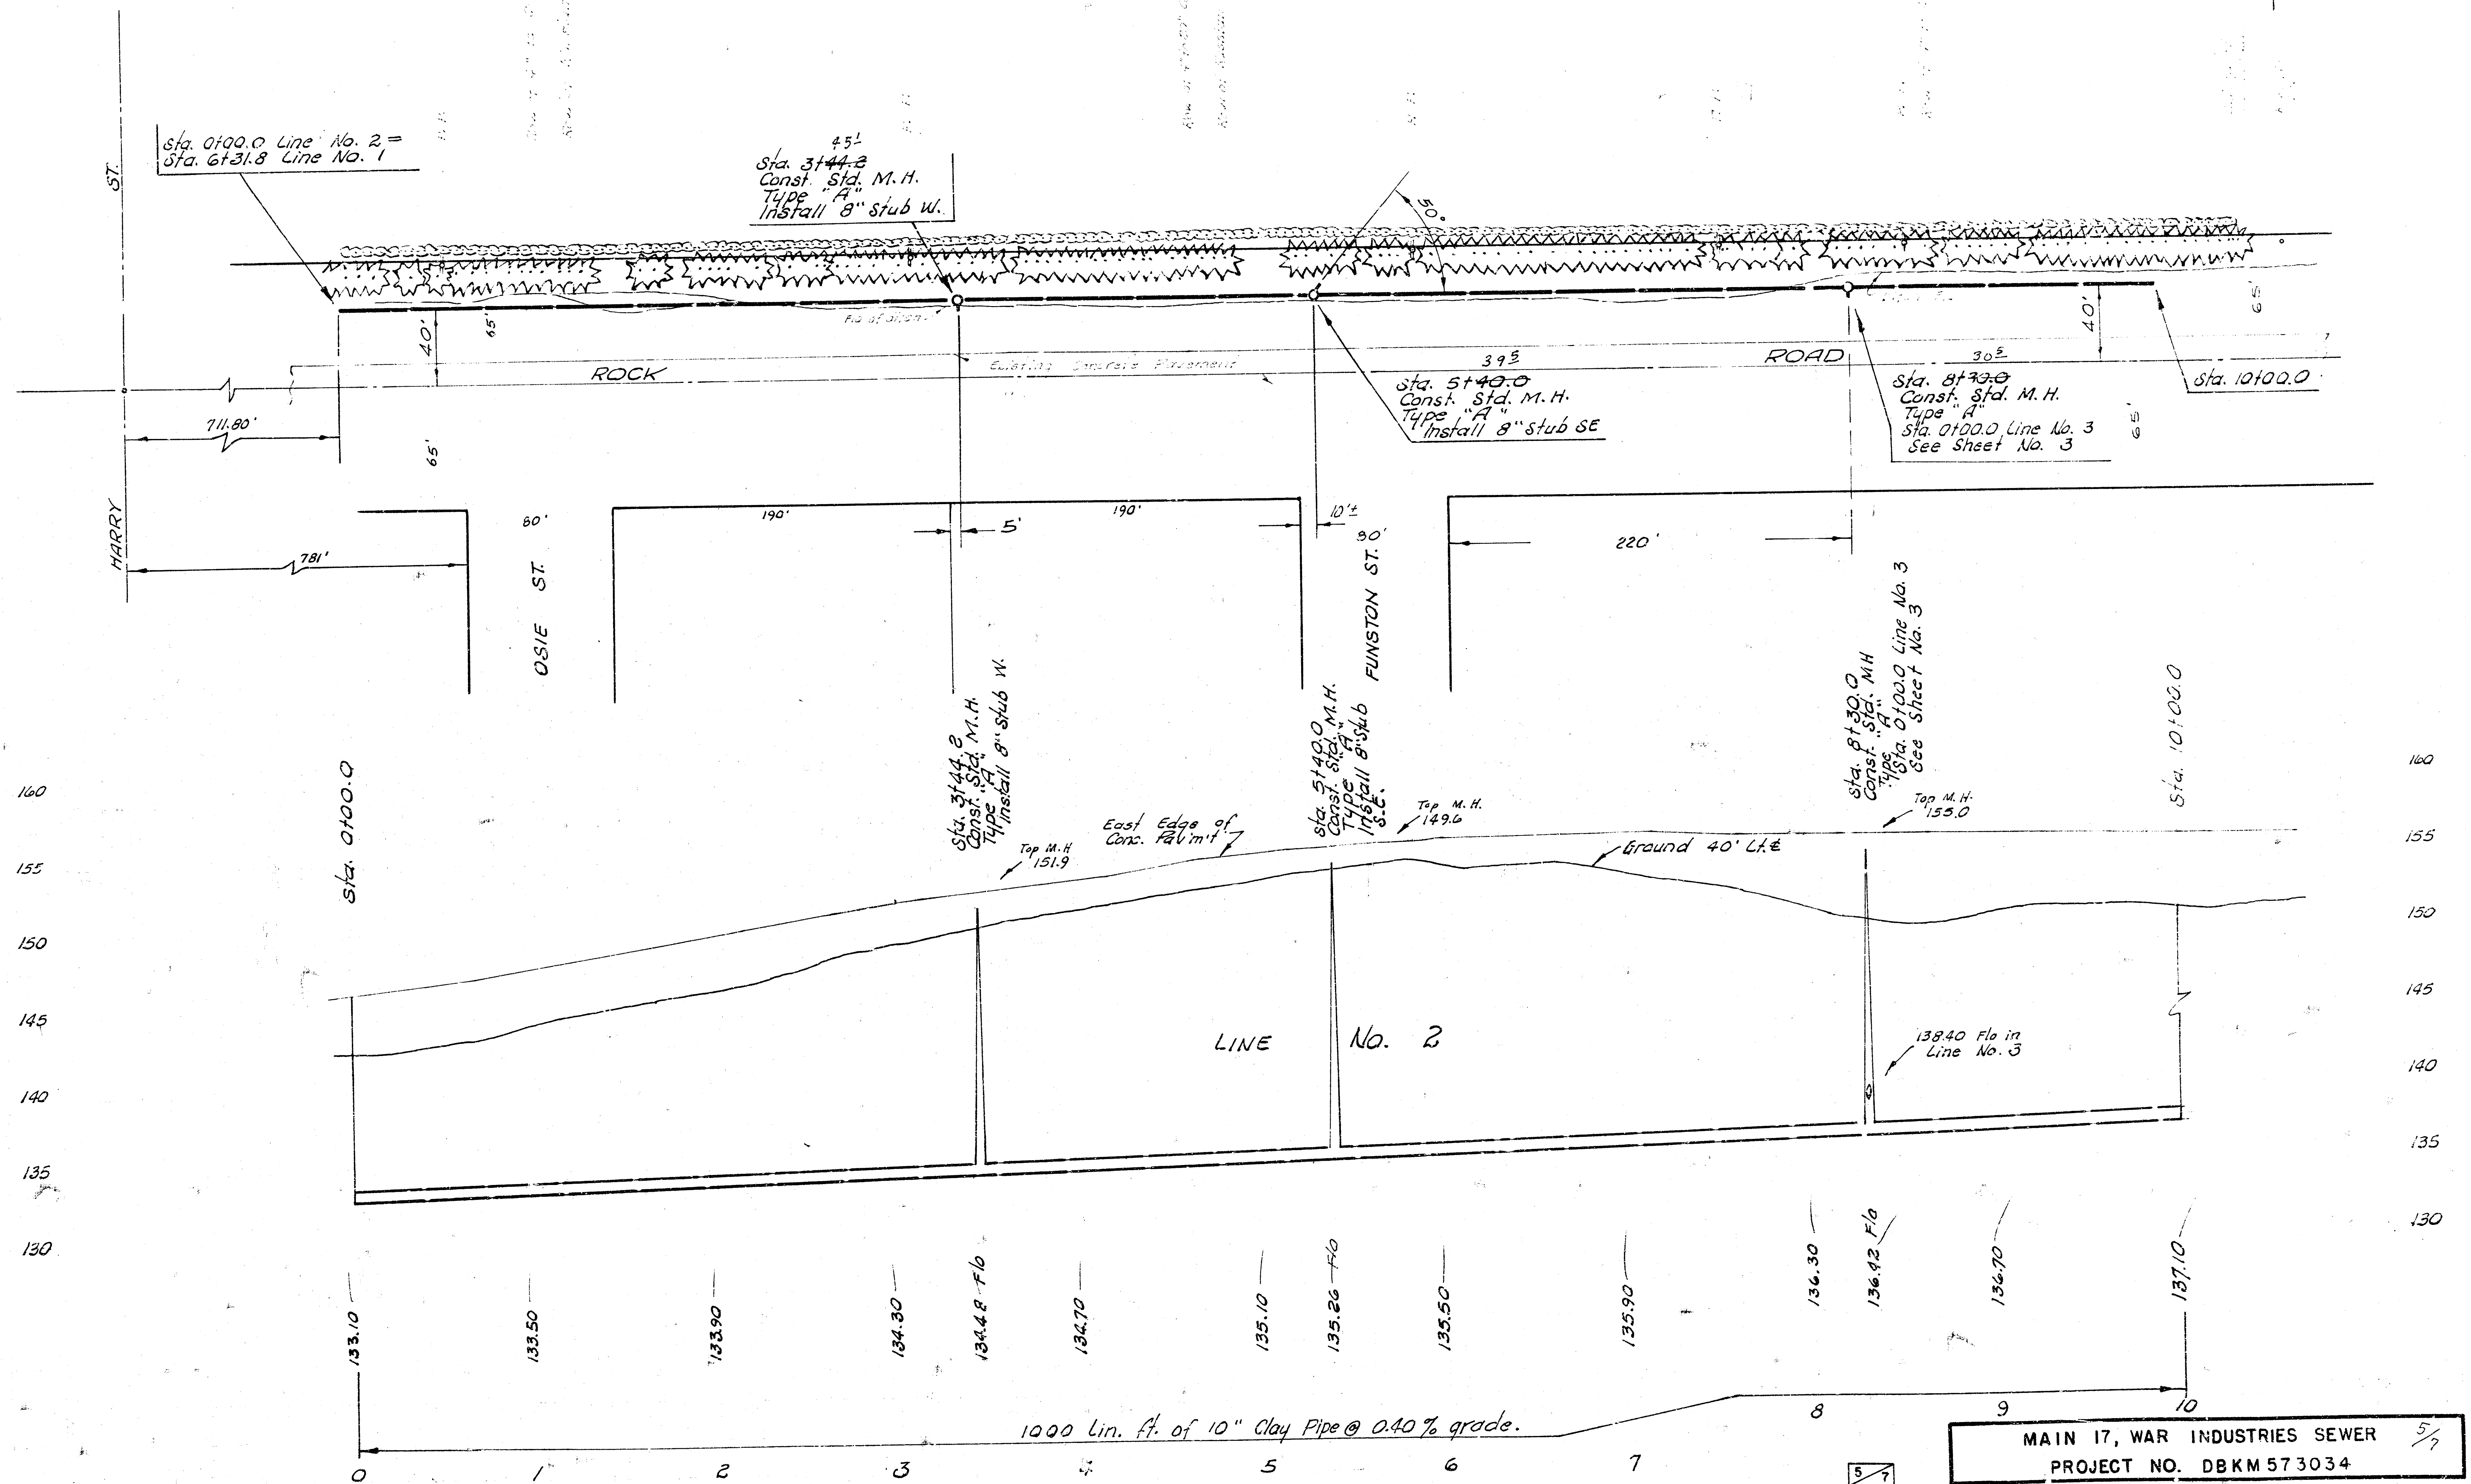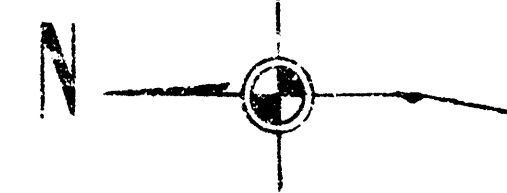

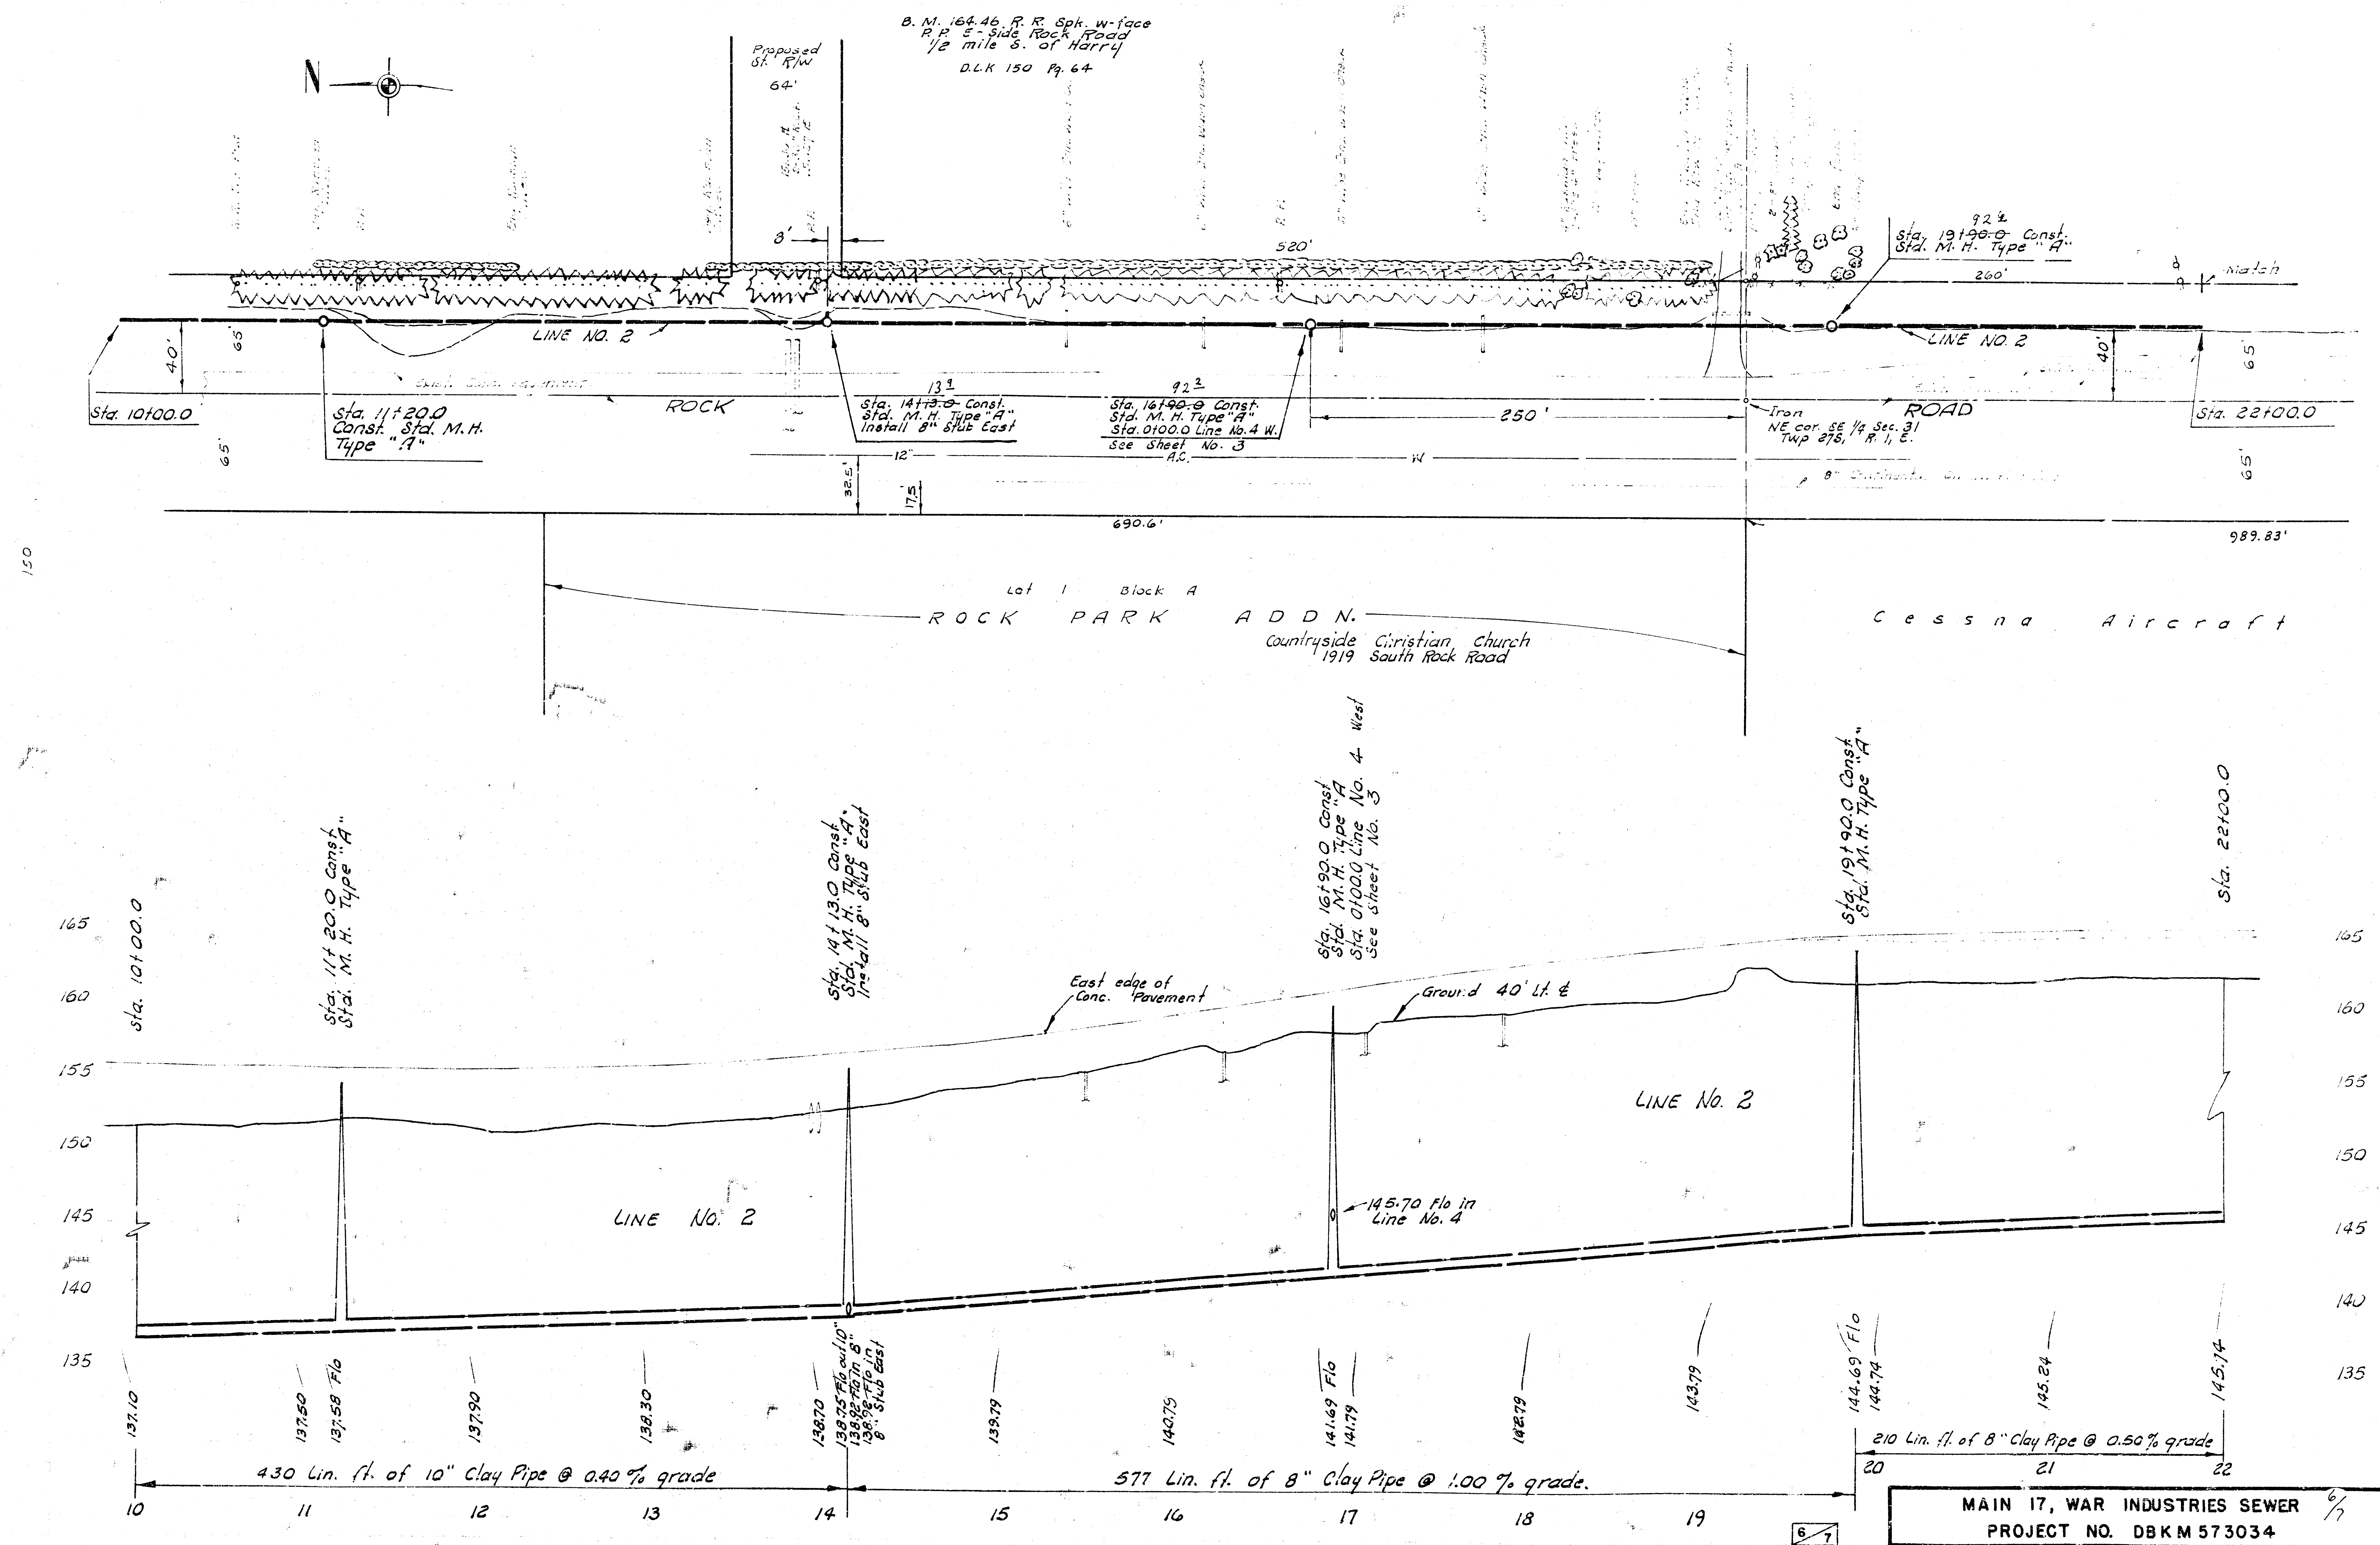

B. M. 165.71 "±" on cfr. Pawnee West
on cfr. Rock Road N-S

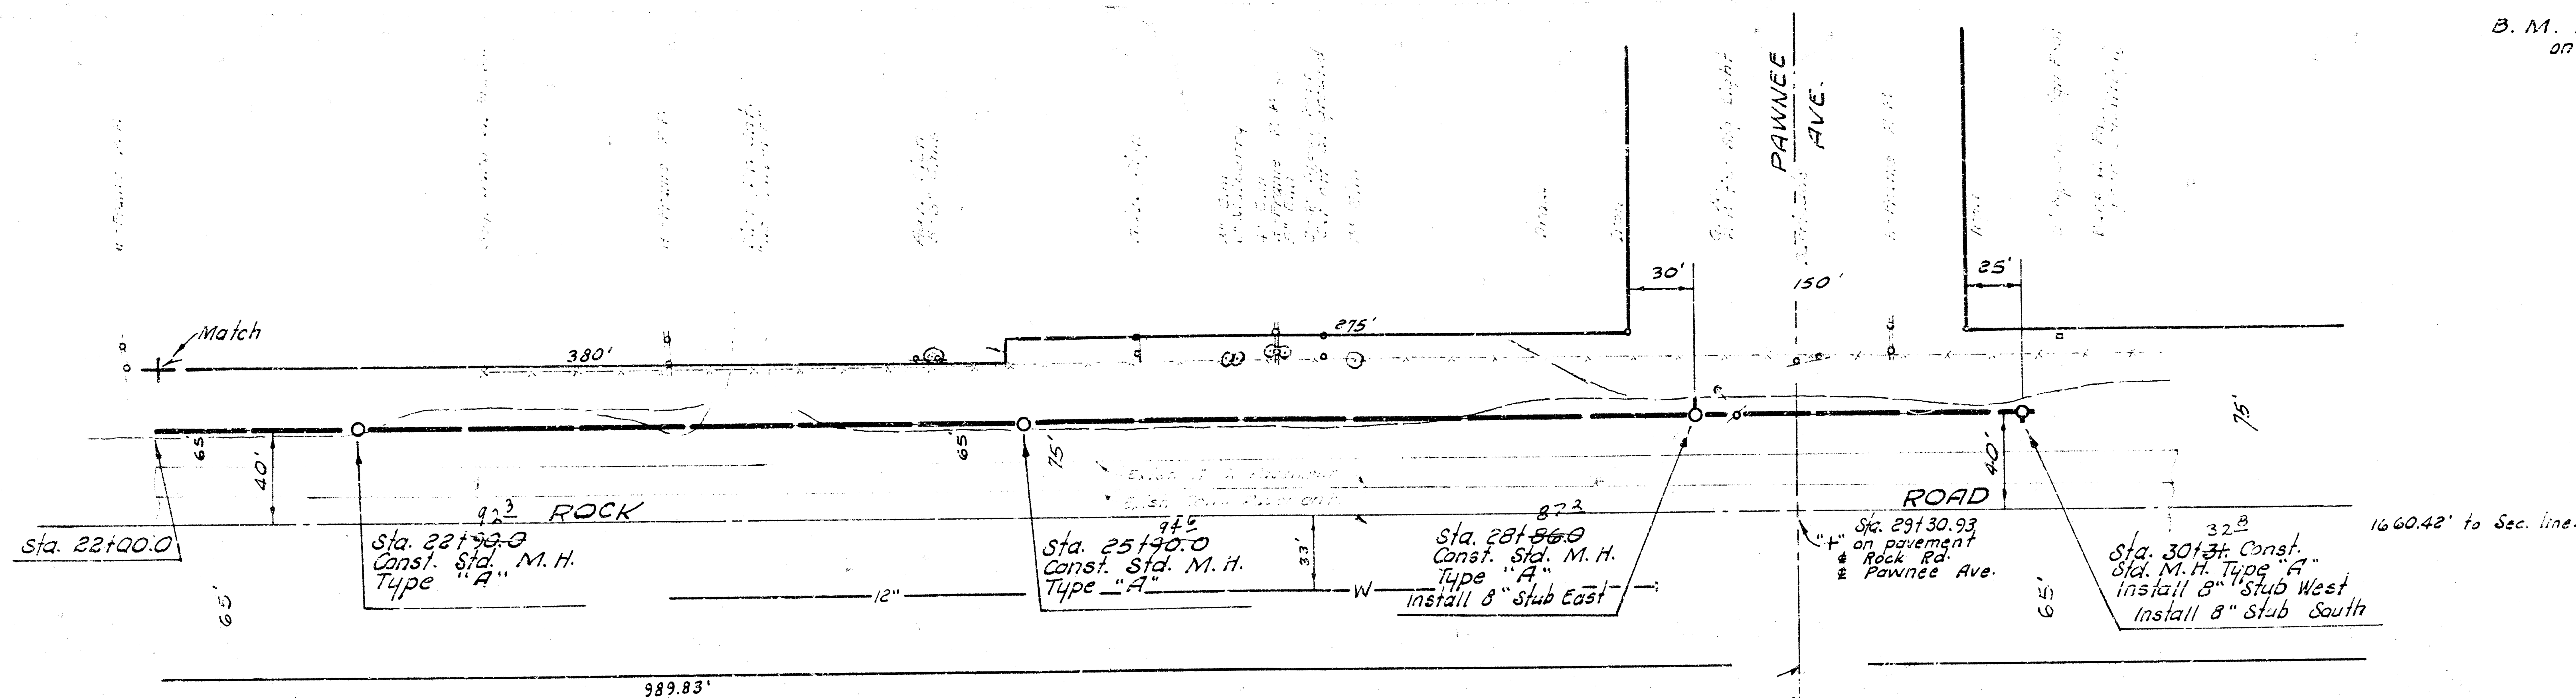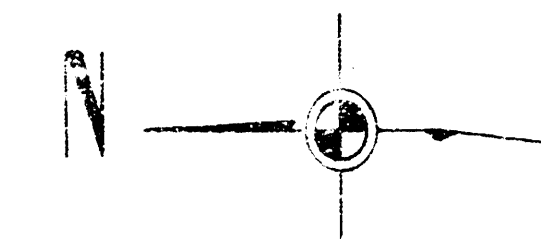

C e s s n a A i r c r a f t

