

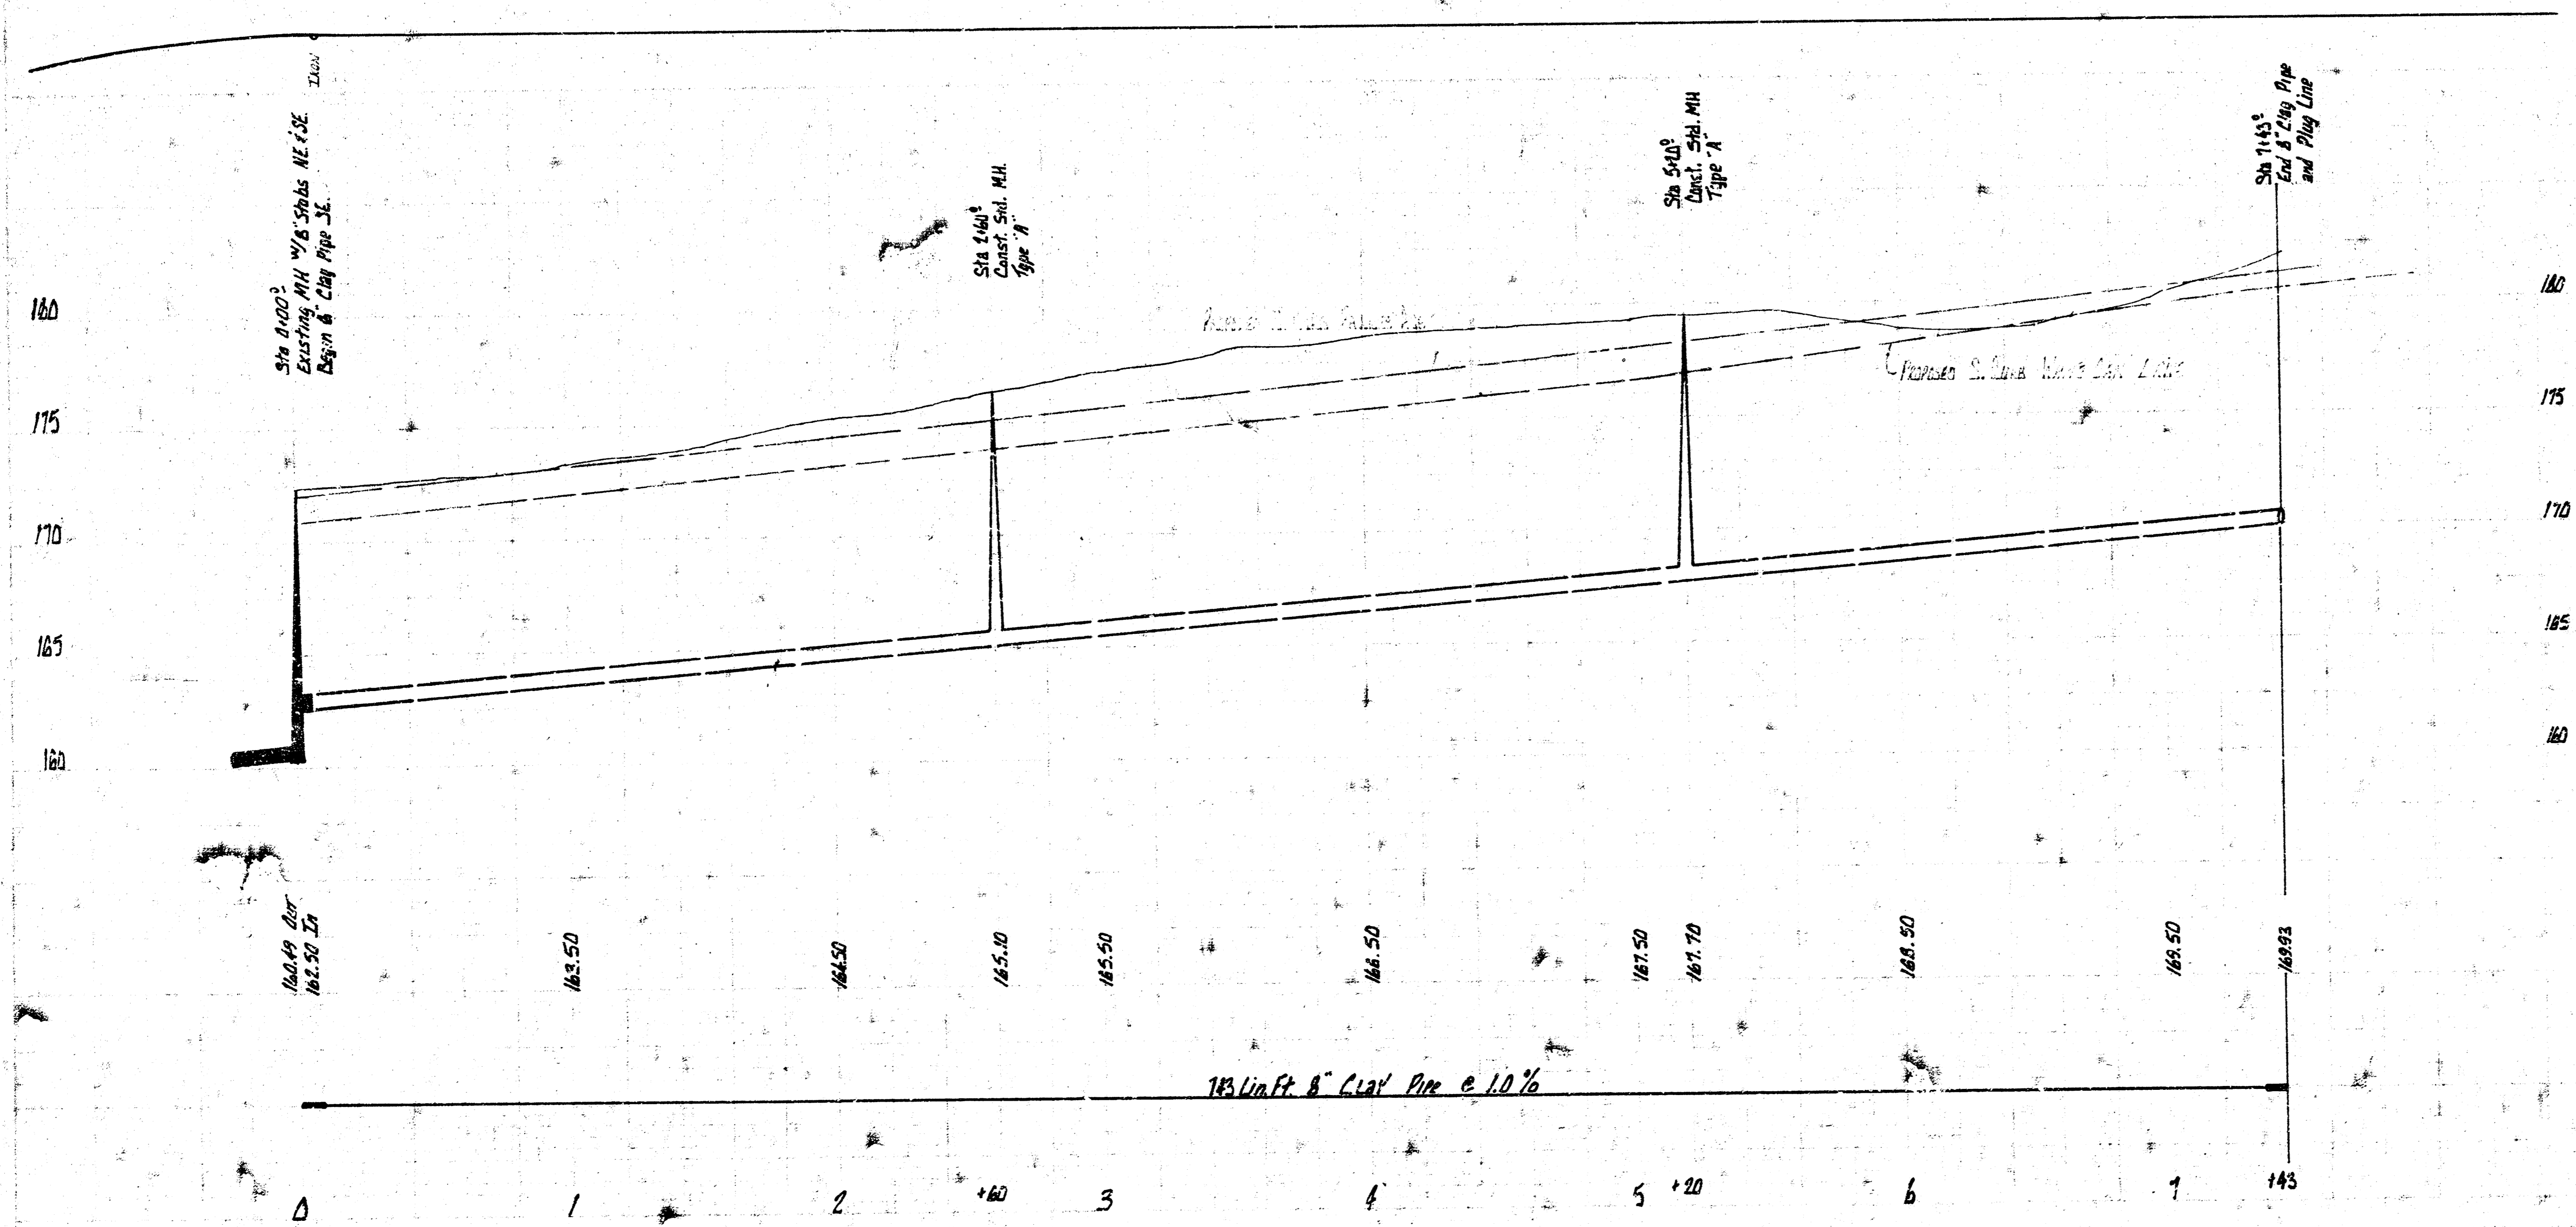


B.M. 165.71 on CENTER LINE OF ROCK RD & CENTER OF PAWNEE WEST
 SCALE: PLAN 1"=40' PROFILE 1"=40' HOR. 1"=5' VERT.

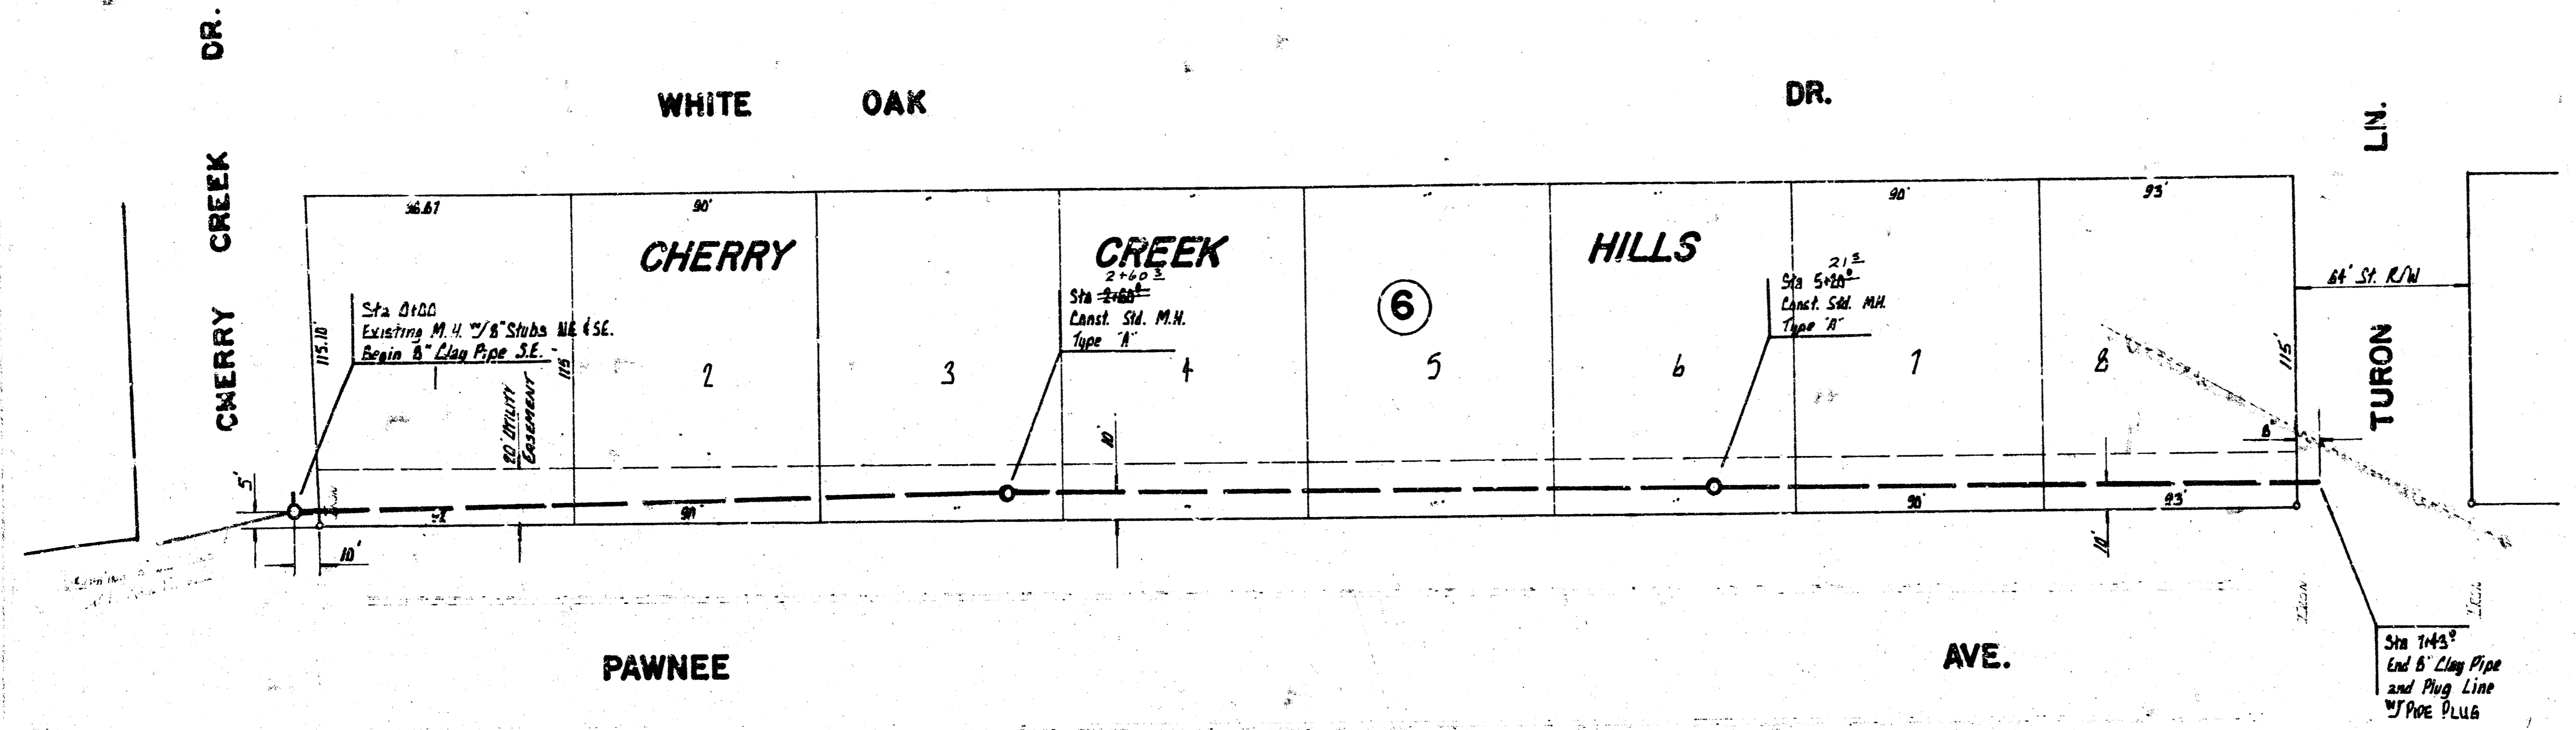

NOTE: CONSTRUCTION OF THIS PROJECT SHALL BE COORDINATED WITH MAIN SEWER CONSTRUCTION ALONG THE EAST SIDE OF ROCK ROAD.

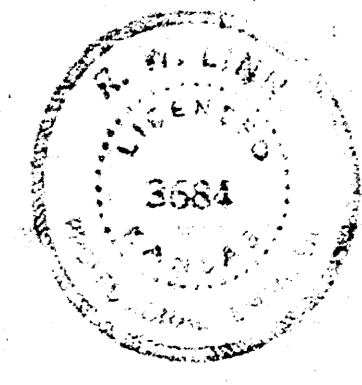

As Built Final Plans 280-Y
Lot 2, Main 17, W.I.S.
 R. W. LINN City Engineer
 City of Wichita, Kansas
 Date: July 1973
 Project No. DBKL573C13

115 Engr

