
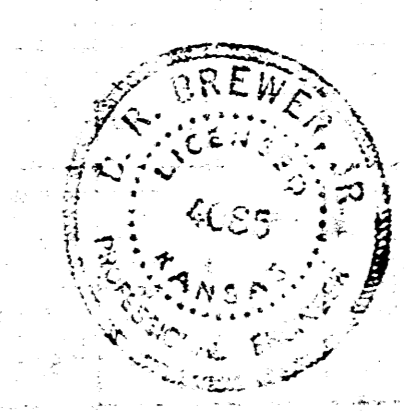


NOTE: CONSTRUCTION OF THIS PROJECT SHALL BE COORDINATED WITH MAIN SEWER CONSTRUCTION ALONG THE EAST SIDE OF ROCK ROAD.

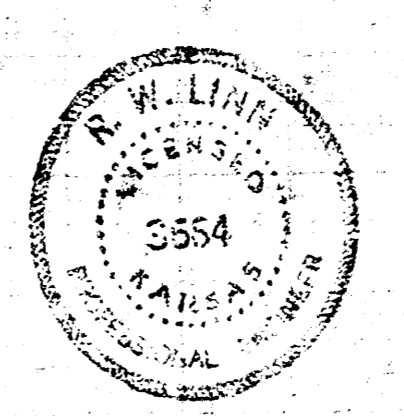

As Built Final Plans 280-Y
Lat 3, Main 17, W1.S.
R. W. LINN CITY ENGINEER
CITY OF WICHITA, KANSAS
 DATE: July 1973
 PROJECT NO. **DBKL573014**