




B. M. 171.69 R. R. Spk. N. face  
Osage Orange hedge SW cor.  
Cherry Creek Dr. & Lori Ln.

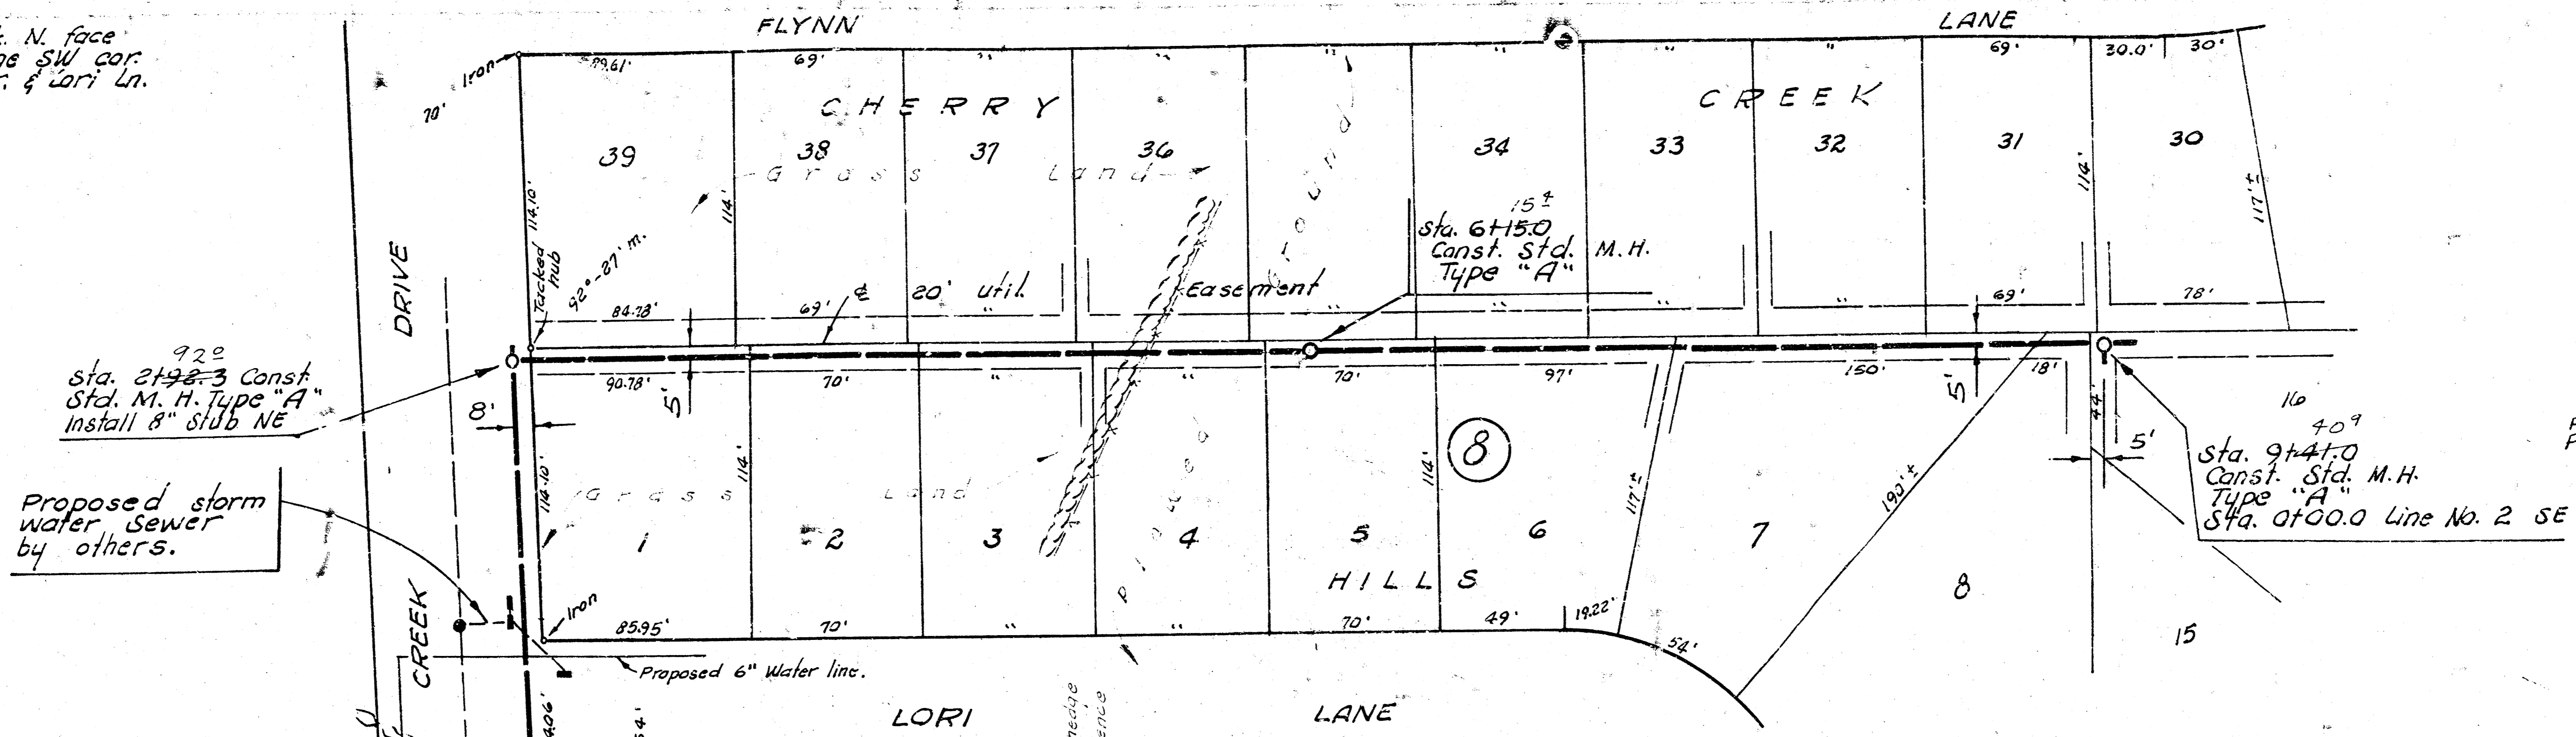

Plan Scale 1" = 40'  
Profile Scale 1" = 5' Vert.

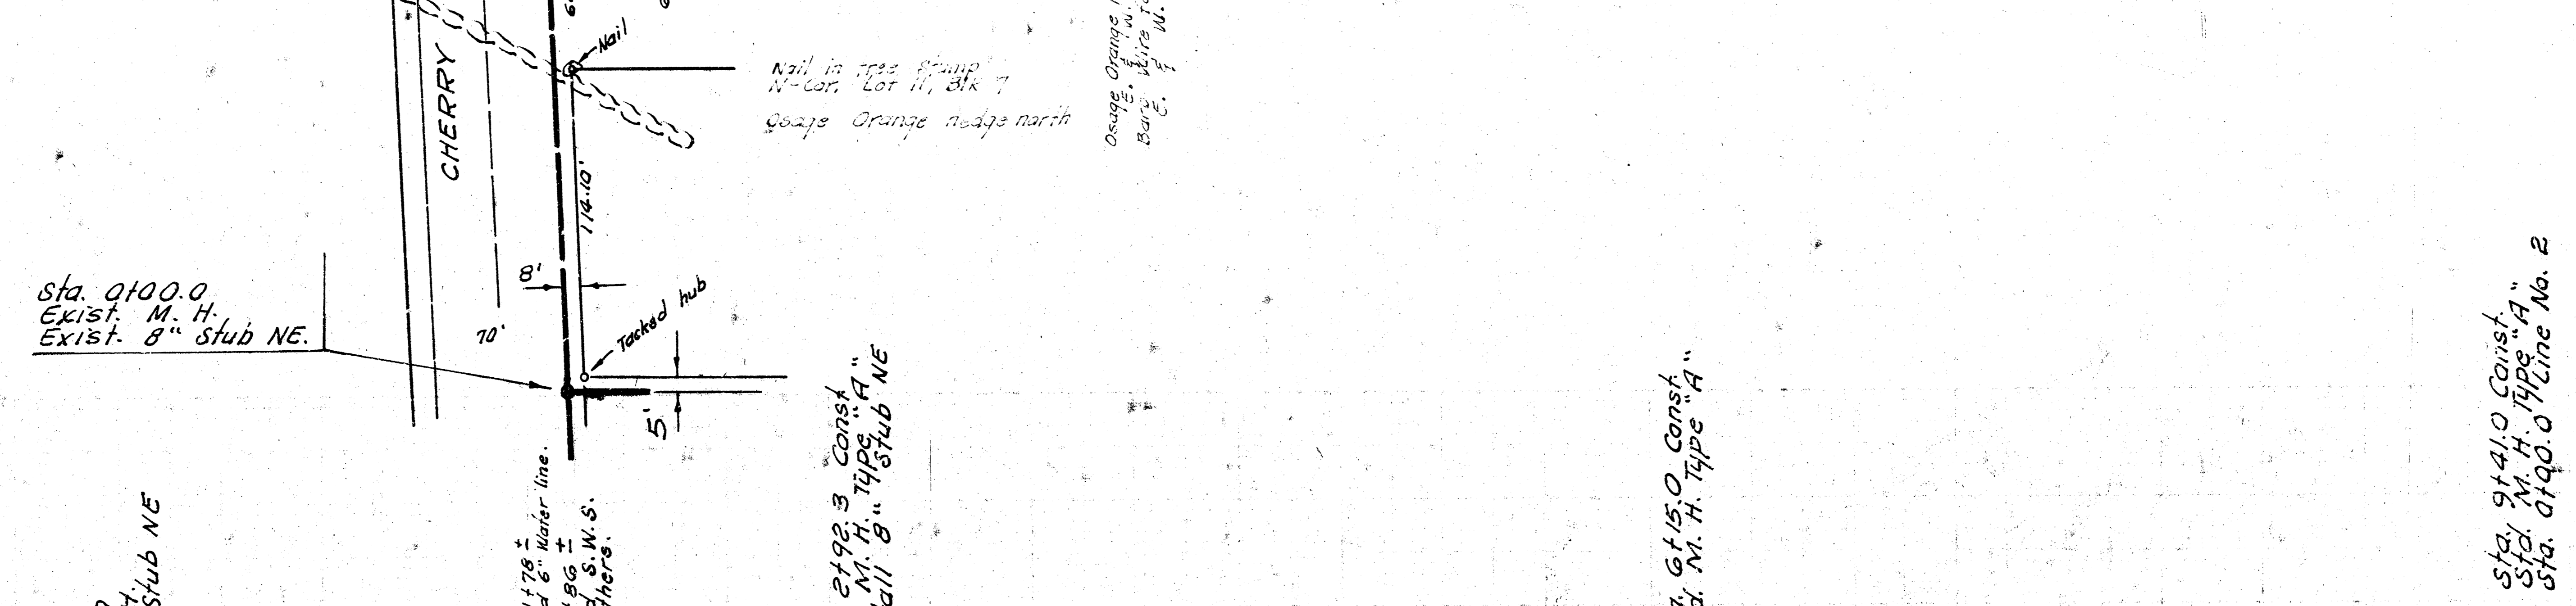



NOTE: CONSTRUCTION OF THIS PROJECT SHALL BE COORDINATED WITH MAIN SEWER CONSTRUCTION ALONG THE EAST SIDE OF ROCK ROAD.

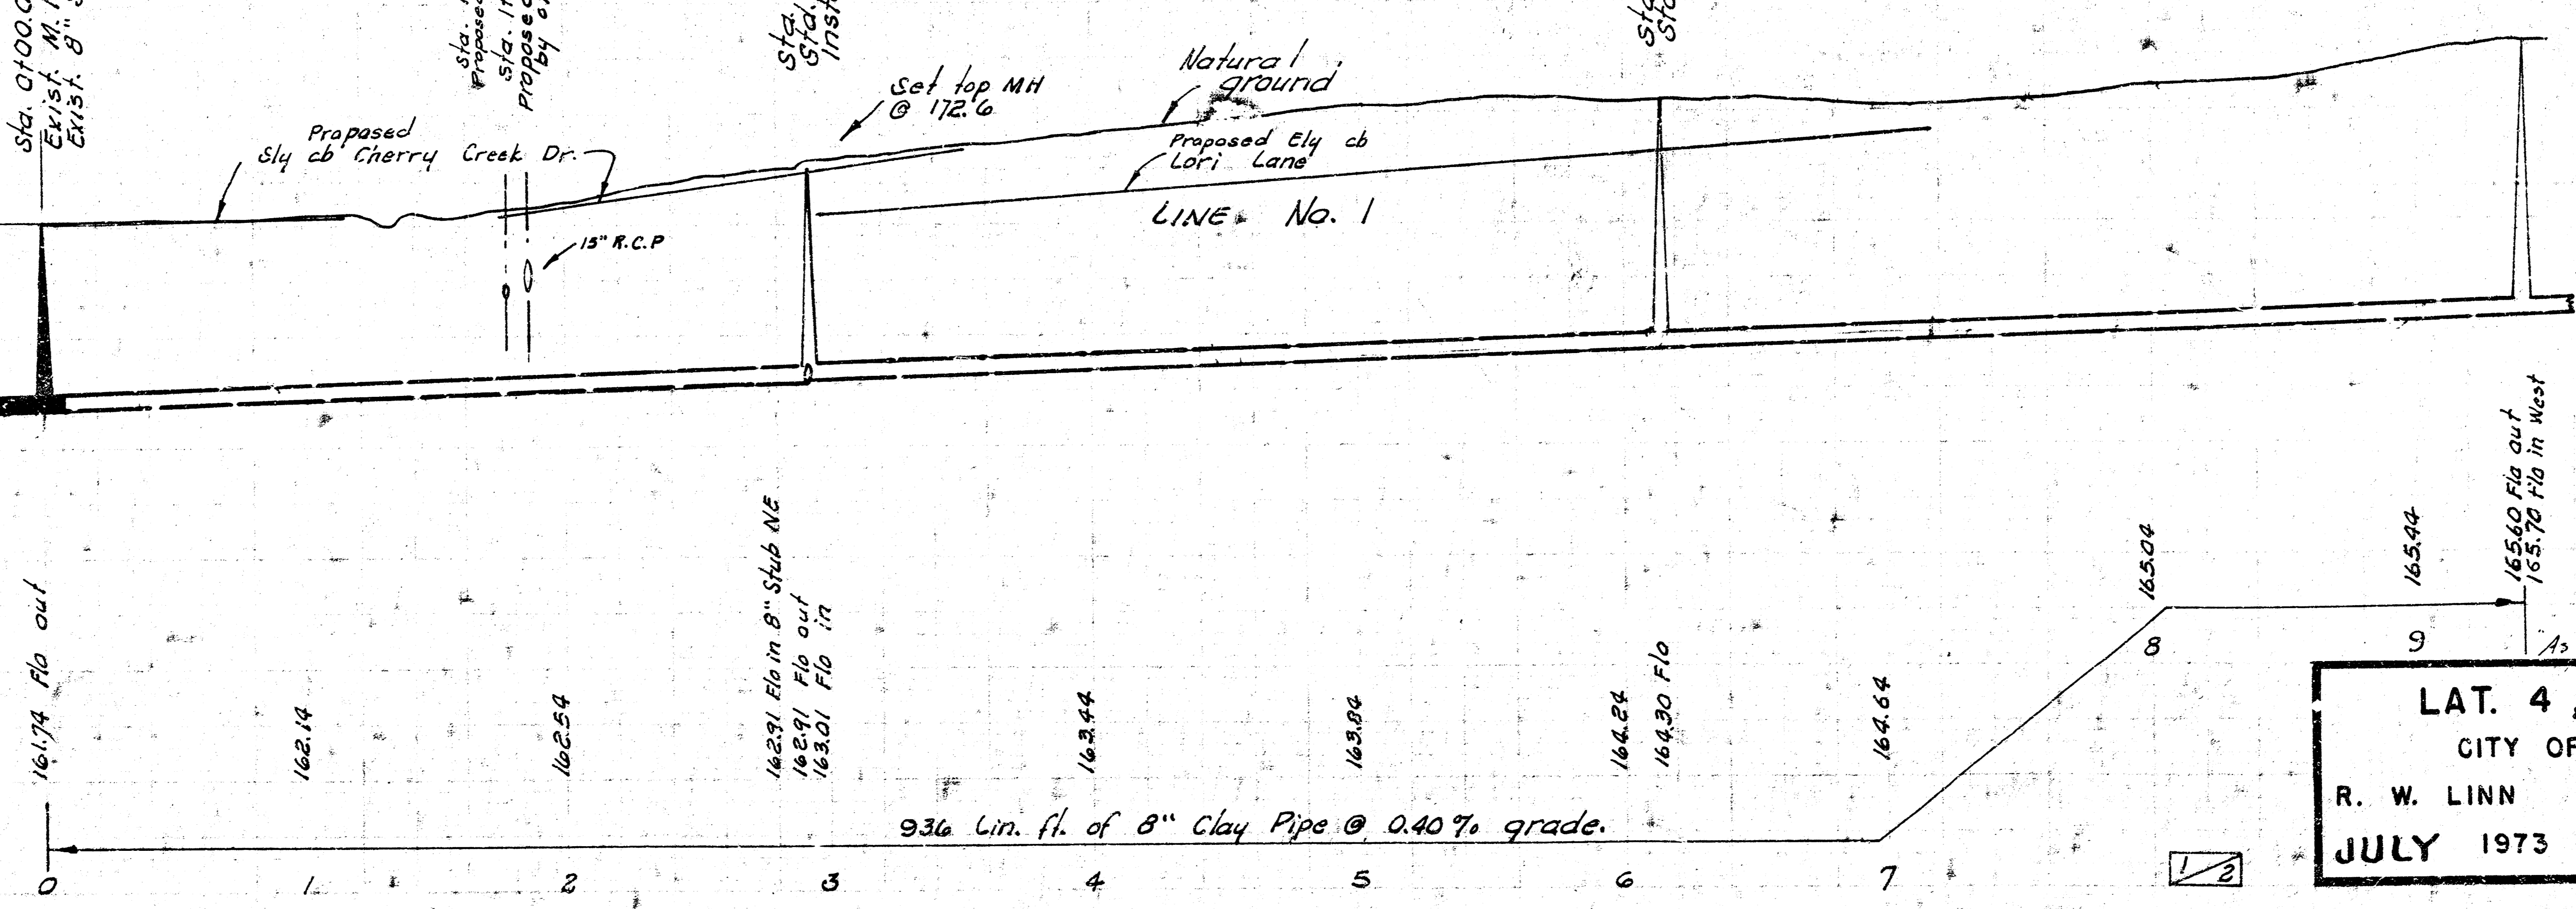

LAT. 4, MAIN 17, W. I. S.  
CITY OF WICHITA, KANSAS  
R. W. LINN — CITY ENGINEER  
JULY 1973 PROJECT NO. DBKL573015



As Built Final Map 280.9

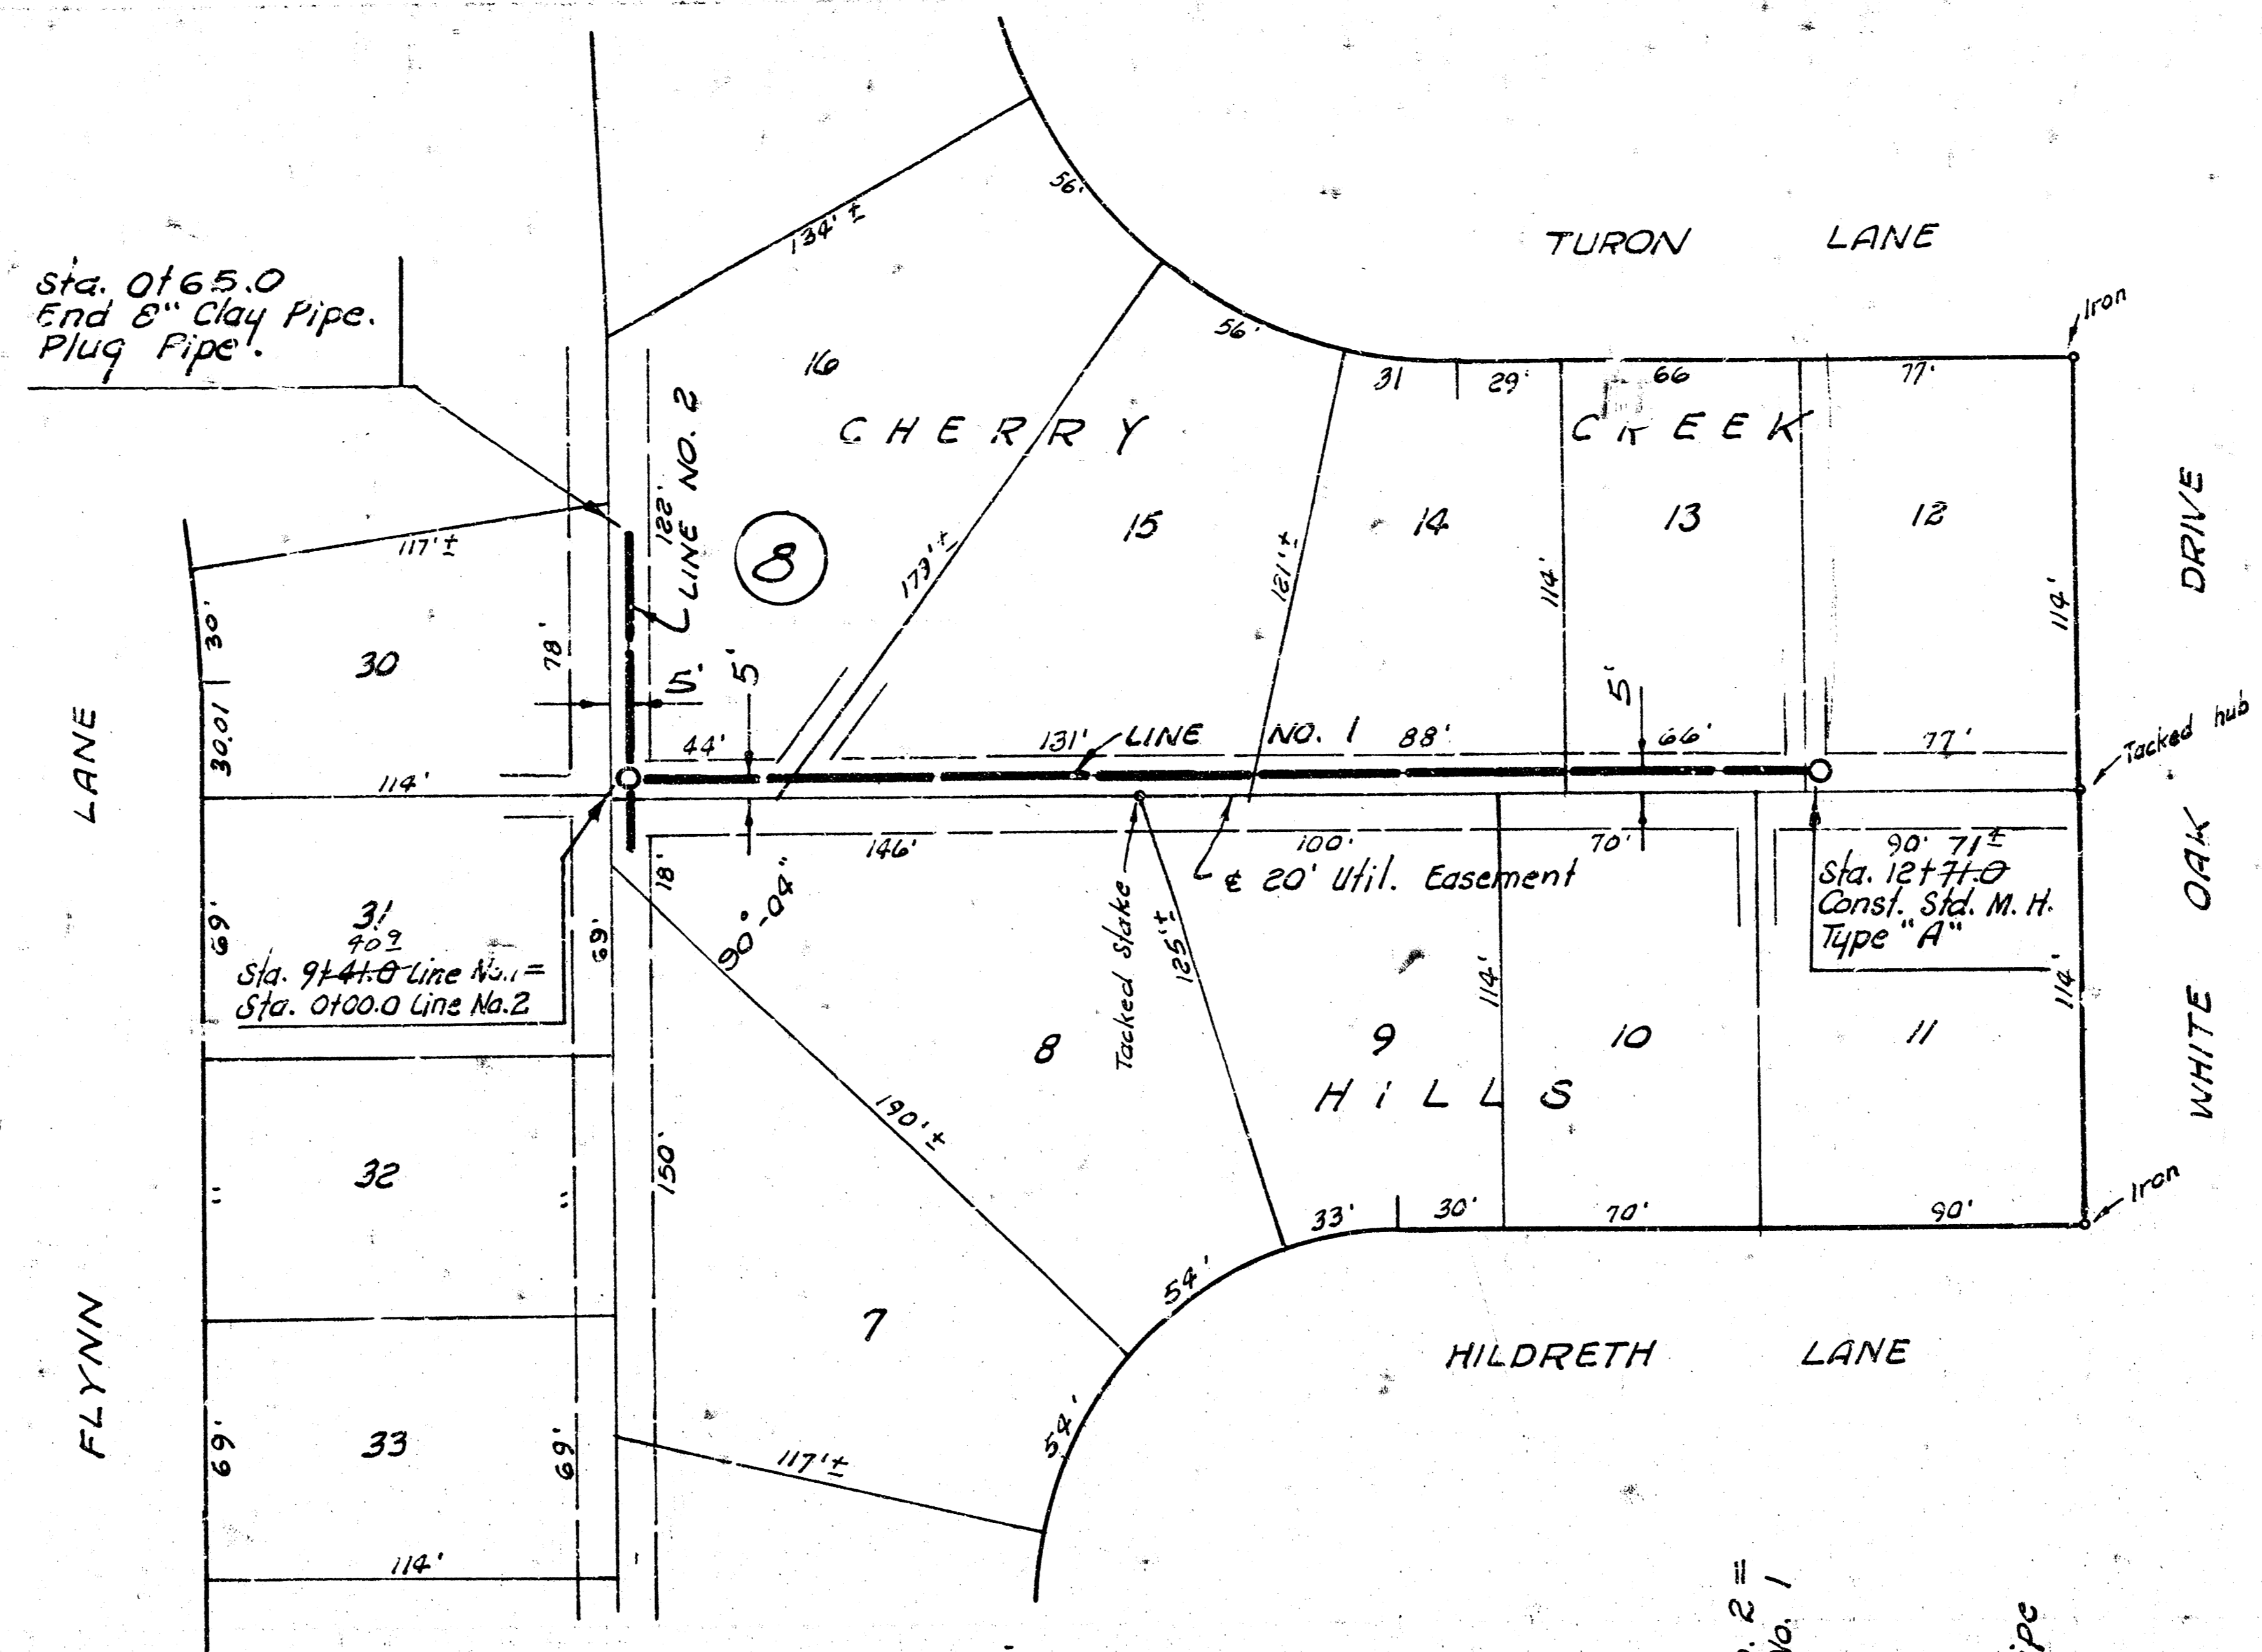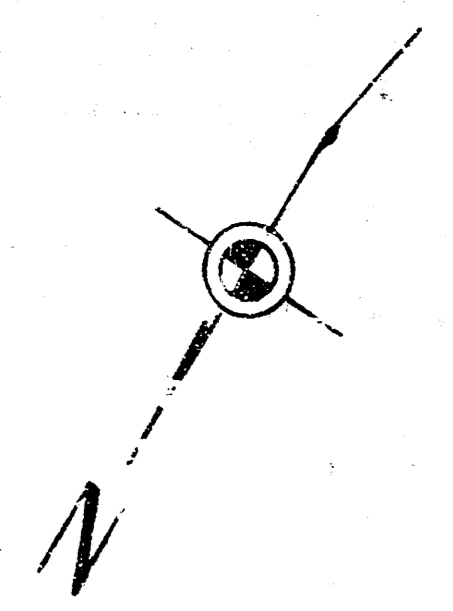

Sta. 0165.0  
End 8" Clay Pipe.  
Plug Pipe.

Sta. 9144.0 Line No. 1 =  
Sta. 0100.0 Line No. 2

Sta. 12171.0  
Const. Std. M. H.  
Type "A"

Sta. 9141.0 Line No. 1 =  
Sta. 0100.0 Line No. 2





Sta. 12171.0 Const.  
Std. M. H. Type "A"

Sta. 0100.0 Line No. 2 =  
Sta. 9141.0 Line No. 1

Sta. 0165.0  
End 8" Clay Pipe  
Plug Pipe.

180  
175  
170  
165  
160

185  
180  
175  
170  
165  
160

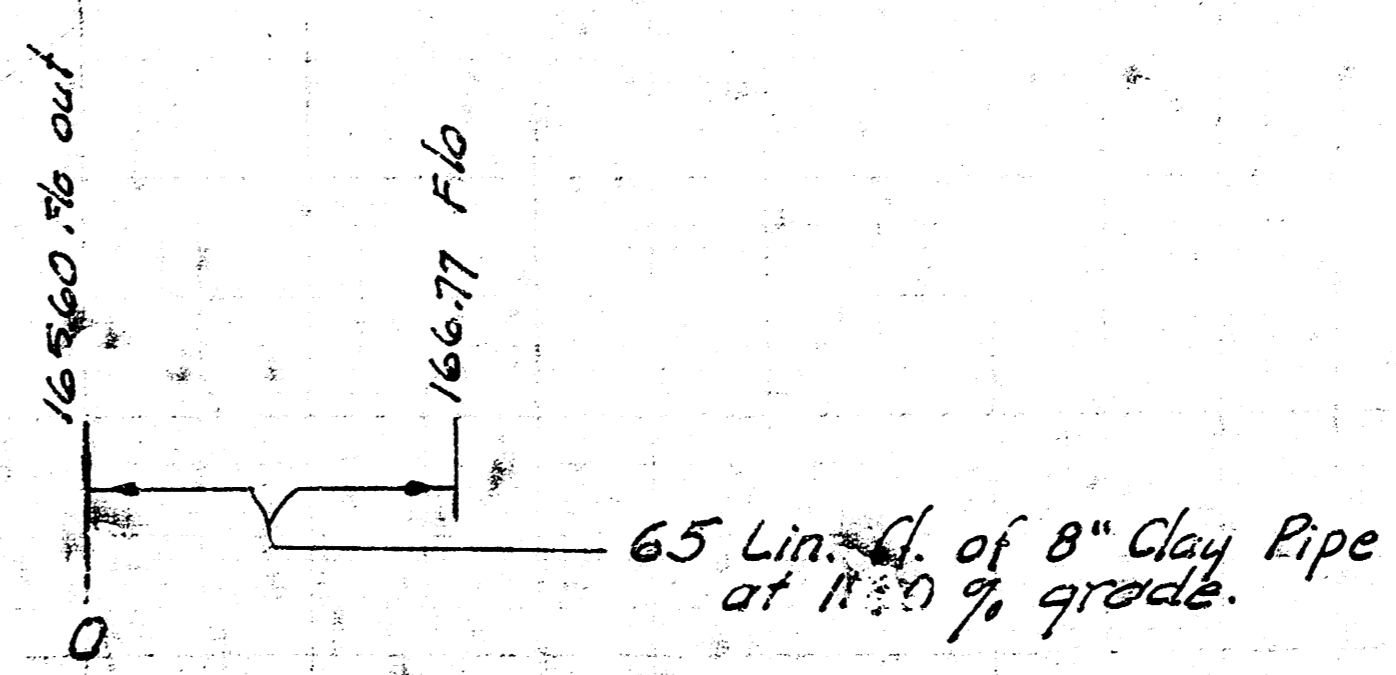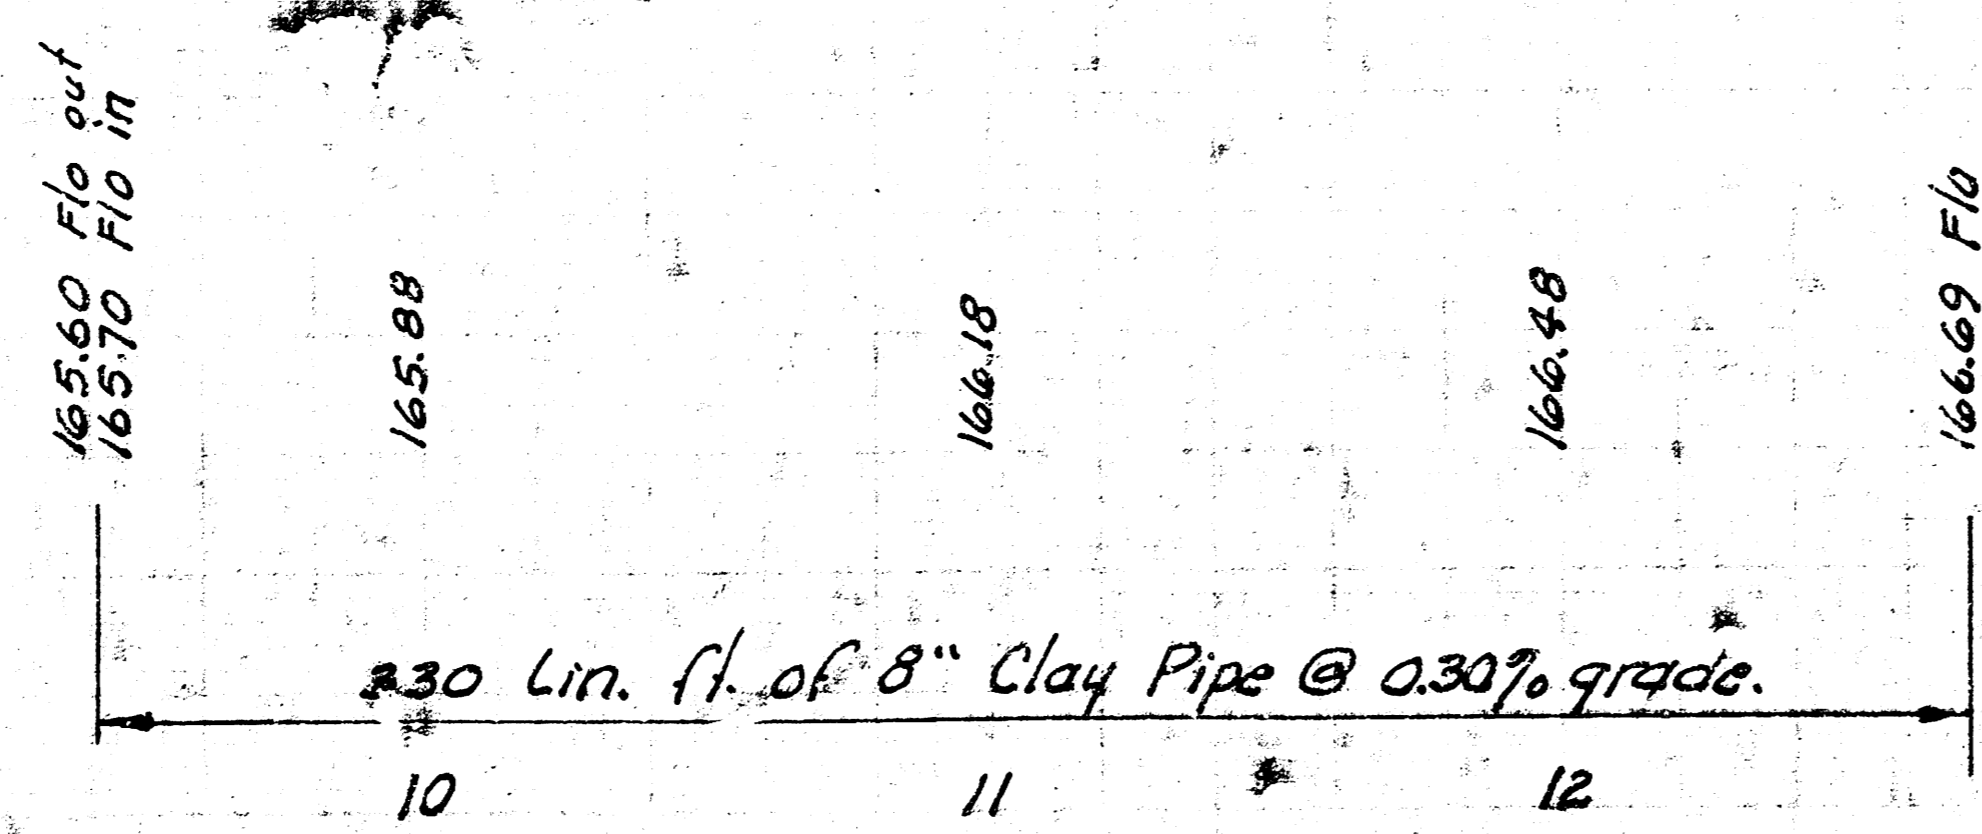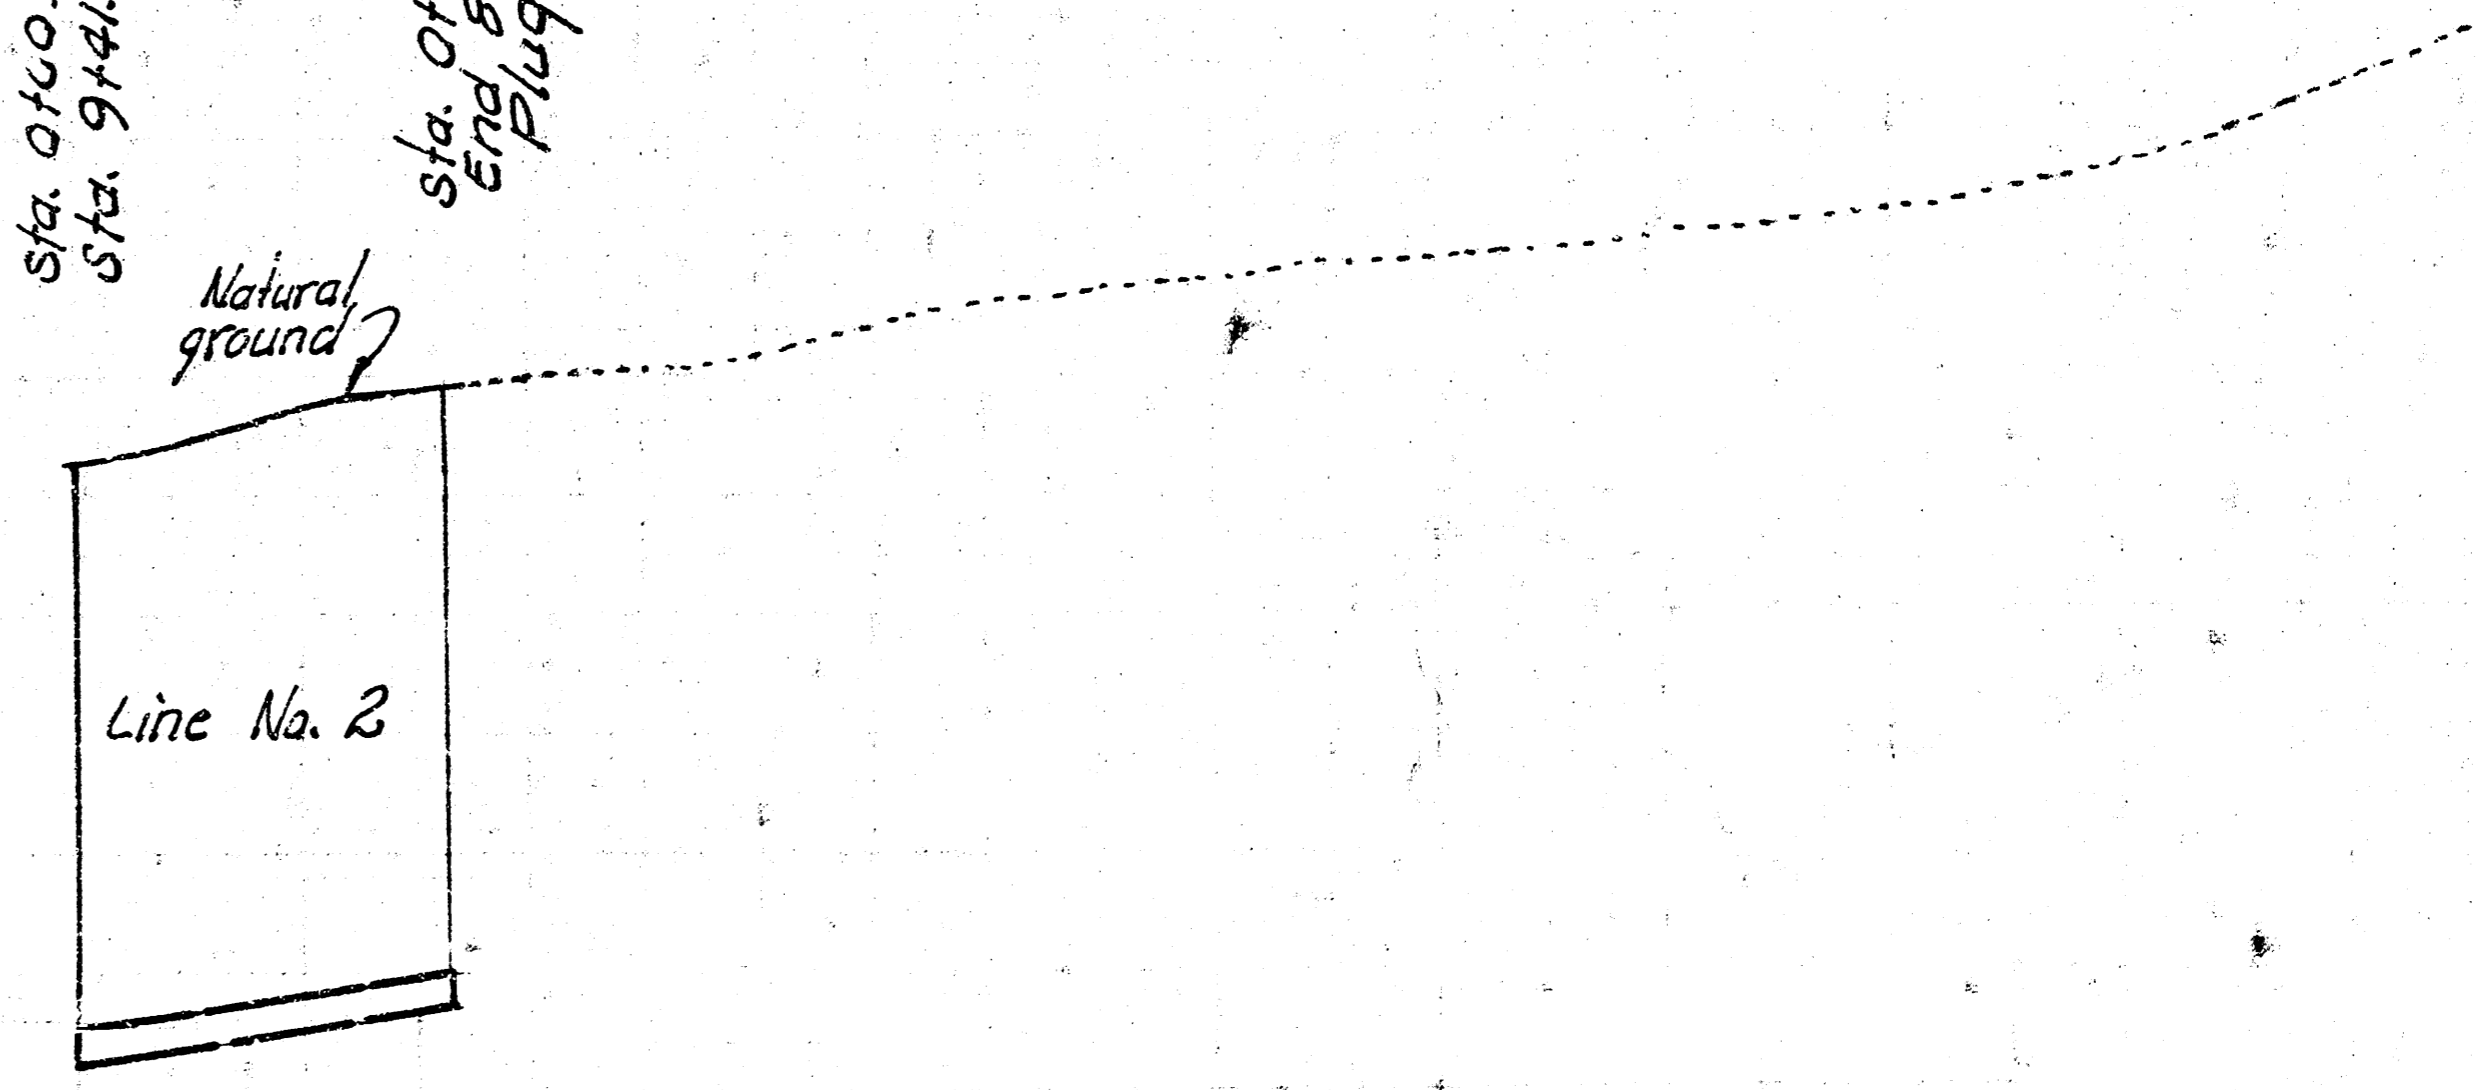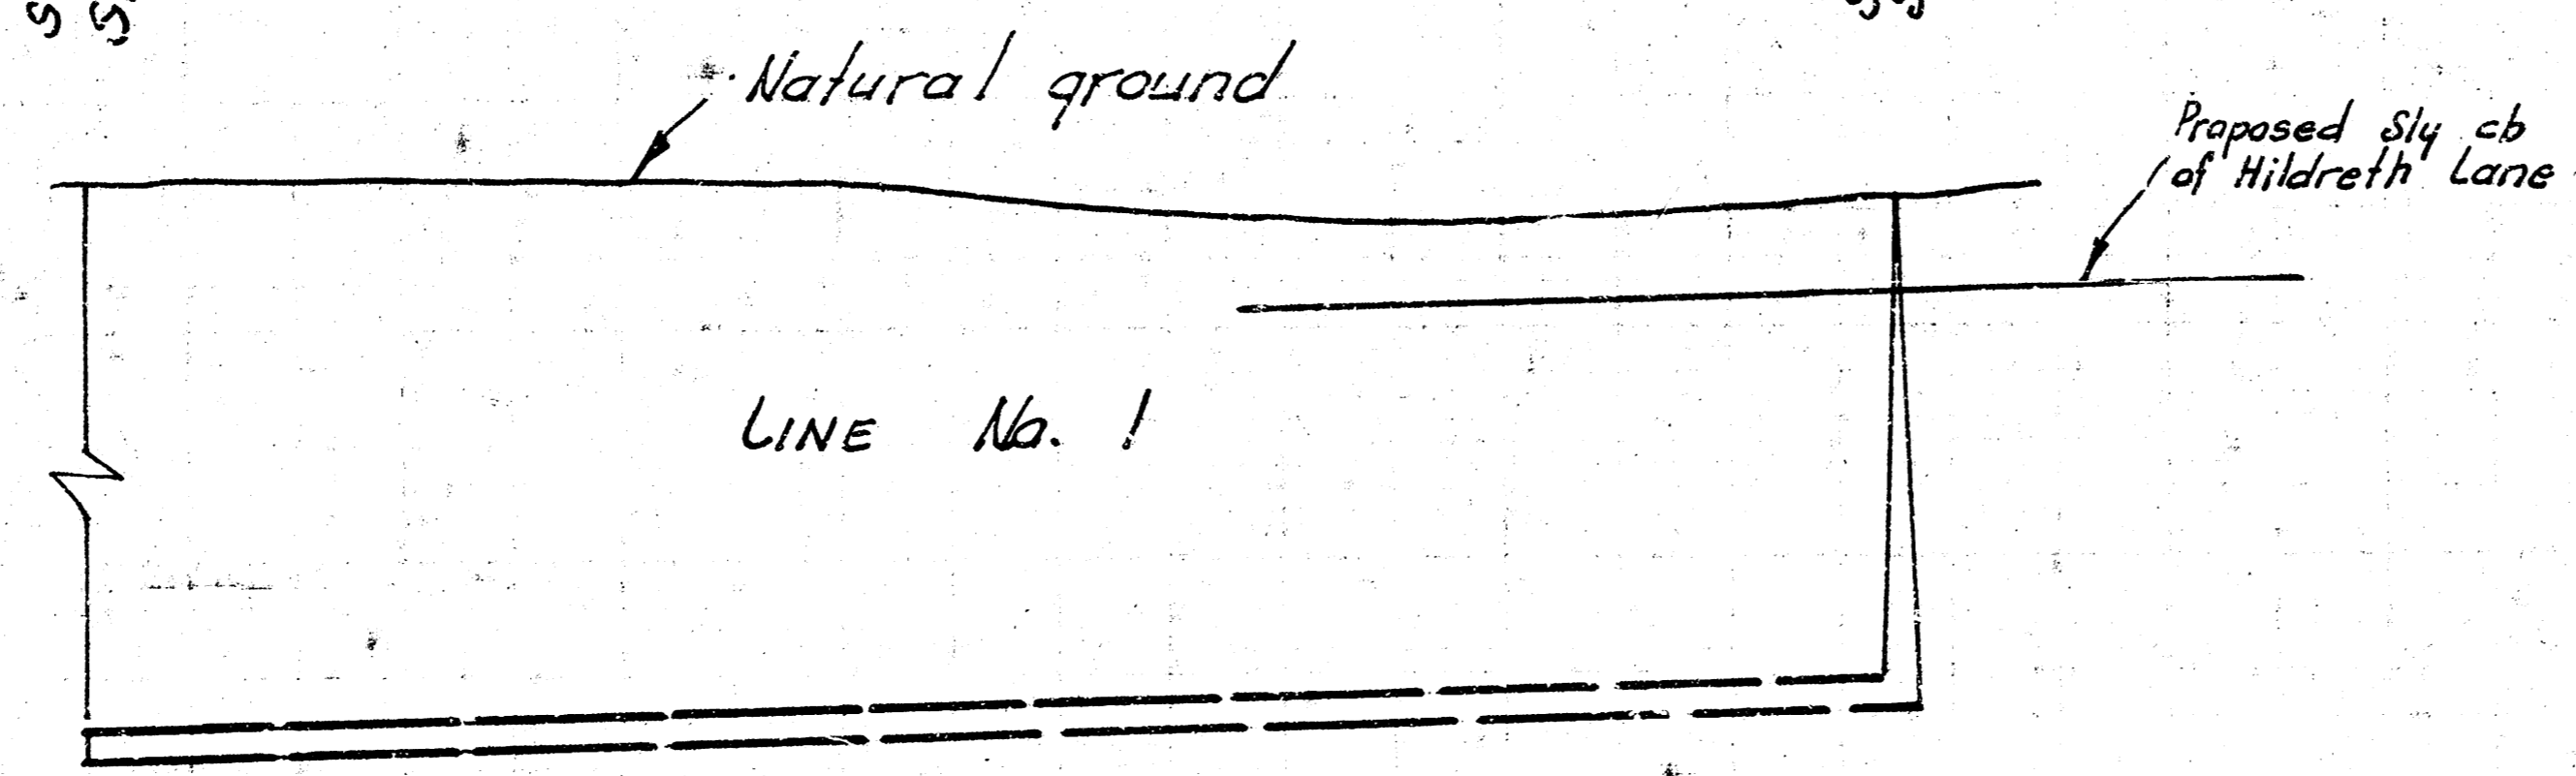

LAT. 4, MAIN 17., W. I. S.  
PROJECT NO. DBKL573015

2/2

14 2 5 11 2/2