



3. M. 171.69 R. P. Spk. N. face
Jesse Orange hedge SW cor.
Cherry Creek Dr. & Lori Ln.

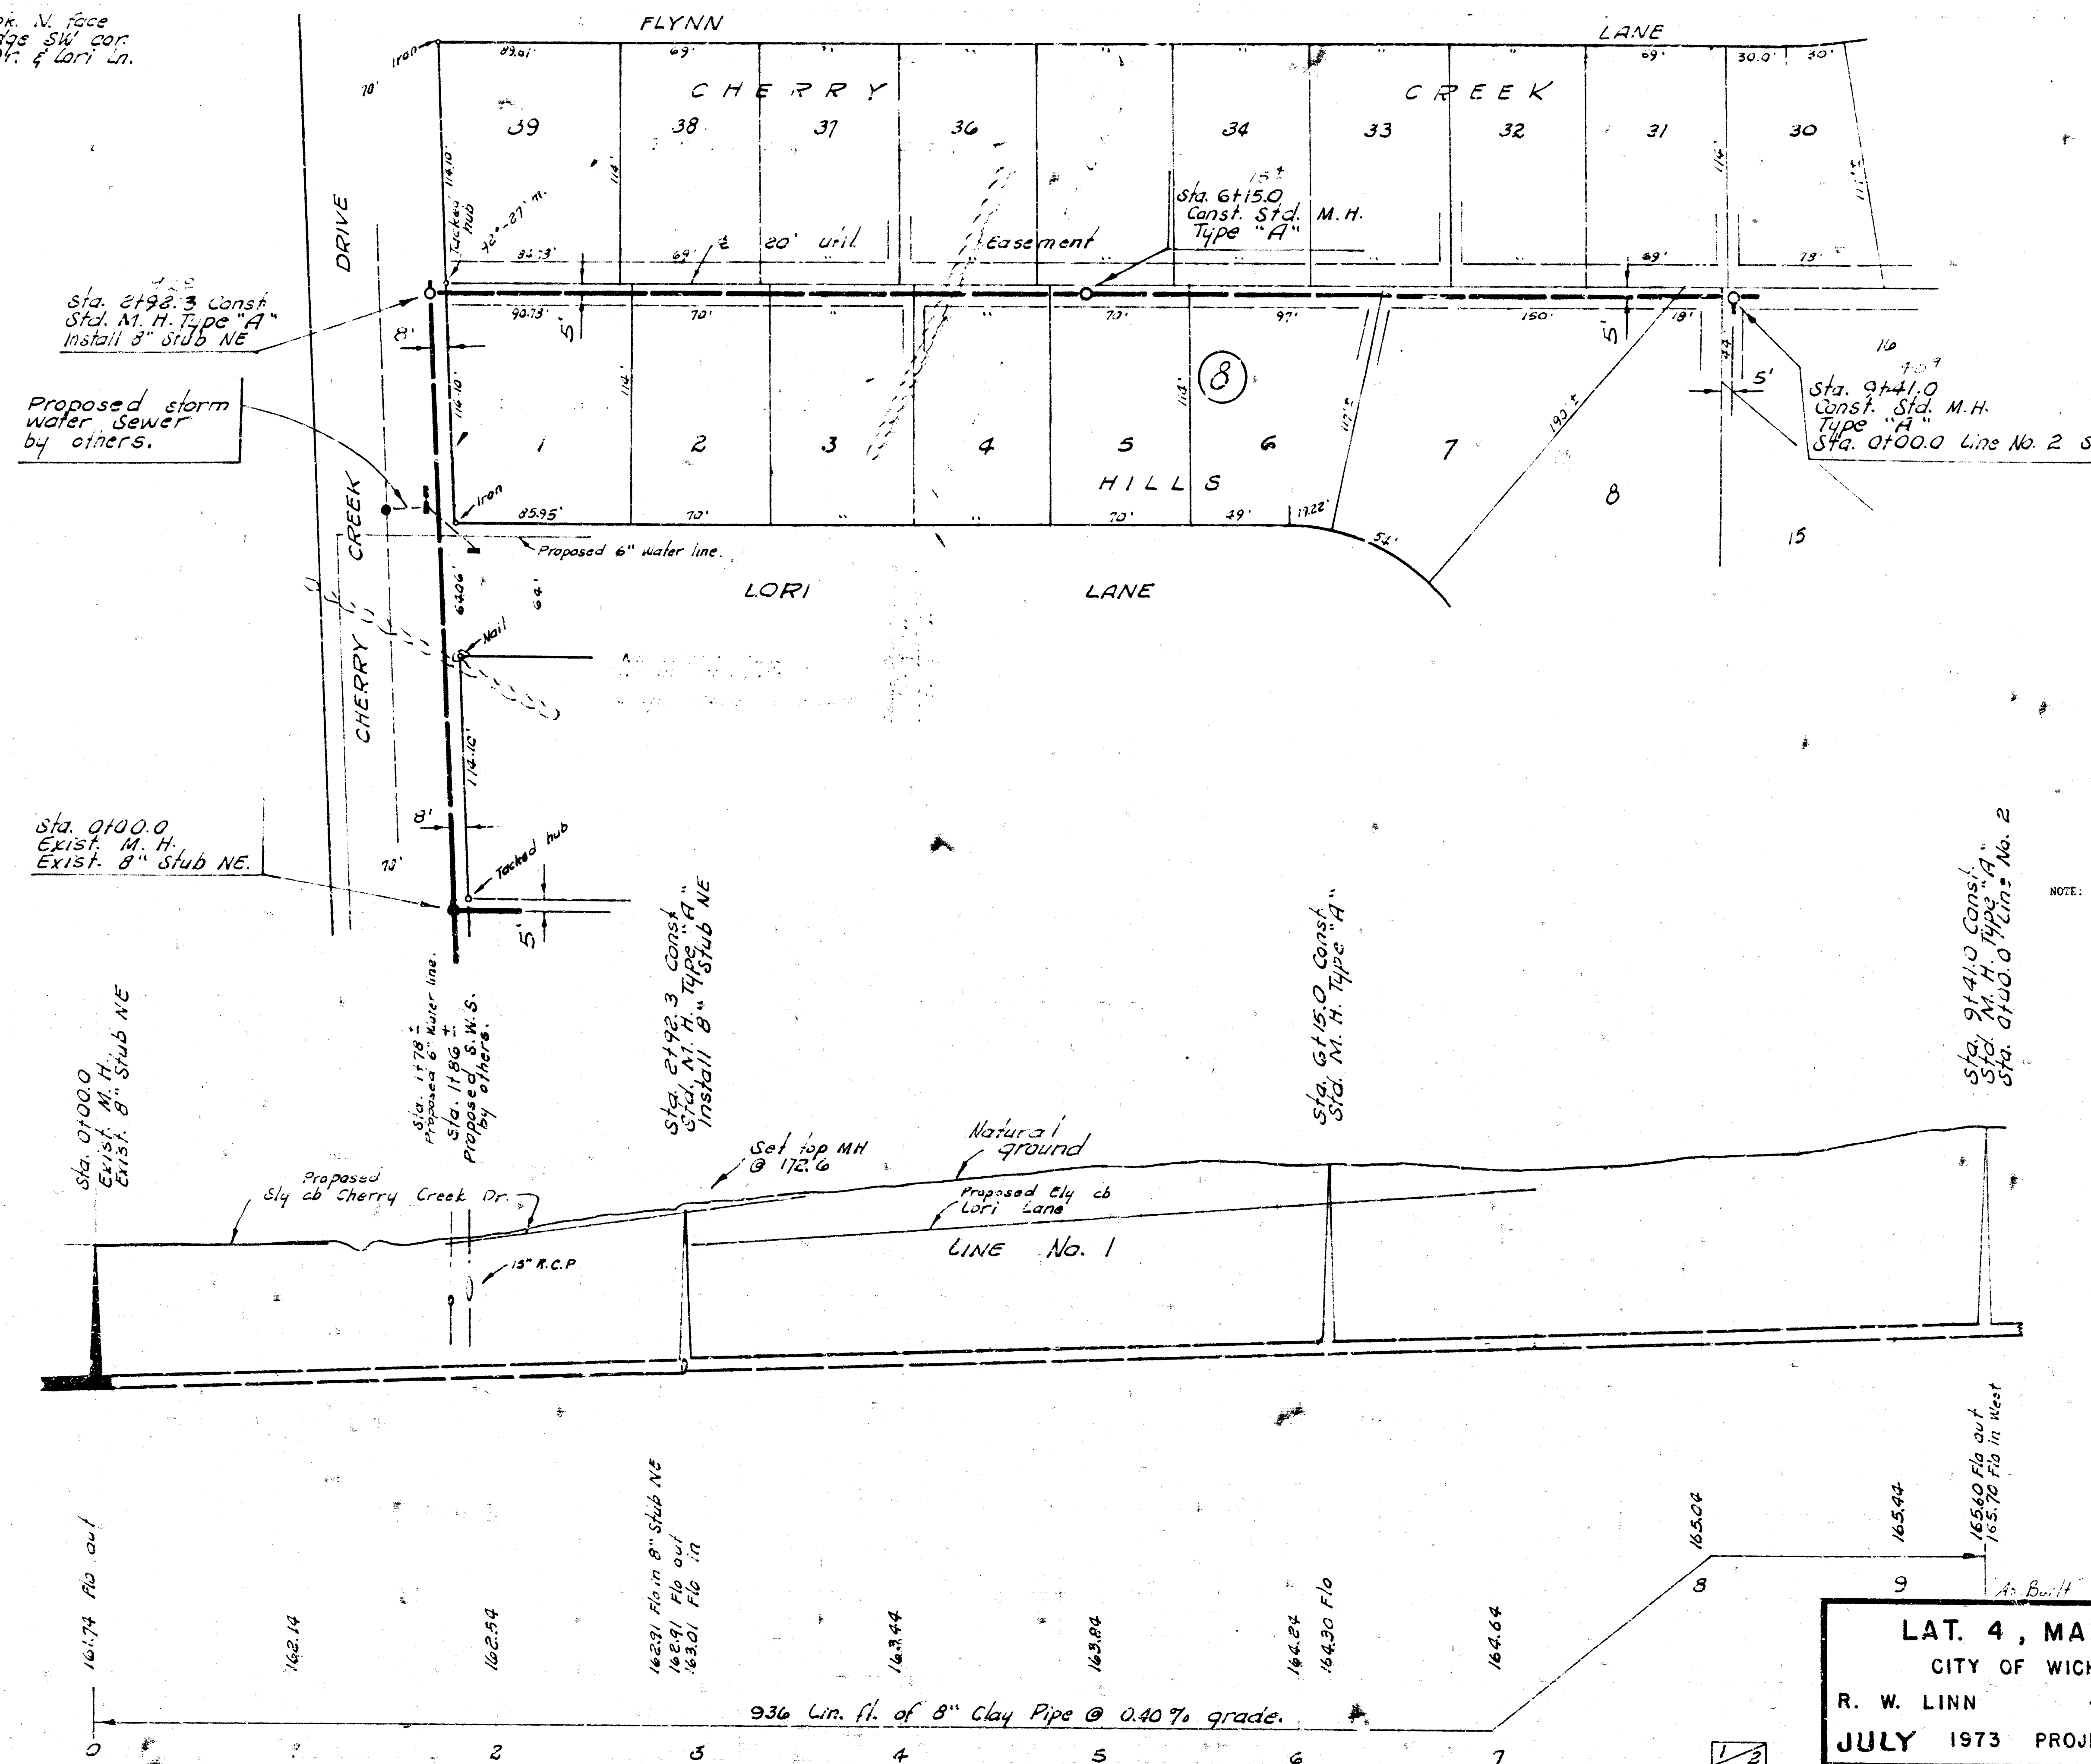


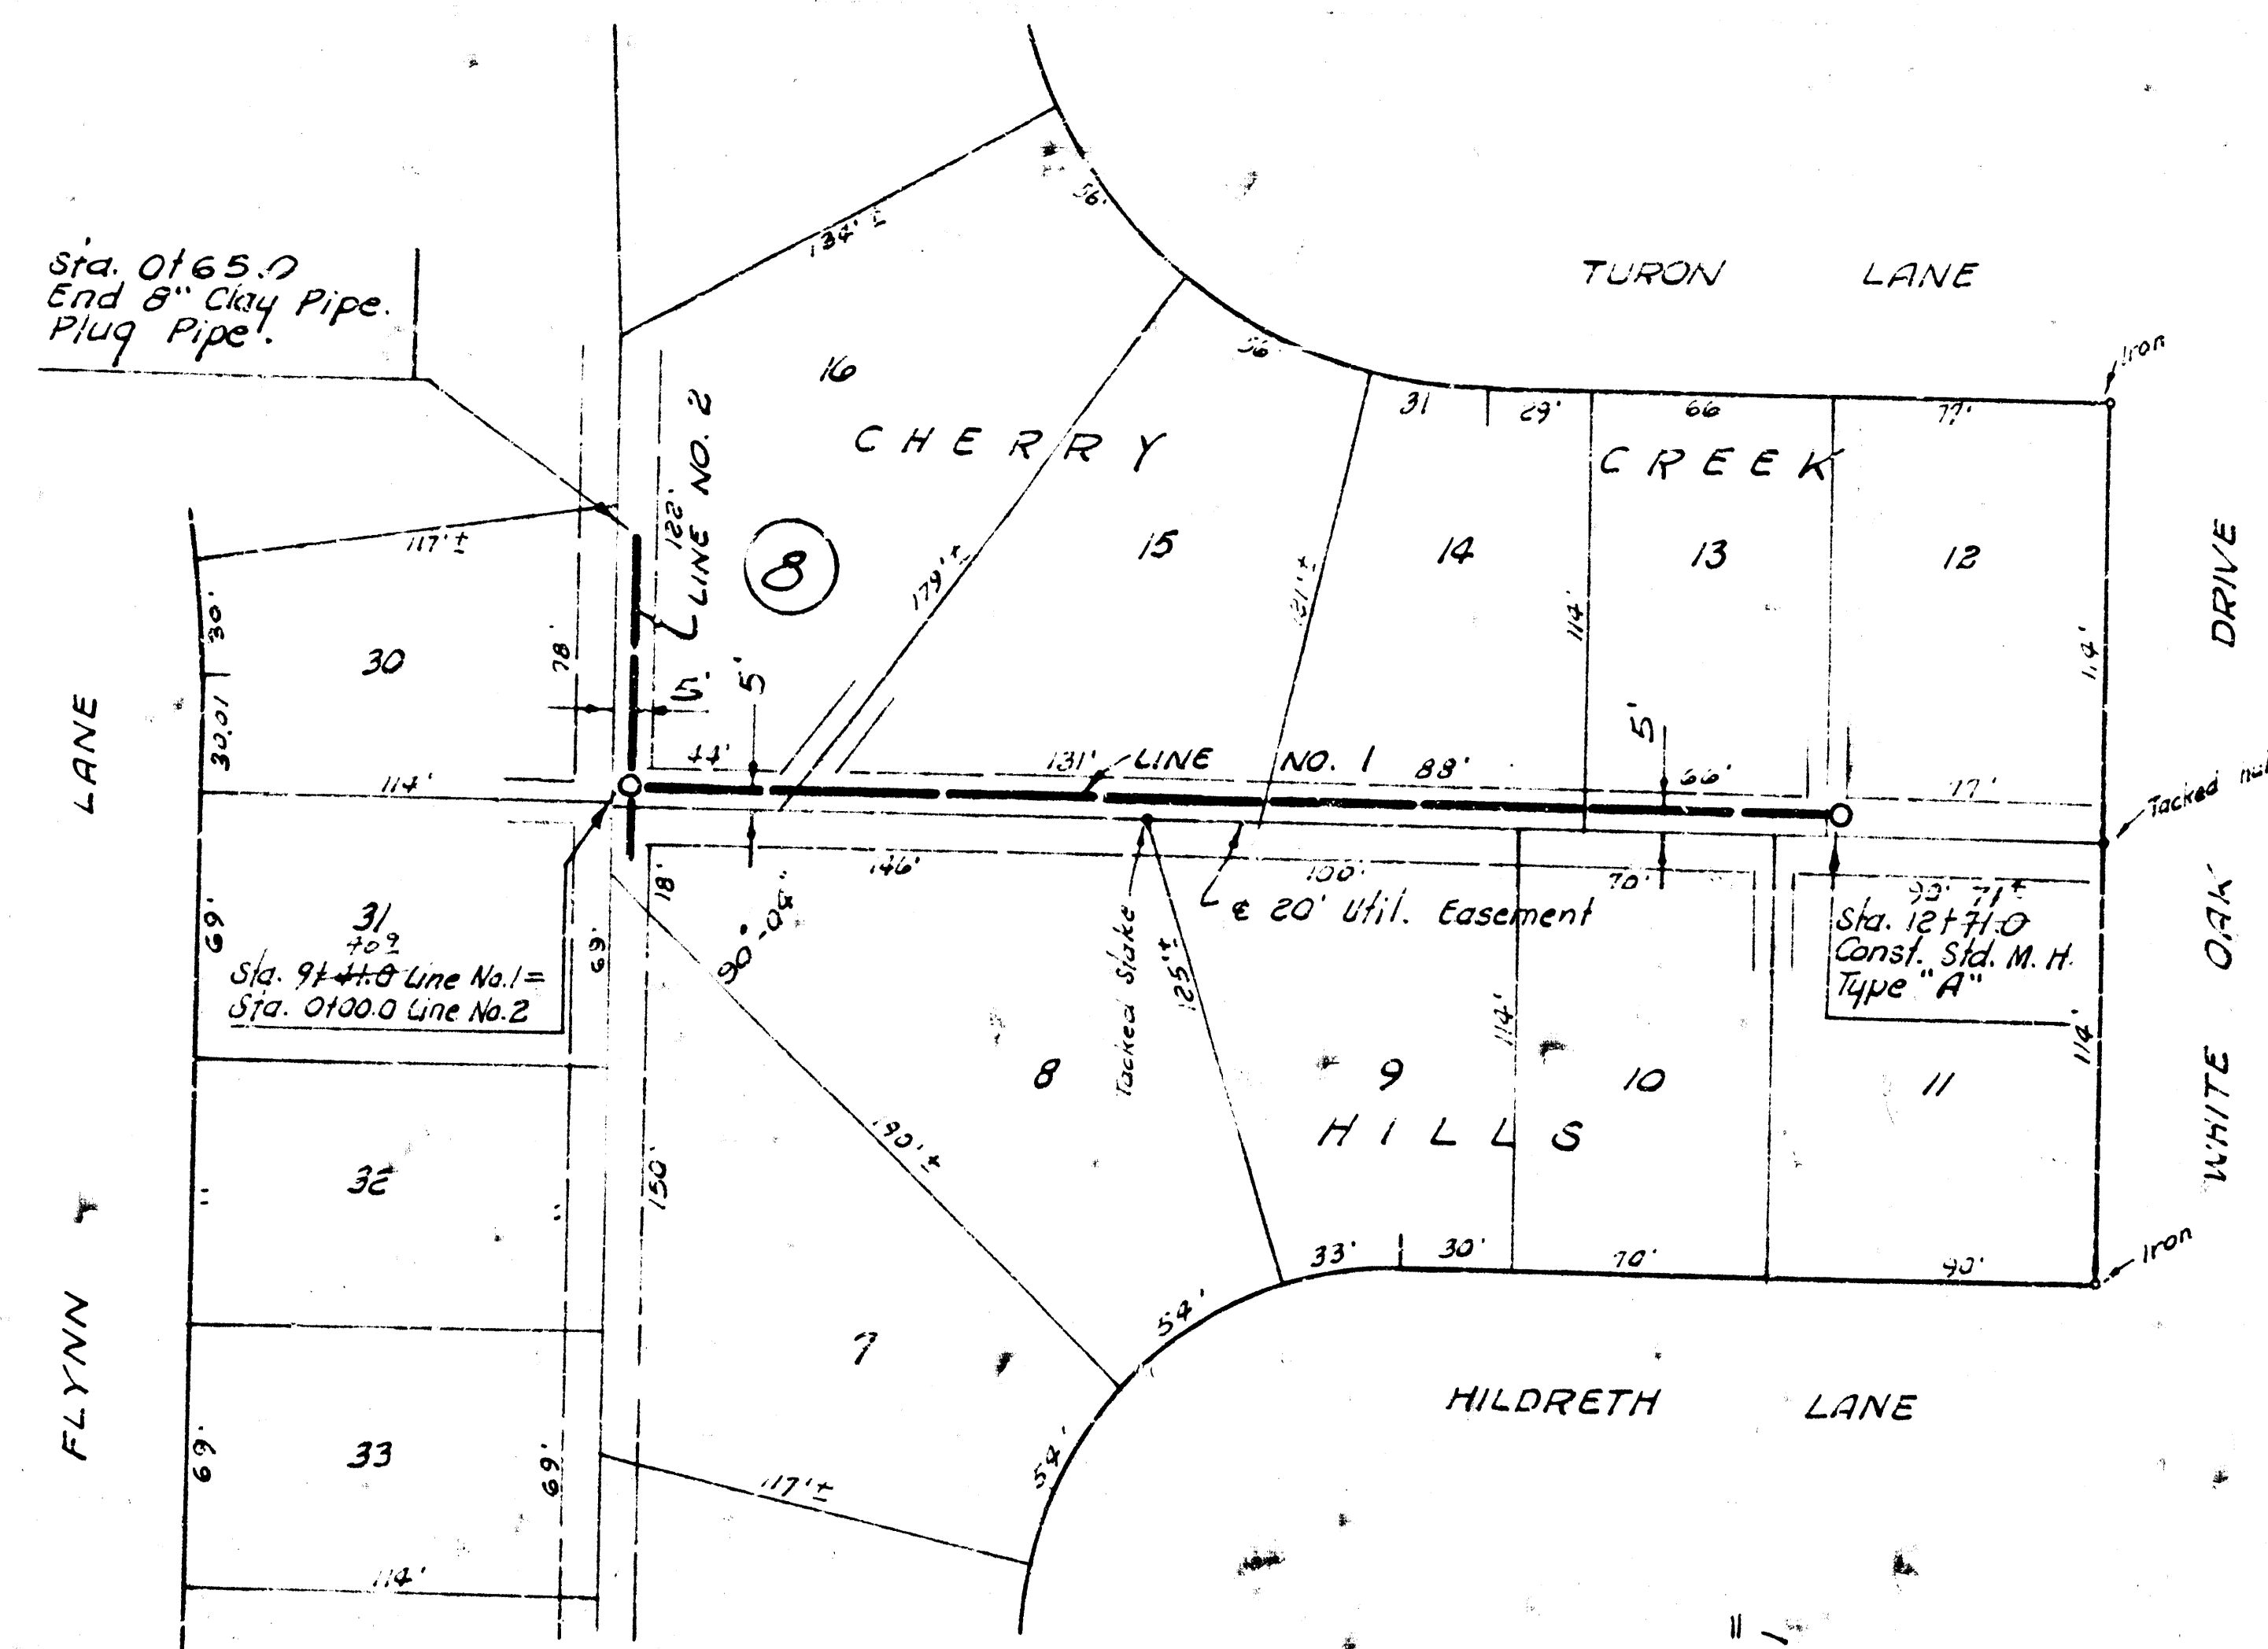


Sta. 91+41.0 Line No. 1 =
Sta. 0100.0 Line No. 2

Sta. 12171.0 Const.
Sta. 12171.0 Type "A"

Sta. 0100.0 Line No. 2 =
Sta. 91+41.0 Line No. 1

Sta. 0165.0
Sta. 0165.0 Pipe
Plug Pipe

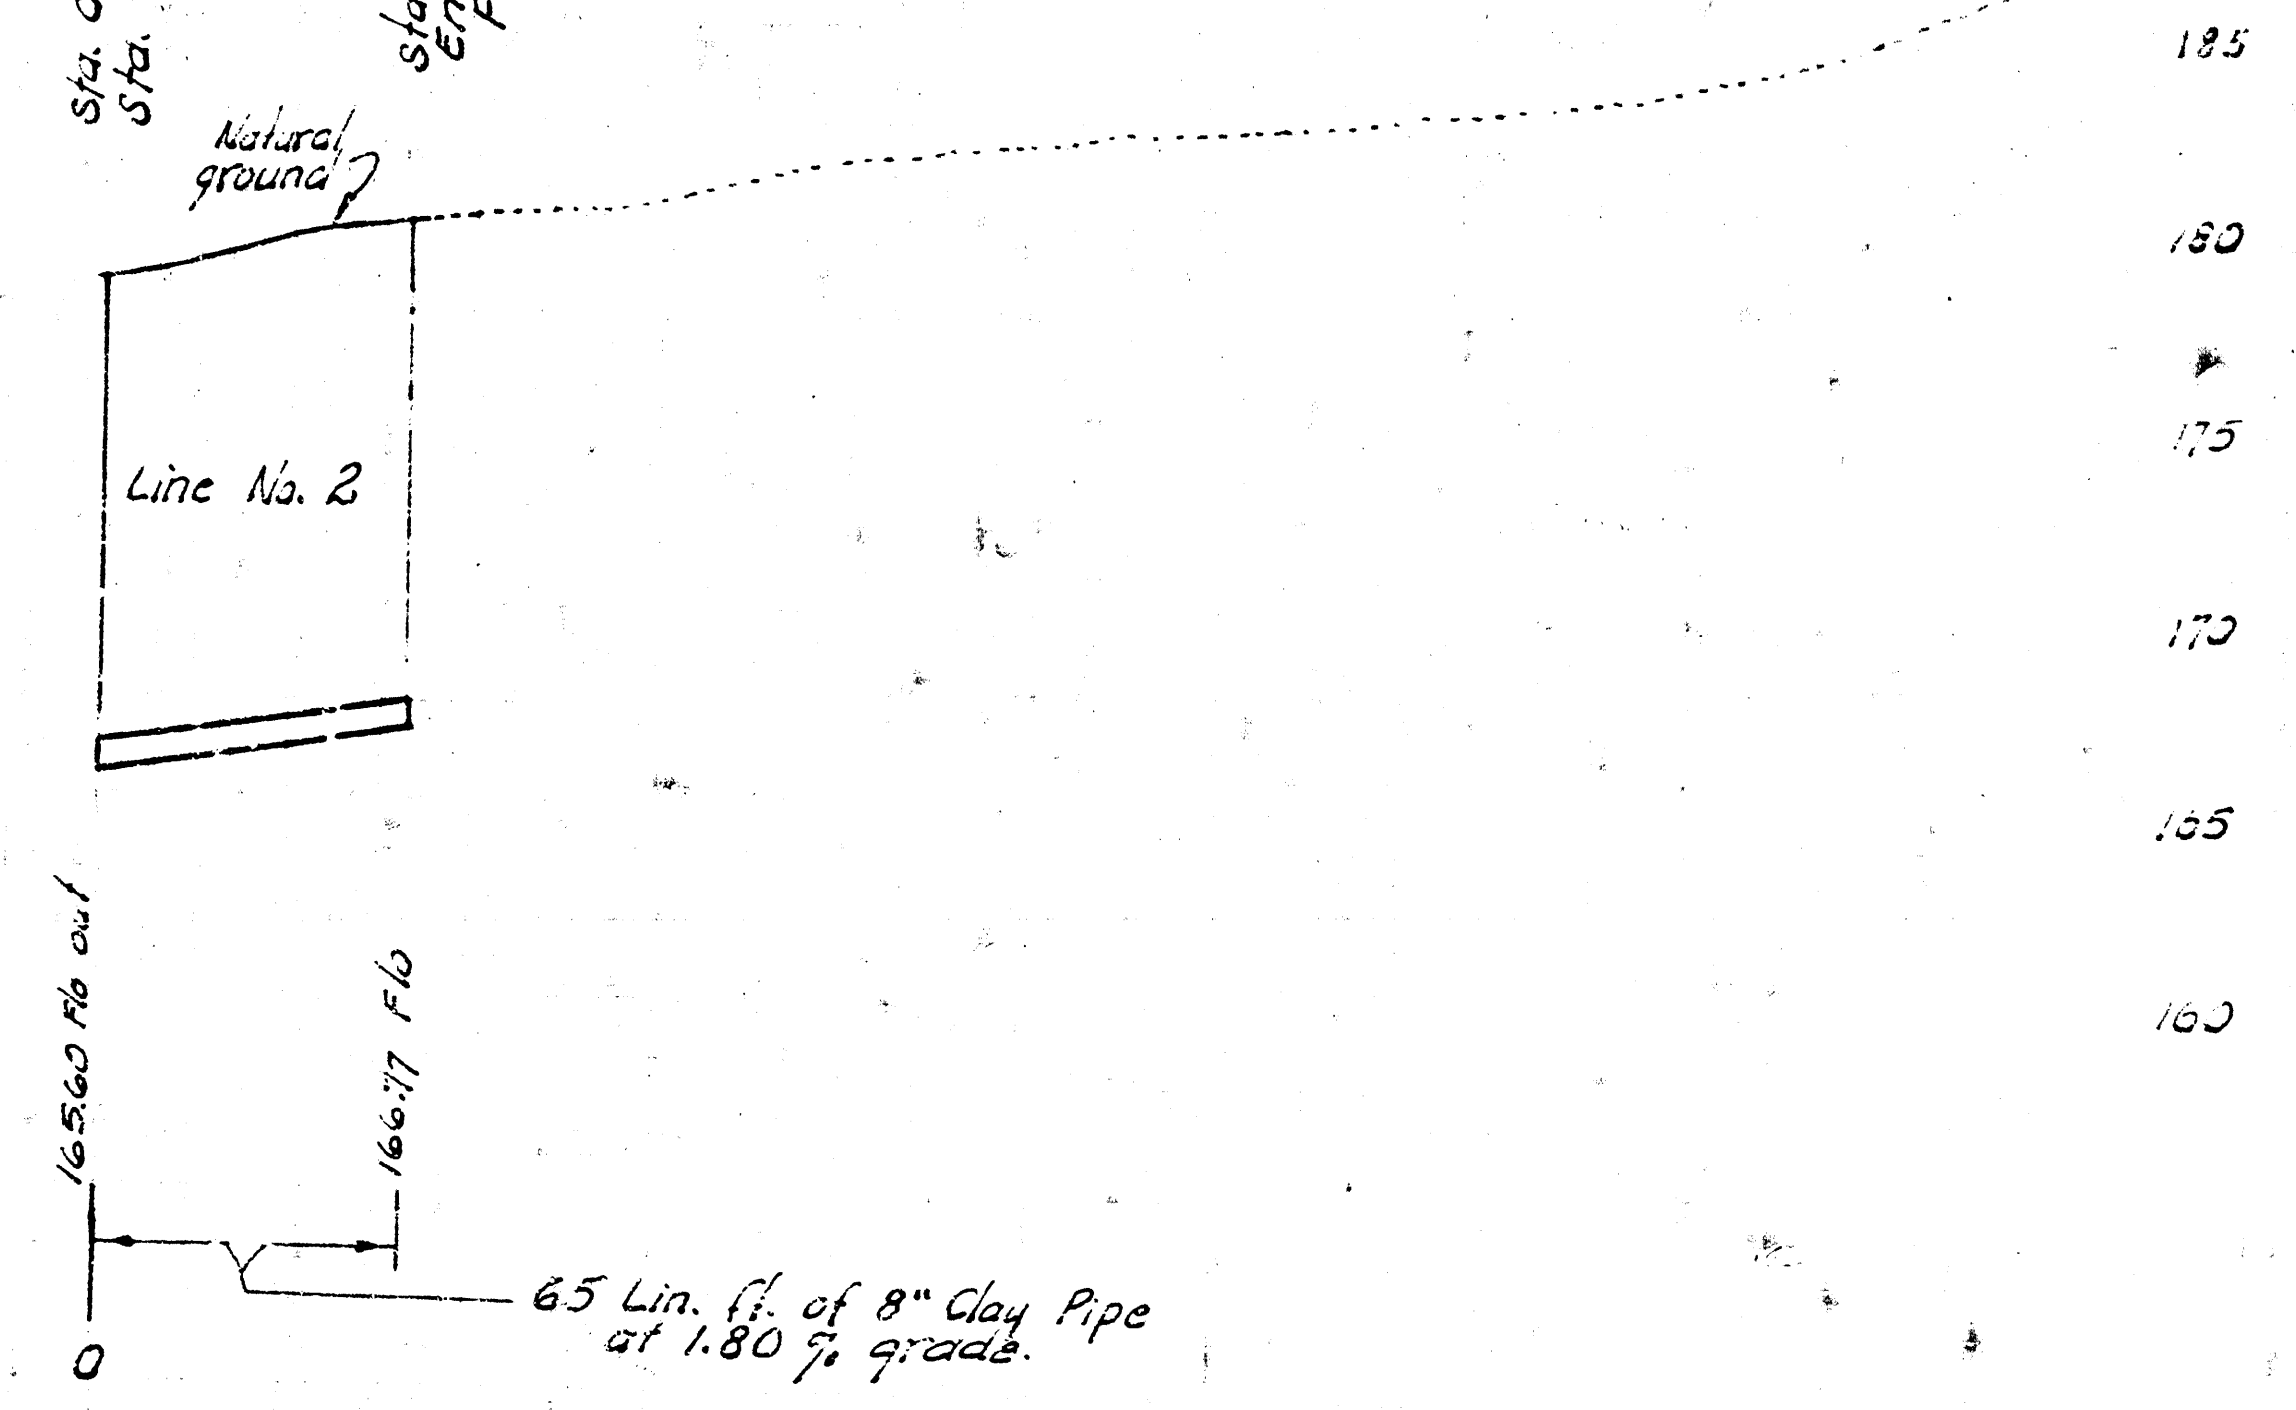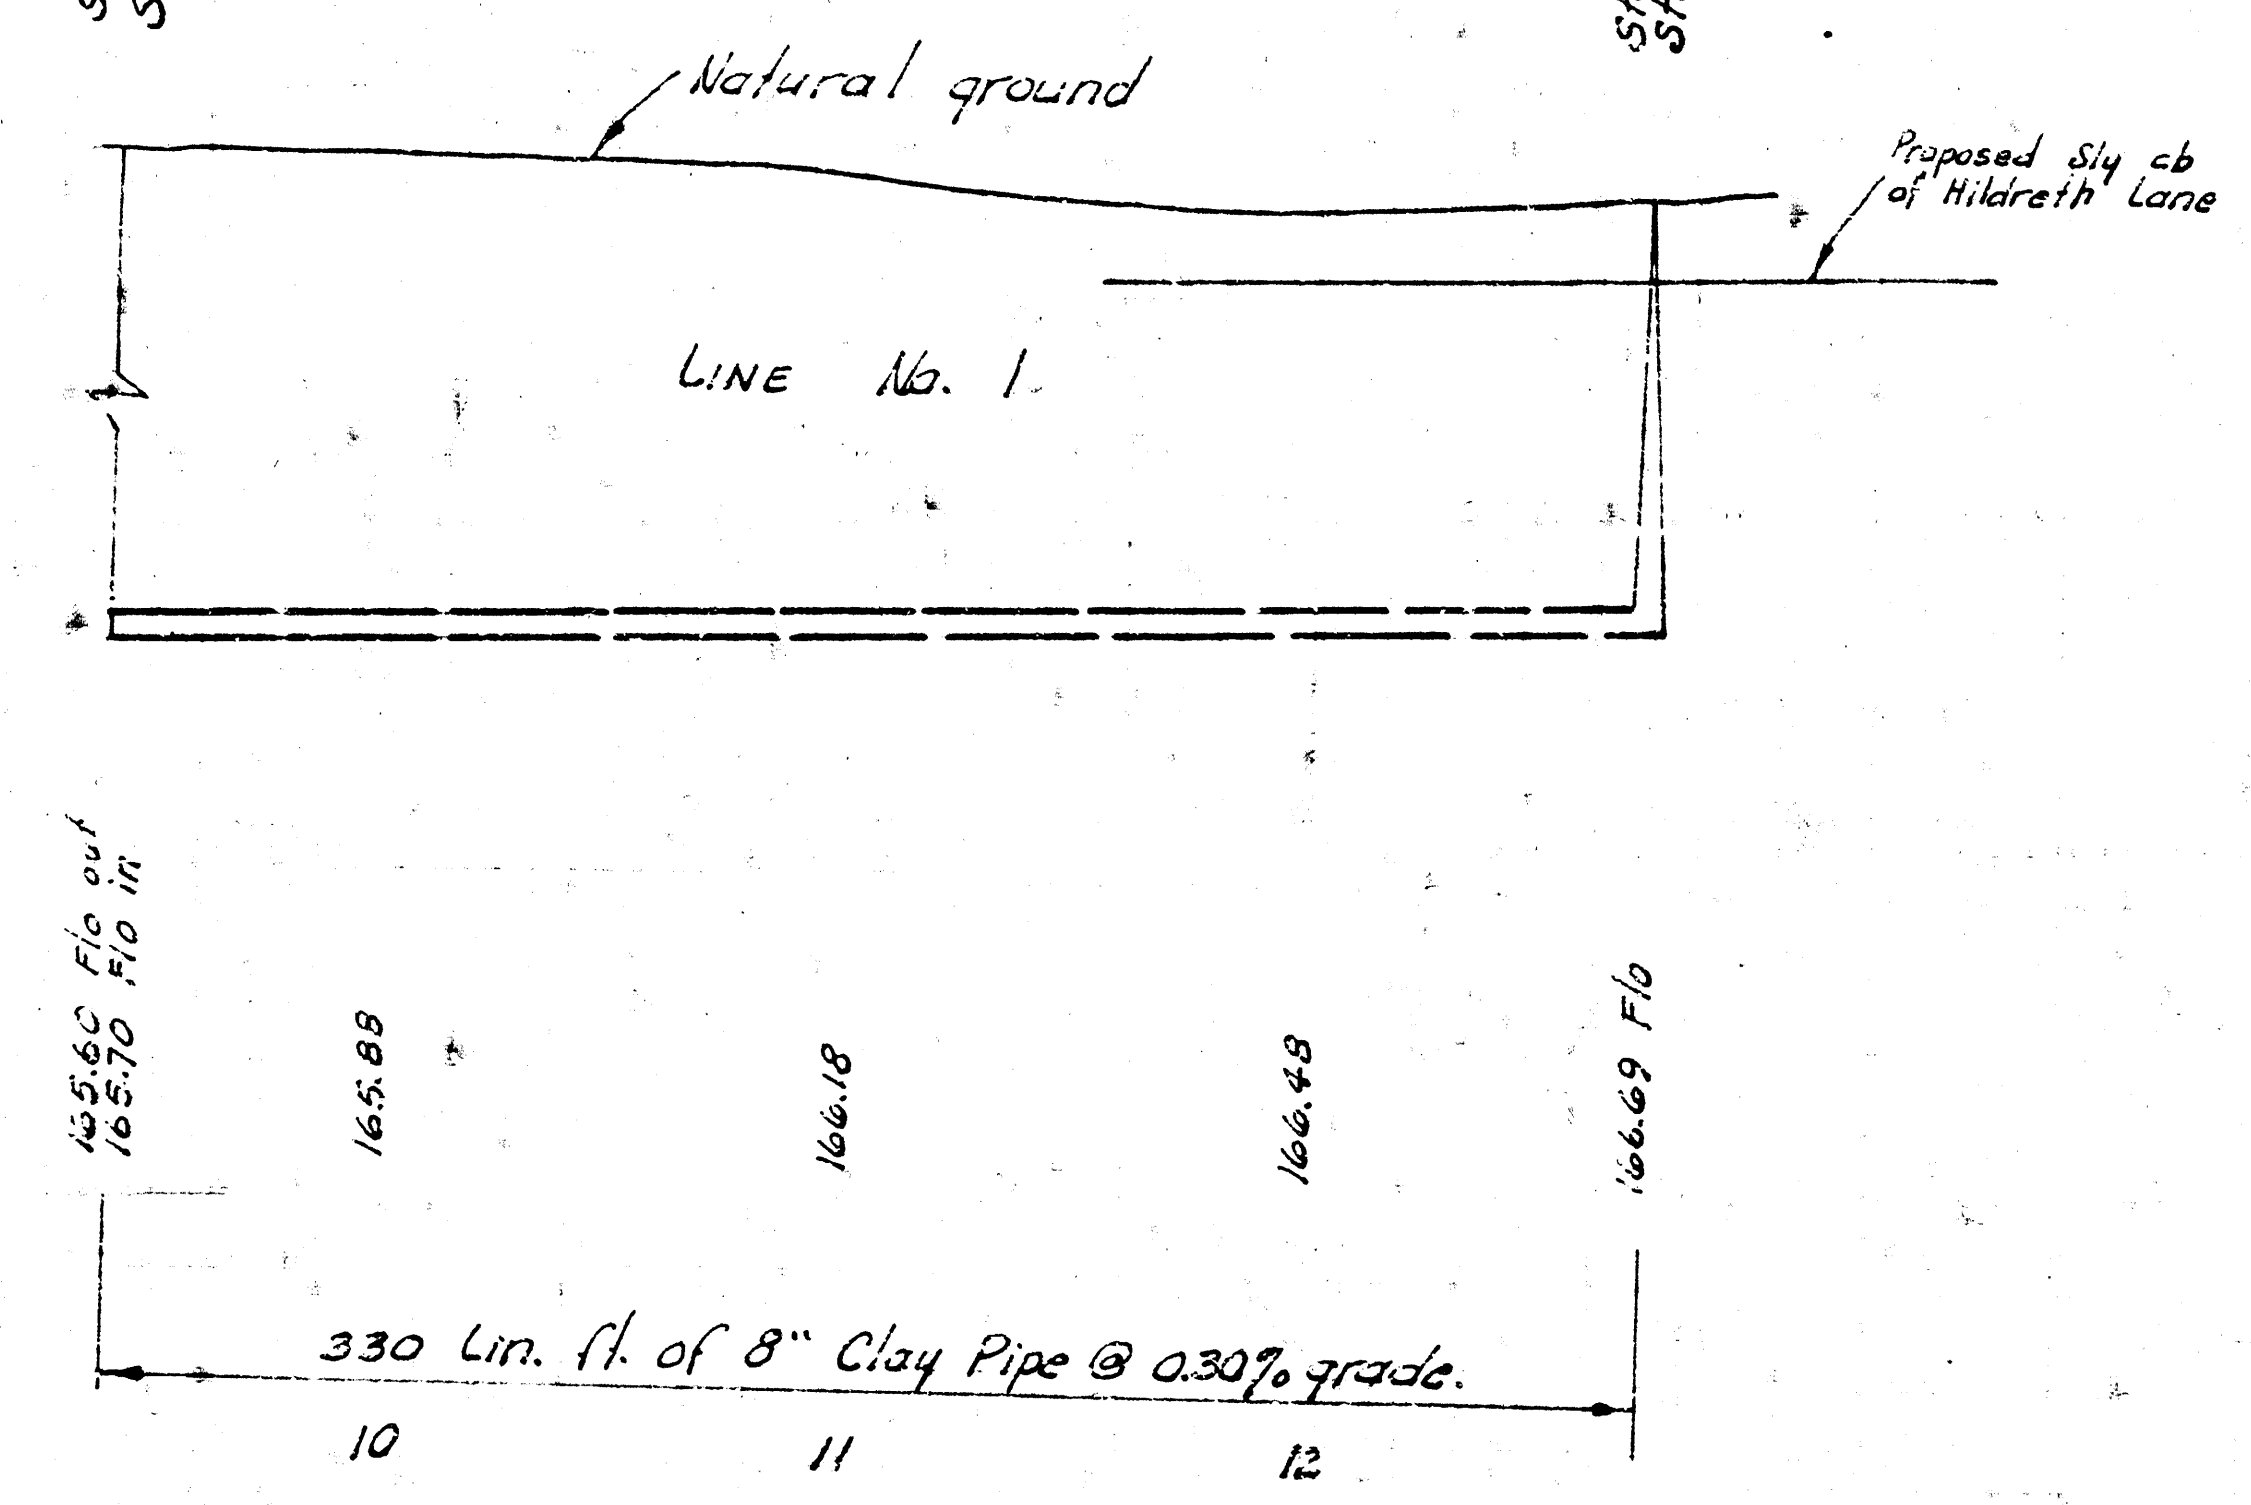

LAT. 4, MAIN 17, W. I. S.
PROJECT NO. DBKL573015

13