



S.M. 19880 P.P. Spike in E. Side p. pole 30' N. of intersection of  
 OAK KNOLL & Bray Co. Driveway.

**CAUTION**  
 UNDERGROUND  
 UTILITIES  
 Please check with K.G. & E. or  
 Southwestern Bell  
 Telephone Co. for Location

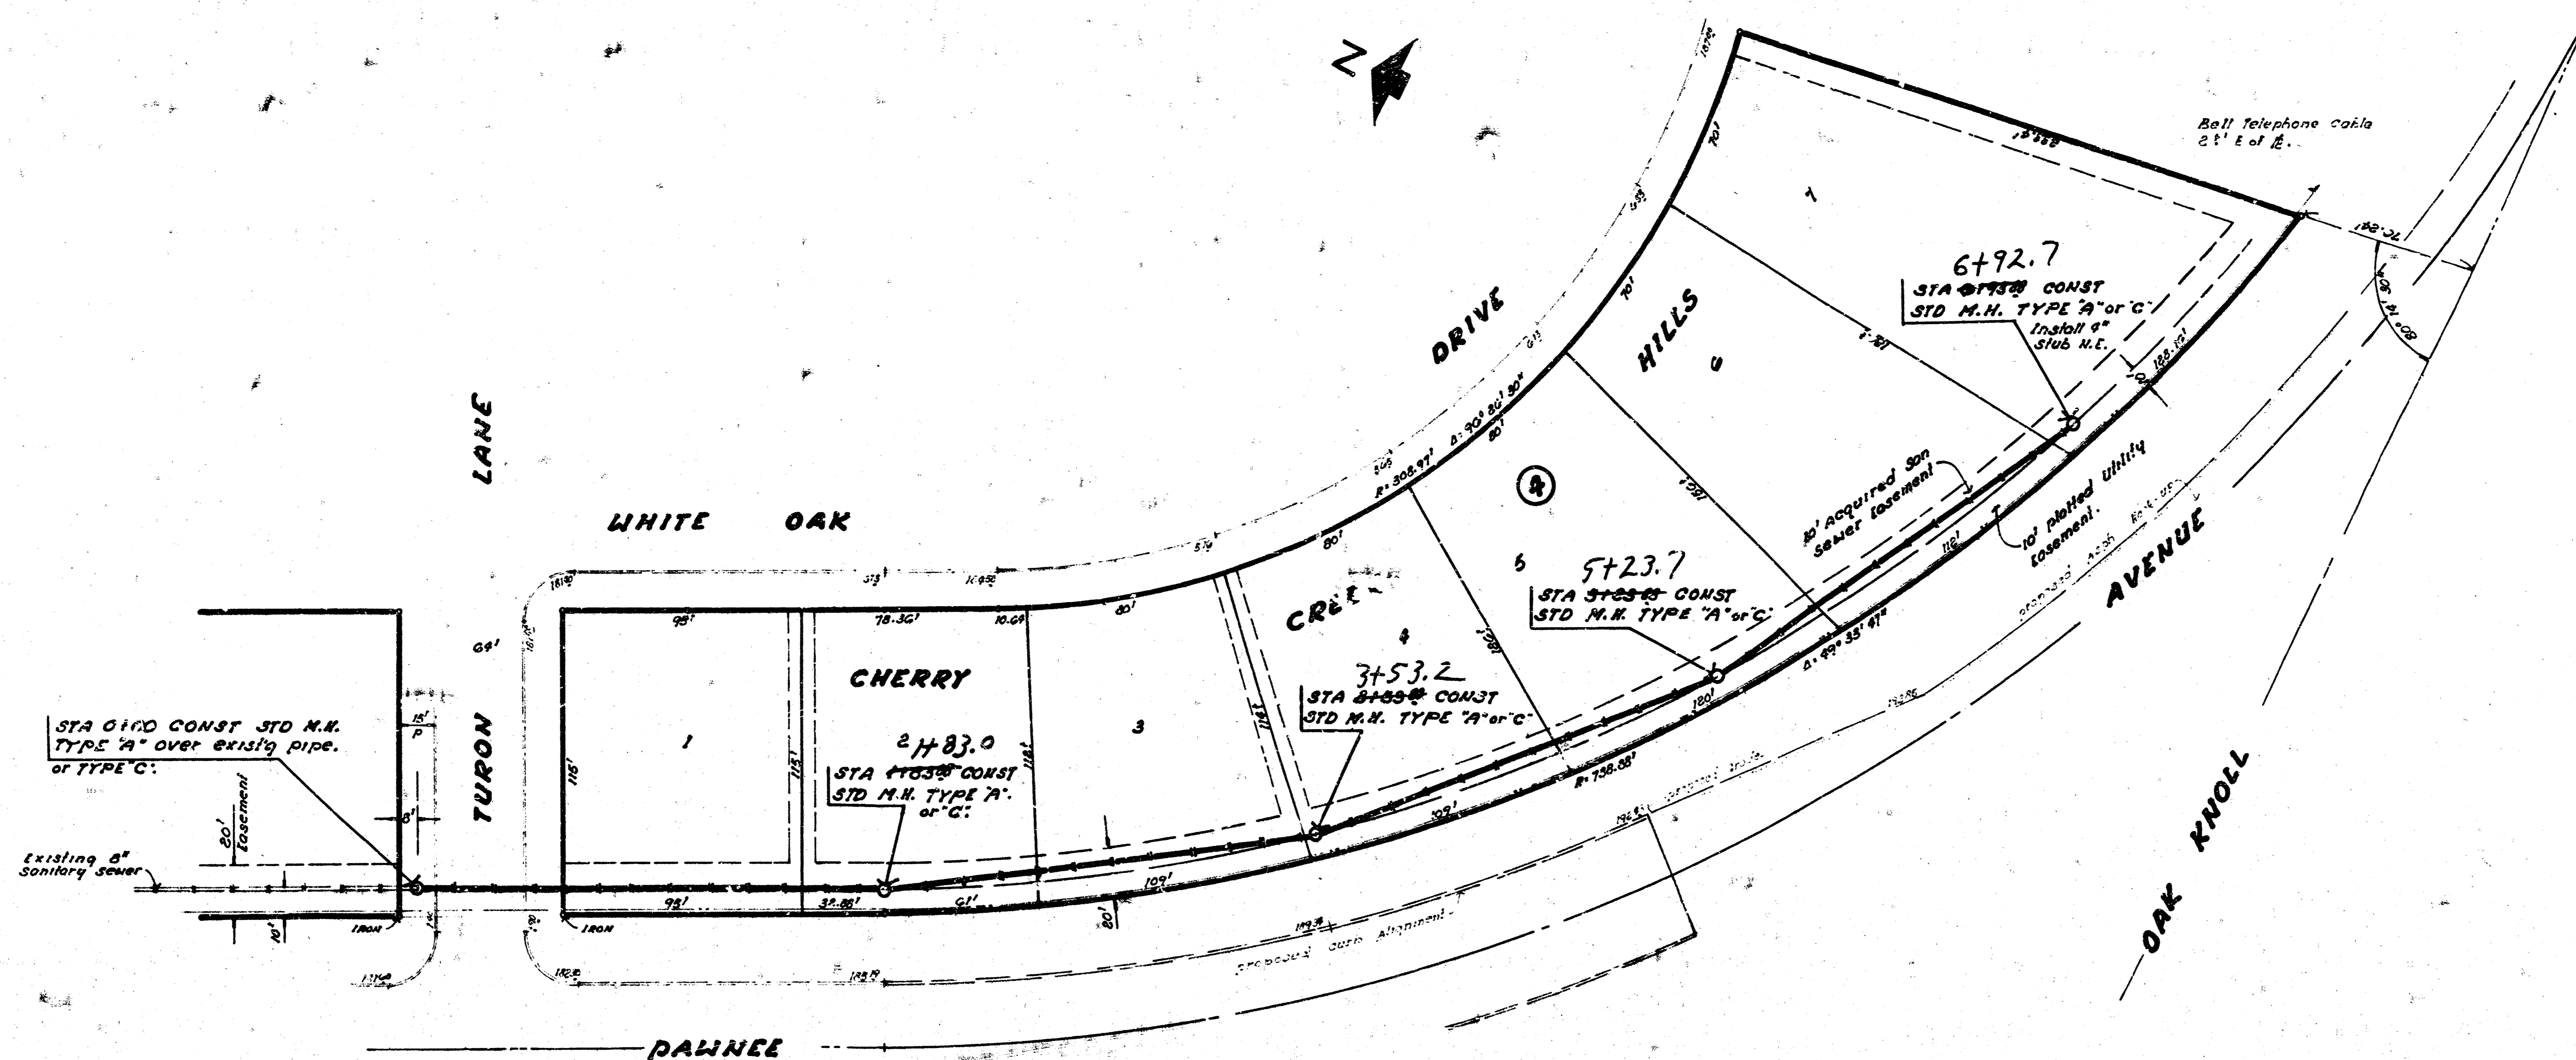

plan scale 1" = 40'  
 profile 1" = 40' Horiz  
 1" = 5' Vert

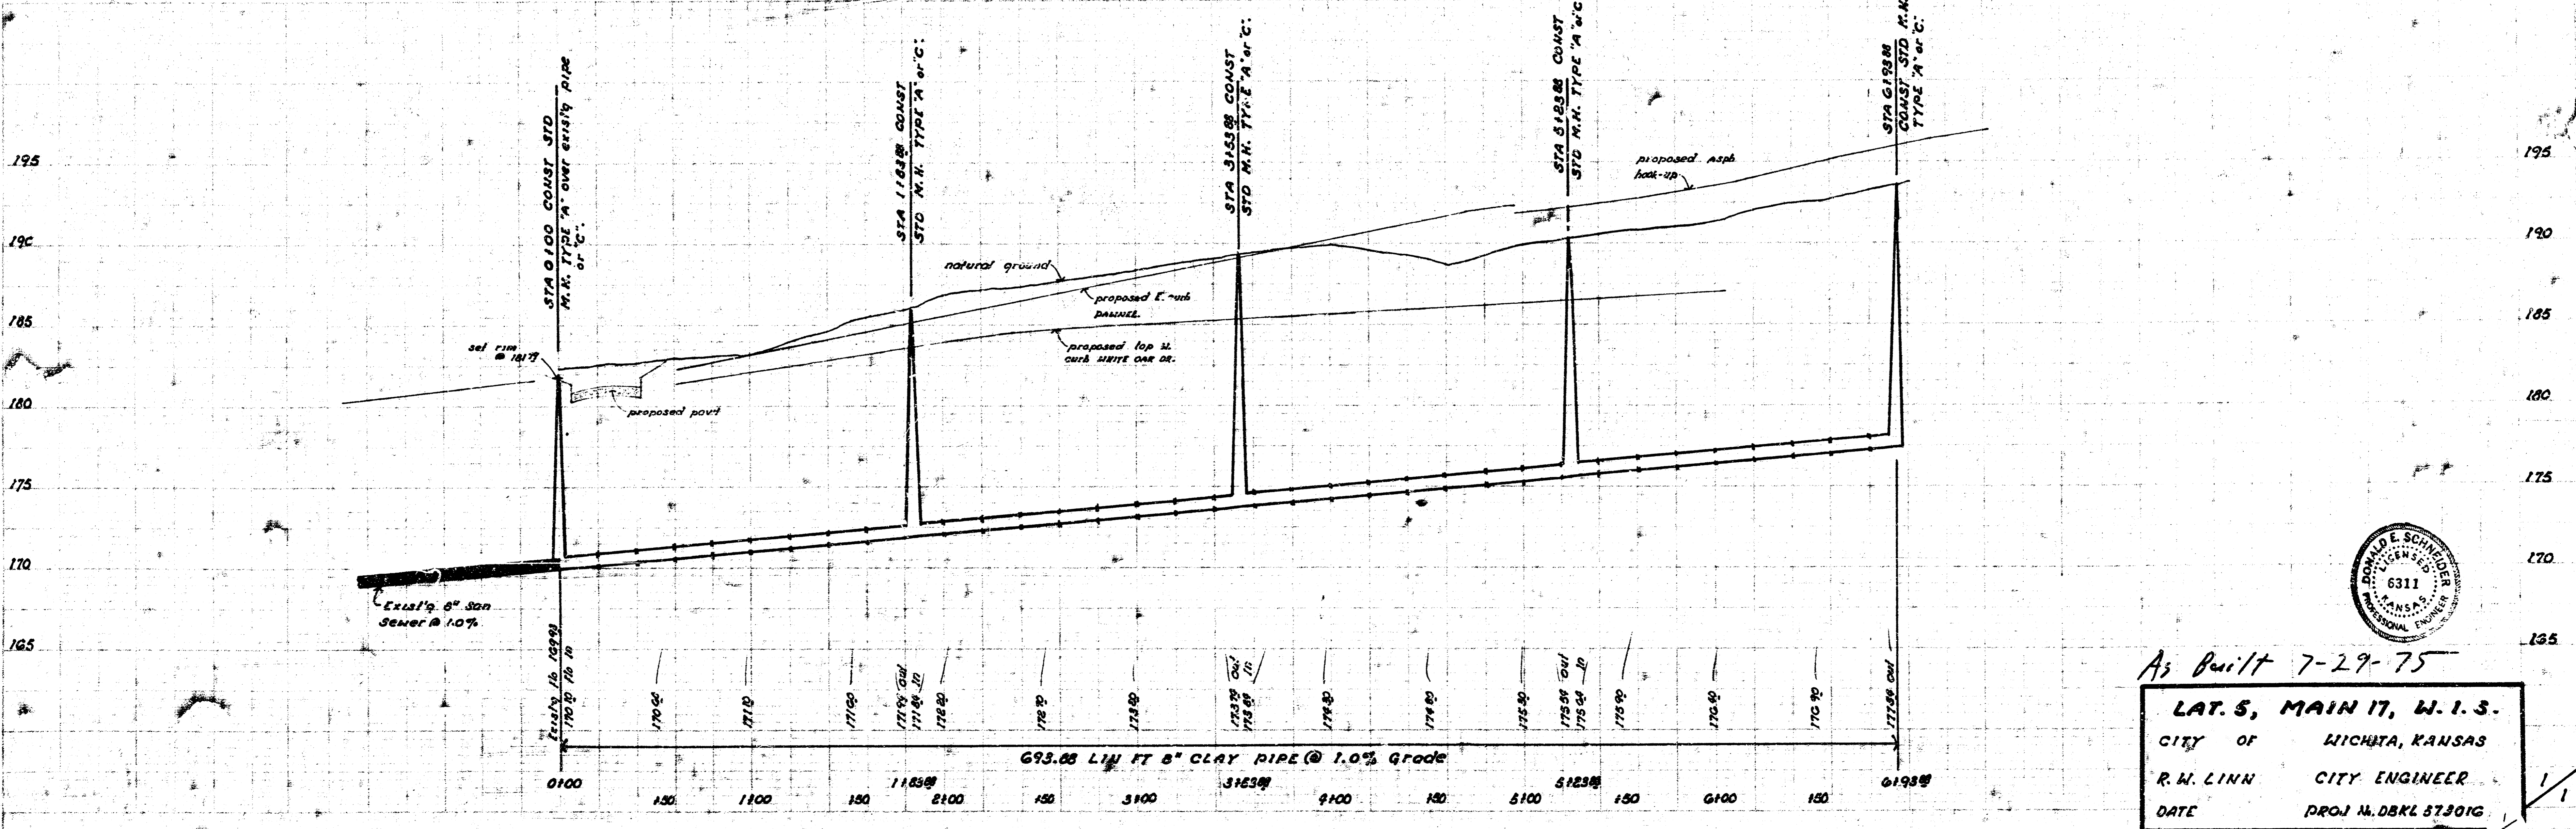

As Built 7-29-75  
**LAT. S, MAIN 17, W. 1. S.**  
 CITY OF WICHITA, KANSAS  
 R. M. LINN CITY ENGINEER  
 DATE PROJ. M. DBKL 57301G