





B. M. 198.26 R. R. Spk. E. S. P.P. 30 North of
 Intersection of Oak Knoll & Bray Co. Driveway.
 B. M. 178.06 on east rim M.H. @ S.E. cor lot 8
 Blk. 8 Cherry Creek Hills Addn.

Plan Scale 1" = 40'
 Profile Scale 1" = 40' Horiz.
 1" = 5' Vert.

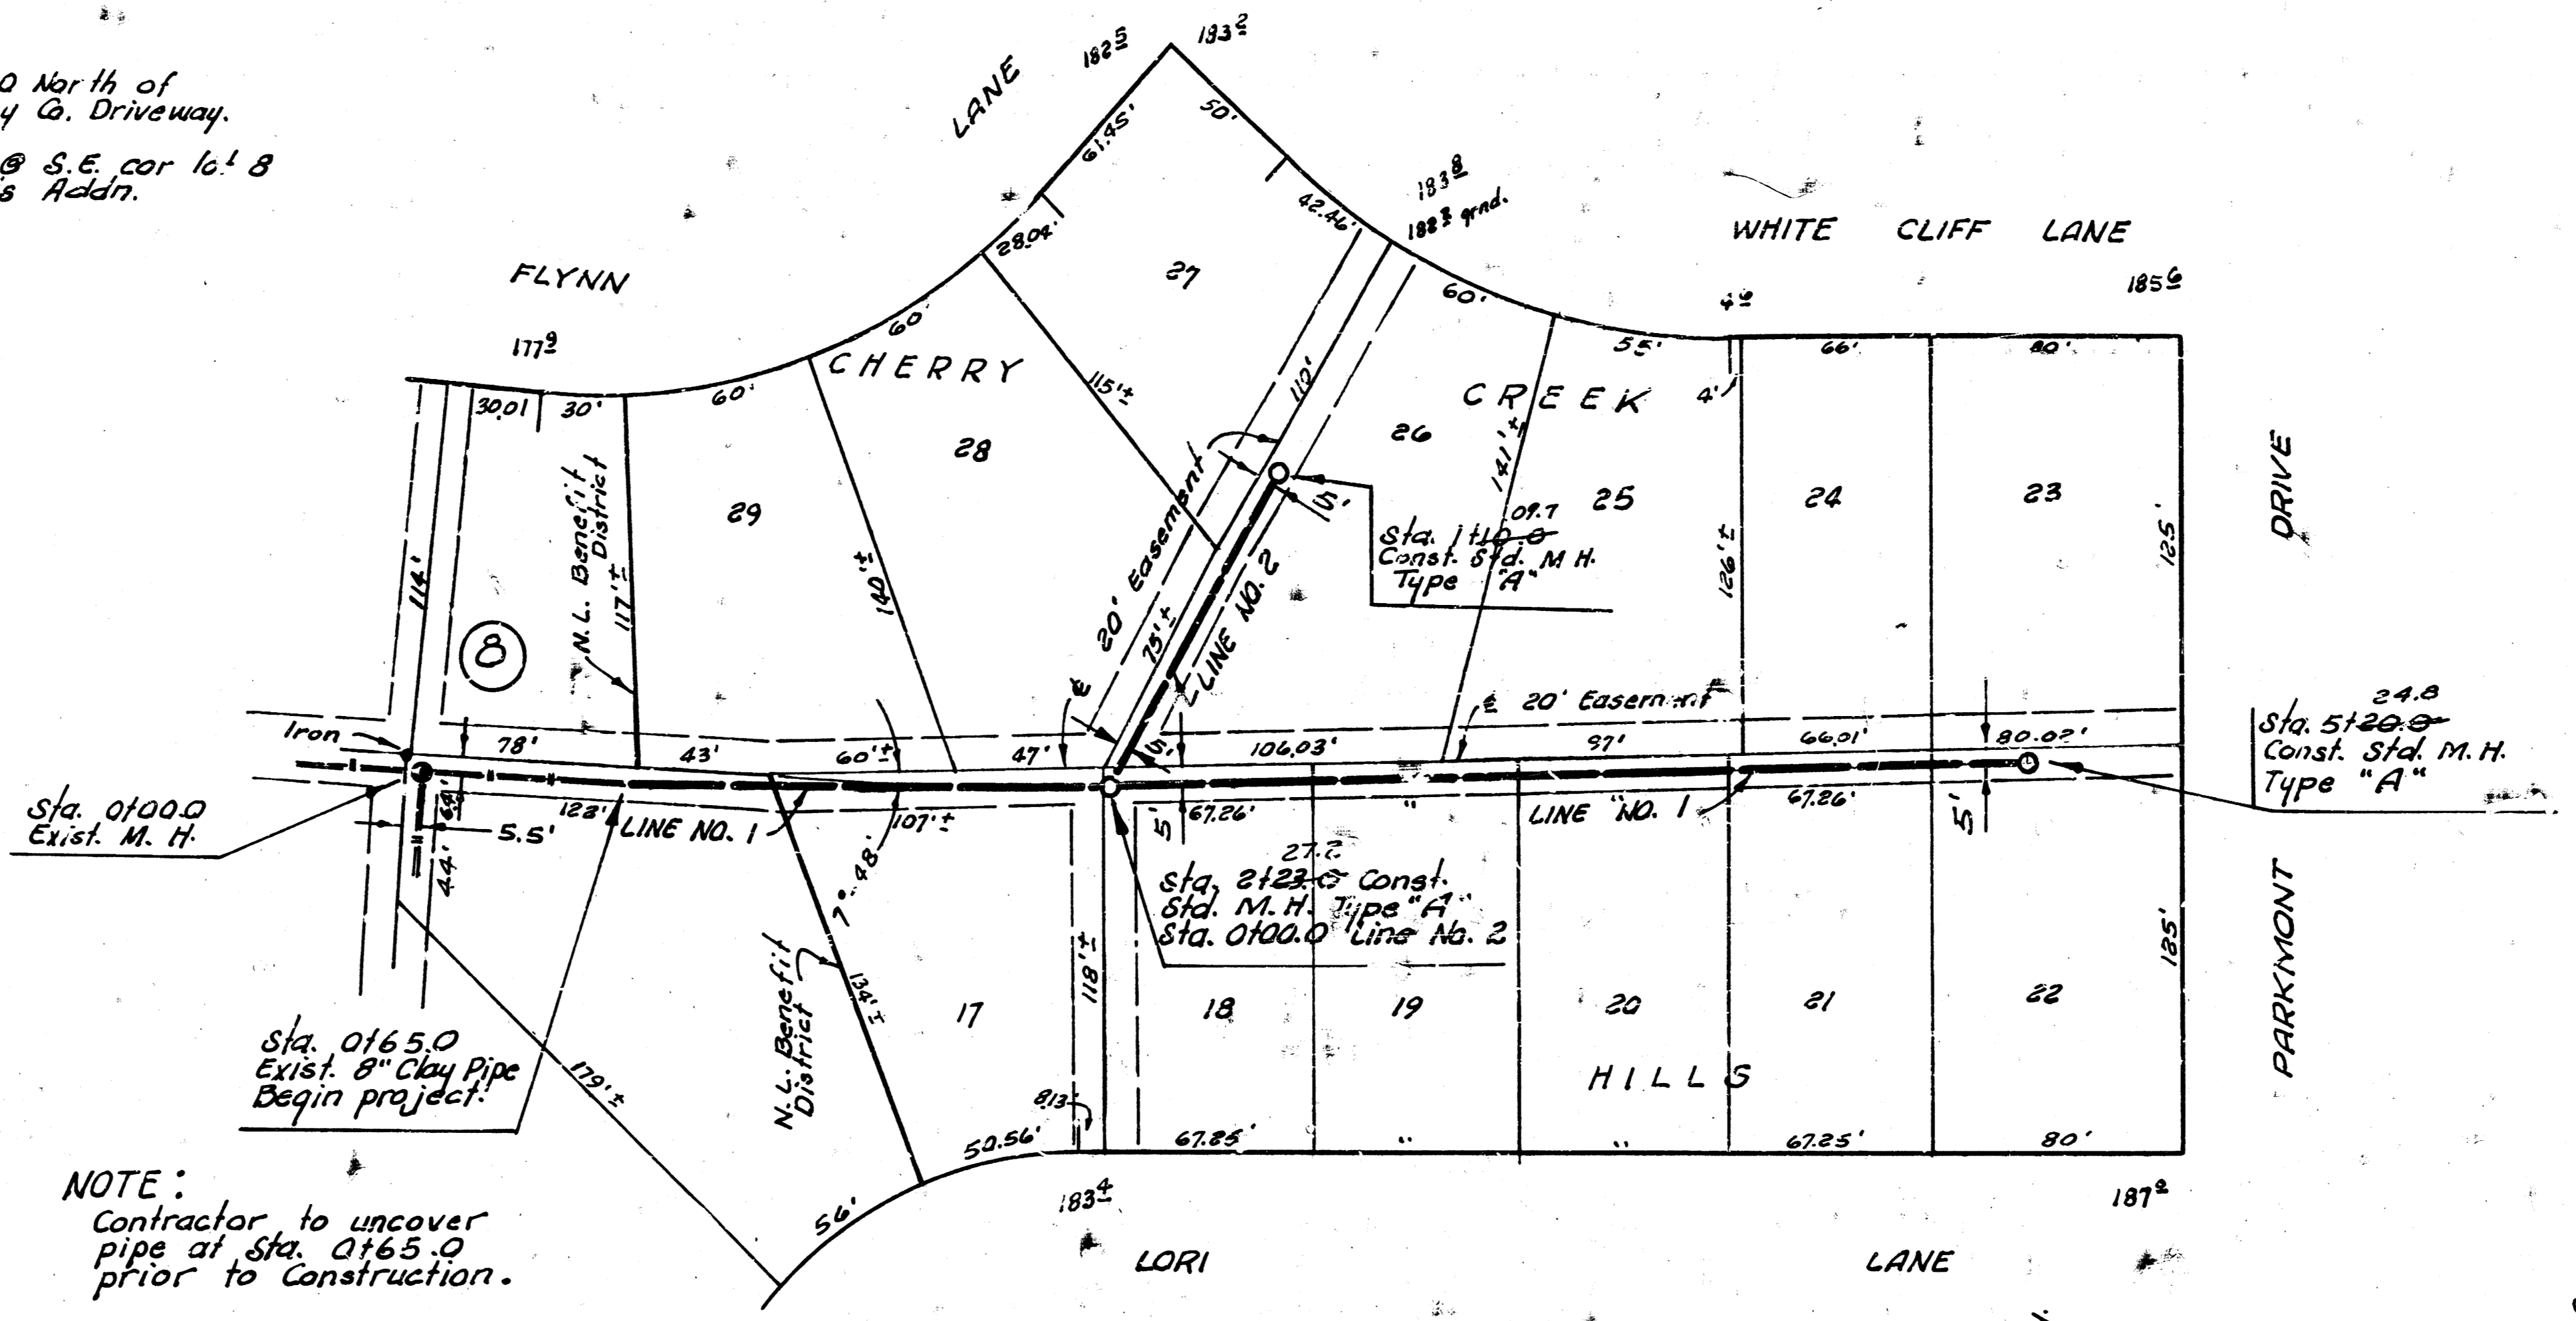

NOTE:
 Contractor to uncover
 pipe at Sta. 0165.0
 prior to construction.

185
 180
 175
 170
 165
 160

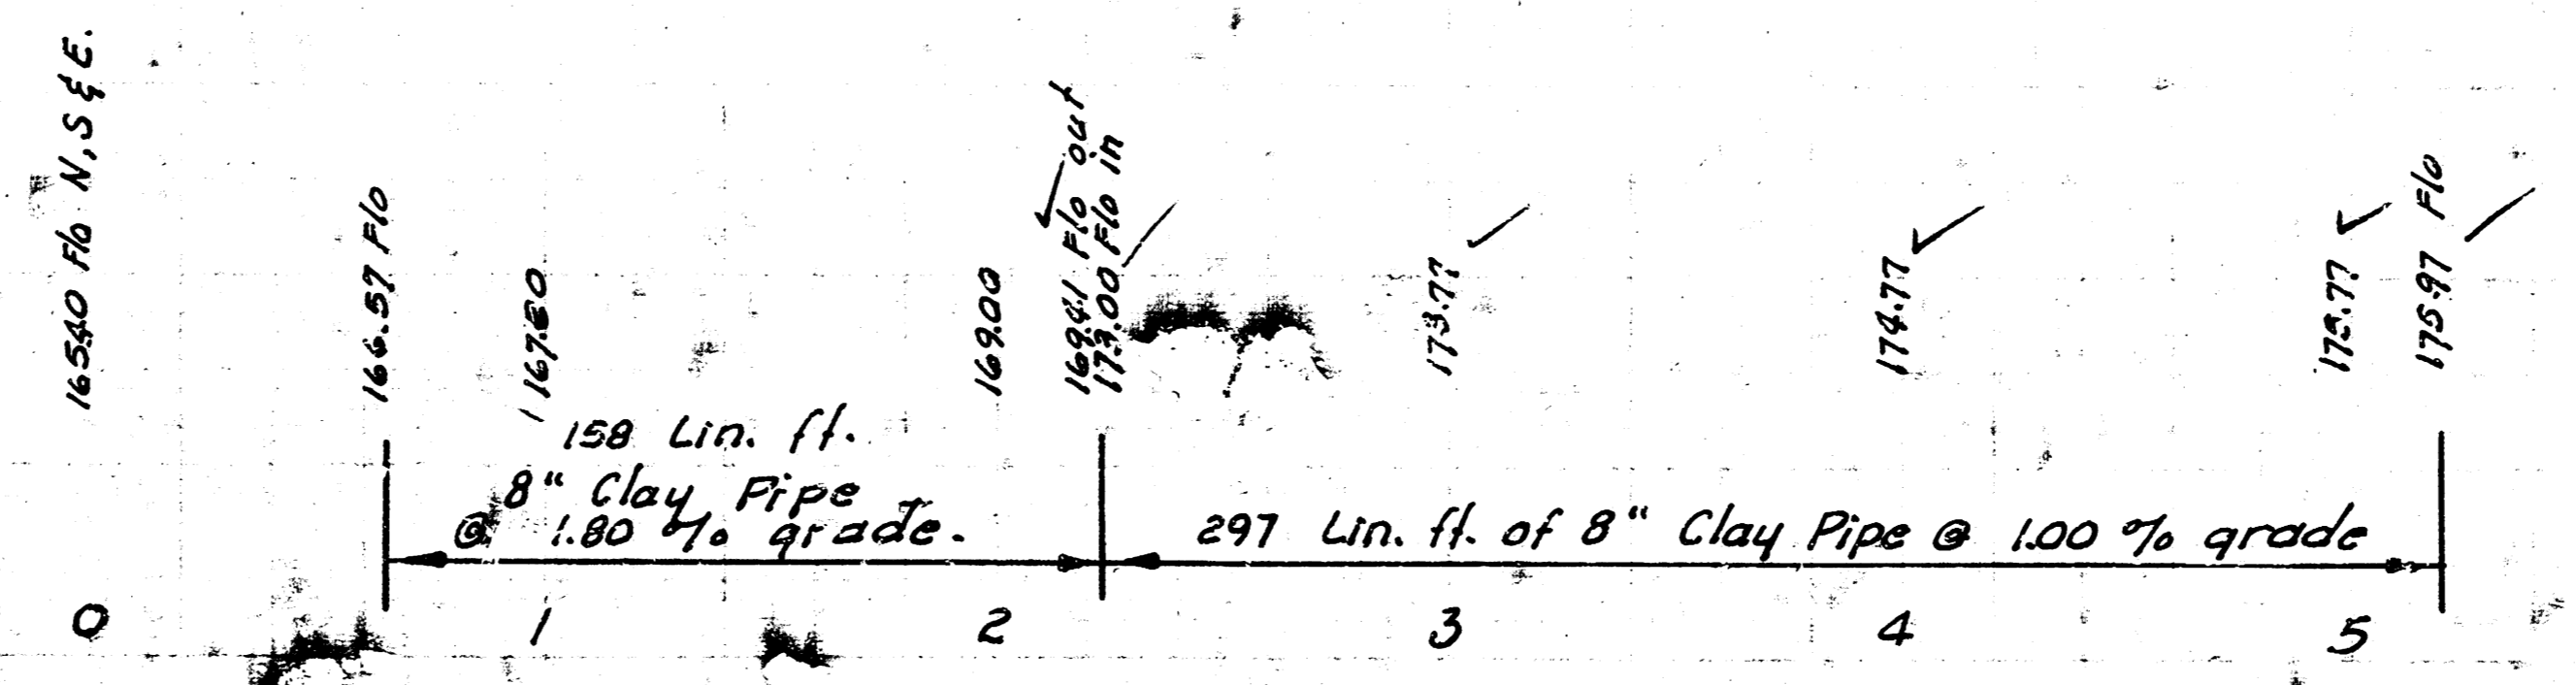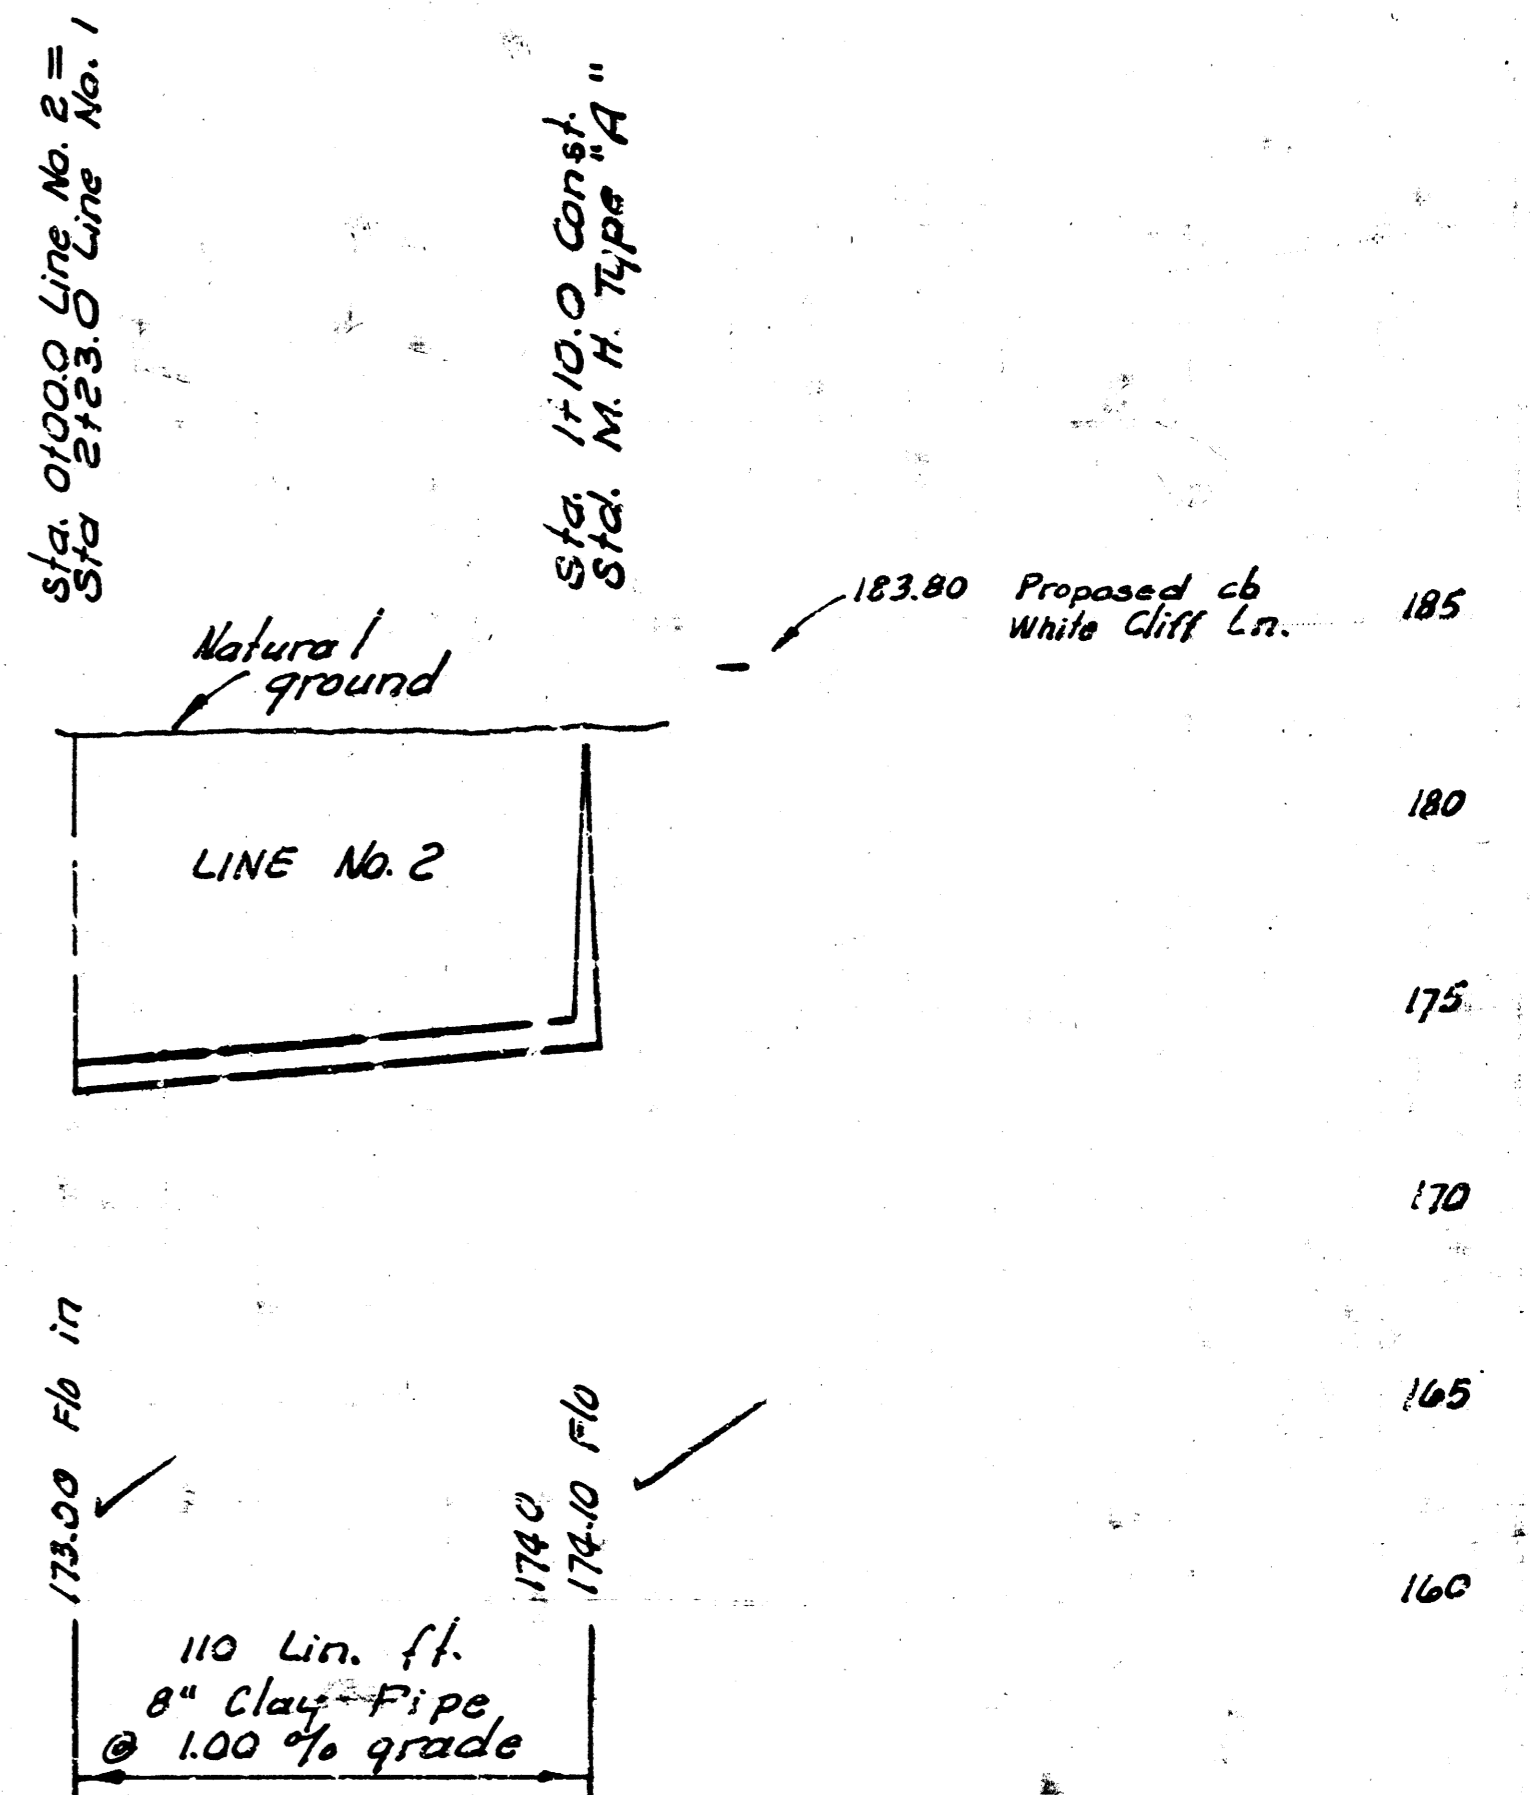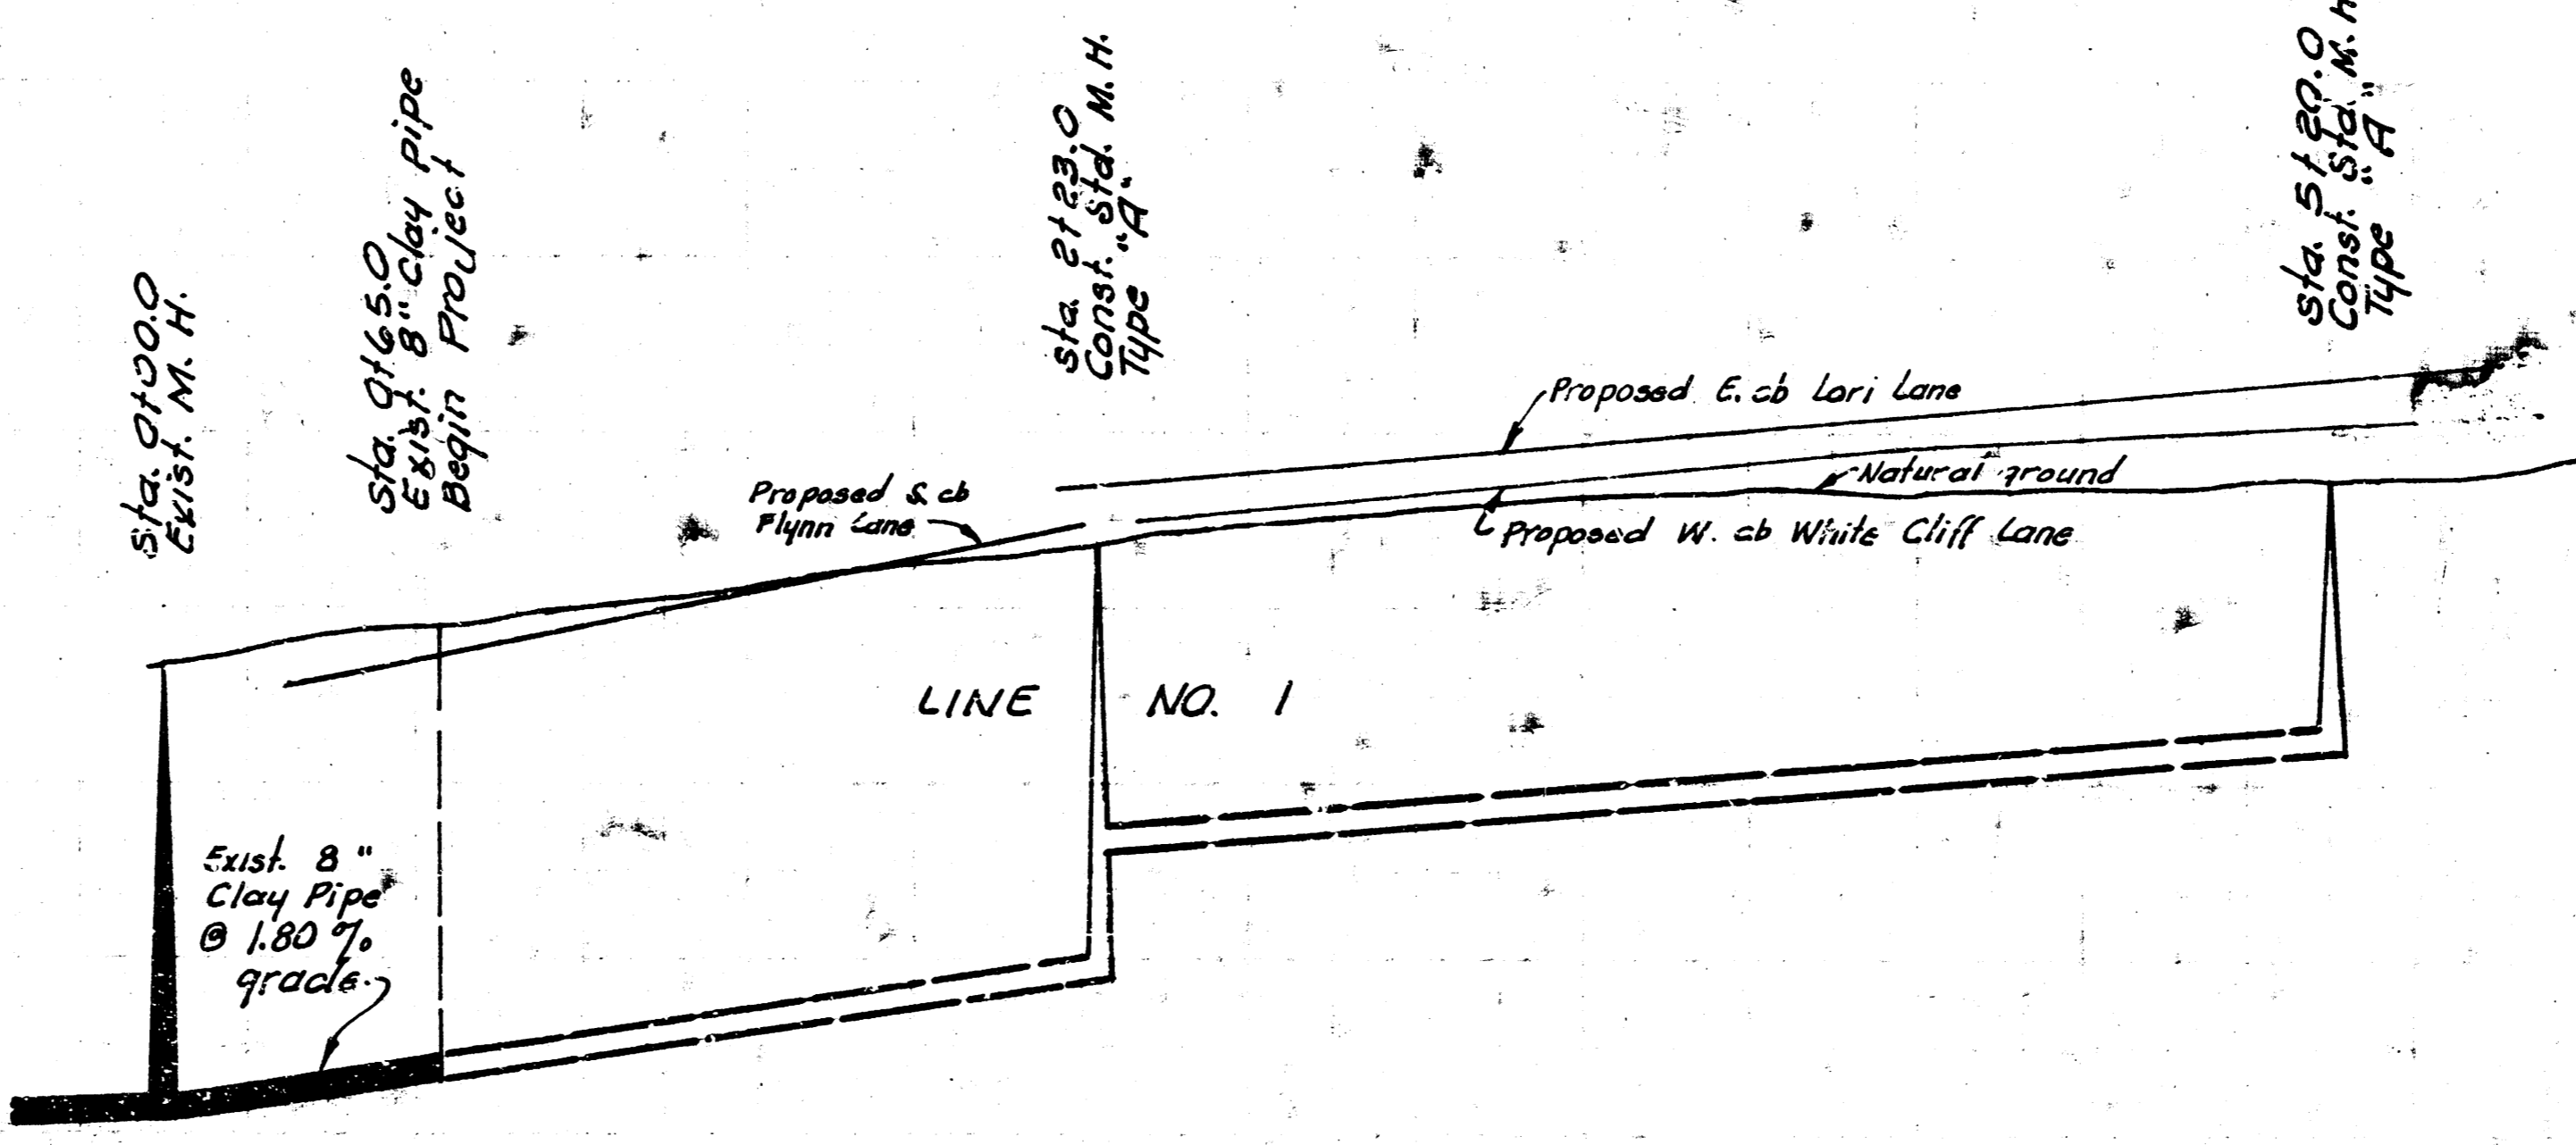

"As BUILT" FINAL MEAS. G-1
 LAT. 7, MAIN 17, W. I. S.
 CITY OF WICHITA, KANSAS
 R. W. LINN - CITY ENGINEER
 MAY 1974 PROJECT NO. DBKL573018

FILMED FROM THE BEST
 AVAILABLE COPY