


B. M. 153.50 "a" cut NW cor. N-Wing wall on top of dam app. 130' S. of Lakeland Circle.
 B. M. 144.53 Top steel T. Pnc. P 30' N. of N.L. Longford Lane & E.L. Cedar Lakes Adm.

Plan Scale 1" = 40' Horz.
 Profile Scale 1" = 5' Vert.


NOTE:
 Tie Conc. Cradle to manholes with 4 - 3" # 4 Steel bars.
 Bid price of Lin. ft. of conc. Cradle is to include the steel.
 Conc. Cradle may be deleted with the approval of the field Engineer.

NOTE:
 The bid price of Lump Sum Clearing Right-of-Way to include all cost of removing trees, Hedggs, Stumps and any other items in the way of the construction of the sewer.

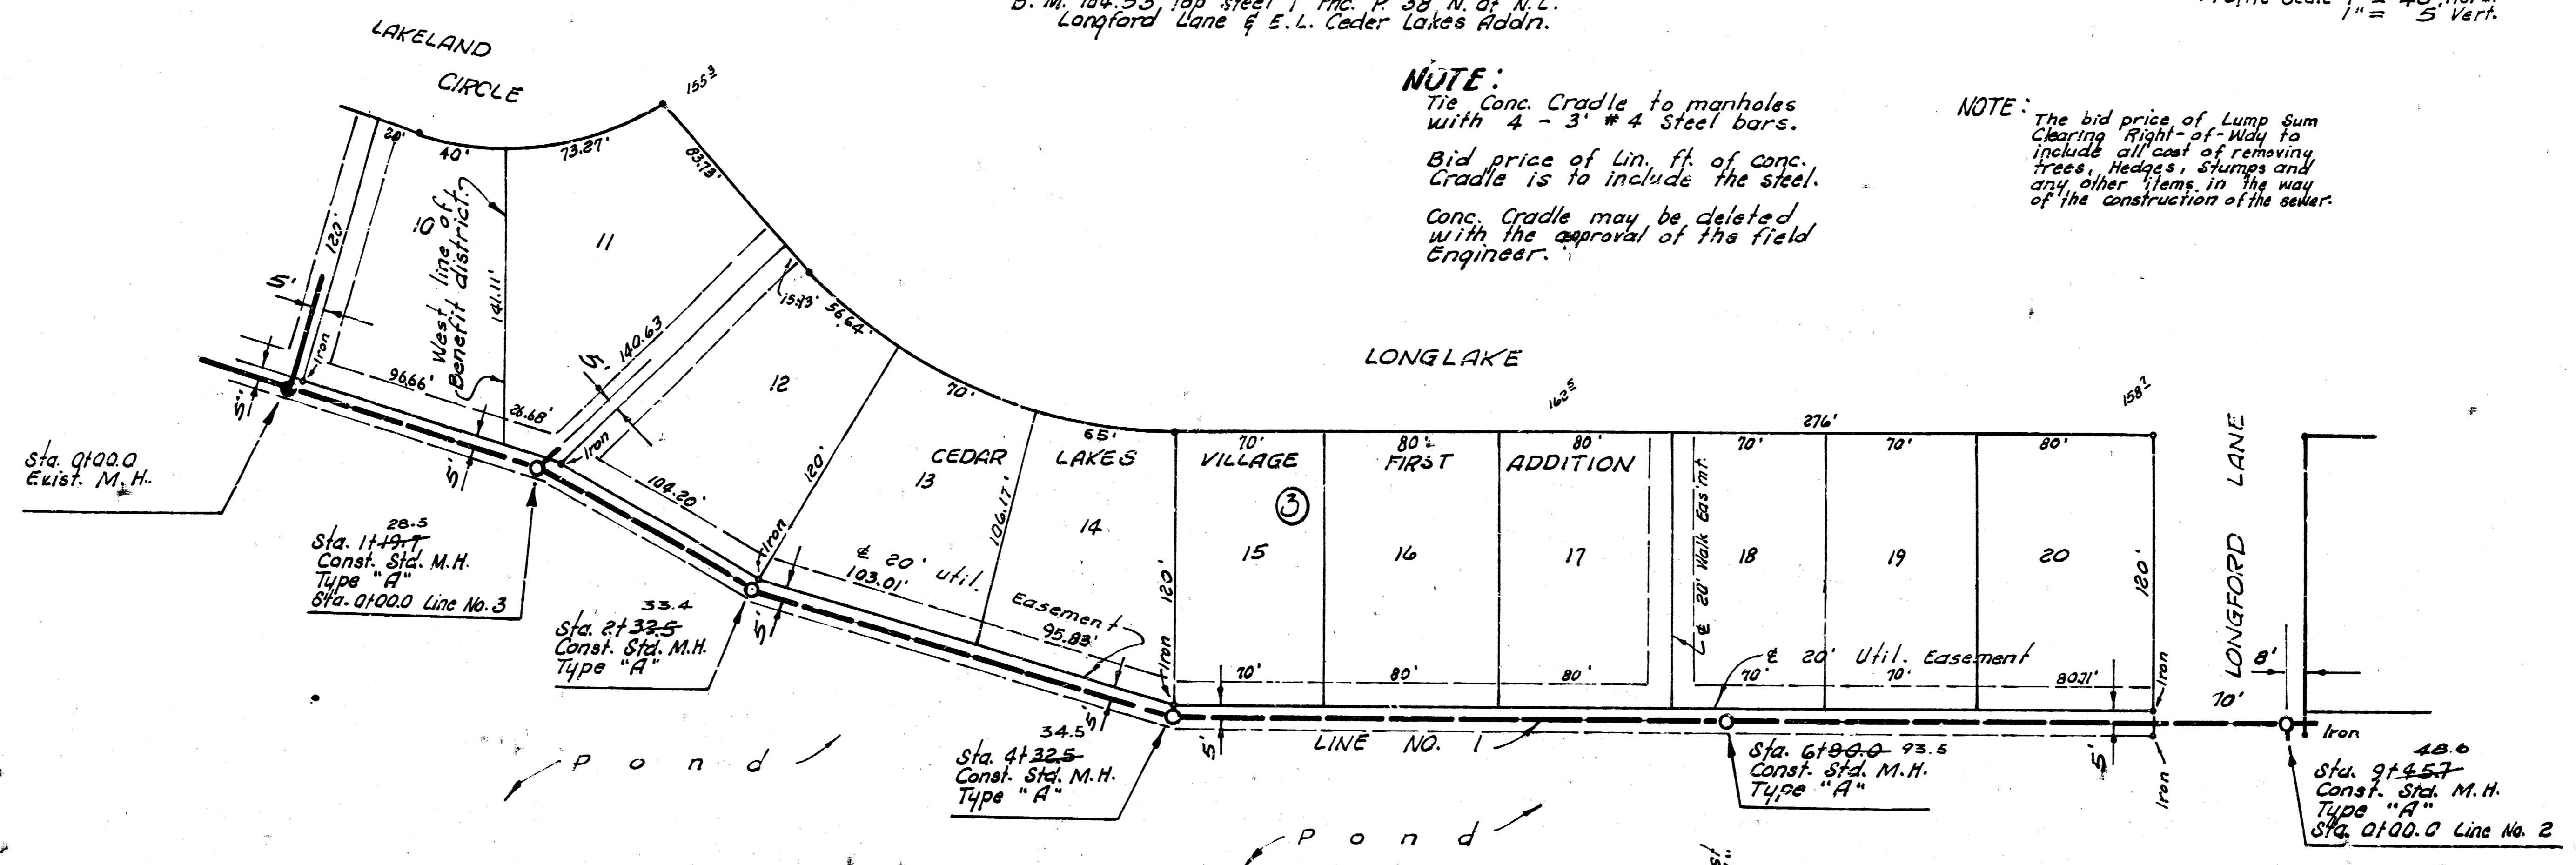

u. R. Rev.



165
160
155
150
145
140
135

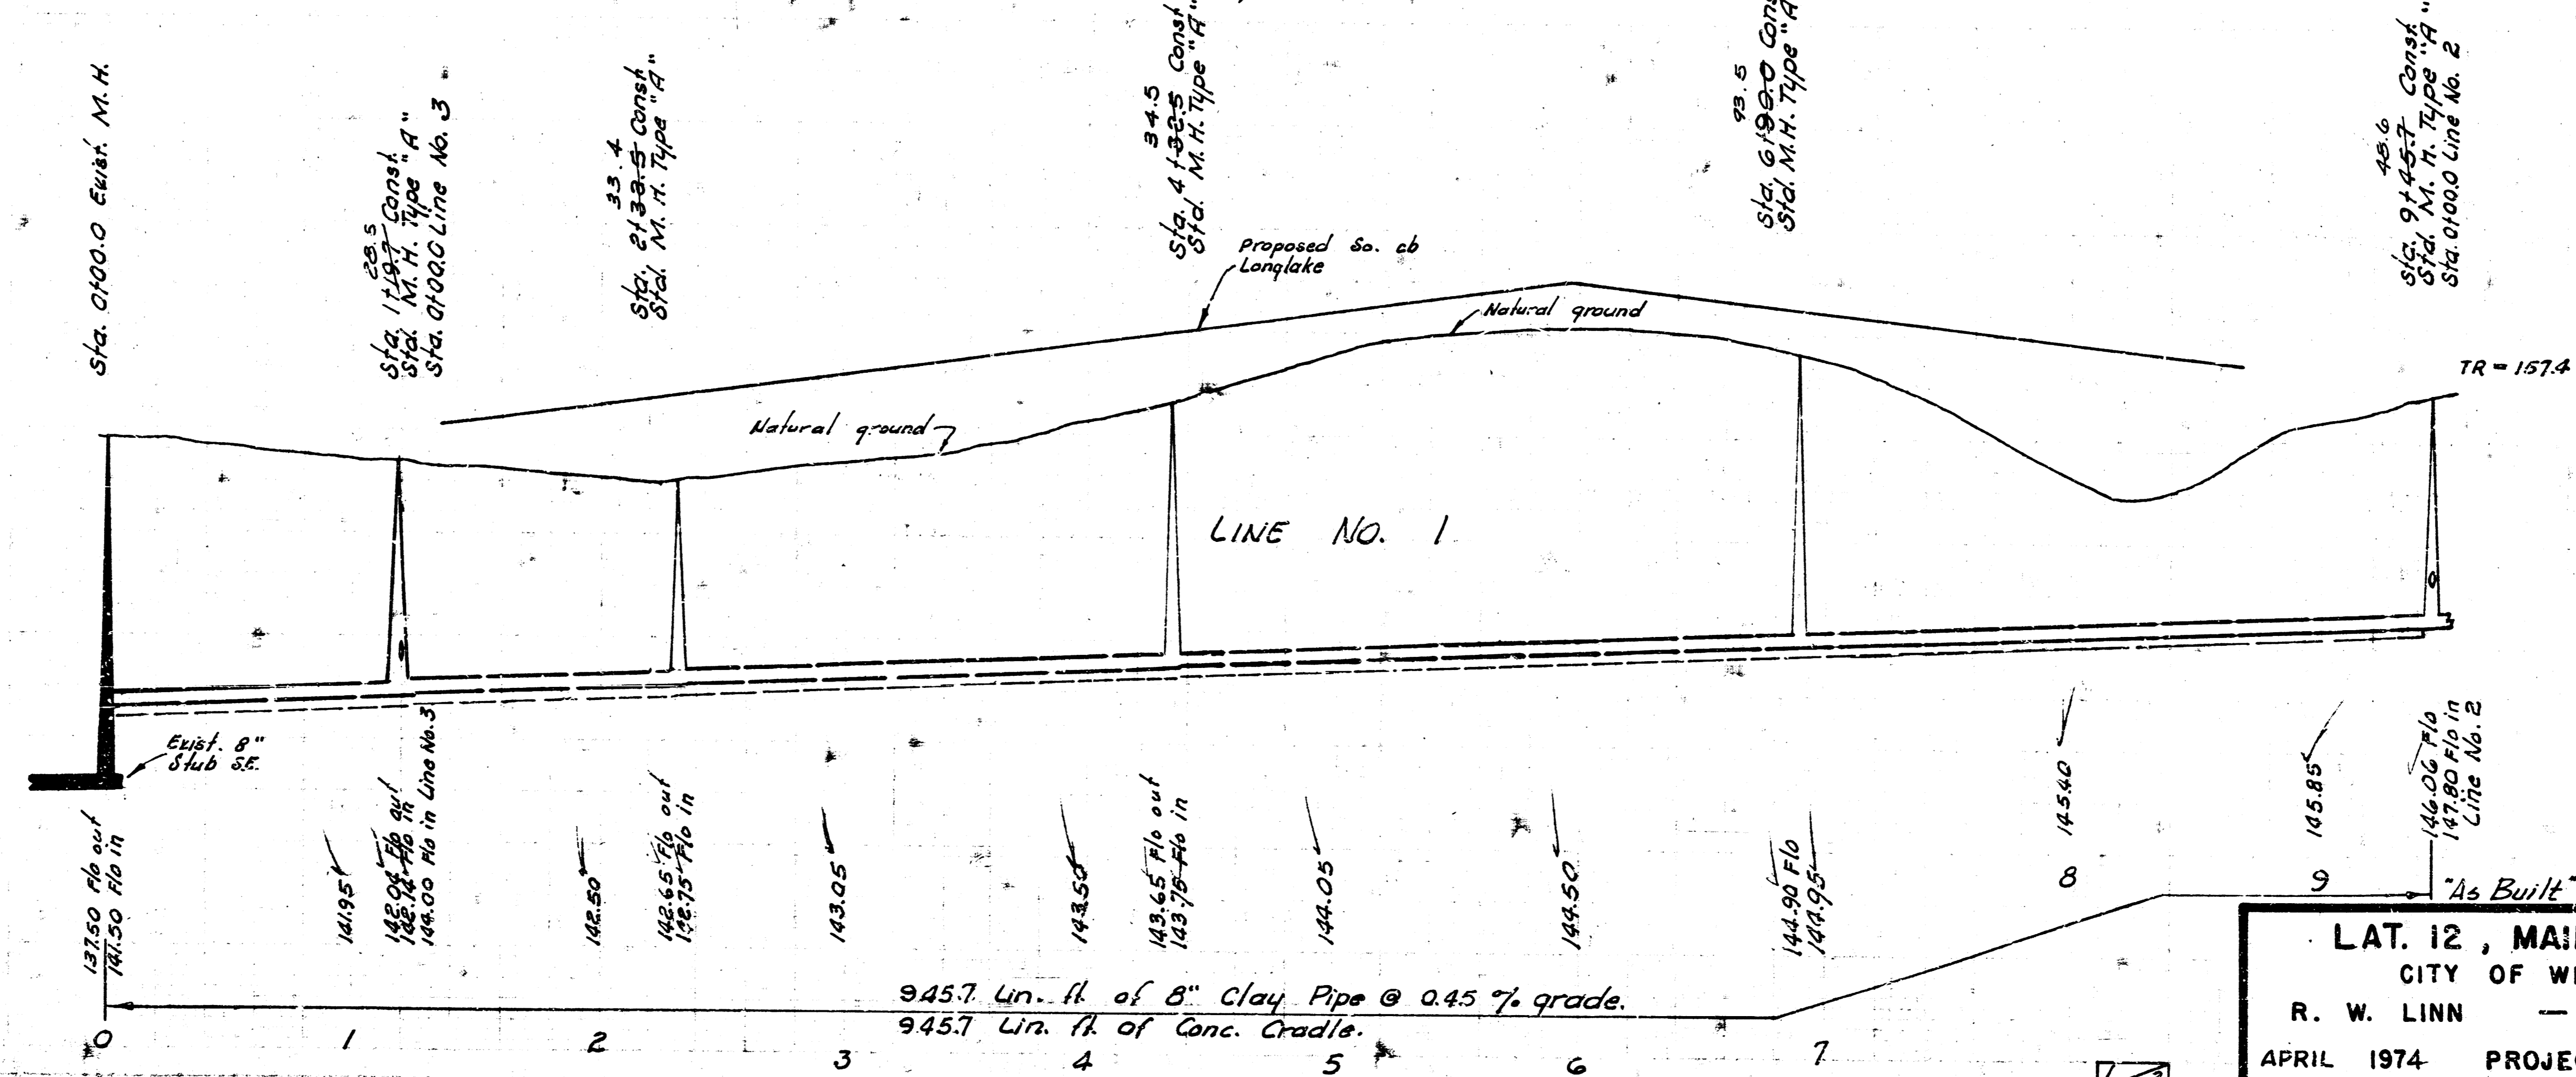



LAT. 12, MAIN 17, W. I. S.
 CITY OF WICHITA, KANSAS
 R. W. LINN — CITY ENGINEER
 APRIL 1974 PROJECT NO. DBKL 5730



FILMED FROM THE BEST AVAILABLE COPY

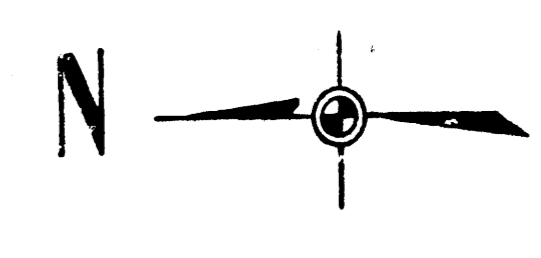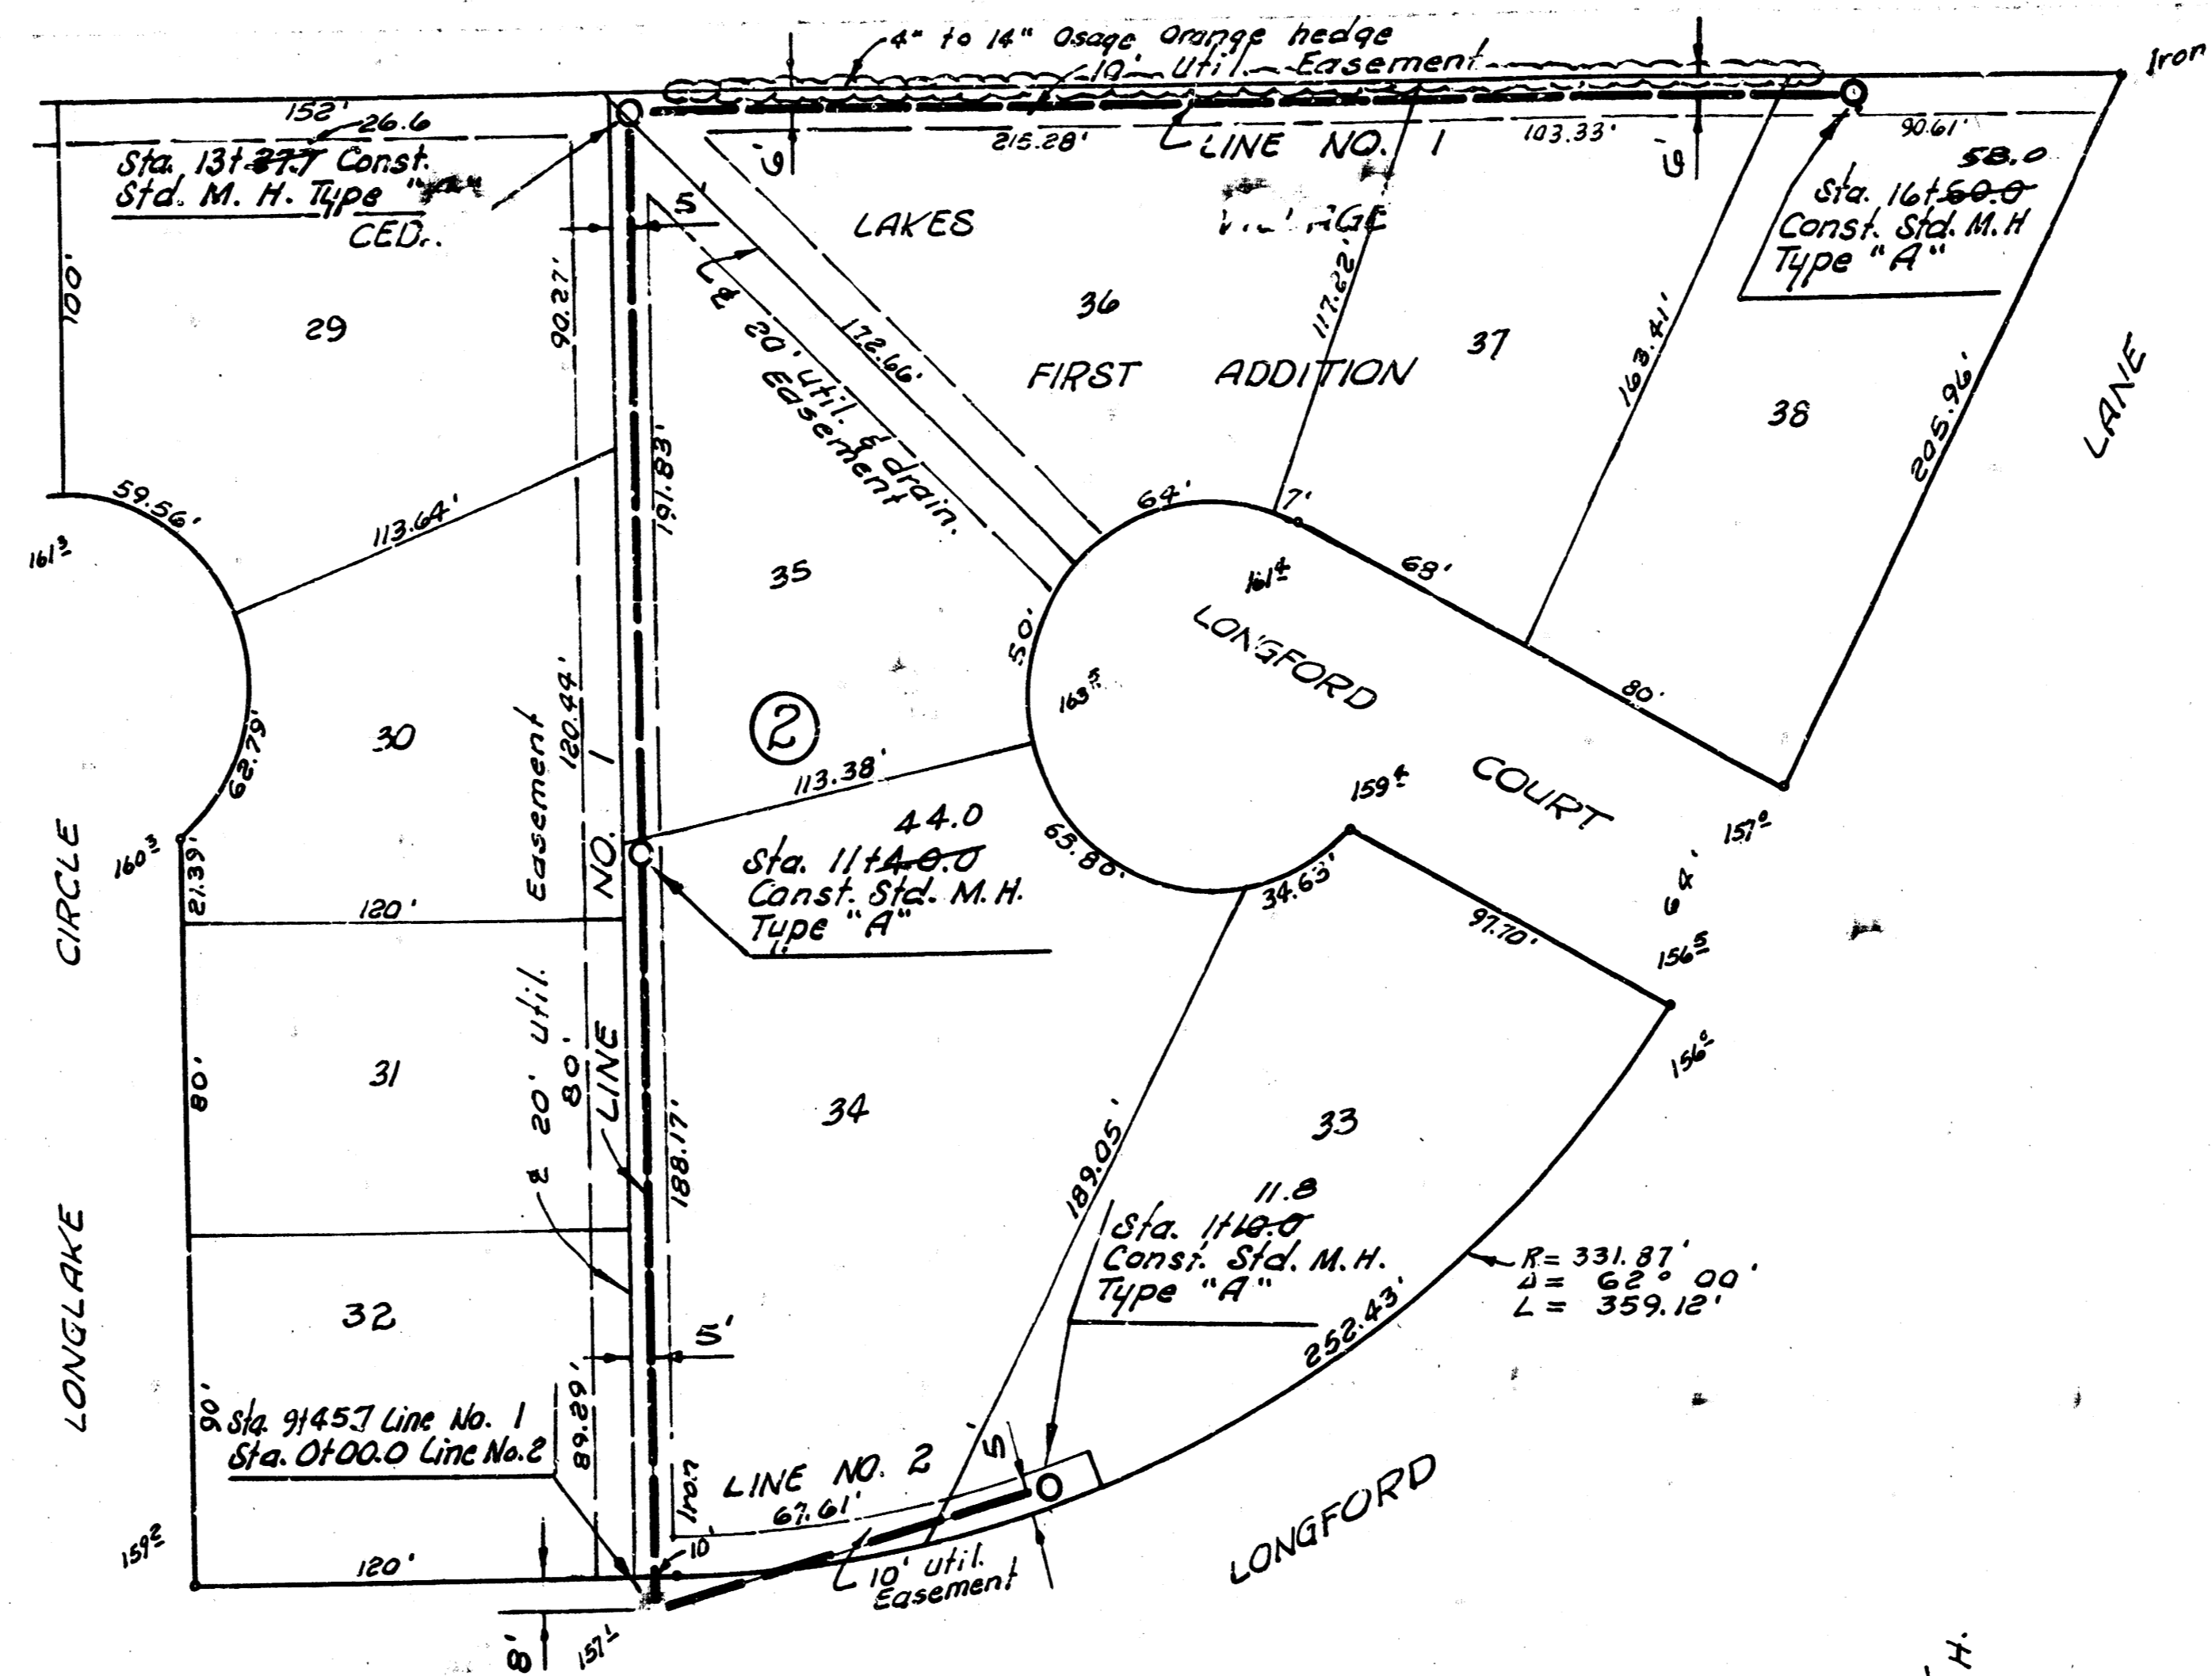

165
160
155
150
145
140

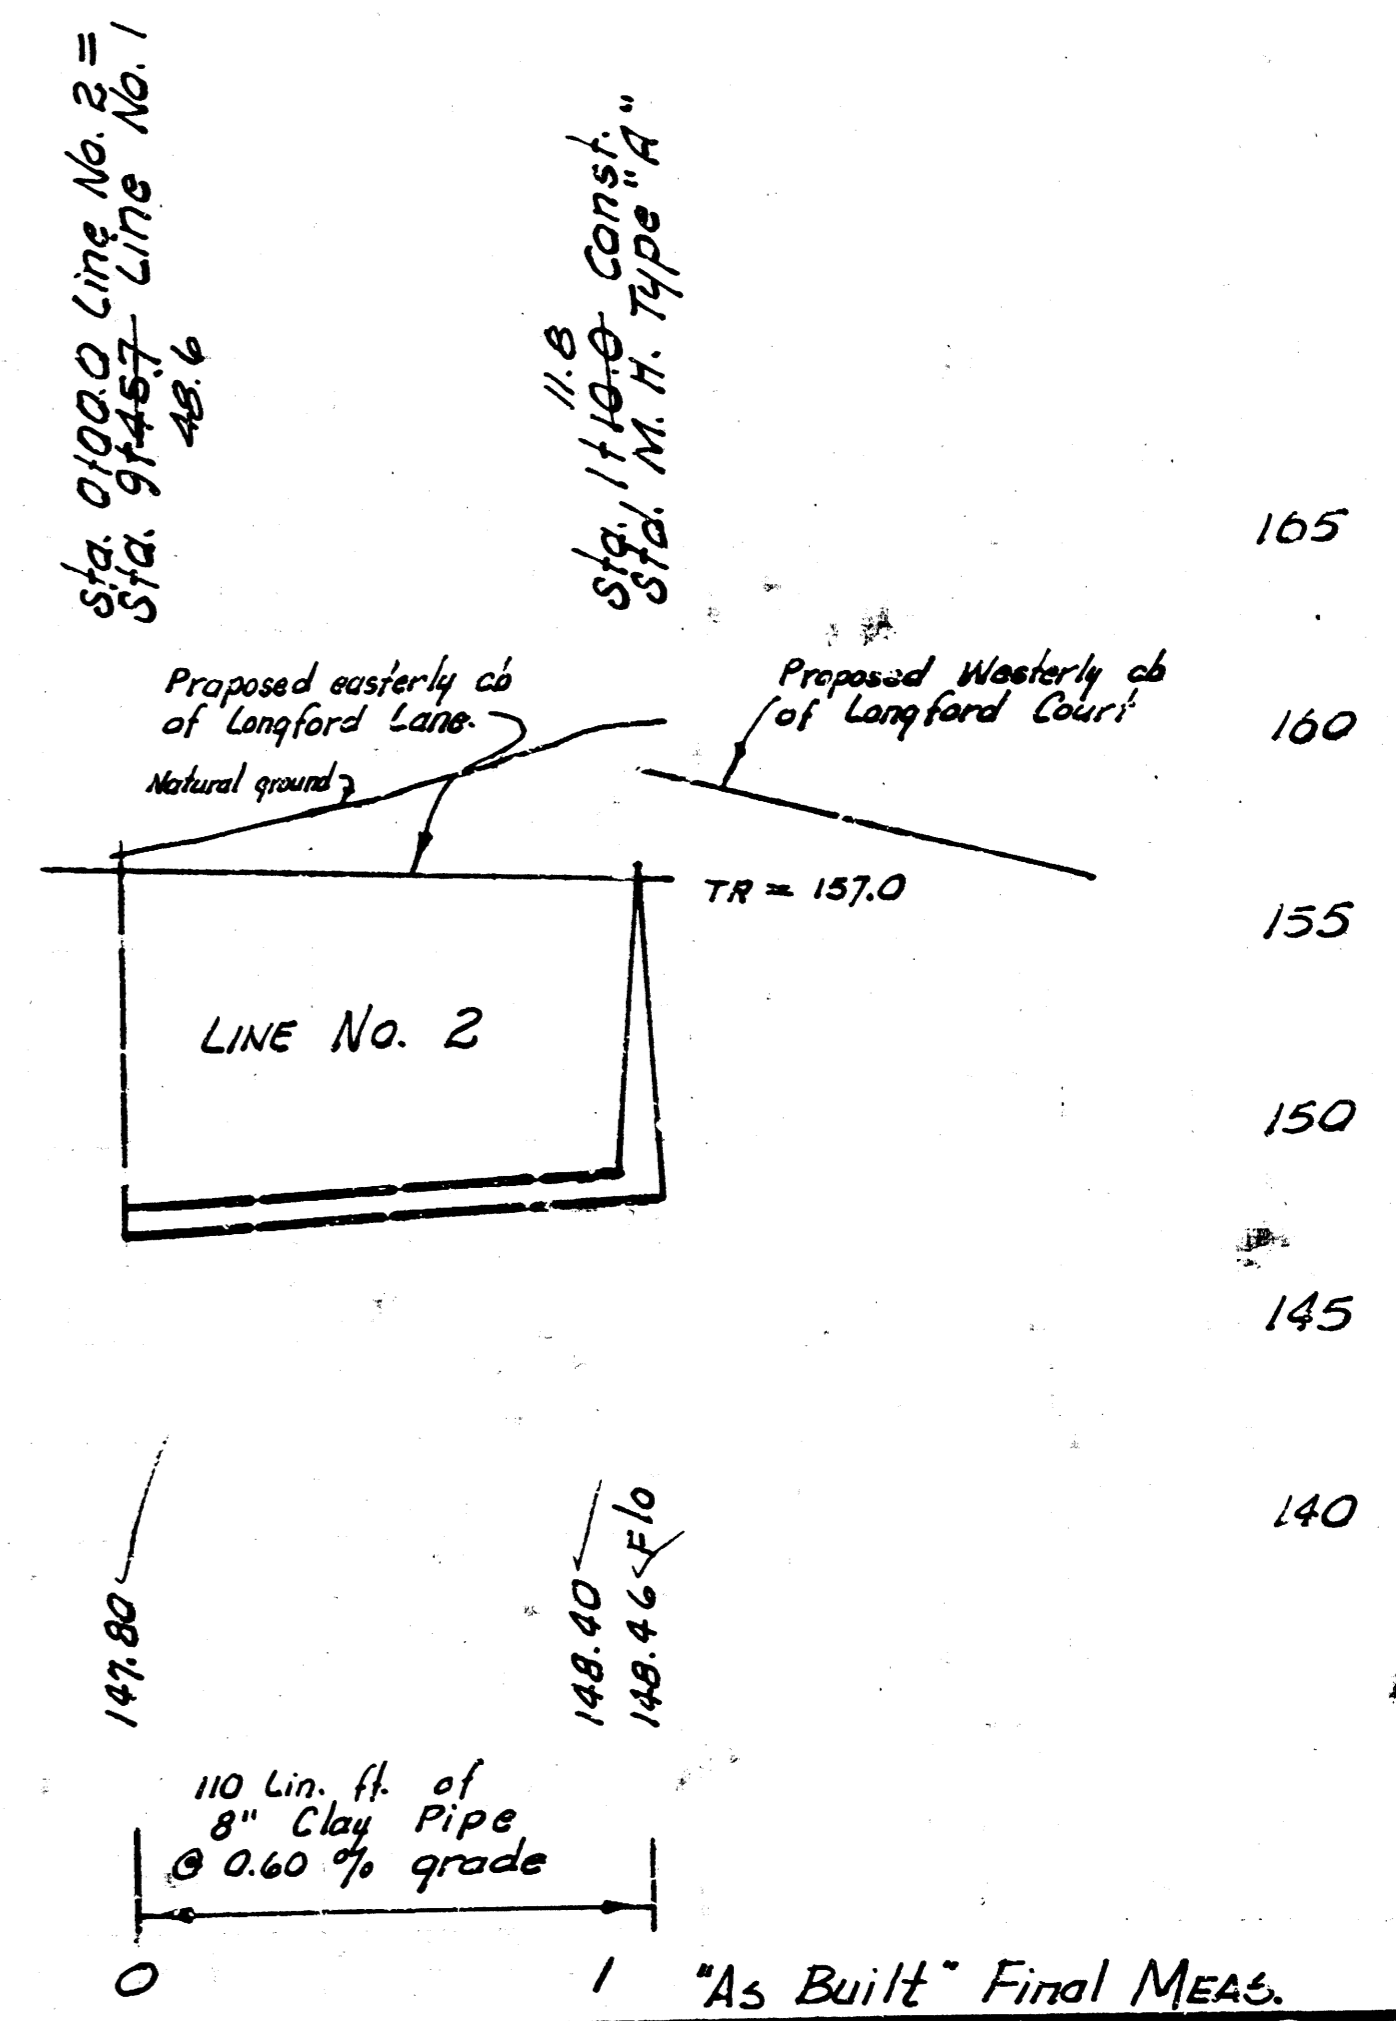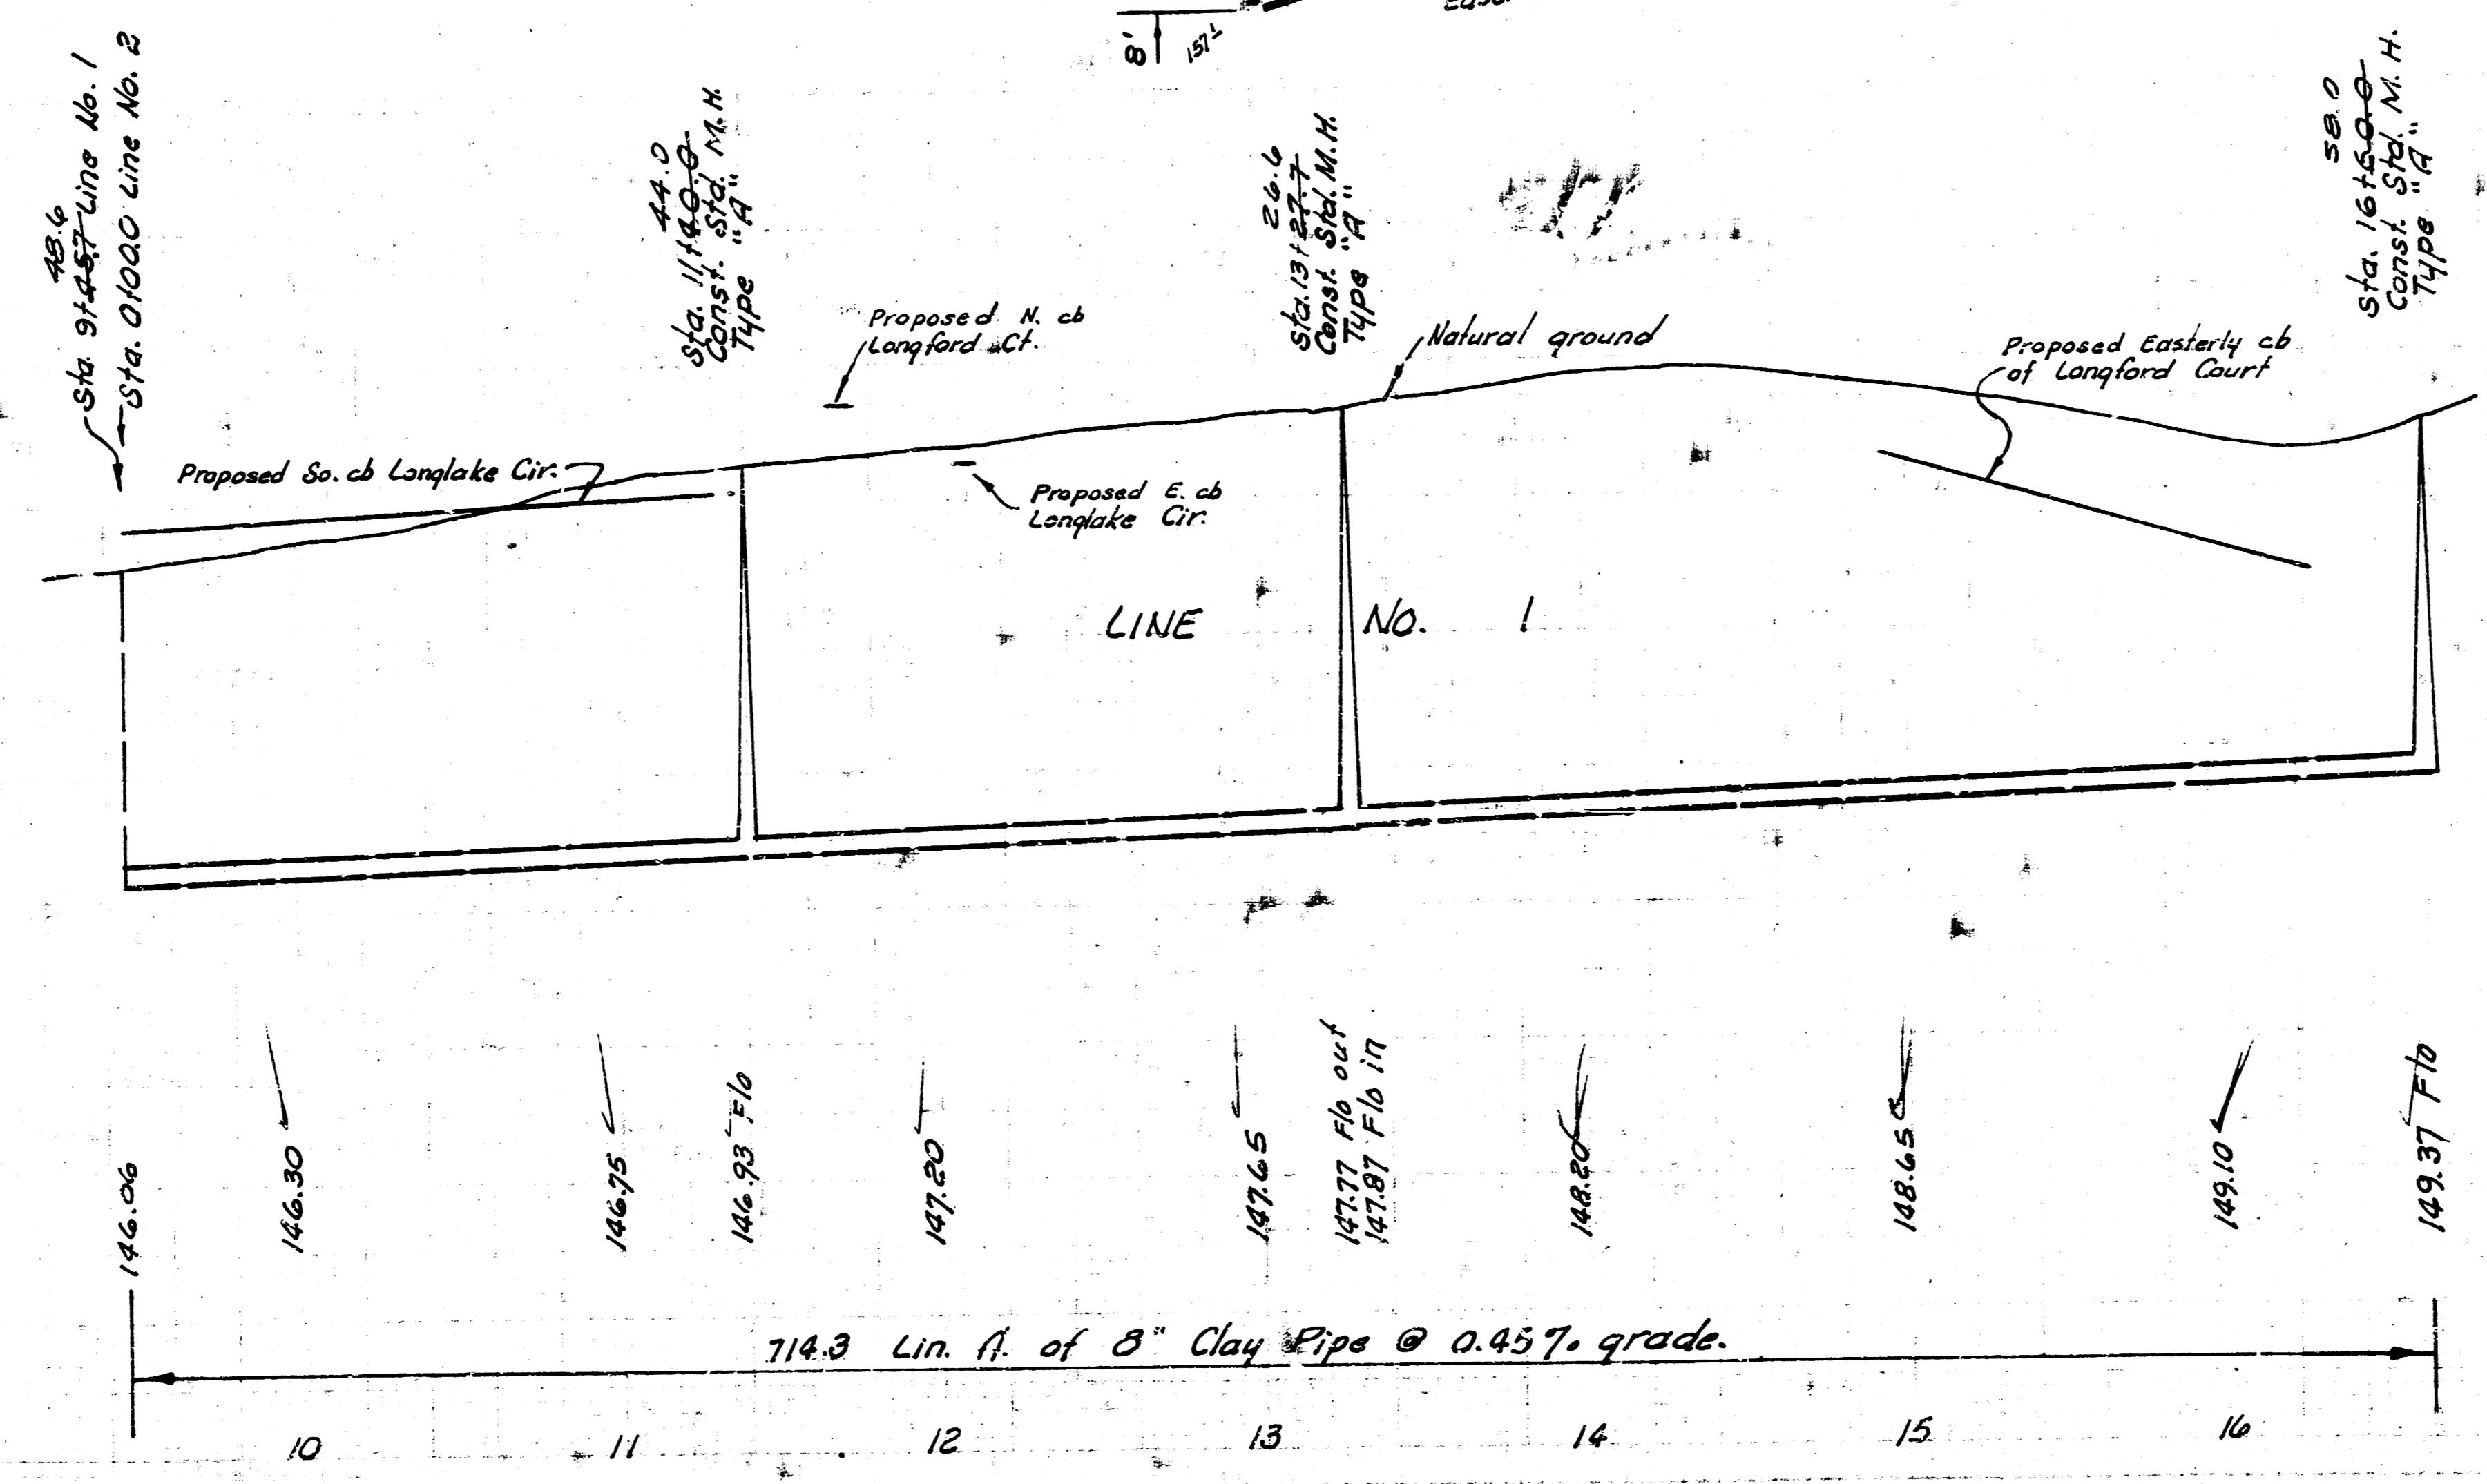

1 "As Built" Final MEAS.
LAT. 12, MAIN 17, W. I. S. 3/3
PROJECT NO. DBKL 573 04 5

