
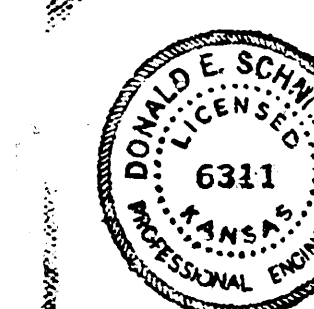
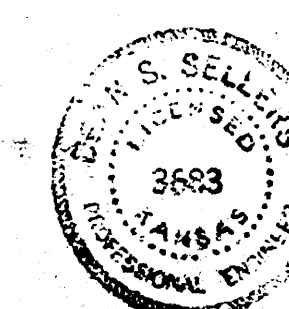
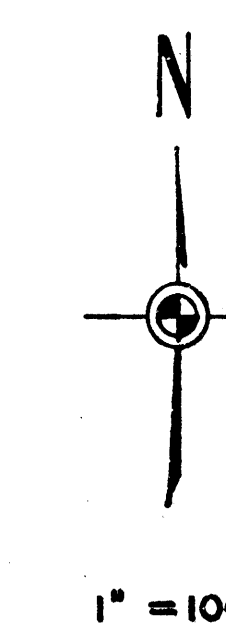


LAT. 16, MAIN 17, WAR INDUSTRIES SEWER
CITY OF WICHITA, KANSAS
R. W. LINN - CITY ENGINEER
JAN. 1974, PROJECT NO. DBKL 573082

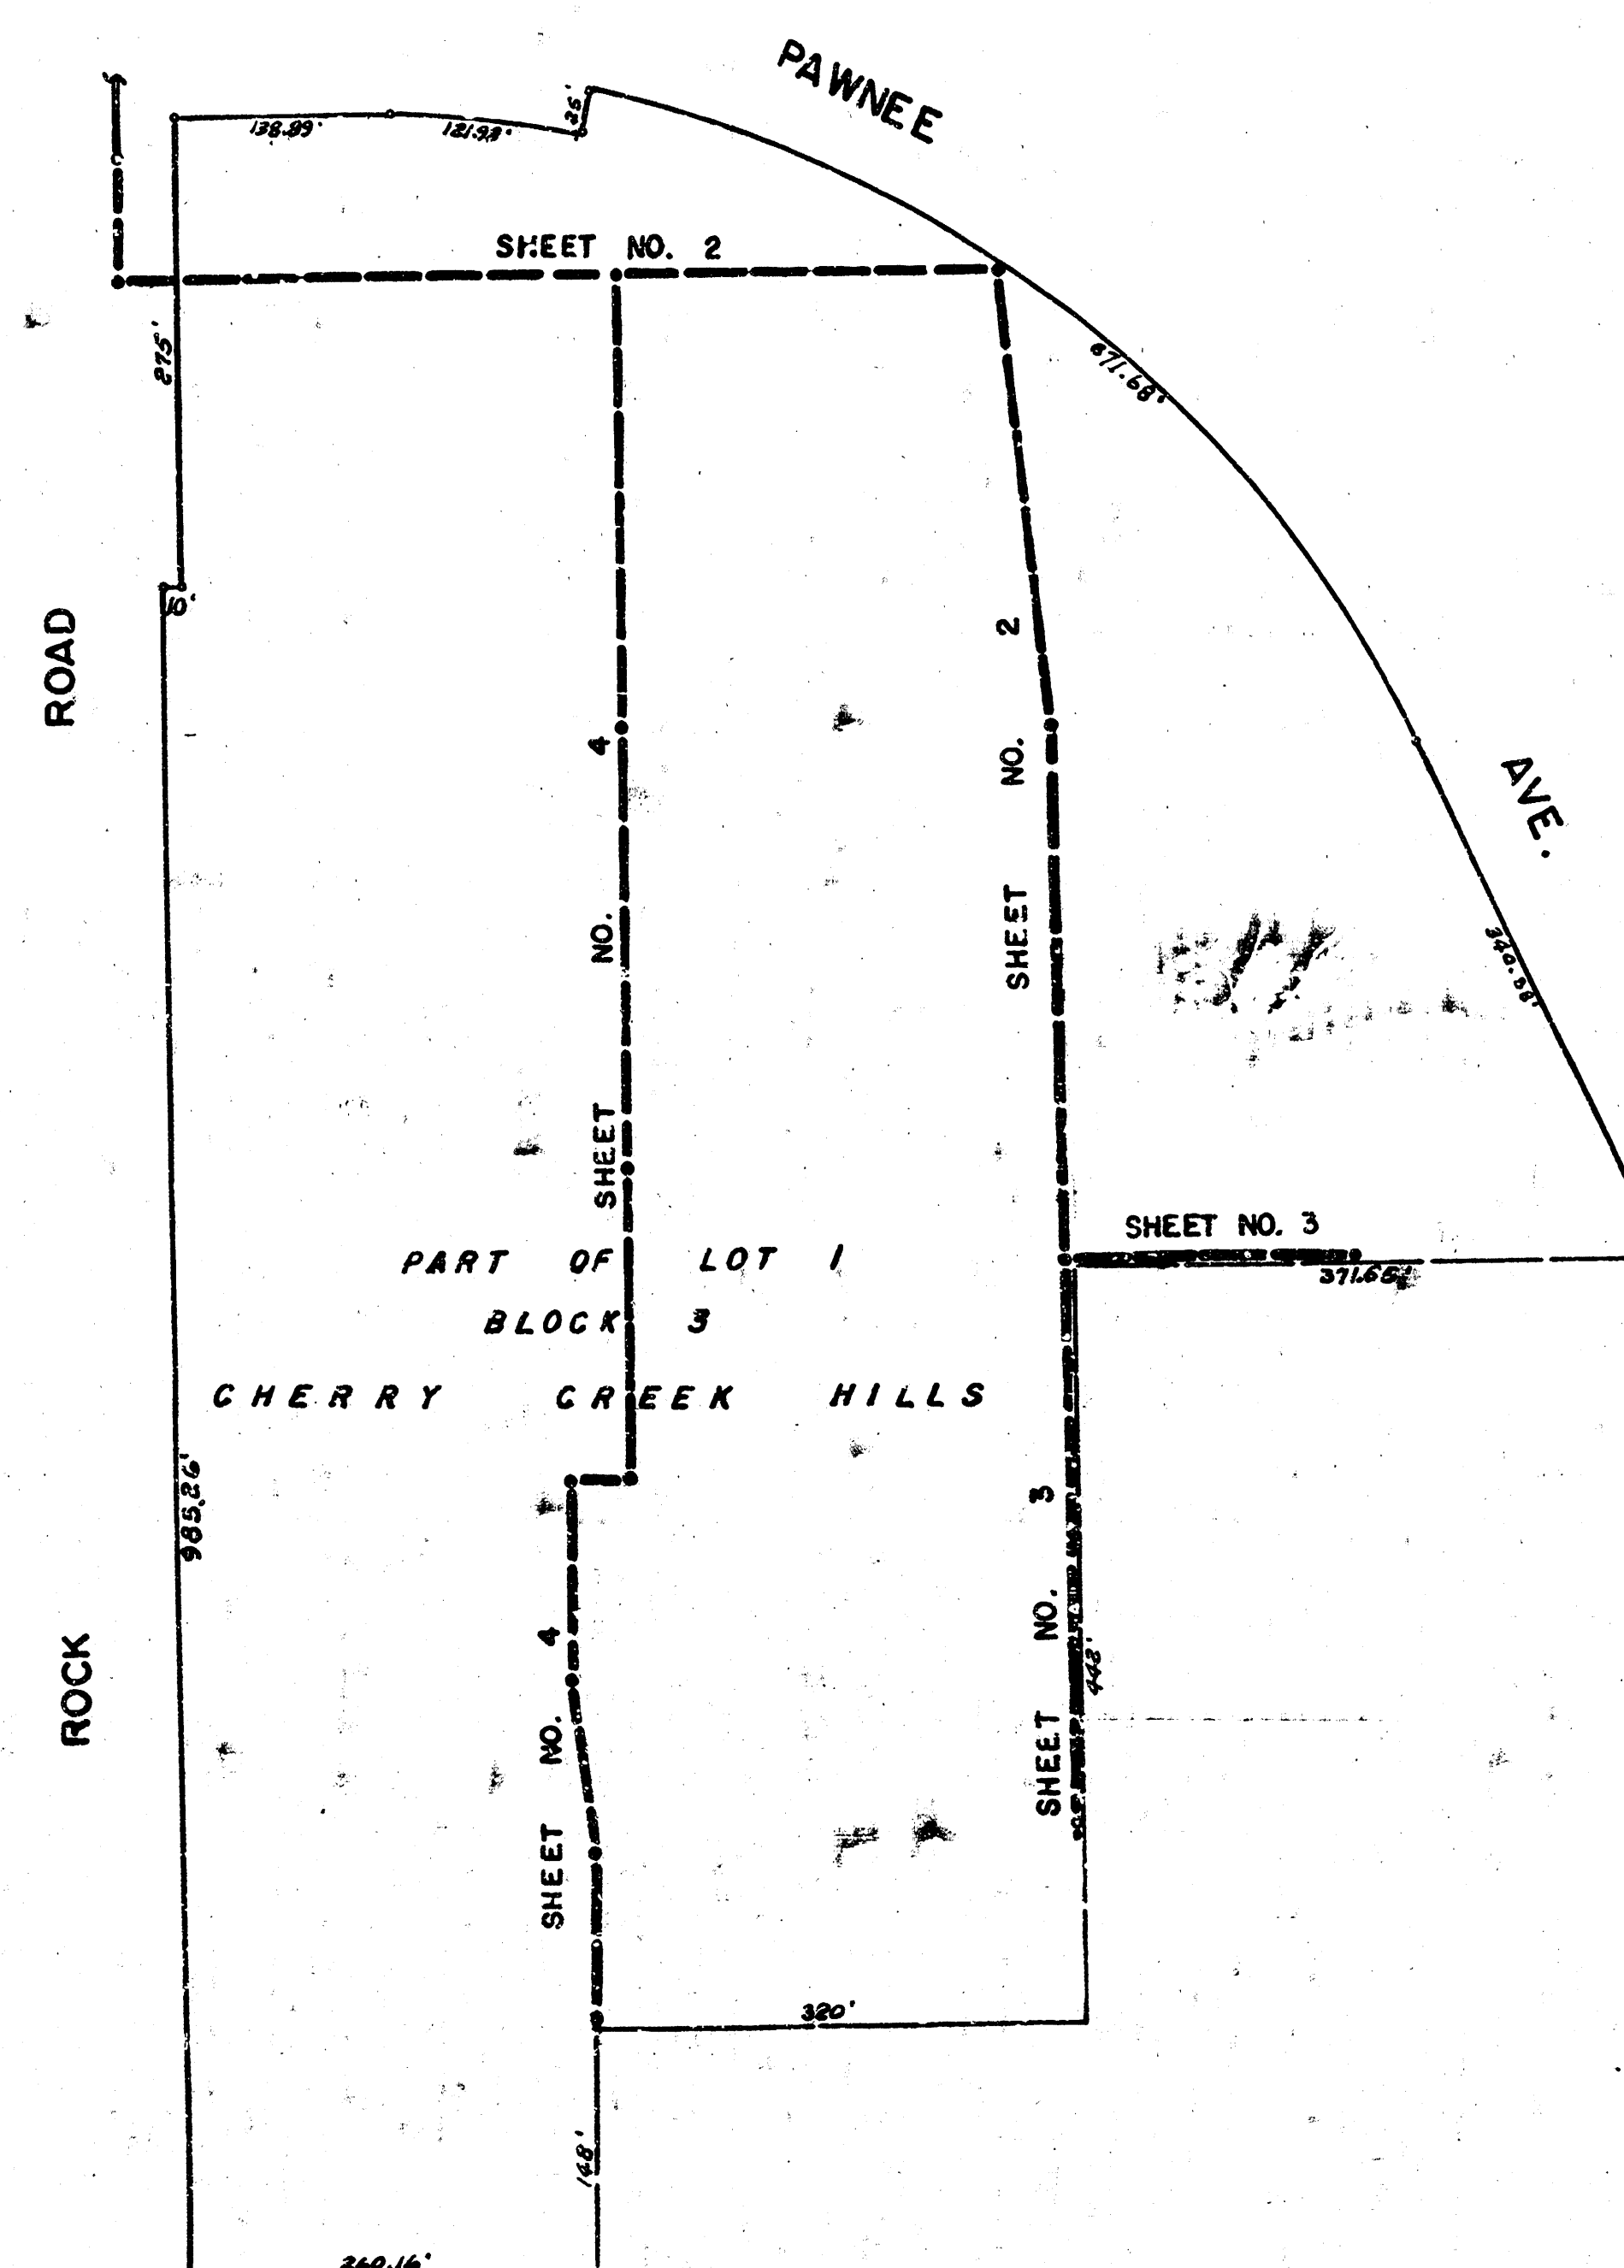

AS Built Final Meas. 9-E

LAT. 16, MAIN 17, W. I. S.
PROJECT NO. DBKL573082

FILMED FROM THE BEST
AVAILABLE COPY

