


LAT. 16, MAIN 17, WAR INDUSTRIES SEWER
CITY OF WICHITA, KANSAS
R. W. LINN — CITY ENGINEER
JAN. 1974, PROJECT NO. DBKL 57 3082

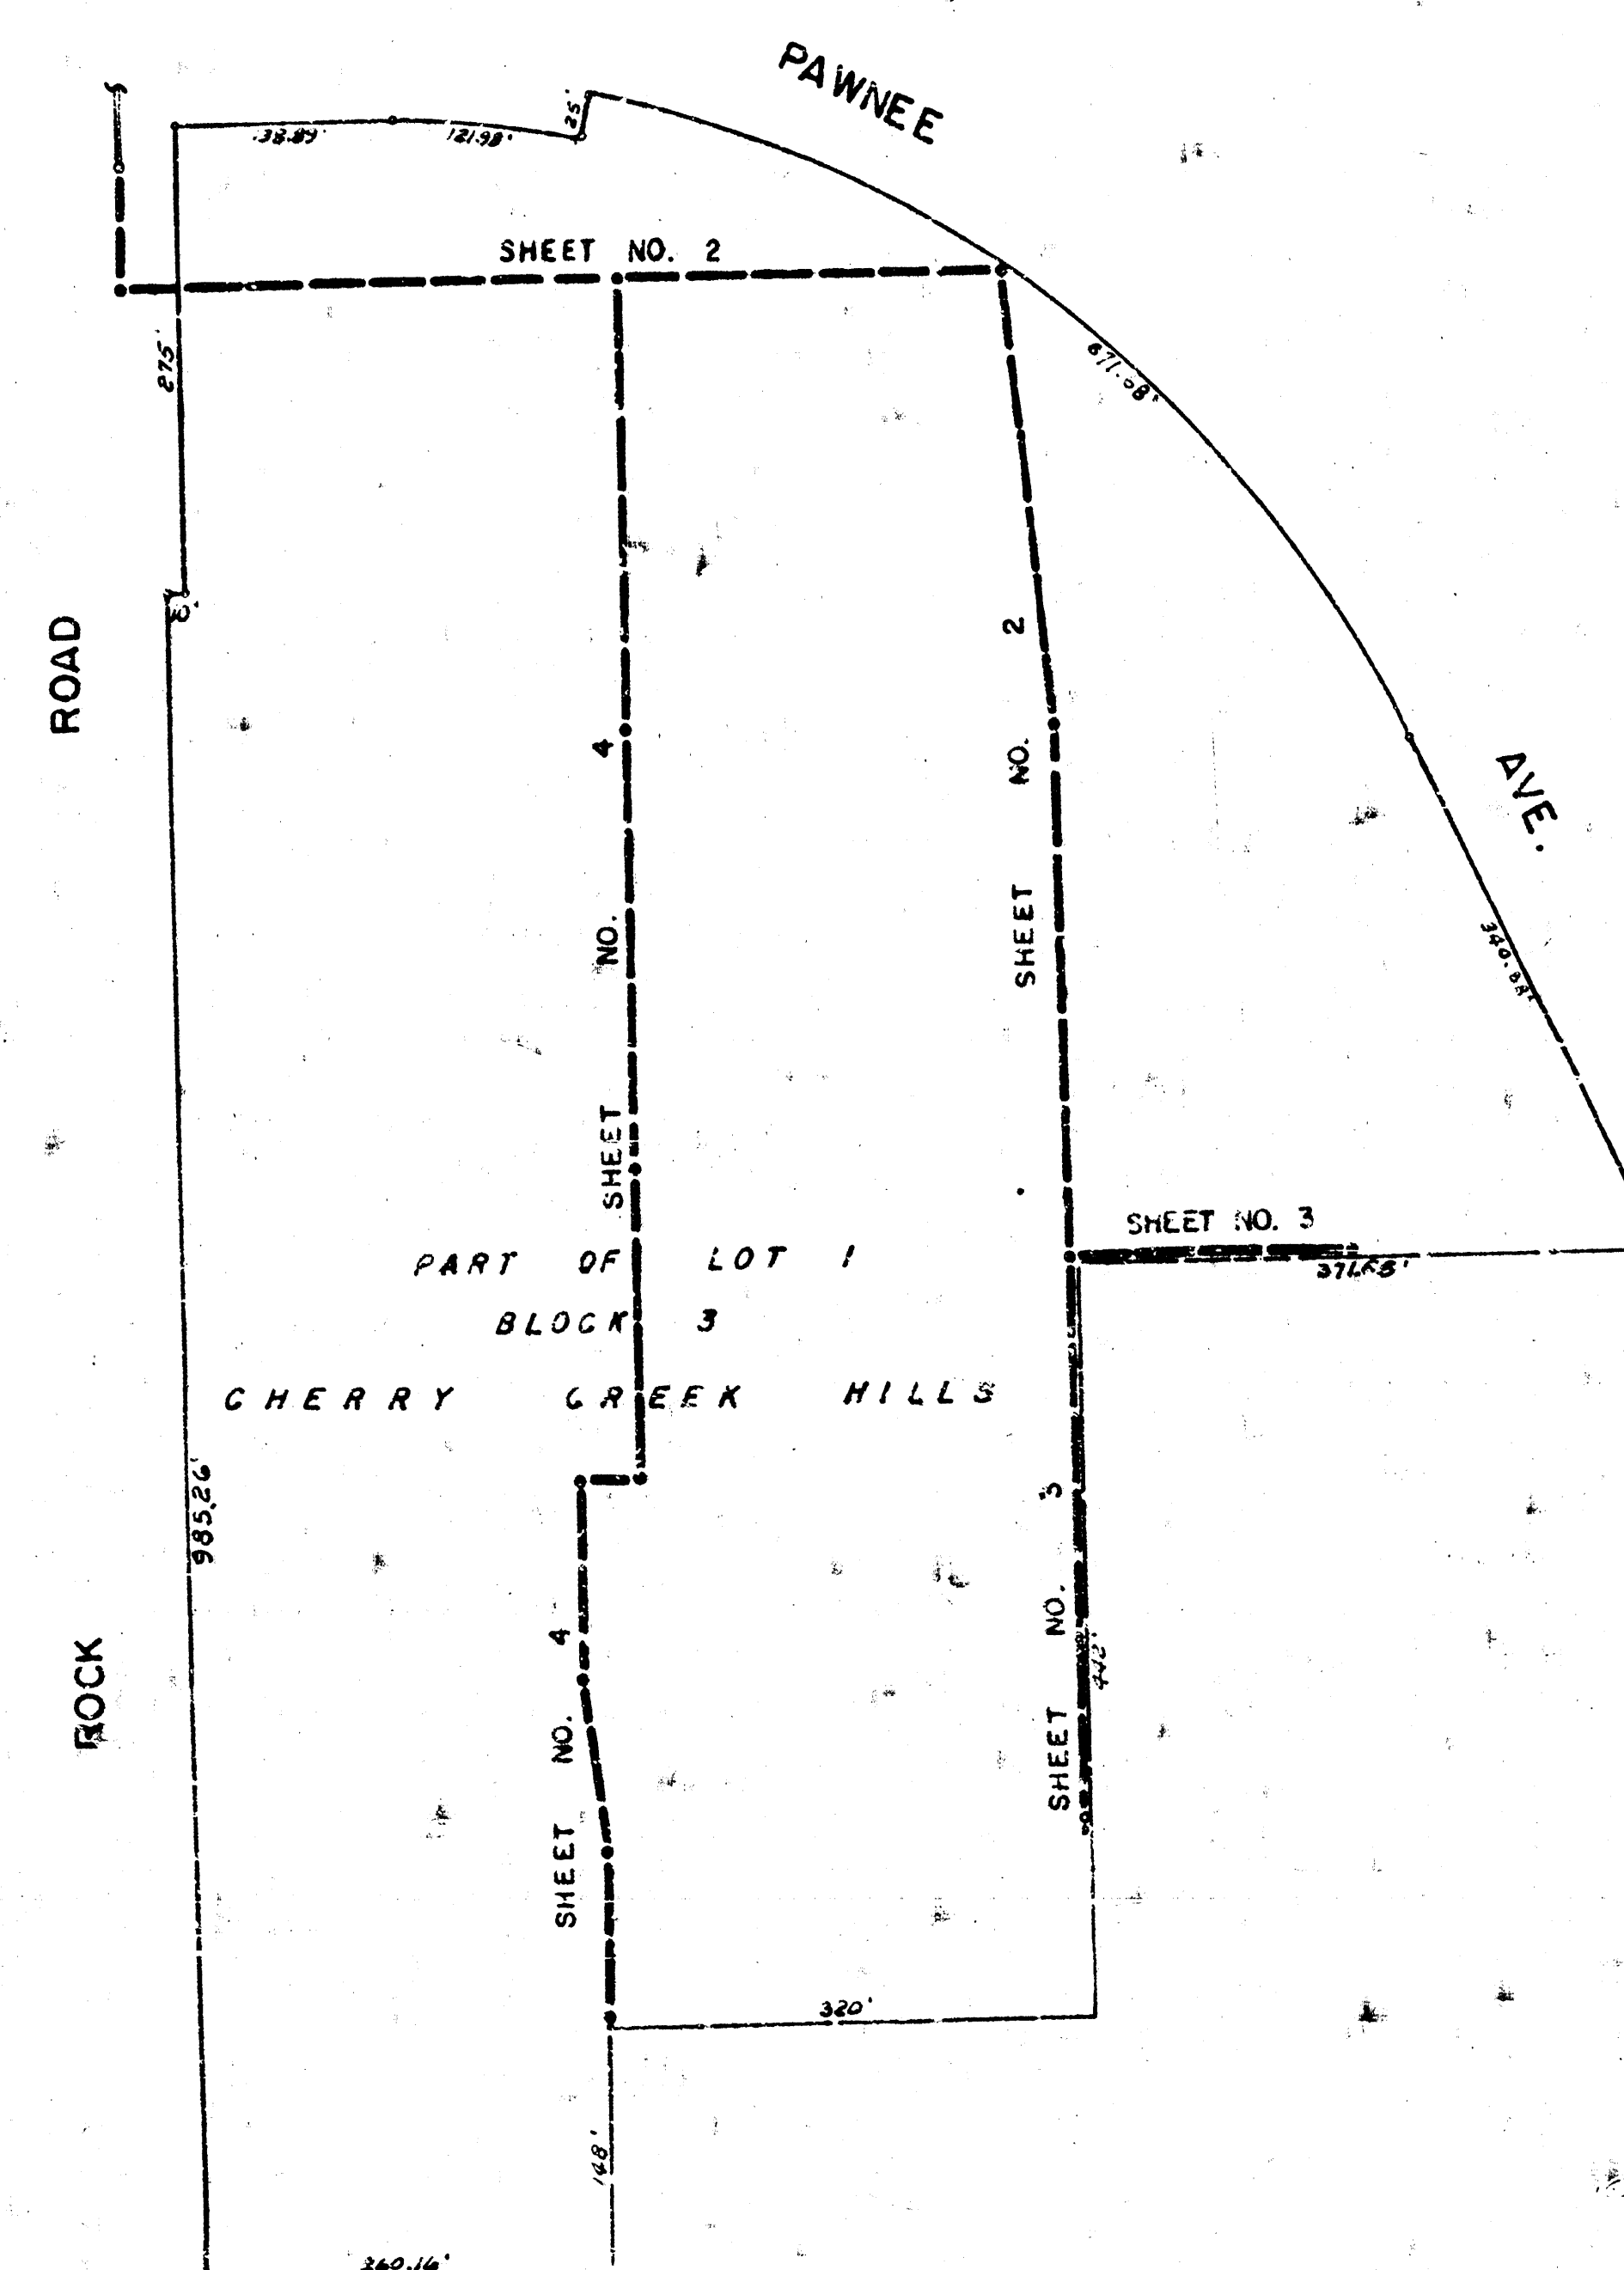


AS BUILT Final Mess. 9-E

LAT. 16, MAIN 17, W. I. S.
PROJECT NO. DBKL 57 3082


3 M. 165.71 "X" in pavement & Rock Rd. &
 & Pawnee West.

231

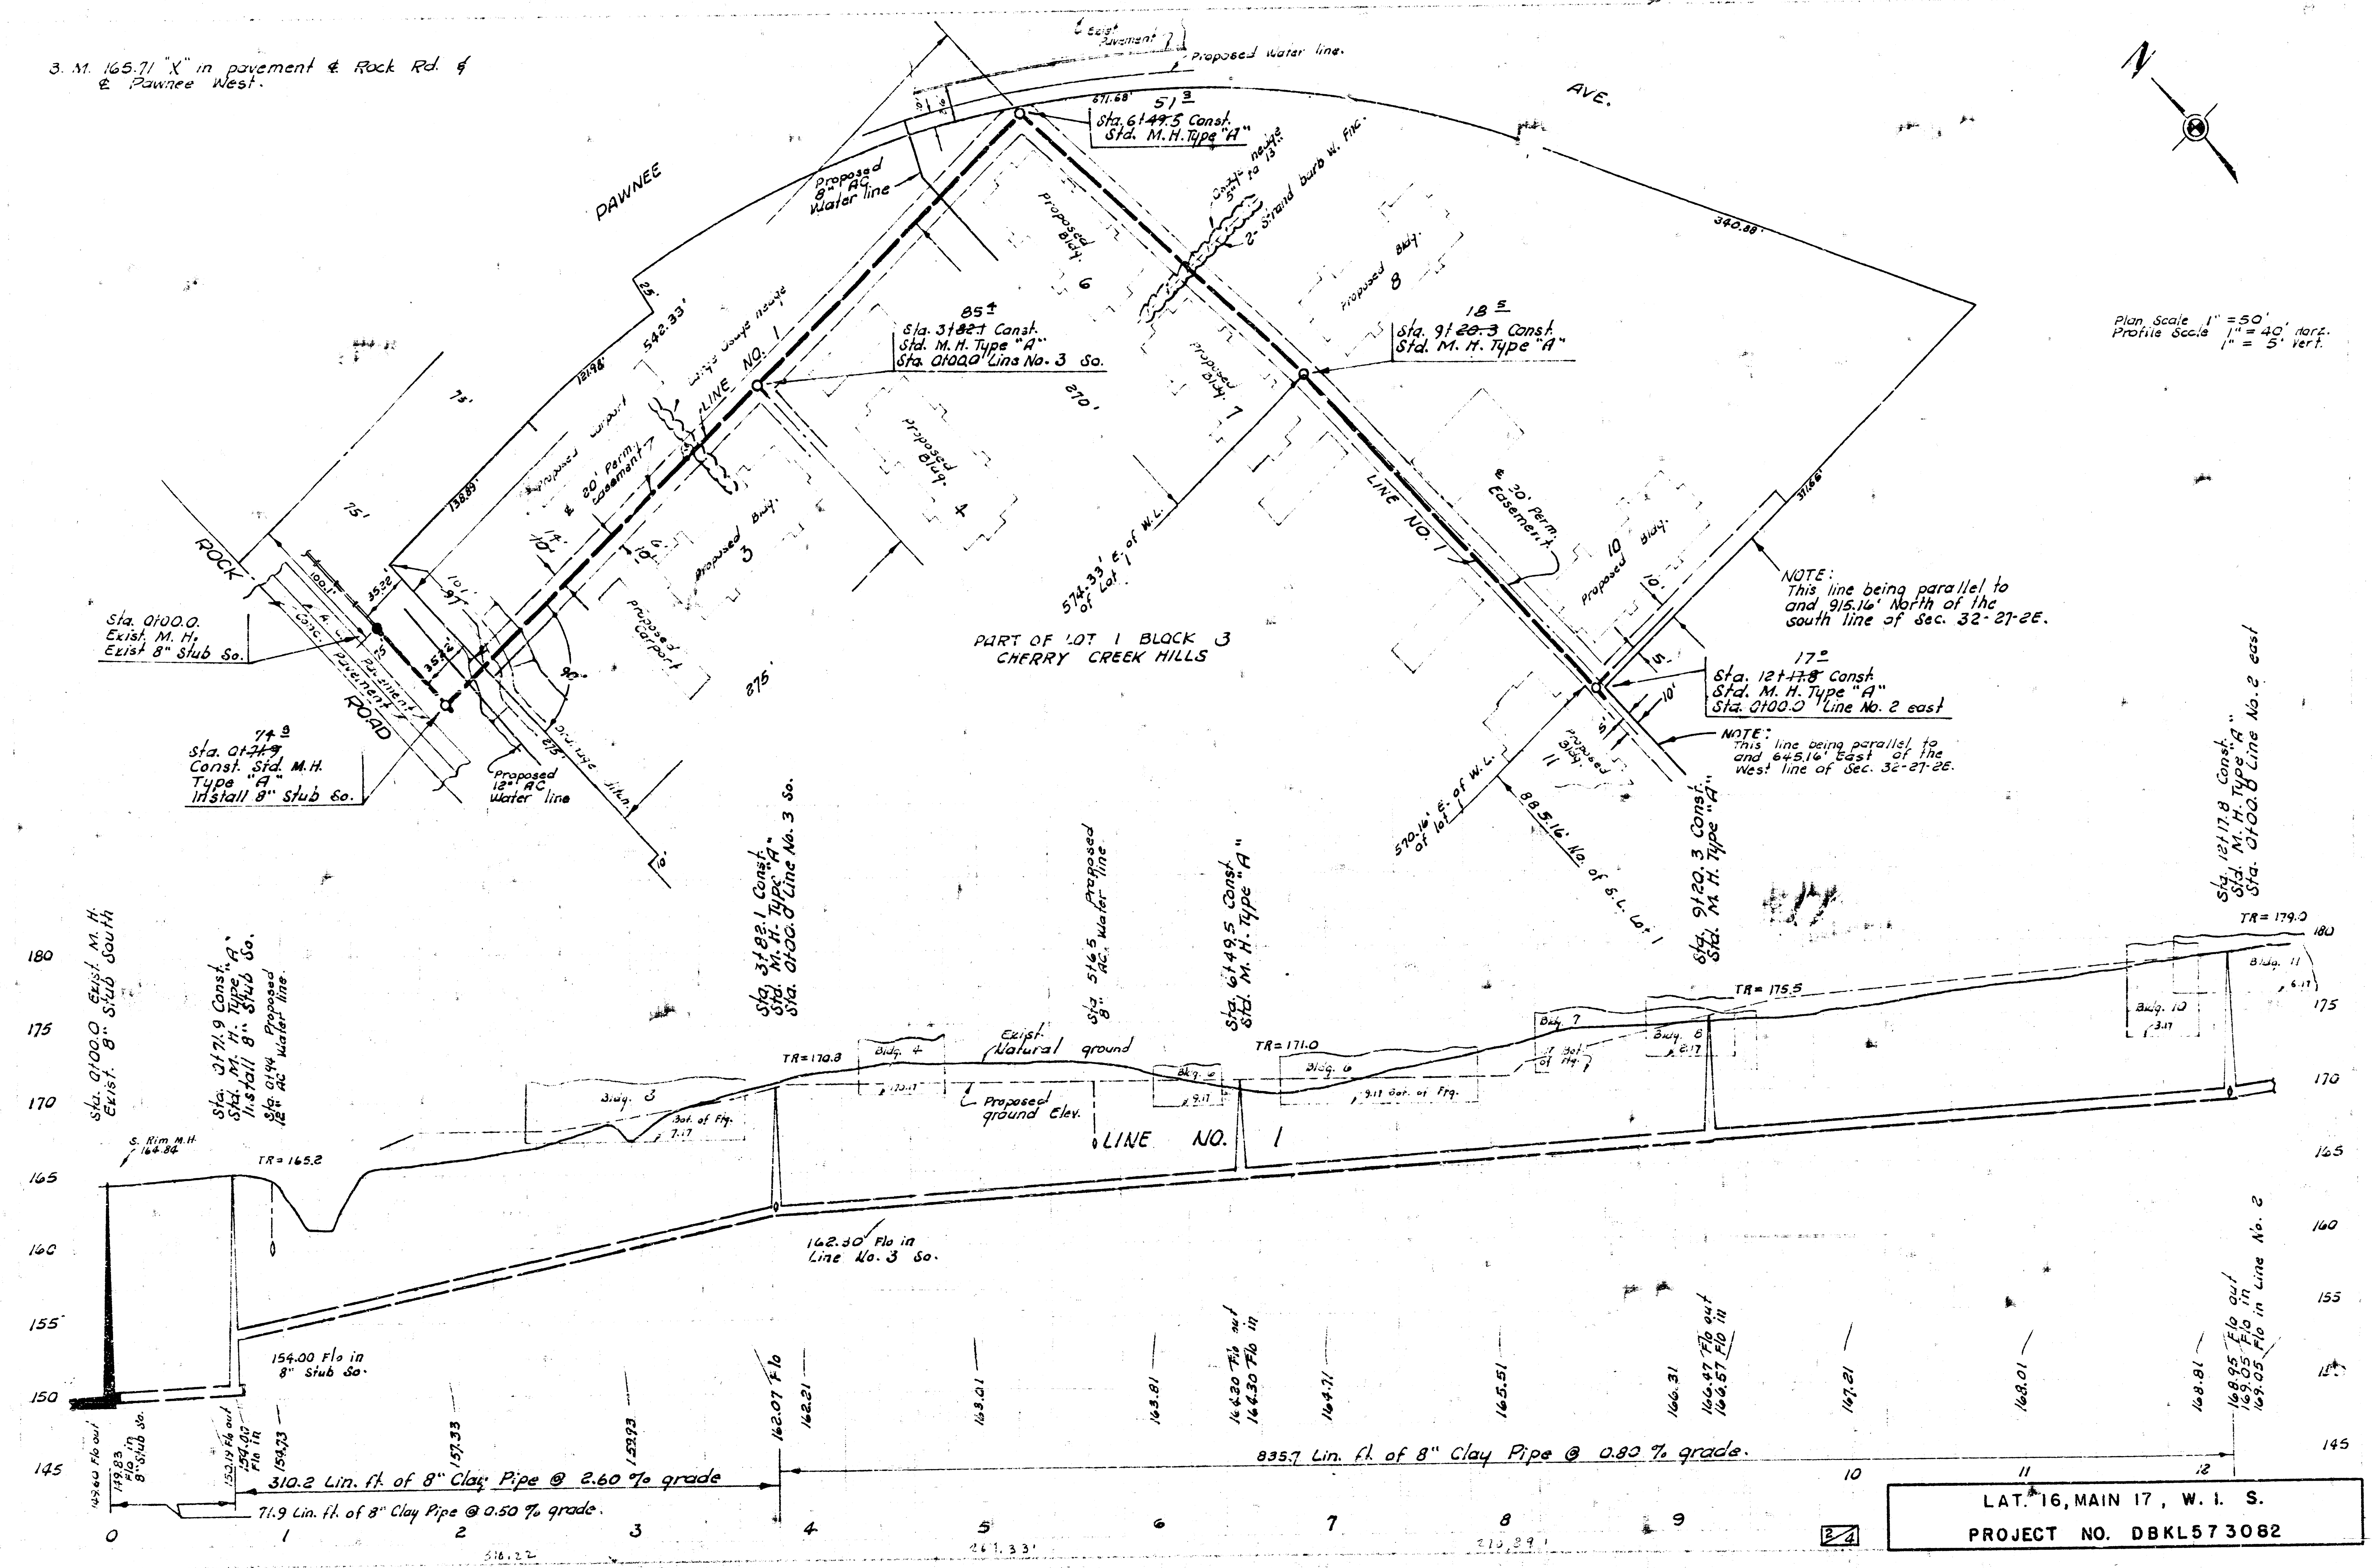

Plan Scale 1" = 50'
 Profile Scale 1" = 5' vert.

LAT. 16, MAIN 17, W. 1. S.
 PROJECT NO. DBKL573082

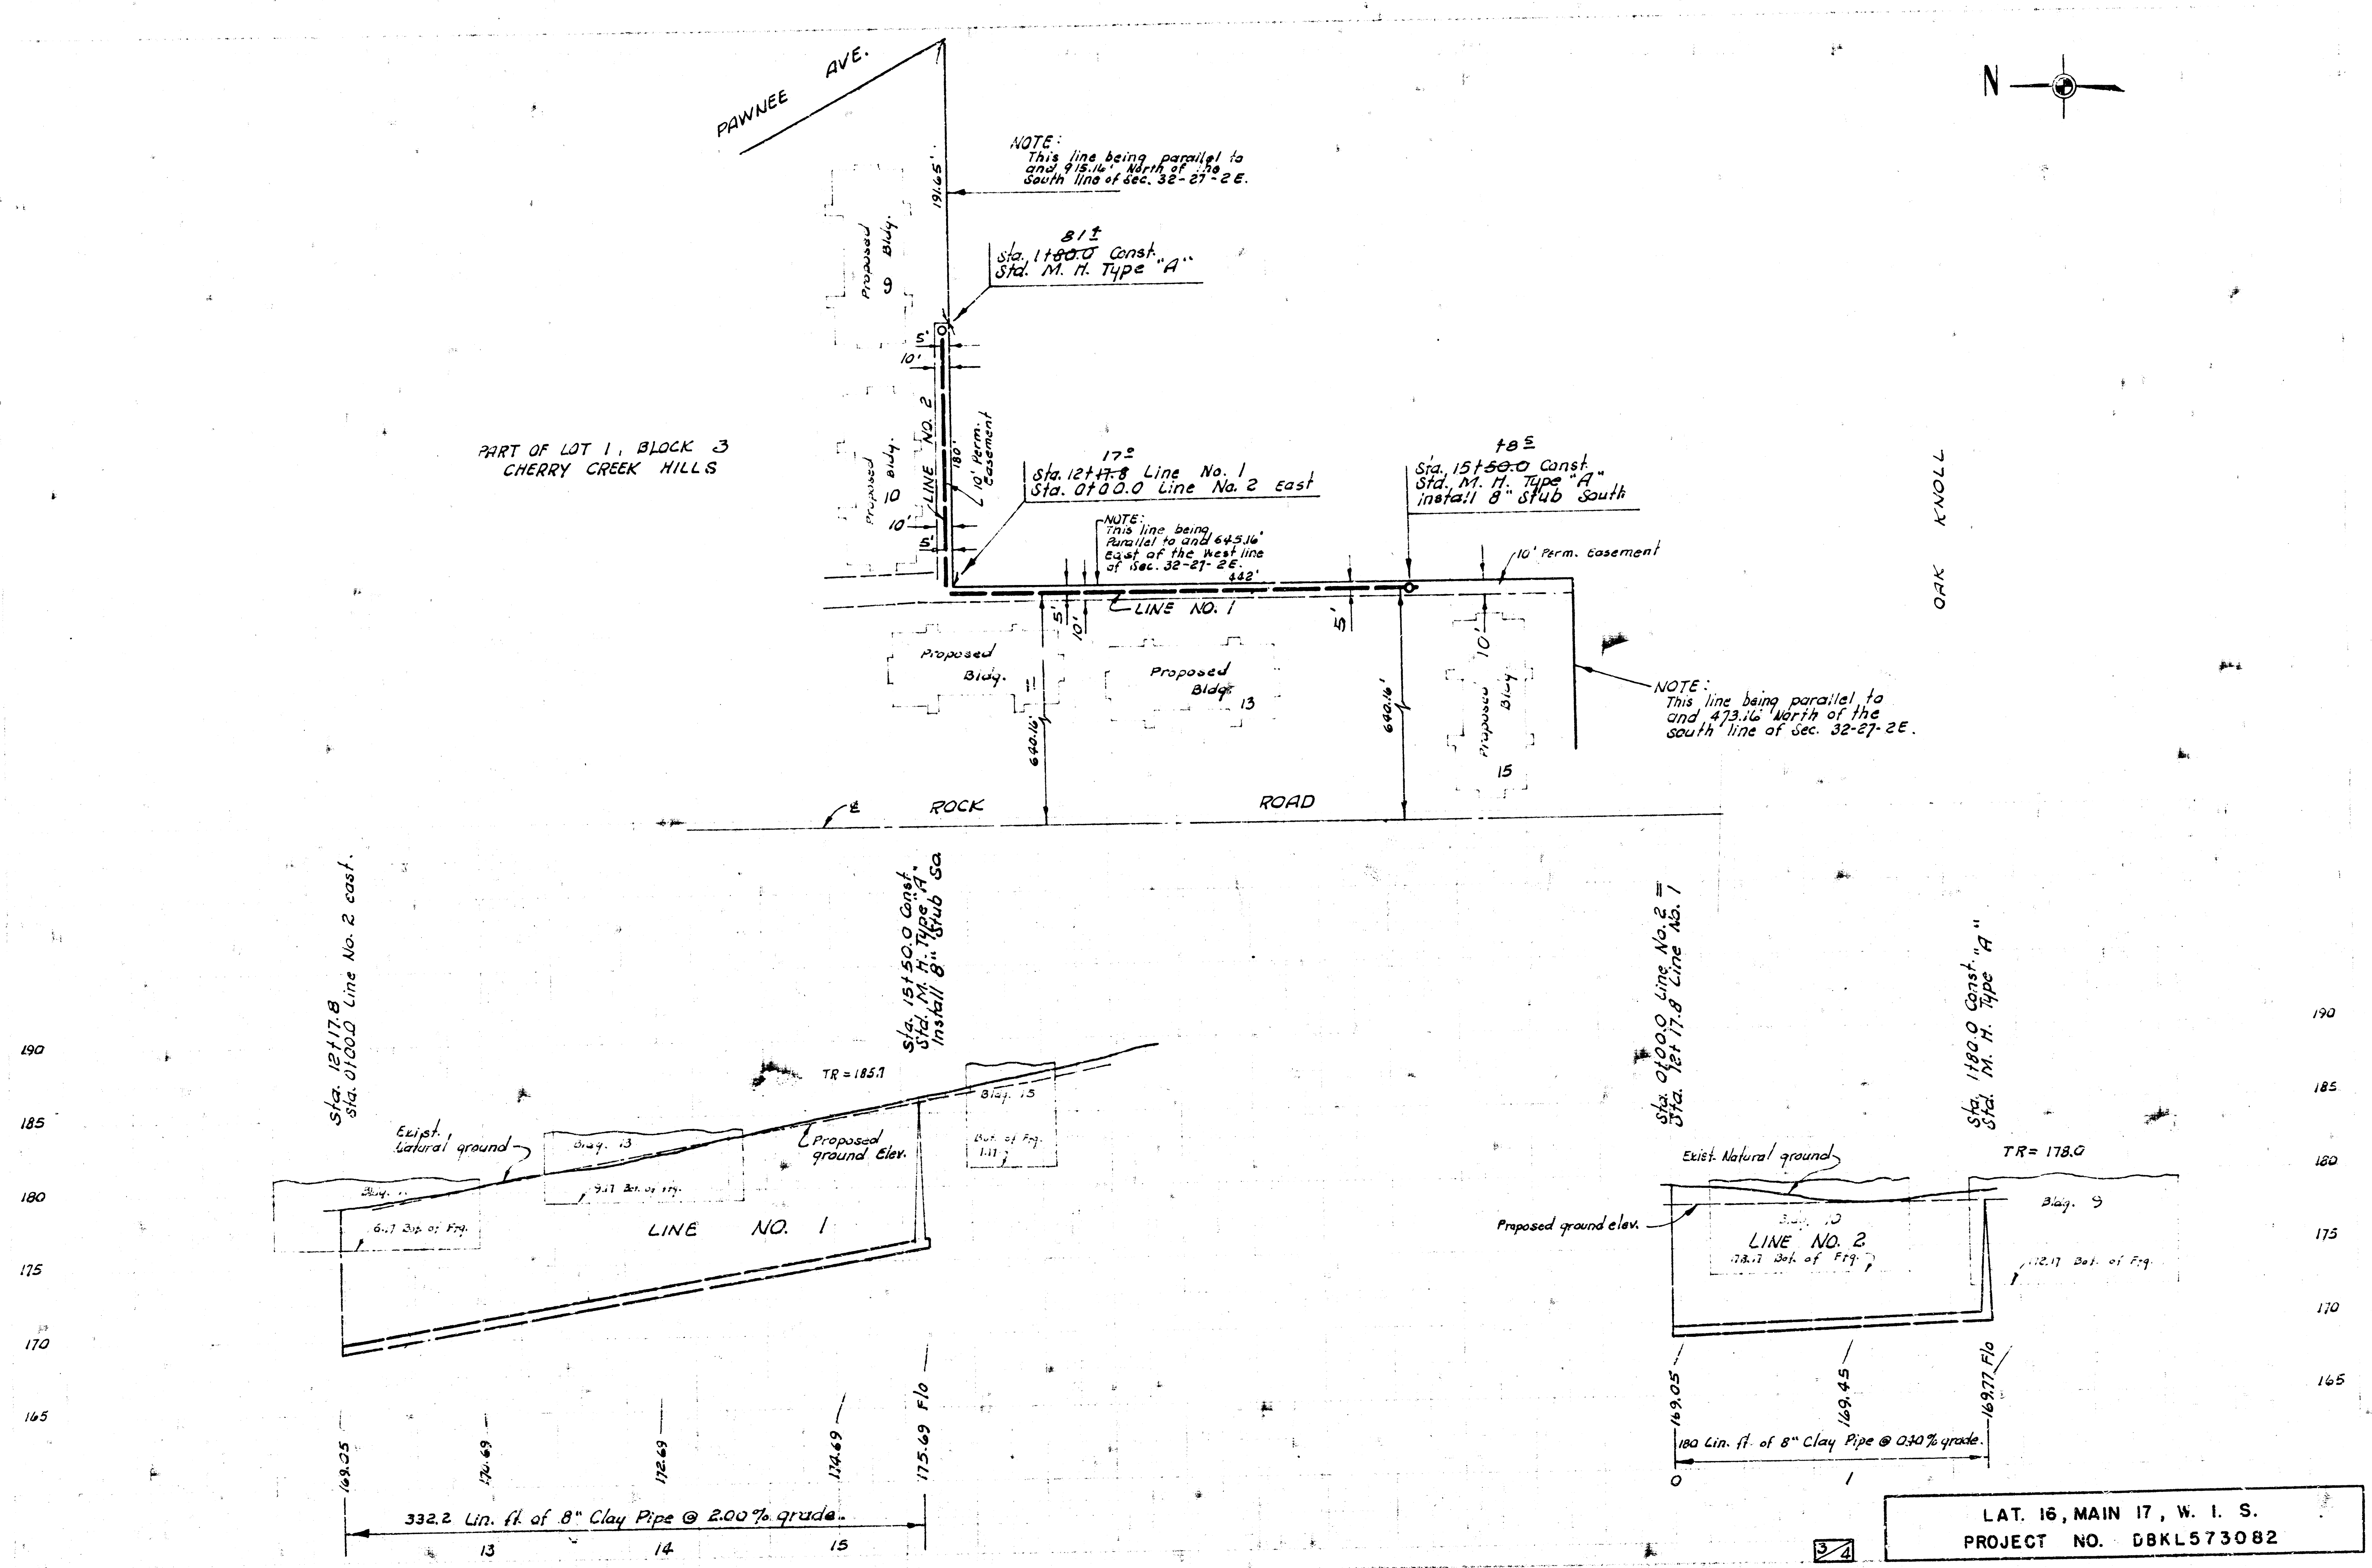

LAT. 16, MAIN 17, W. 1. S.
PROJECT NO. DBKL573082

