

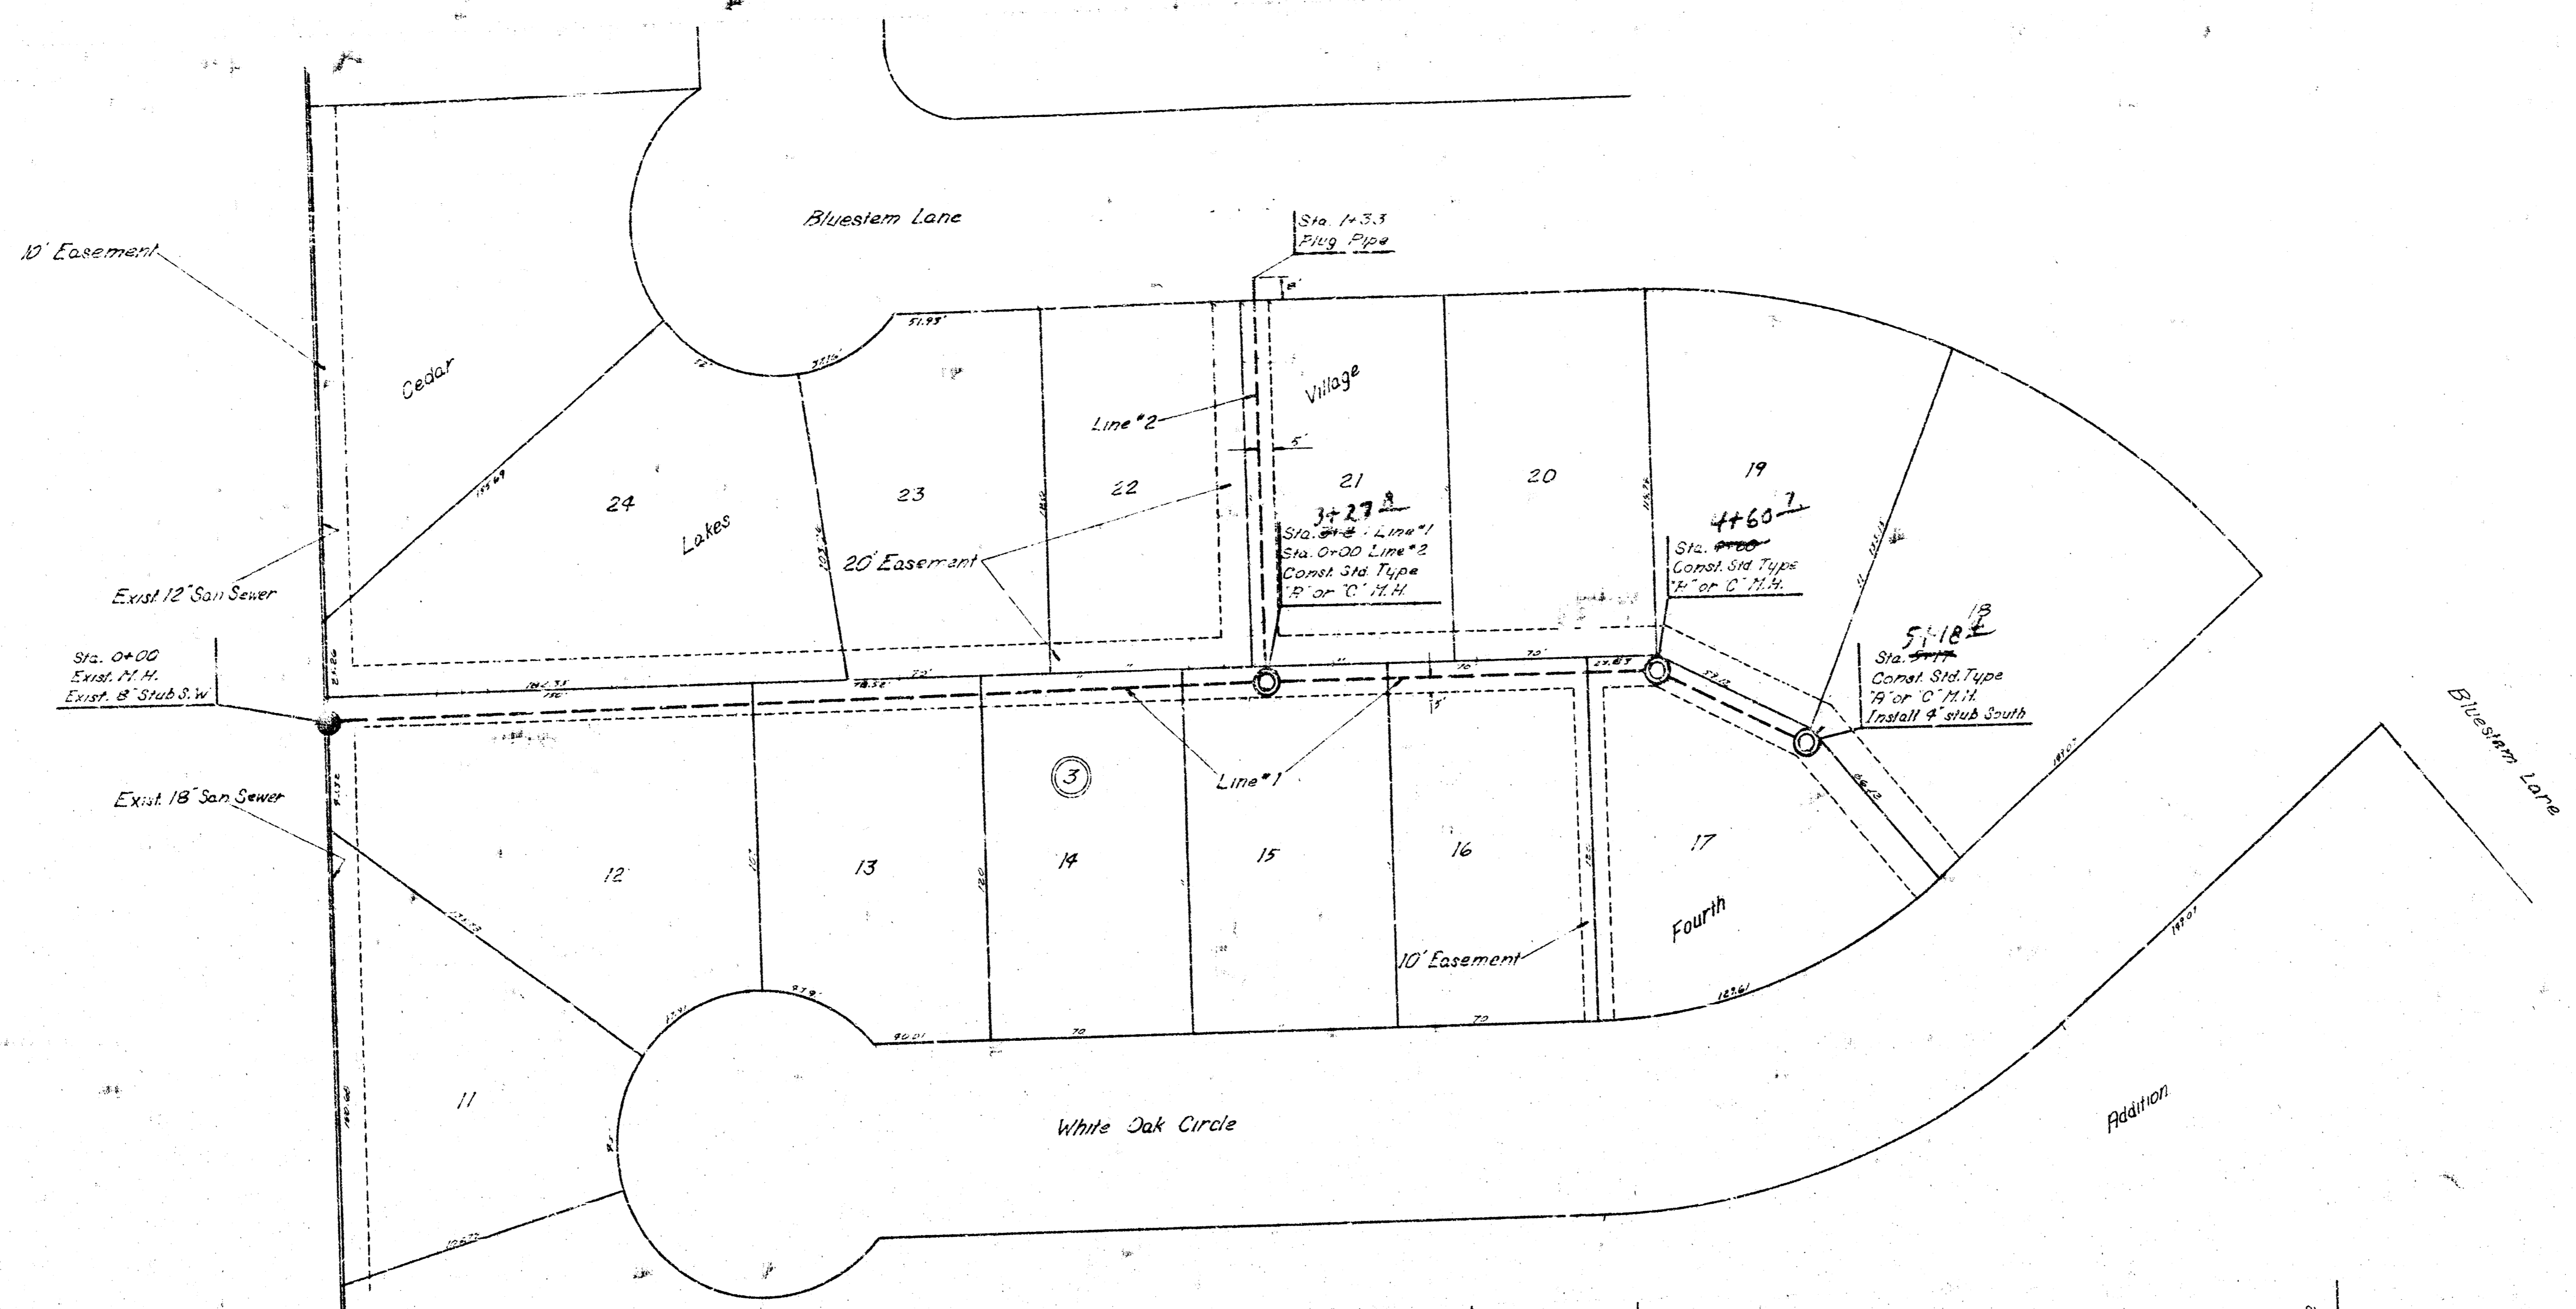


S.M. 153.10 P.R. Spike N. Face P.R. 7' E. of W.L. White Oak Ex. 126' So. of S.L. 174 Version

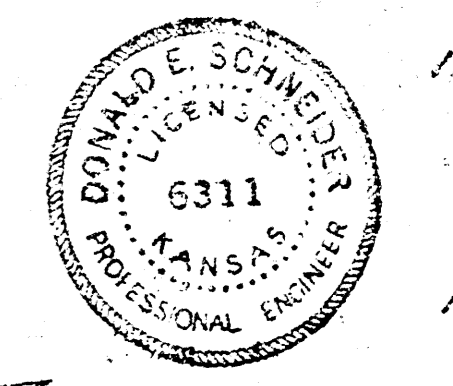

Flag of Sta. 1+77 Line #2 is under a temporary plug and should be removed if project.

Scale
Plan: 1"=20'
Profile: 1"=40'
Vert: 1"=5'

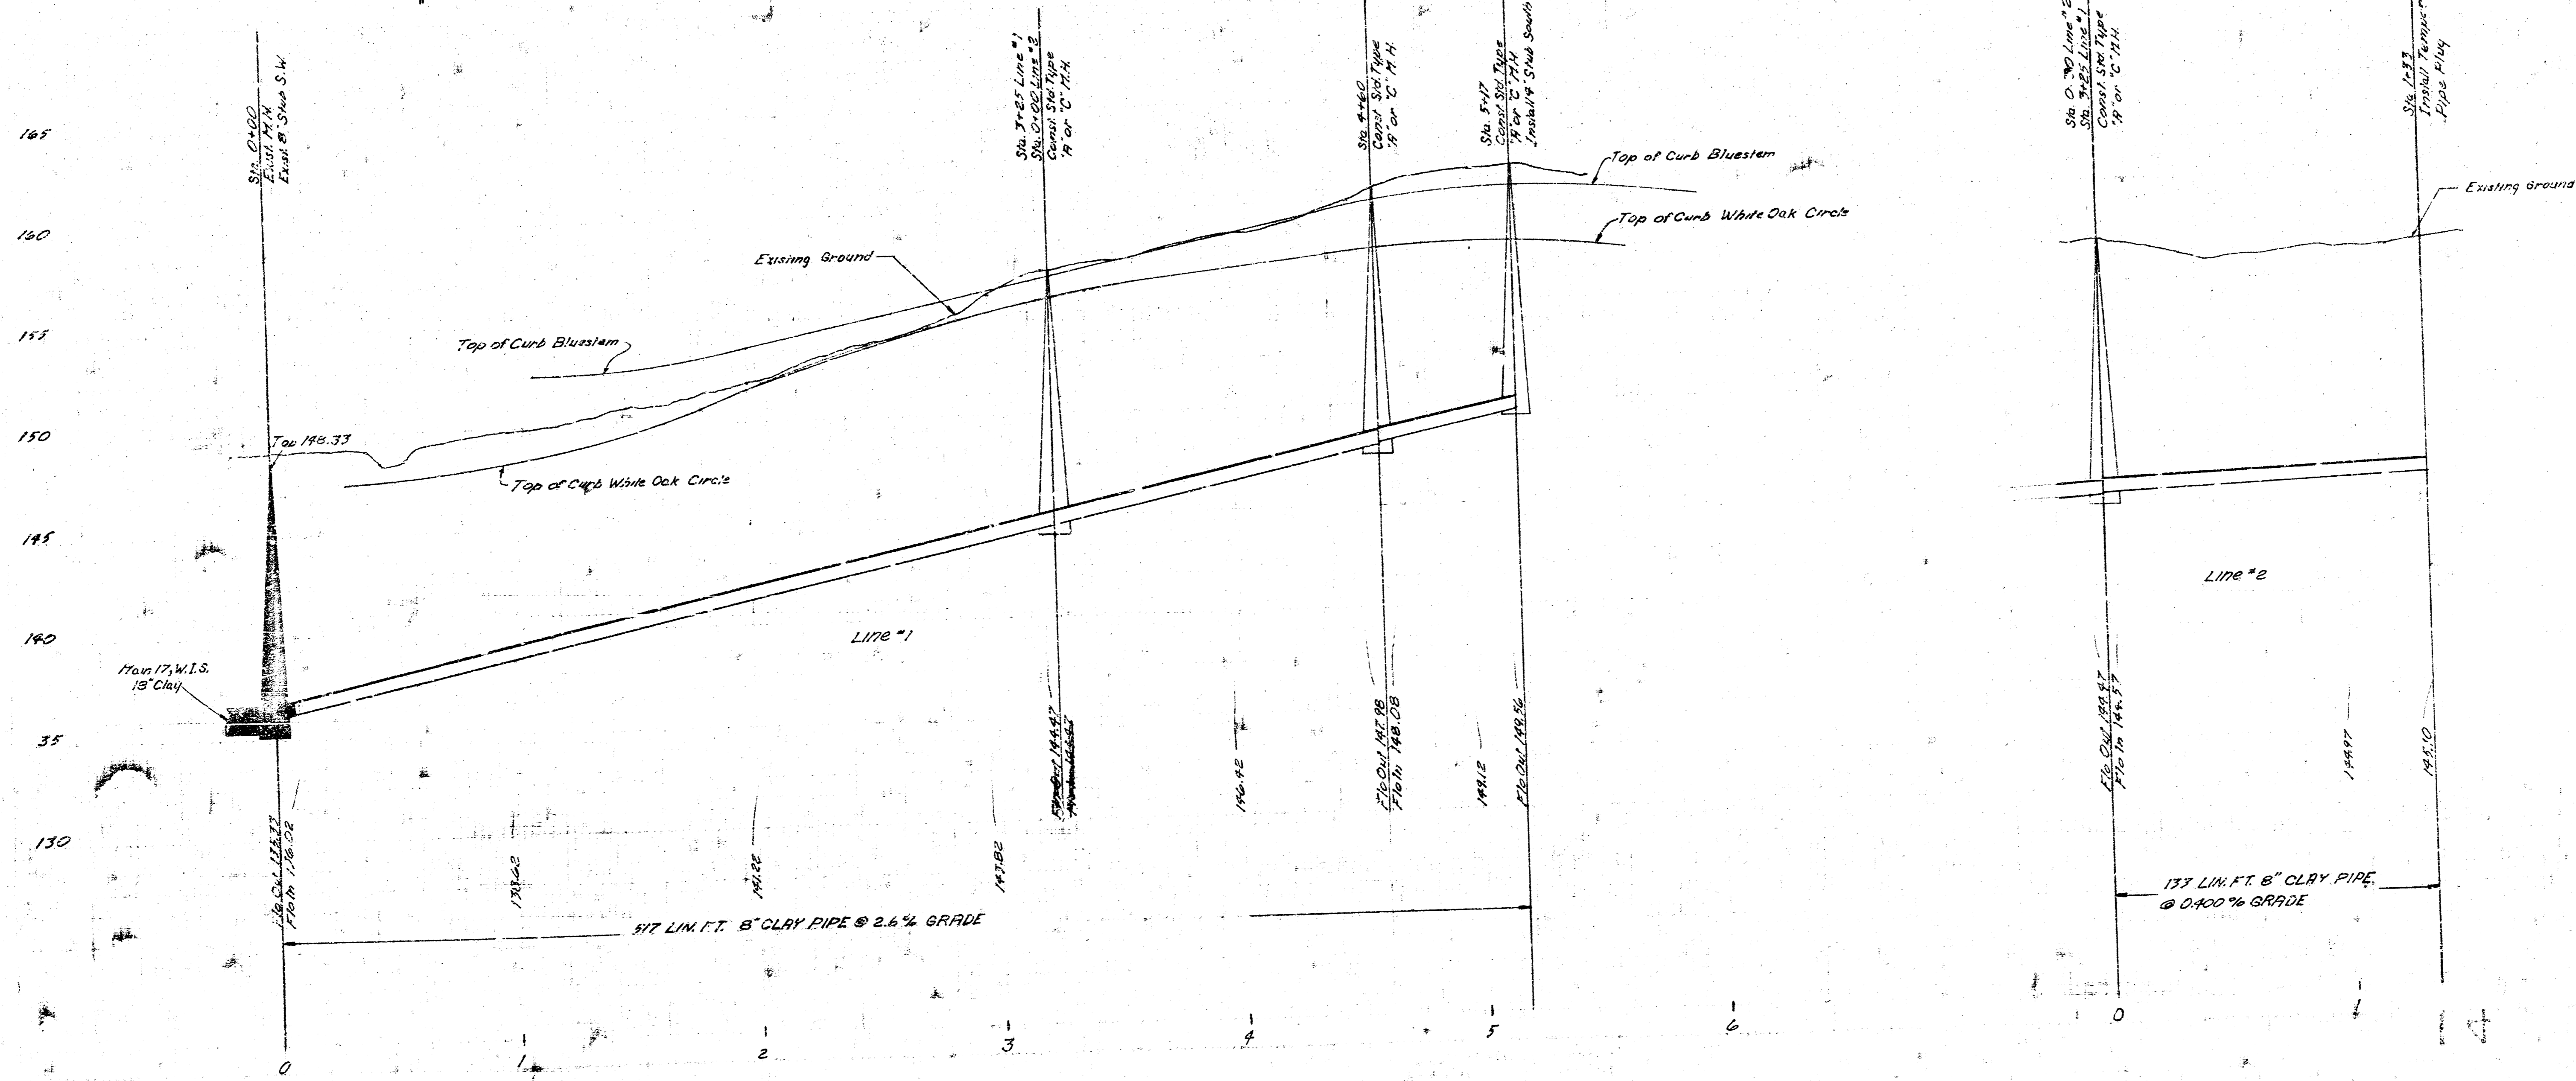

As Built 9-10-75
 Lot 21, North 77, War Industries Sewer
 City of Wichita, Kansas
 R. W. Linn, City Engineer
 Project No. D-41574104
 Date: Sheet 1 of 1