

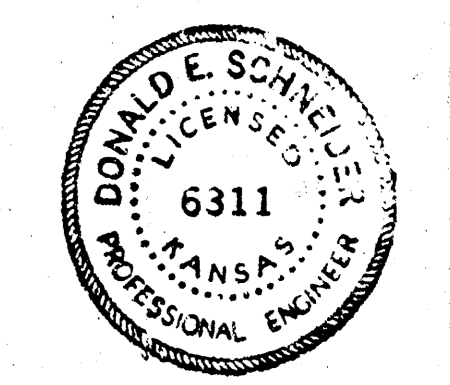


- BM = 157.10 + Cut on C of Rock Road & Bluestem East of Rock Road
- BM = 159.12 RR spike N. face PP 7' E. of W. Line White Oak Dr. & 126' S. of SL. Mt. Vernon East
- BM = 152.40 Brass Plug SW cor. RCB on Bluestem 300' East of Rock Road
- BM = 153.46 SW cor. conc. headwall Lake in Cedar Lakes

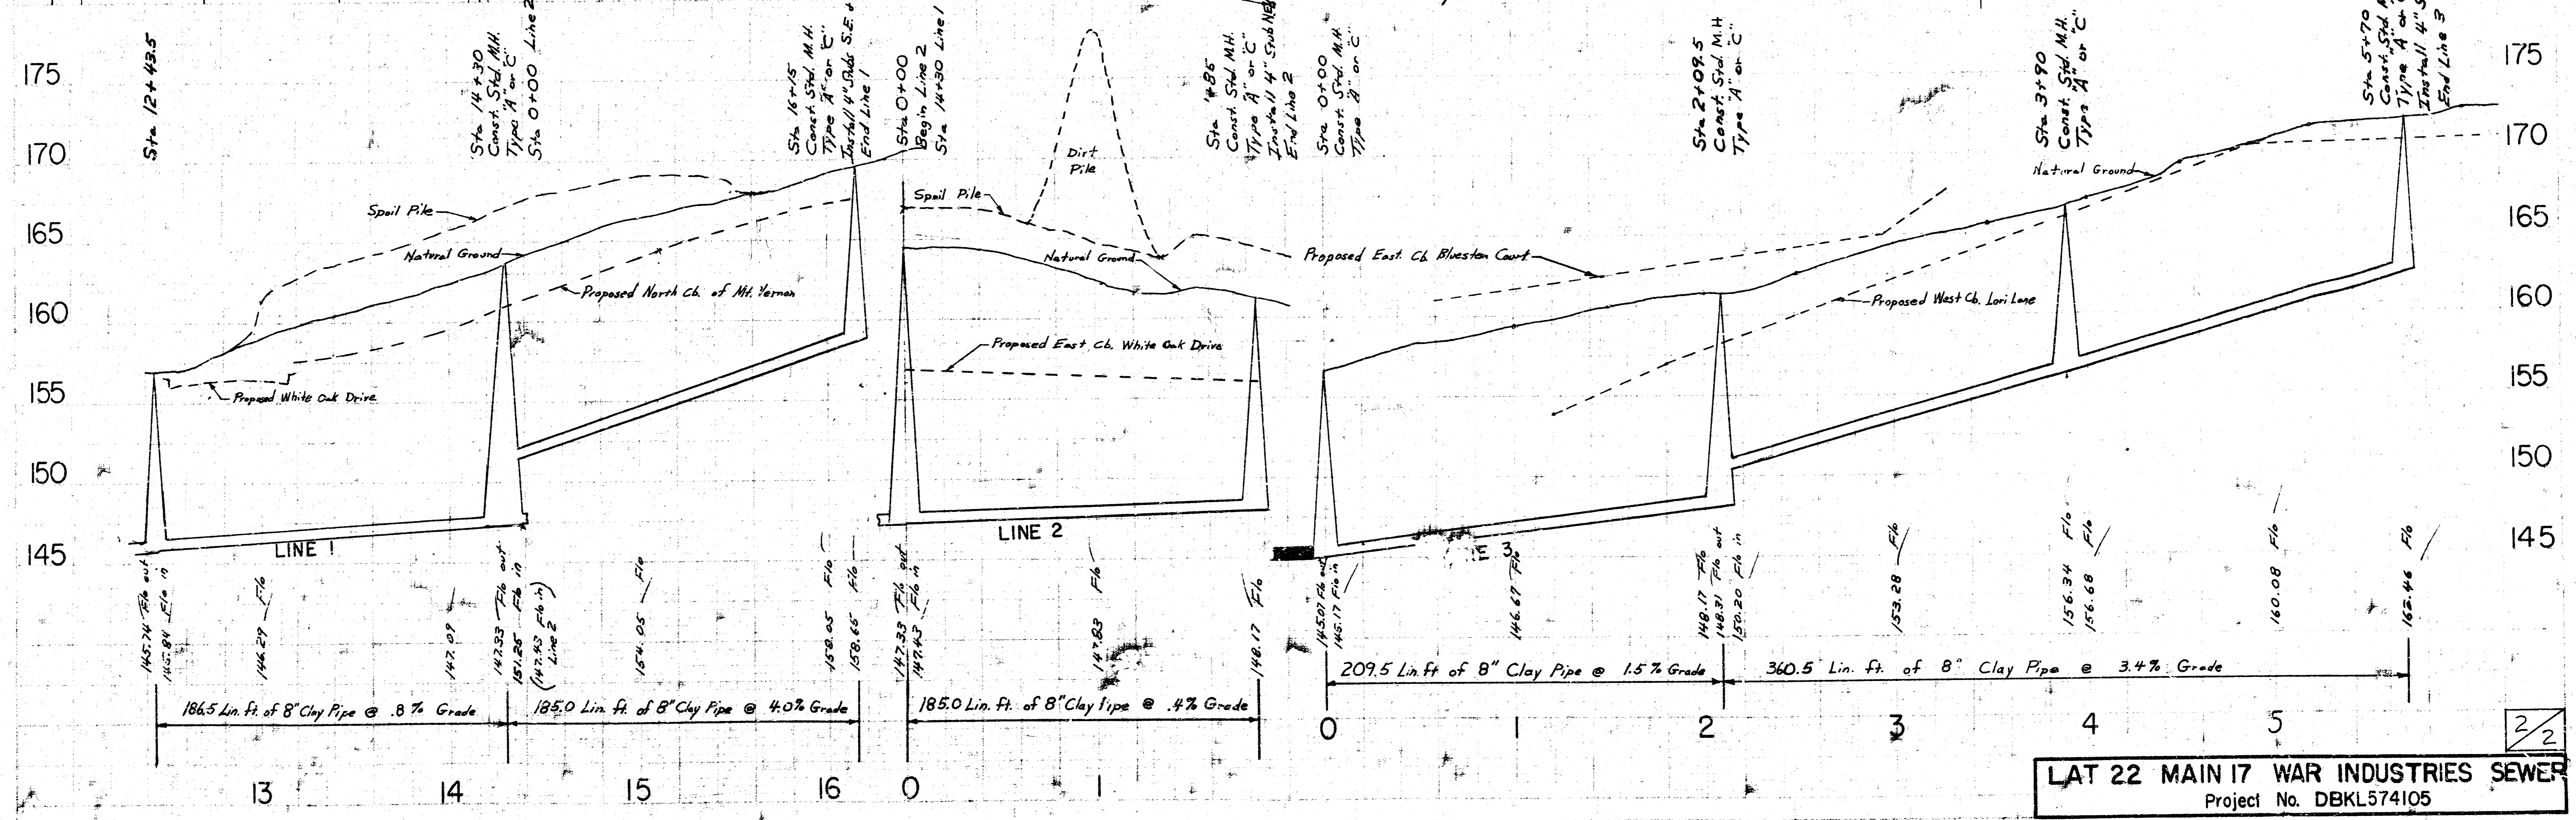

LAT. 22 MAIN 17 WAR INDUSTRIES SEWER
 CITY OF WICHITA, KANSAS
 R. W. LINN CITY ENGINEER
 PROJECT NO. DBKL574105

As Built 1-28-76

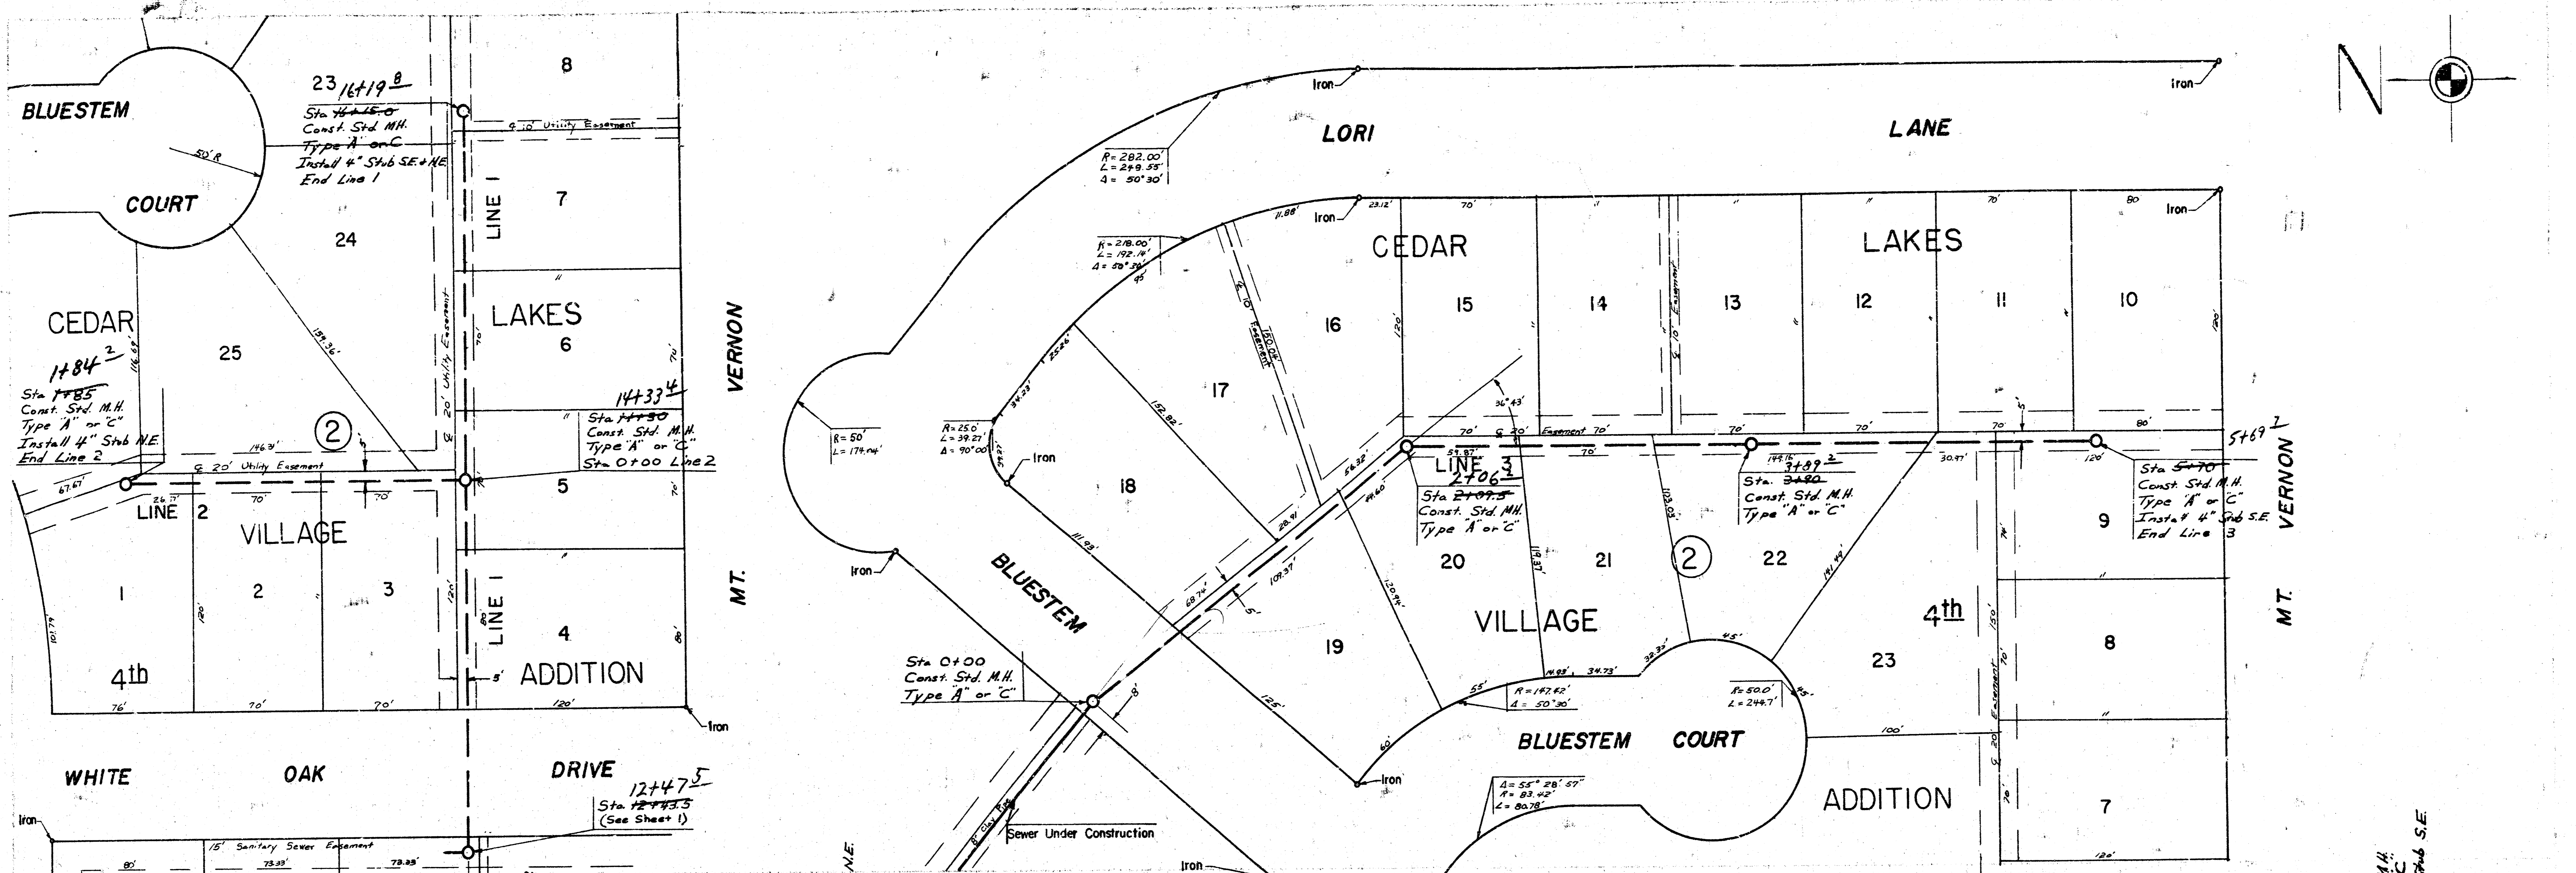

LAT 22 MAIN 17 WAR INDUSTRIES SEWER
Project No. DBKL574105