

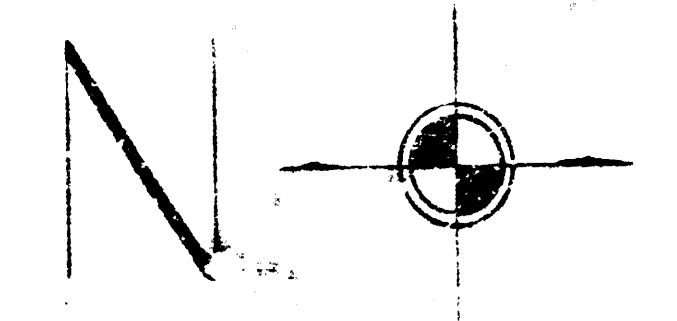


BM = 153.46 " " on SW corner Concrete Headwall to Dyke

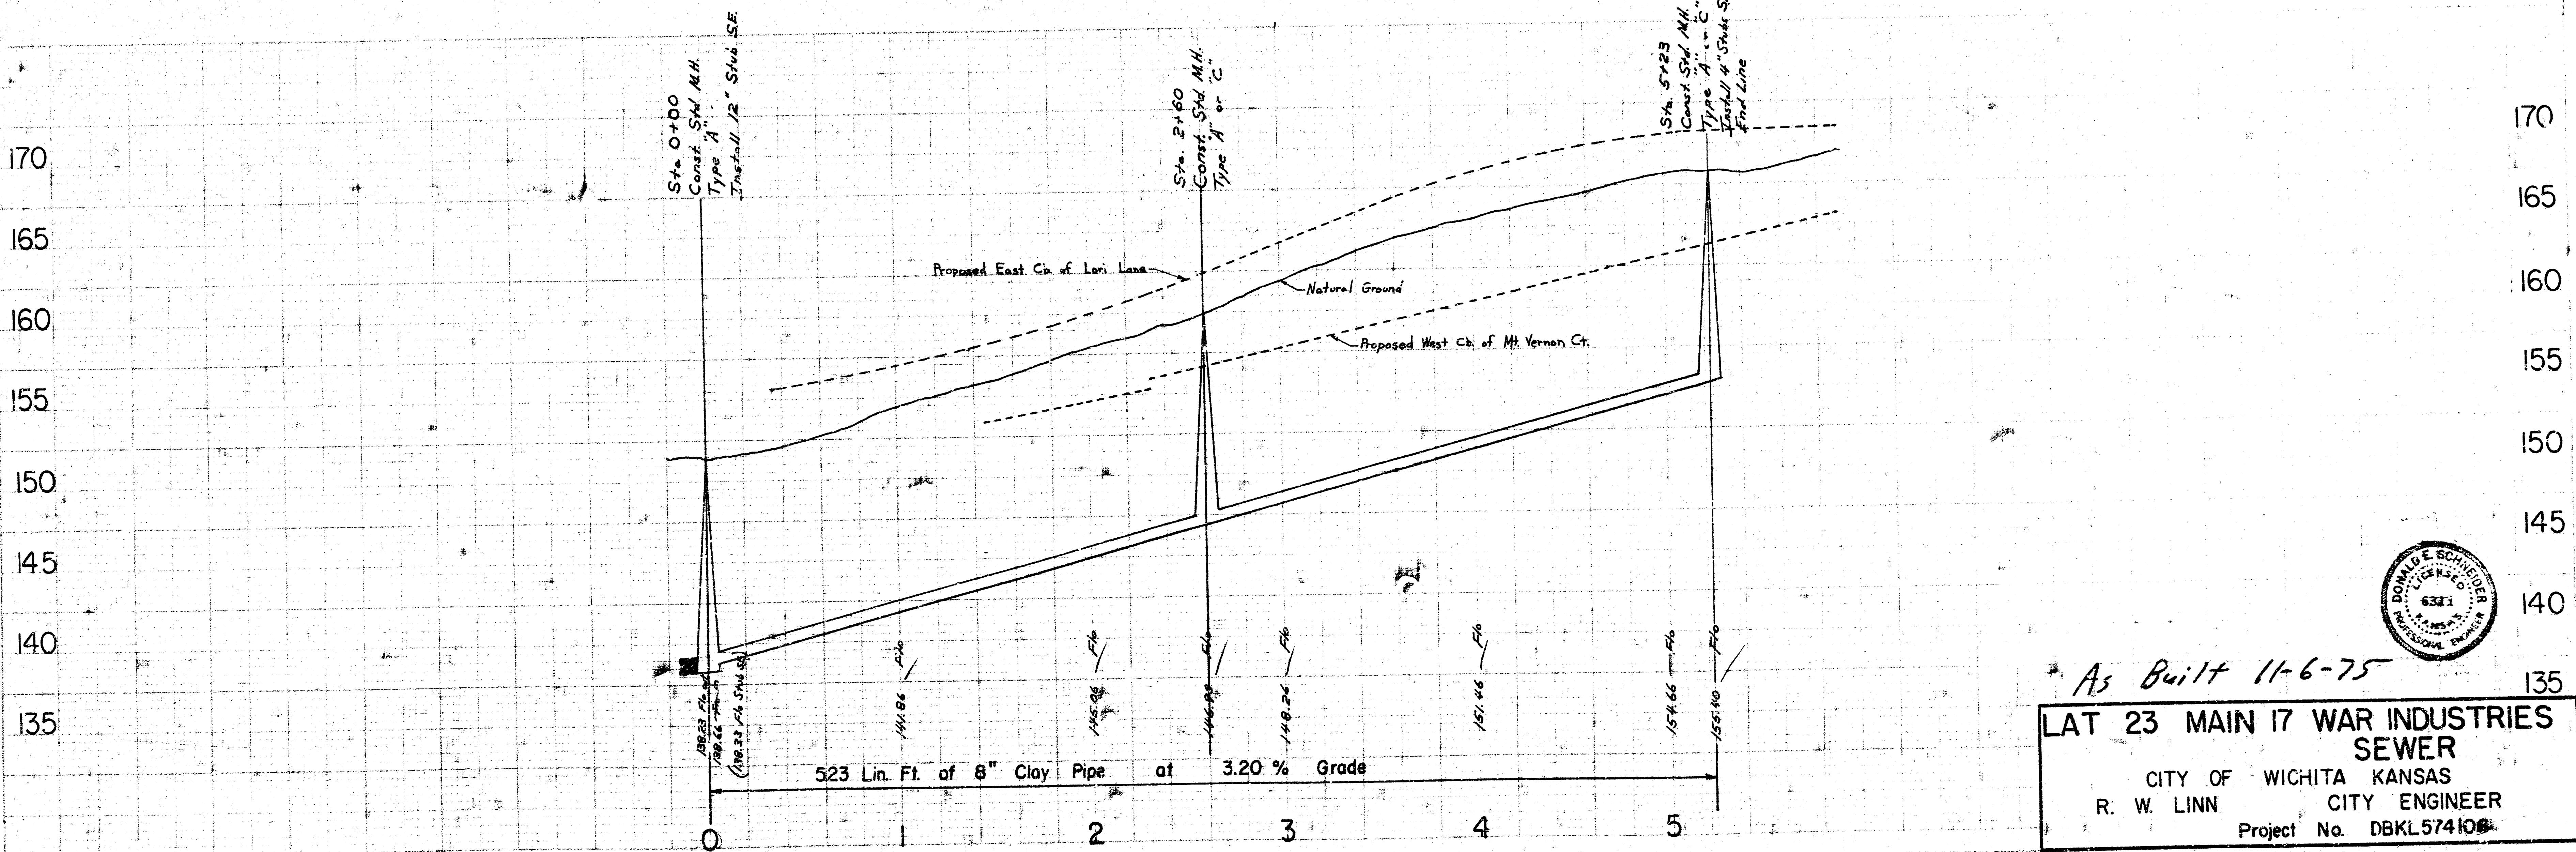

Plan Scale 1" = 40'
Profile Scale 1" = 40' Horiz.
1" = 5' Vert.

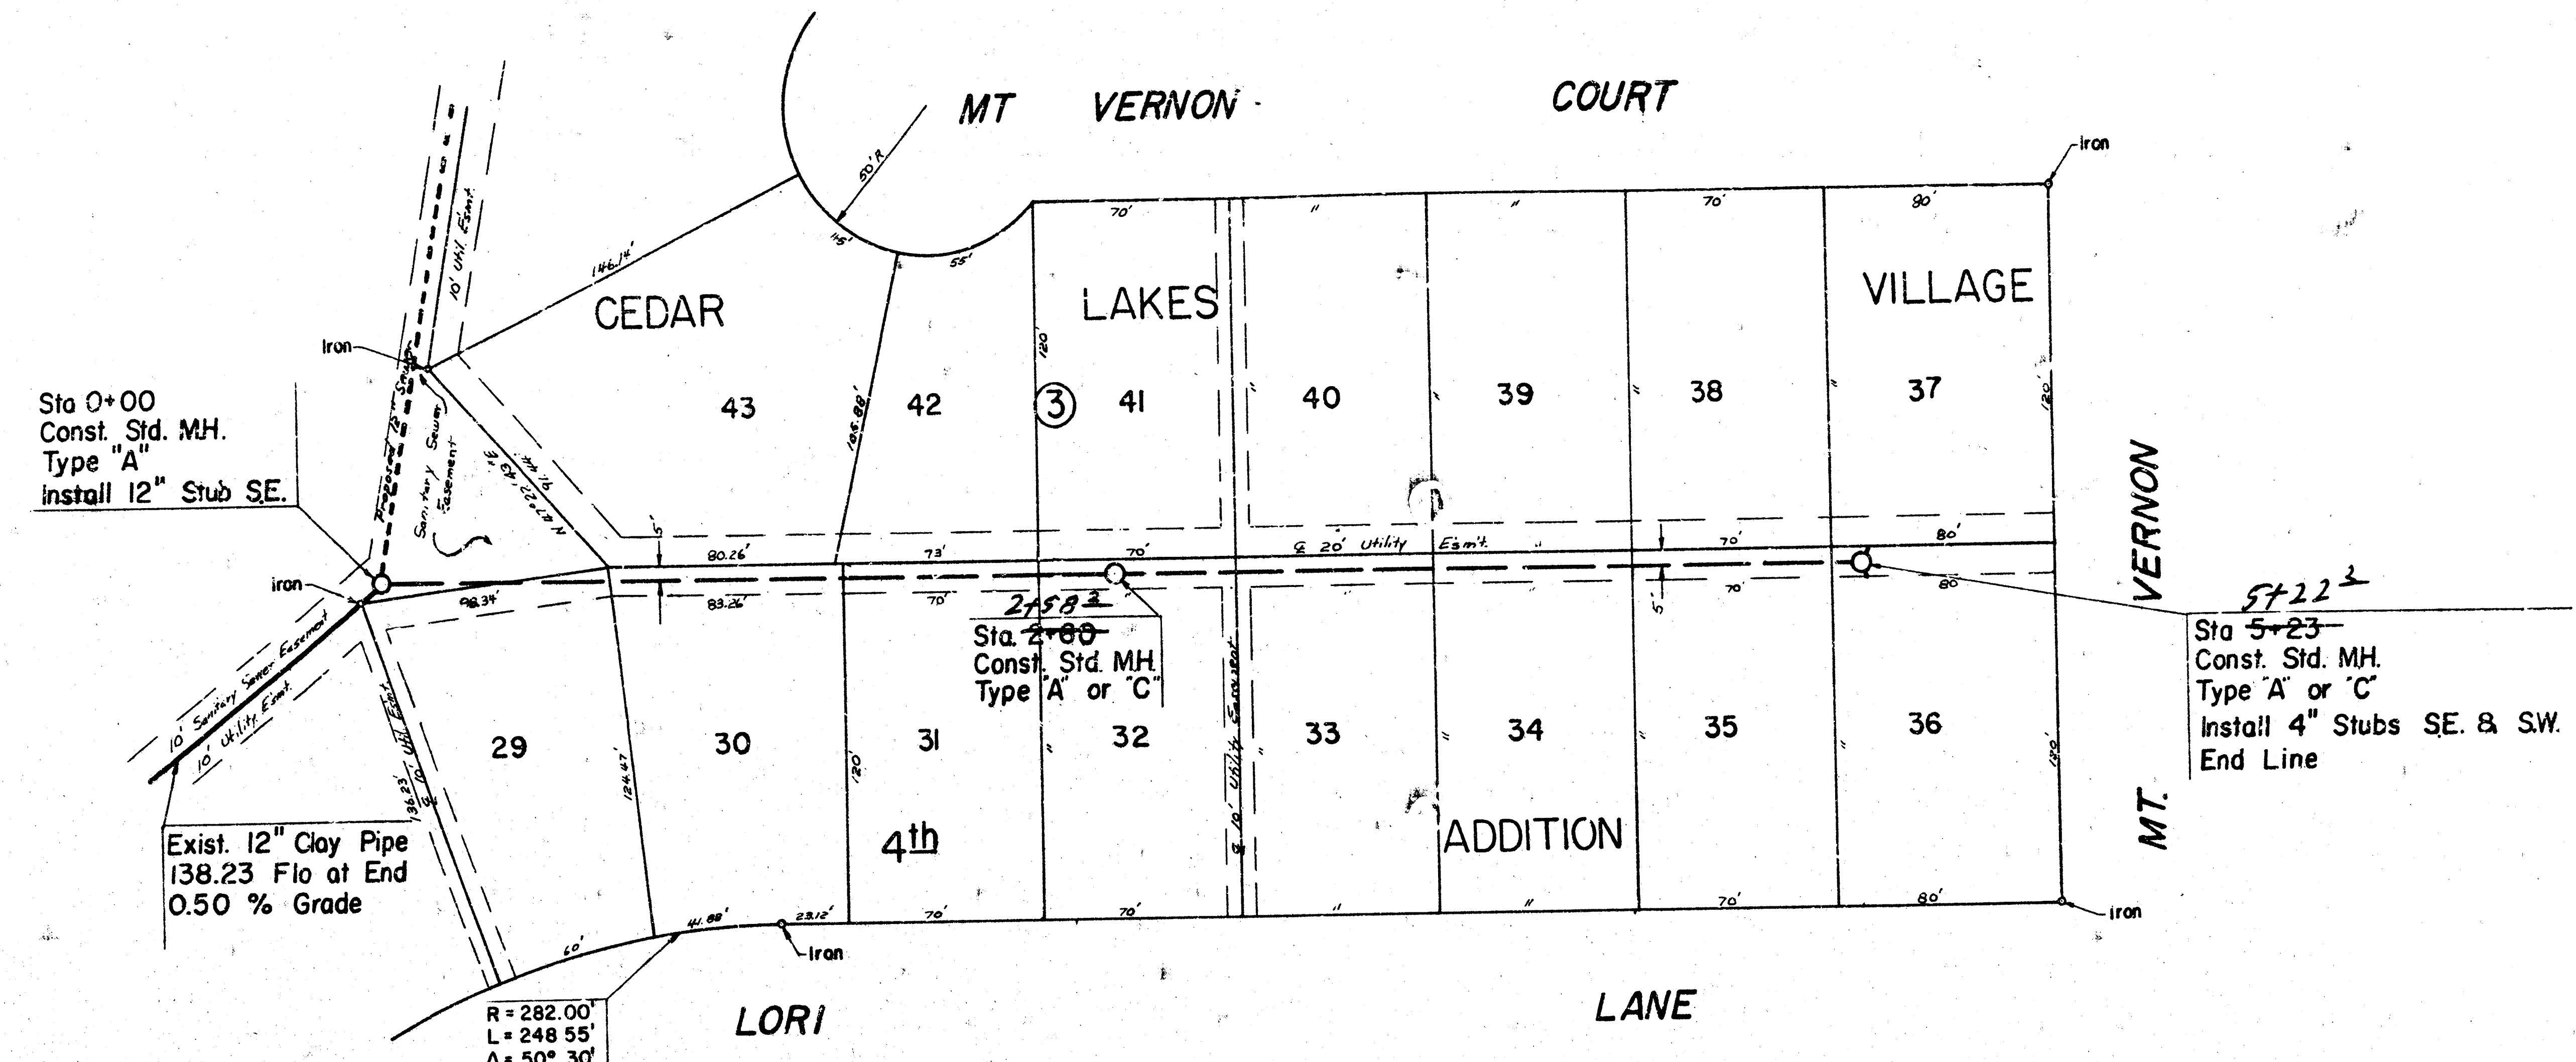

As Built 11-6-75
LAT 23 MAIN 17 WAR INDUSTRIES SEWER
 CITY OF WICHITA KANSAS
 R. W. LINN CITY ENGINEER
 Project No. DBKL57410

