


Plans
 2146
 No. 263


B.M. 161.75 - R.R. Spike E. Face of Street Life Pole, SW. Cor. of Lincoln & Dalton.
 B.M. 15687'-Top of Curb, S. End of Rad., SW. Cor. of Cypress & Lincoln.

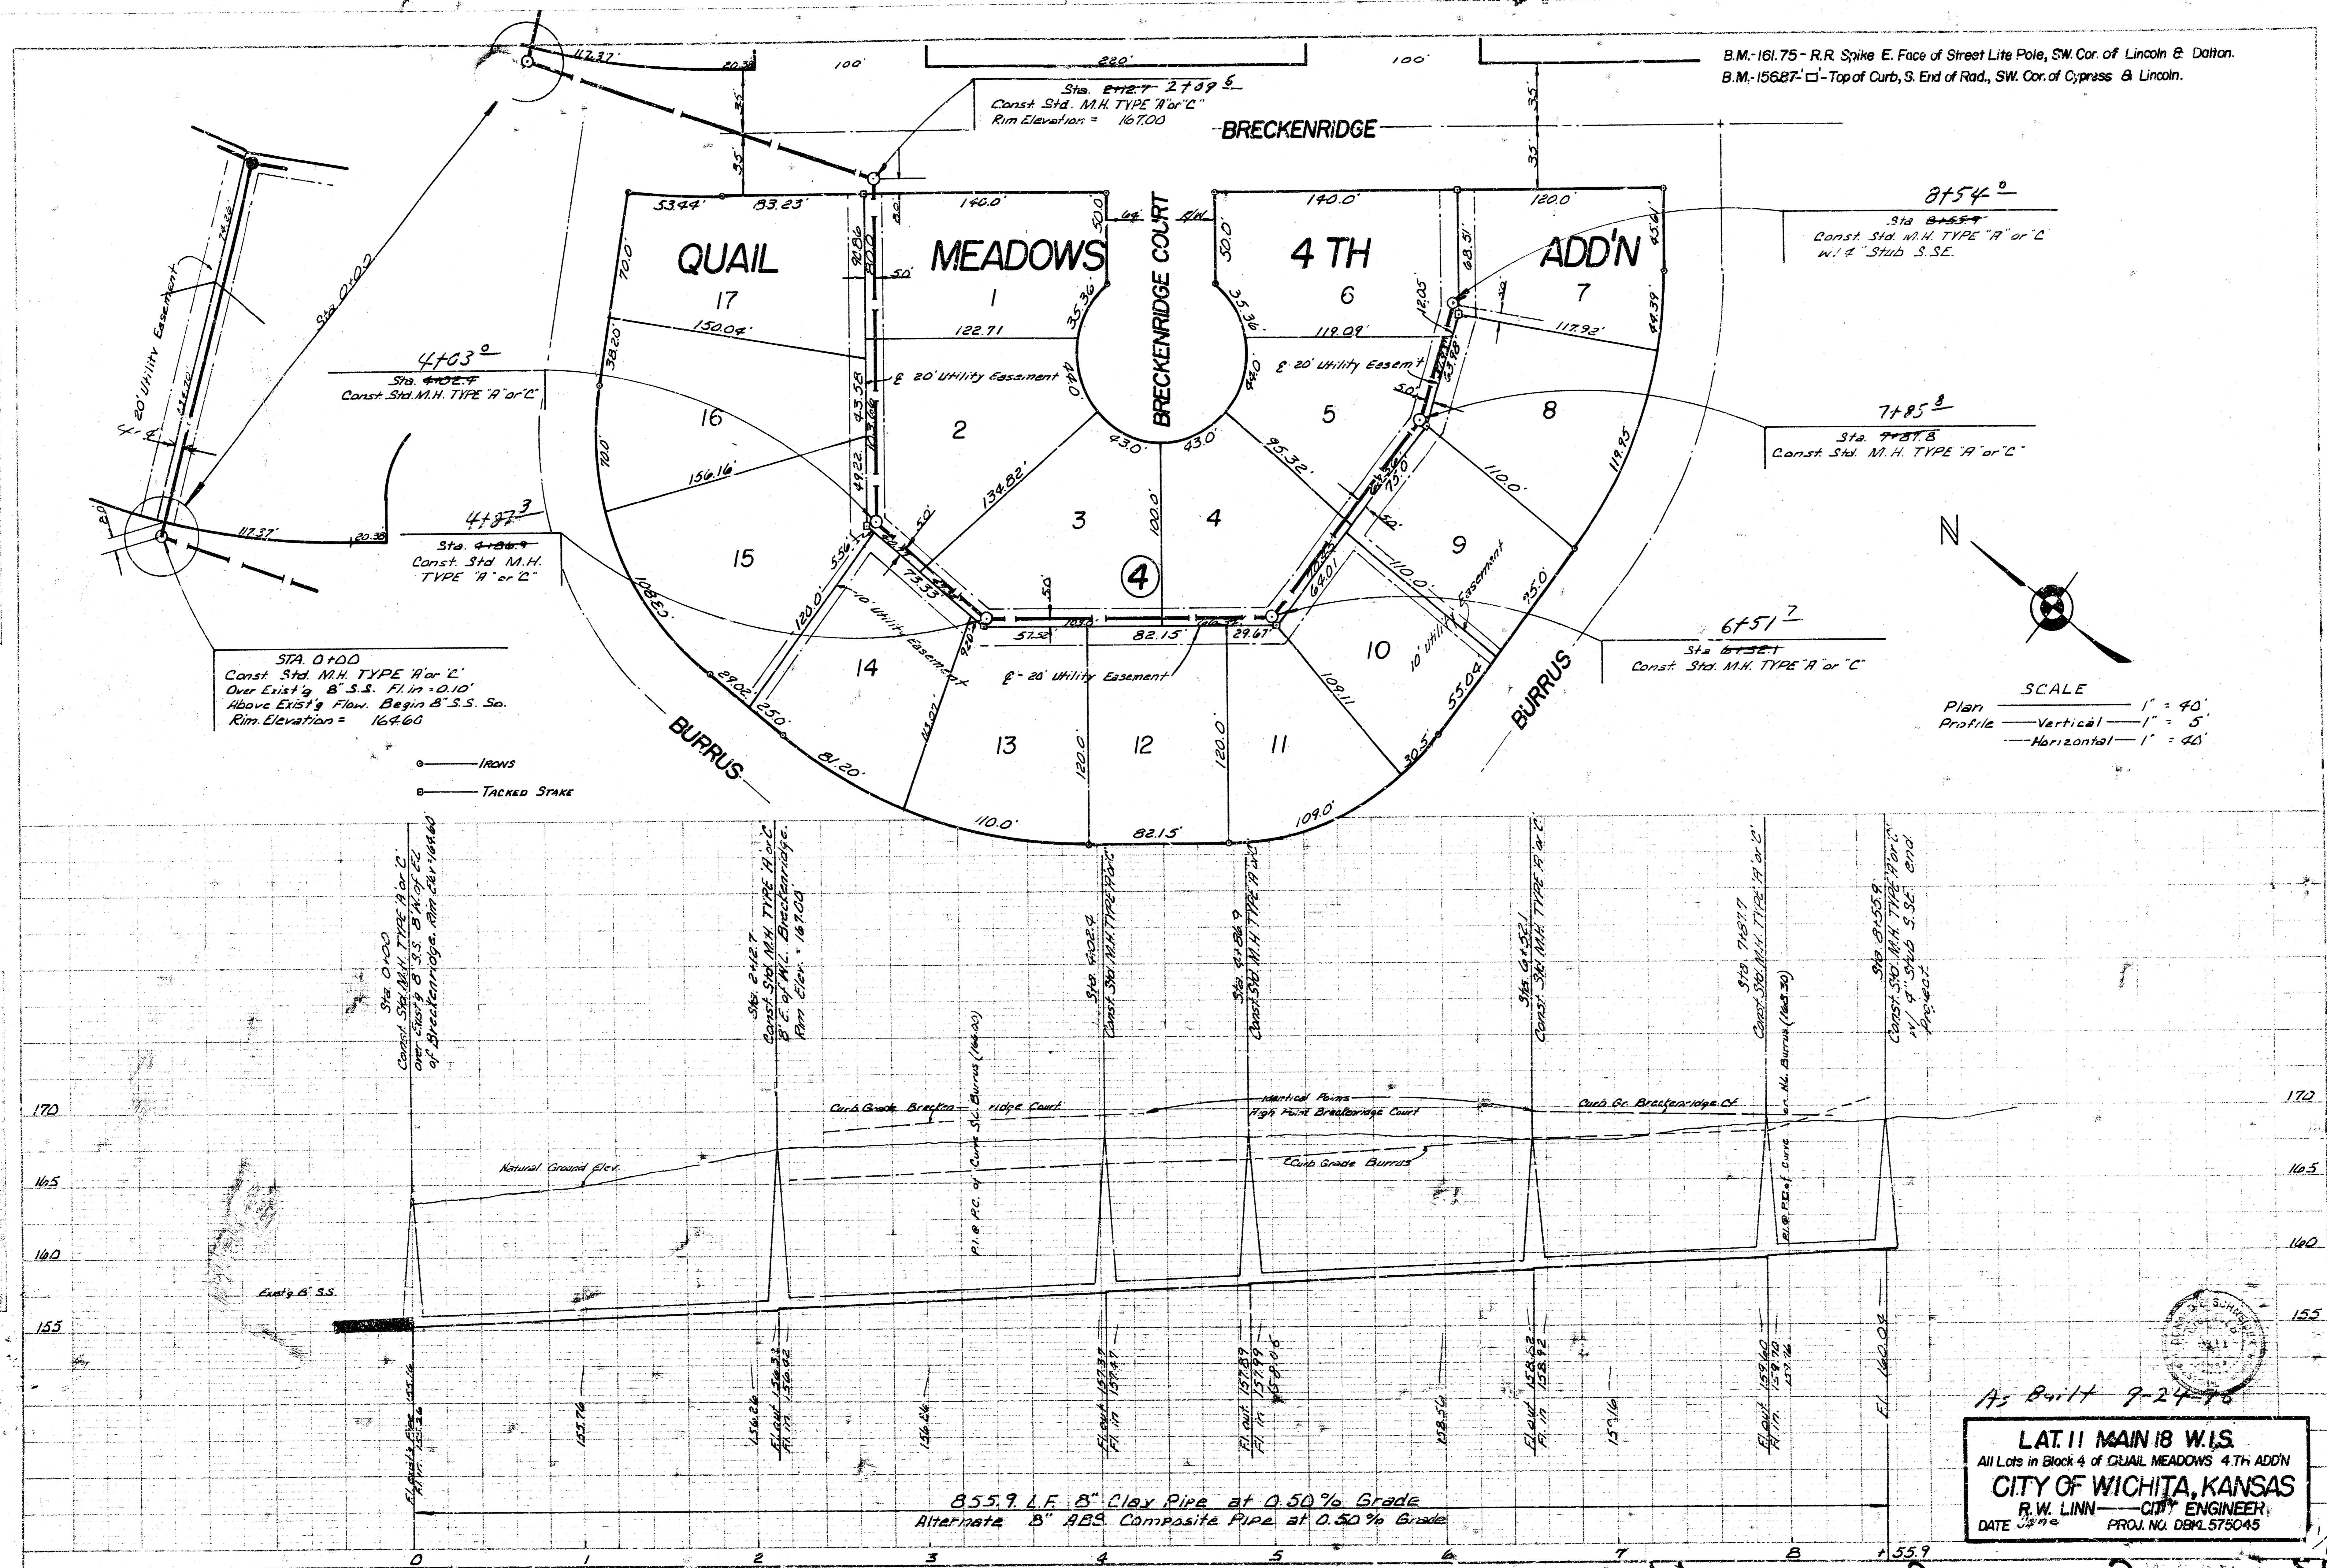

STA. 0+00
 Const. Std. M.H. TYPE 'A' or 'C'
 Over Exist'g B.S.S. Fl. in +0.10'
 Above Exist'g Flow. Begin B.S.S. So.
 Rim Elevation = 164.60

— IRONS
 — TACKED STAKE

SCALE
 Plan — 1" = 40'
 Profile — Vertical — 1" = 5'
 — Horizontal — 1" = 40'

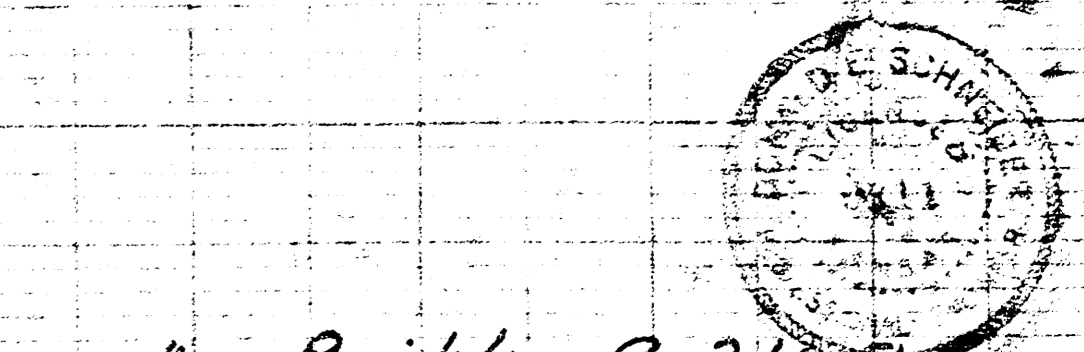

As Built 9-24-78
LAT. 11 MAIN 18 W.S.
 All Lots in Block 4 of QUAIL MEADOWS 4TH ADD'N
CITY OF WICHITA, KANSAS
 R.W. LINN — CITY ENGINEER
 DATE 3/2/78 PROJ. NO. DEM. 575045

855.9 L.F. 8" Clay Pipe at 0.50% Grade
 Alternate B' ABS Composite Pipe at 0.50% Grade