
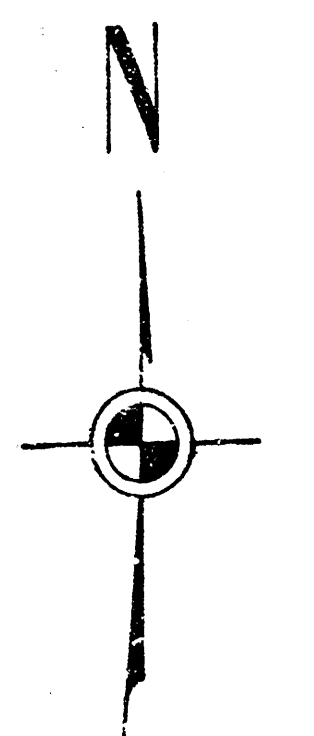


MAIN 19, WAR INDUSTRIES SEWER

CITY OF WICHITA, KANSAS


R. W. LINN - CITY ENGINEER

1976, PROJECT NO. DBKM 574055

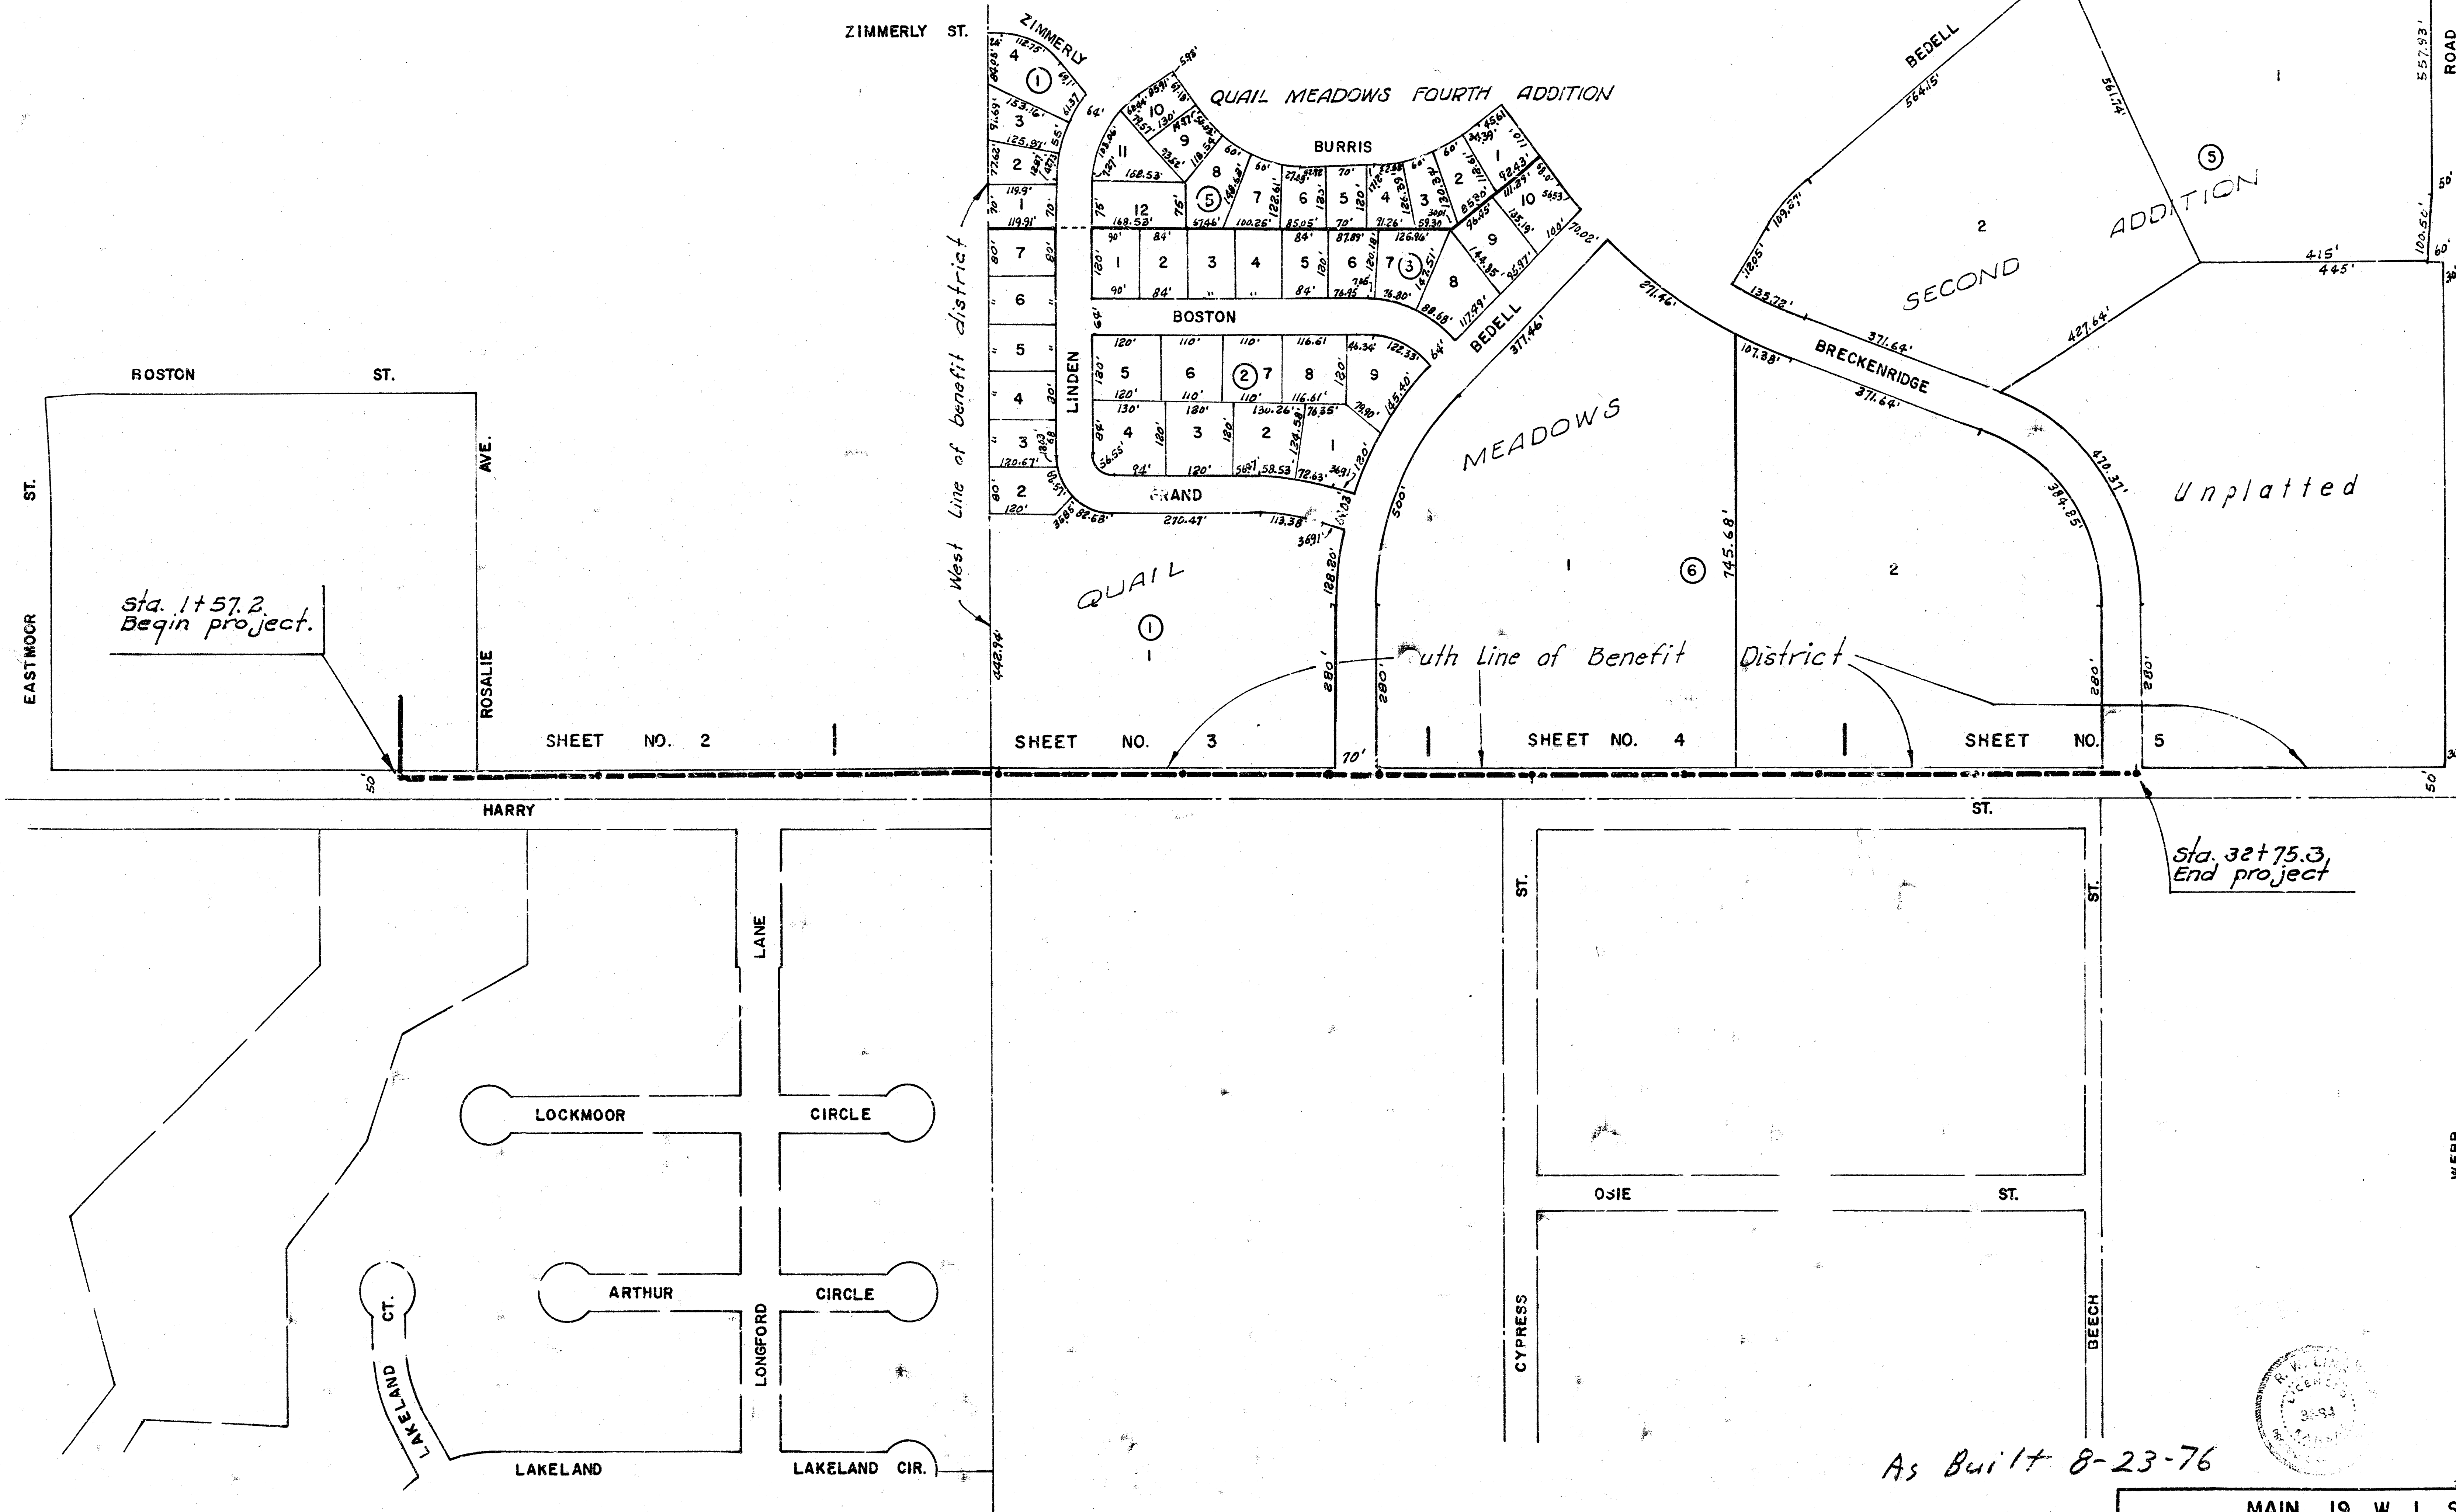


SCALE
1" = 150'

As Built 8-23-76

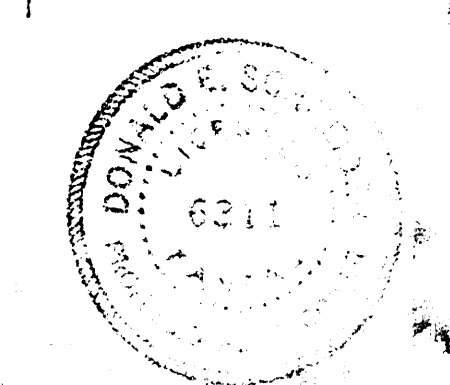

B. M. 161.82 City Std. 42' W. & 48' S. of 1/4 Sec. cor.
1/2 Mile E. of Rock Rd. & Harry.

B. M. 172.03 Webb Rd. & Harry City B.M. disc.
48' So. & 46' W. of E. both.

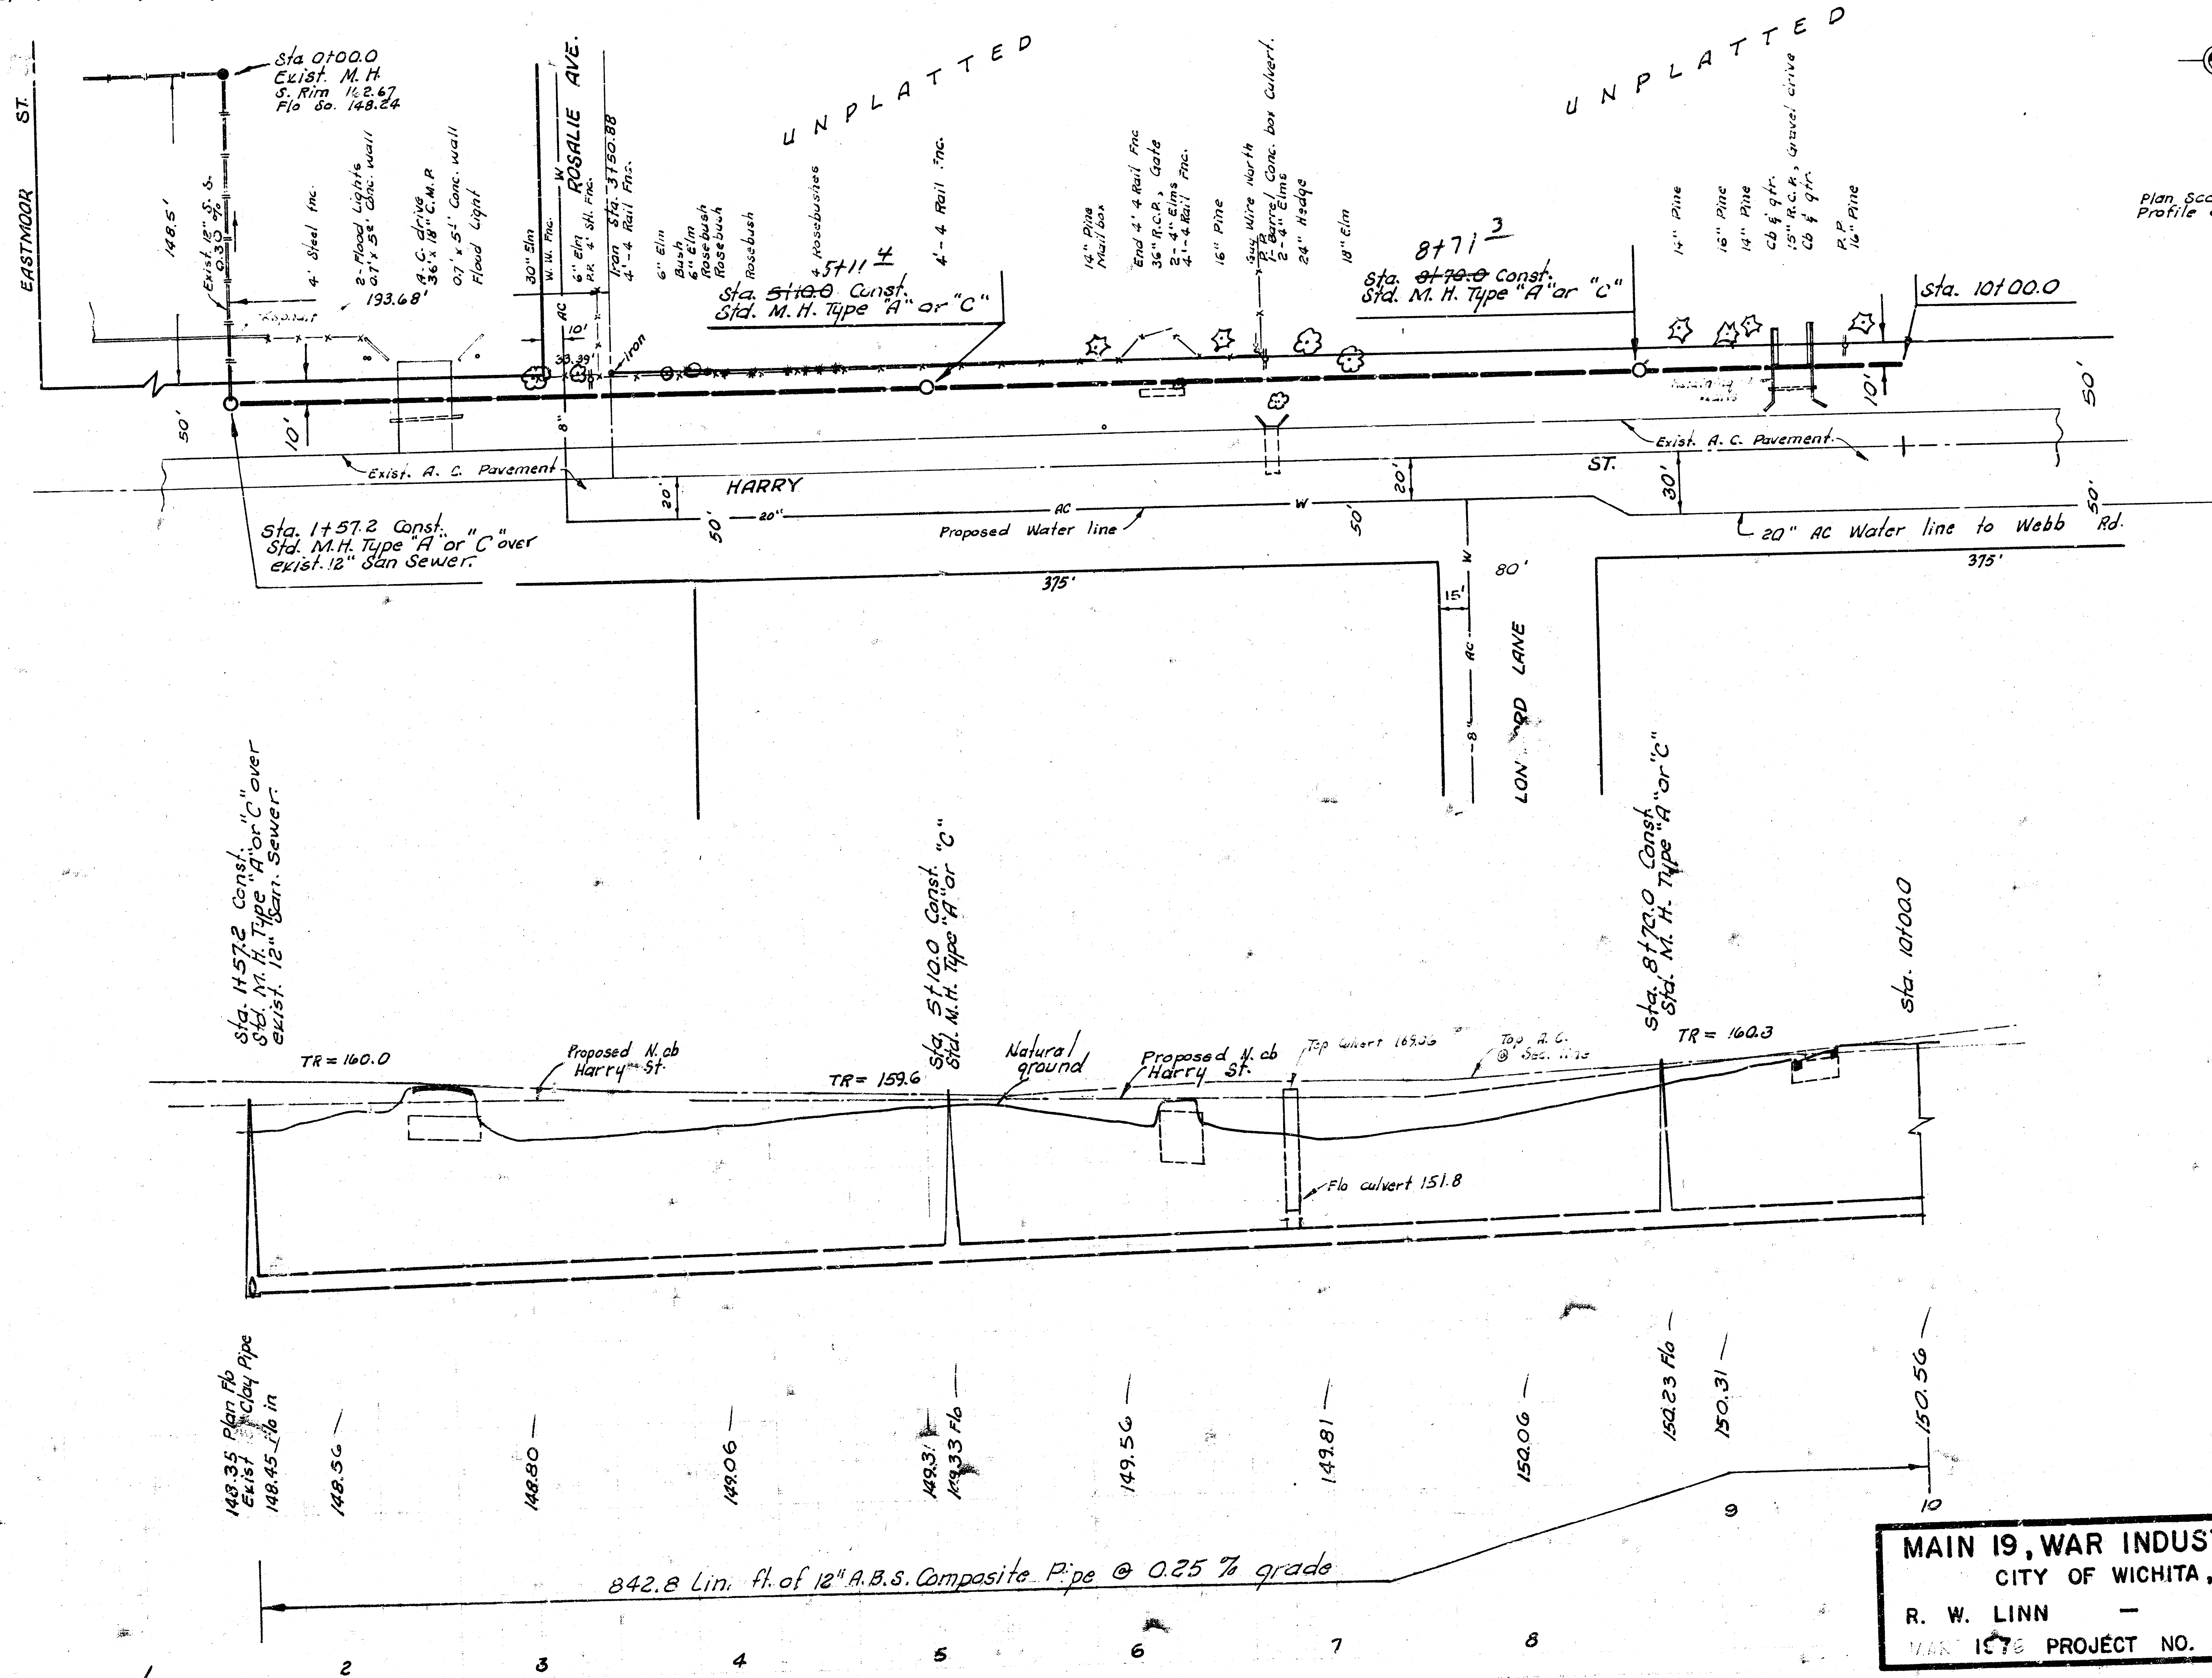

Plan Scale 1" = 40' Horiz.
Profile Scale 1" = 5' Vert.

MAIN 19, WAR INDUSTRIES SEWER
CITY OF WICHITA, KANSAS
R. W. LINN — CITY ENGINEER
PROJECT NO. DBKM 57 4055

