
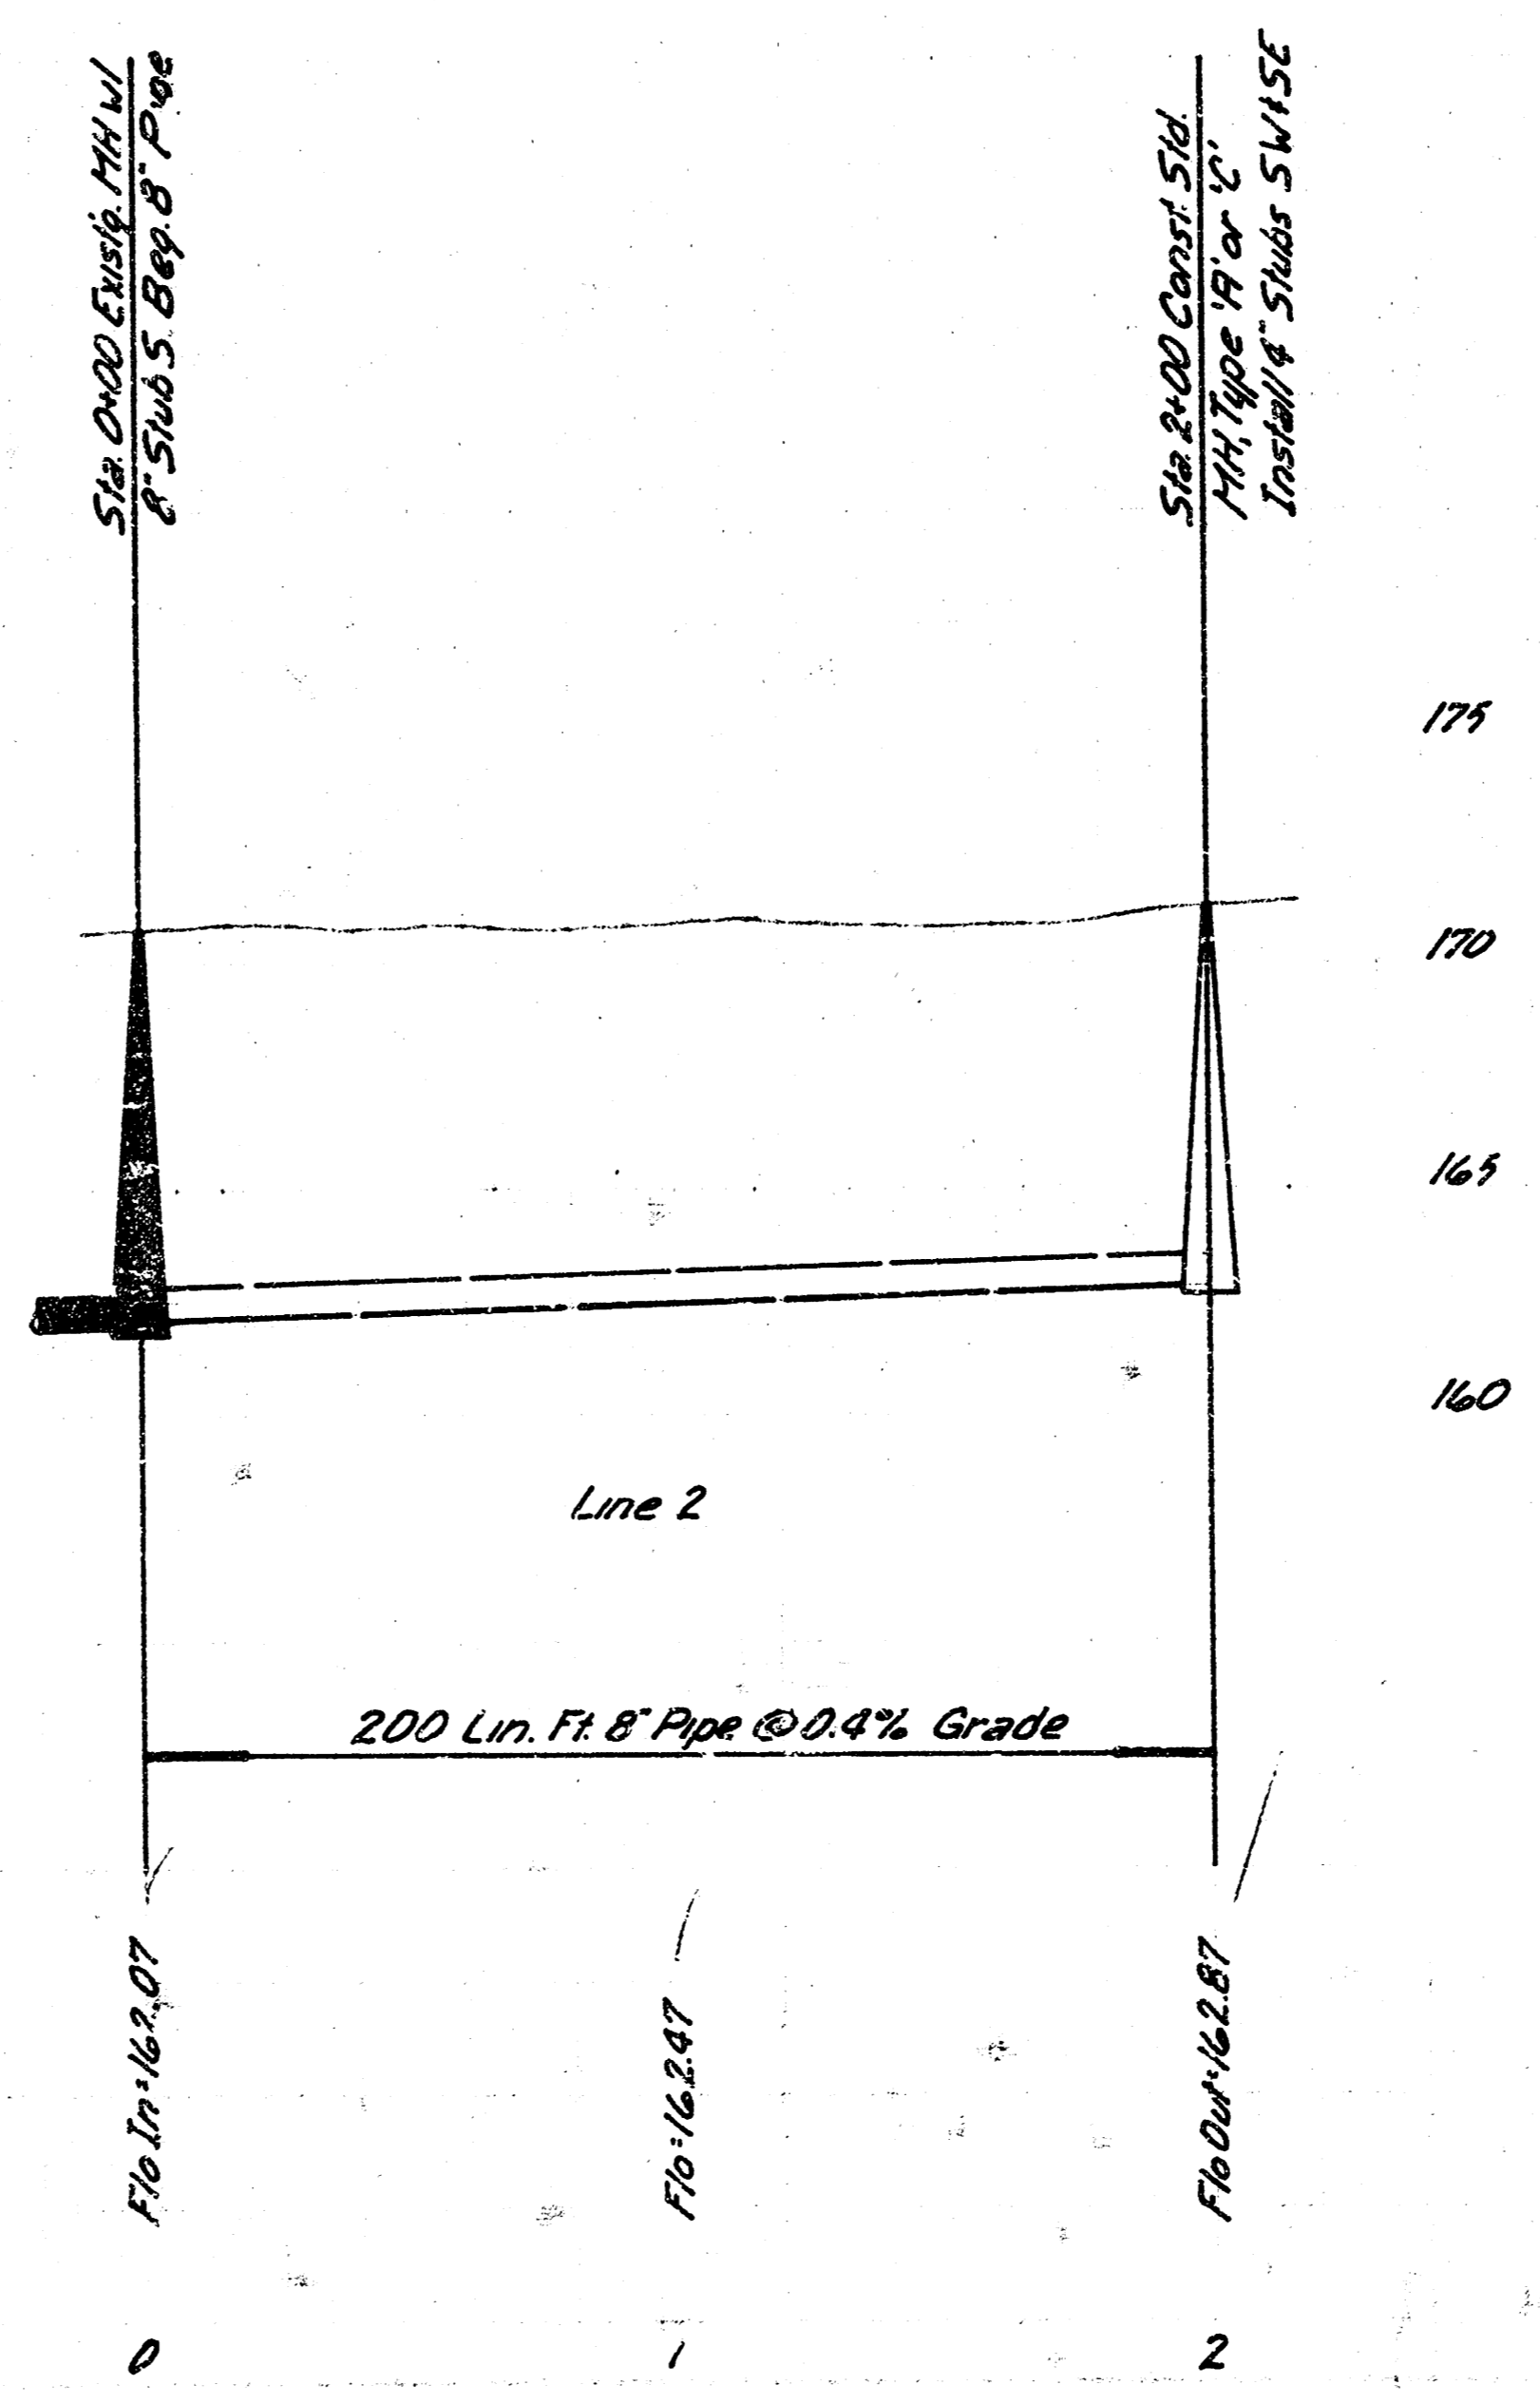


Field Engineer to set Top of MH's to Finish Grade as Determined by the Developer.

B.M. 16948 R.R. Spk. W. Face P. Pole N.E. Cor Funston & Cypress

SCALE
Plan 1"=40'
Profile Vert. 1"=40'
Vert. 1"=5'

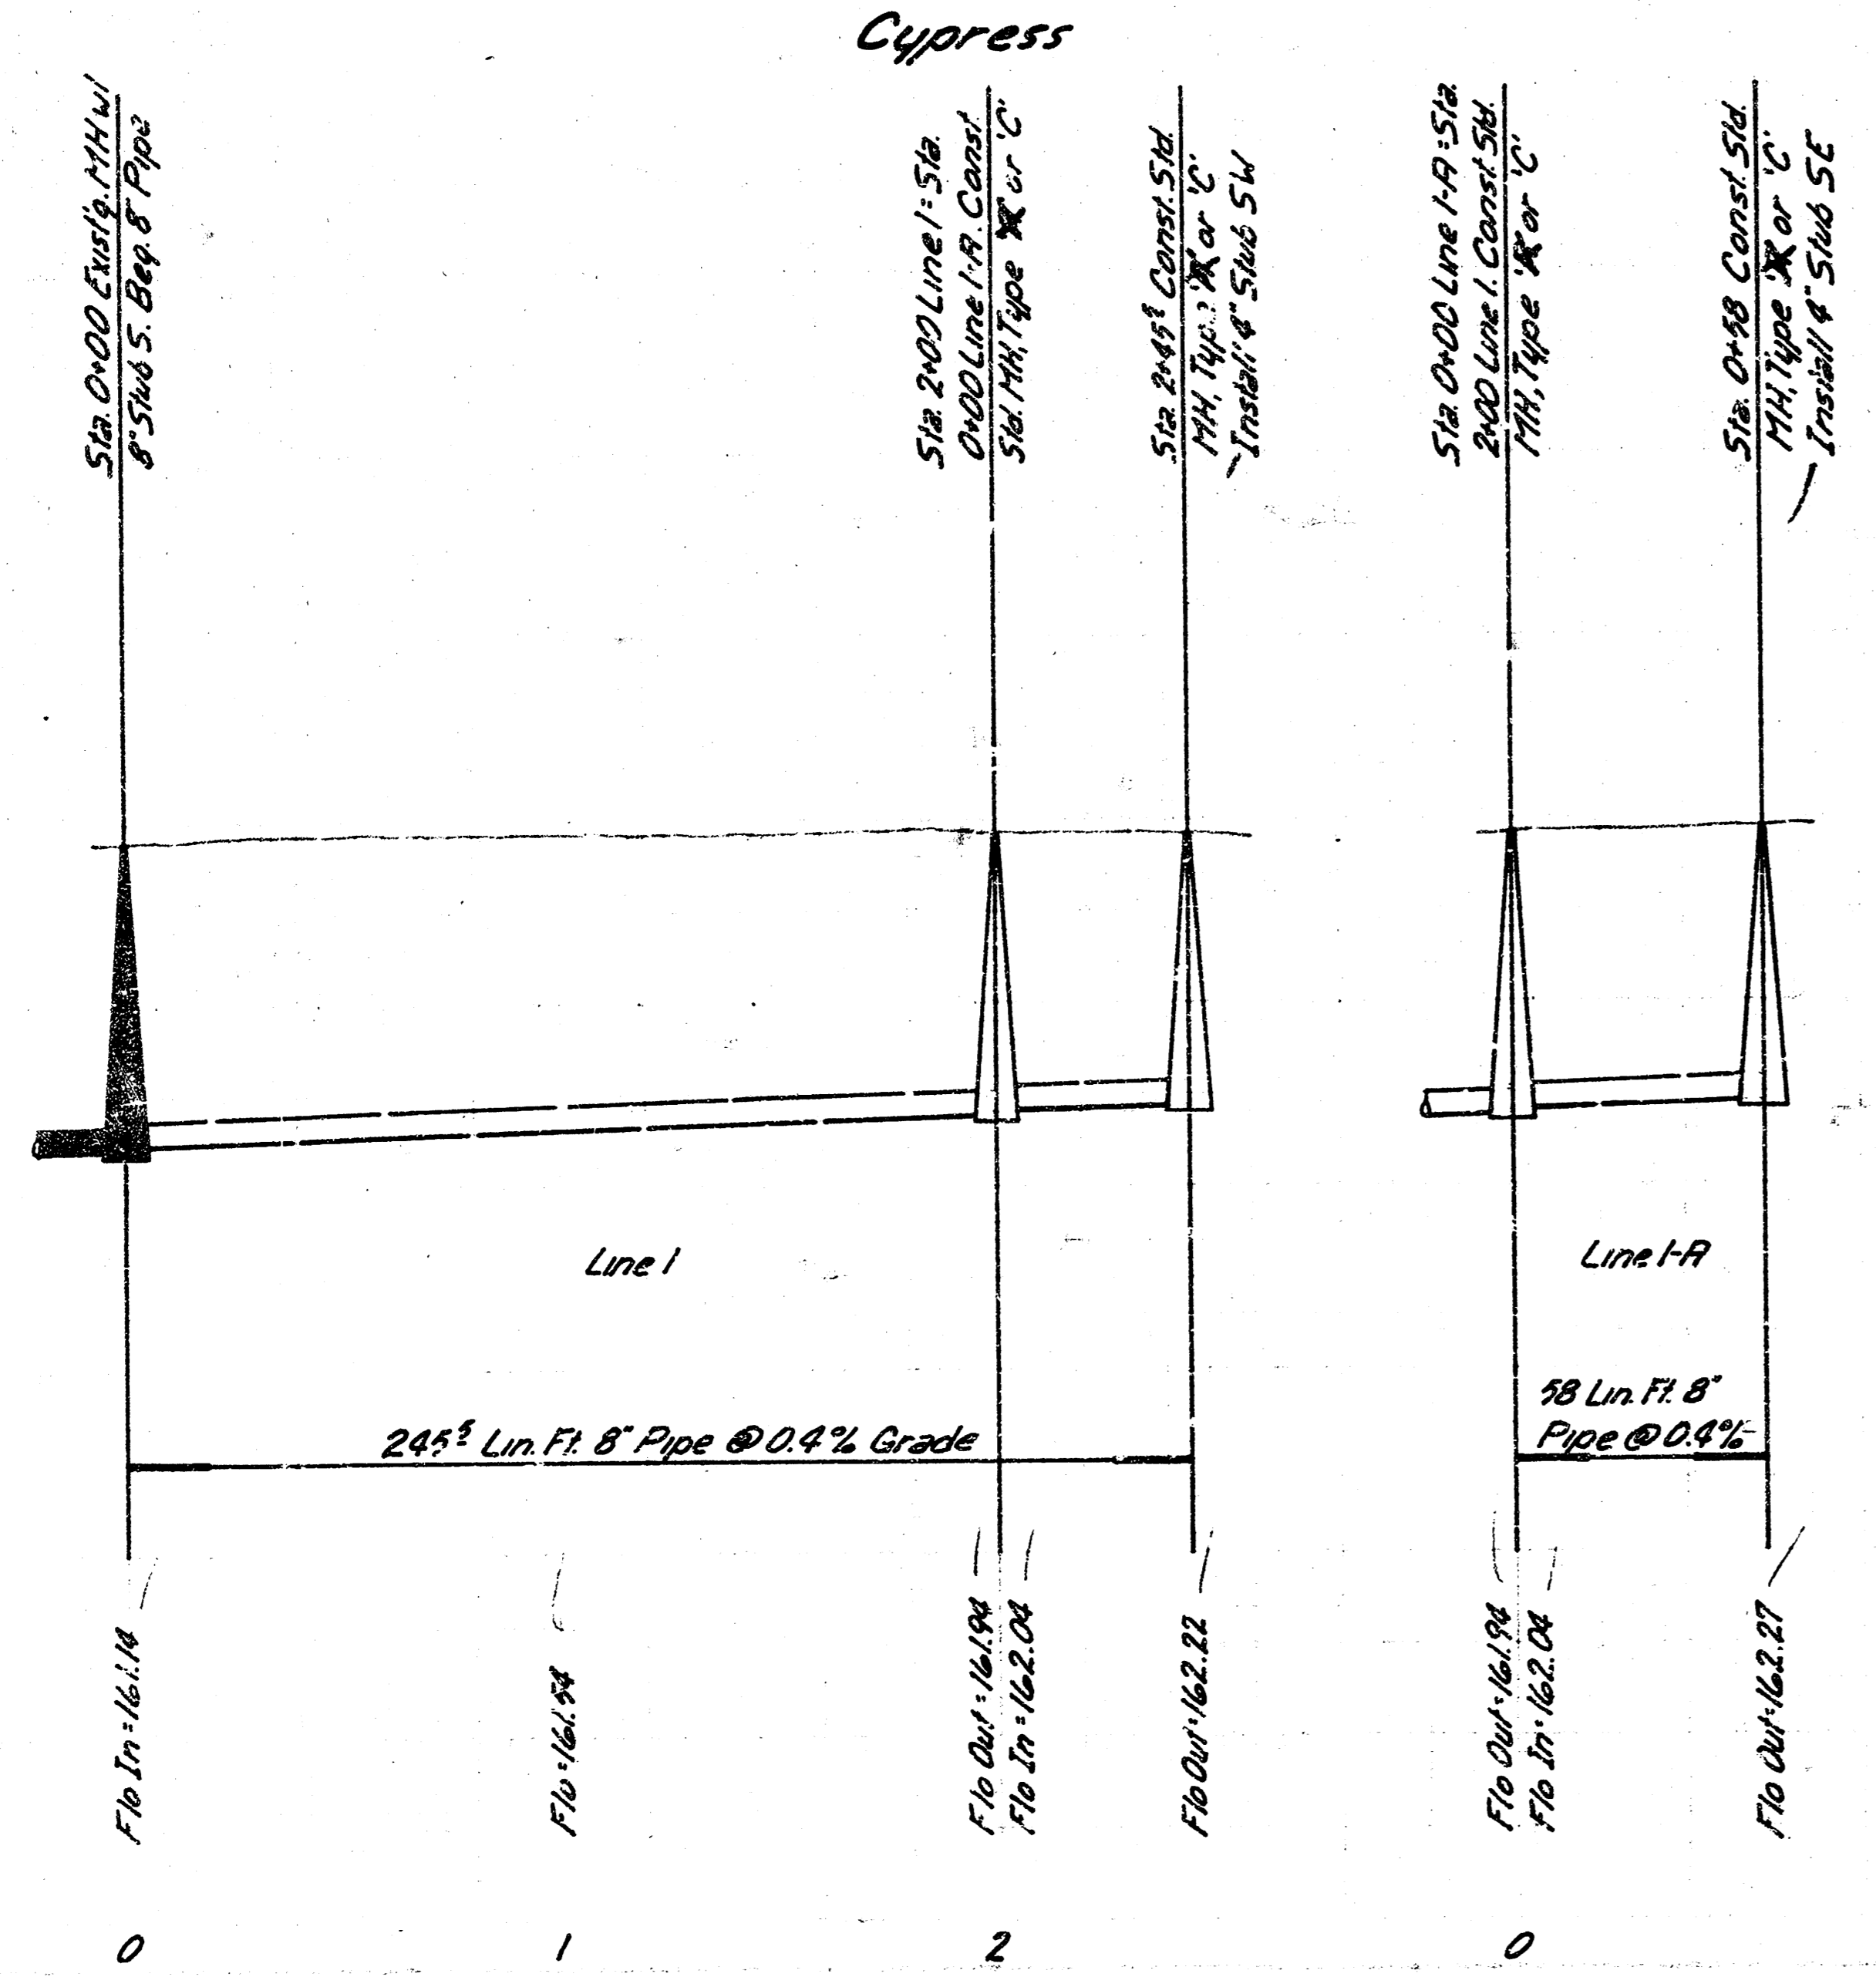




As Built 2d 9/1/70
BK'S-E286
Revised 3/11/80 EDS

8208
KANSAS
ENGINEER




Lateral 9, Main 19, War Industries Sewer
468-76-245-80871-000-000-301
Dept. of Public Works-Eng. Div.
City of Wichita, Kansas
Dean S. Sellers - Acting City Engineer

Date: _____

FILMED FROM THE BEST AVAILABLE COPY

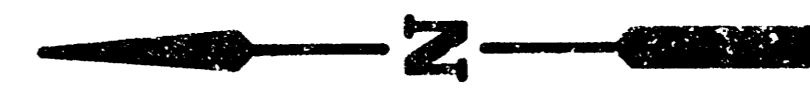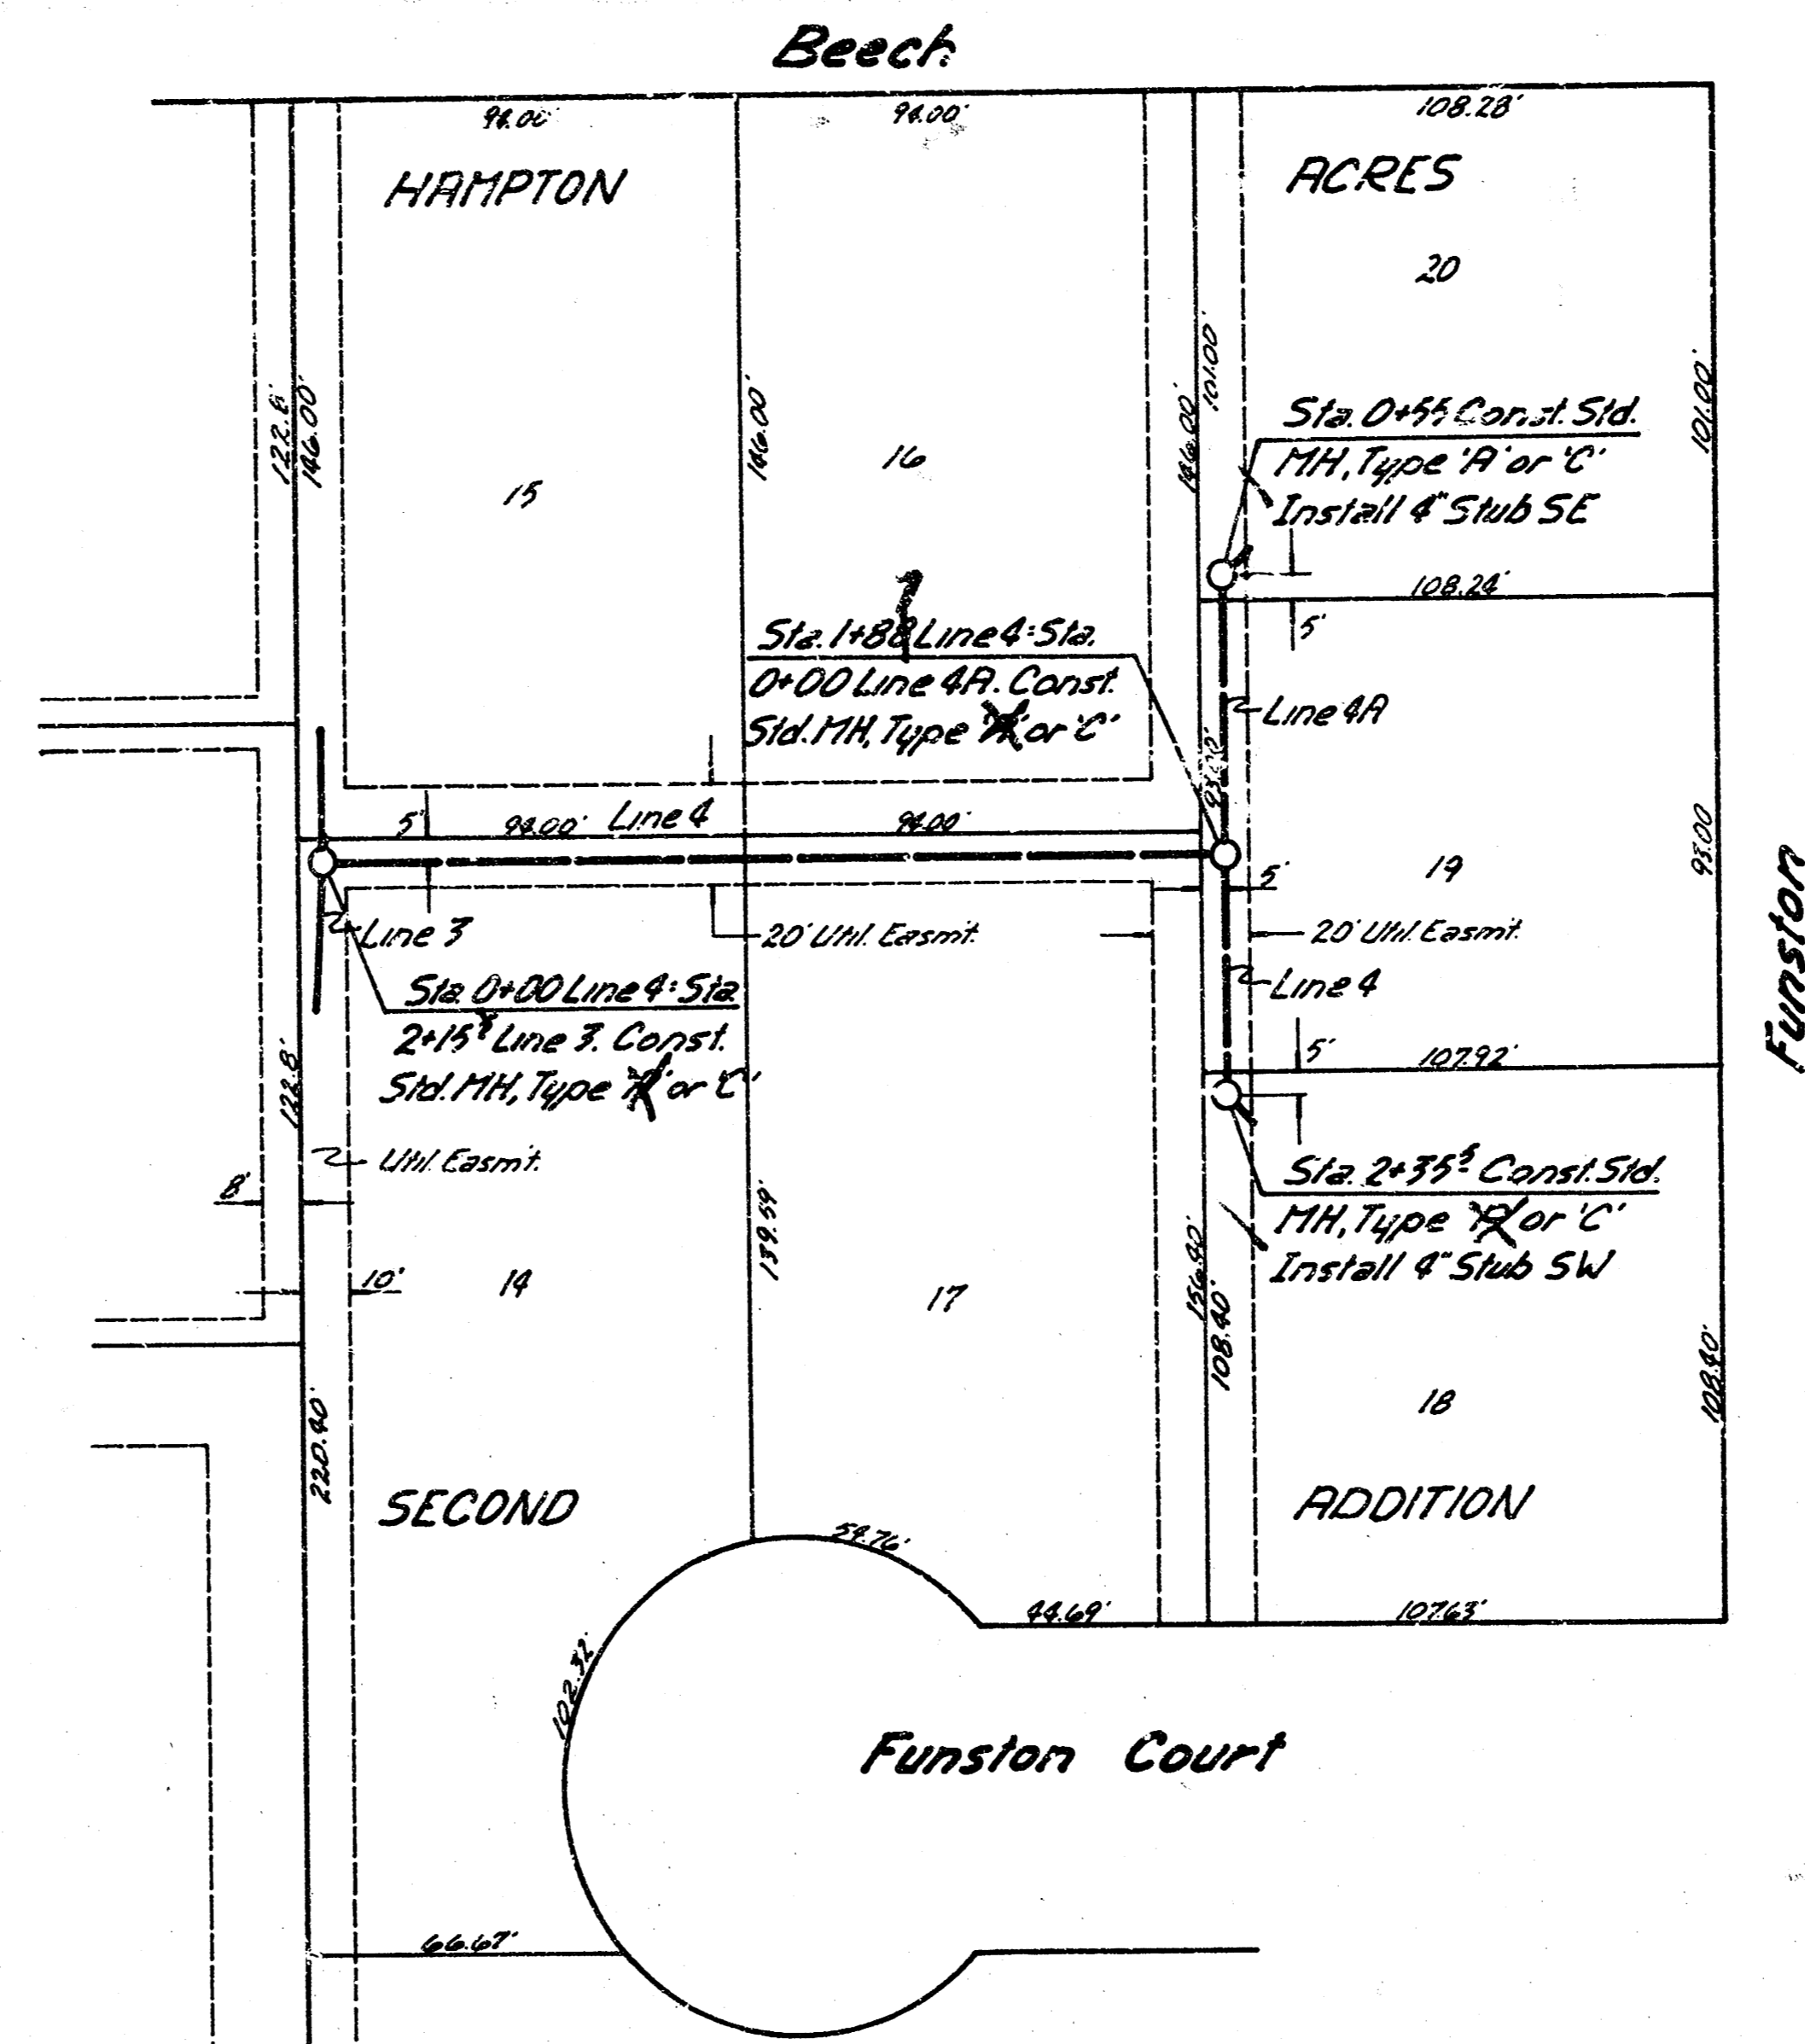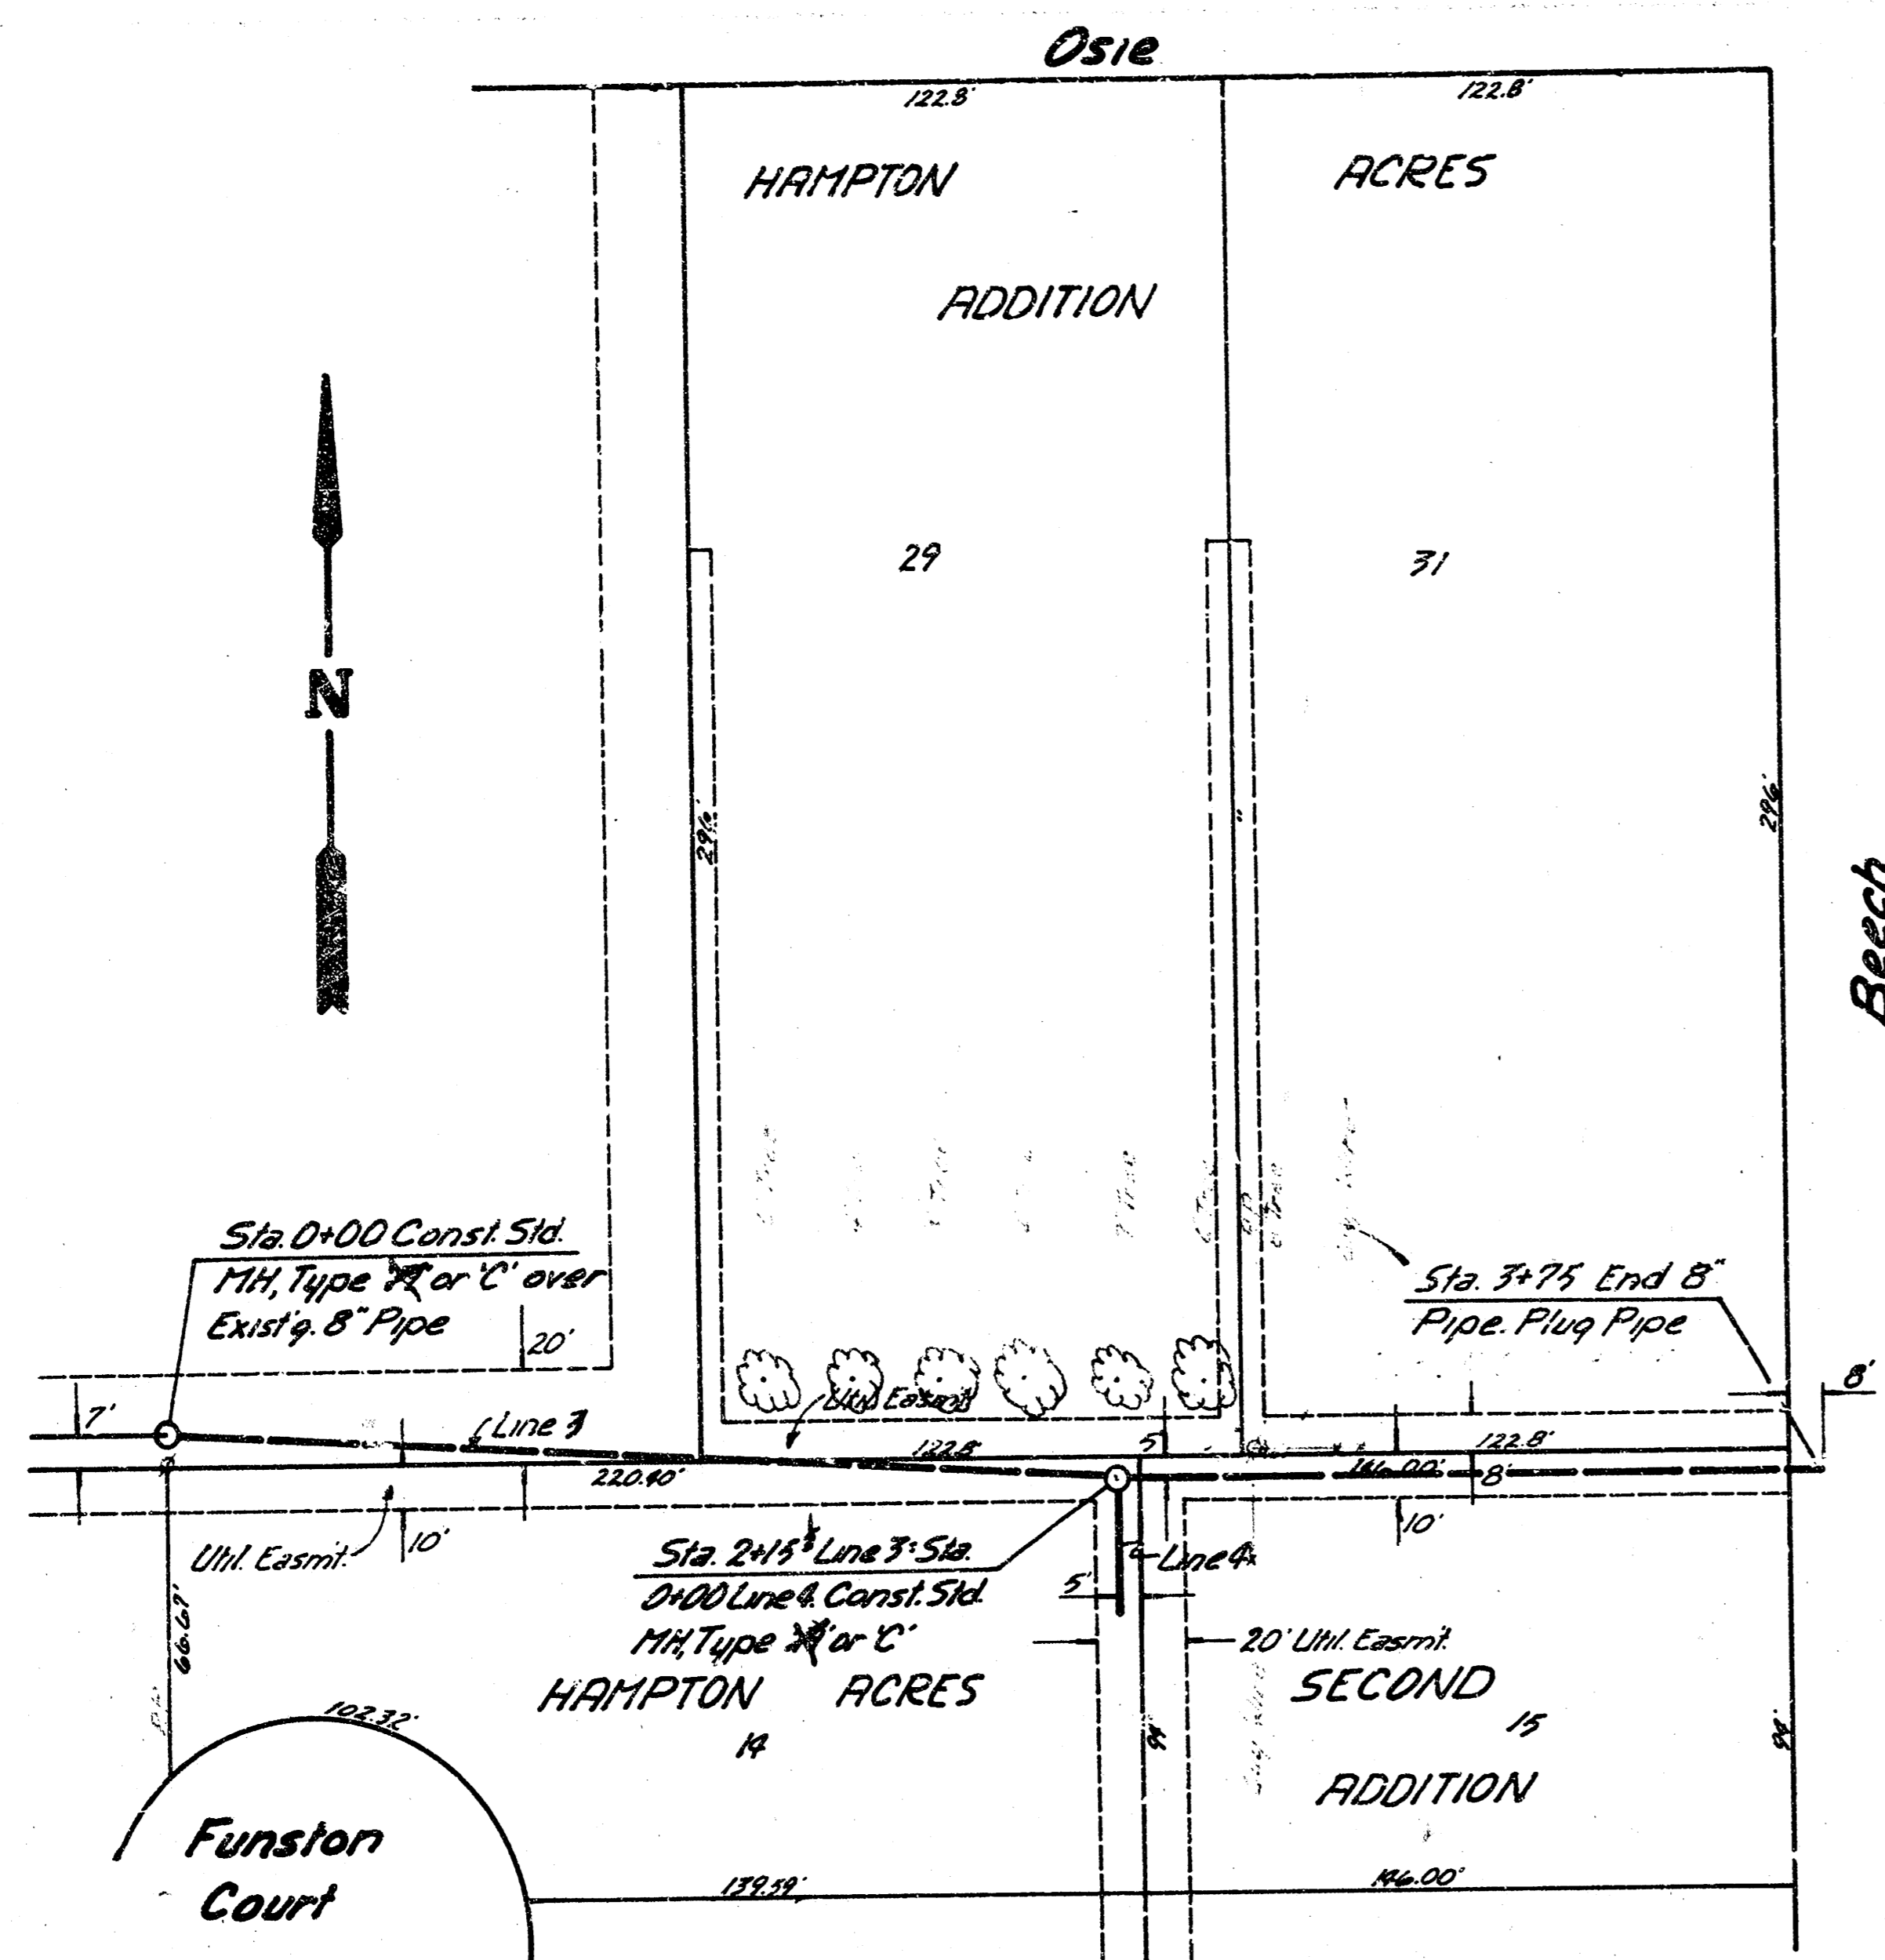

SCALE
Plan 1"=40'
Profile Hor. 1"=40'
Vert. 1"=5'

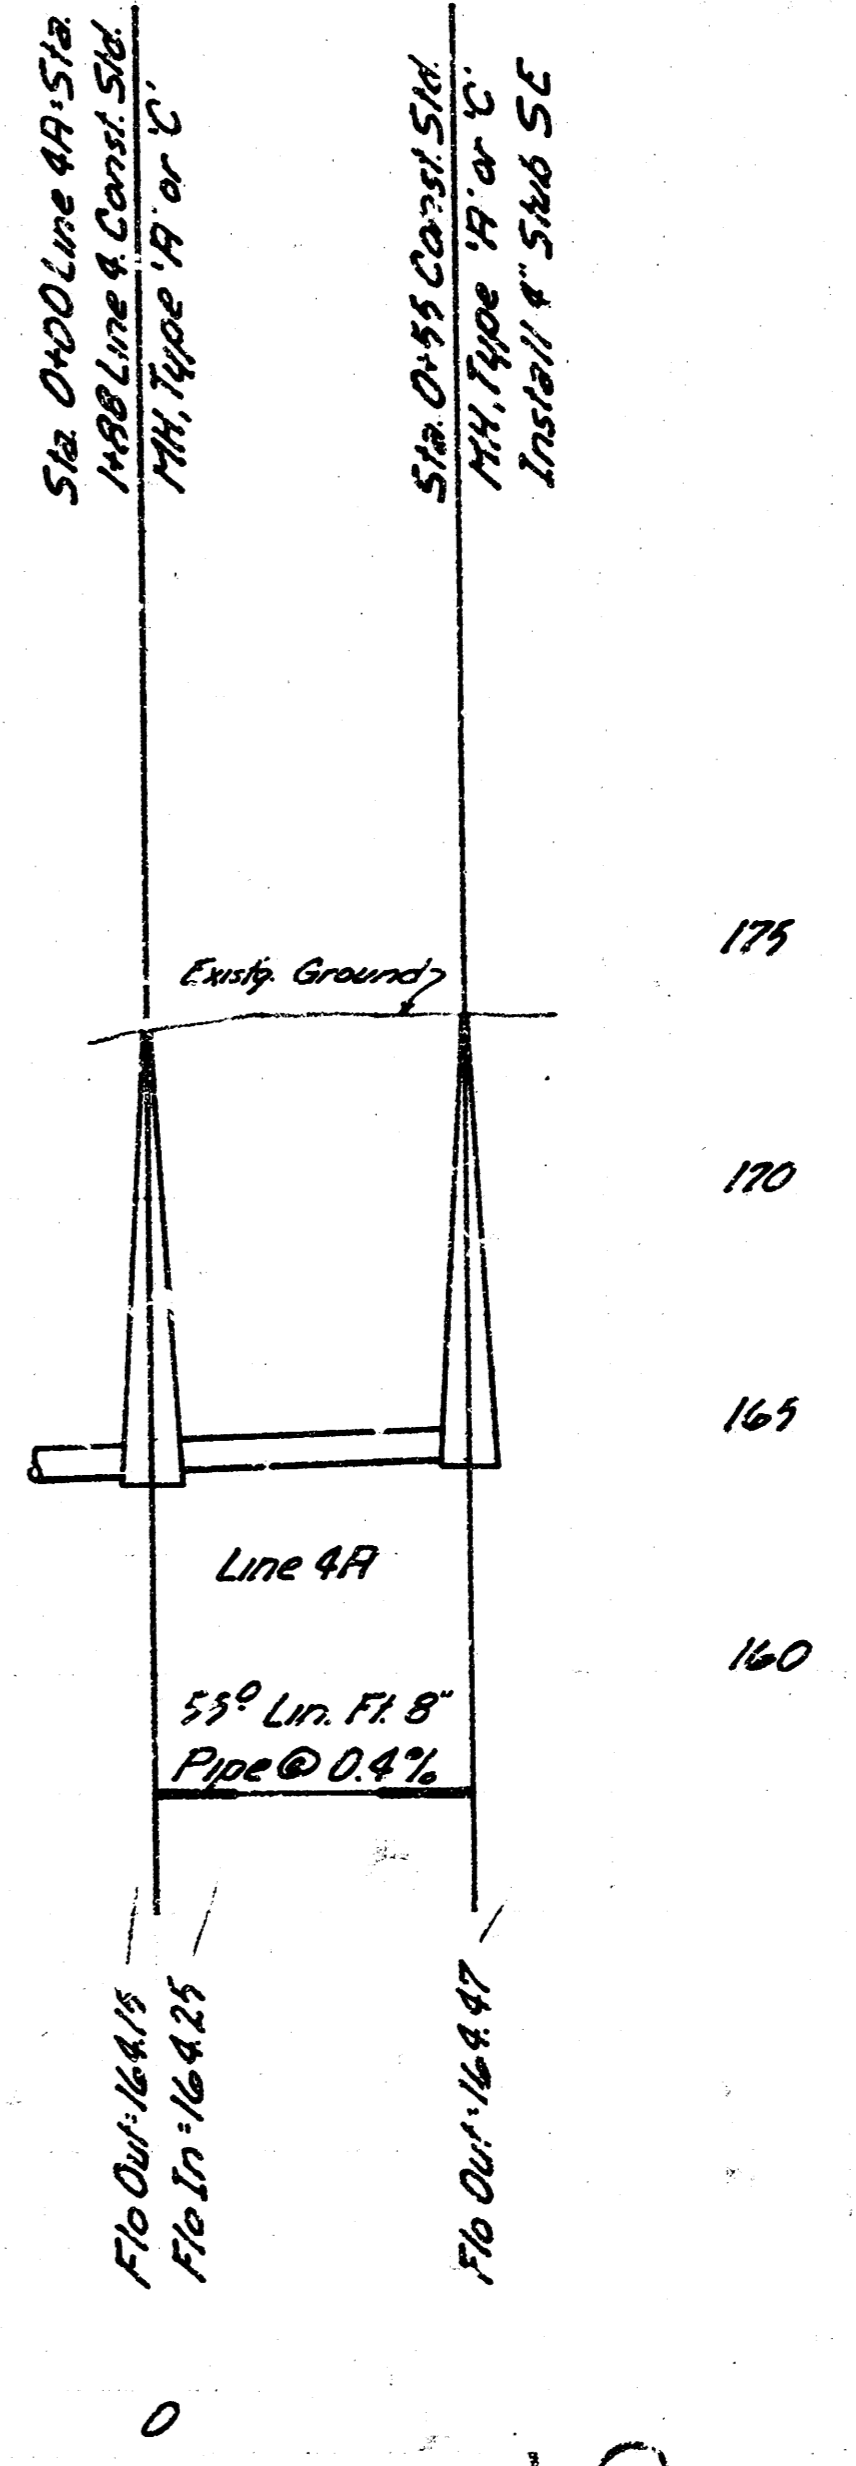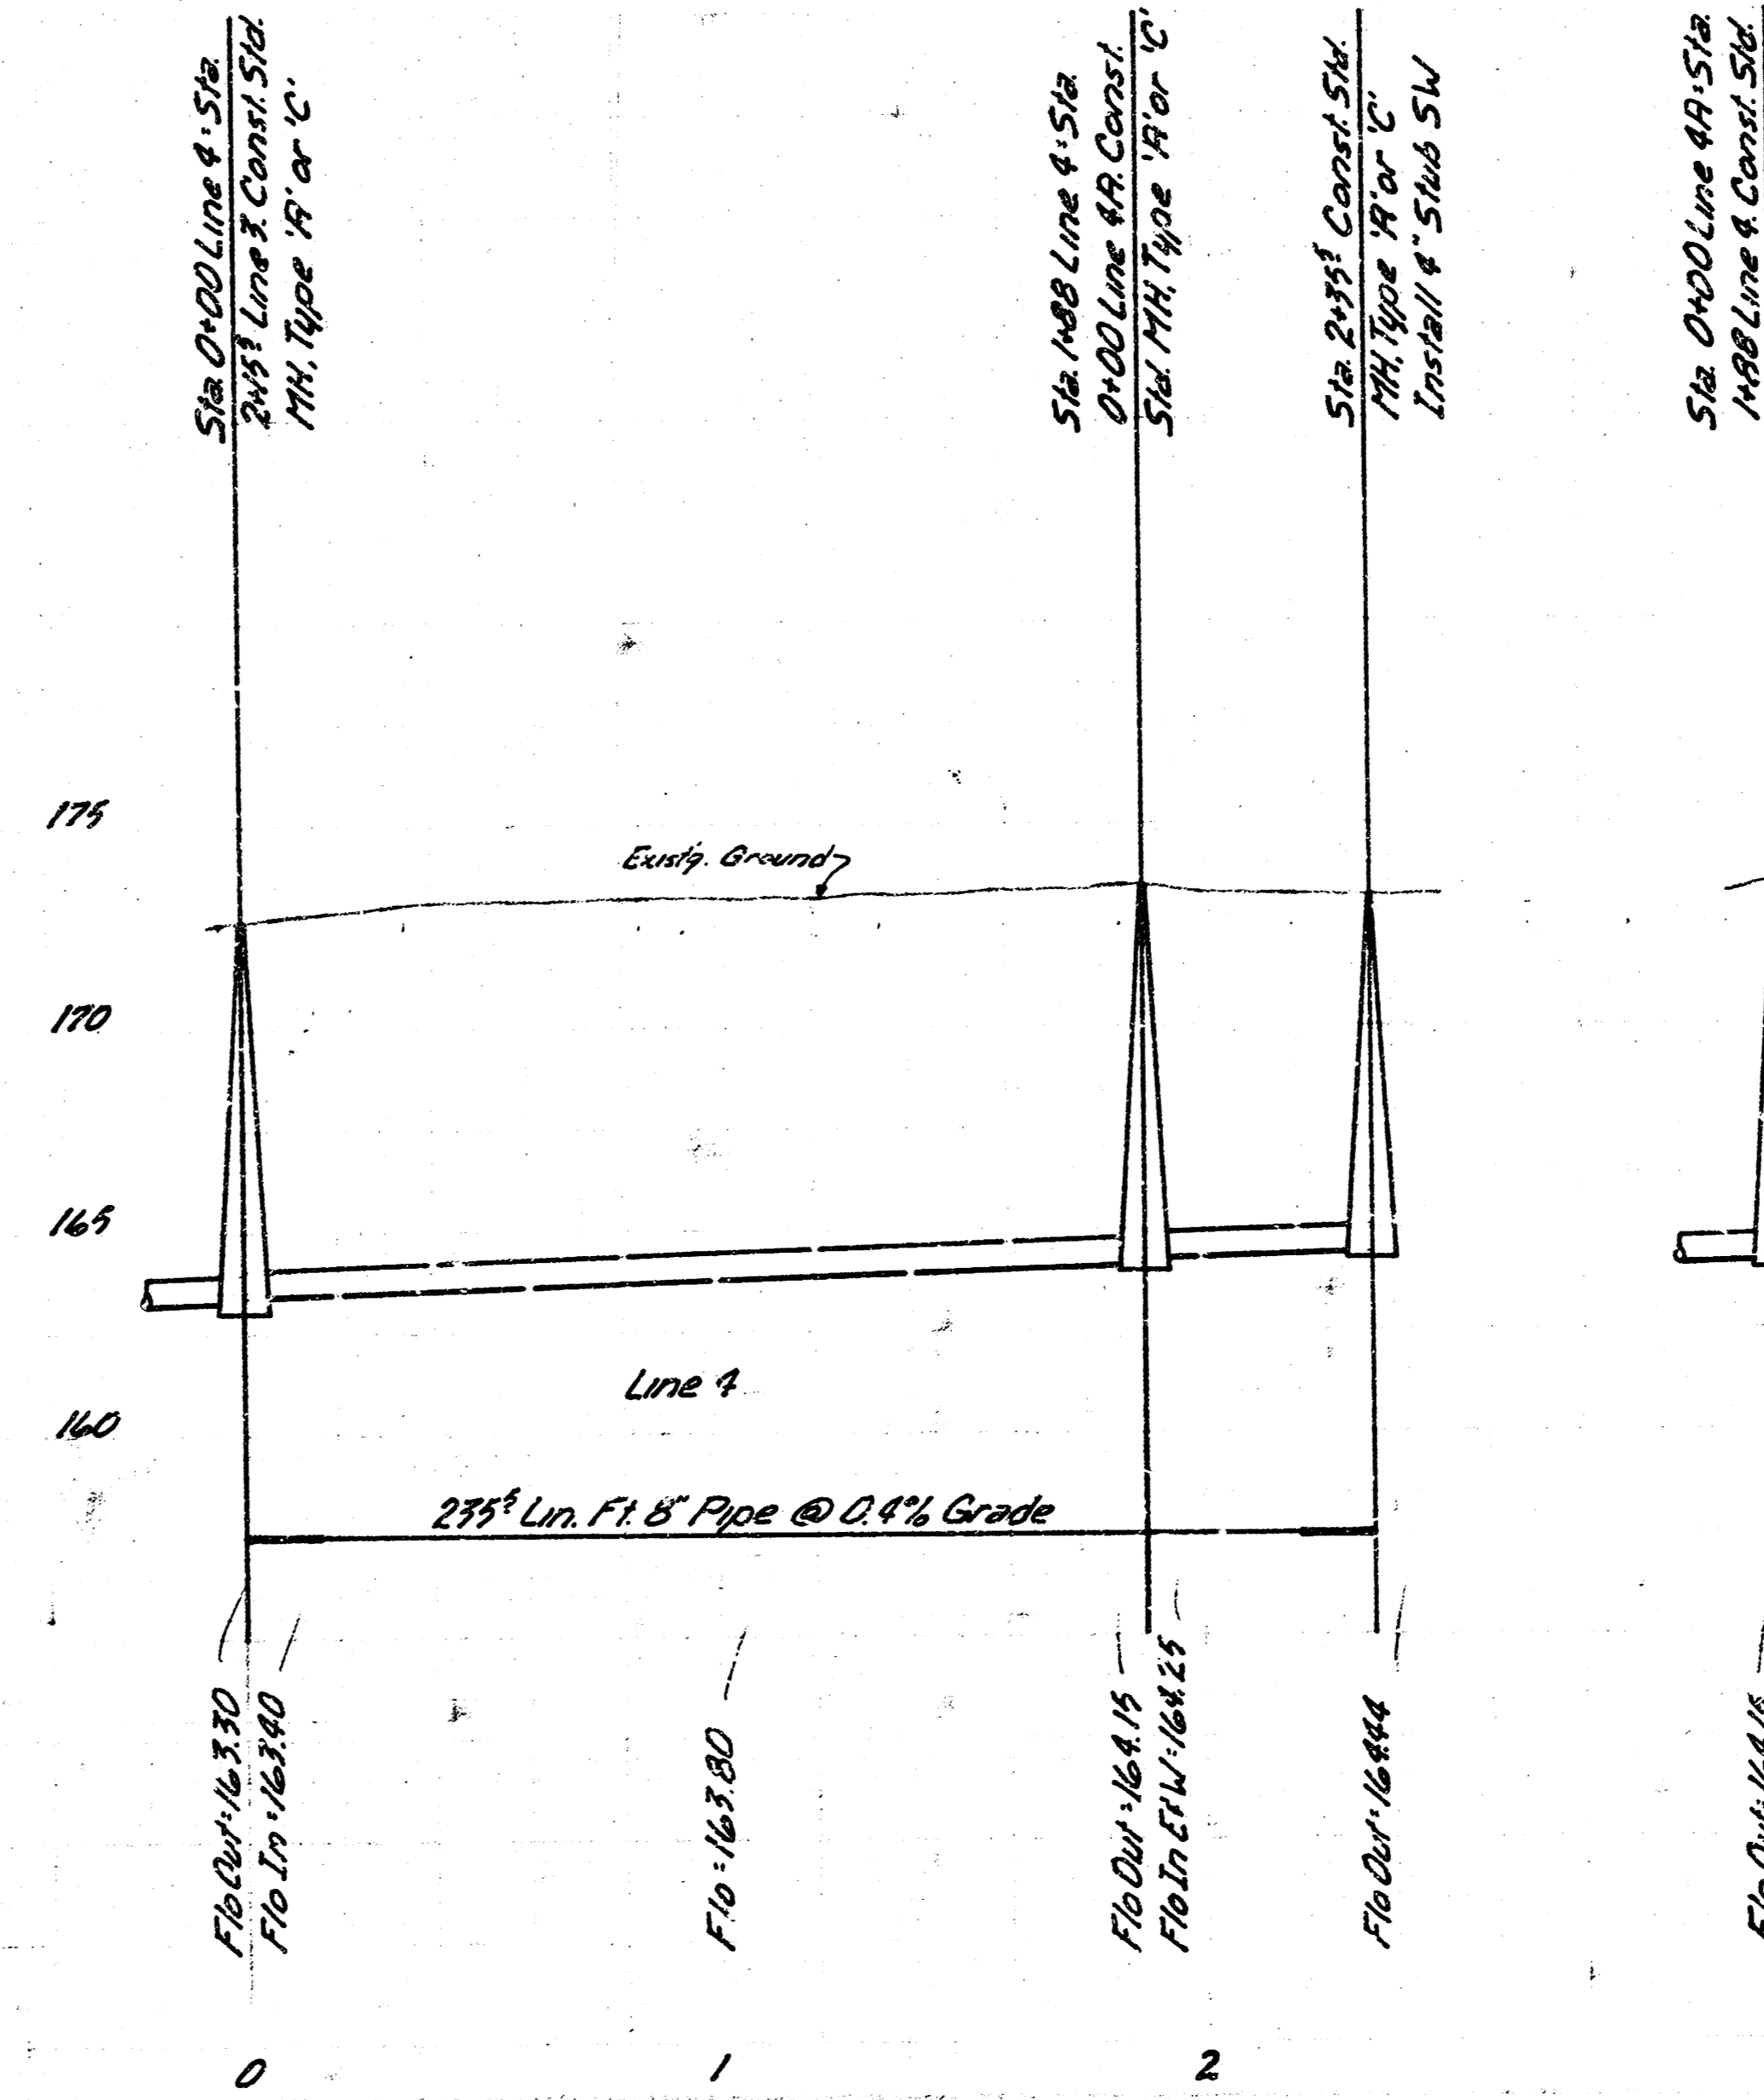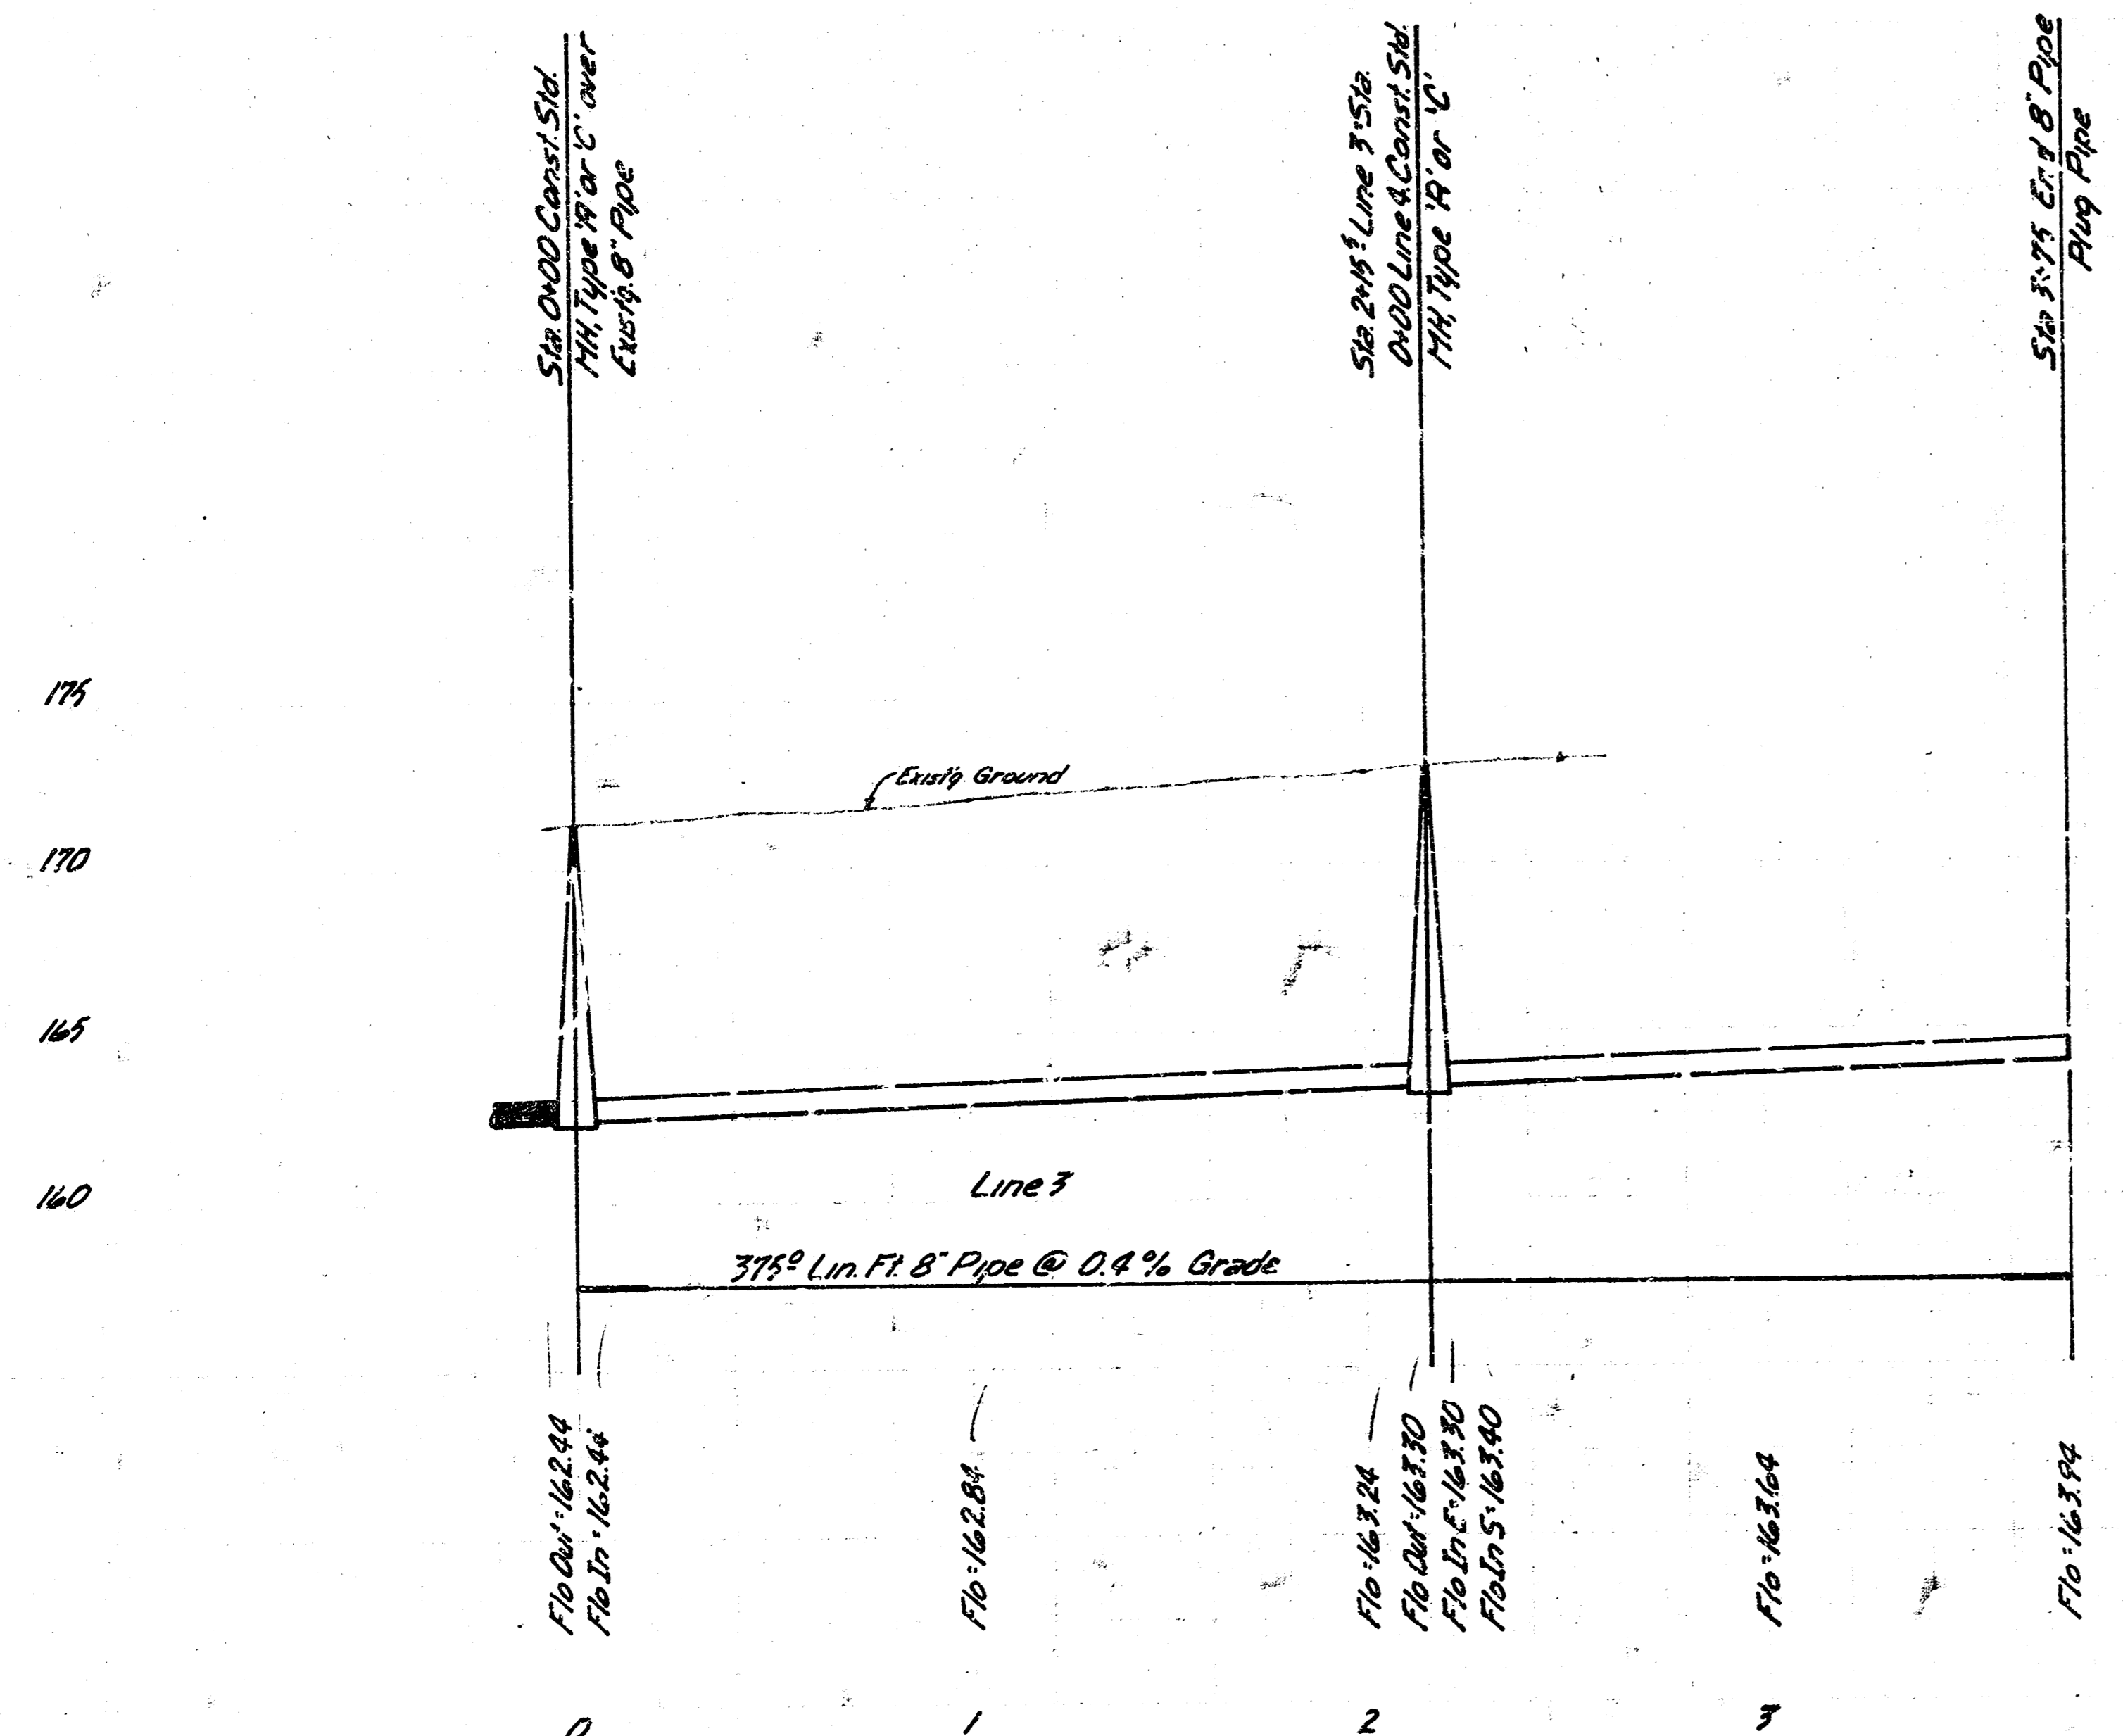

Revised 3/14/80

Lat. 9, Main 19, W15

FILMED FROM THE BEST AVAILABLE COPY