


E. B. Sellers
R. 12/20/83

D.R. 33

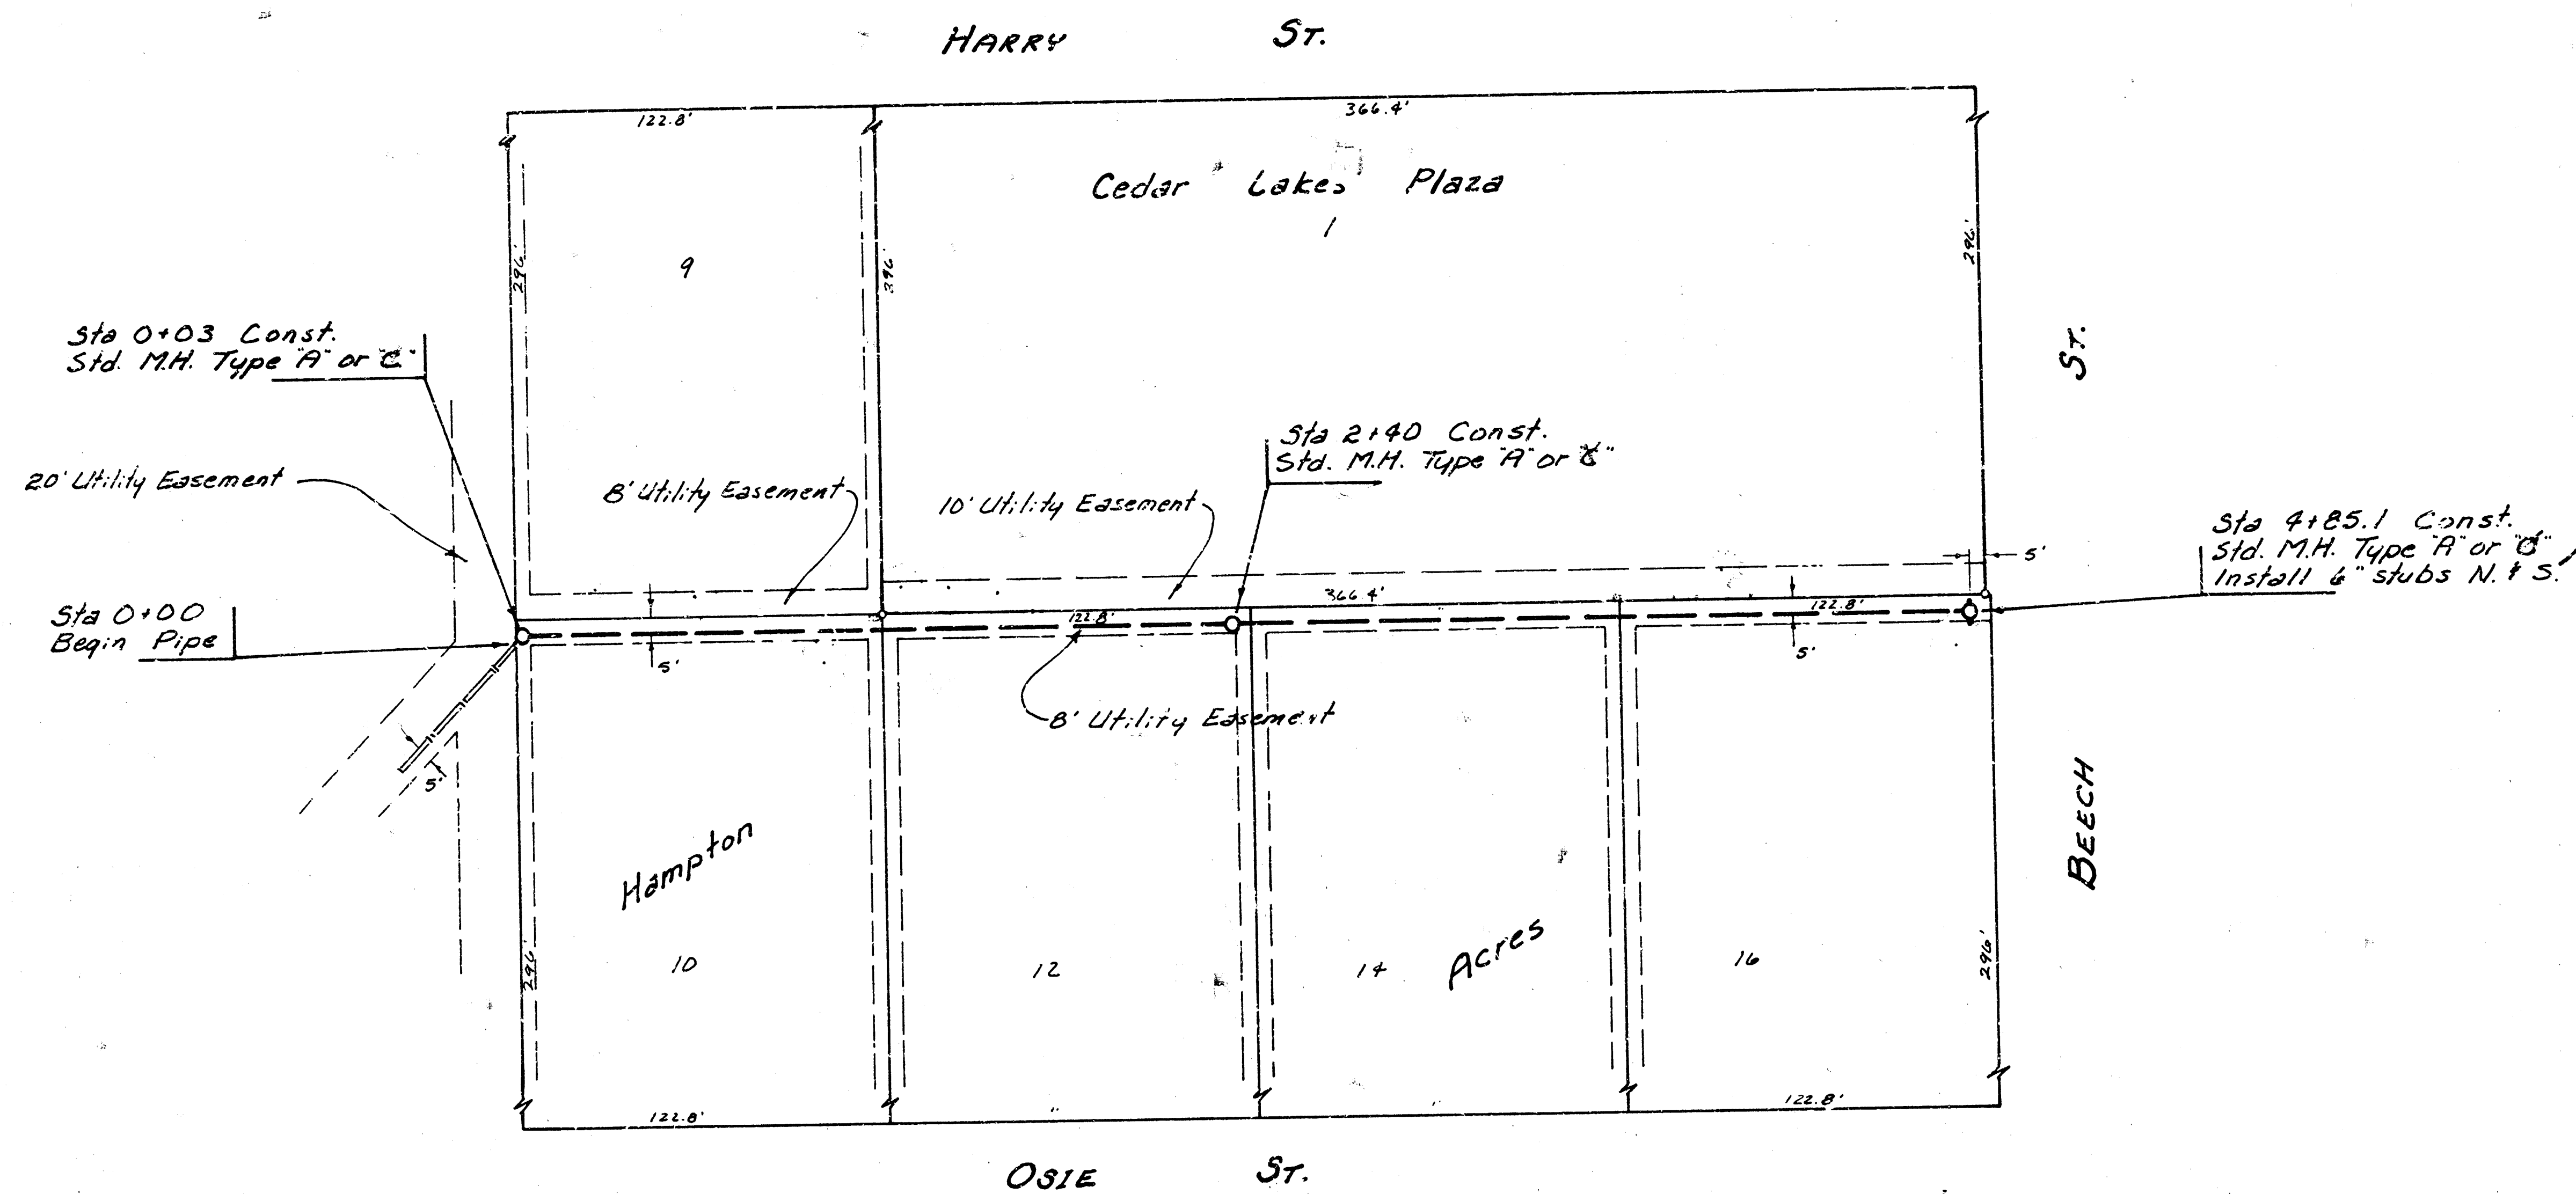

Scale Plan 1" = 40'
Profile 1" = 40' Horiz.
1" = 5' Vert.

B.M. 172.03 City Std. 48" S. & 46" W. of E's
Webb Rd. & Harry.

B.M. 173.05 Bridge Spike, S Face of P.P.
≈ 295' S. of SL Harry St. &
≈ 7' E. of WL. of Beech.


175

170

165

160

155

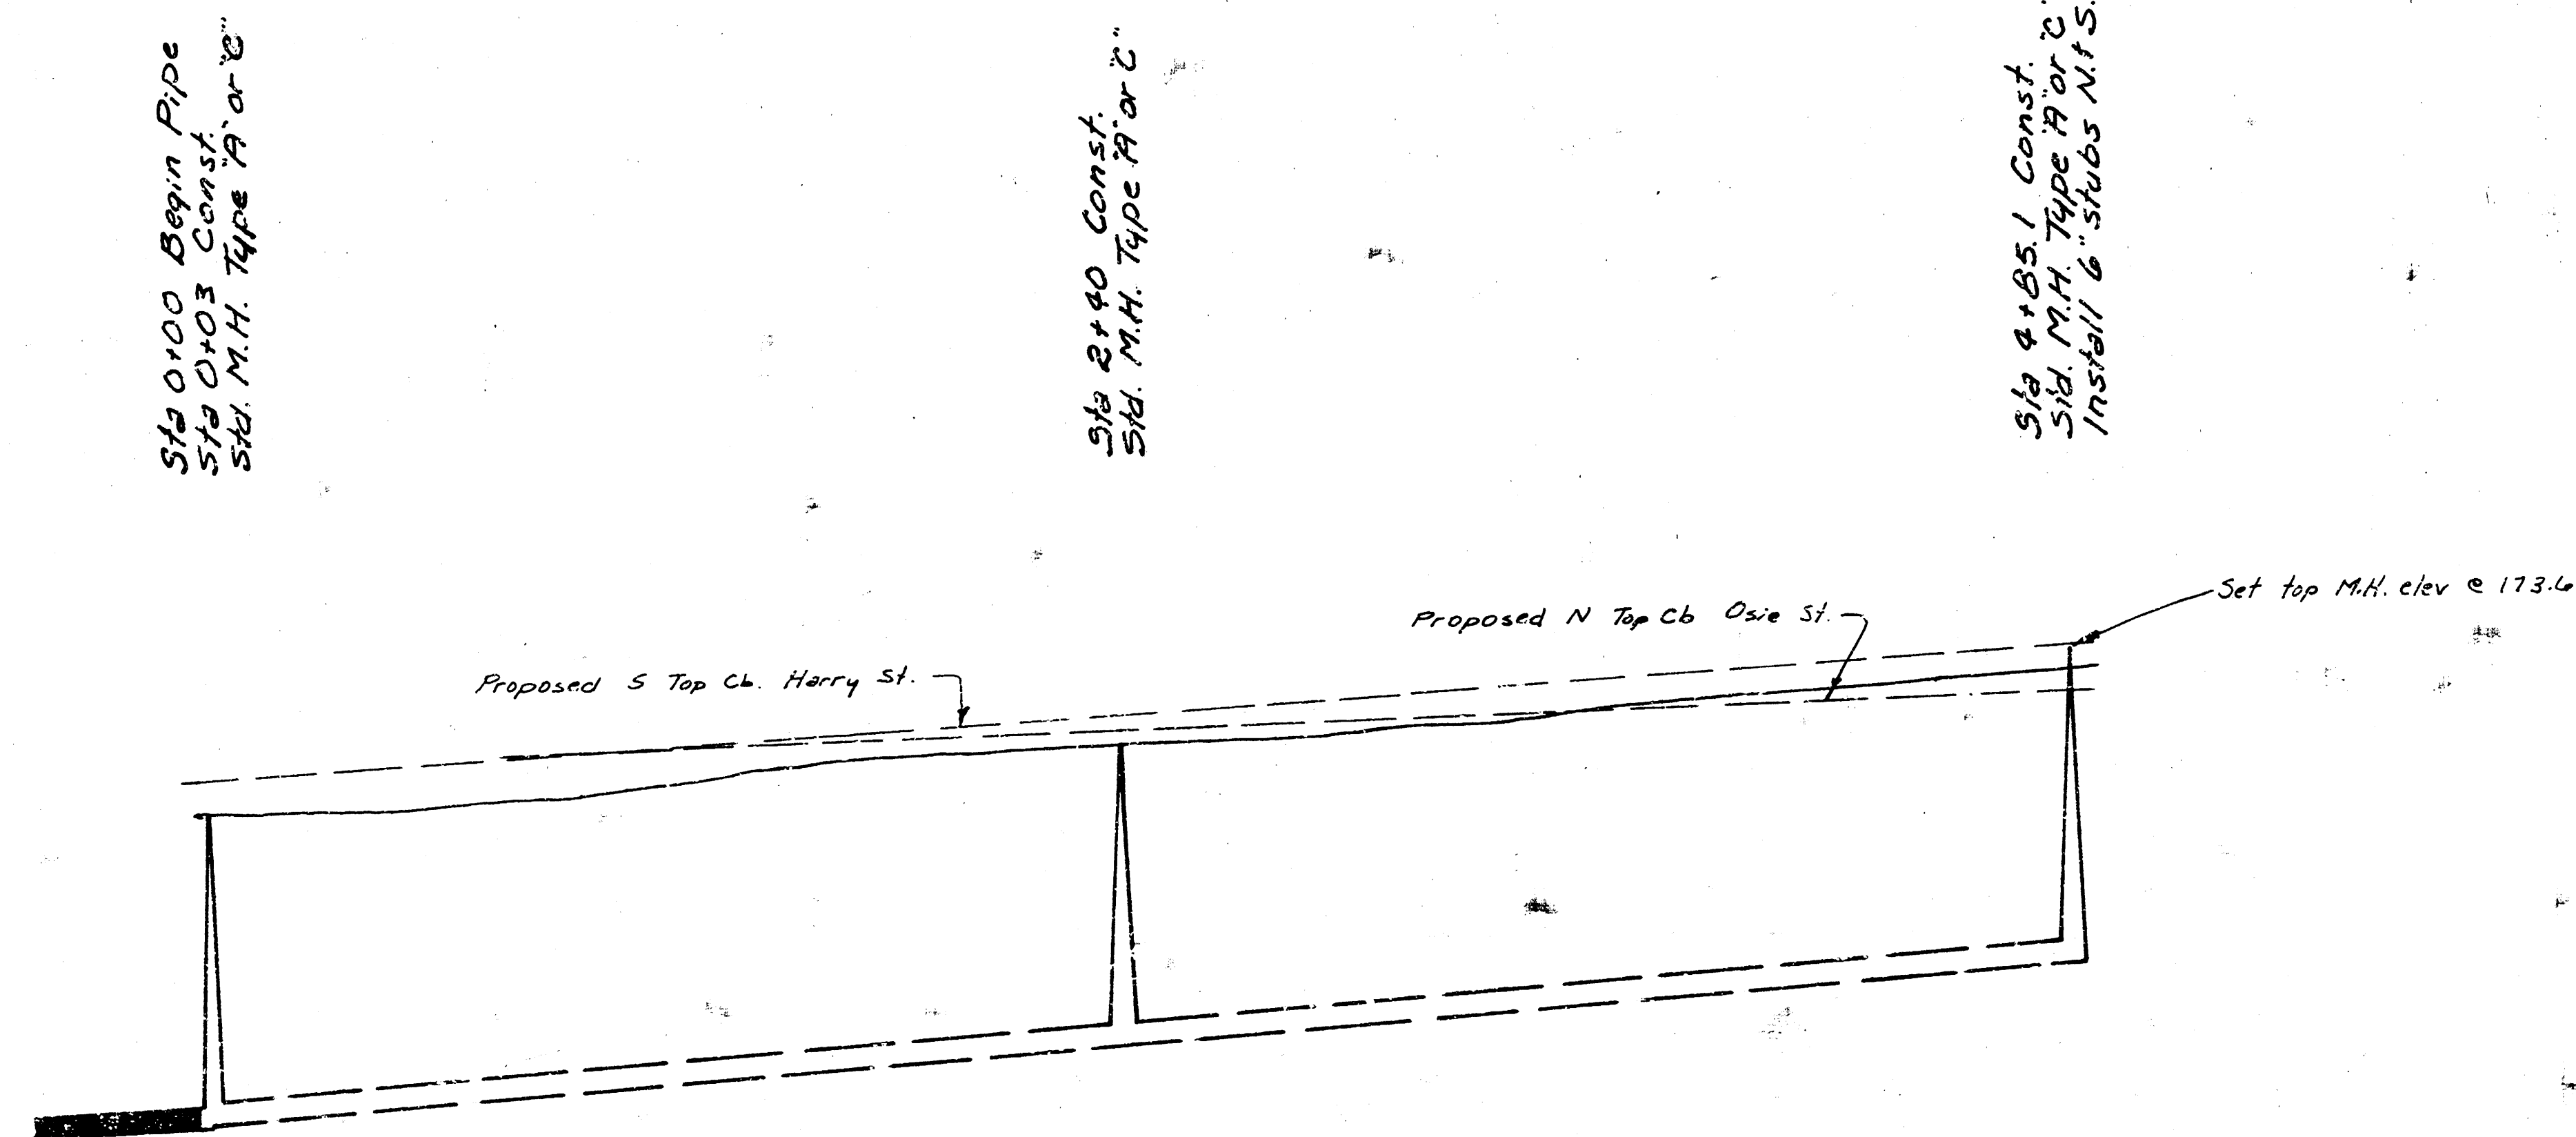

3 L.F. of 8" A.B.S. Composite
Pipe @ 0.40% Grade

482.1 L.F. of 8" Clay Pipe @ 0.85% Grade

Alternate 8" A.B.S. Composite Pipe or 8" P.V.C. Pipe

As Built
7-30-84
E231

LAT 10, MAIN 19, WAR INDUSTRIES SEWER
CITY OF WICHITA, KANSAS
DEAN SELLERS — CITY ENGINEER
PROJECT NO. 468-76-245-80900-000000-001