



B. M. 197.32 City Standard Disc 41.5' N. and 33' E. of 1/4 E. of Gouverneur Rd and 13th St.

B. M. 202.02 R.R. Spike W. side P. Rd. W. side Gouverneur Rd approx. 30' N. of E. Lawrence Lane Court.

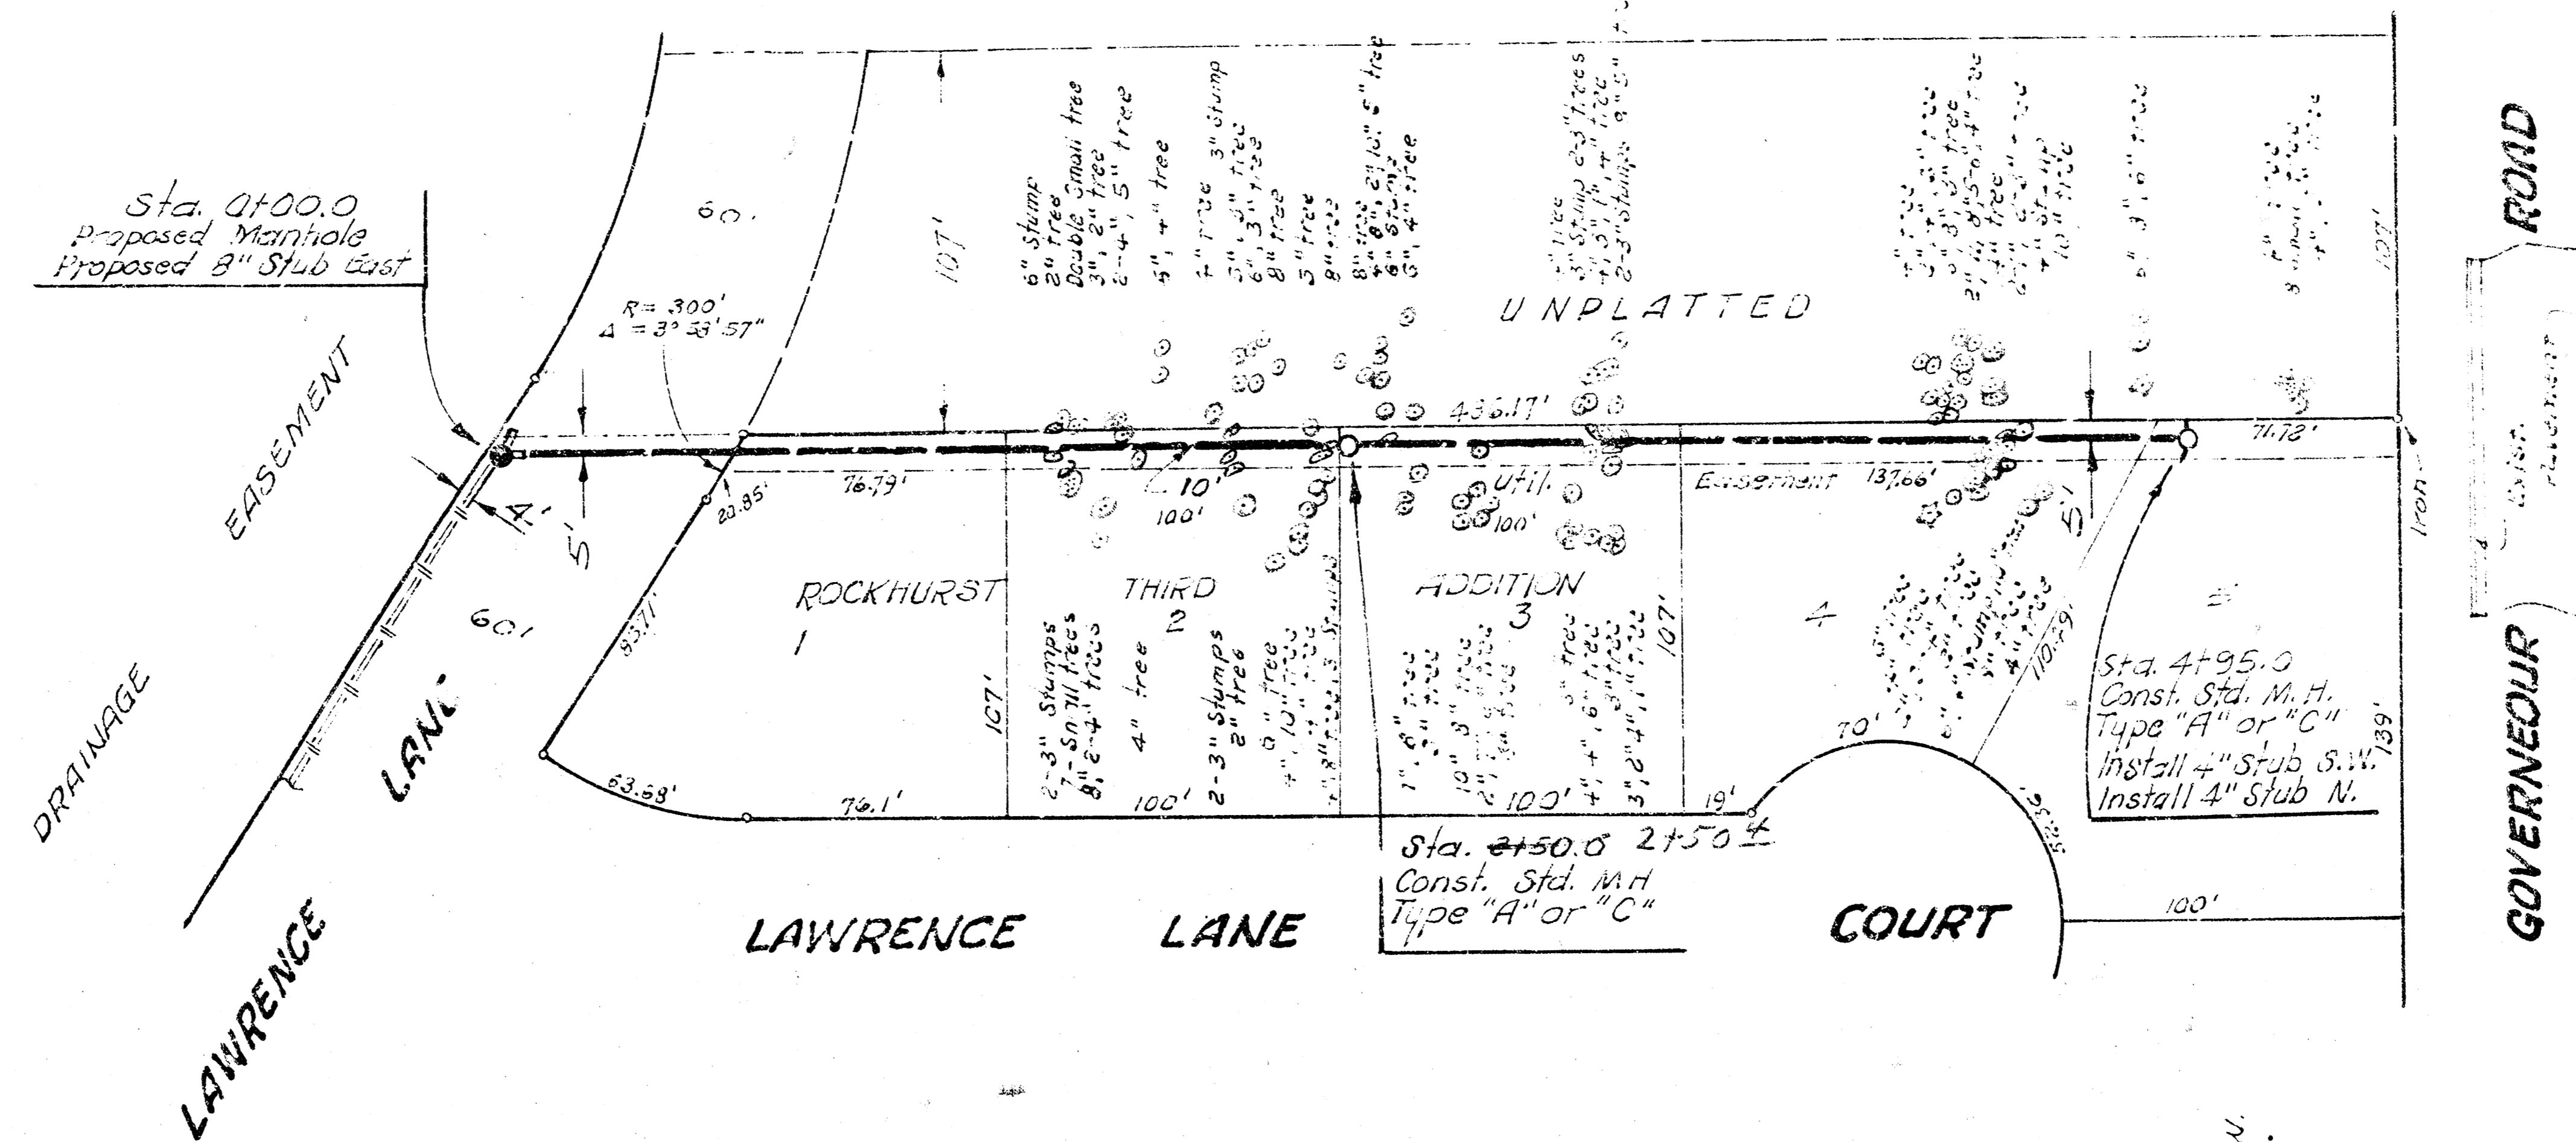

205
200
195
190
185
180
175

205
200
195
190
185
180
175

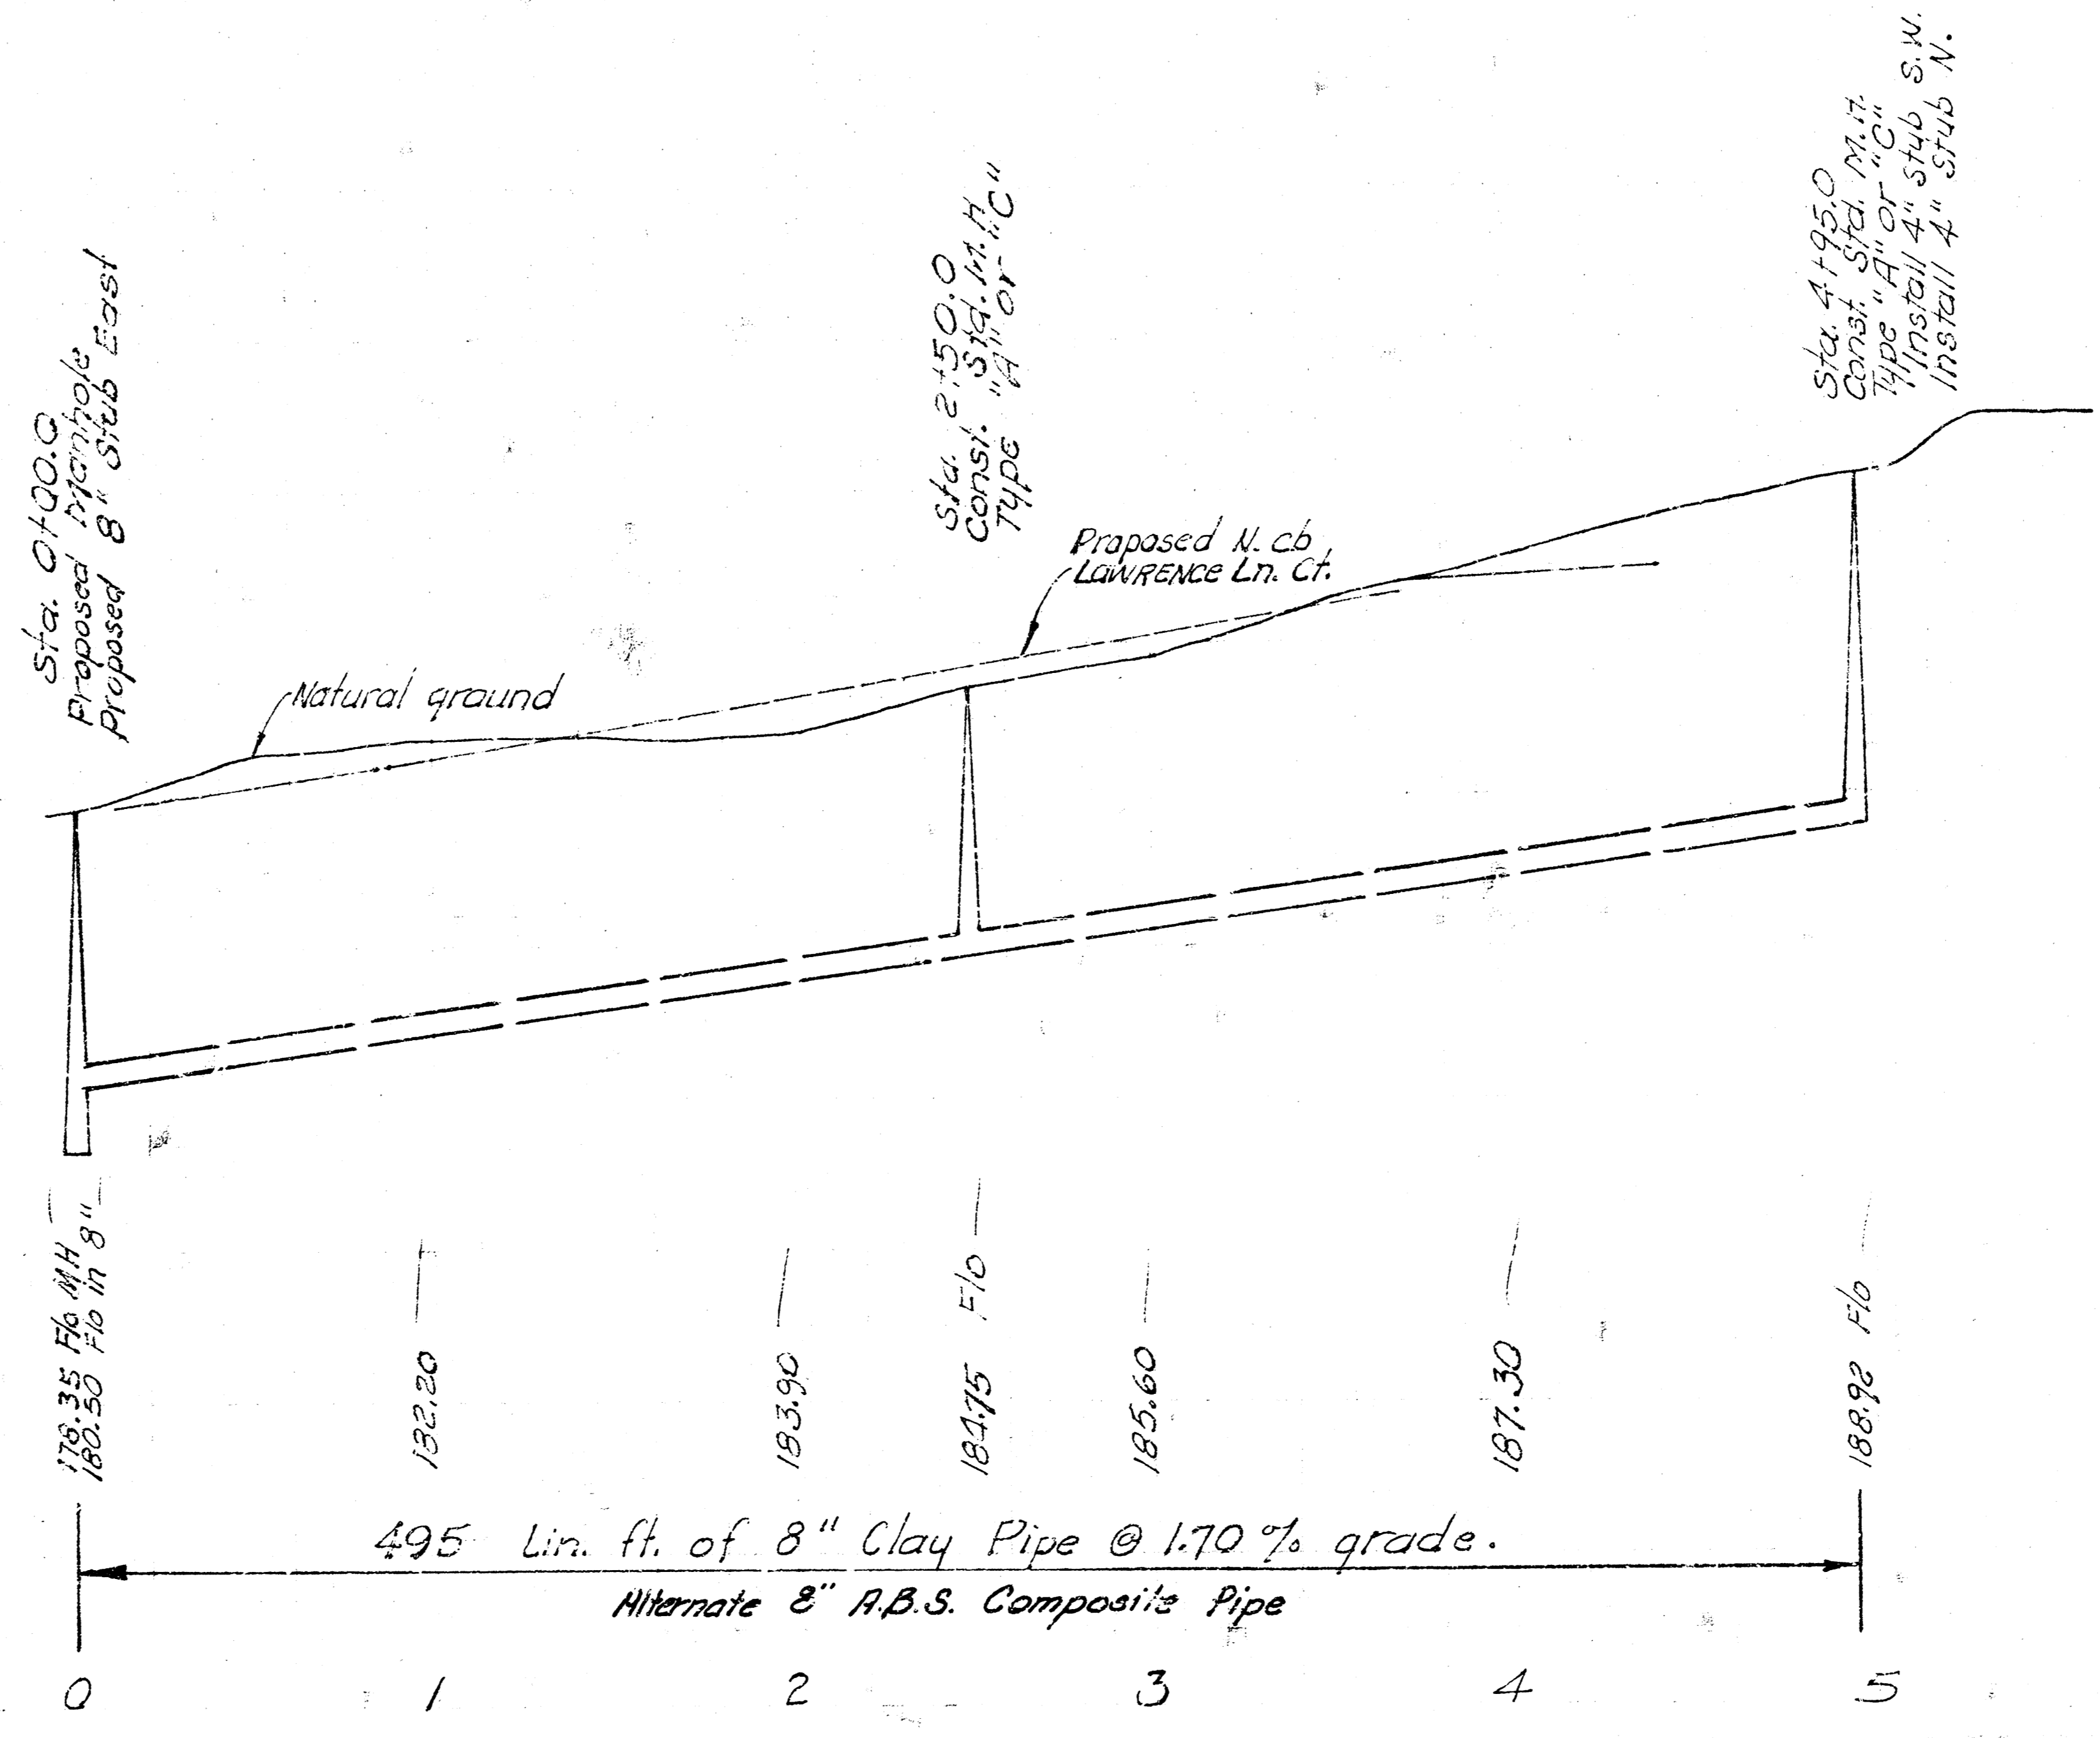

As built 2-24-77

LAT. I, MAIN 20 A, W. I. S.
CITY OF WICHITA, KANSAS
R. W. LINN CITY ENGINEER
DATE: 10-76 PROJECT NO. DBKL 576046