


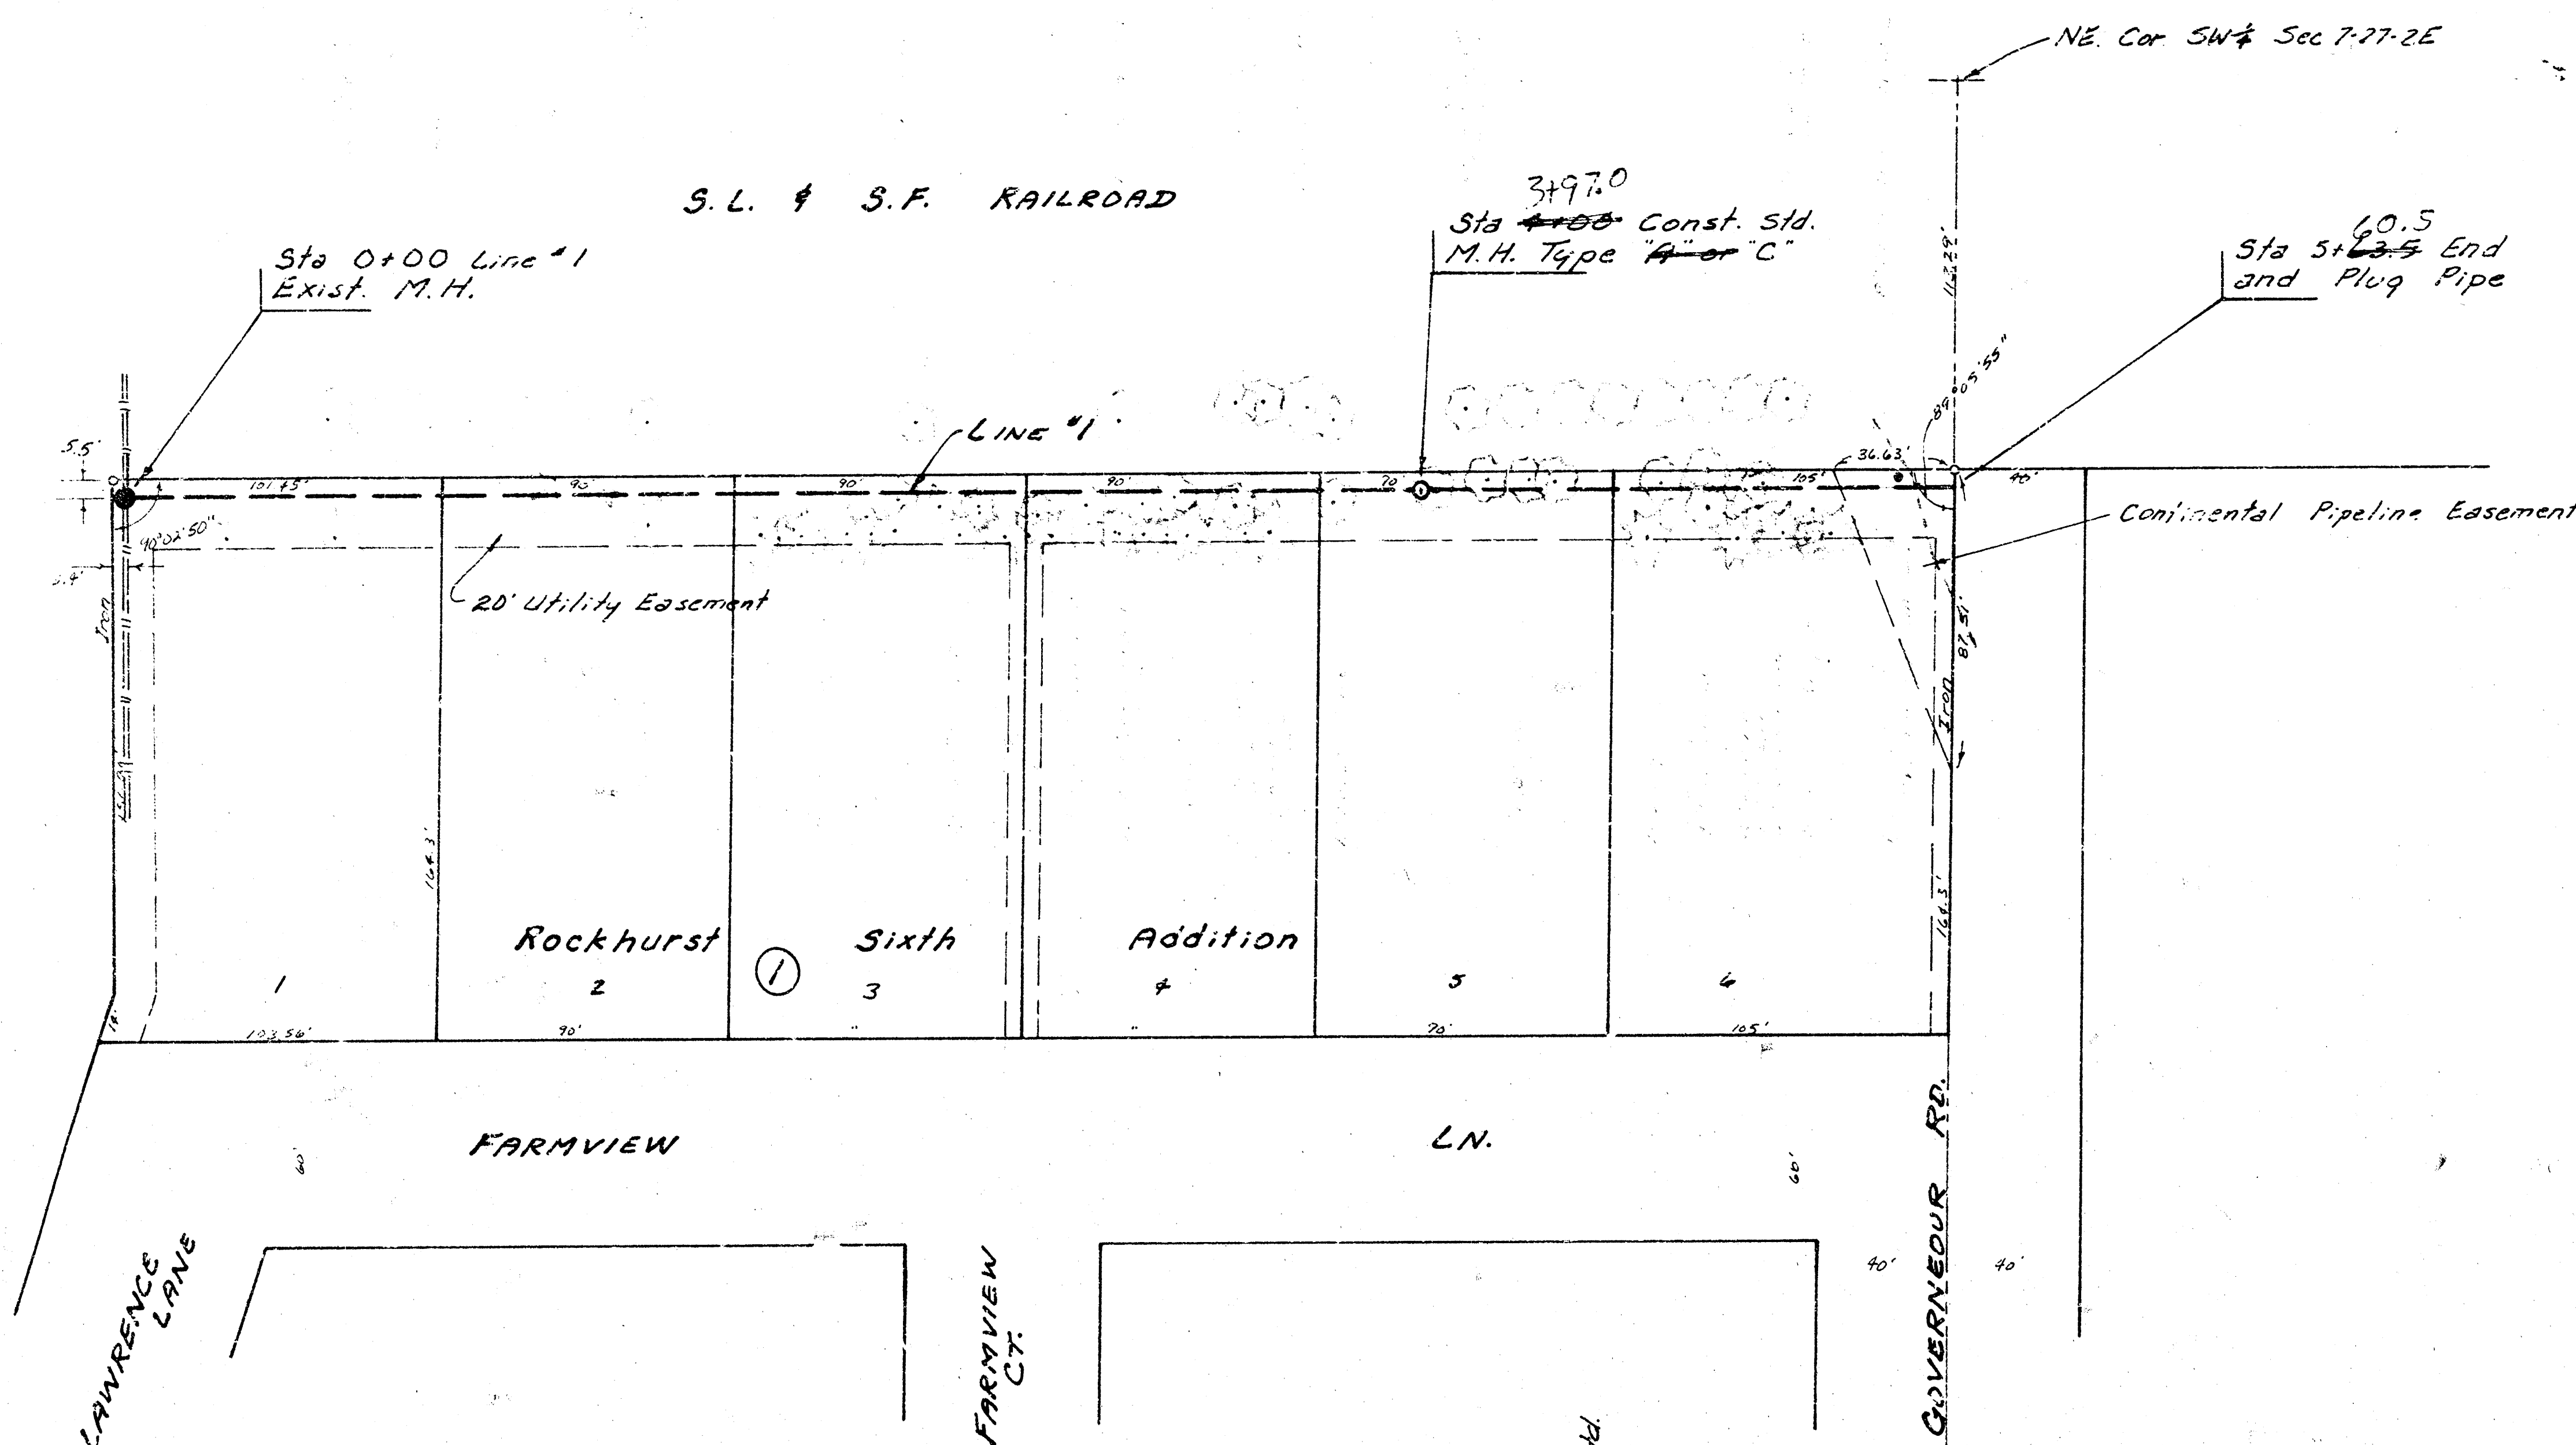


Scale Plan 1" = 40'
Profile 1" = 40' Horiz.
1" = 5' Vert.

NOTE: CONTRACTOR SHALL NOTIFY CONTINENTAL PIPELINE COMPANY PRIOR TO DOING ANY WORK ON THEIR EASEMENT.

CONTRACTOR SHALL GIVE PROPERTY OWNERS AND/OR TENANTS OF DEVELOPED PROPERTY DIRECTLY AFFECTED BY THE CONSTRUCTION OF THIS PROJECT A MINIMUM ADVANCE NOTICE OF 48 HOURS PRIOR TO STARTING ANY CONSTRUCTION.





B.M. 204.23 "x" Top of E. Curb of Gouverneur at Aberdeen.

205
200
195
190
185
180

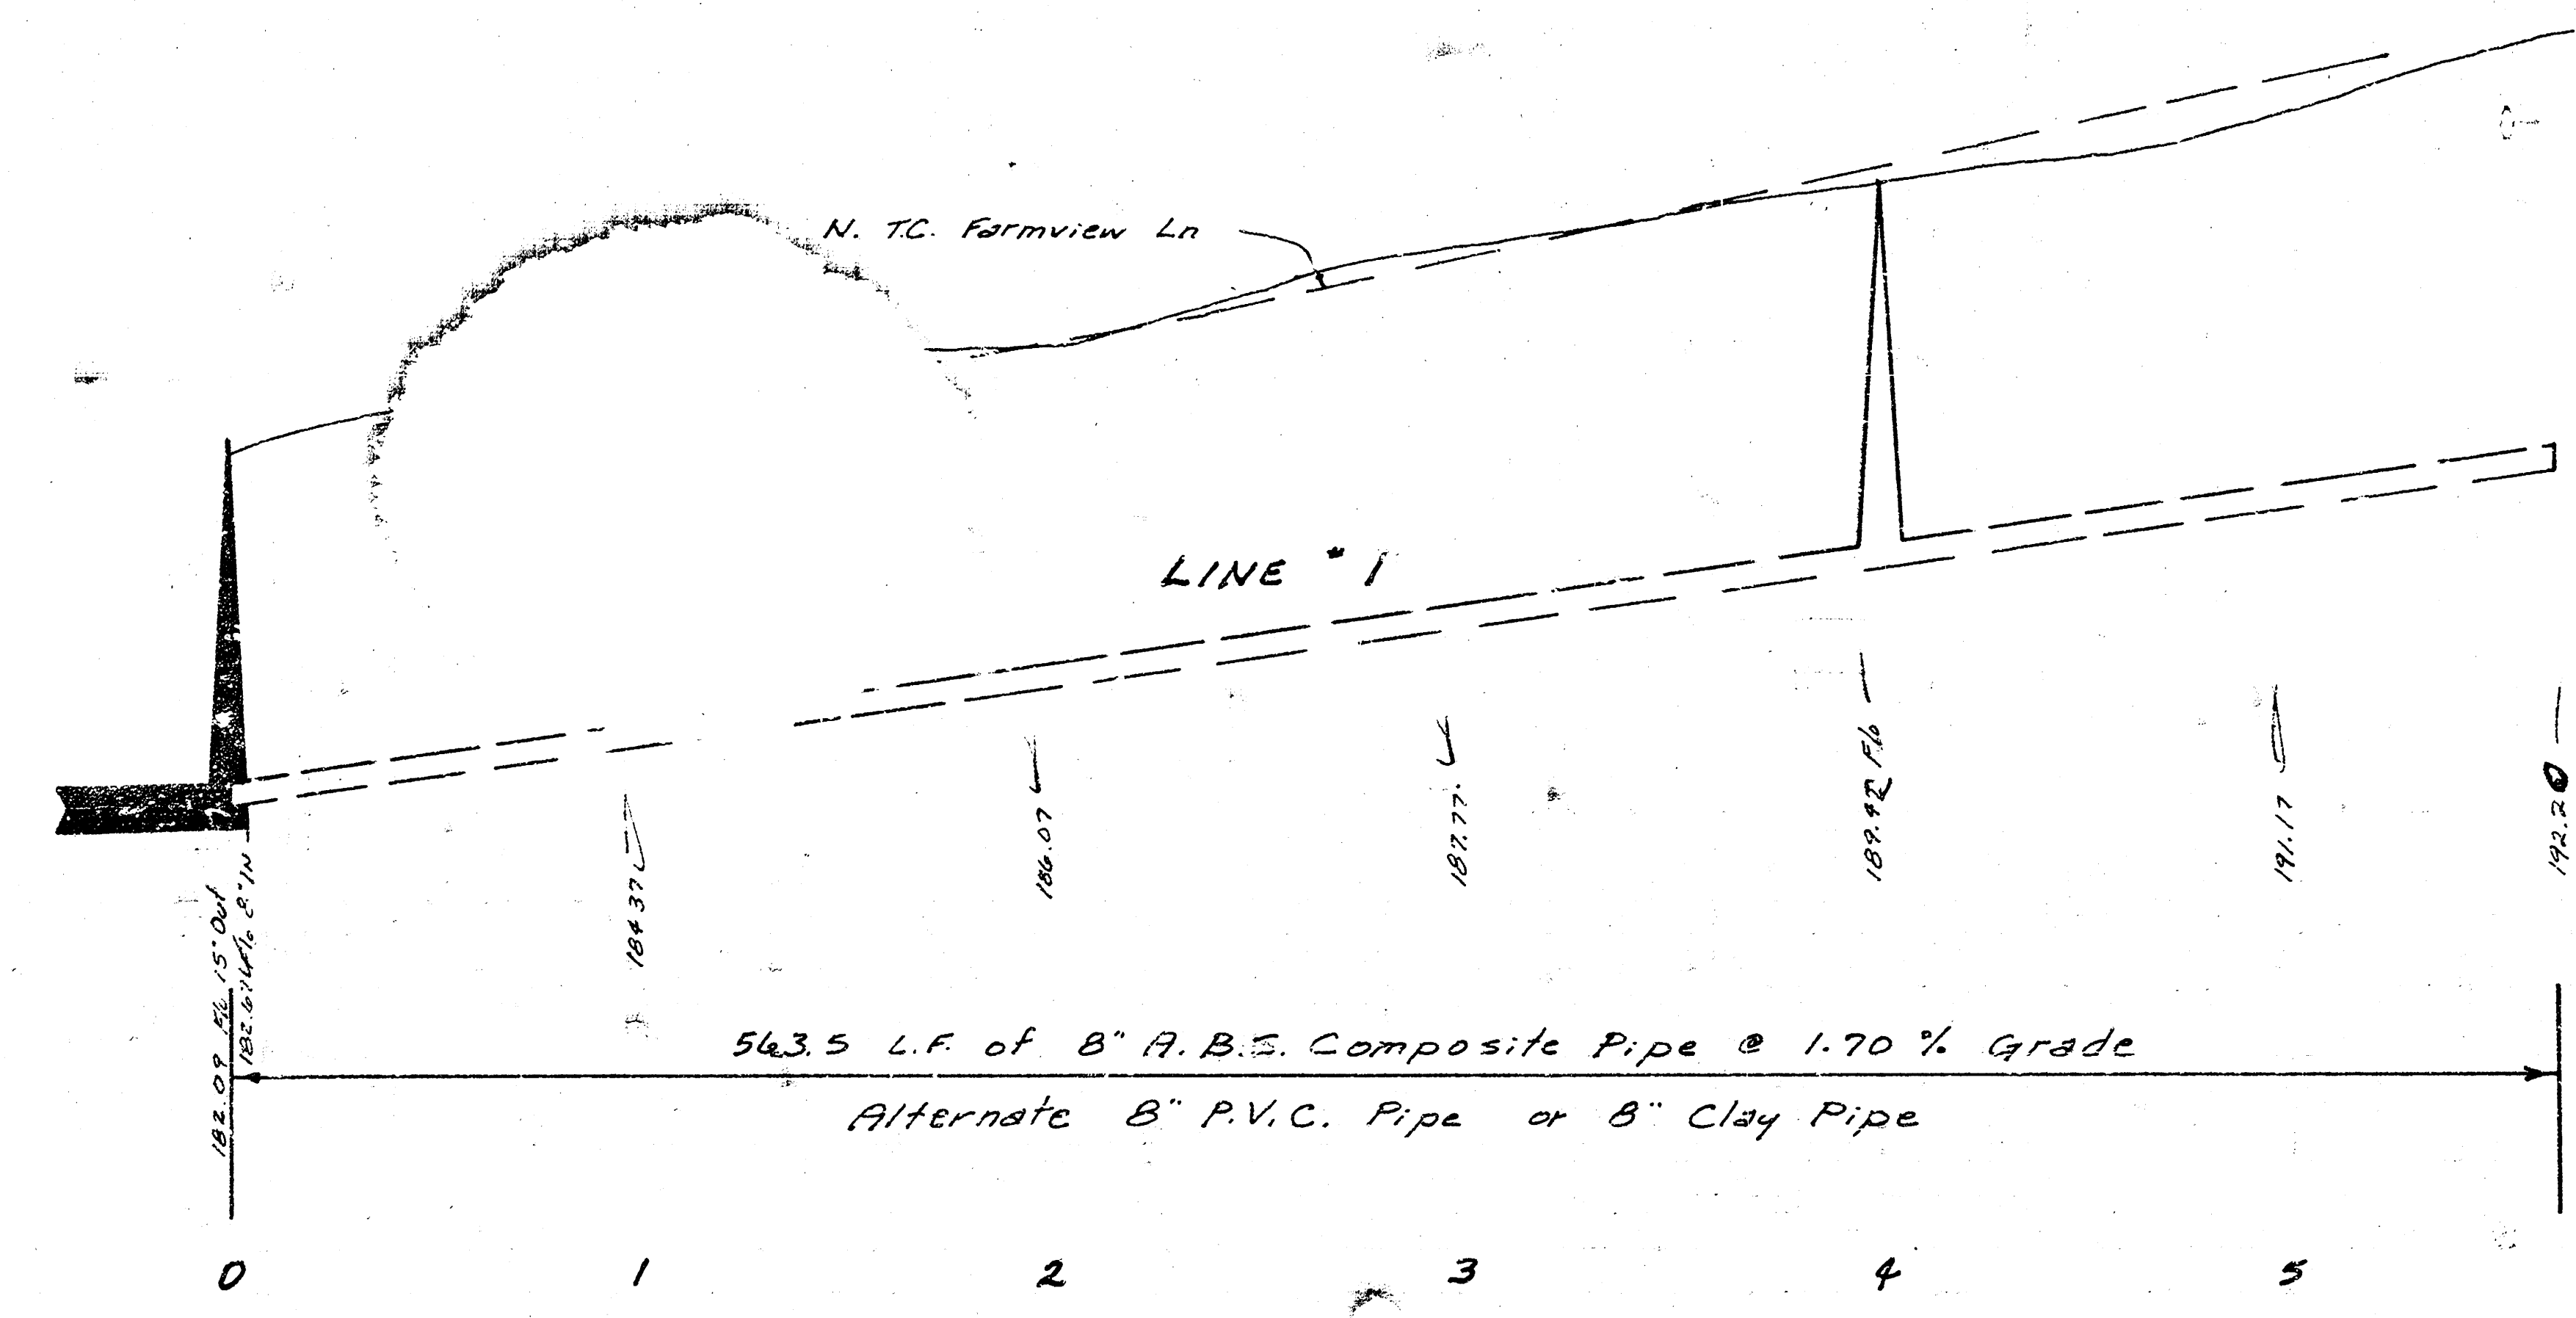

205
200
195
190
185

LAT 14, MAIN 20, WAR INDUSTRIES SEWER
CITY OF WICHITA
R.W. BRUGGEMAN
DIRECTOR OF ENGINEERING - CITY ENGINEER
PROJ. NO. 468-76-245-80975-000-000-001

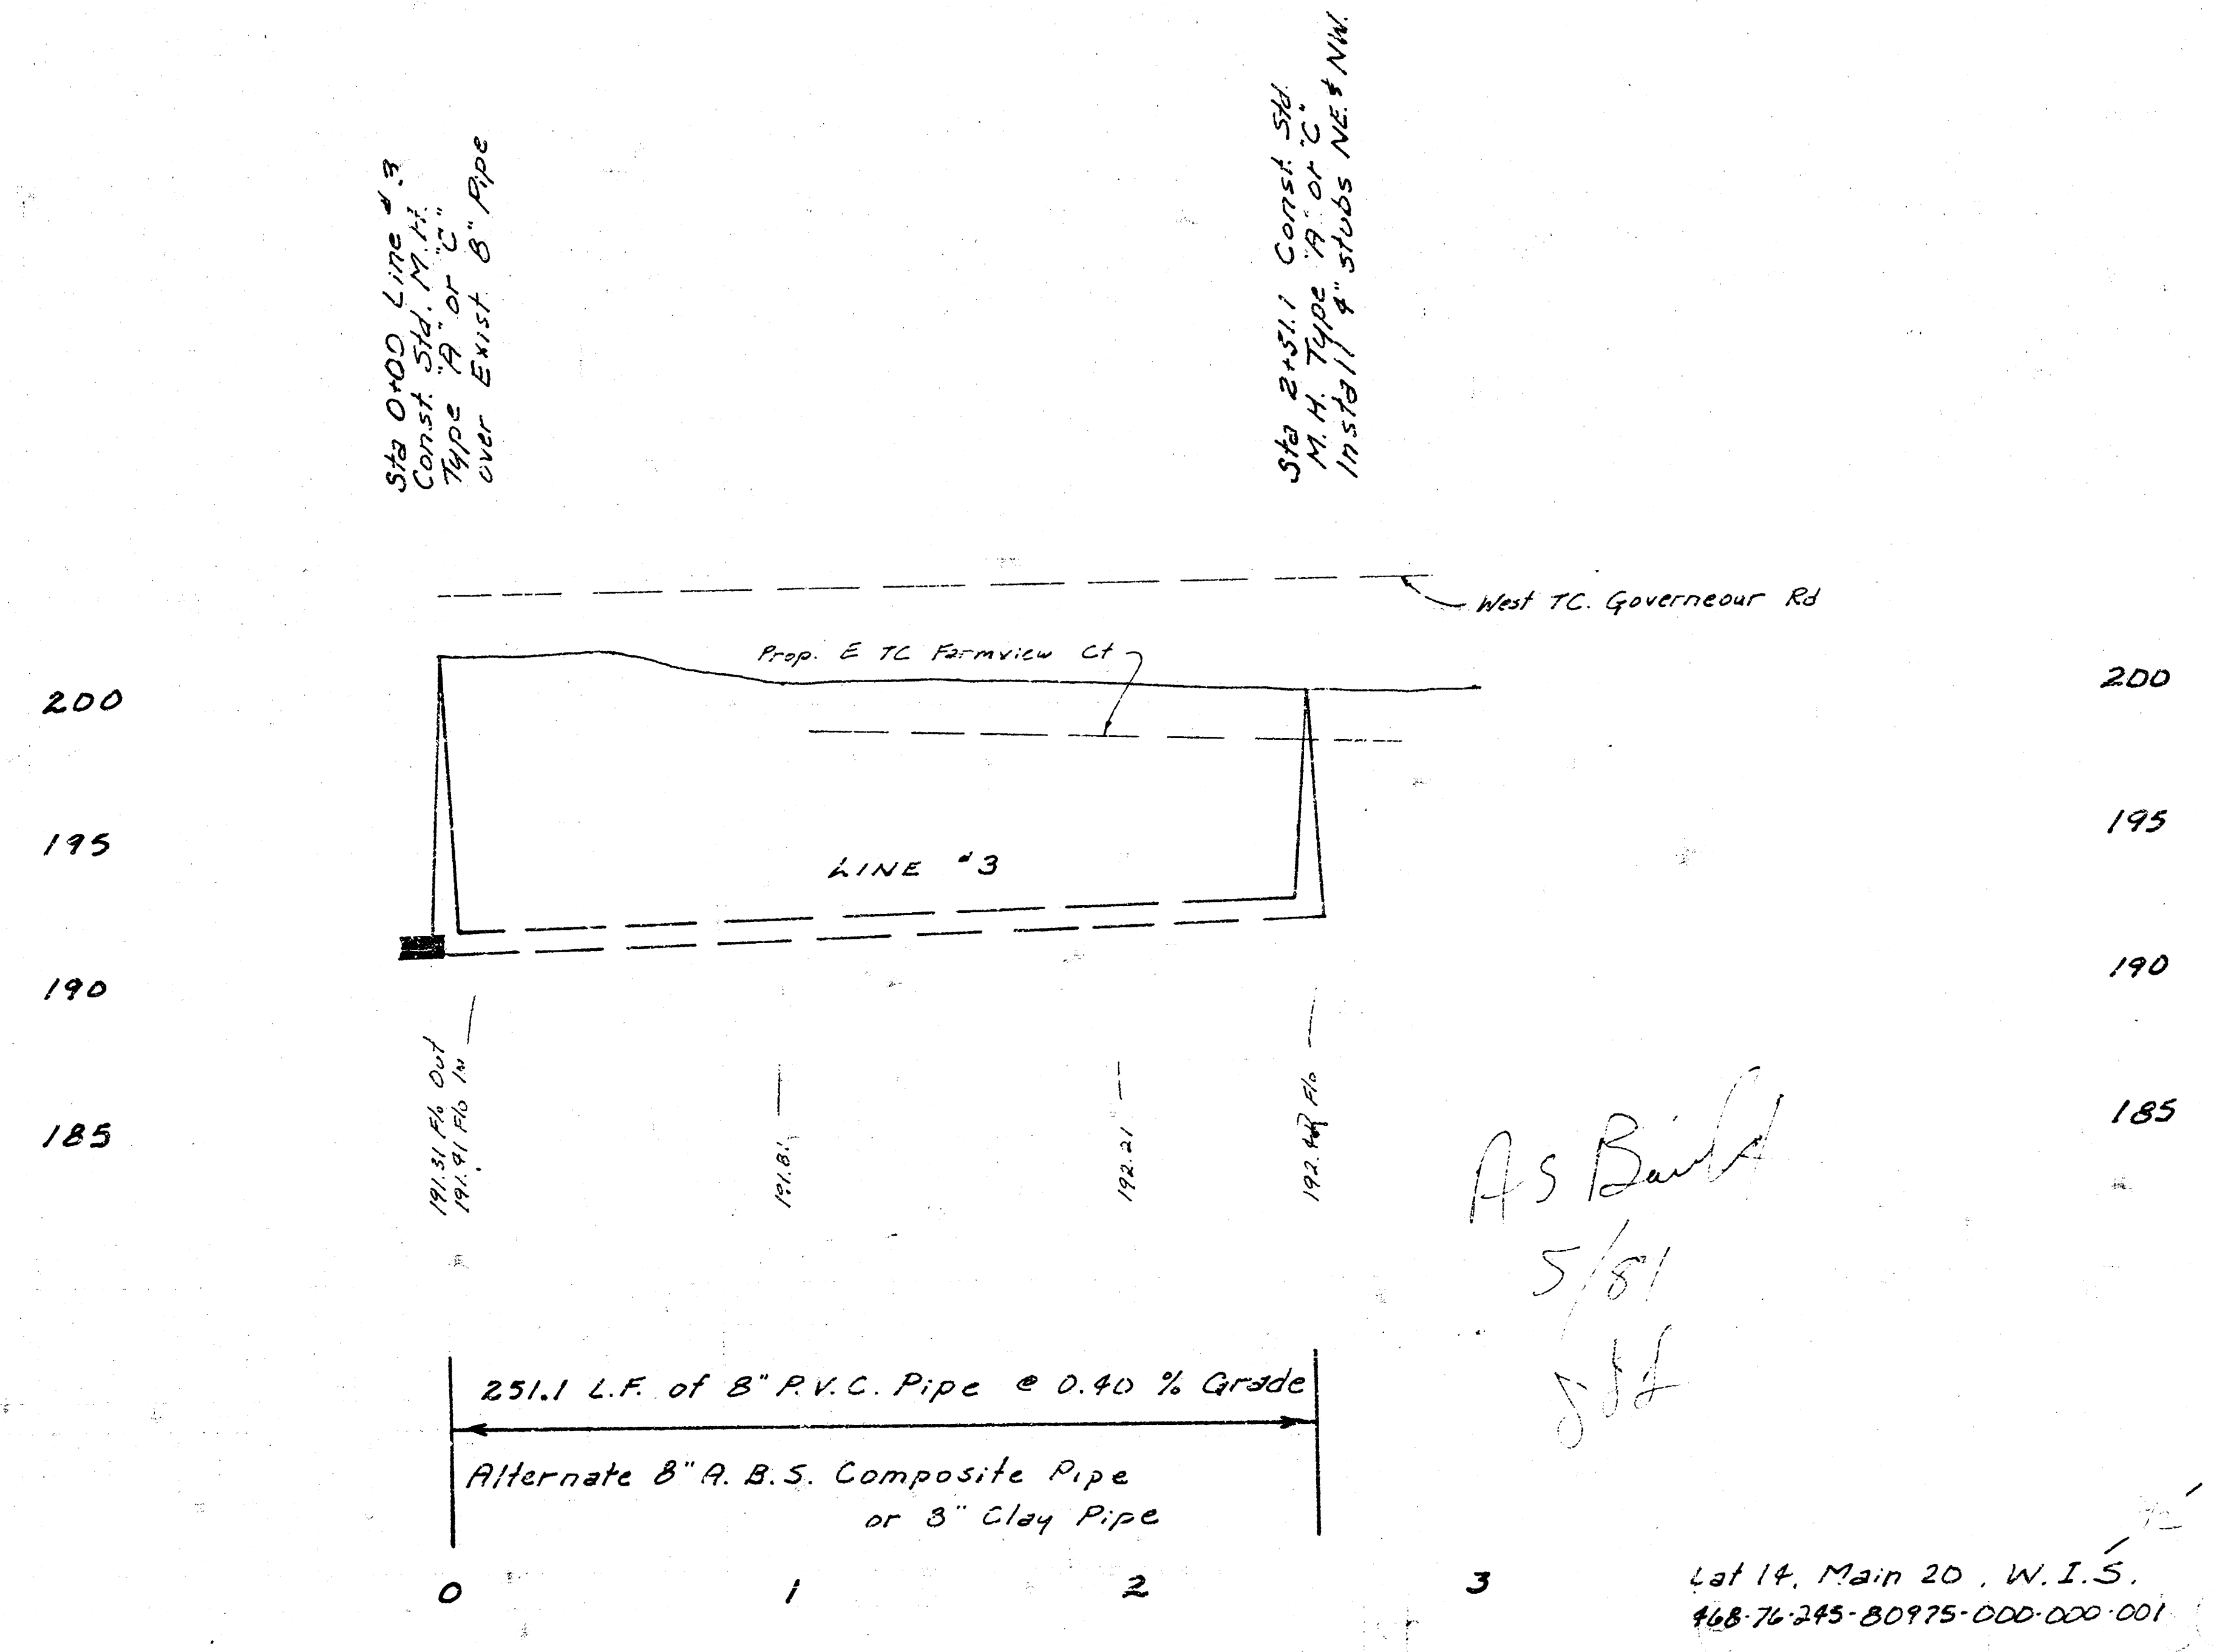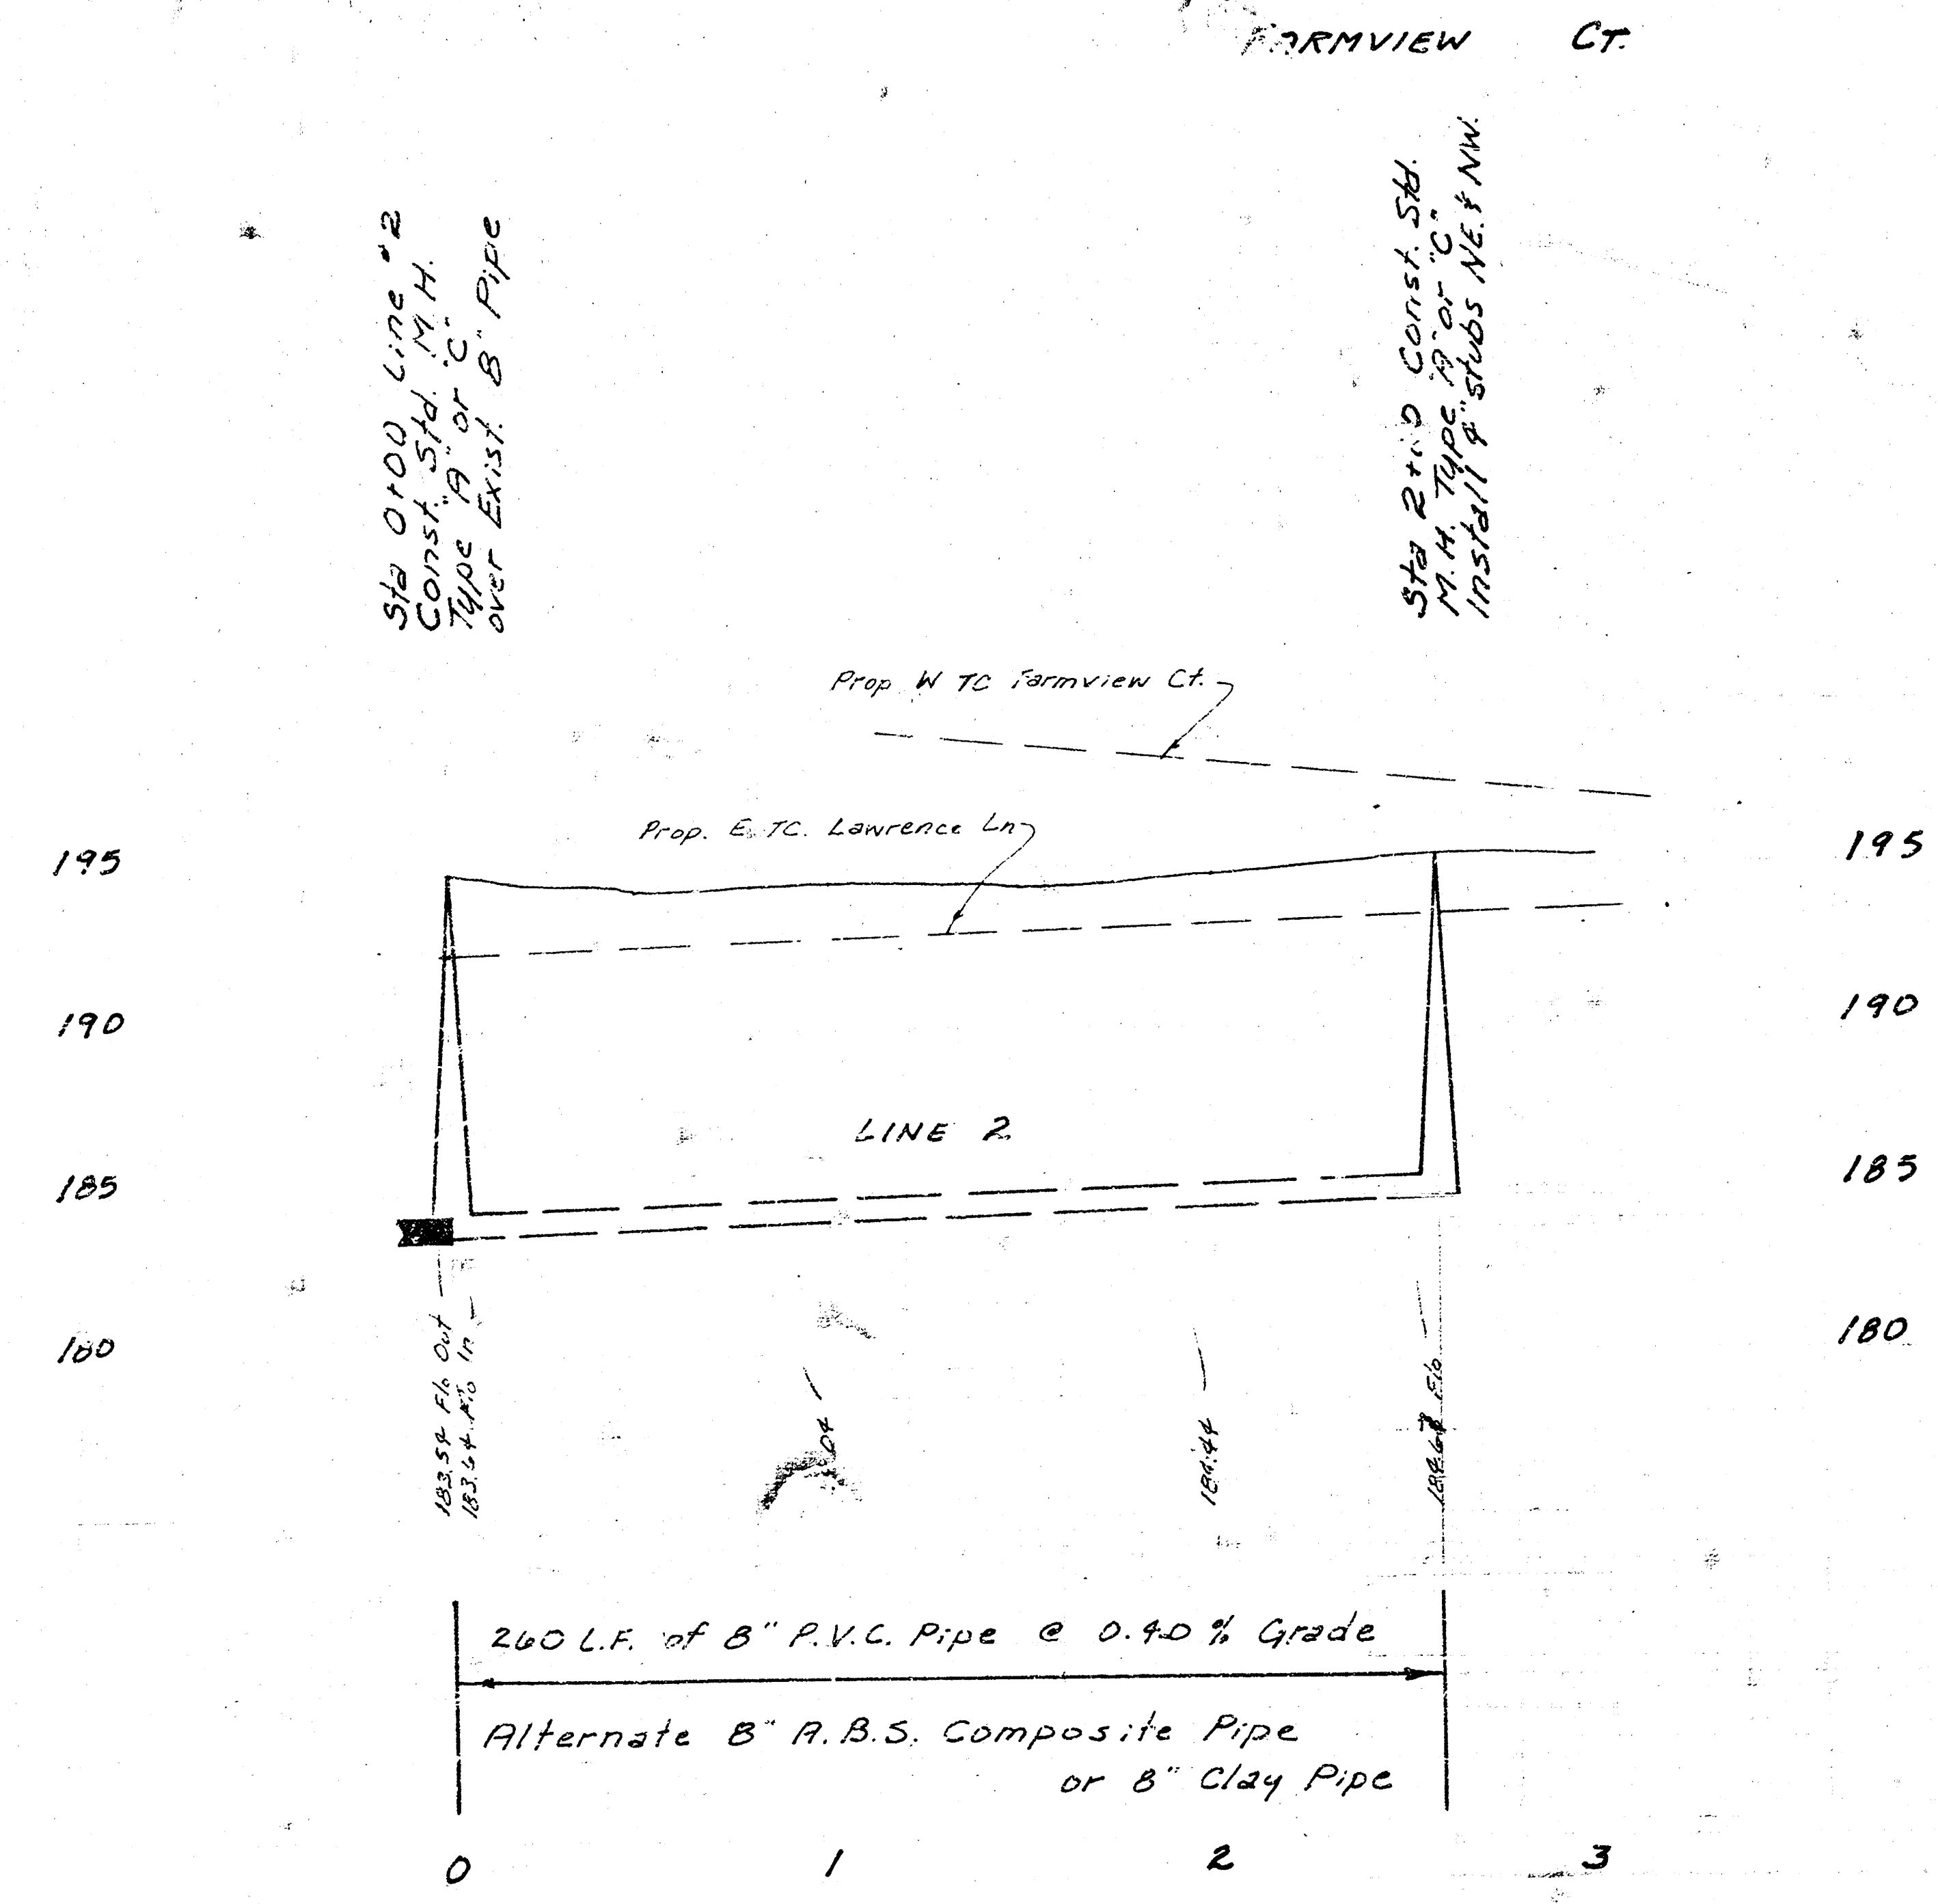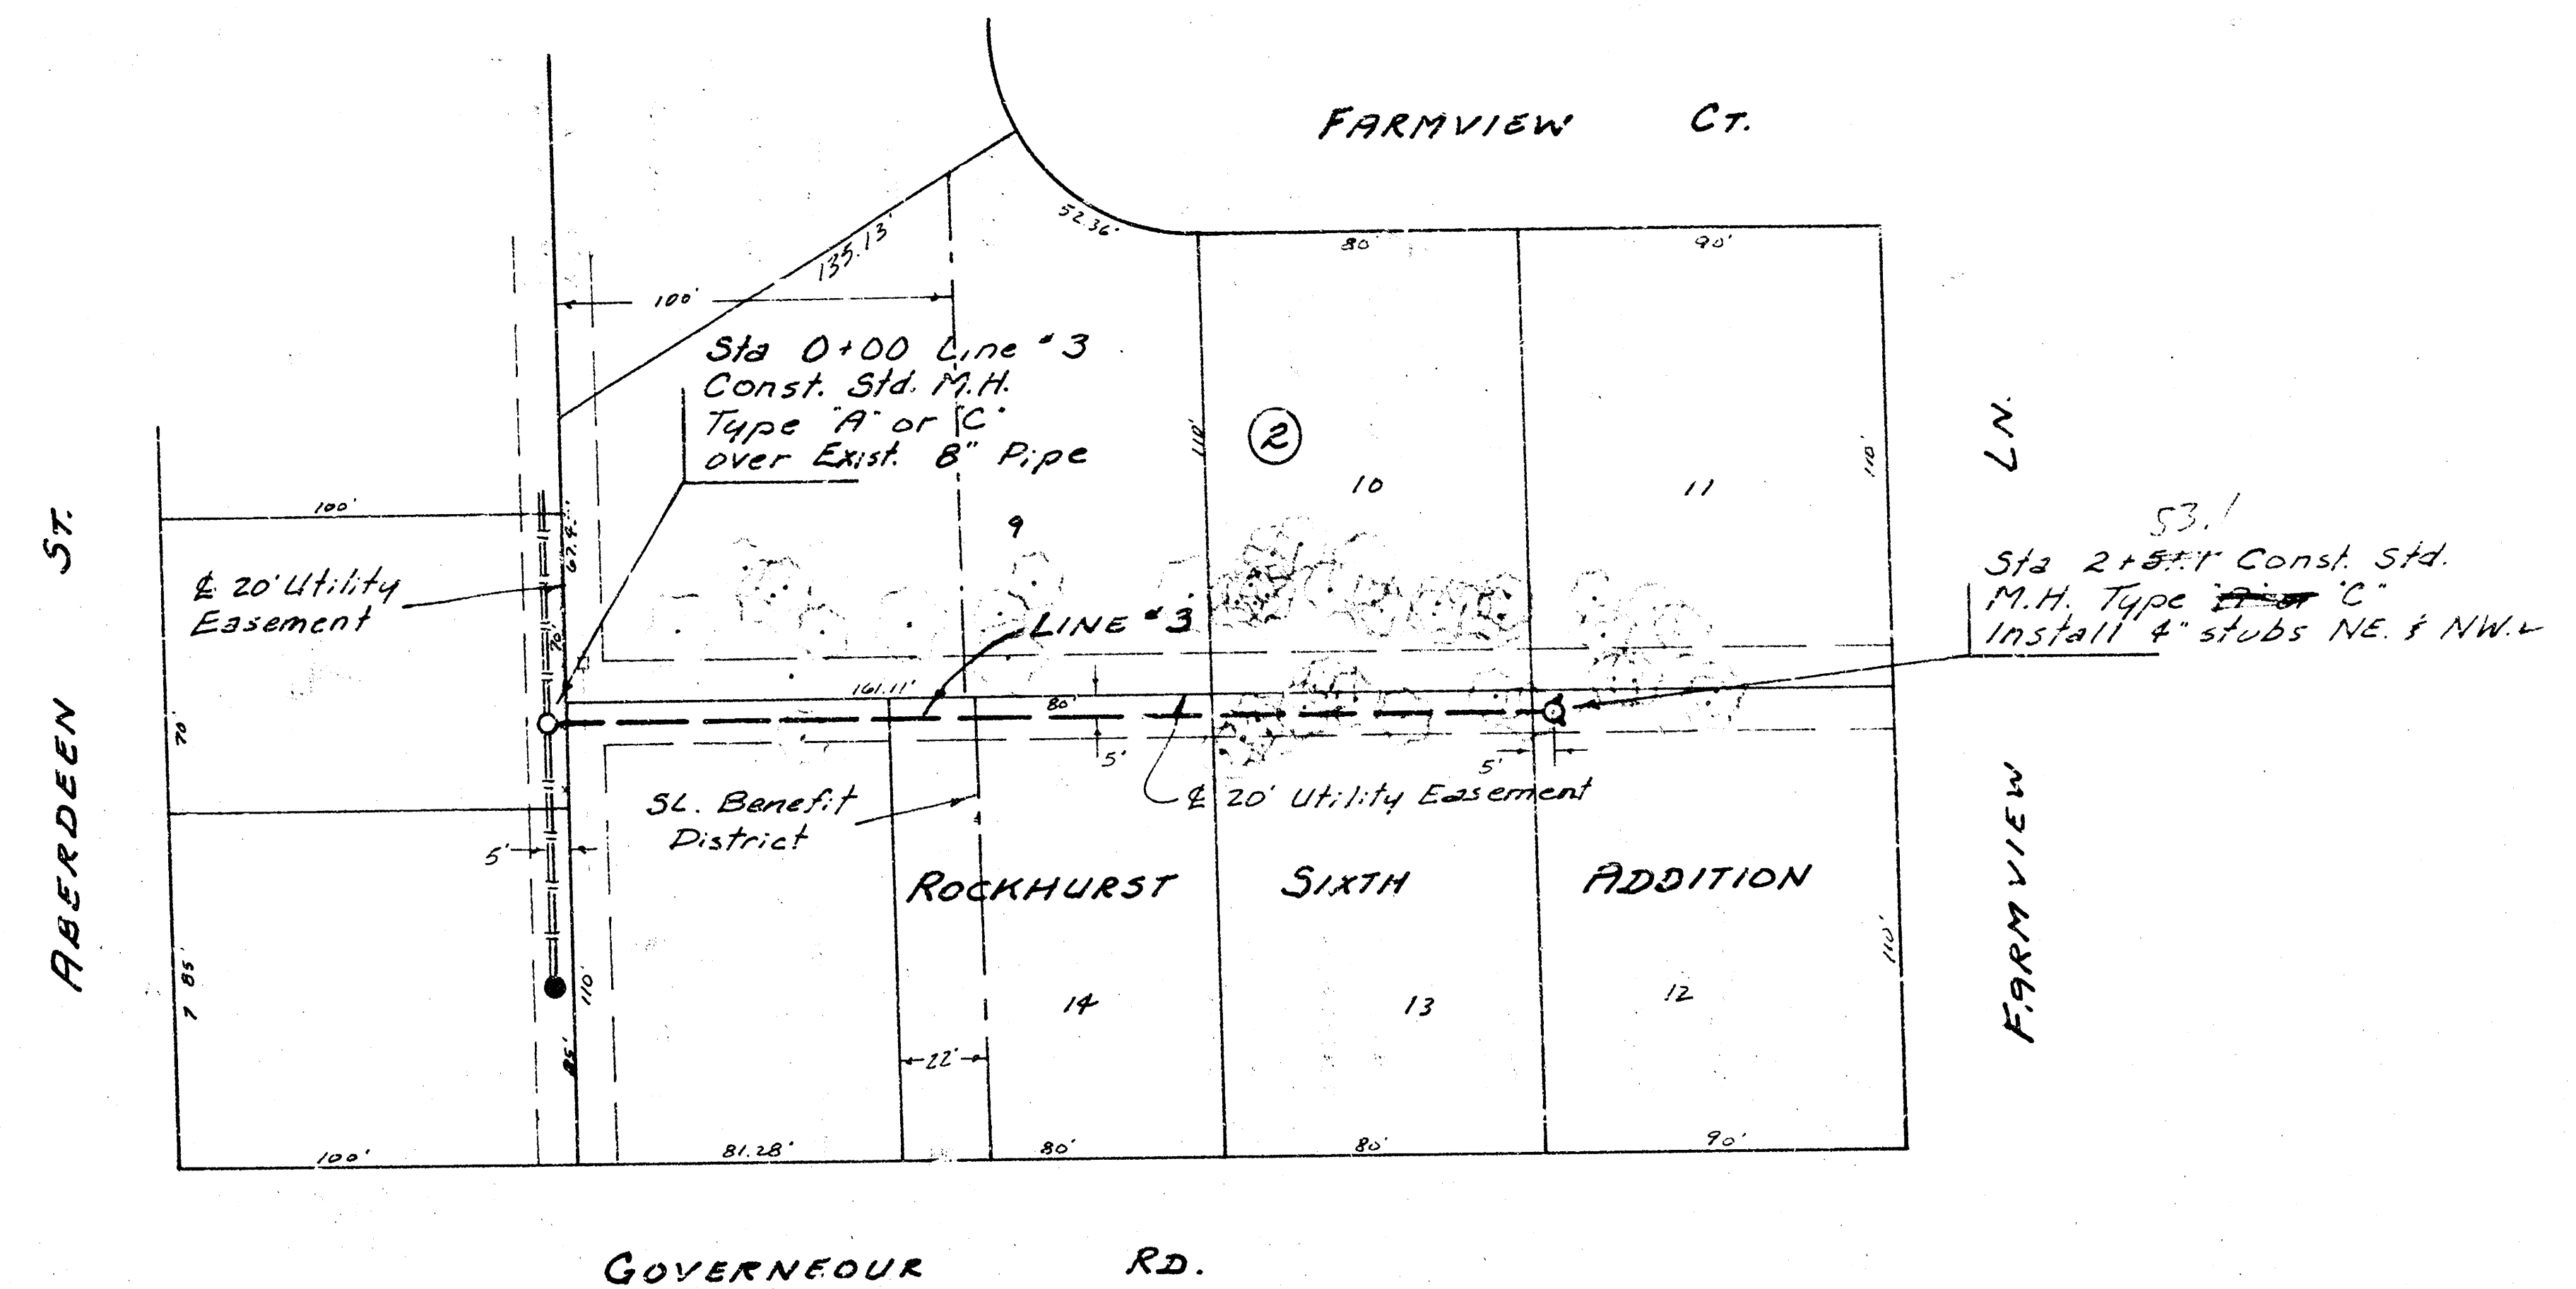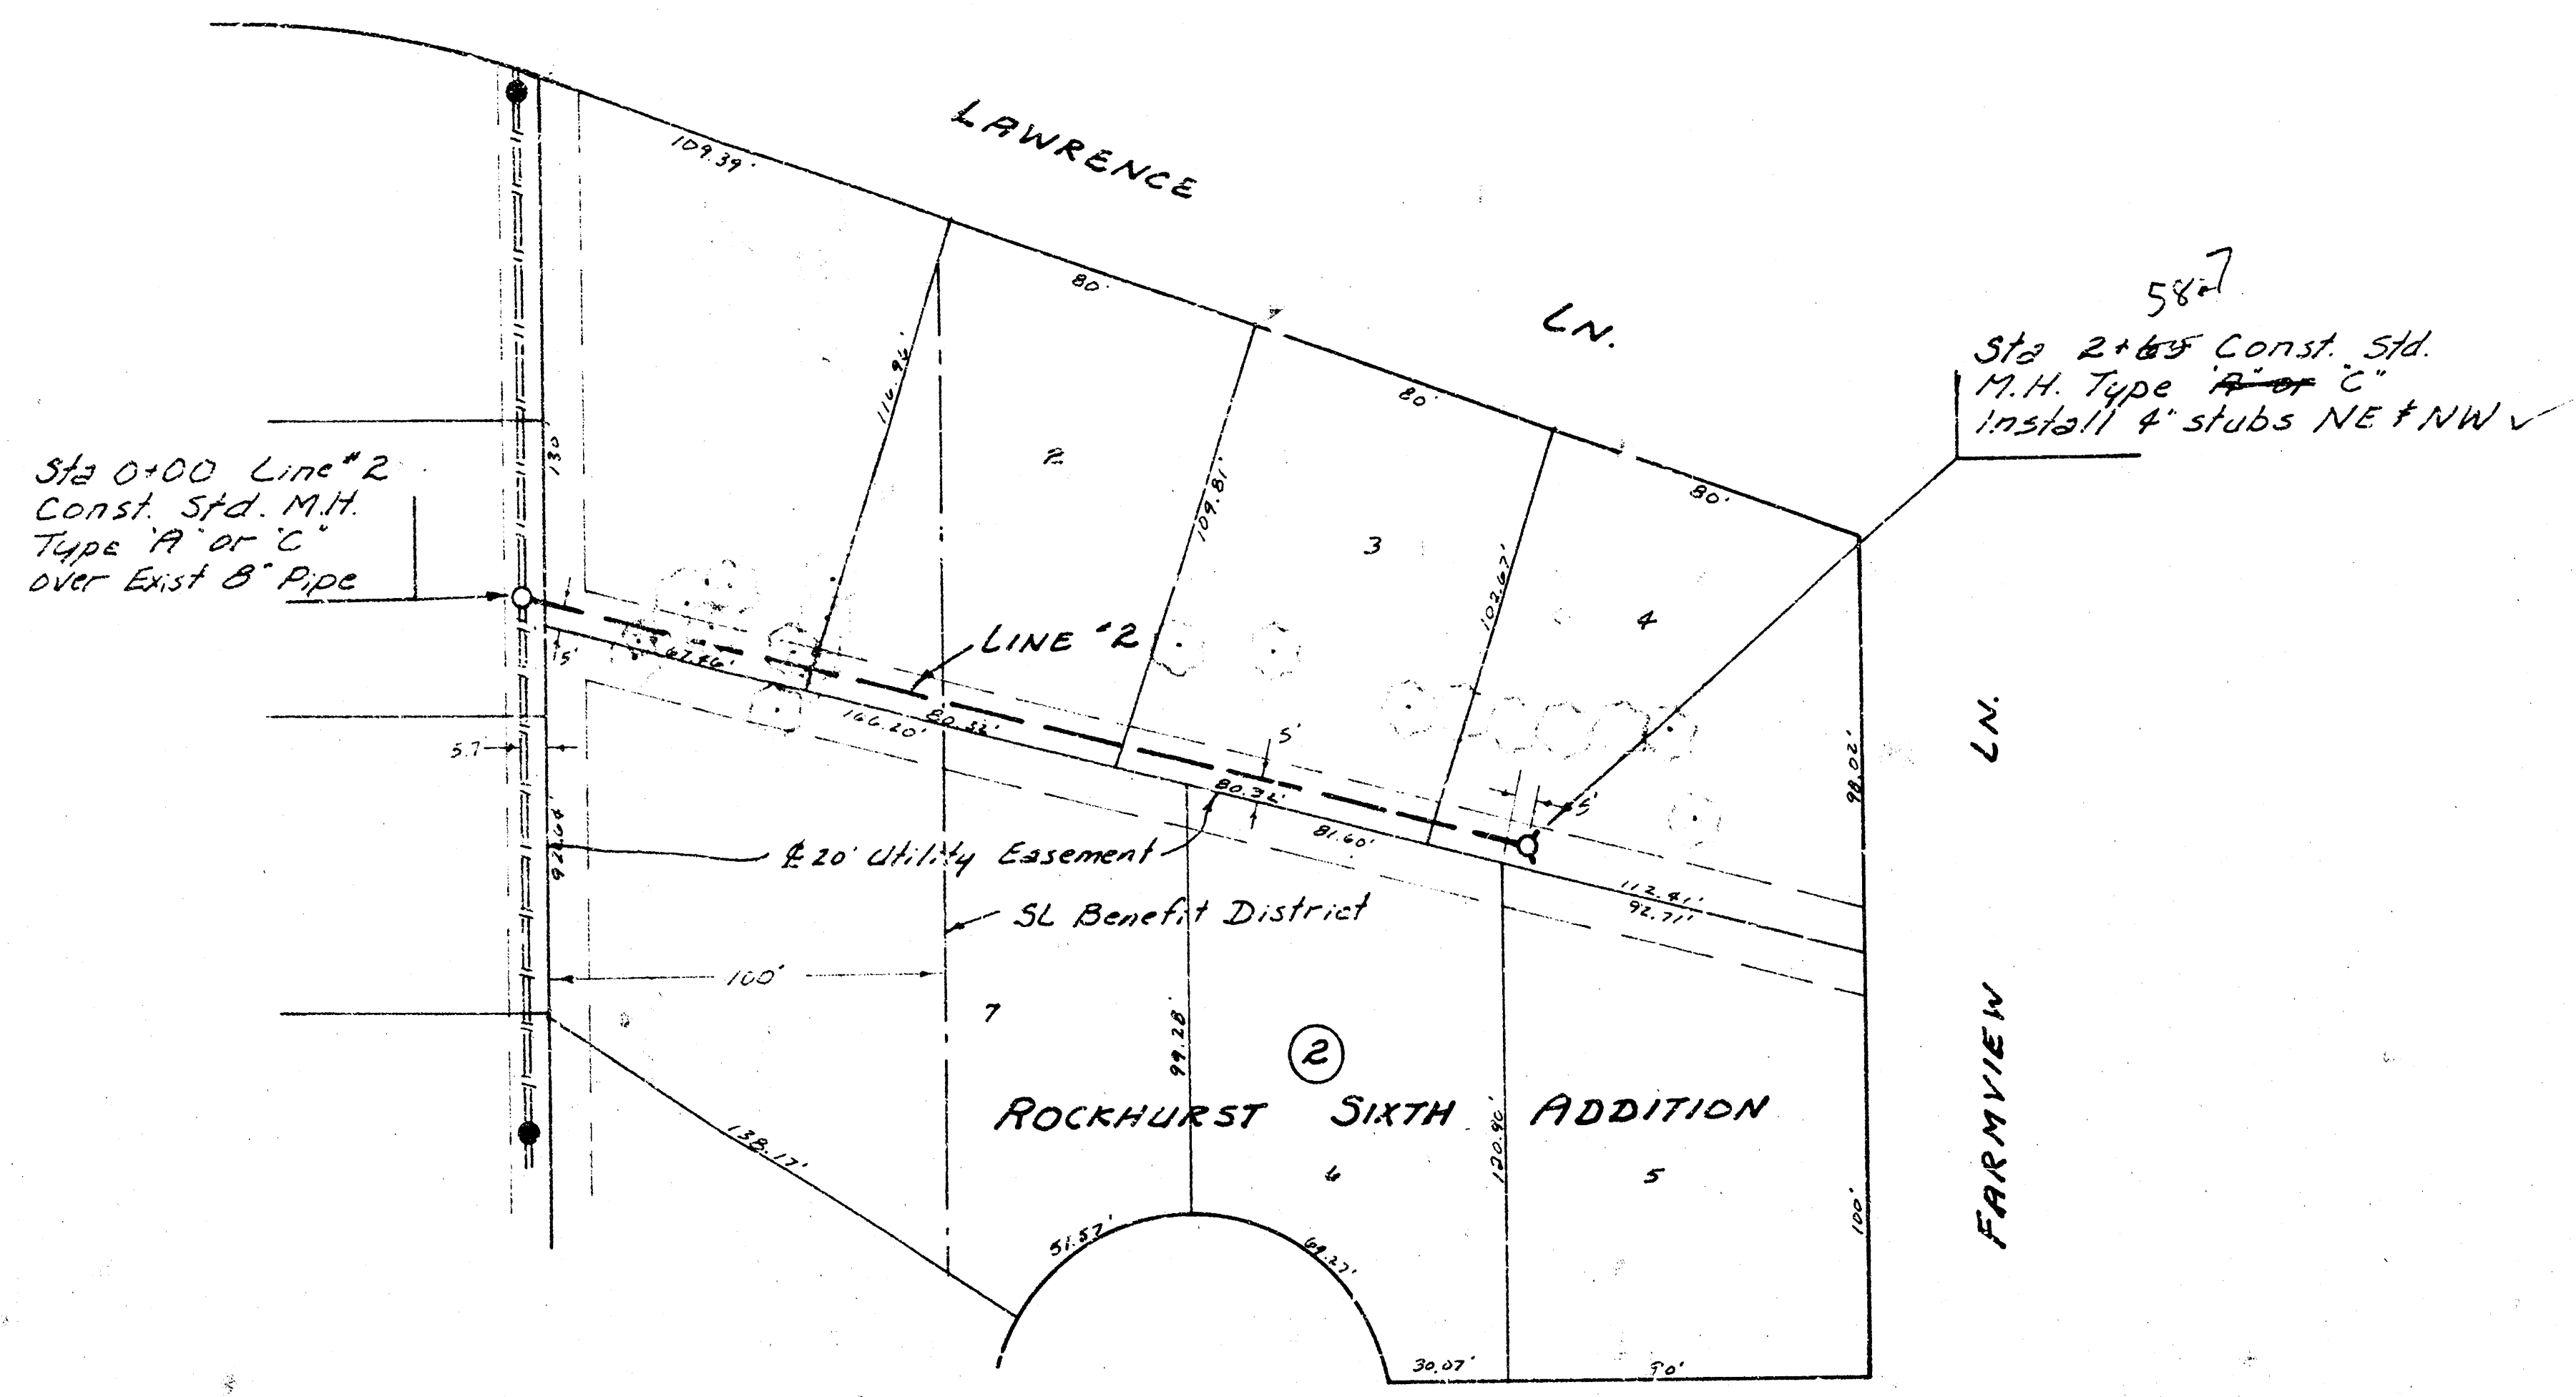

AS BUILT
5/8/1
JST