


MAIN EXTENSION - MAIN 22, W. I. S.

PROJECT NO.

468 76 245 80971 000 000 001


CITY OF WICHITA, KANSAS

DEAN SELLERS, ACTING CITY ENGINEER

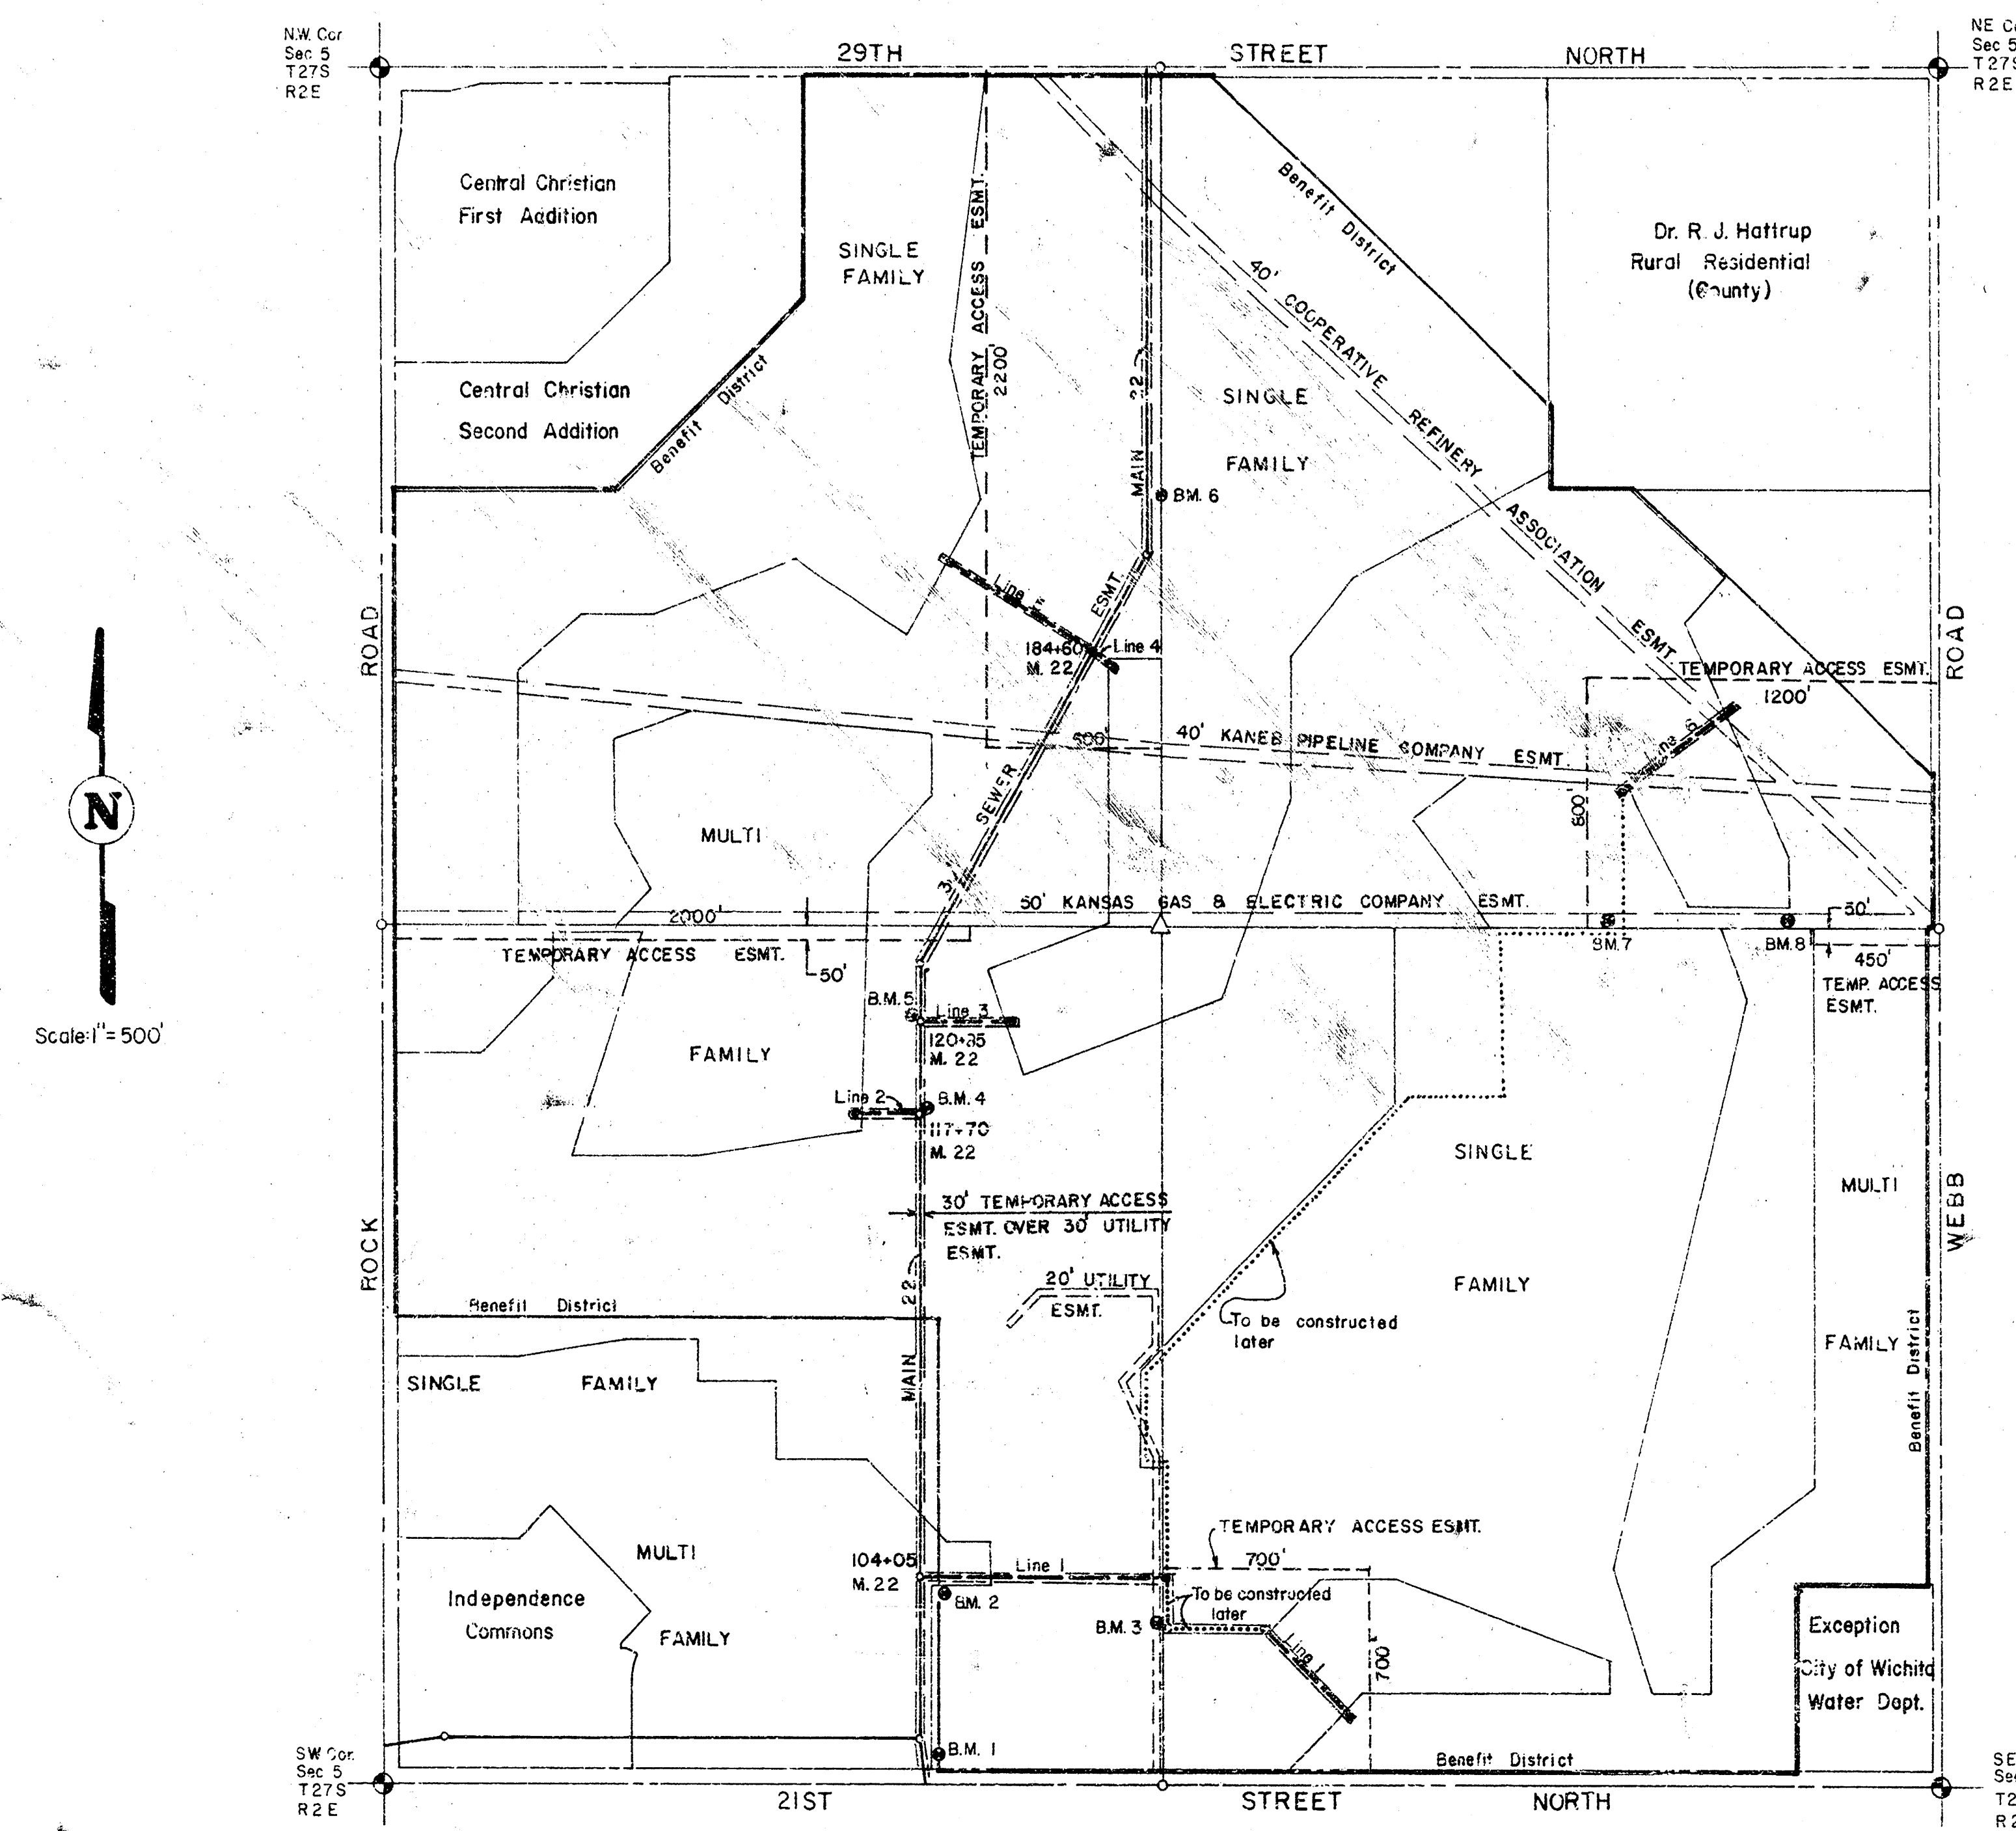

INDEX TO DRAWINGS

SHEET	DESCRIPTION
1	TITLE SHEET
2-3	LINE 1
4	LINE 2 & LINE 3
5	LINE 4 & LINE 5
6	LINE 6

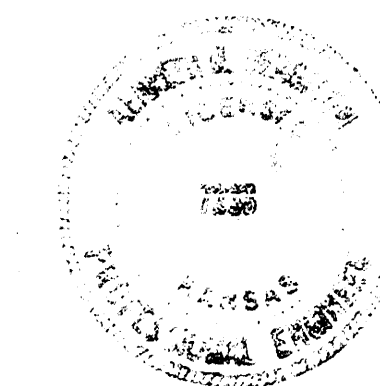


Van Doren - Hazard - Stallings

Architects • Engineers • Planners
Topeka Wichita Minneapolis

Sheet 1
of 6

MAIN EXTENSION, MAIN 22, W.I.S.
468 76-245 80971 000 000 001

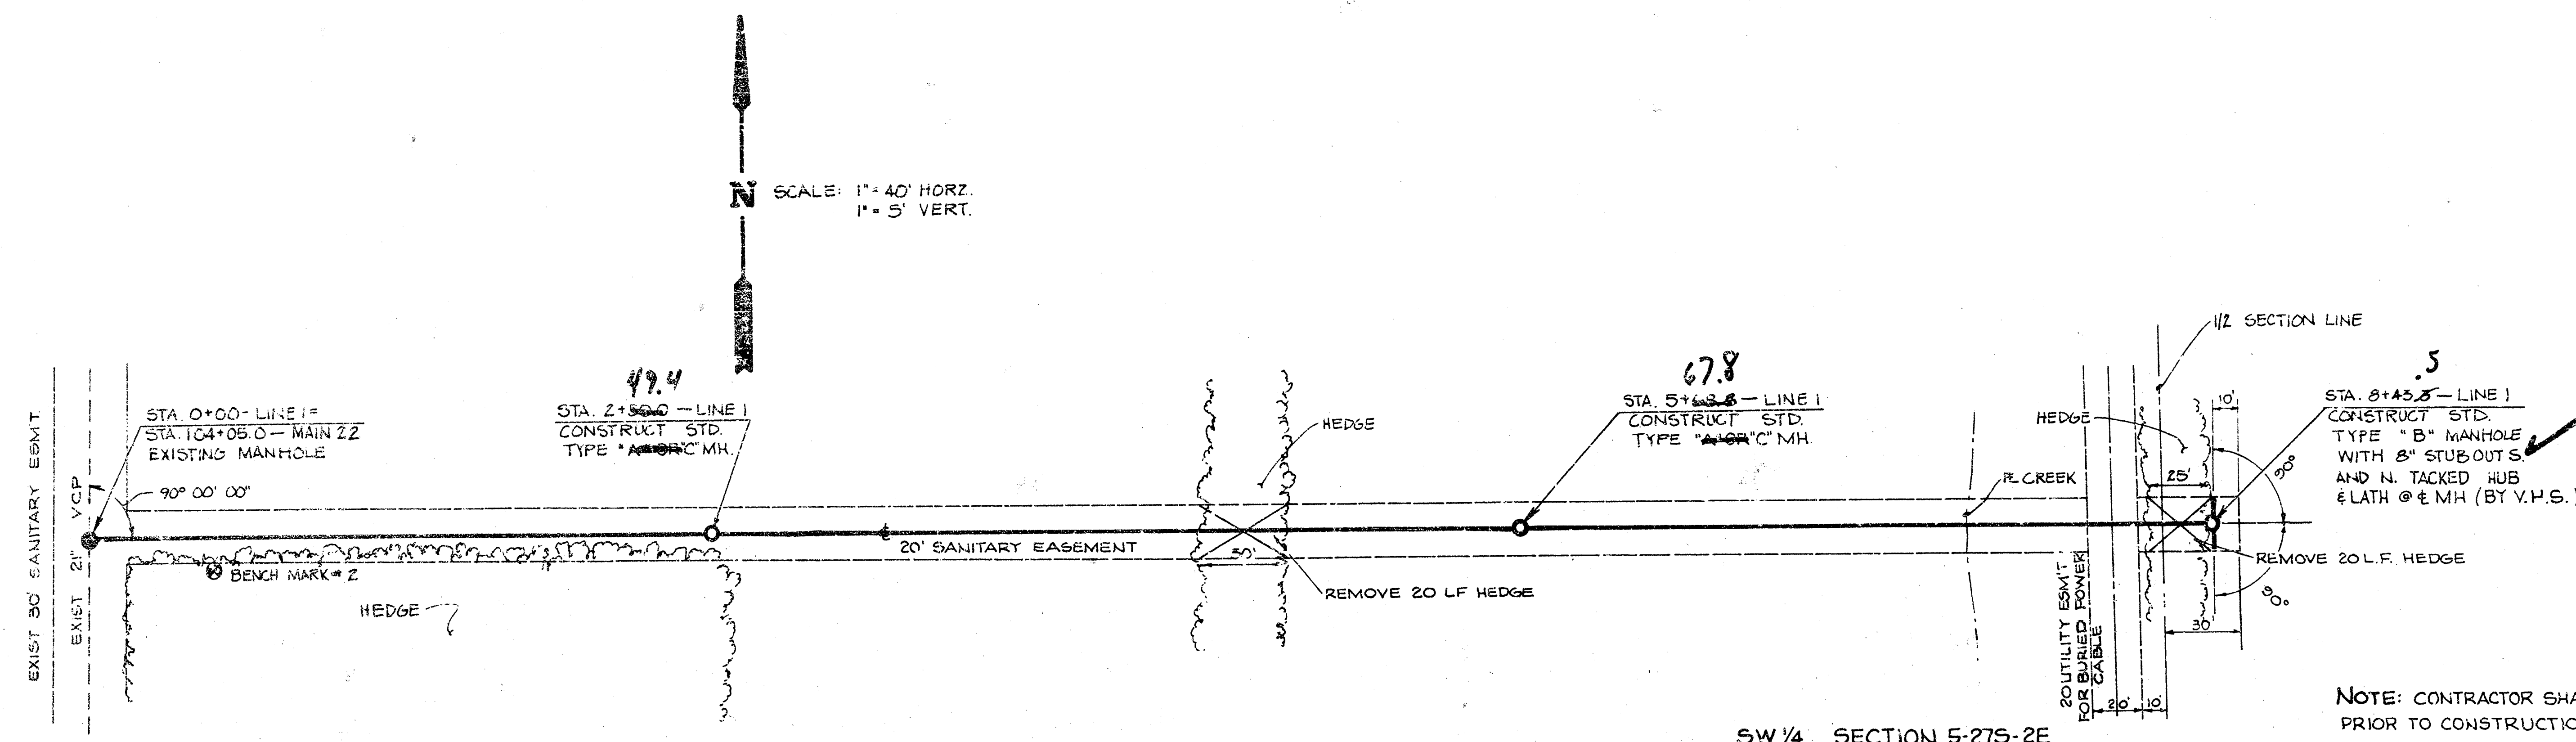


SW 1/4, SECTION 5-275-2E

NOTE: CONTRACTOR SHALL CONTACT K&E PRIOR TO CONSTRUCTION OF SEWER LINE

BENCH MARKS:
BENCH MARK #1: STP SPK. E. FC. PP. S. SIDE 21ST STREET NORTH 1820' E. ROCK ROAD STA. 96+96.17' LT. MAIN 22 WIS. ELEV. = 193.26
BENCH MARK #2: RR SPK NE FC. 10' ELM. STA. 0+50.12' RT. LINE 1 ELEV. = 194.92
BENCH MARK #3: TOP BENT SPK E. ROOT 2-6" HEDGE TREES 30' RT. 9+75. ELEV. = 194.36

BENCH MARK #1


BENCH MARK #3

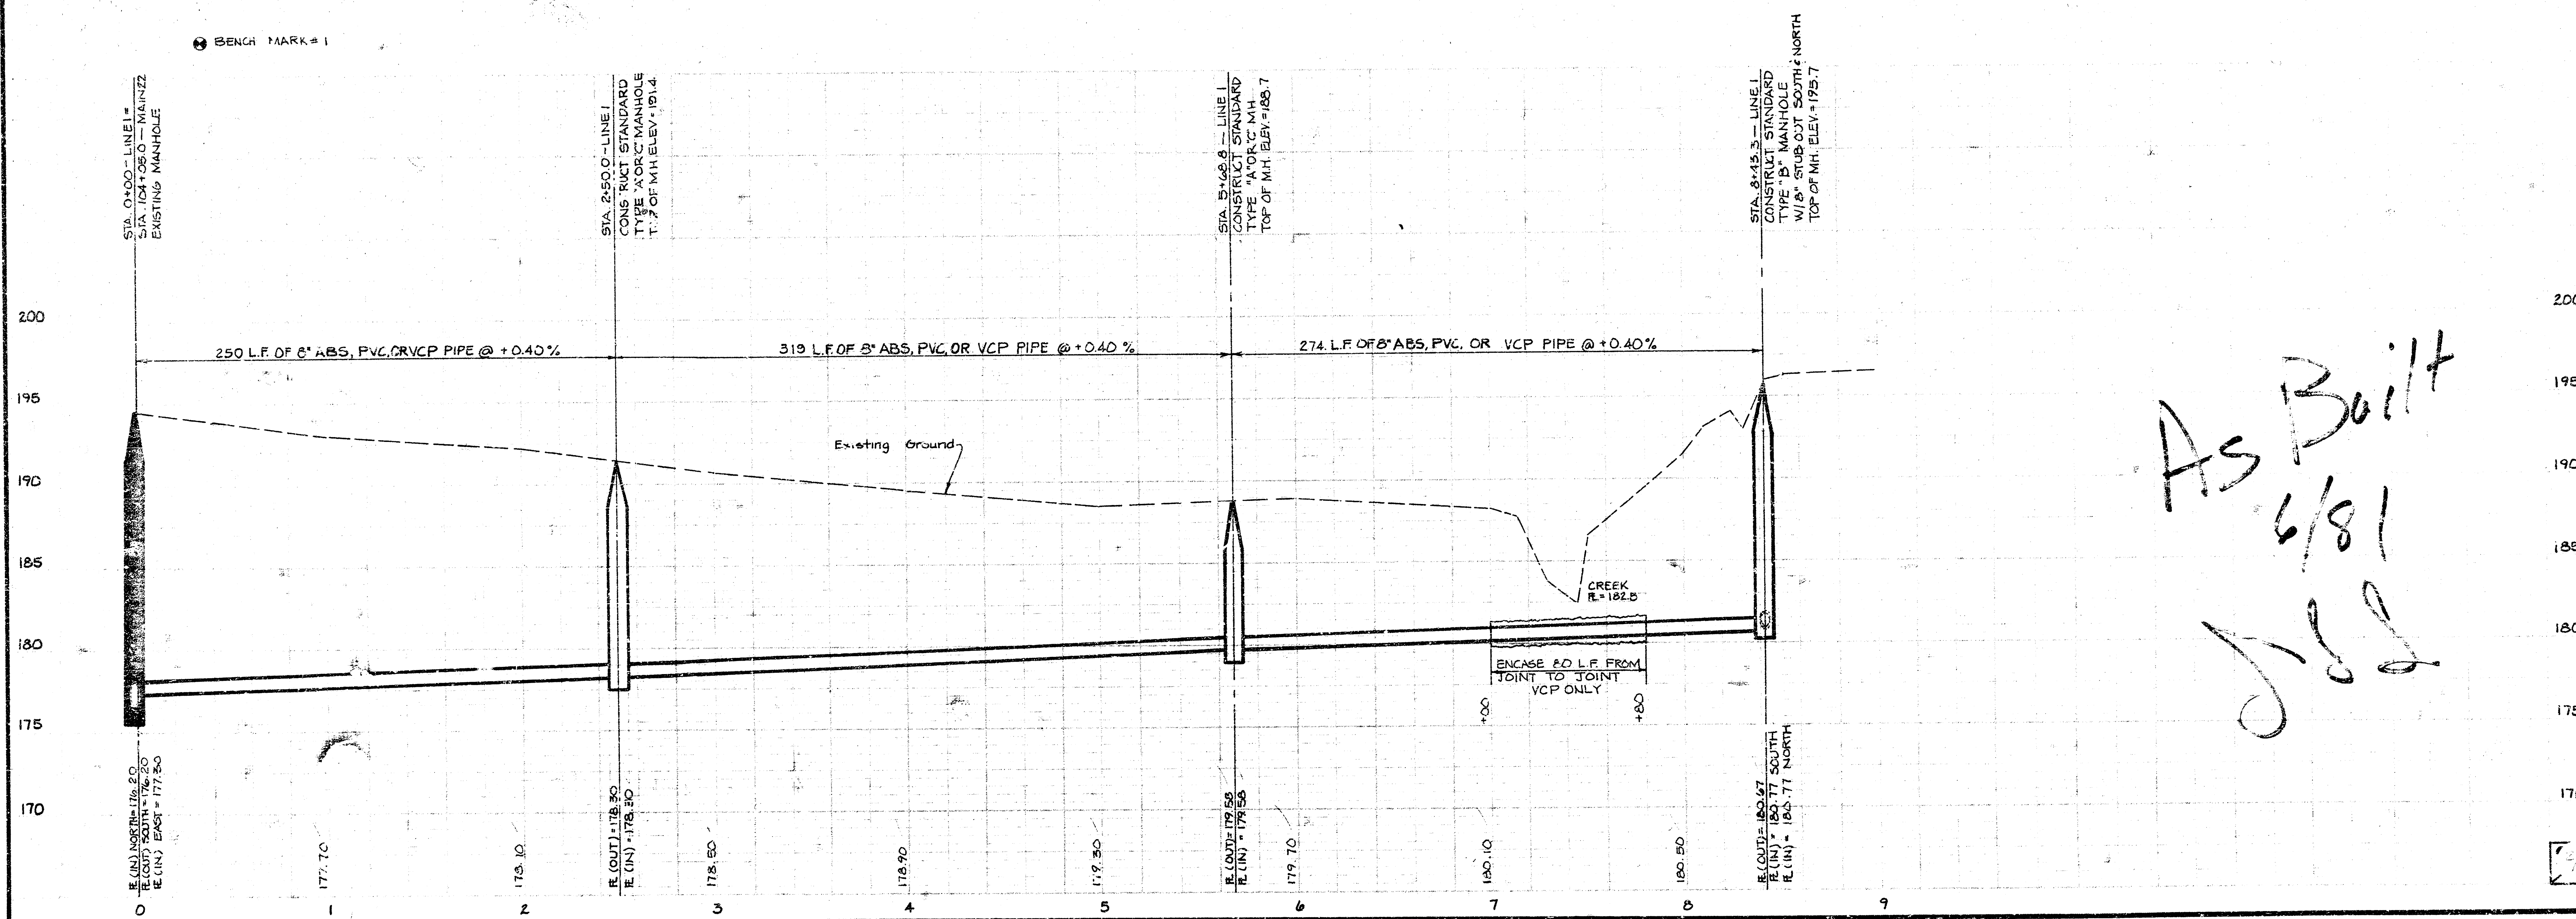


As Built
6/81
JSS

MAIN EXTENSION, MAIN 22, W.I.S.
468-76-245-80971-000-000-001



SCALE: 1" = 40' HORIZ.
1" = 5' VERT.

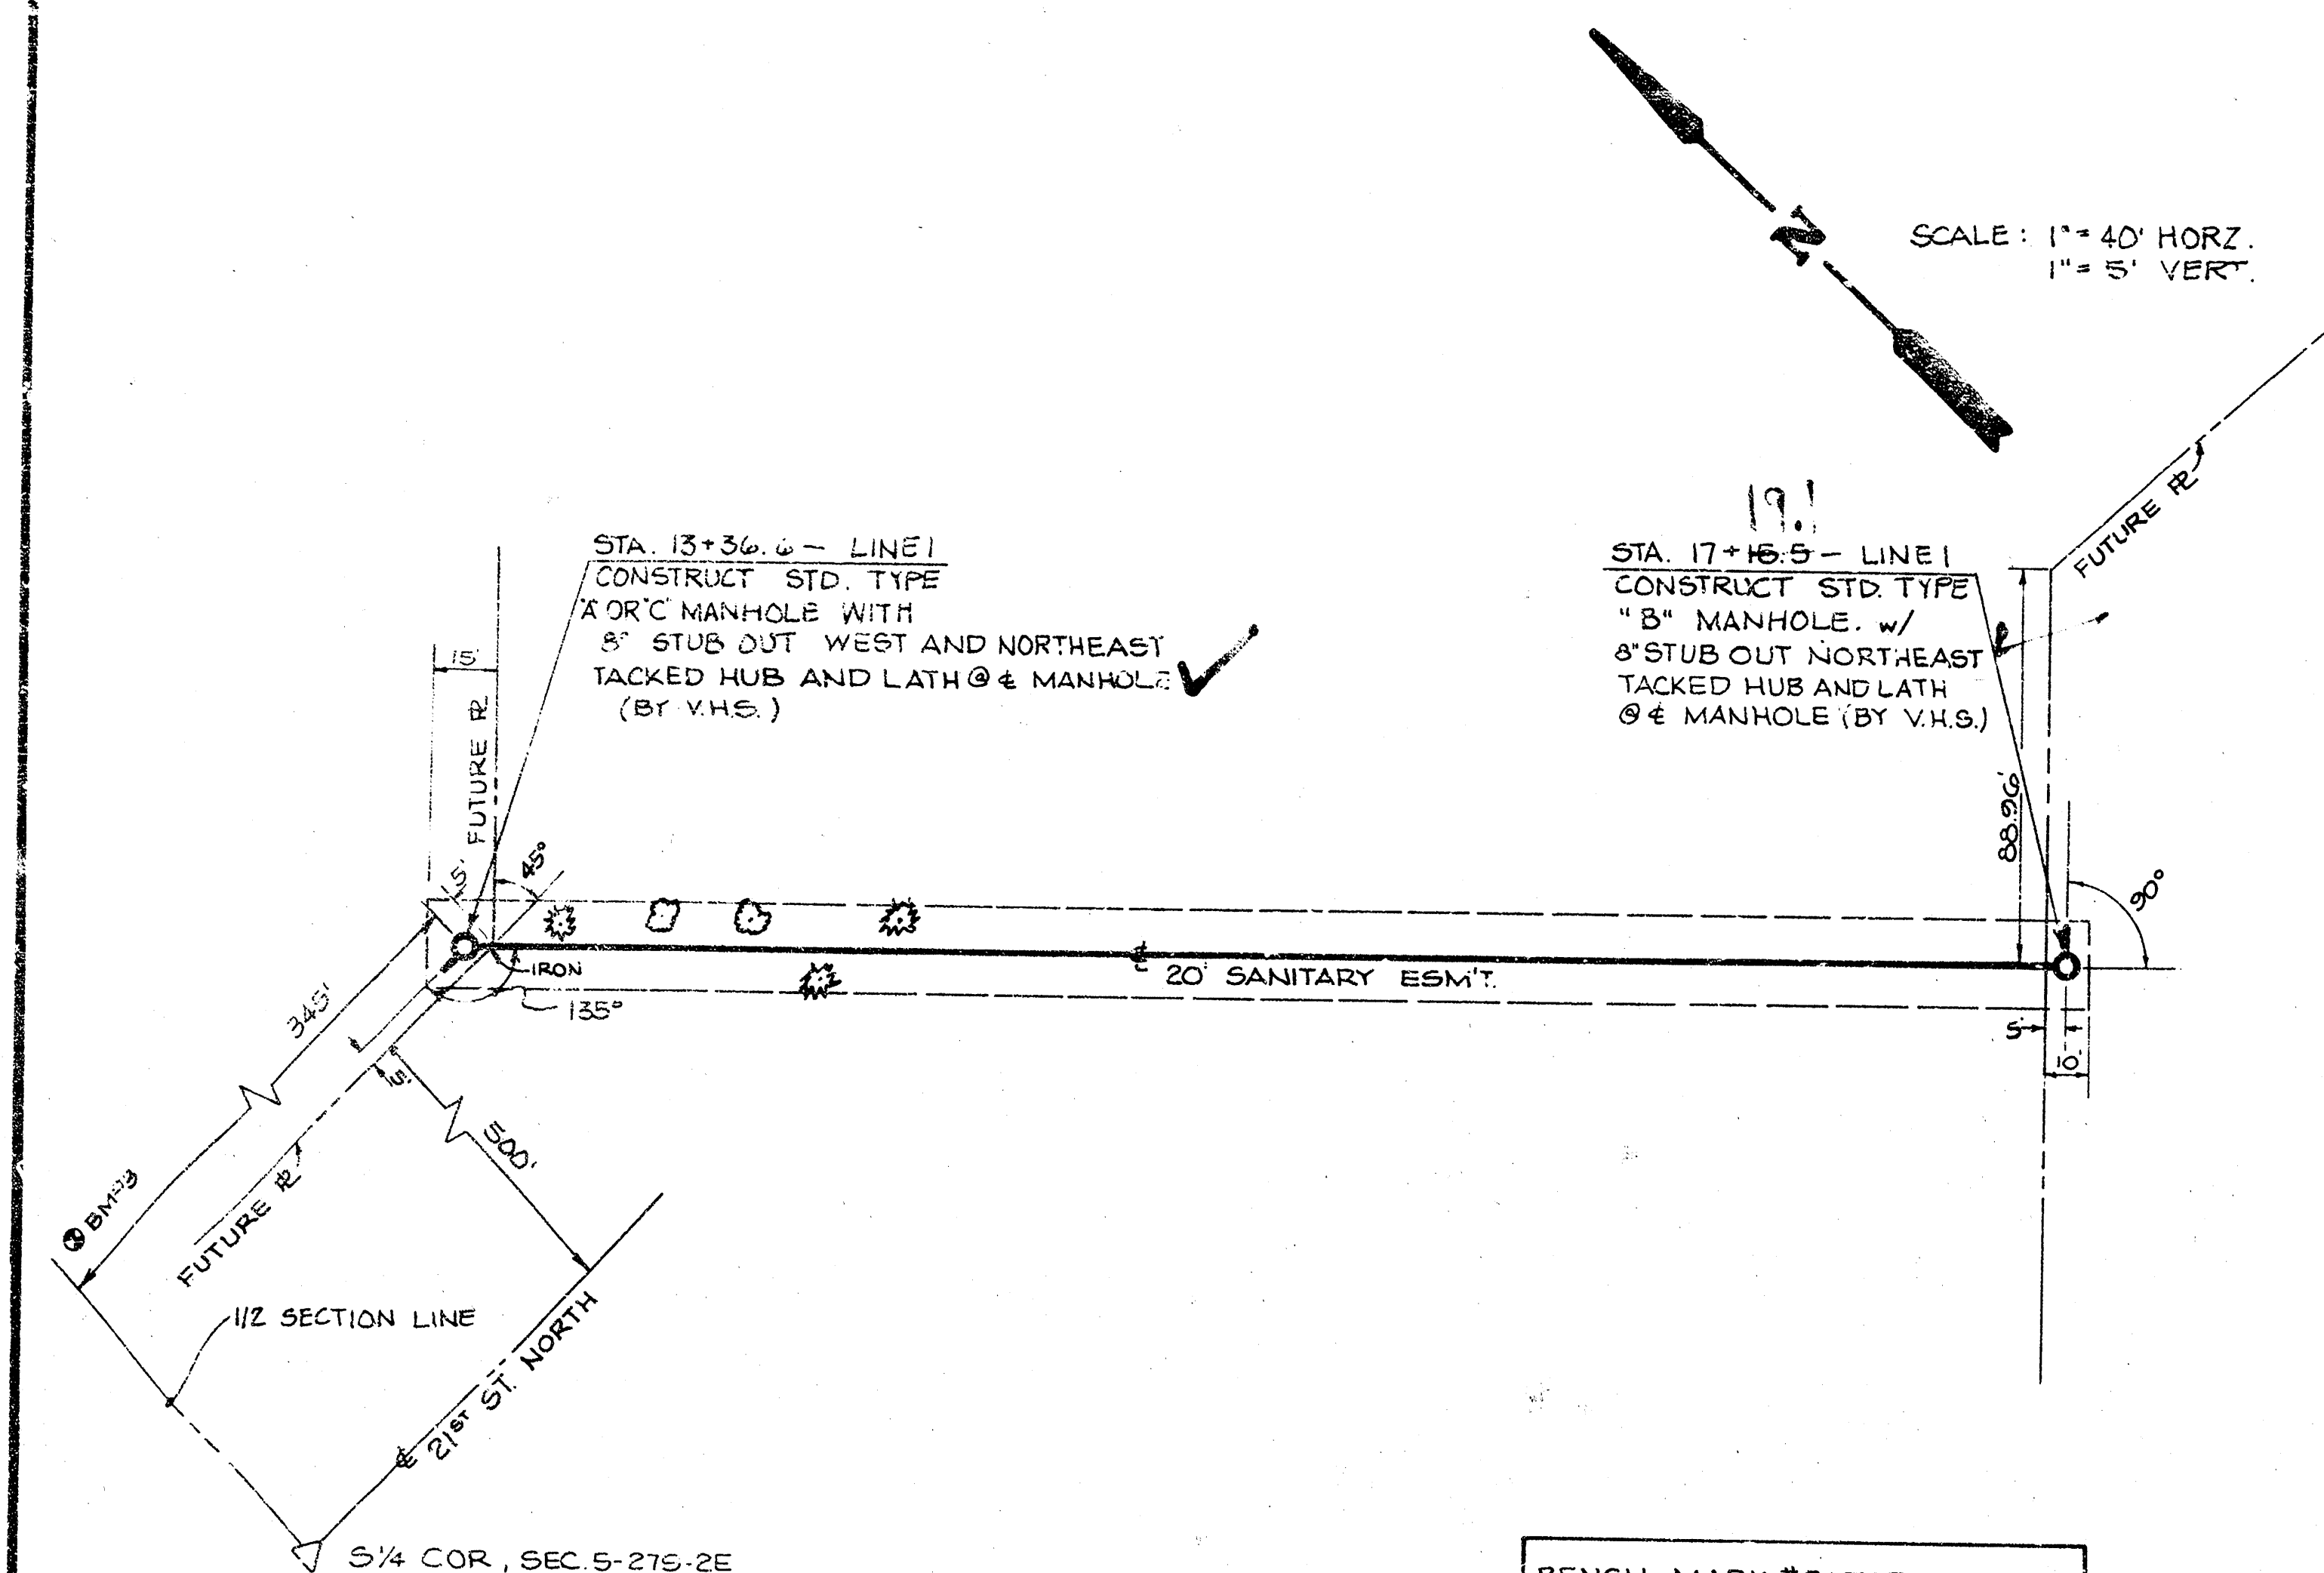

BENCH MARK #3: TOP BENT OF
E ROOT 2-6\"/>

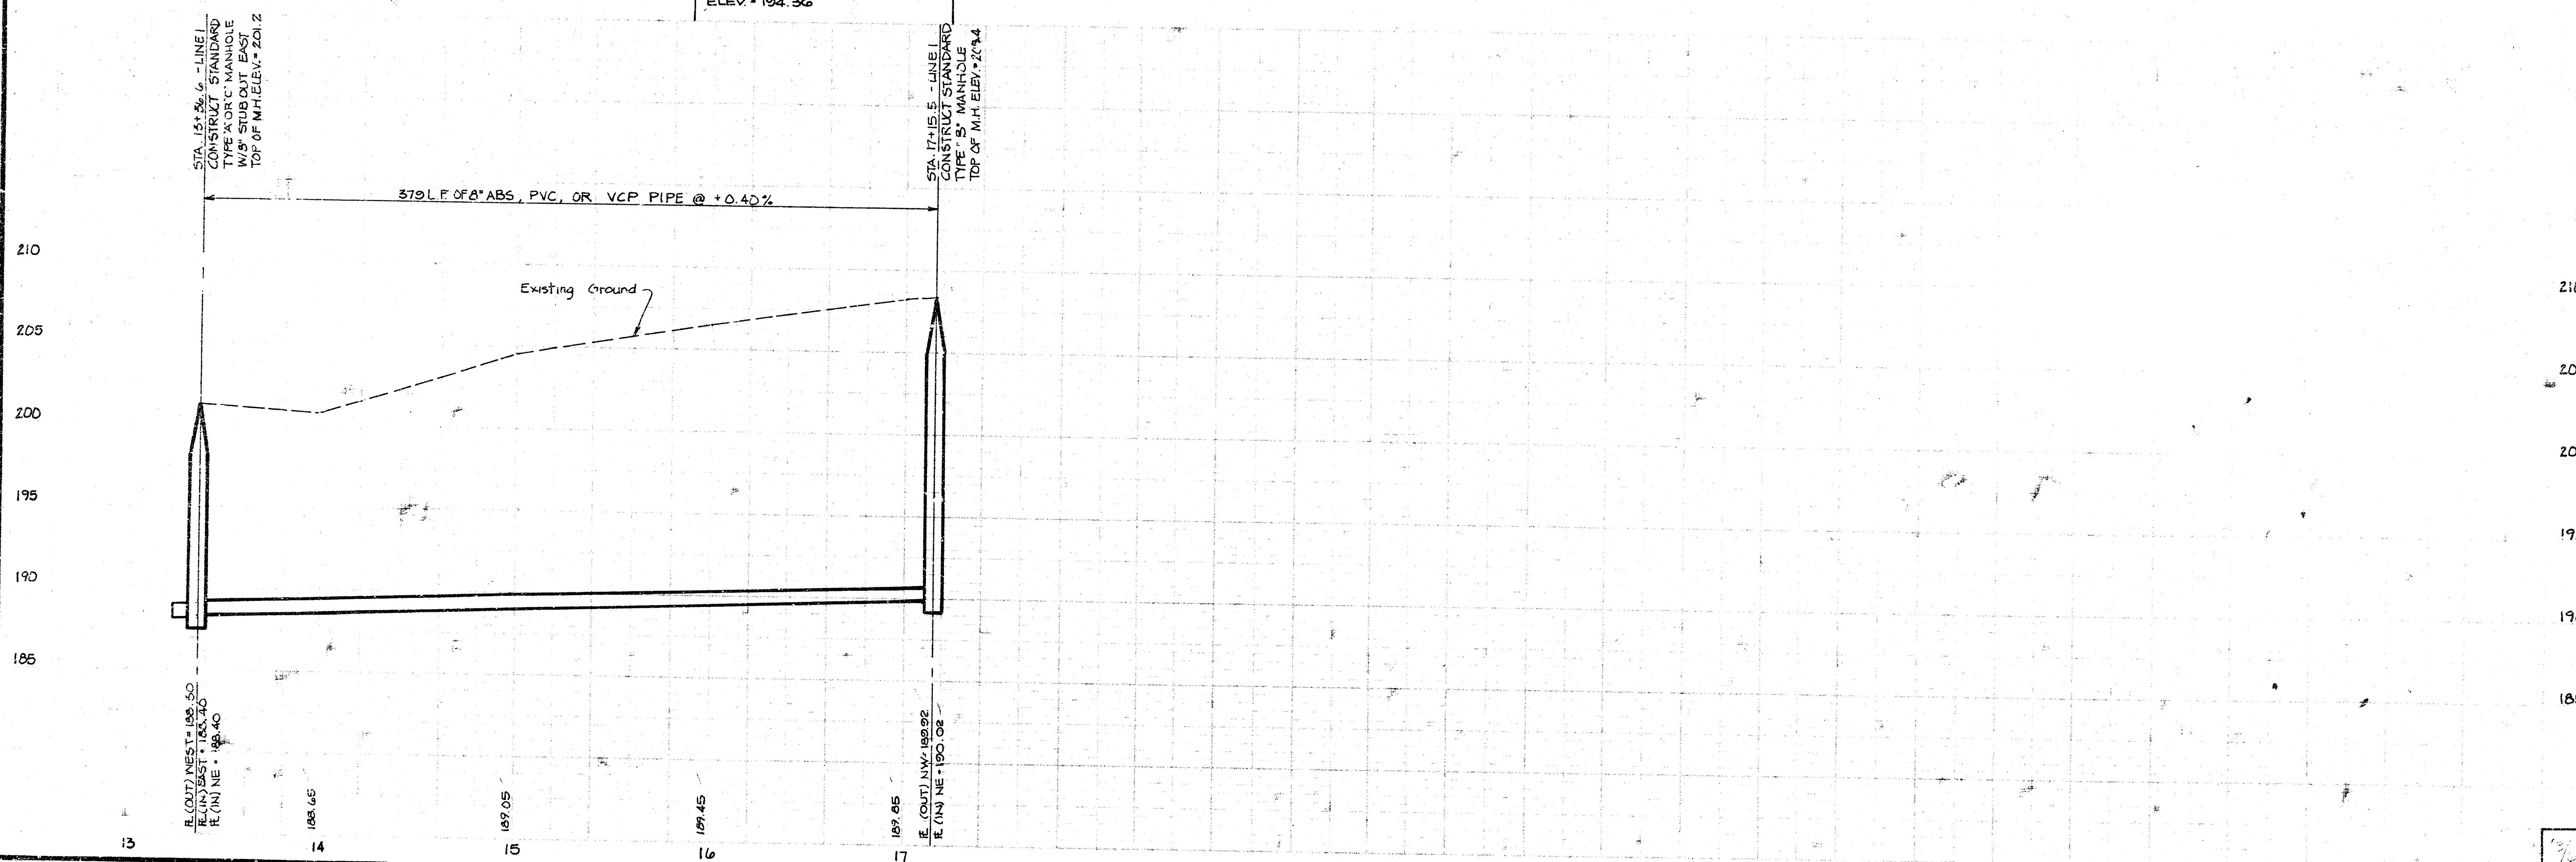


MAIN EXTENSION, MAIN 22, W.L.S
463.76.245.80971.000.000.001

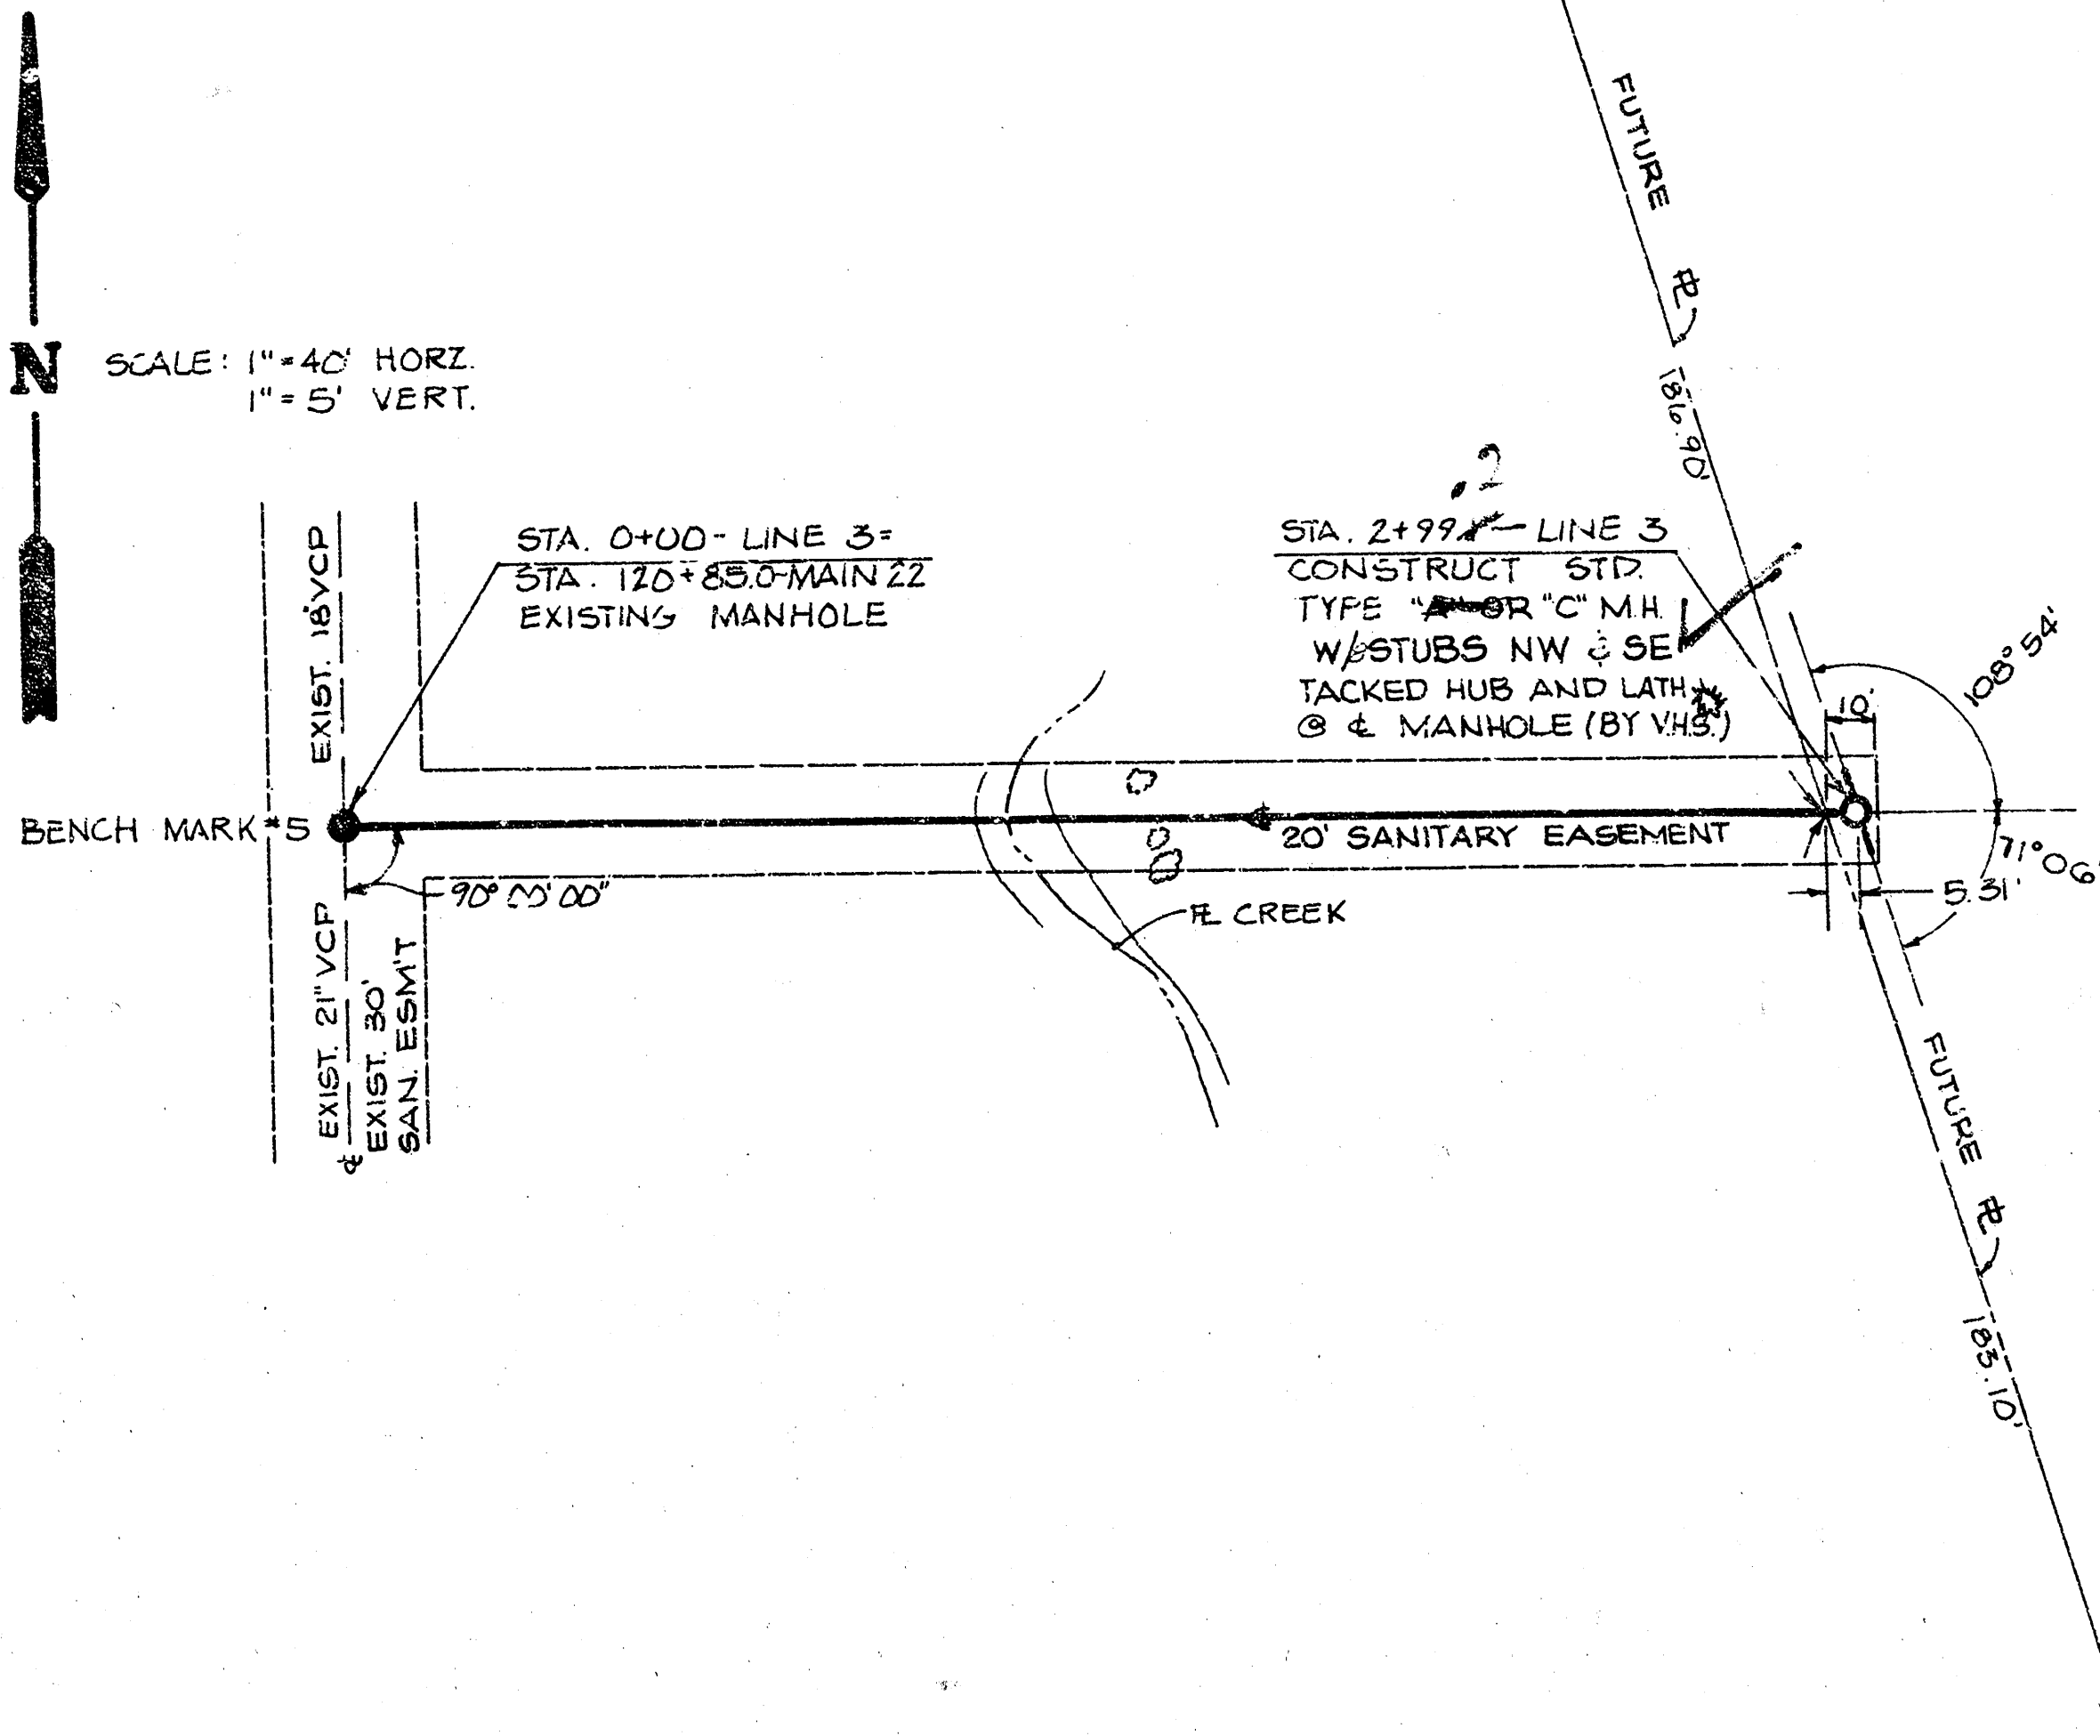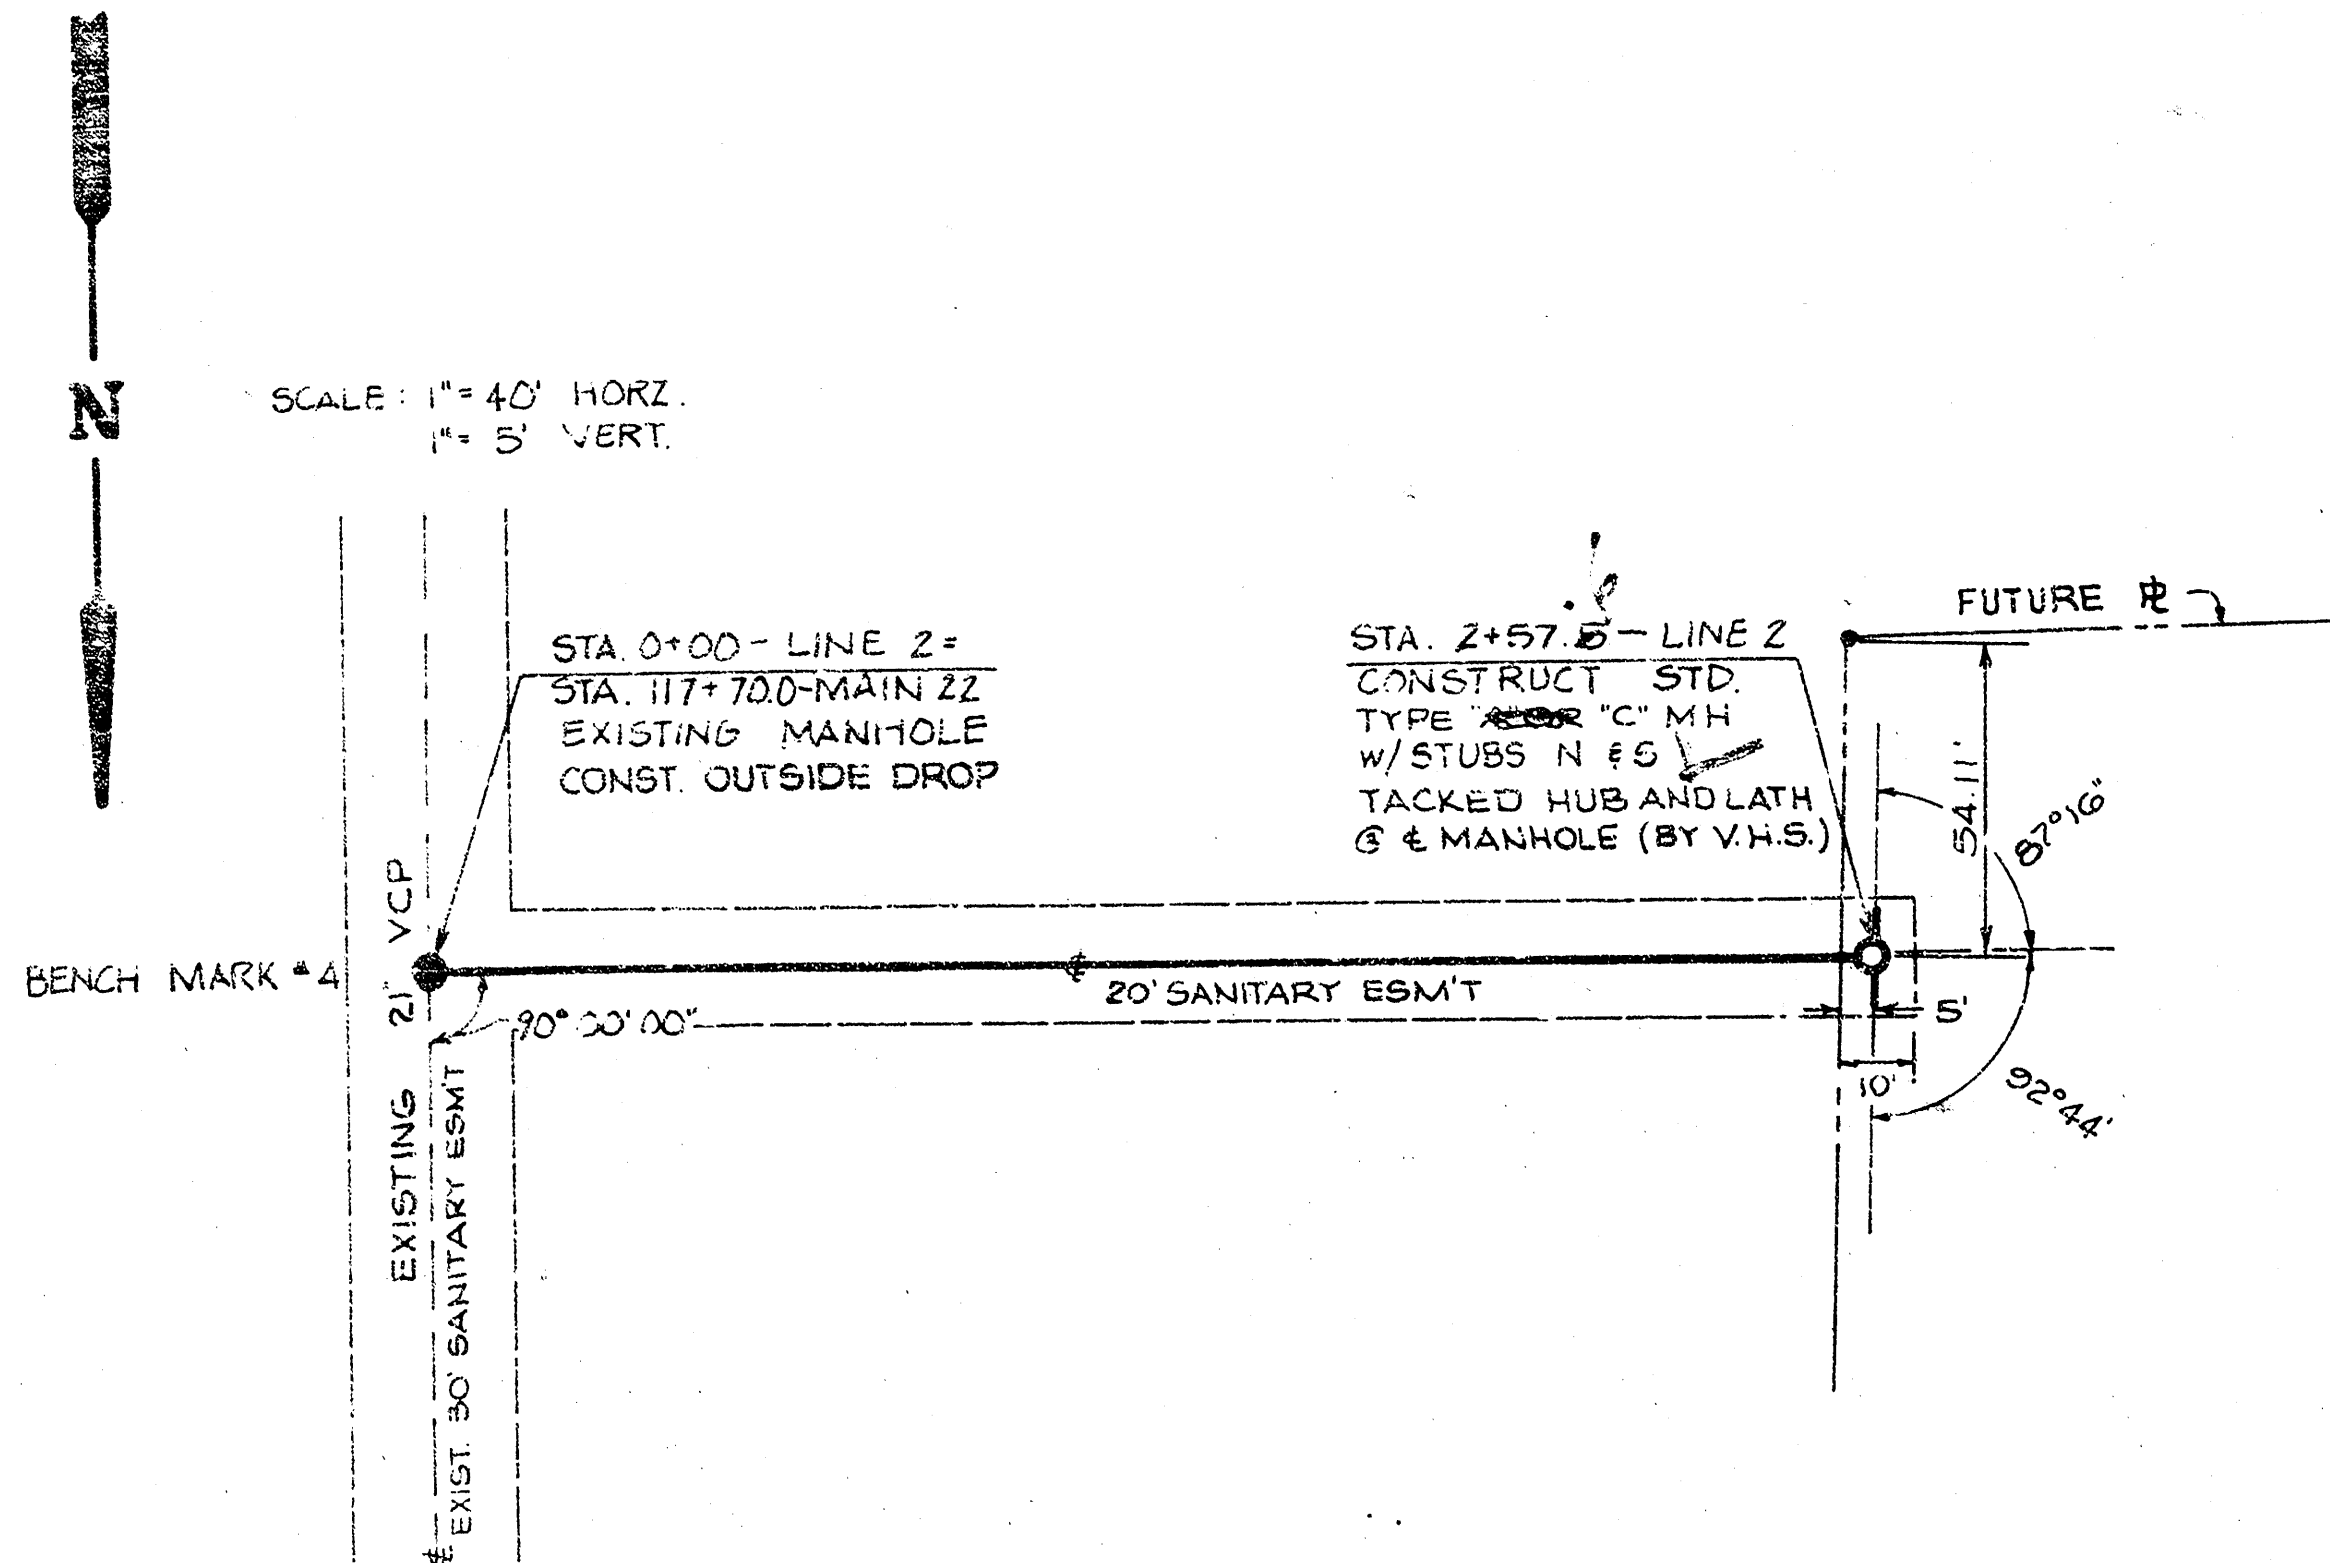


BENCH MARKS

BENCH MARK #4: SW MH
RIM STA. 117+70
ELEV. = 195.26

BENCH MARK #5: E RIM
MH. STA. 120+85
ELEV. = 198.38

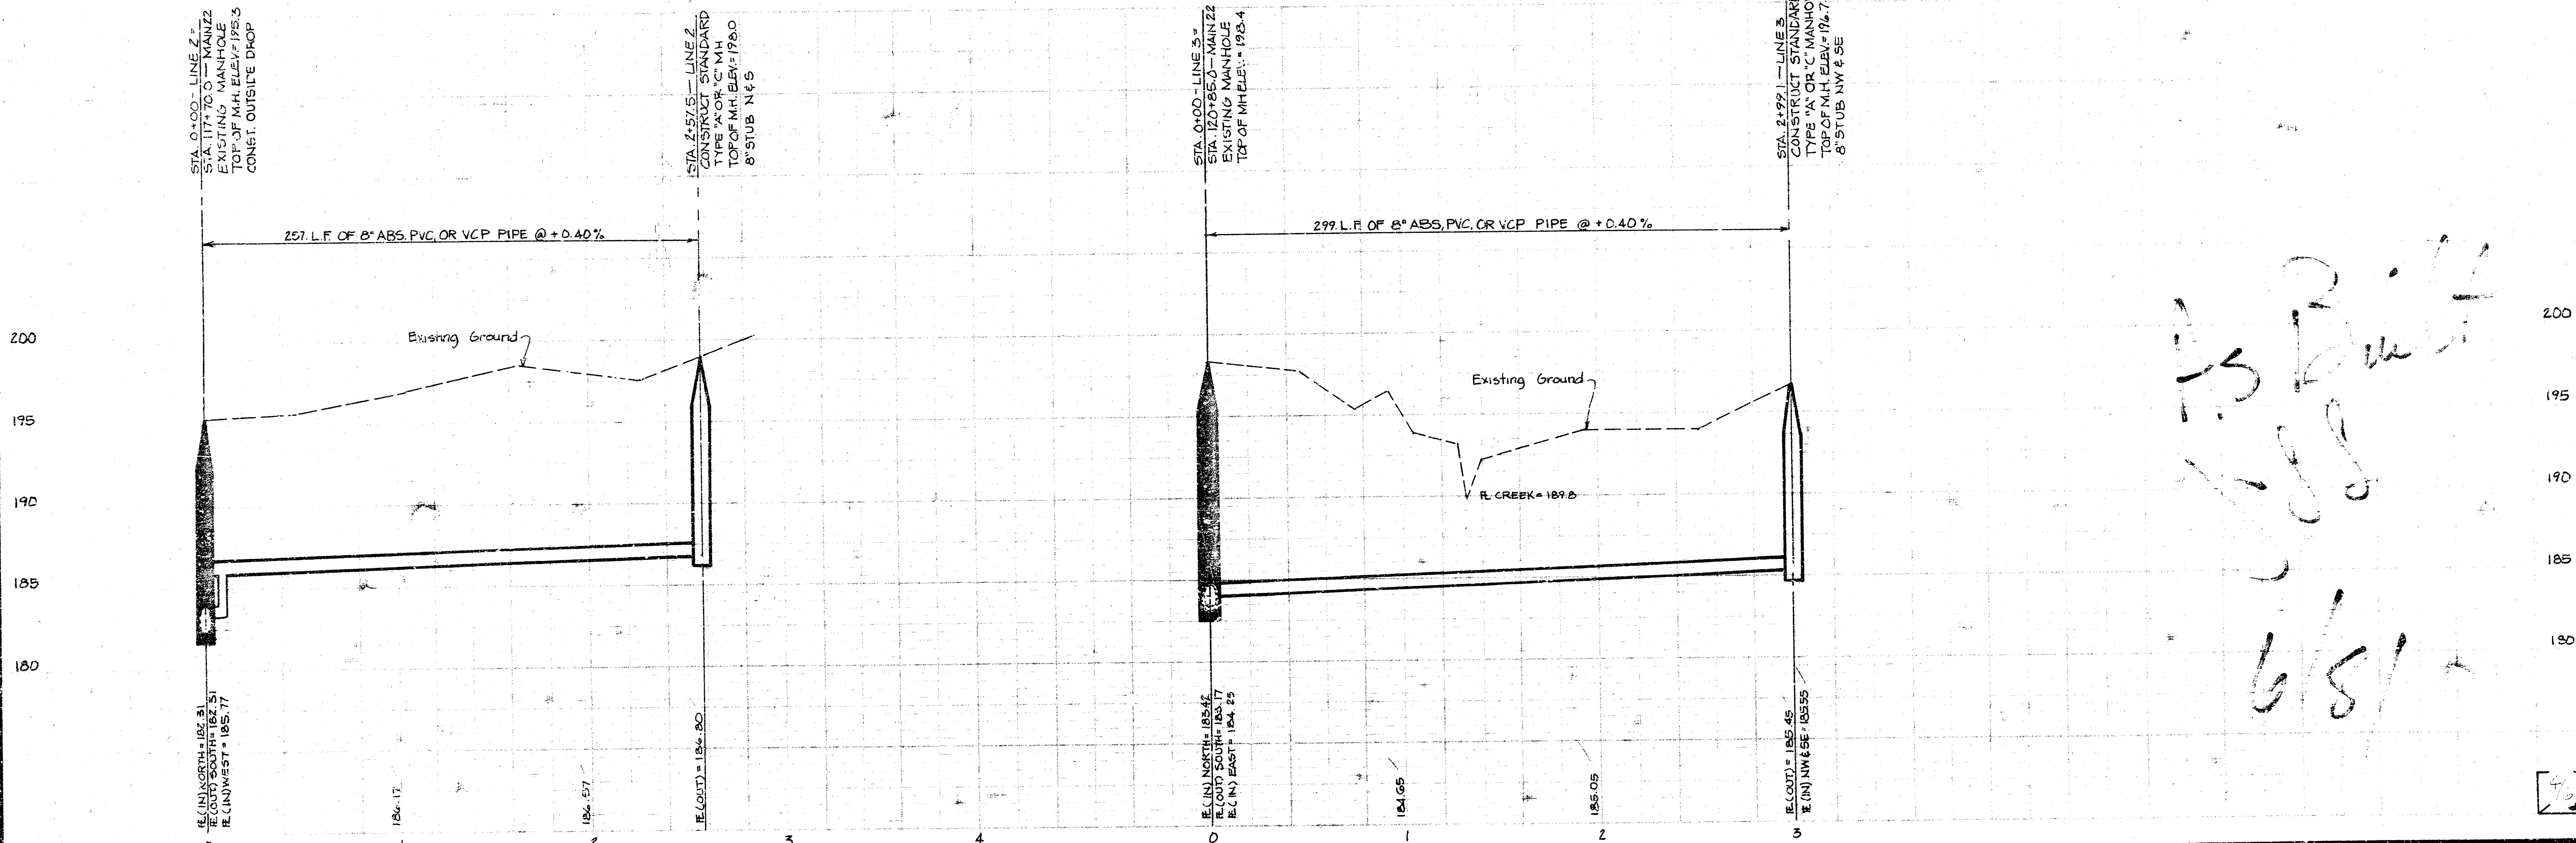


MAIN EXTENSION, MAIN 22, W.I.S.
468-76-245-80971 000-000-001


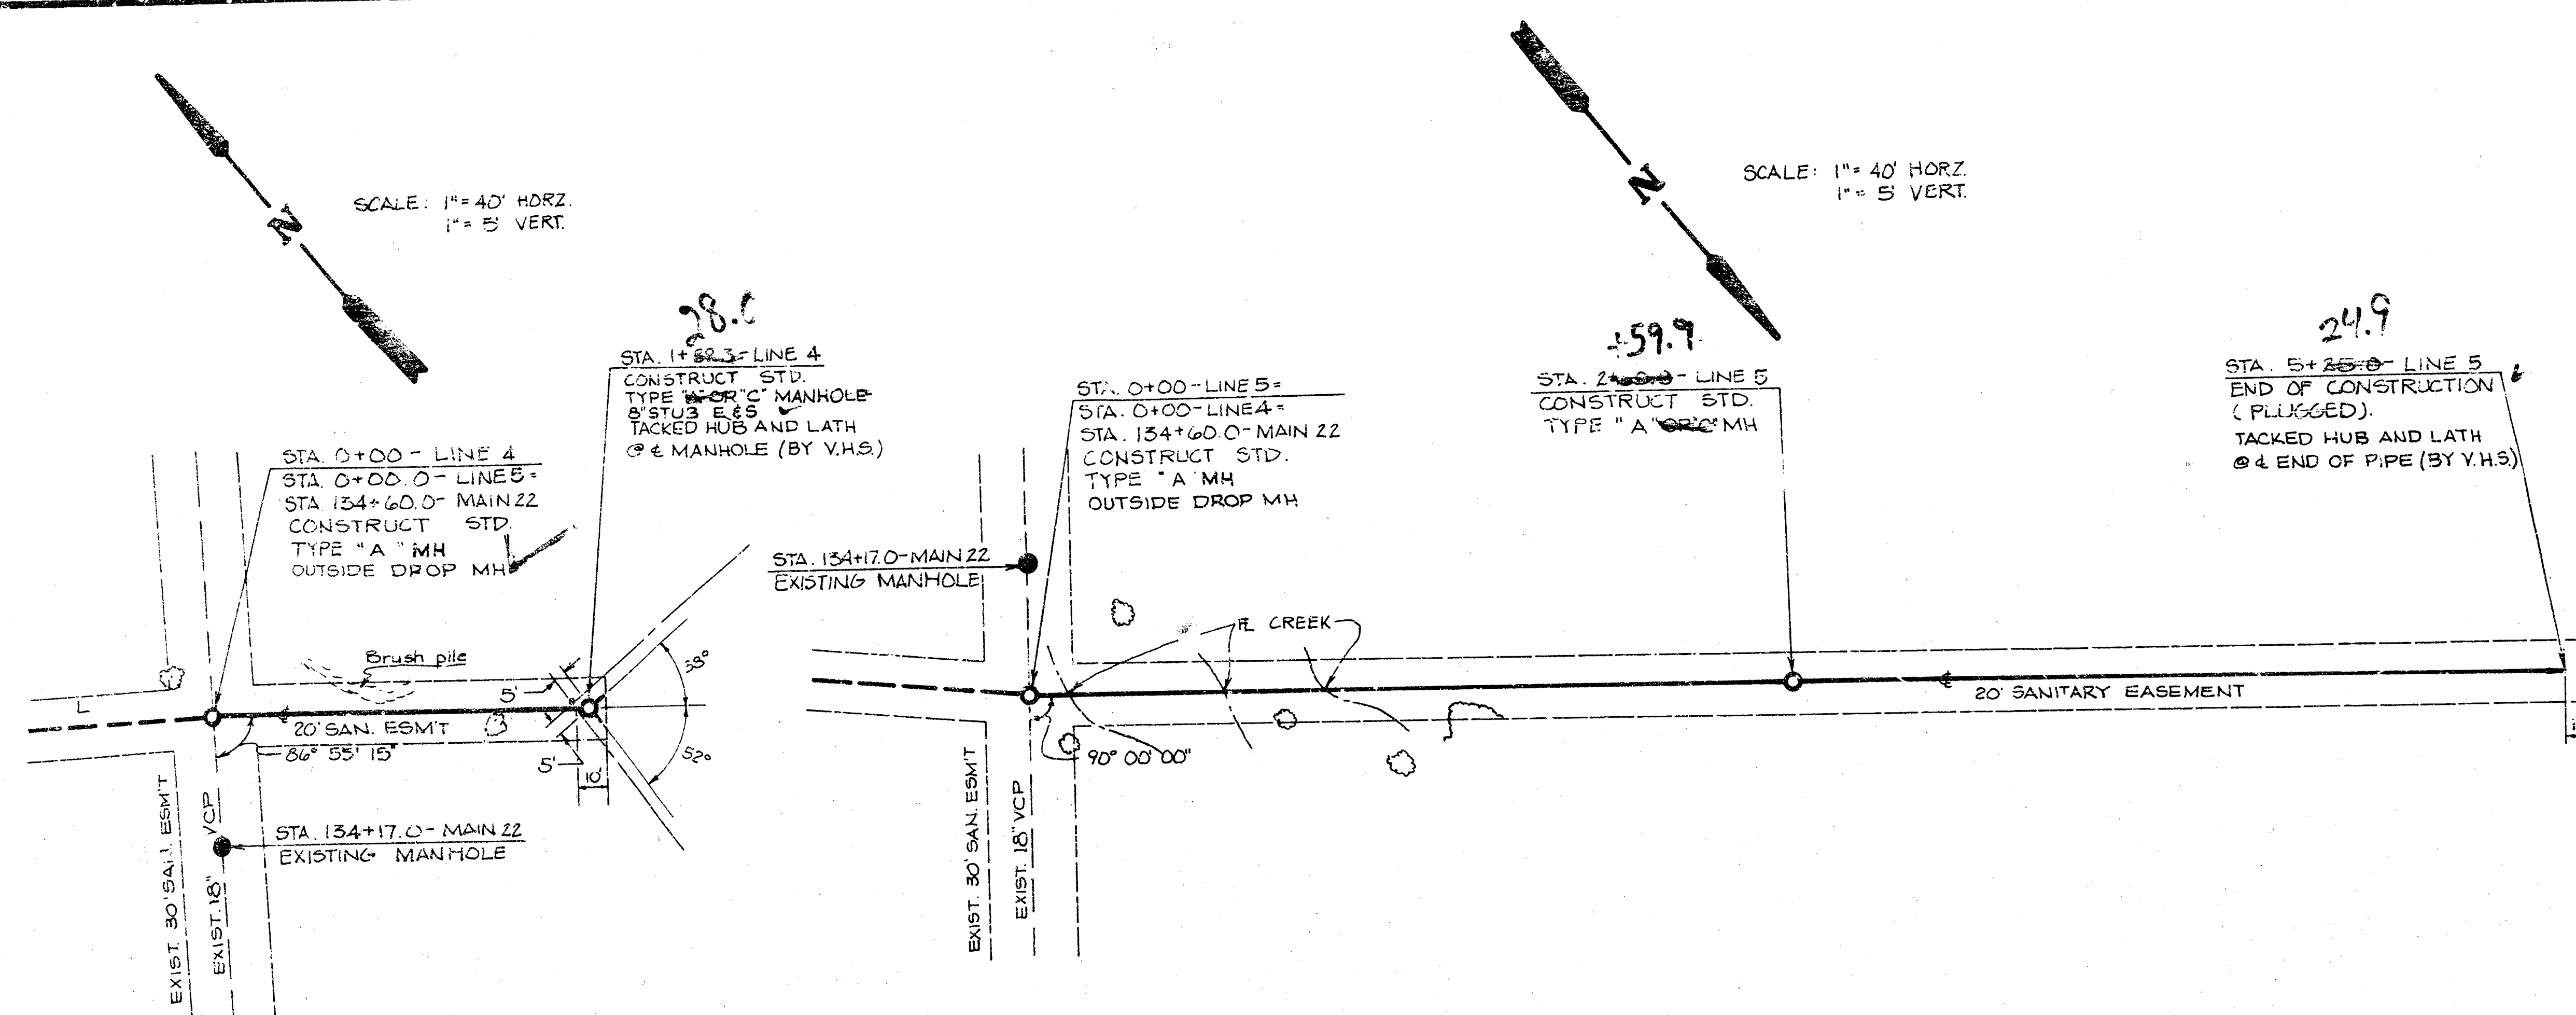


BENCH MARKS:

BENCH MARK # 6: BENT SPIKE
W. ROOT 25' HEDGE 139+72
50' RT. MAIN 22.
ELEV. = 219.06

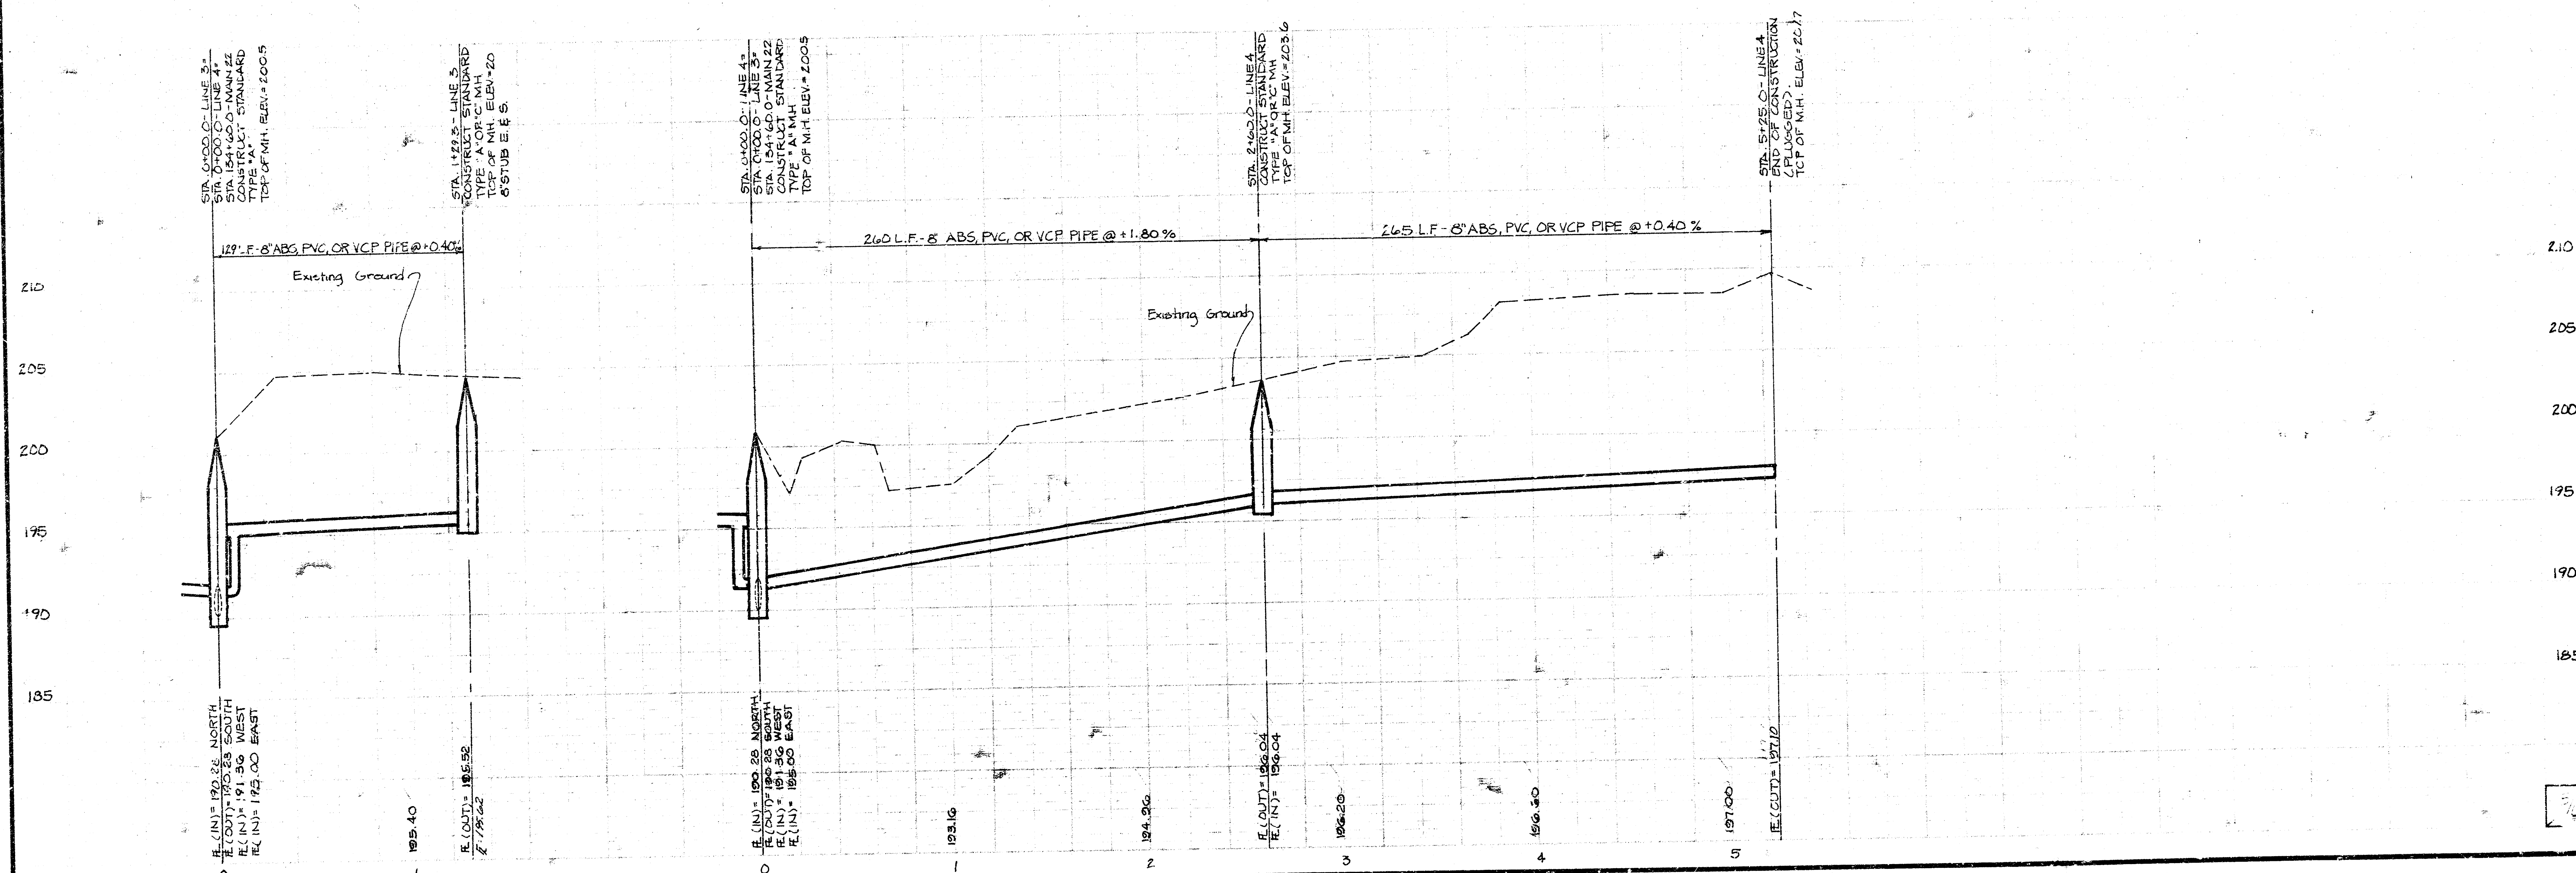

MAIN EXTENSION, MAIN 22, W.I.S.
468-76-245 80971 000-000-001

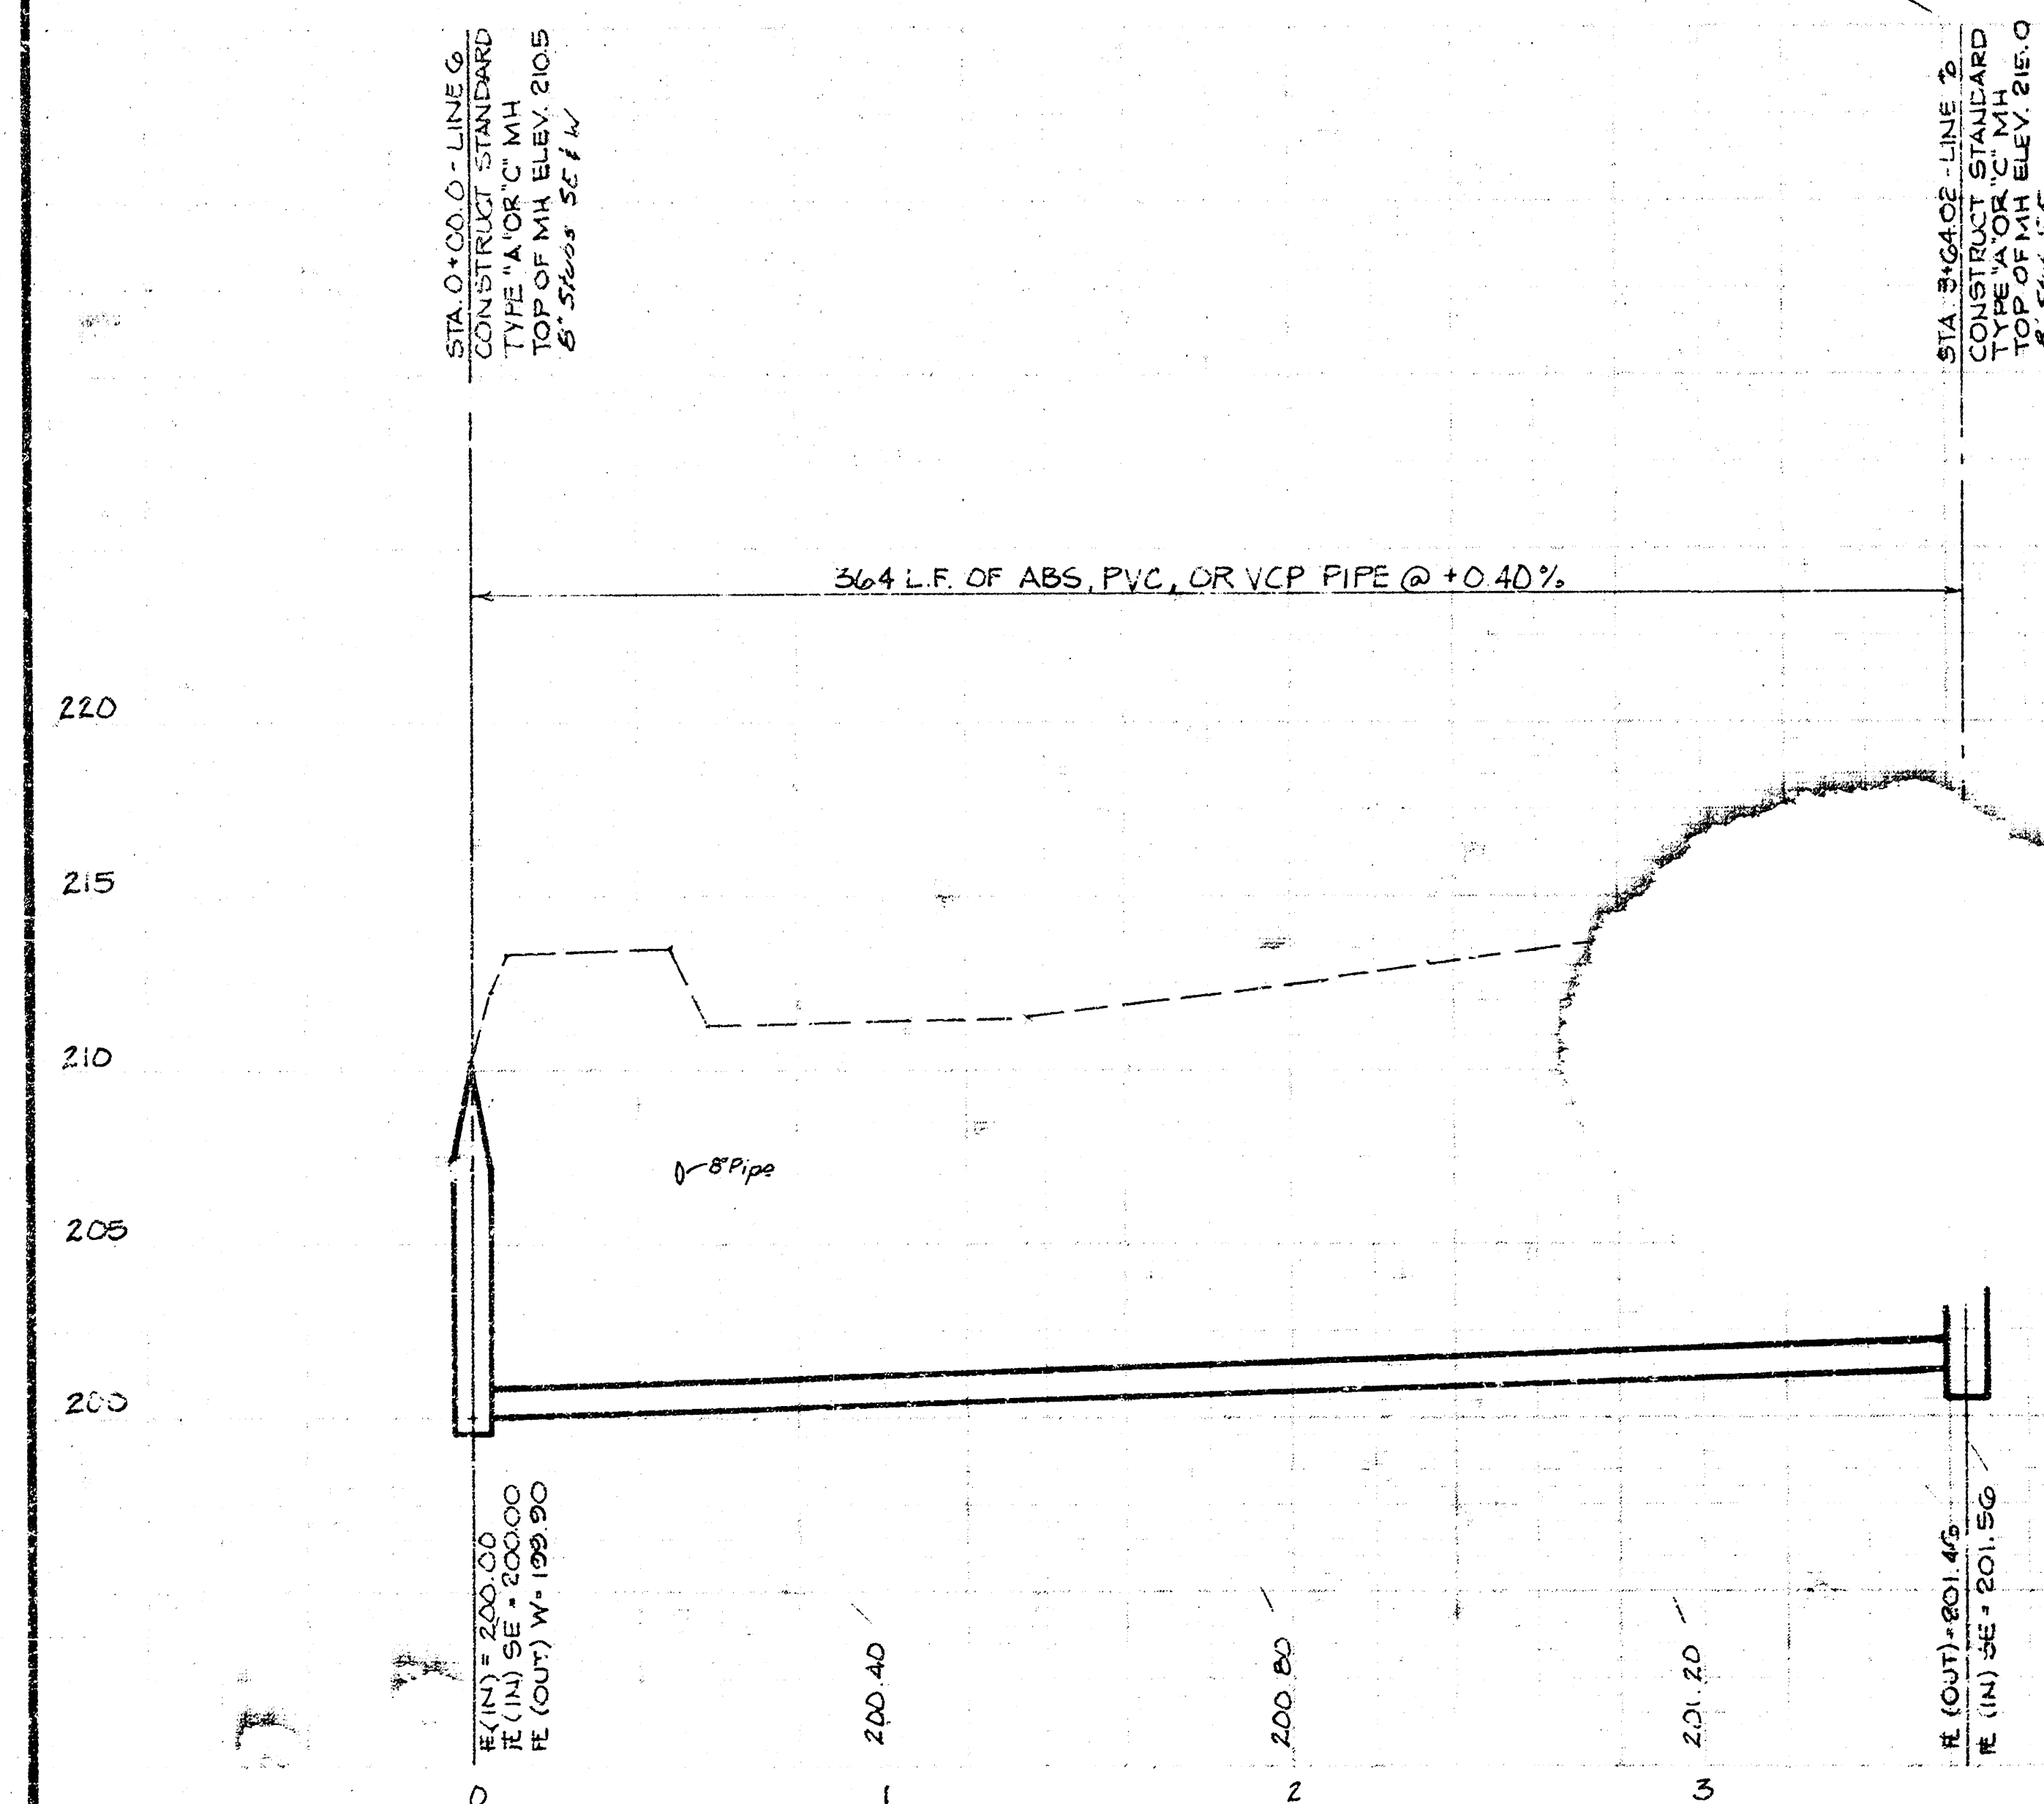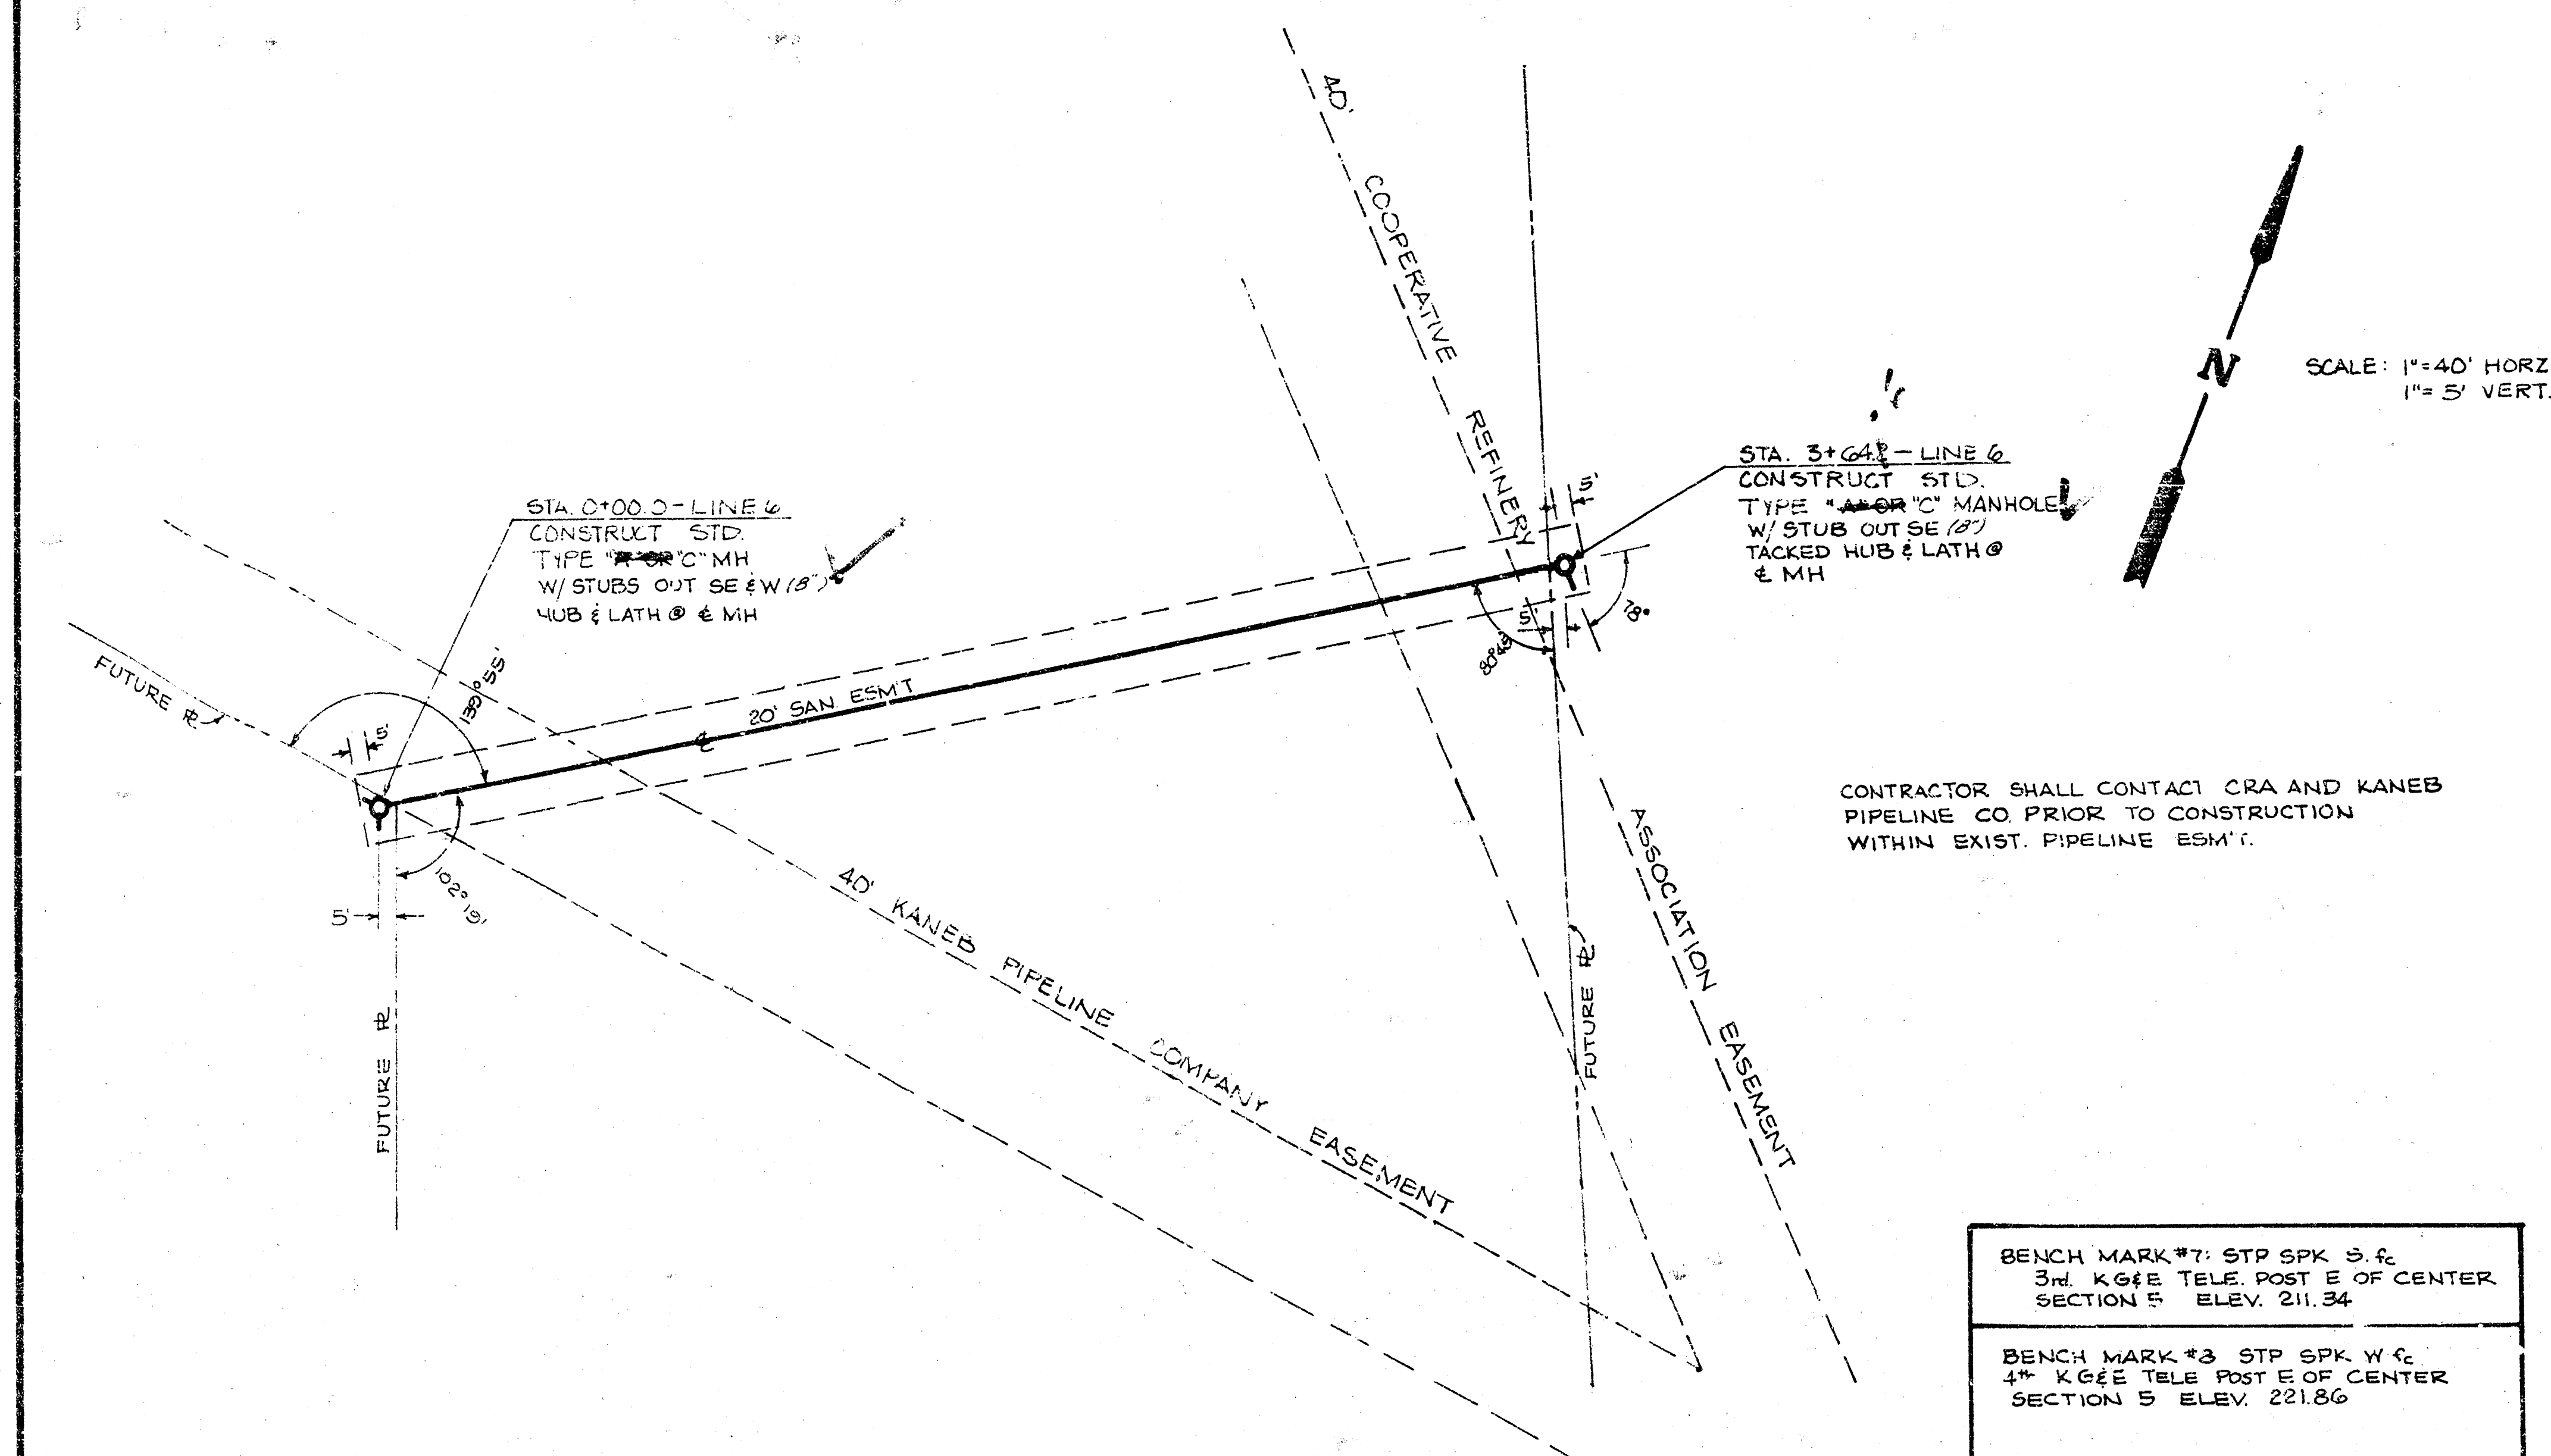

*1/3 Built
6/81*

4/6