

# LATERAL 1, MAIN 22 W.I.S.

PROJECT NO.

468-76-245-80594-000-000-001


CITY OF WICHITA, KANSAS

R.W. LINN CITY ENGINEER

SEPTEMBER, 1978

SYCAMORE VILLAGE THIRD ADDITION

INDEX TO DRAWINGS	
SHEET NO.	DESCRIPTION
1	TITLE & LOCATION MAP
2	LINE 1, 2
3	LINE 3, 4
4-5	SEWER APPURTENANCES

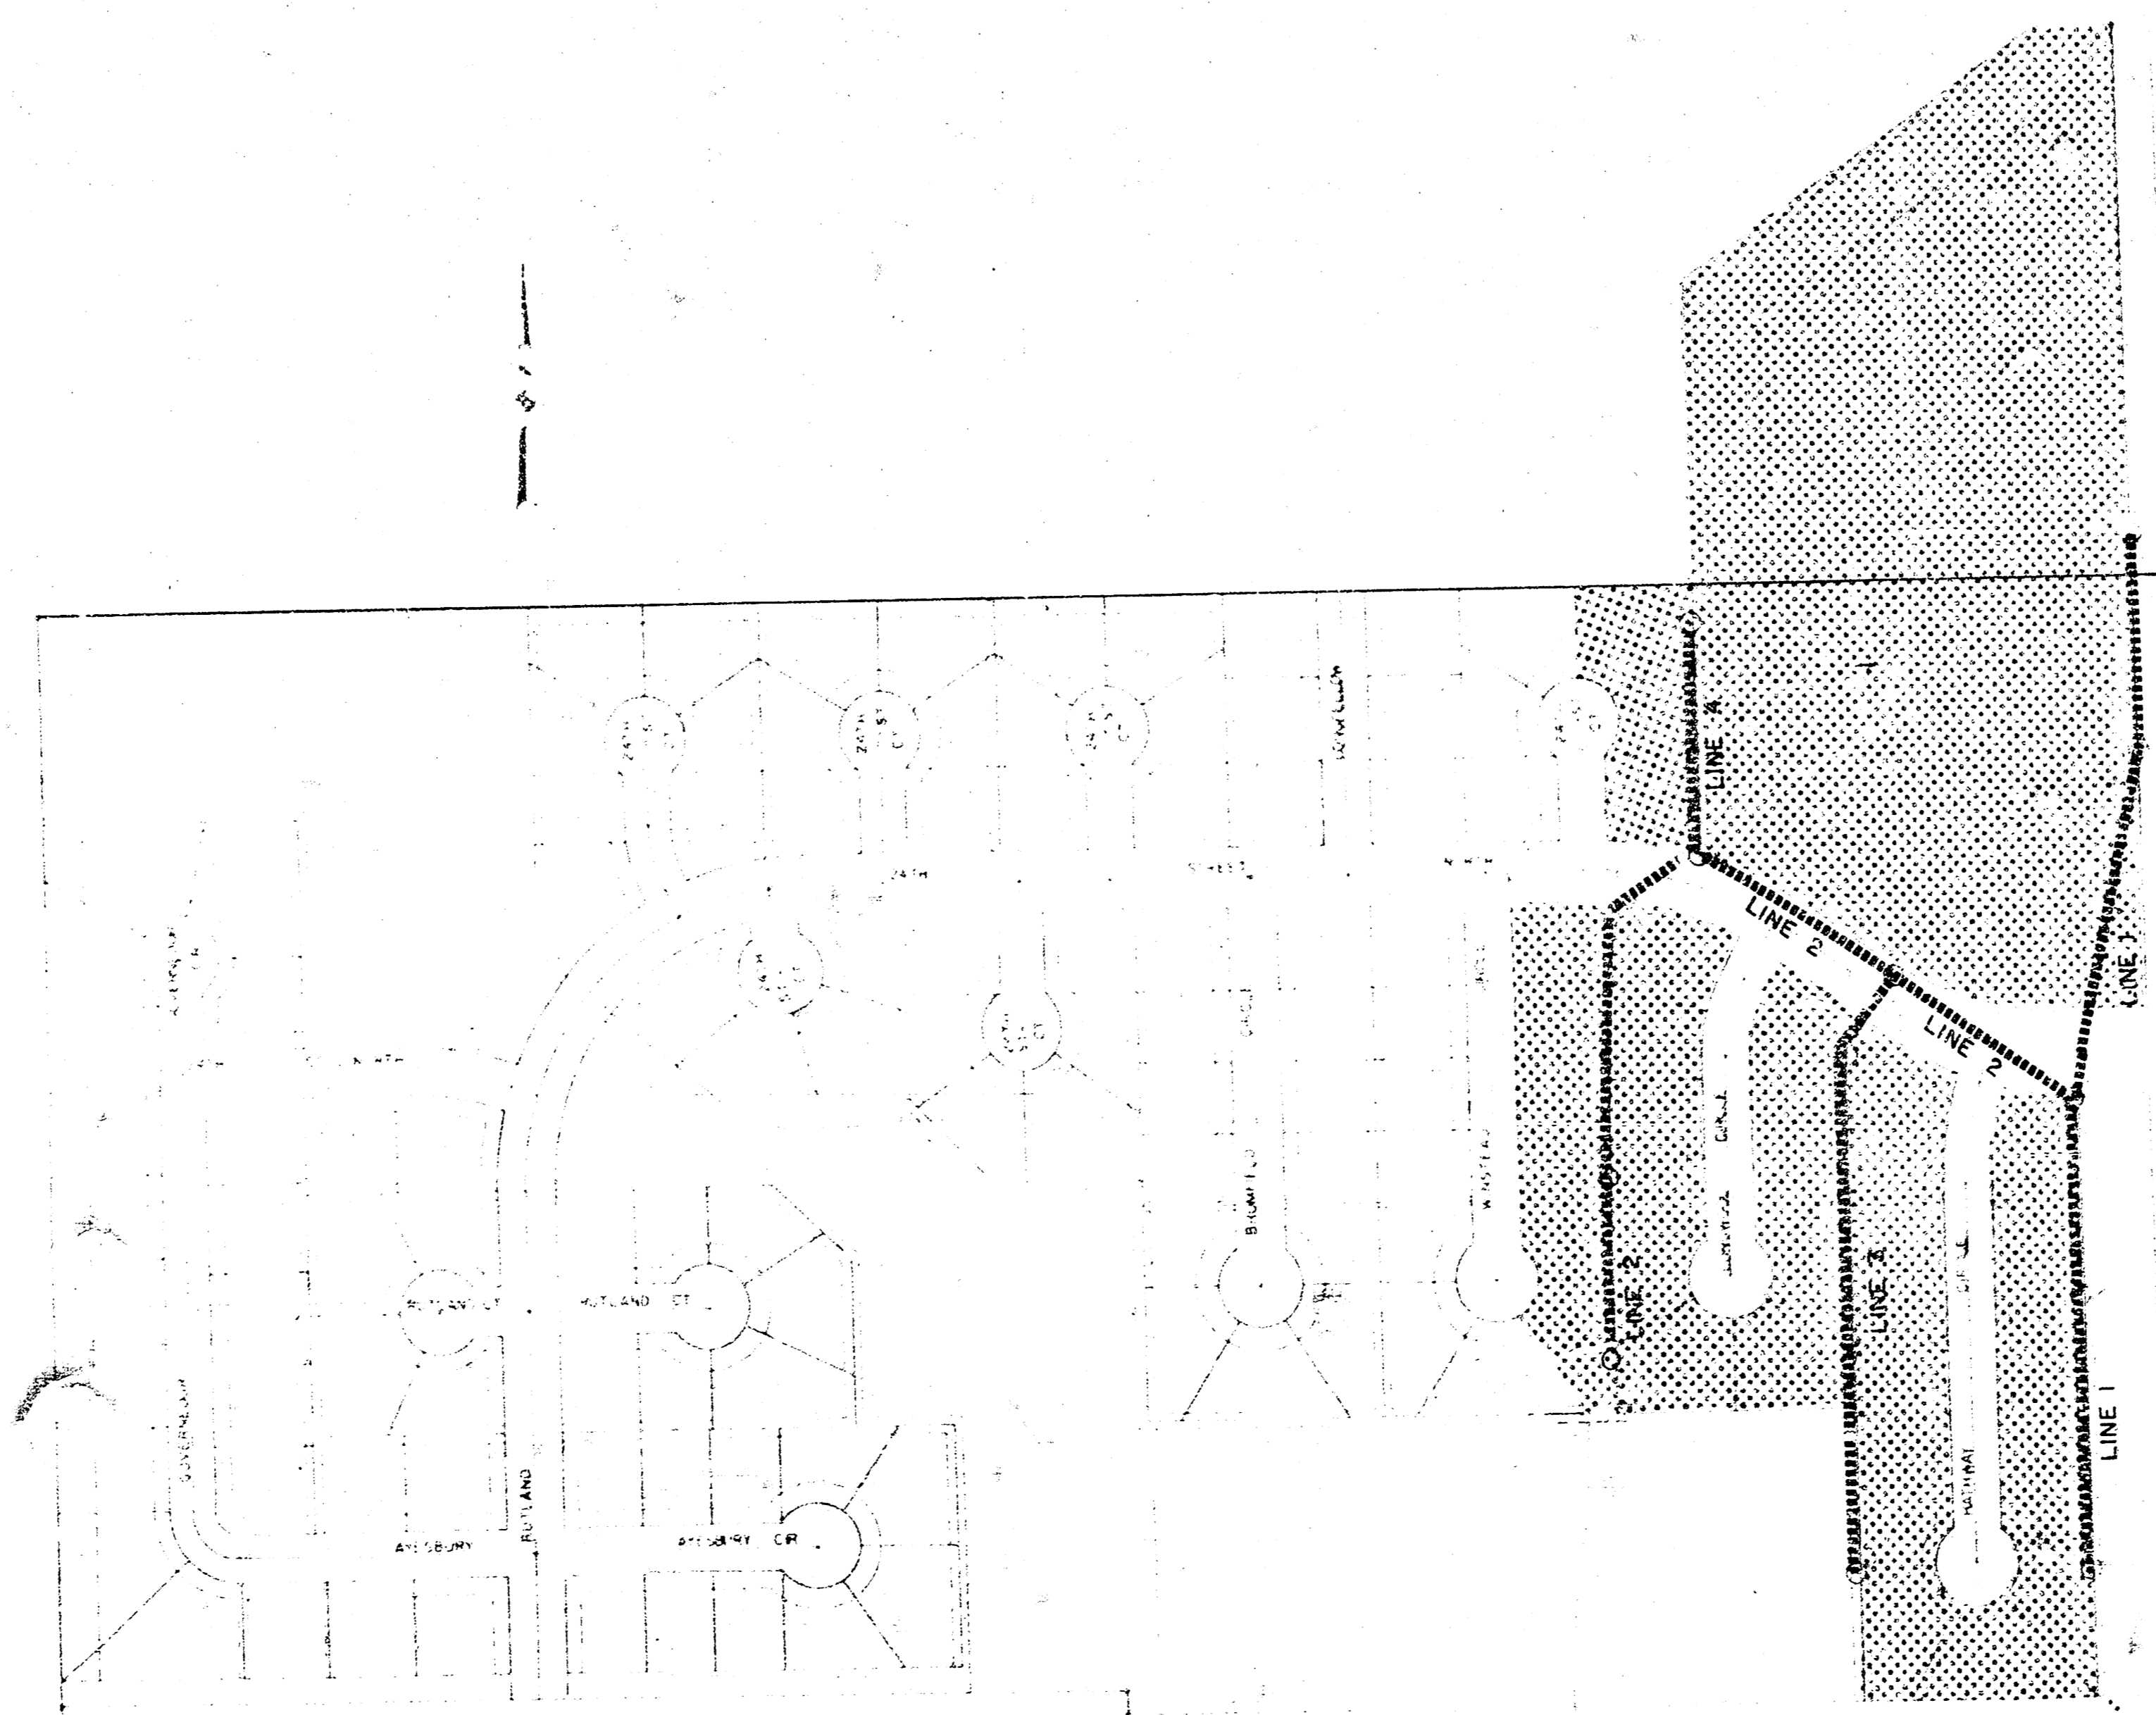

BENEFIT DISTRICT - LOTS 43 THROUGH 80, BLOCK 5; LOTS 7 THROUGH 11, BLOCK 4, ALL IN SYCAMORE VILLAGE THIRD ADDITION.



As Bldg - 9/20/78  
R.E.C.P.

Revised 10/27/78 Line 2

VAN DOREN-HAYWARD & ASSOCIATES ARCHITECTS-ENGINEERS-PLANNERS 4301 W. 11th St. WICHITA, KANSAS 67212	SHEET 1 1/3
--	-------------------

BM #1 - Spk Step in PP Bl #7  
Sta 0+50 - Rock Rd  
Elev 215.37

BM #2 - Spk Step in PP Bl #8  
Sta 9+60 - Rock Rd  
Elev 217.99

