


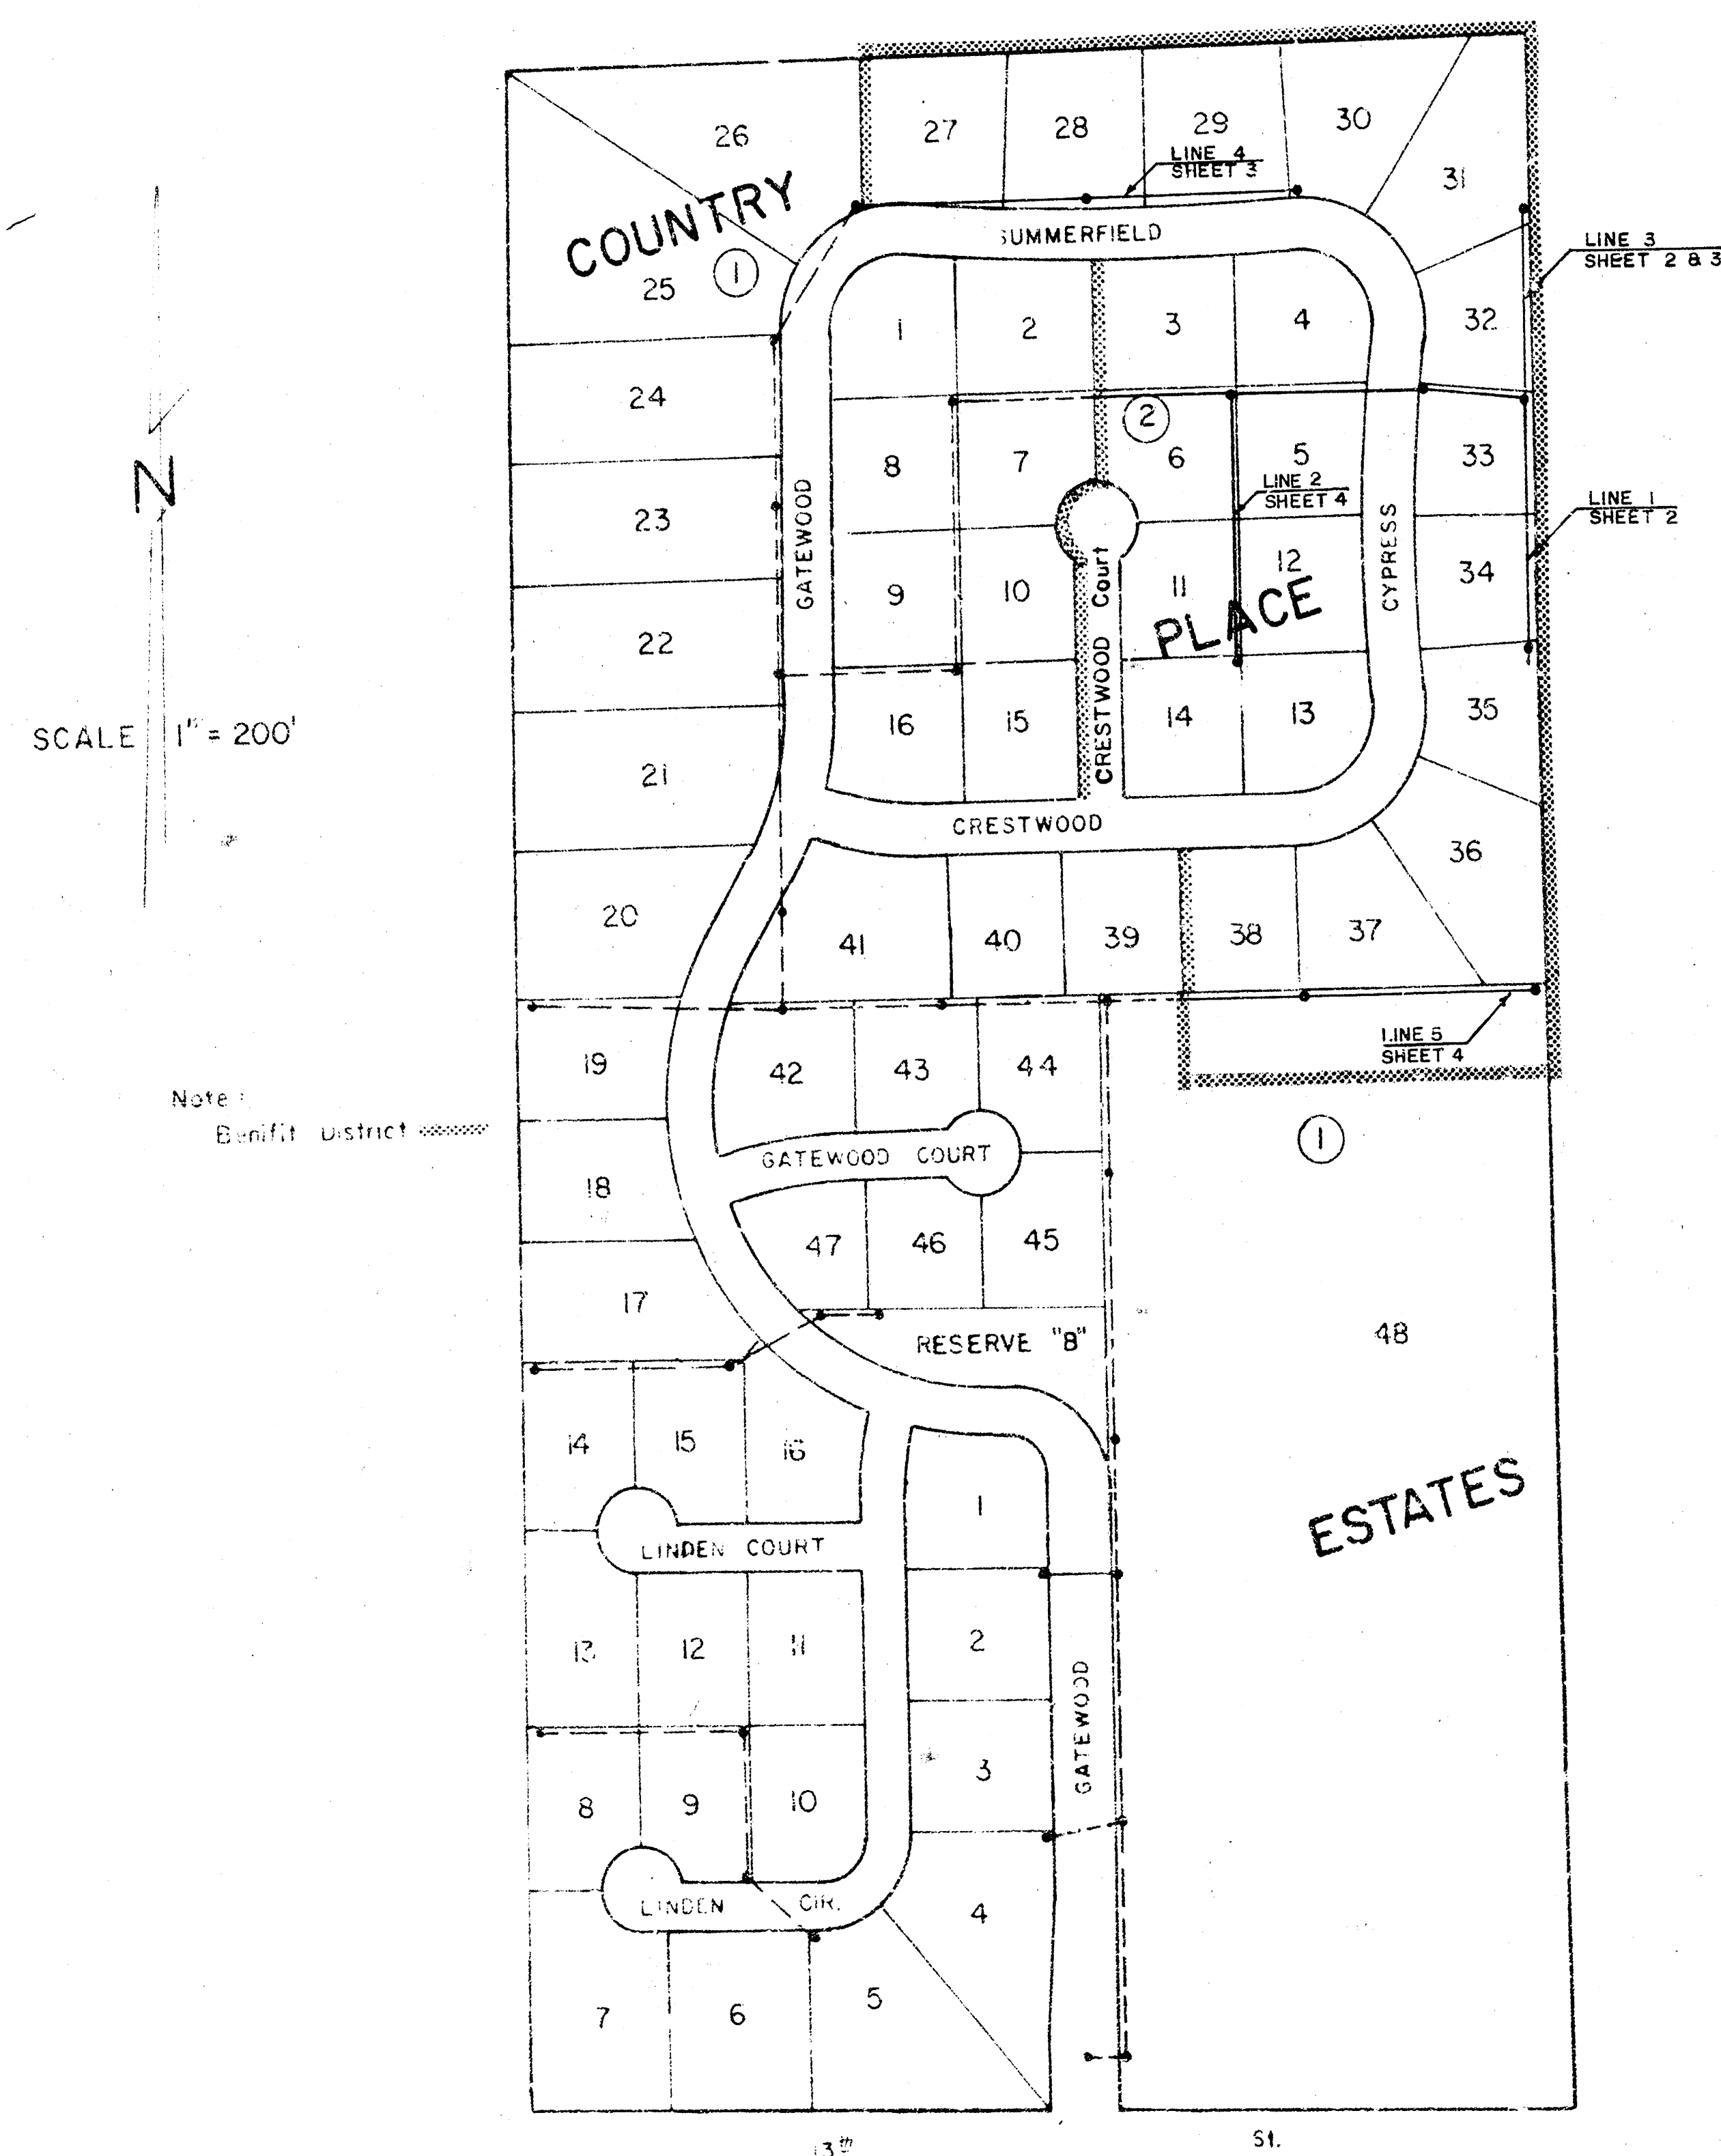

Lateral 4, Main 22 WAR INDUSTRIES SEWER

City of Wichita, Kansas

DEAN SELLERS

City Engineer


Date: _____

Project No. _____


468-76-245-80717-000-000-001

NOTE: FIELD ENGINEER SHALL SET TOPS OF MANHOLES TO MATCH PROPOSED FINISHED GRADE AS DETERMINED BY THE DEVELOPER. RISERS AND ADDITIONAL STUBS SHALL BE INSTALLED ON THIS PROJECT TO SERVE INDIVIDUAL LOTS WHEN ORDERED BY THE FIELD ENGINEER. RISER CONSTRUCTION SHALL CONFORM TO THE REQUIREMENTS AS SHOWN ON STANDARD RISER DETAIL SHEET. LOCATIONS OF THE ENDS OF THE RISERS SHALL BE MARKED BY FASTENING GREEN PLASTIC COLORED TAPE TO THE END OF THE RISER AND BROUGHT TO THE GROUND SURFACE AS THE EXCAVATION IS BACKFILLED SUCH THAT THE COLORED TAPE WILL BE VISIBLE WHEN THE PROJECT IS COMPLETED. ALL RISERS SHALL BE CONSTRUCTED USING S.D.R. 23.5 A.B.S. OR P.V.C. PIPE. ELEVATIONS OF STUBS AND TOPS OF RISERS SHALL BE SUCH THAT WILL FACILITATE CONNECTION OF BASEMENT DRAINS WHEN THESE LOTS ARE DEVELOPED.


Handwritten: 15 Billed
4/5/1

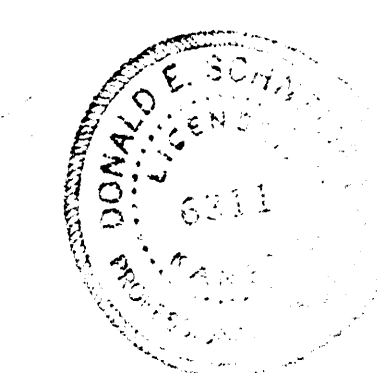

B.M. 184.14 R.R. Spk. N. Face P.P. E. Side GATWOOD
 30' S. of P.O. W.L. Lot 1, B1K. 2.
 B.M. 184.90 R.R. Spk. S. Face 14' Elm 30' N. of N.L.
 GATWOOD & W.L. LINDEN Extended

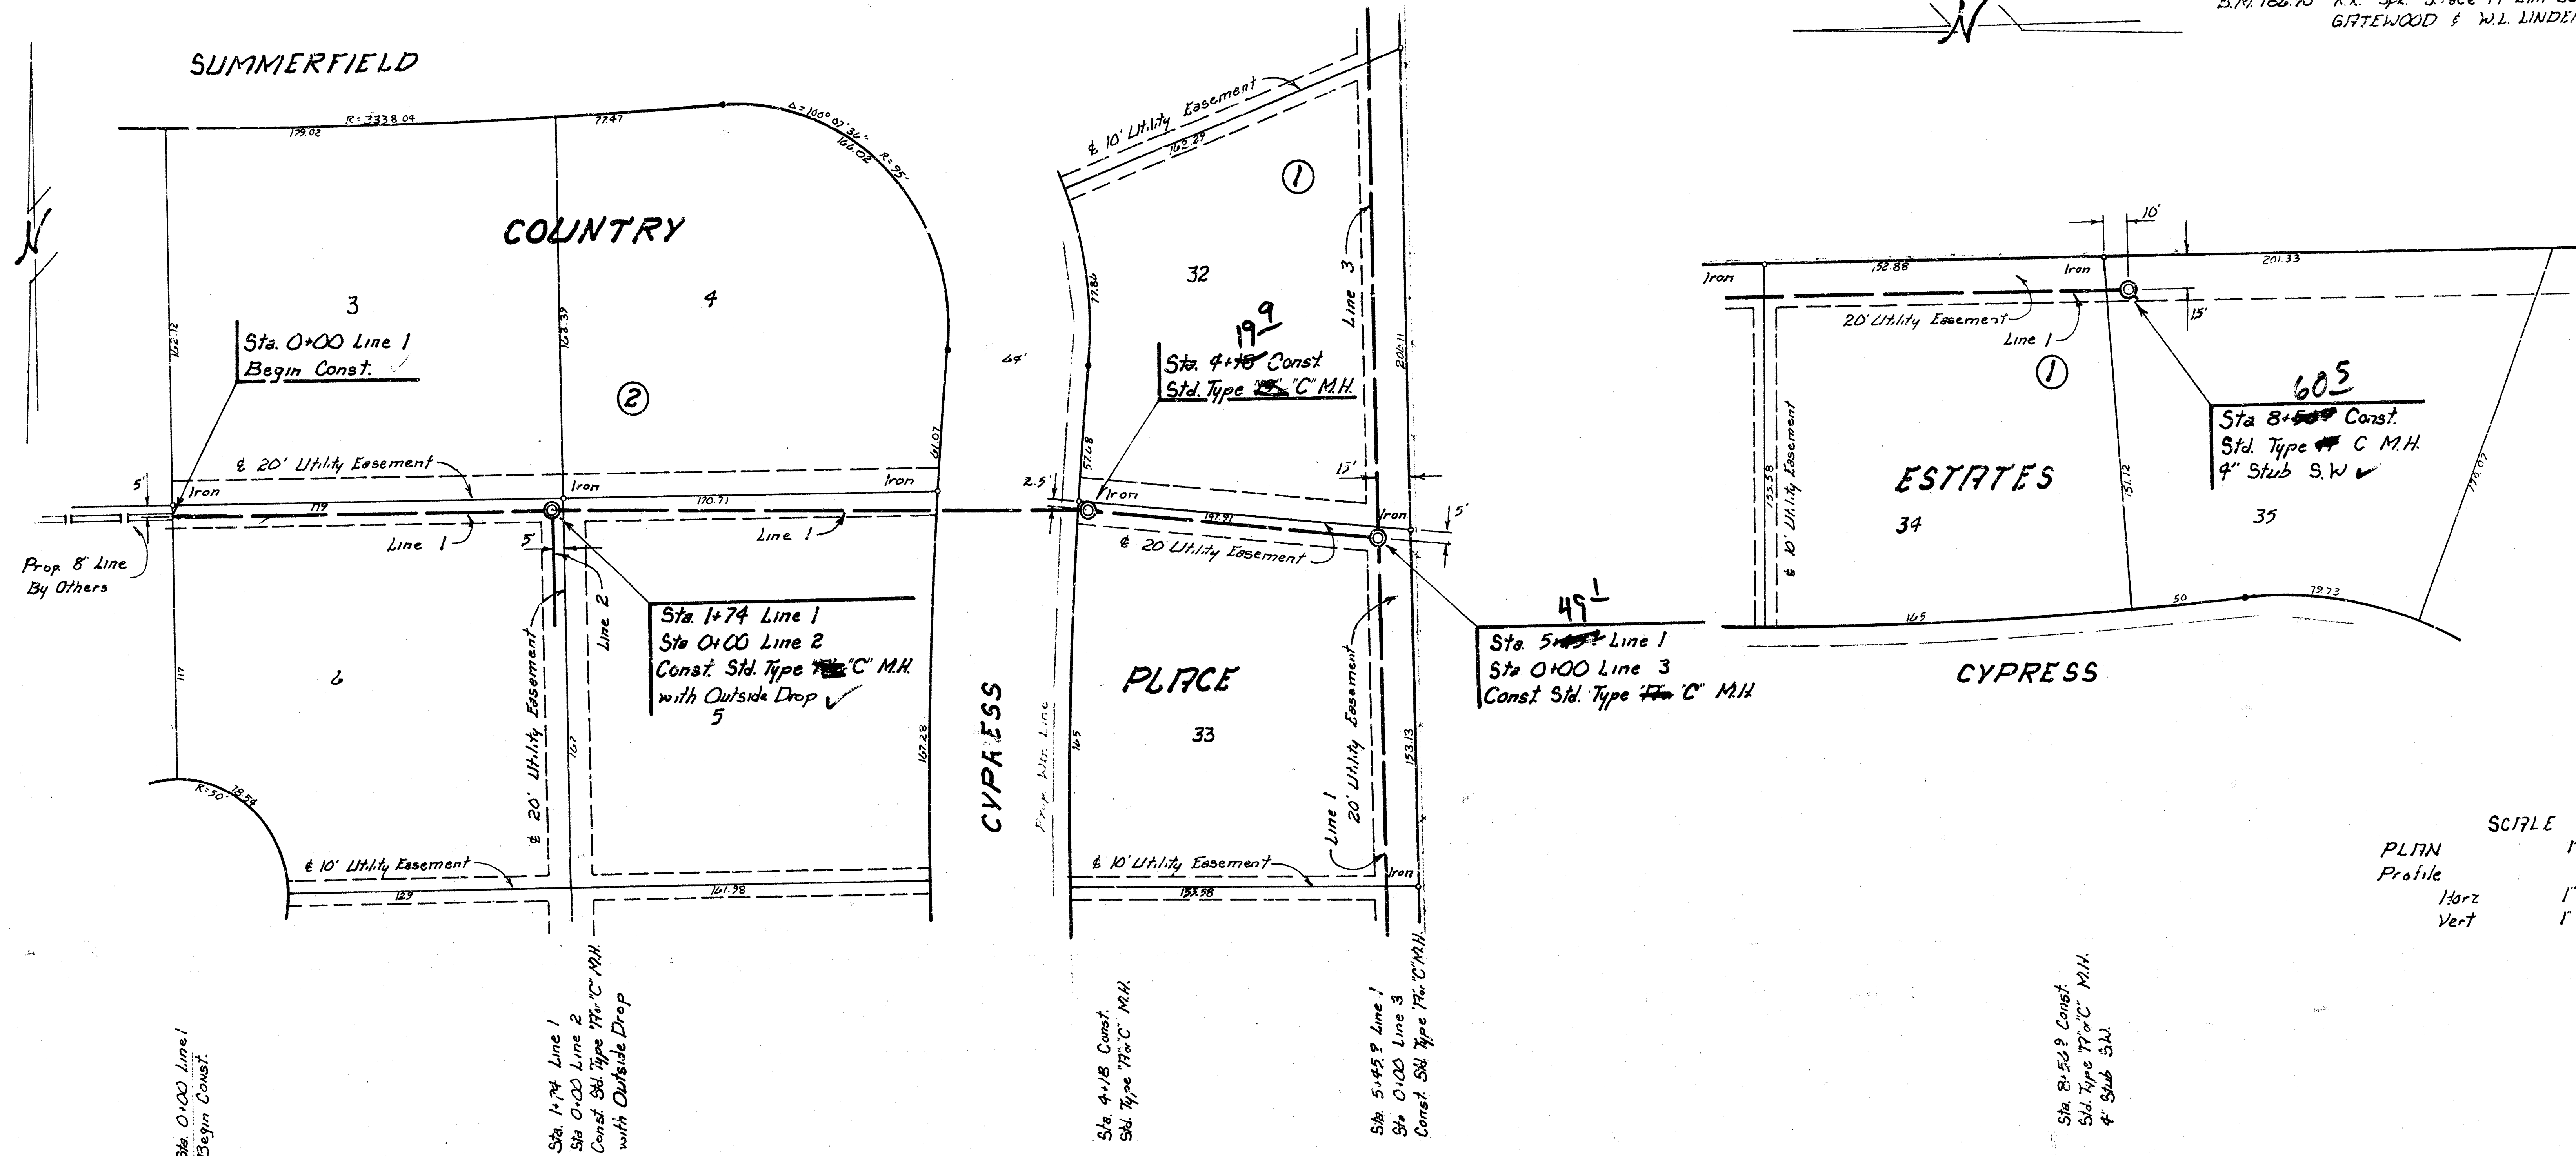


SCALE
 PLTN 1" = 40'
 Profile 1" = 40'
 Horiz 1" = 40'
 Vert 1" = 5'


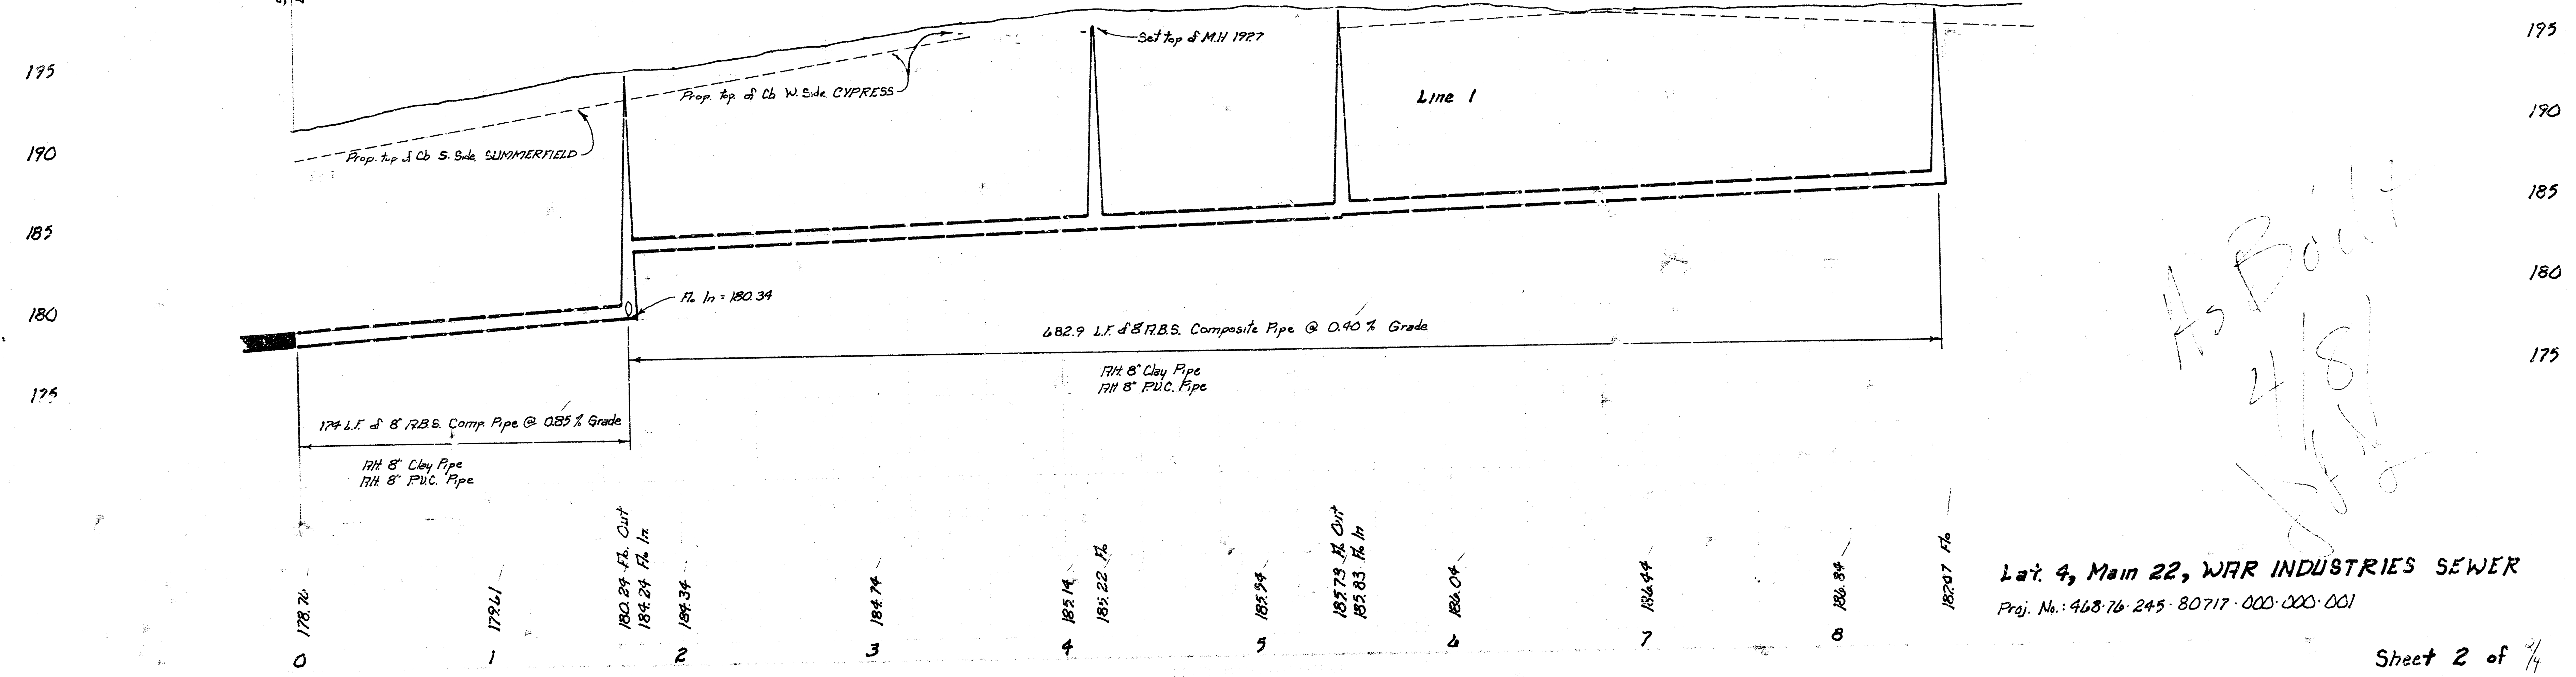


As Bldt
 4/8/88
 J. H. H.



Lat. 4, Main 22, WRR INDUSTRIES SEWER
 Proj. No. 468-76-245-80717-000-000-001

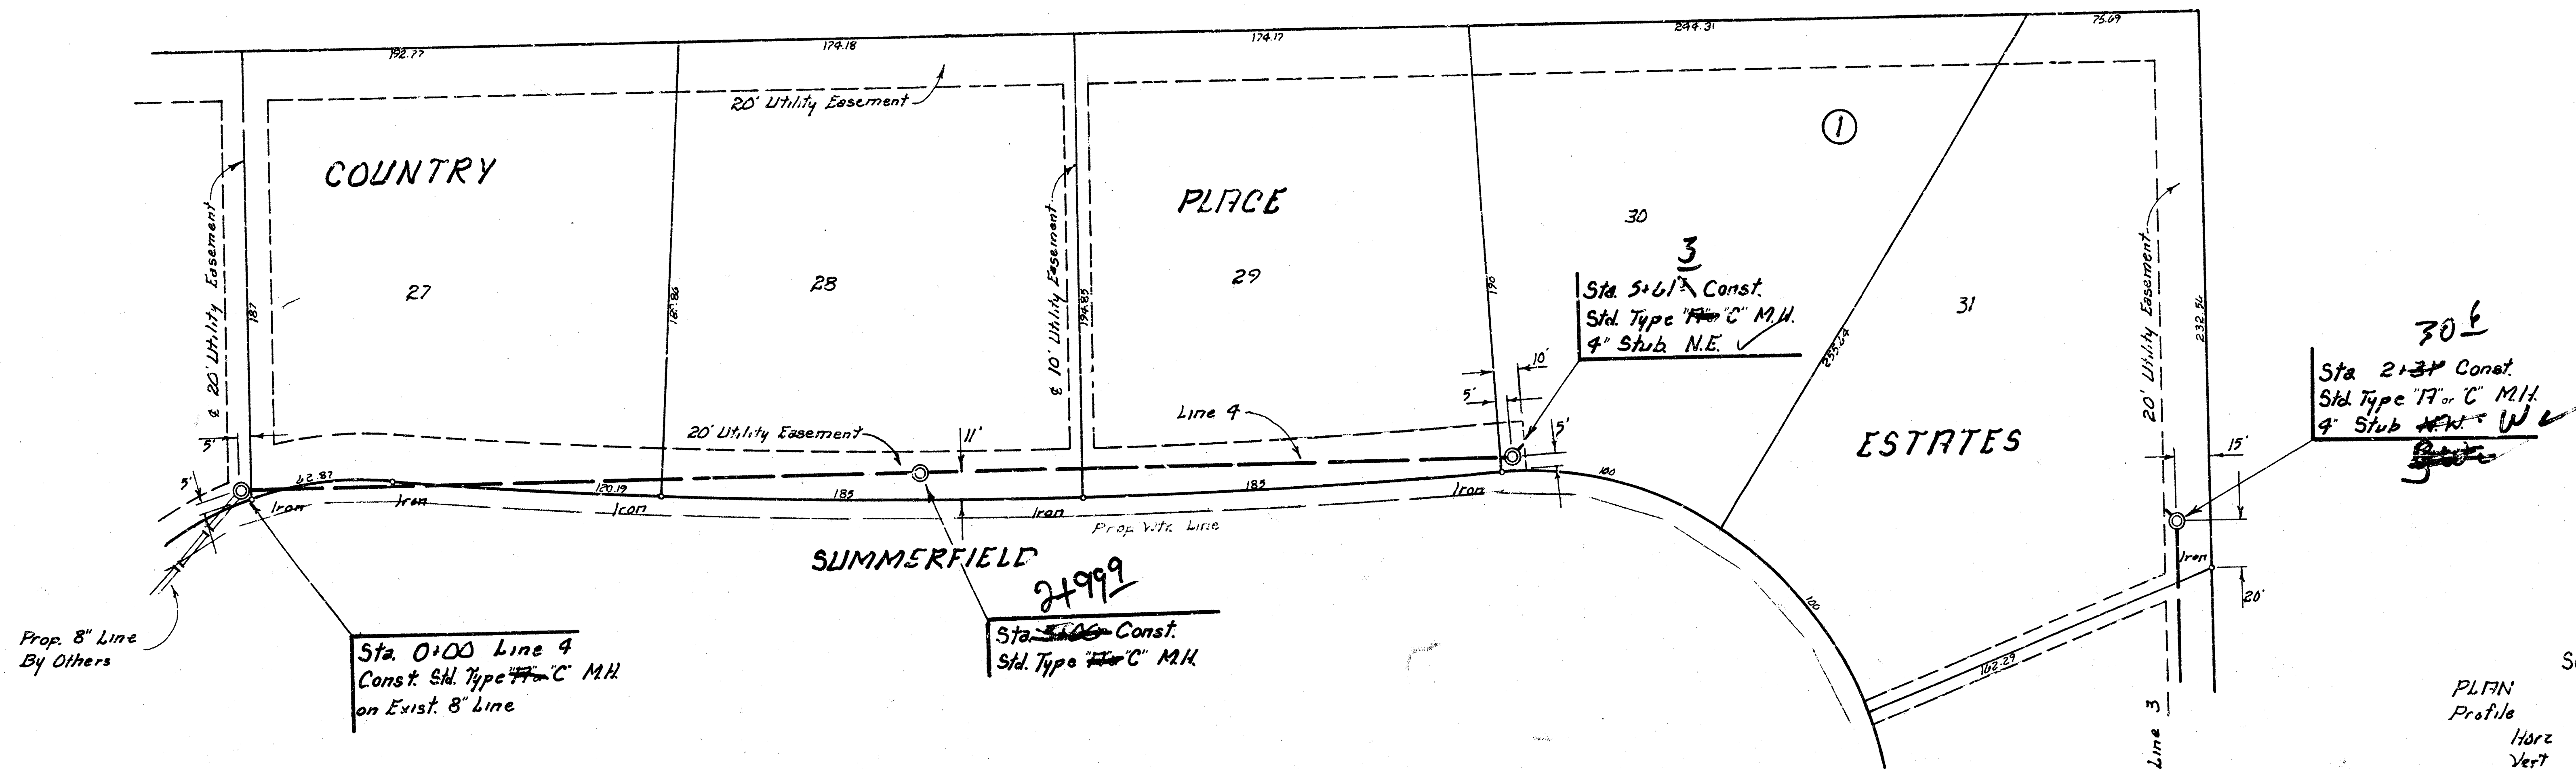

SCALE
 PLAN Profile 1" = 40'
 Horiz 1" = 40'
 Vert 1" = 5'

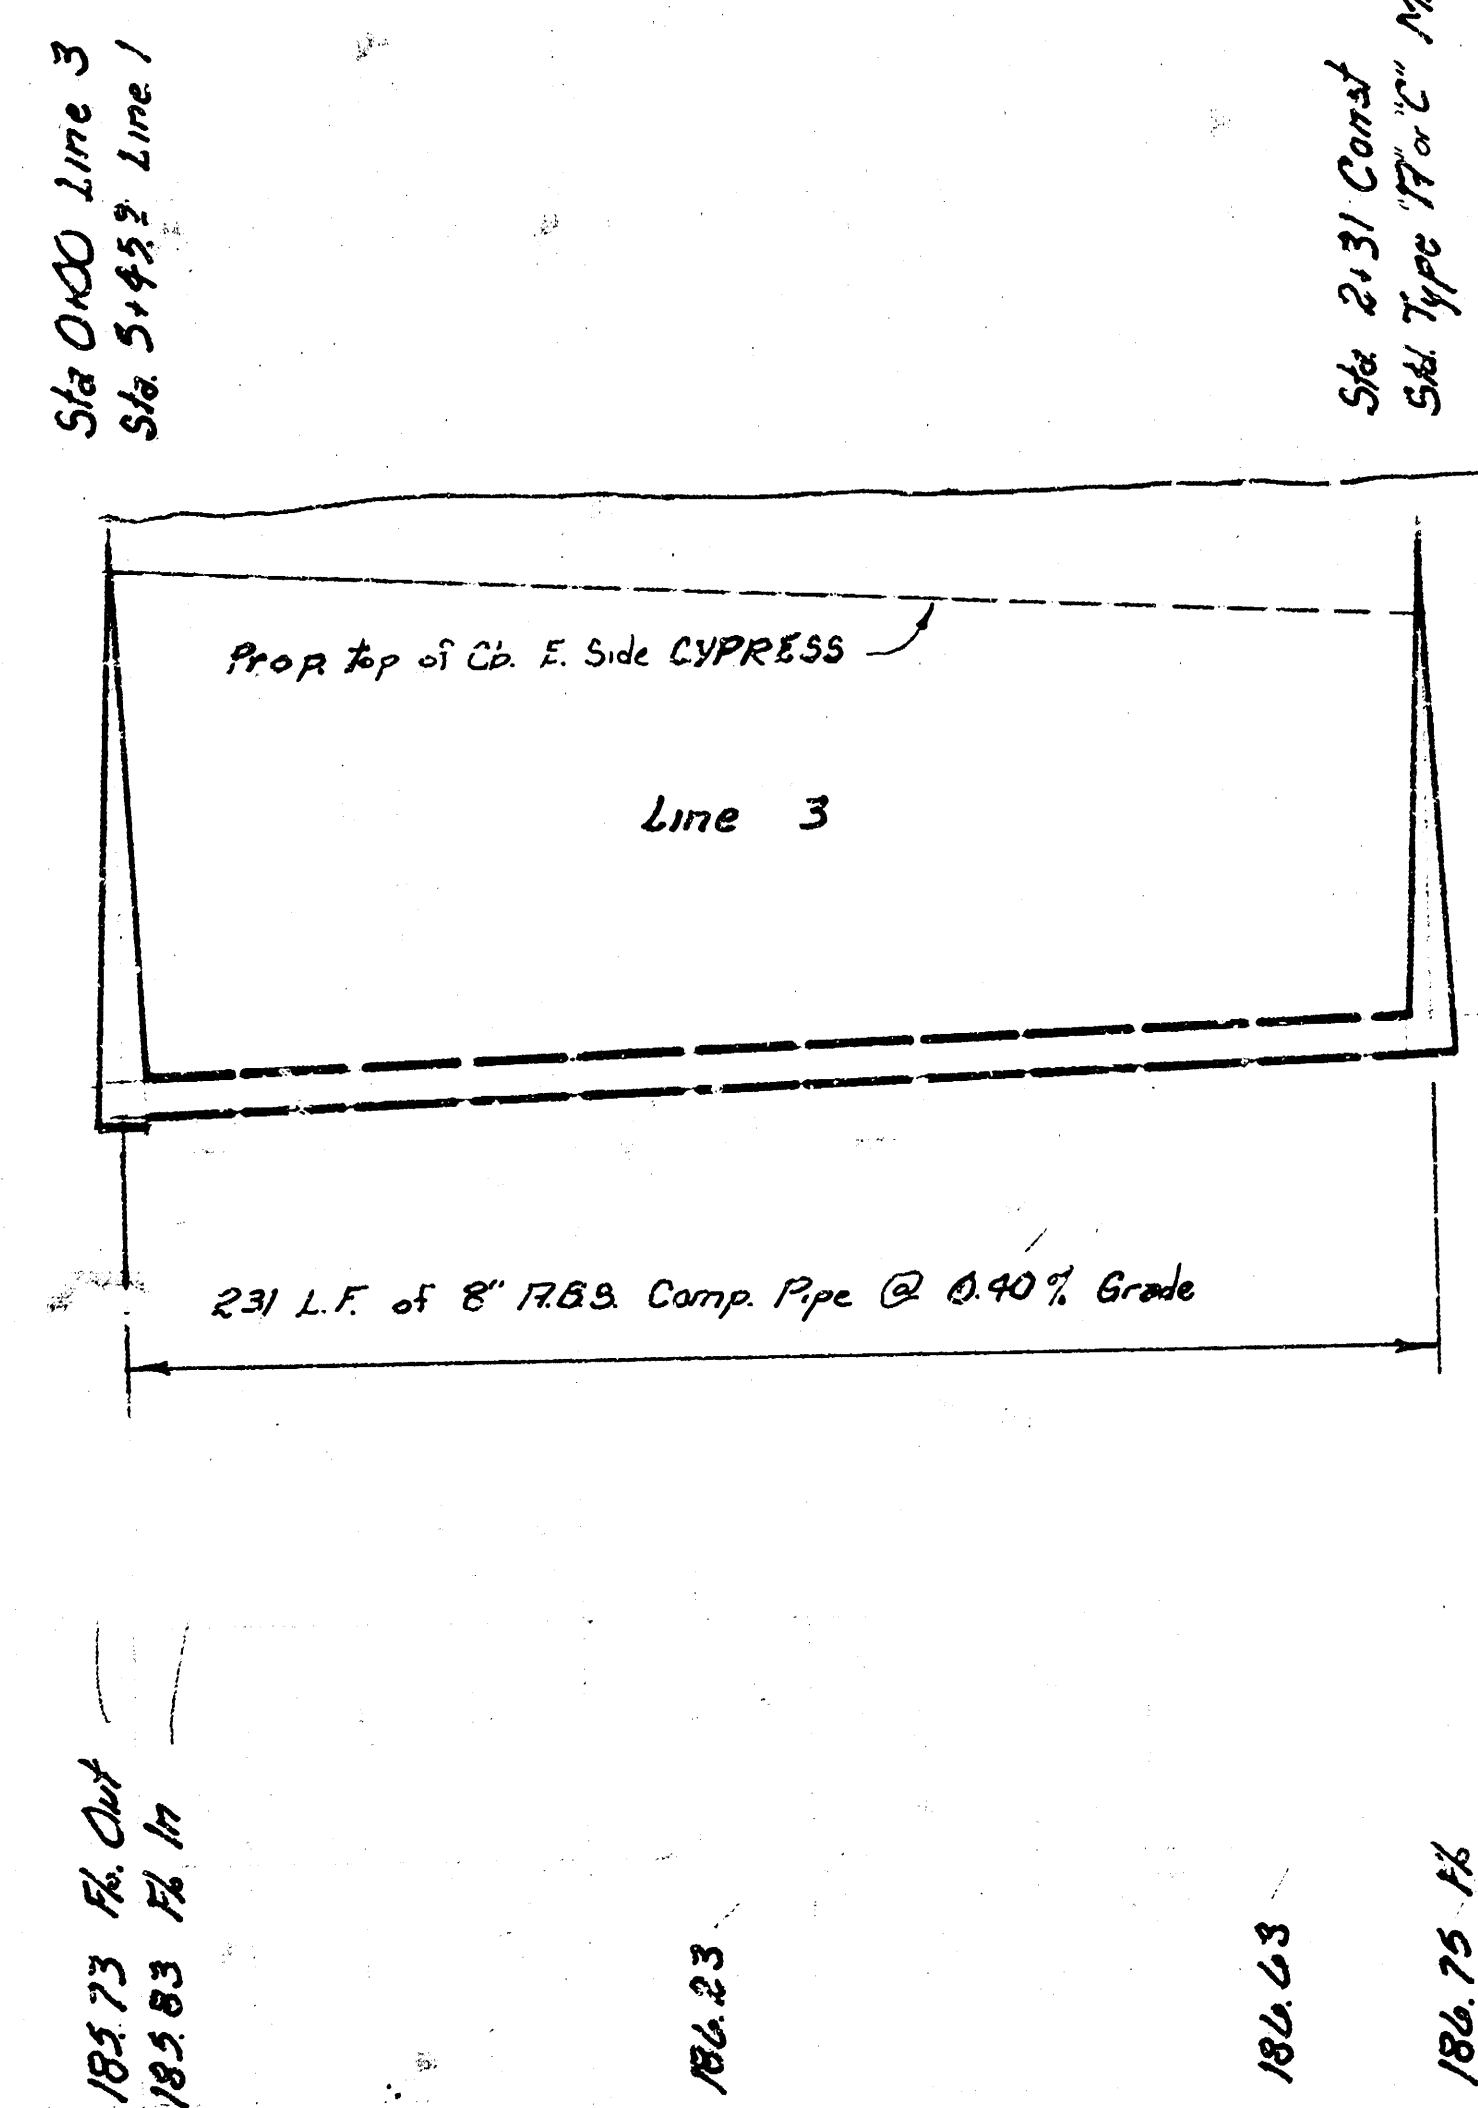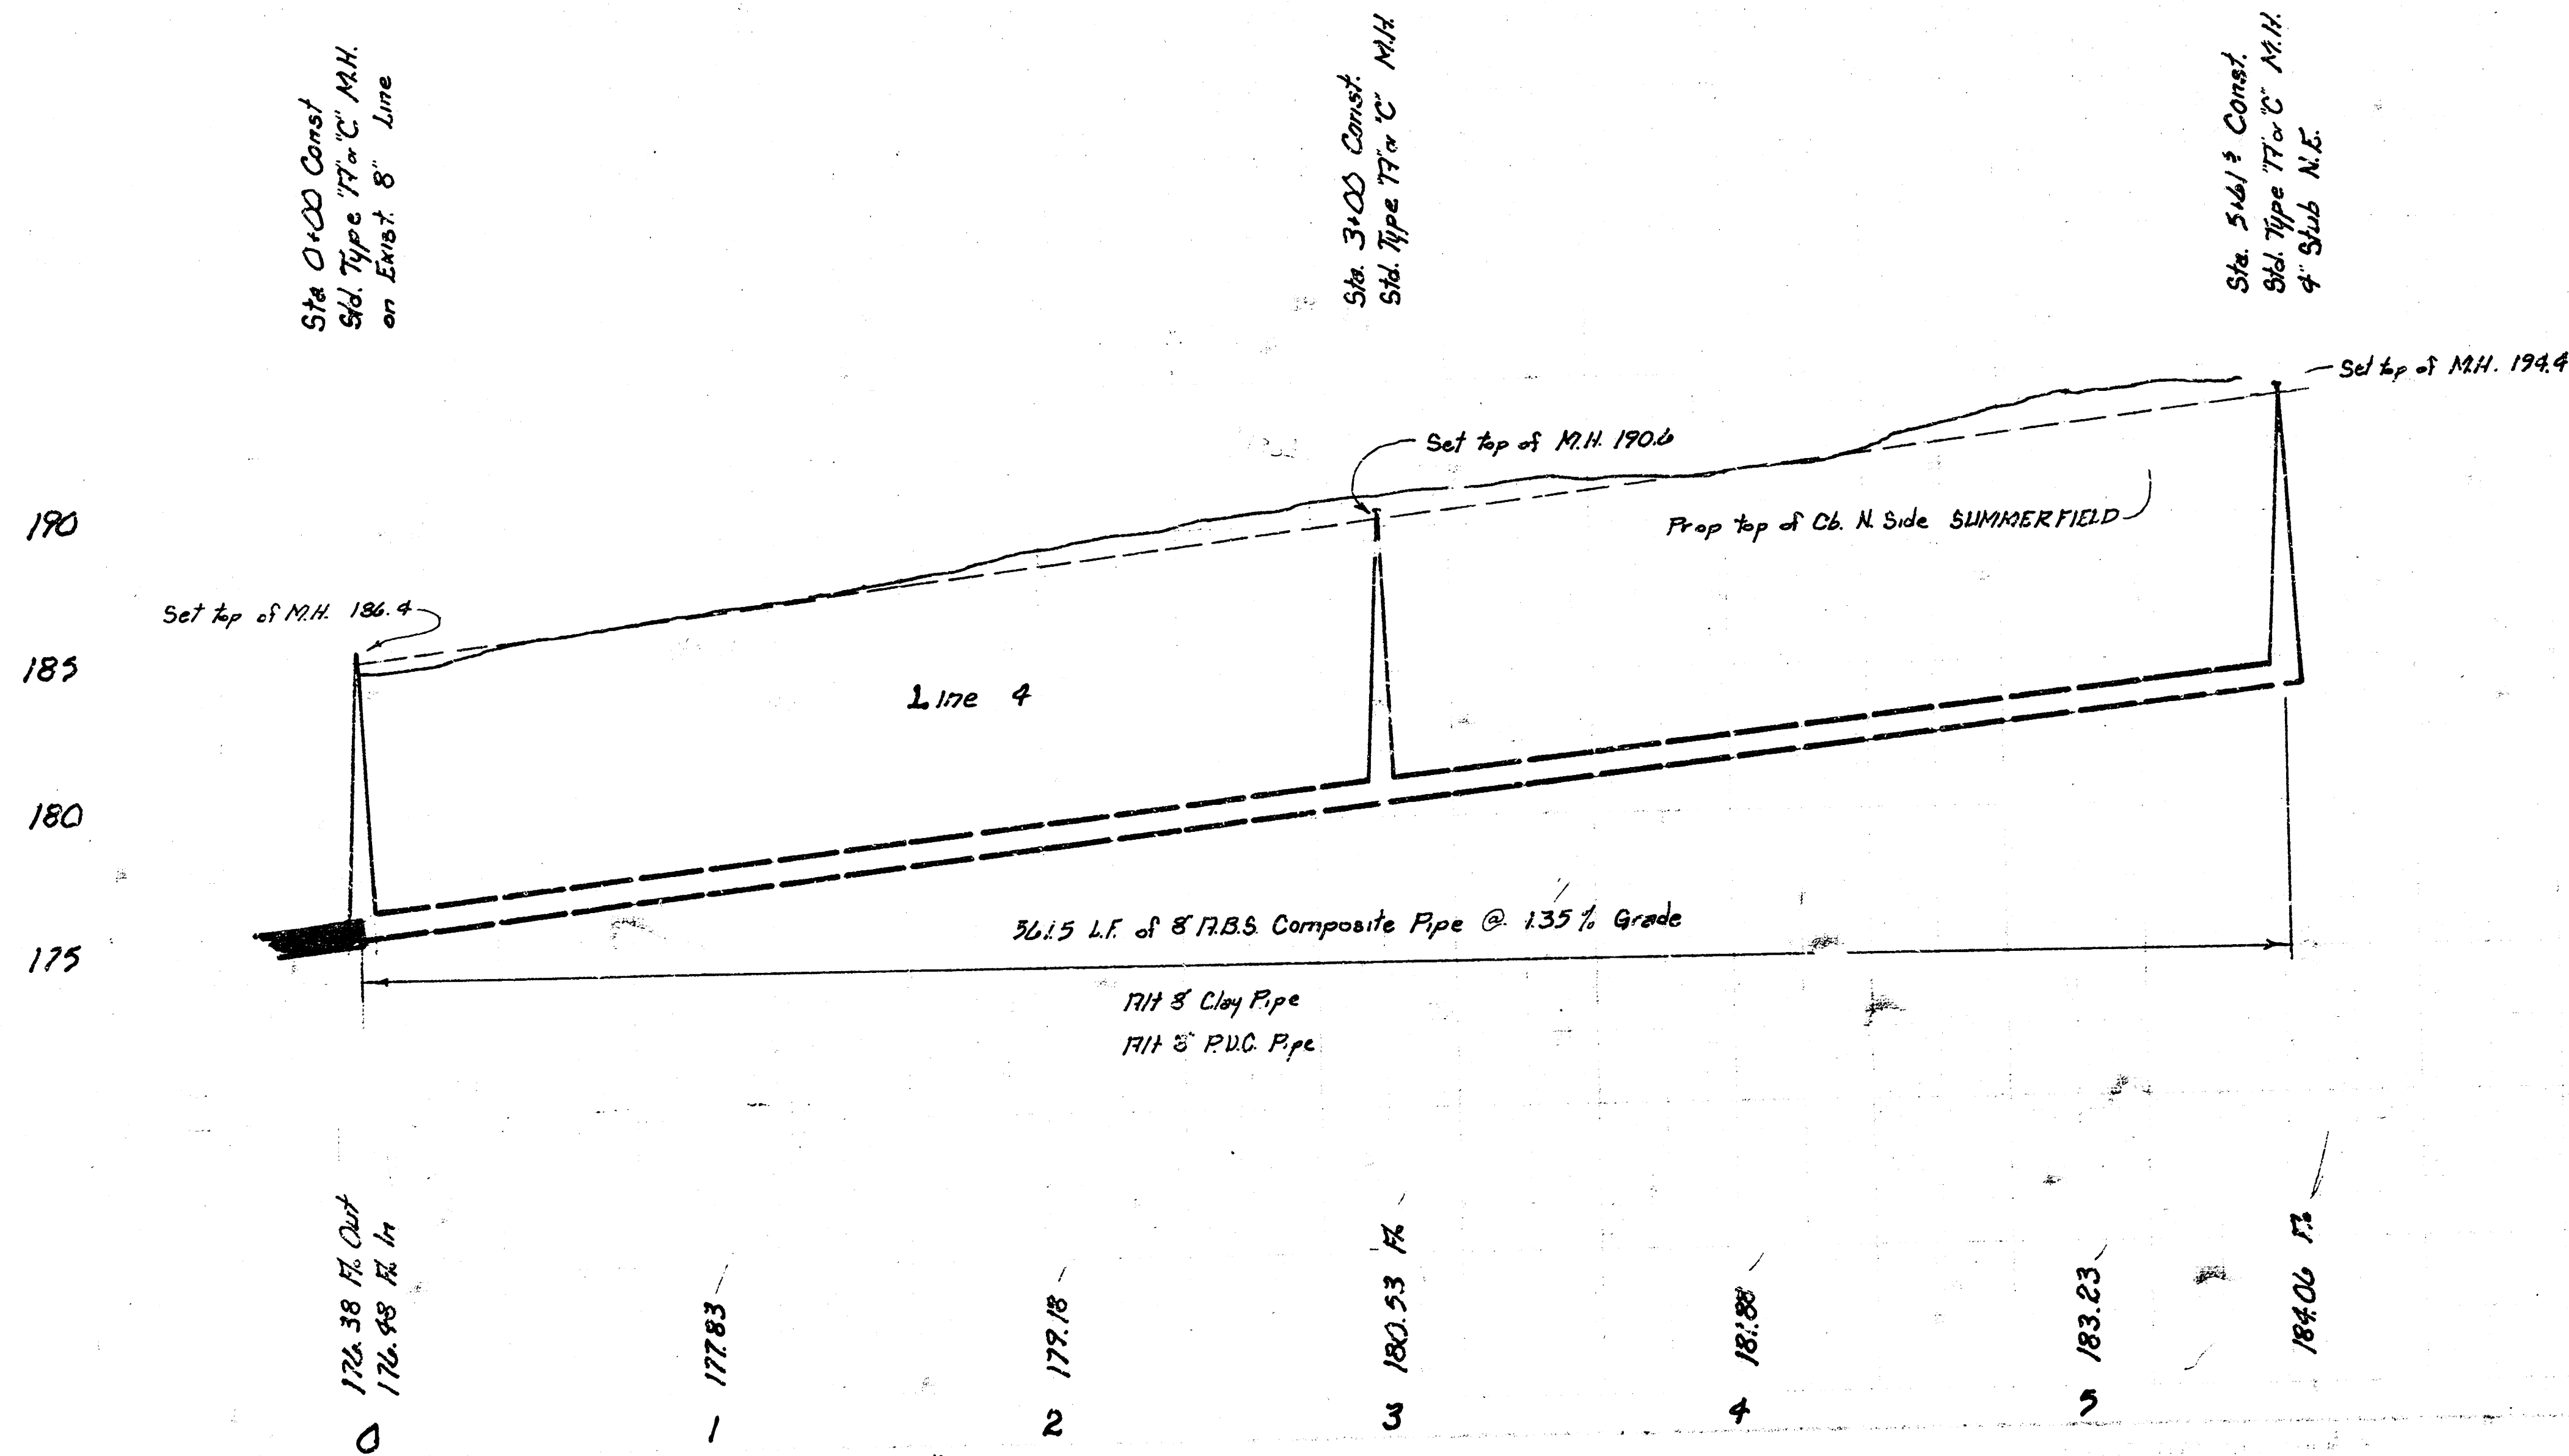

Lot 4, Main 22, WTR INDUSTRIES SEWER
 Proj. No. 438-76-245-80717-000-000-001
 2

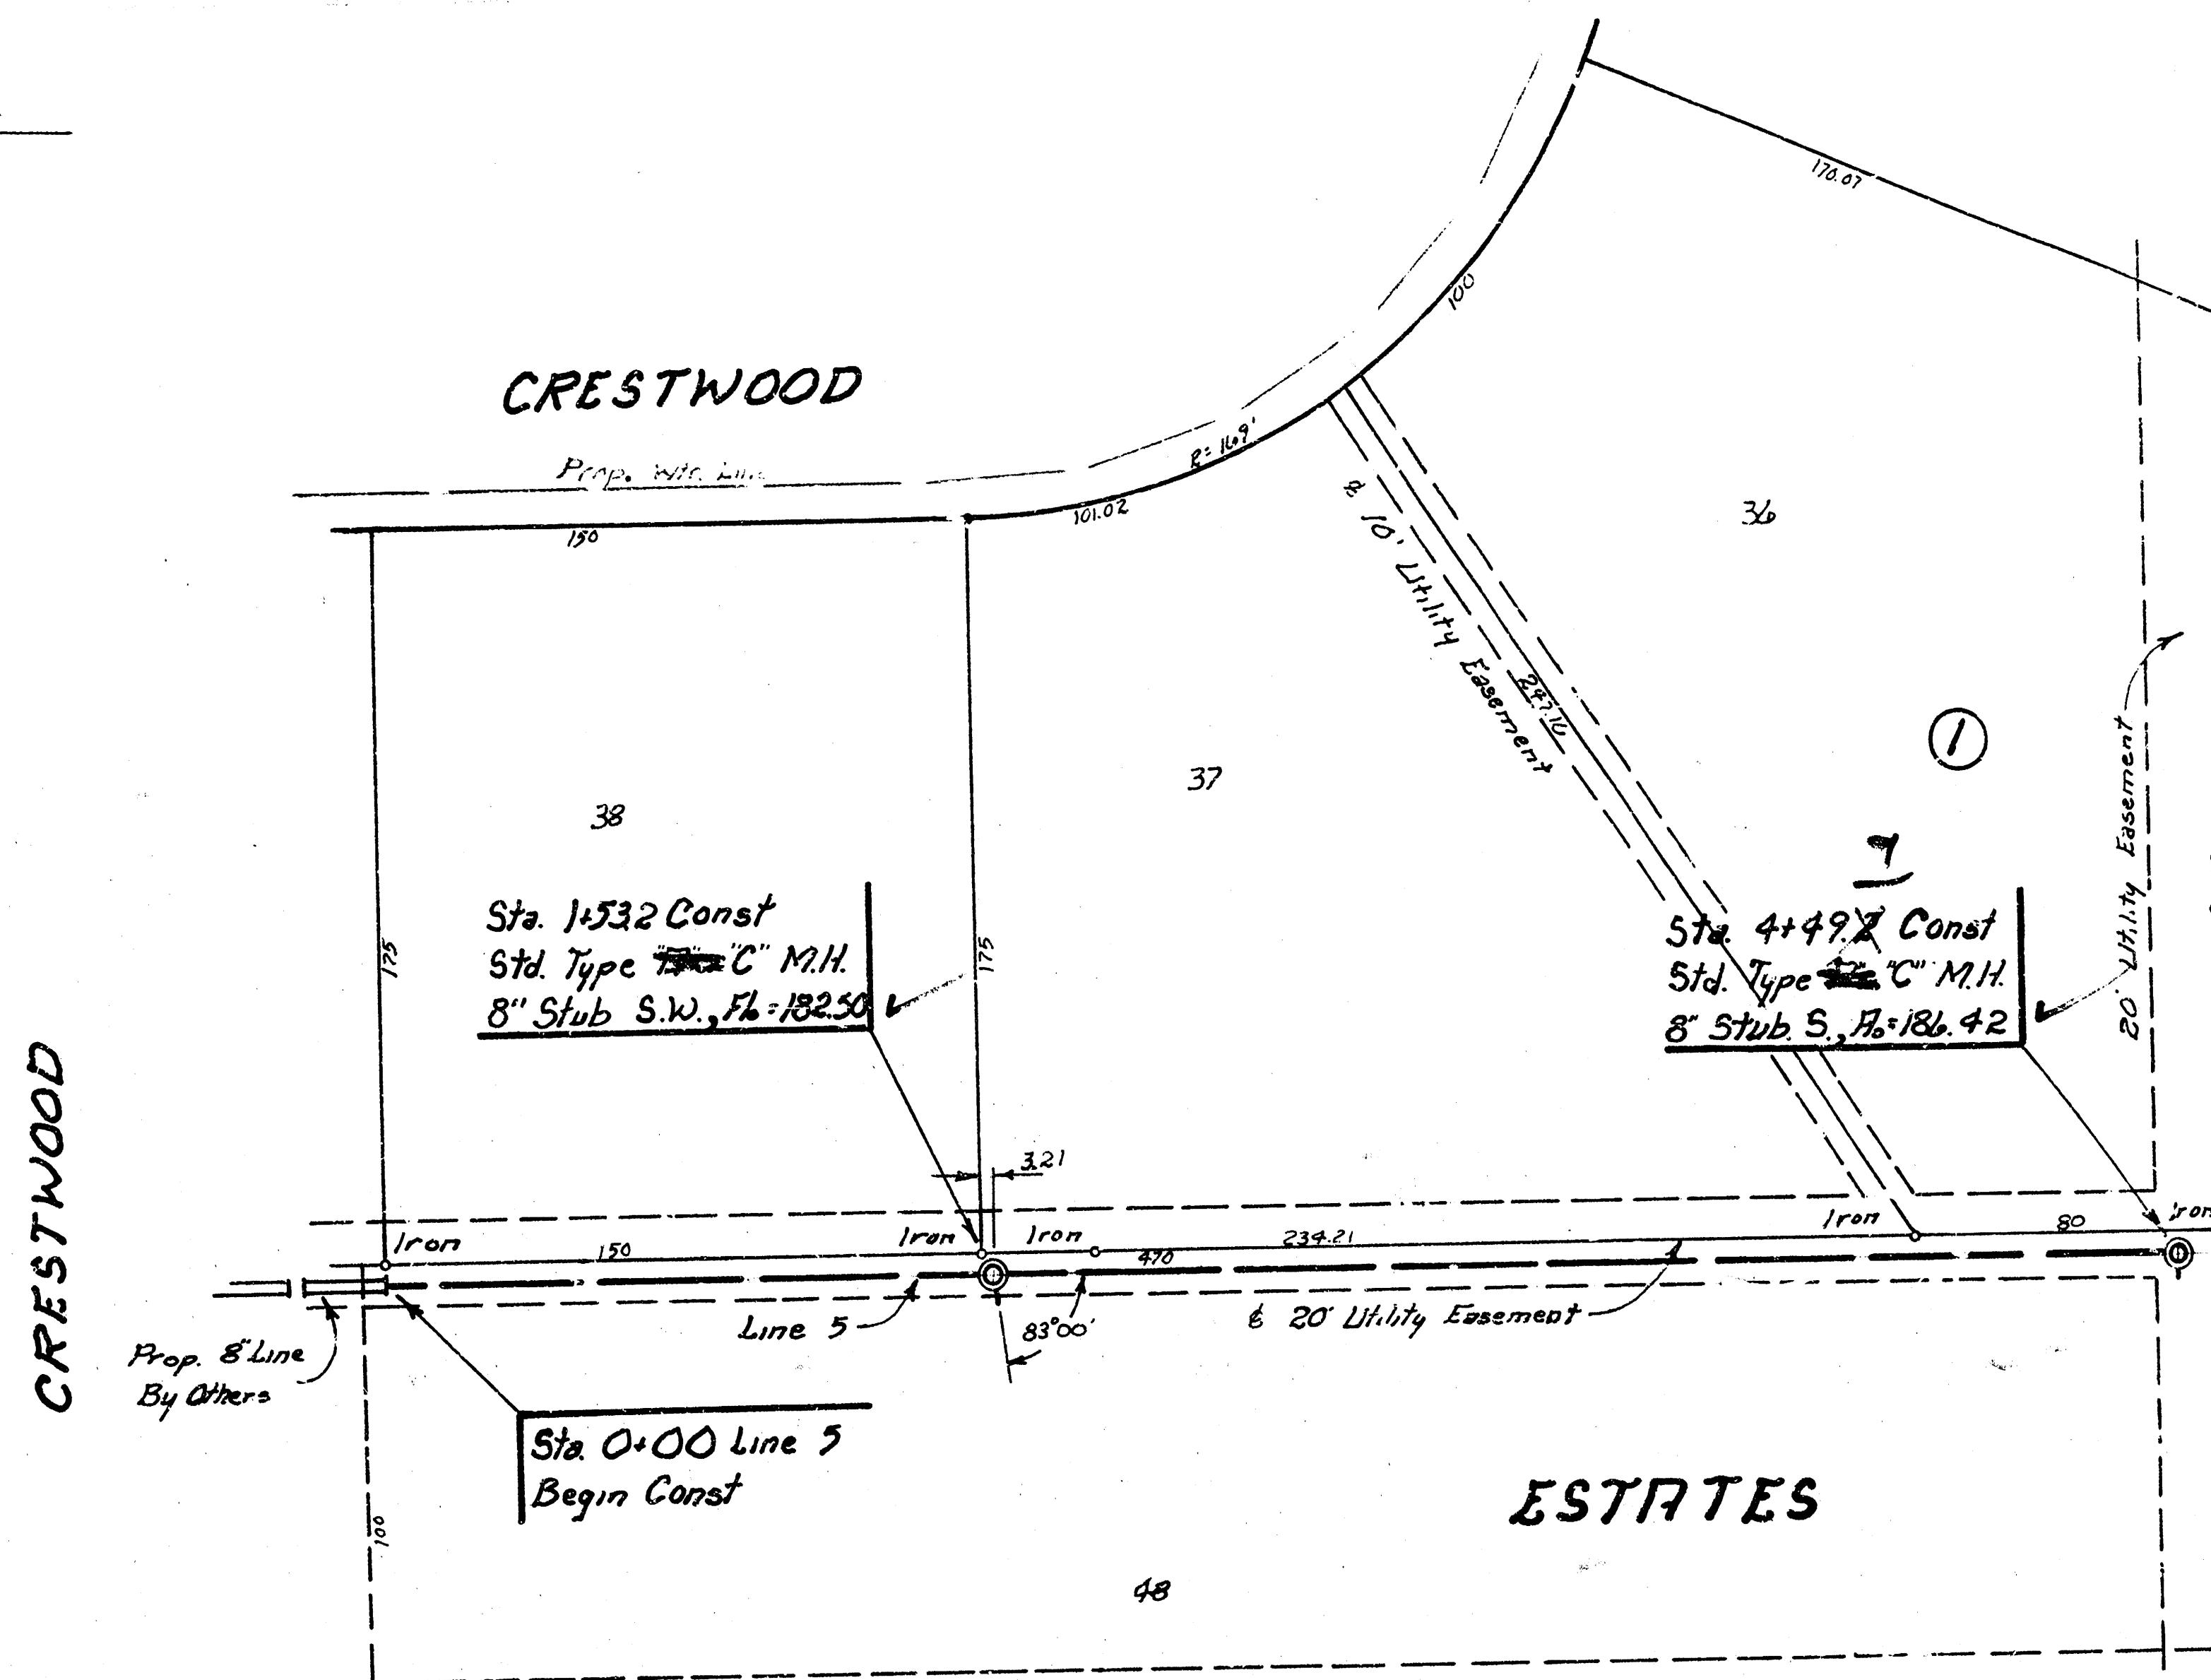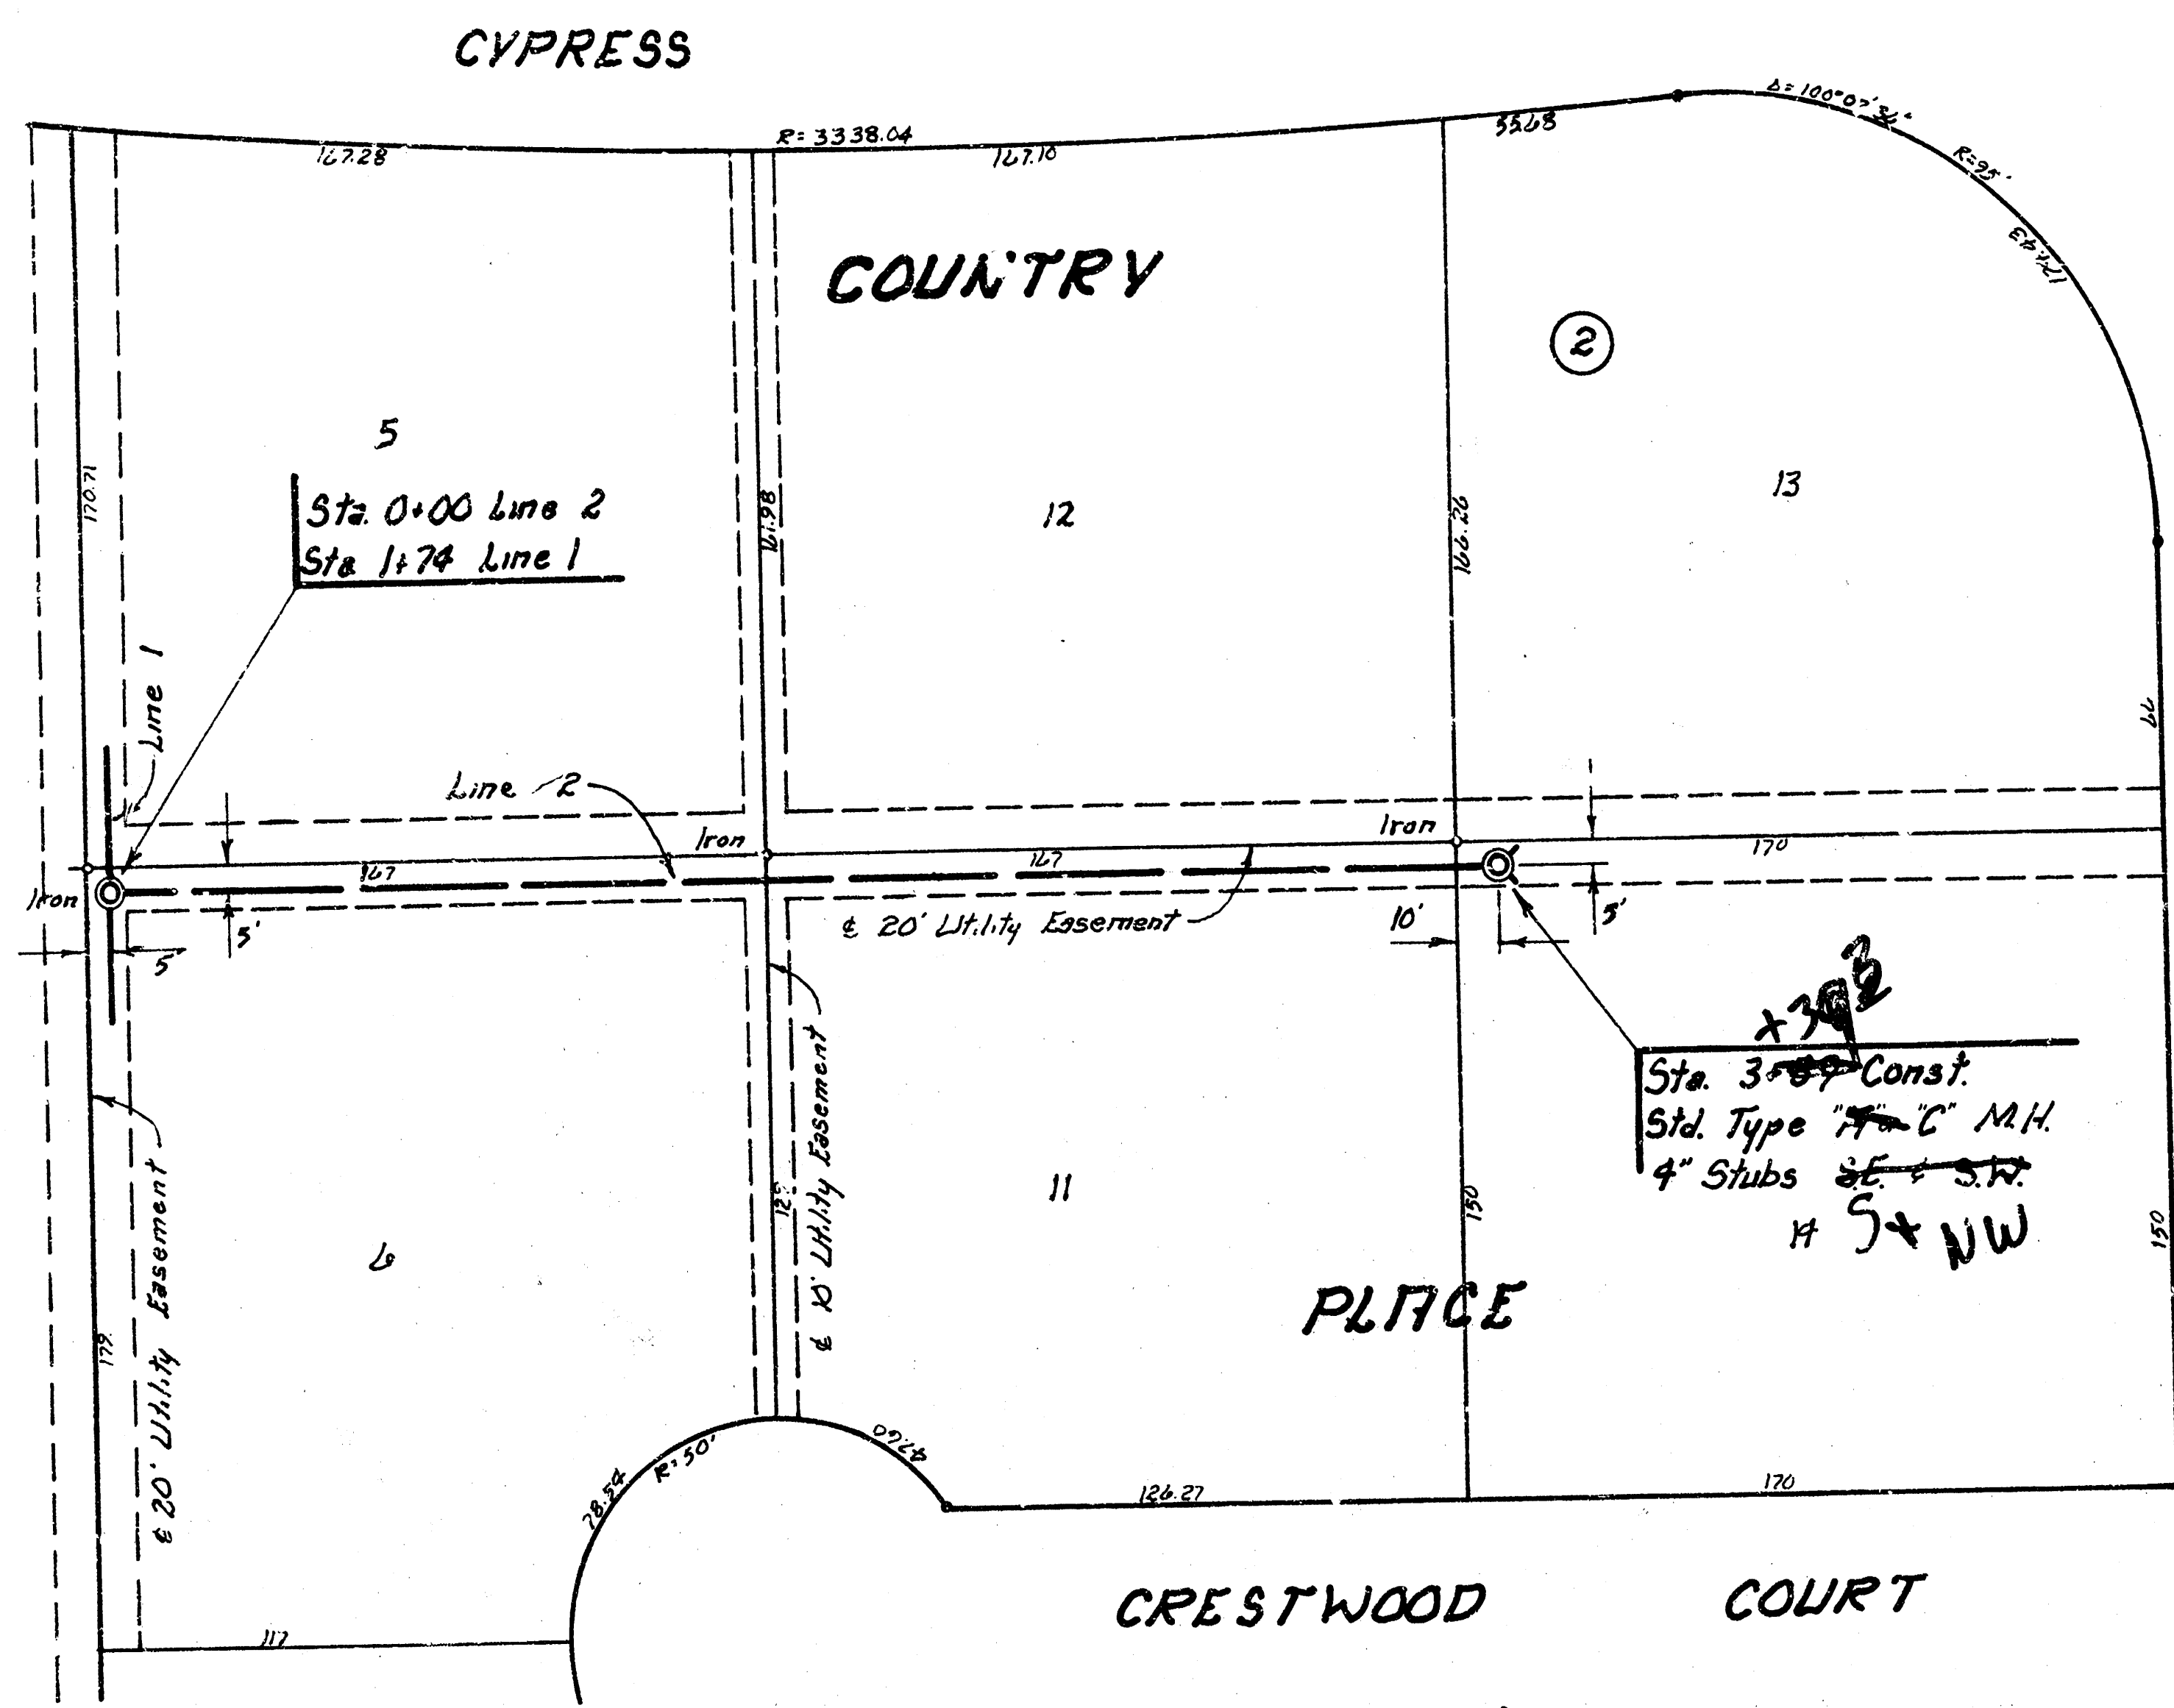

SCALE	1	40
PLAN		
Profile		
Horz	1	40
Vert	1	5

