



R. Loomis

Scale Plan 1" = 40'
Profile 1" = 40' Horiz.
1" = 5' Vert.

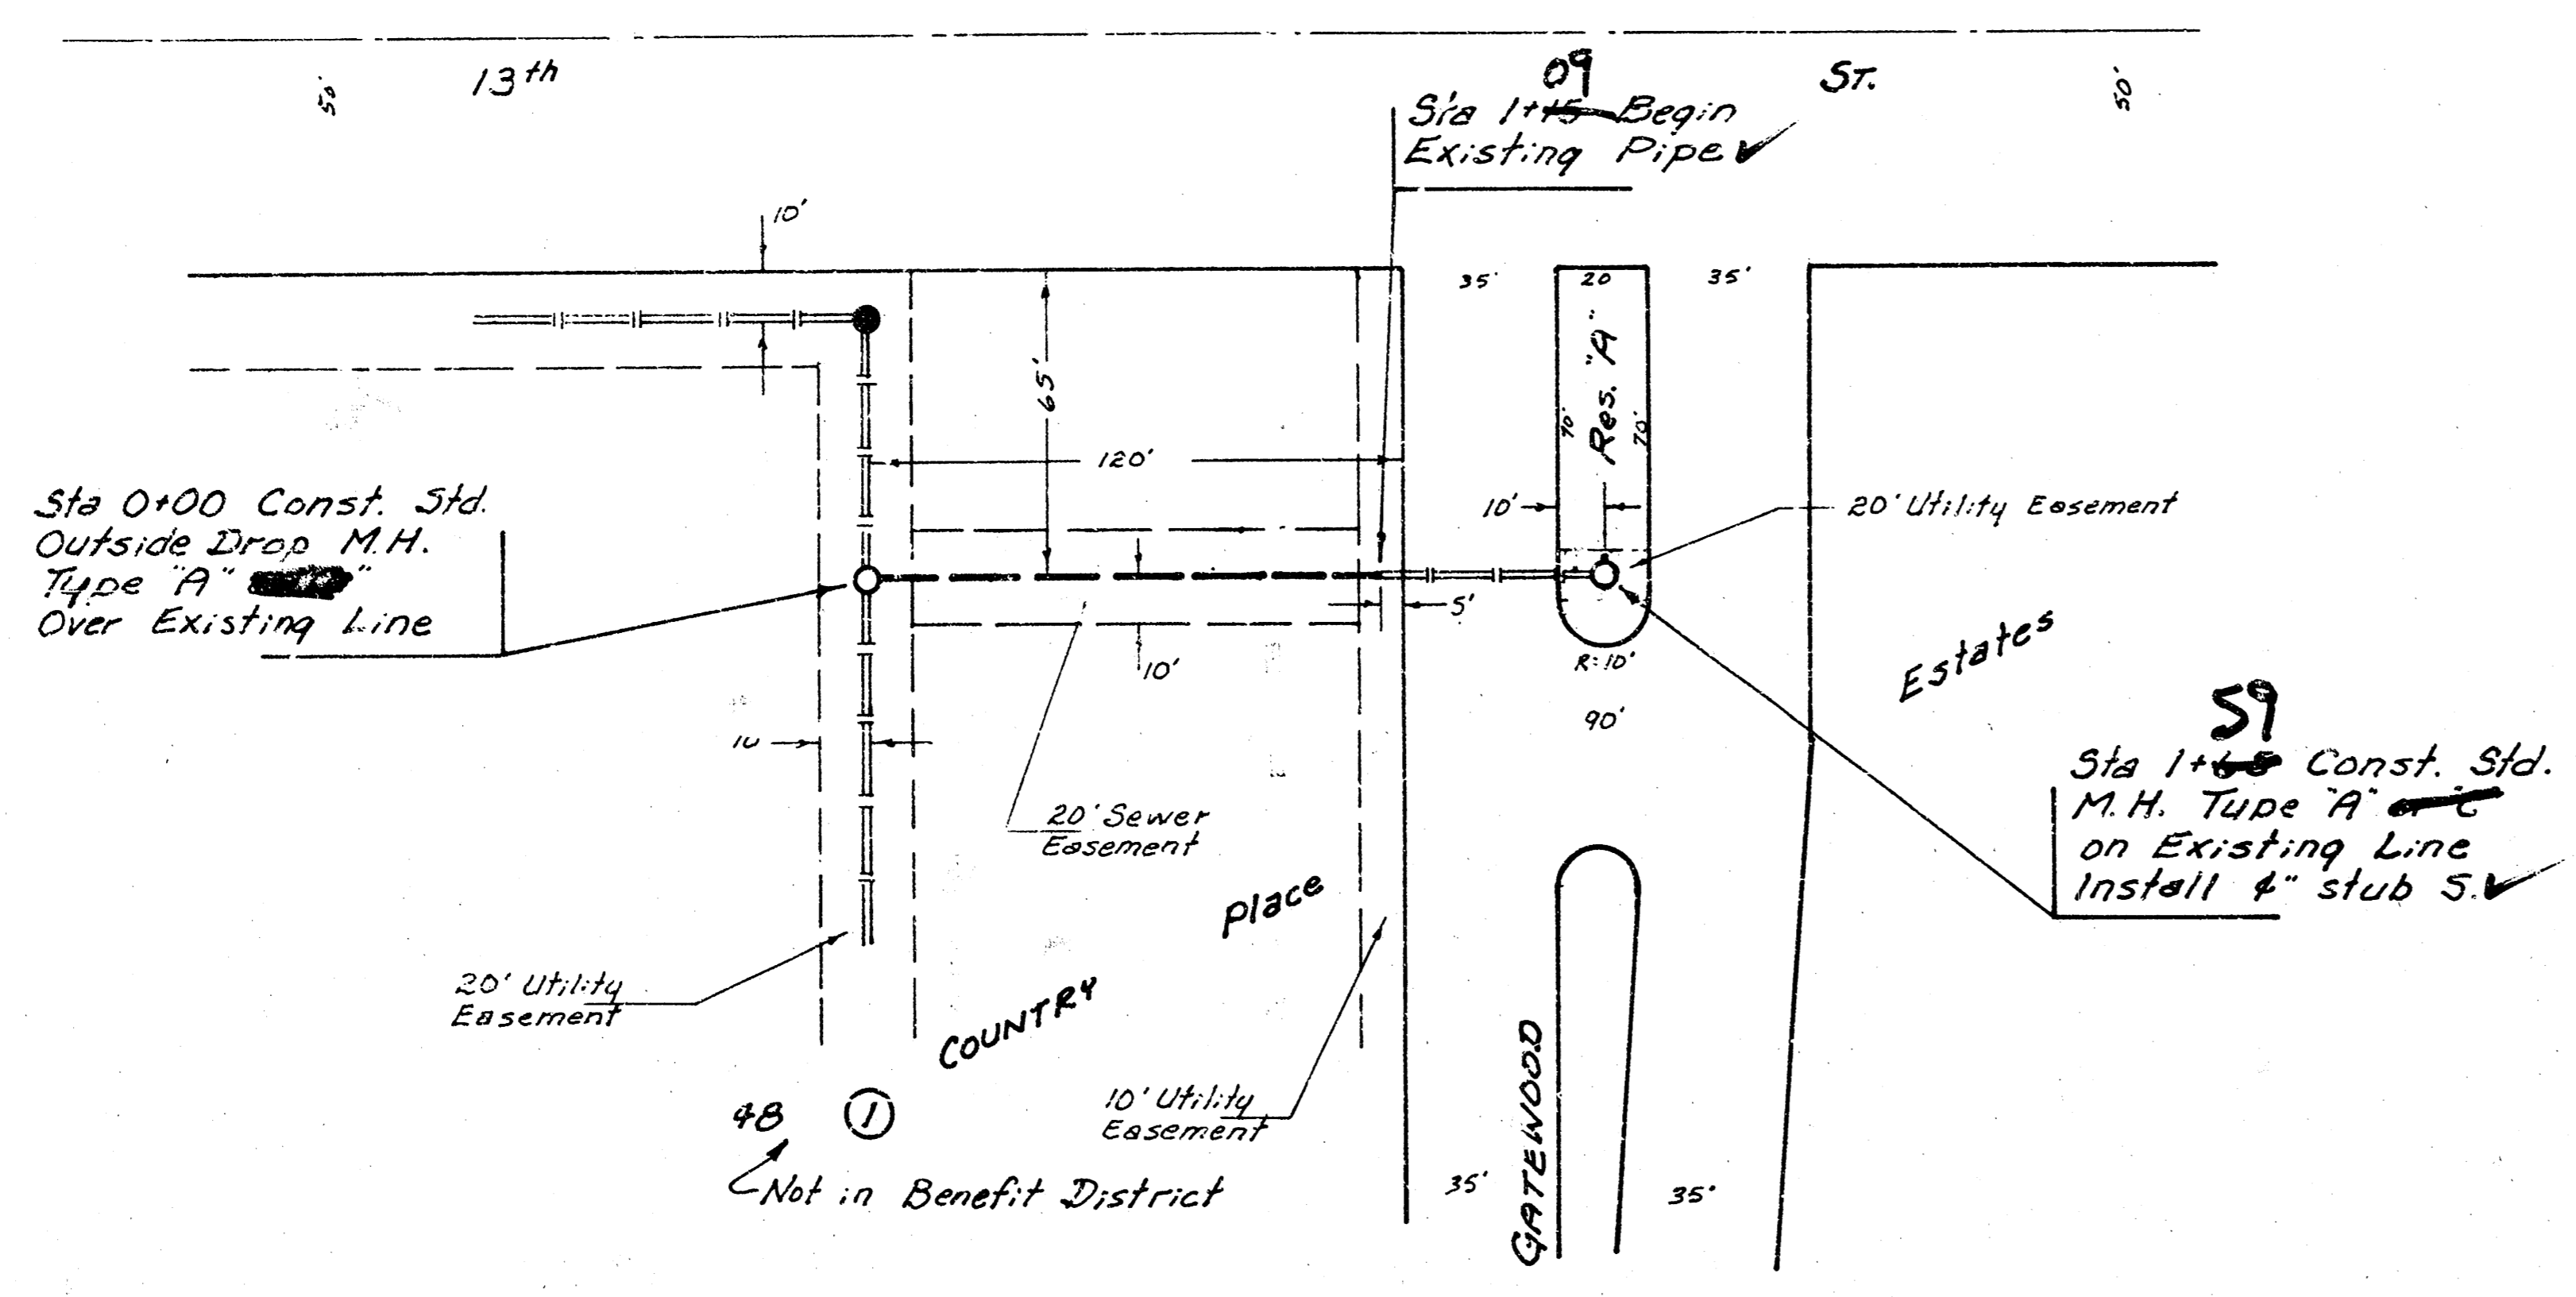

B.M. 198.87 R.R. Spike on NW. Face P.P.
31 ft. S-SW of NW Corner 13th St. and
Gatewood.

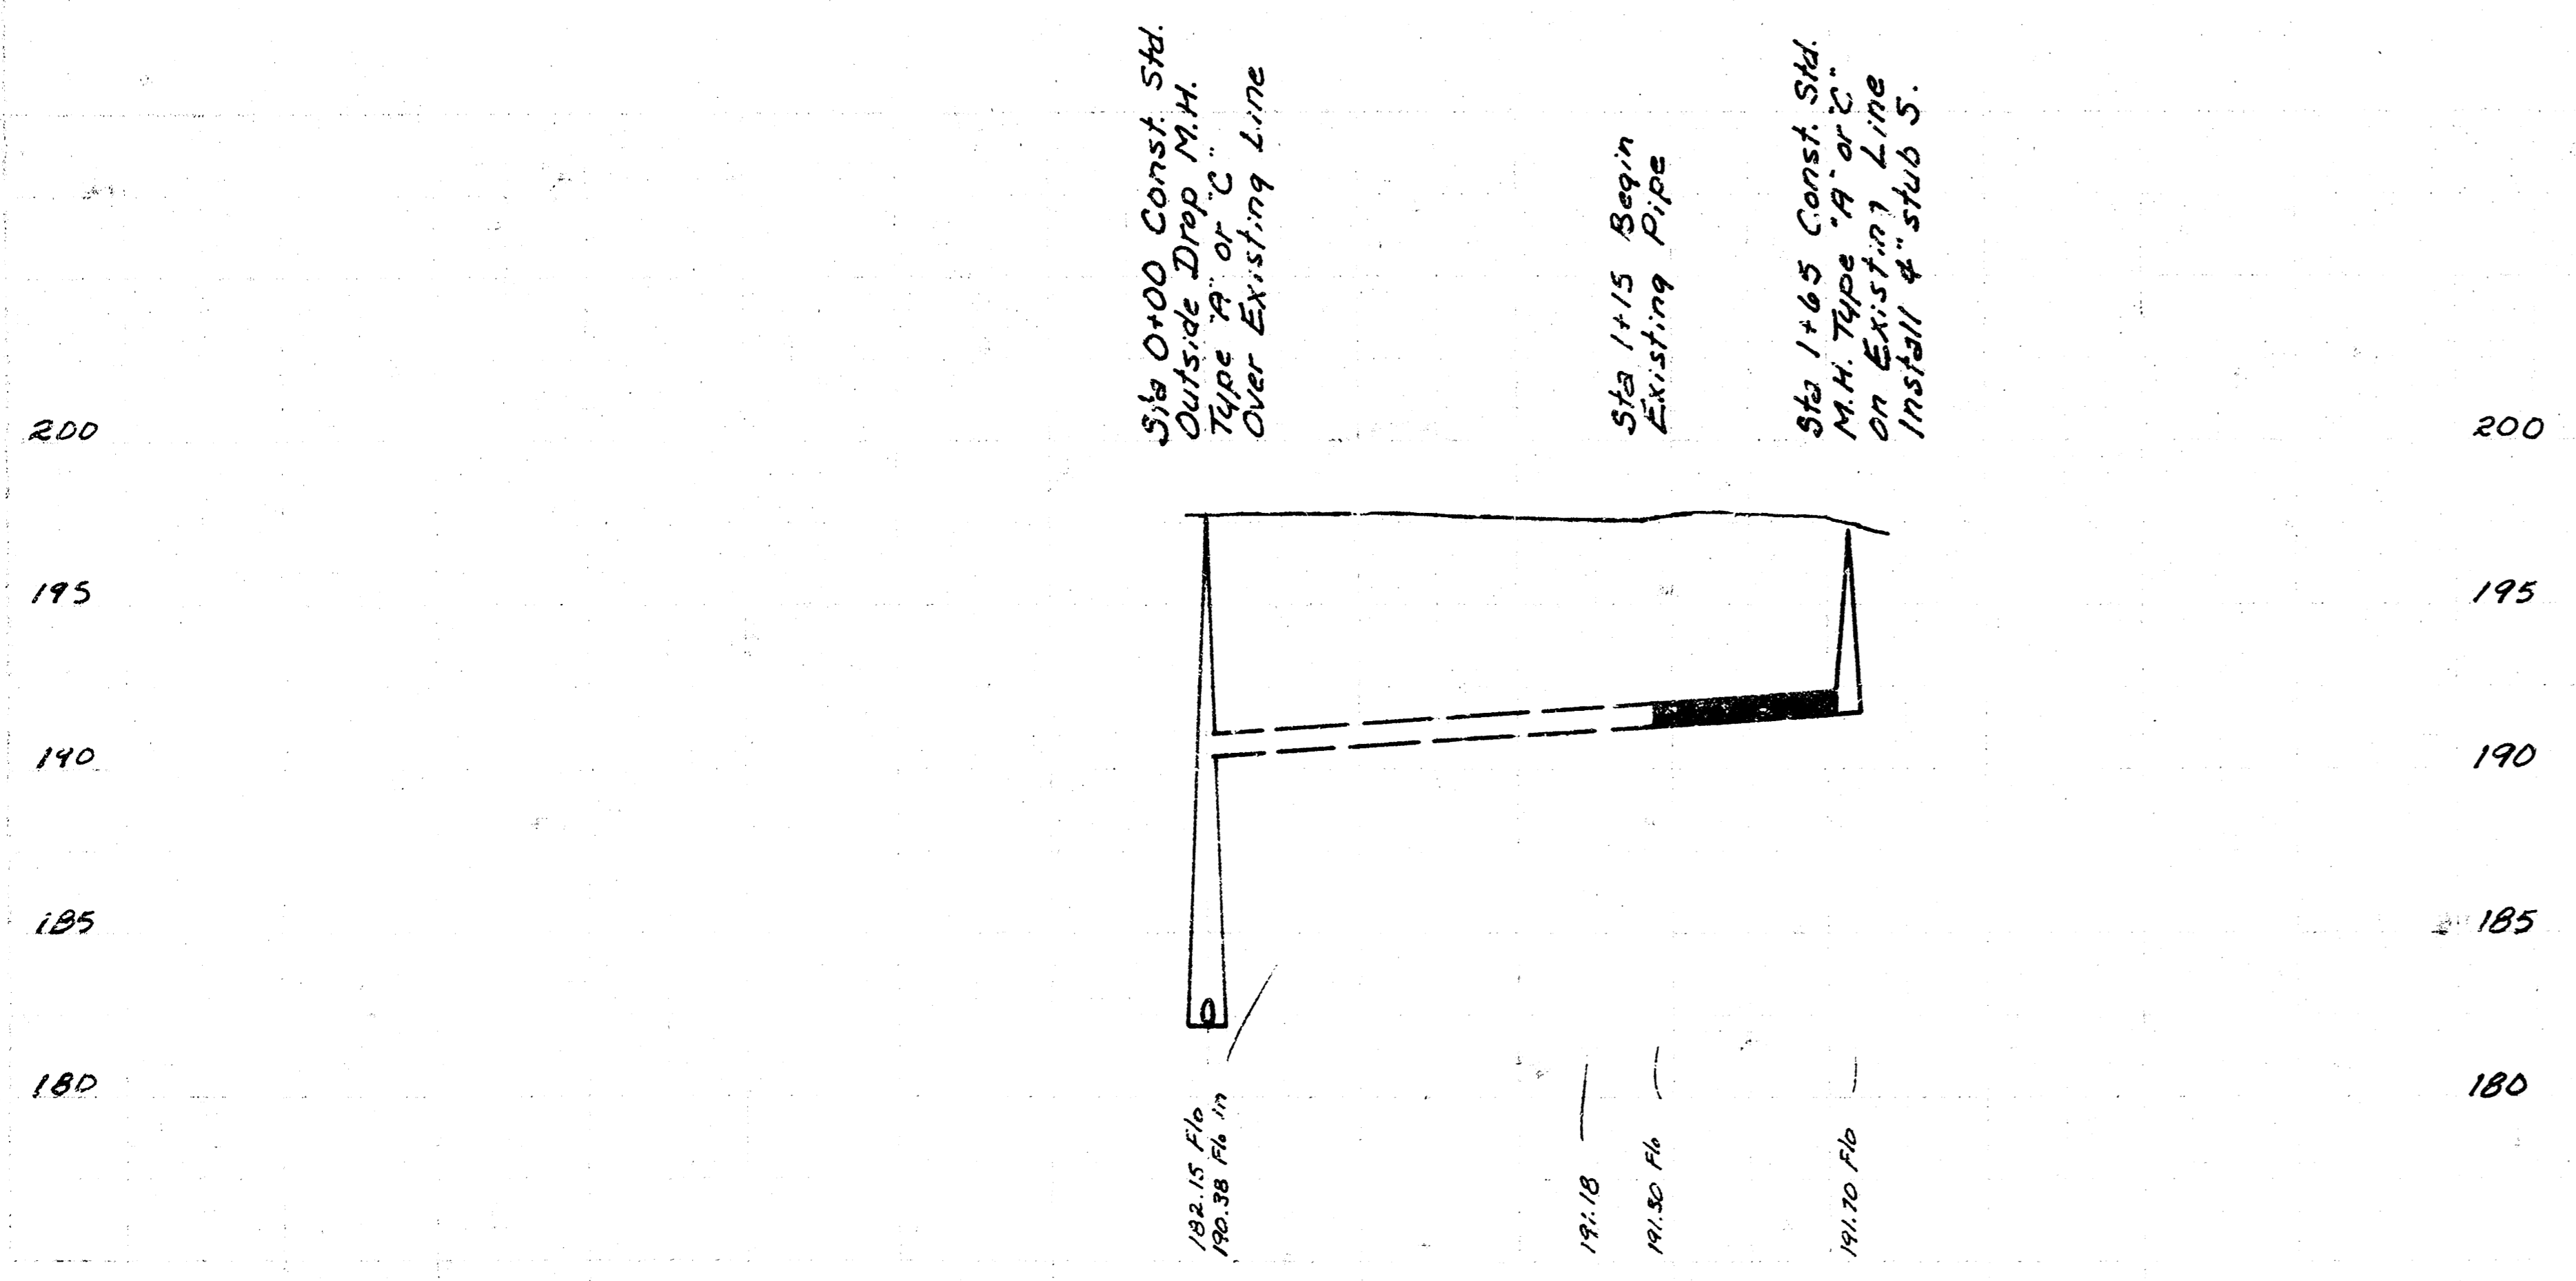

115 L.F. of 8" A.B.S. Composite Pipe
@ 0.80% Grade

As Built
OK
6-13-81



LAT 9, MAIN 22, WAR INDUSTRIES SEWER
CITY OF WICHITA, KANSAS
DEAN SELLERS — CITY ENGINEER
PROJ. NO. 46876245-80840-000-000001

14

S

I

J

11