


WOODSPRING

LATERAL 20, MAIN 22, W.I.S.

PROJECT NO.
468-76-245-81269-000-000-001

CITY OF WICHITA, KANSAS
R.W. BRUGGEMAN, CITY ENGINEER
MAY, 1983

CAUTION: High pressure KANER pipeline. Contact
24 hours prior to excavation. Call Jim Strickland
at 1-316-262-1408.

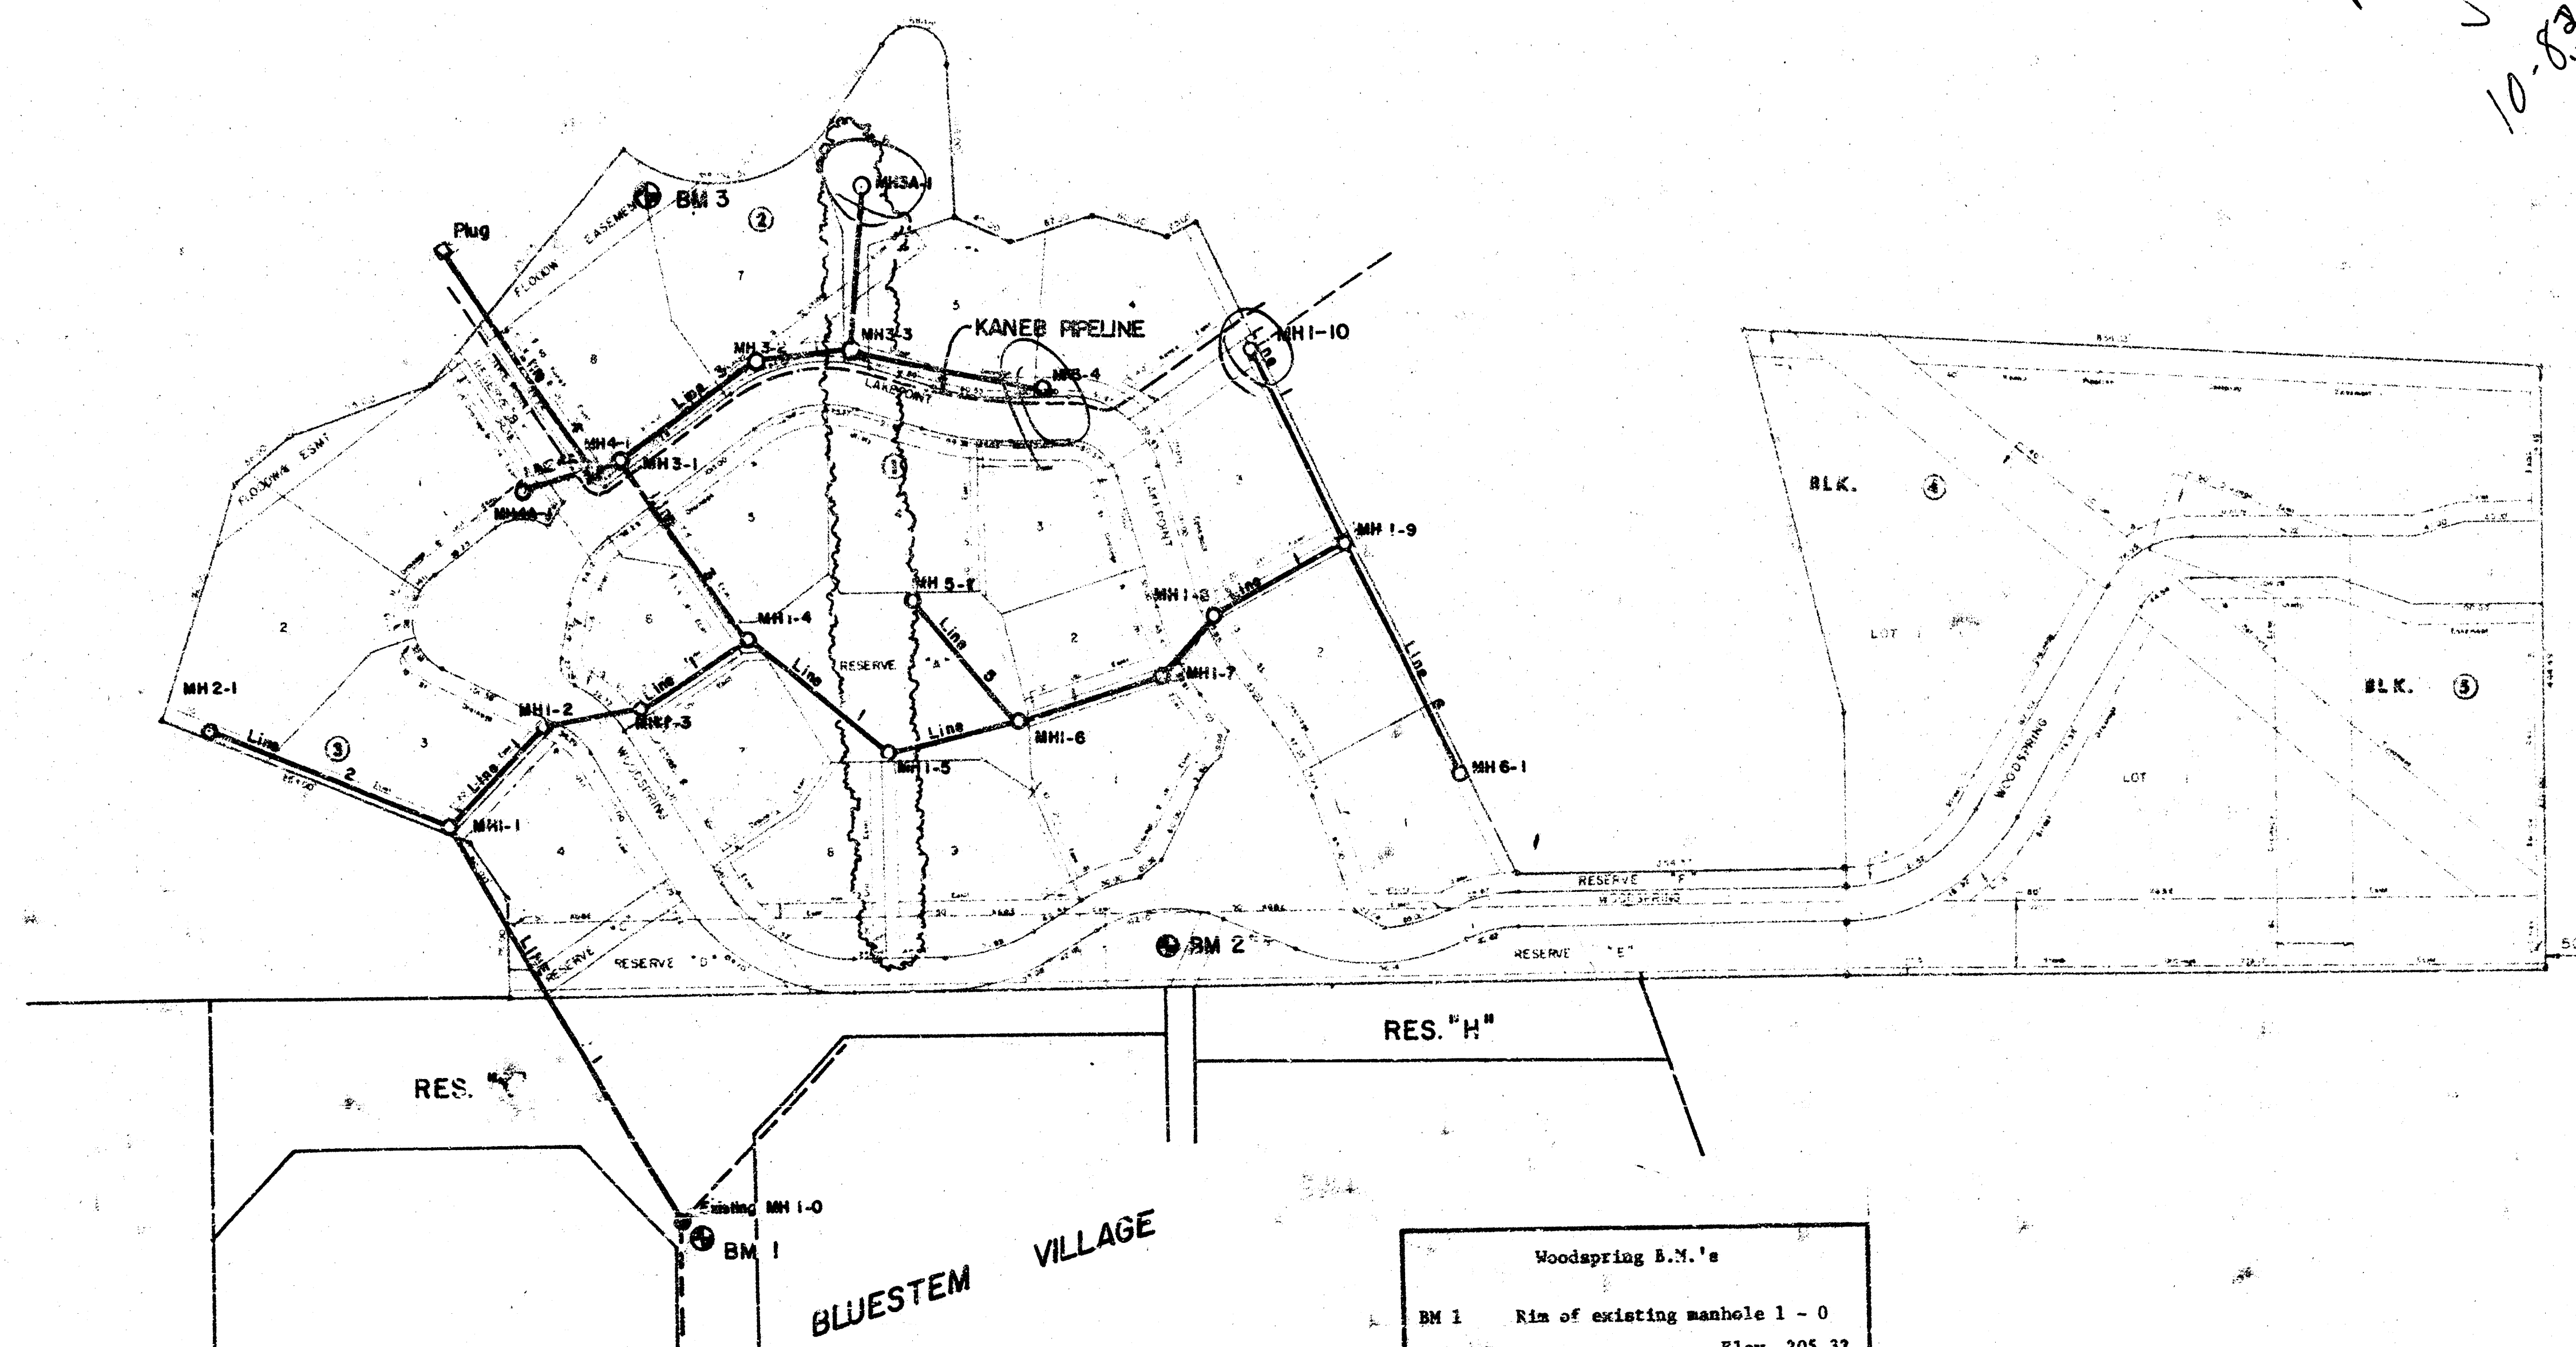

INDEX TO DRAWINGS

SHEET NO.	DESCRIPTION
1	TITLE SHEET
2	LINE 1
3	LINE 1
4	LINE 2 & 3
5	LINE 4, 4A, 5, & 6
6	MANHOLE DETAILS
7	FINAL PLAT



GENERAL NOTES

1. RISER PIPE SHALL BE INSTALLED TO SERVE INDIVIDUAL LOTS OR TRACTS IN CONJUNCTION WITH NEW SANITARY SEWER CONSTRUCTION, UNLESS OTHERWISE ORDERED BY THE ENGINEER, BECAUSE OF GROUND WATER, UNSTABLE SOIL OR UNUSUALLY DEEP CONSTRUCTION. RISER LOCATIONS SHALL BE AS APPROVED BY THE PROPERTY OWNER WITH THE CONCURRENCE OF THE ENGINEER. INSTALLATION OF RISERS OR SEWERS BECAUSE OF UNUSUAL DEPTH WILL BE REQUIRED WHEN THE CENTER IS DEEPER THAN TWELVE FEET (12'). THE CONTRACTOR WILL BE REQUIRED TO FILE WRITTEN DOCUMENTATION WITH THE ENGINEER IN A FORM APPROVED BY THE ENGINEER INDICATING THE LOCATIONS WHERE RISERS ARE TO BE INSTALLED AS REQUESTED BY THE PROPERTY OWNER OR HIS AUTHORIZED REPRESENTATIVE. RISER PIPE CONSTRUCTION SHALL CONFORM TO THE REQUIREMENTS AS SHOWN ON THE STANDARD RISER DETAIL SHEET.
2. THE CONTRACTOR SHALL BE RESPONSIBLE FOR PRESERVING PROPERTY IRONS. THE CONTRACTOR SHALL ESTABLISH ANY PROPERTY IRONS WHICH ARE NECESSARY FOR SEWER OPERATIONS. SUCH IRONS SHALL BE MAINTAINED THROUGHOUT CONSTRUCTION OR A LICENSED PROFESSIONAL ENGINEER SHALL BE RESPONSIBLE FOR THE IRONS IN THE PROPOSAL.

Prior to excavation in Reserve K the contractor shall notify Tallgrass to locate sprinkler lines and to allow time for removal of trees and shrubs. Contact Ken Purg at 681-0243.

The cost of removal and repair of the sprinkler system and all utilities shall be subsidiary to the installation of the sewer lines.

Woodspring B.M.'s	
BM 1	Rim of existing manhole 1 - 0 Elev. 205.32
BM 2	Spike step in south face of K&E "Y" pole. Elev. 211.32
BM 3	Square cut on southeast corner of pond dam. Elev. 207.86

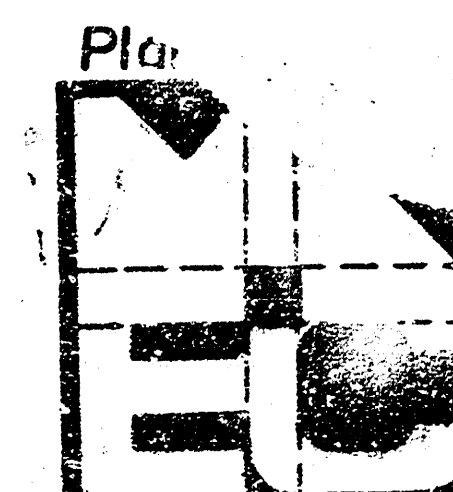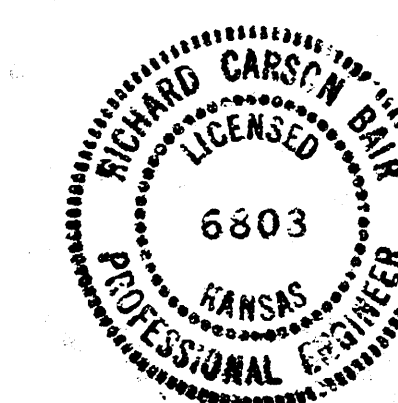

WOODSPRING
SANITARY SEWER
EXTENSIONS

MID-KANSAS ENGINEERING CONSULTANTS PA
240 NORTH ROCK ROAD
SUITE 130
WICHITA, KANSAS 67206

682-6561

FILMED FROM THE BEST
AVAILABLE COPY

Scale:
1" = 40' Horiz.
1" = 5' Vert.


Raise M.H. 1-0 1'-6". The cost shall be subsidiary to the installation of the sewer lines.

Note: Existing M.H. = Sta. 3+41.7- Line 3
Lateral 10, Main 22, W.I.S. Booked
G = 282 C.I.D. Reshape Invert as shown on M.H. Details.

BM 1 Kim of existing manhole 1-0
Elev. 205.32


PLAN LINE 1

PLAN LINE 1

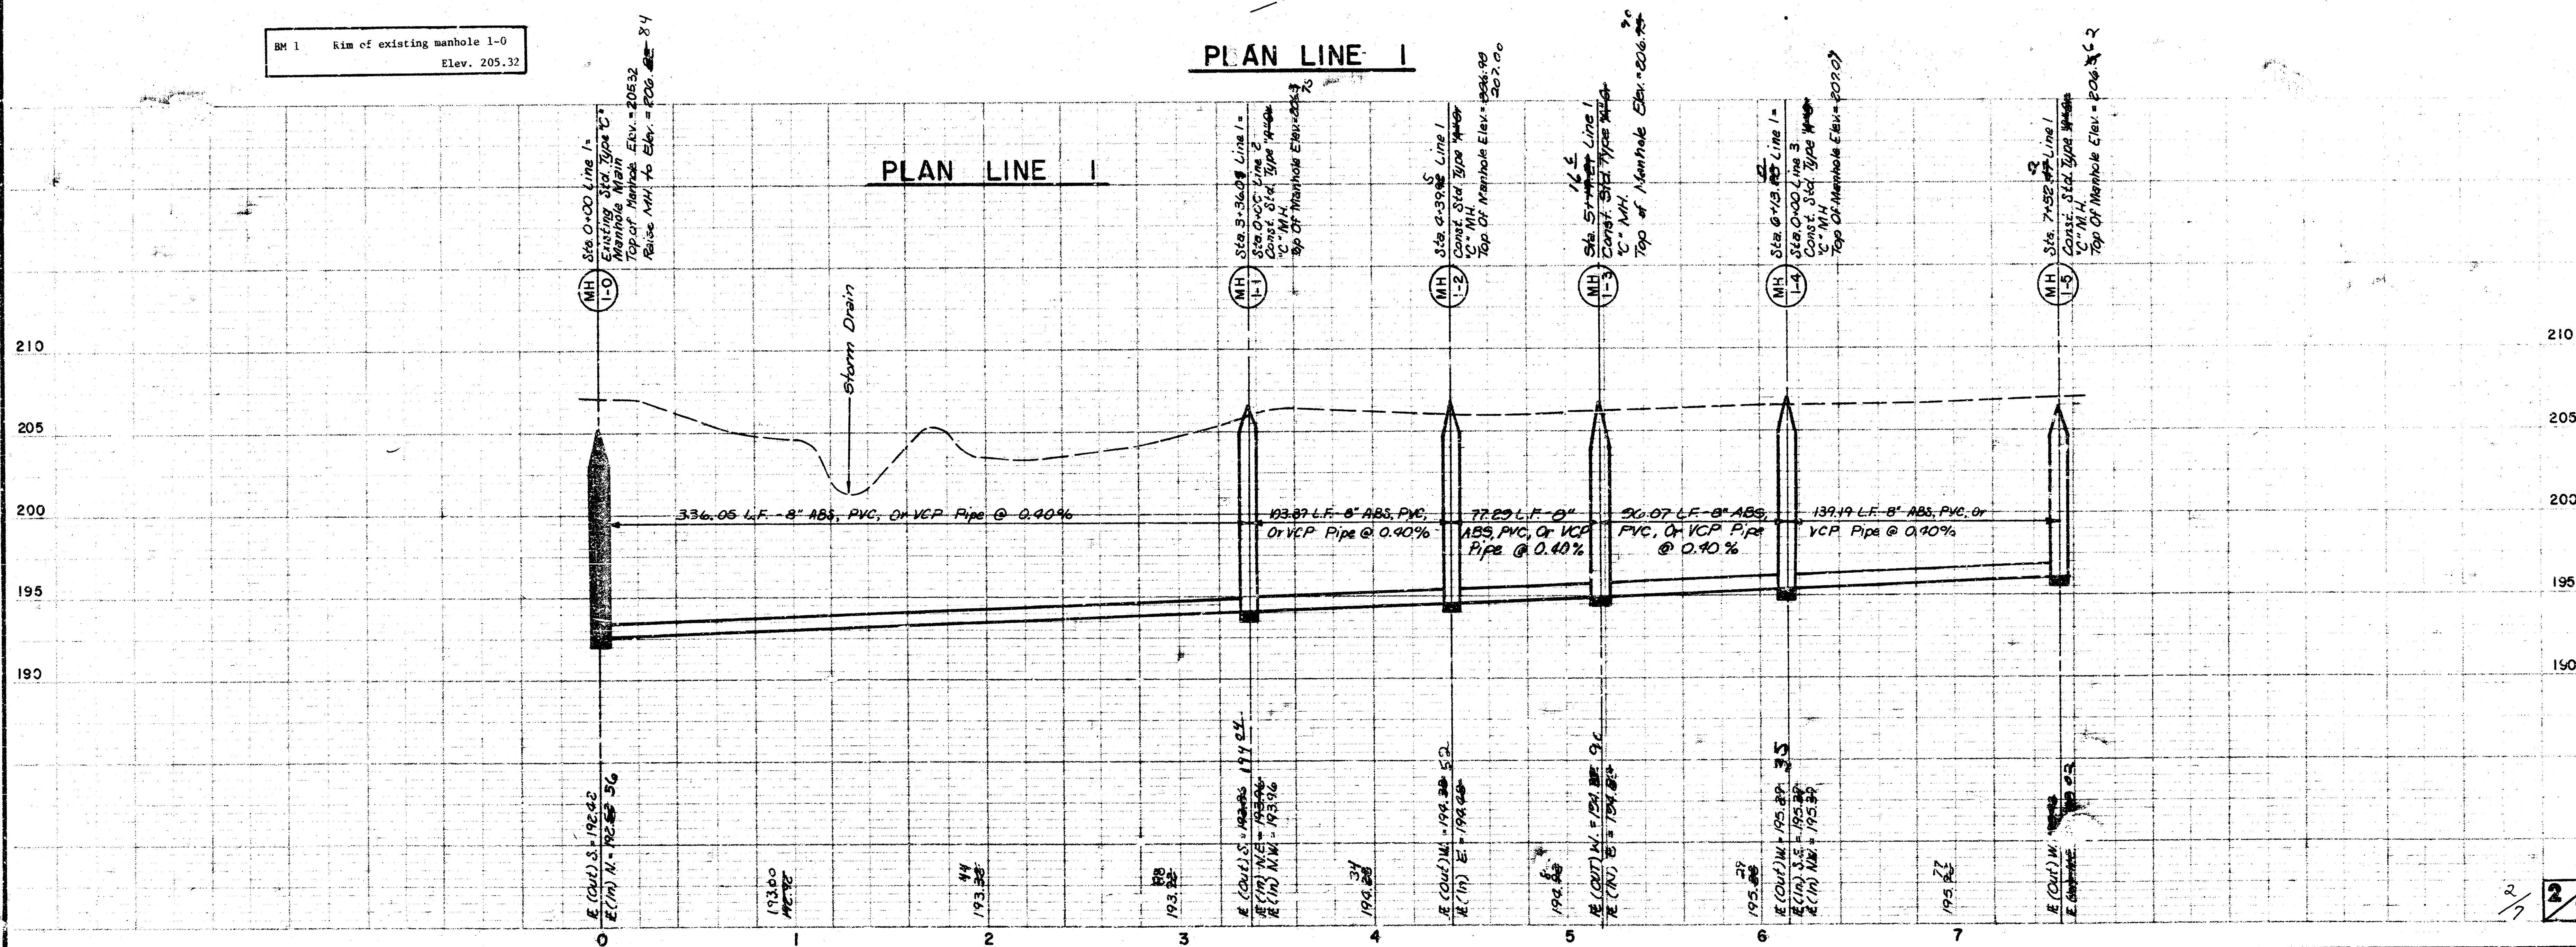

As Built
J.L.L.
10-83

WOODSPRING LAT. 20, MAIN 22, W.I.S.
PROJECT NO.
438-76-245-81269-000-000-001

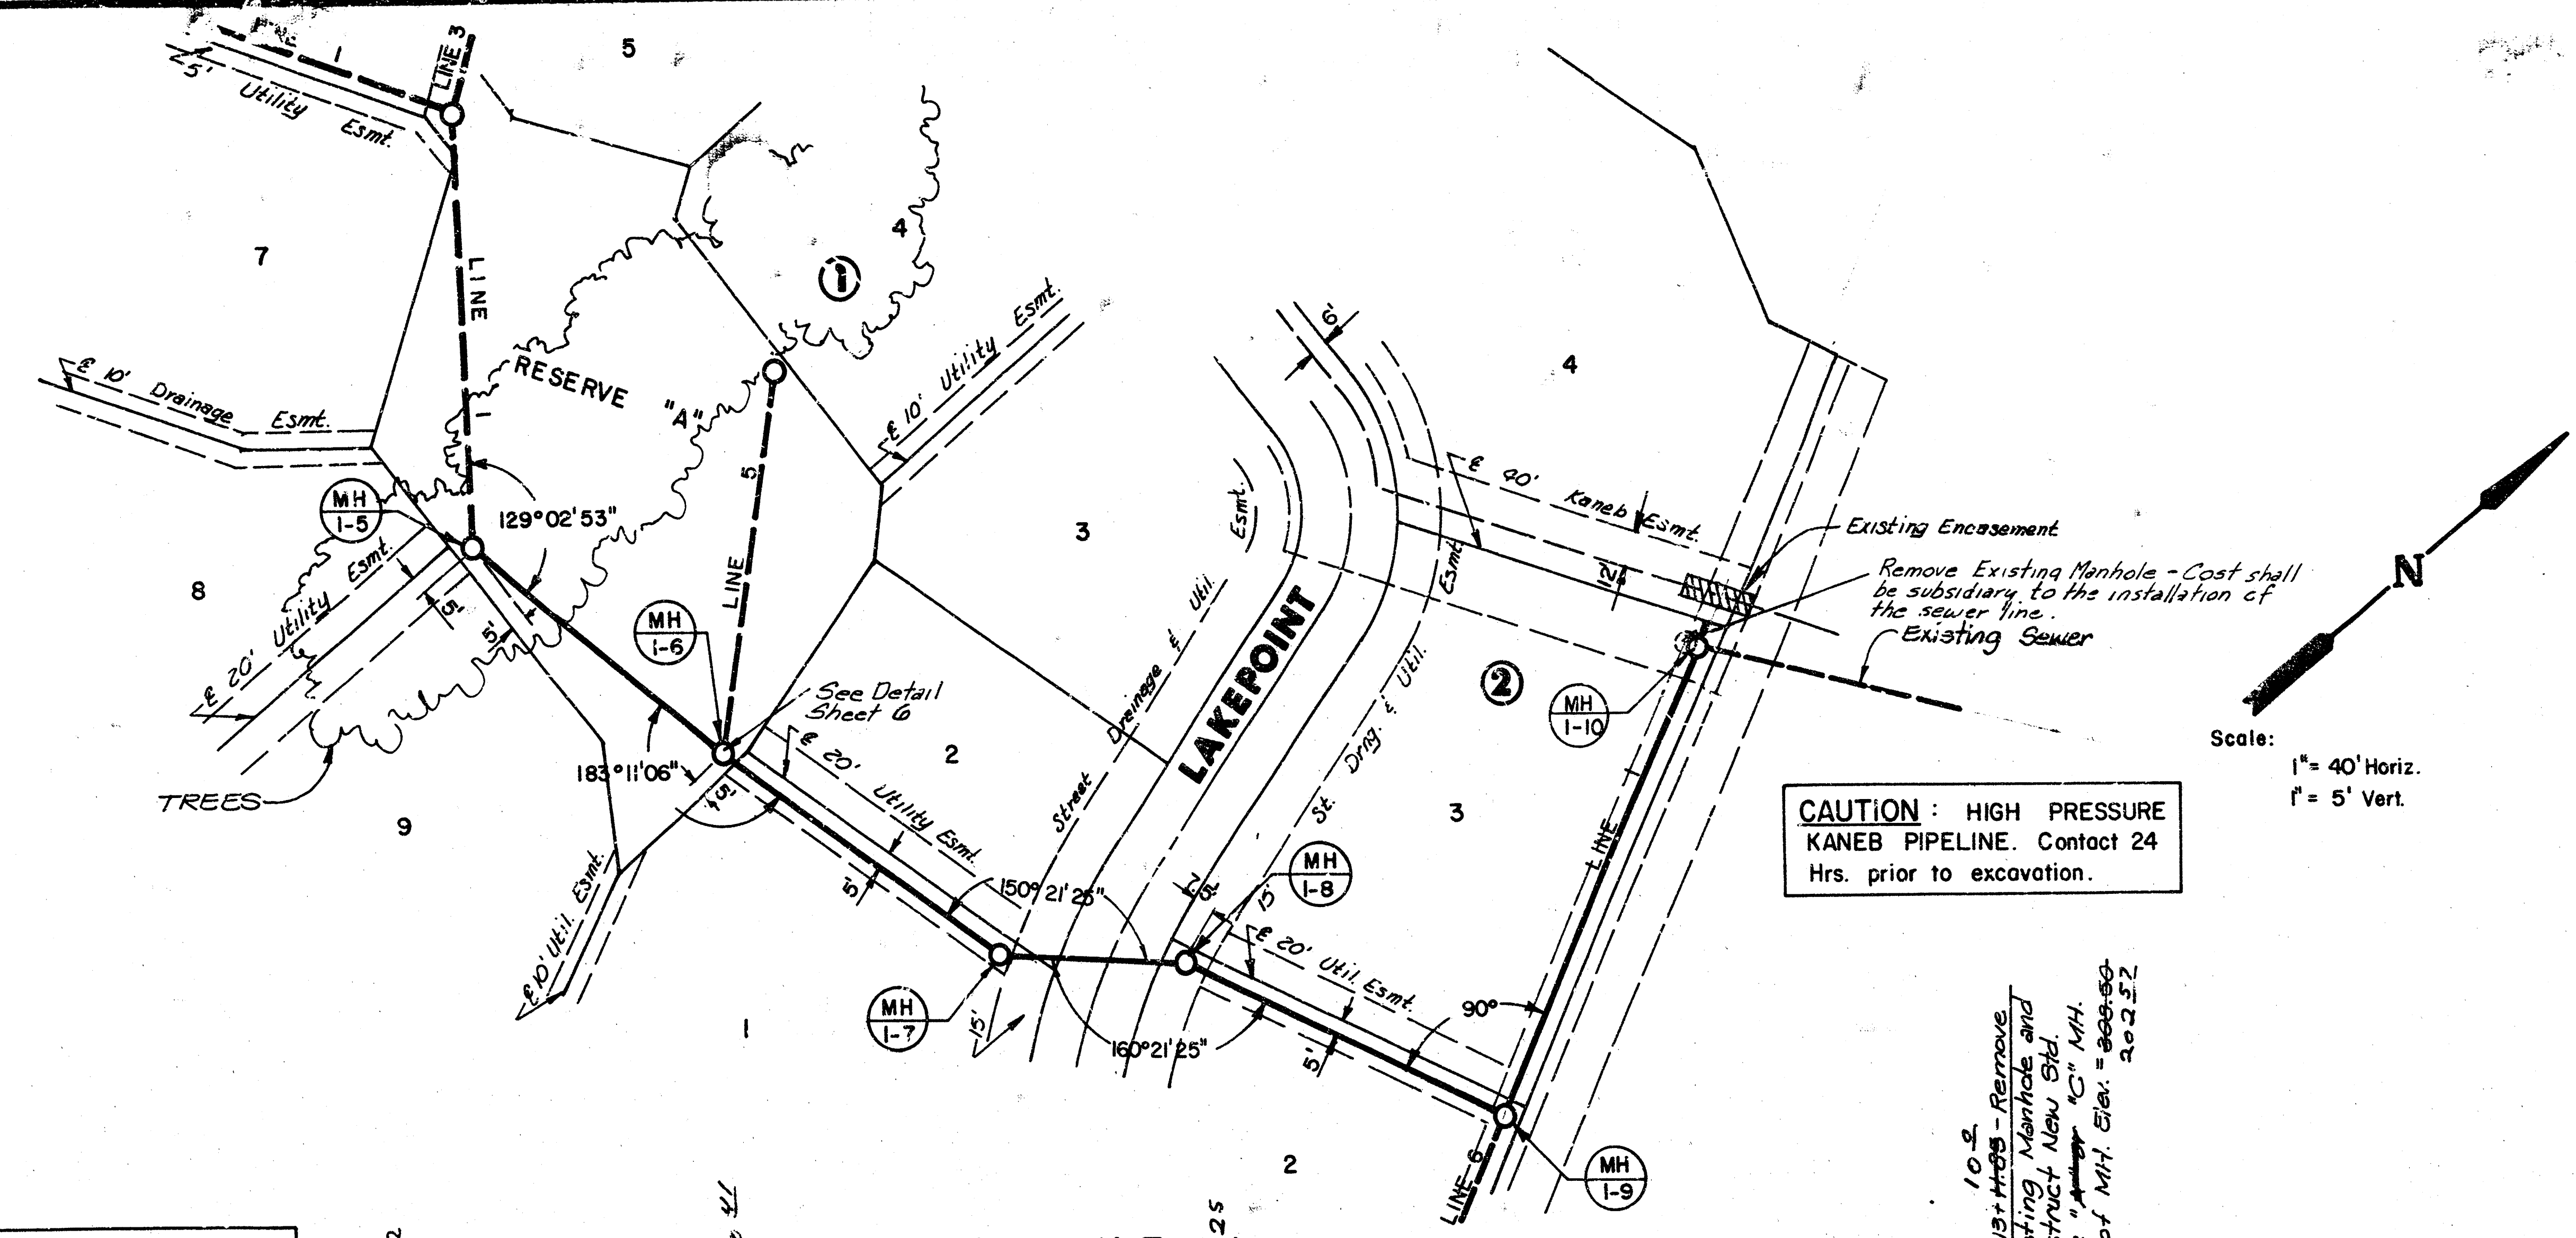

Is Built J.L.L. 10-85


Plan Sheet Revised 8/5/83

BM 2 Spike step in south face of K&S 'Y' pole.
Elev. 211.32

PLAN LINE

PLAN LINE


CAUTION: HIGH PRESSURE KANEB PIPELINE. Contact 24 Hrs. prior to excavation. Call JIM STRICKLAND with KANEB at 1-316-262-1403.

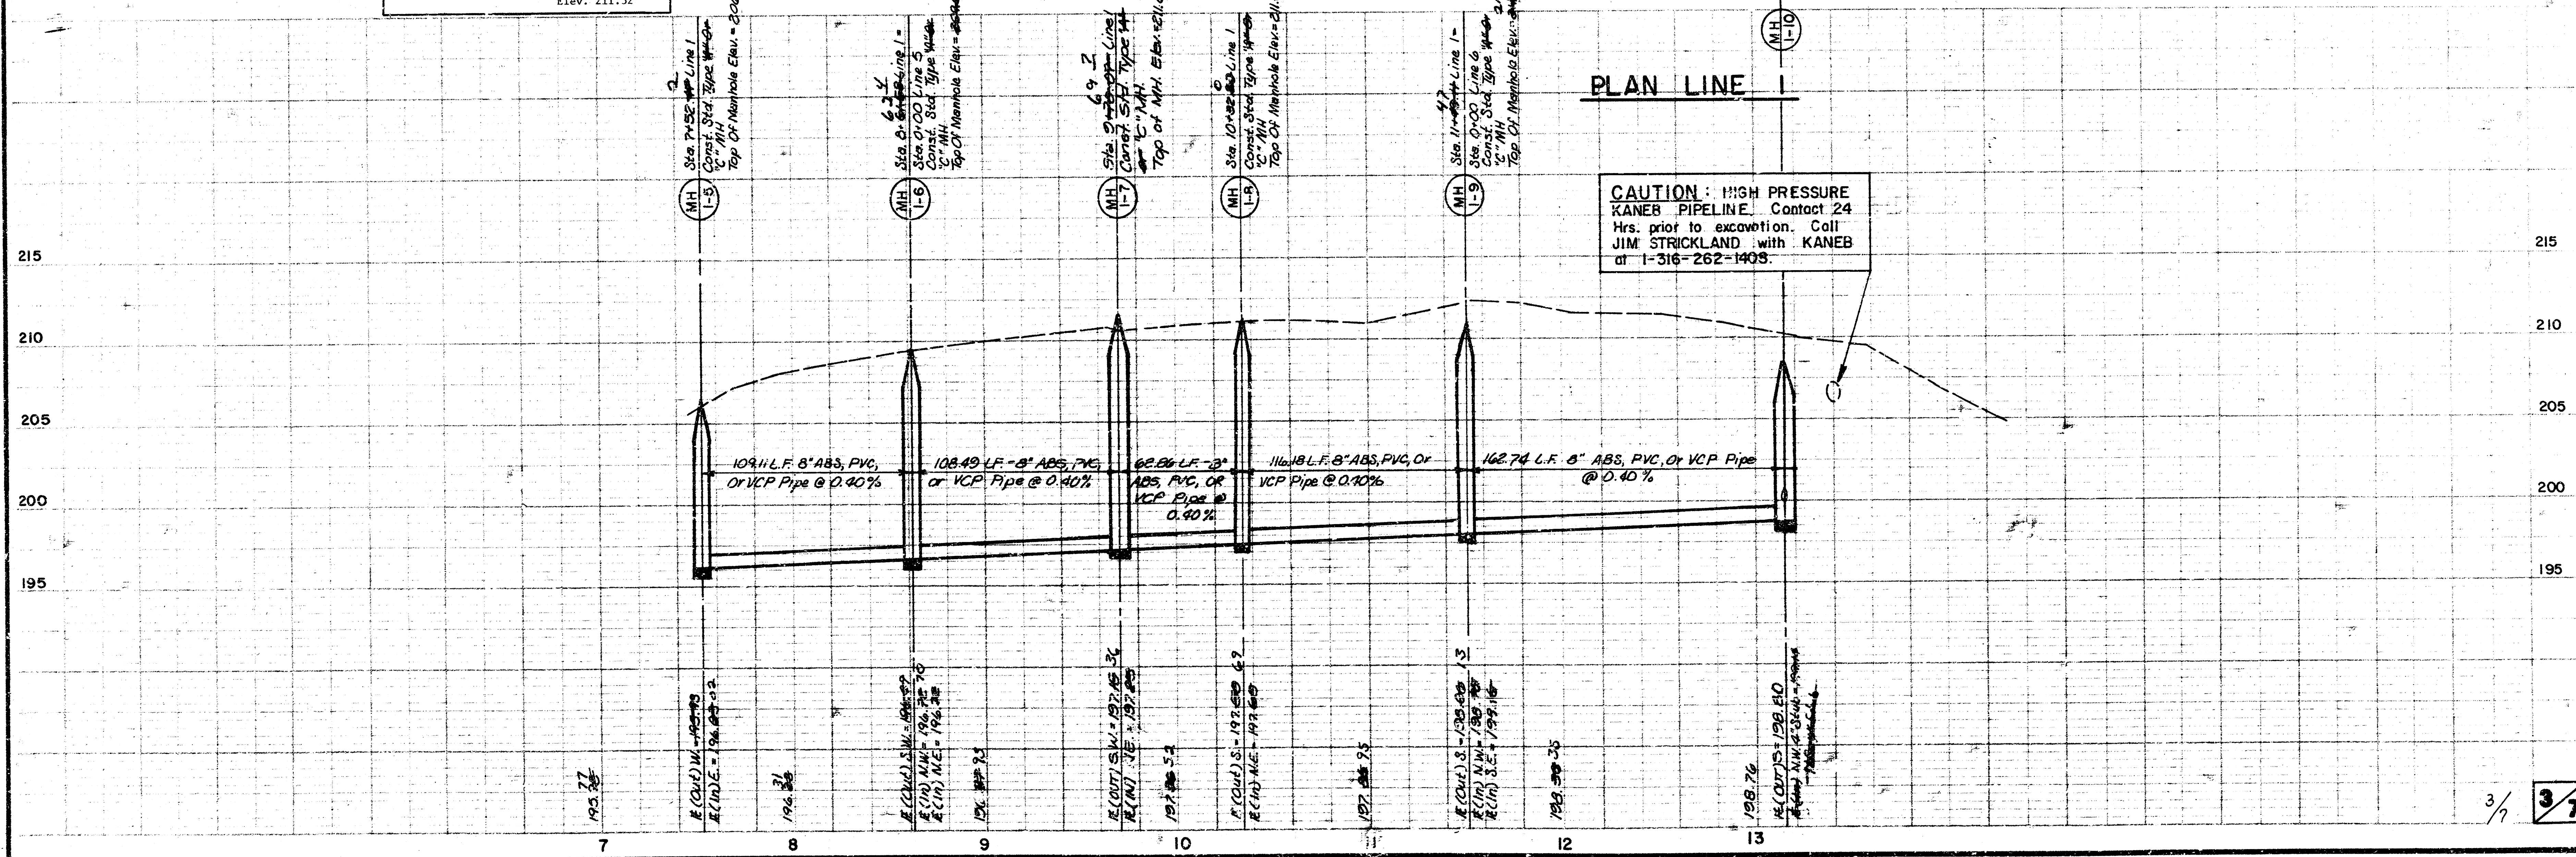


WOODSPRING LAT 20, MAIN 22, W.I.S.
PROJECT NO.
468-76-245- 81269 -000-000-001

Plan Sheet Revised 8/5/83

*As Built
J.L.L.
10-85*

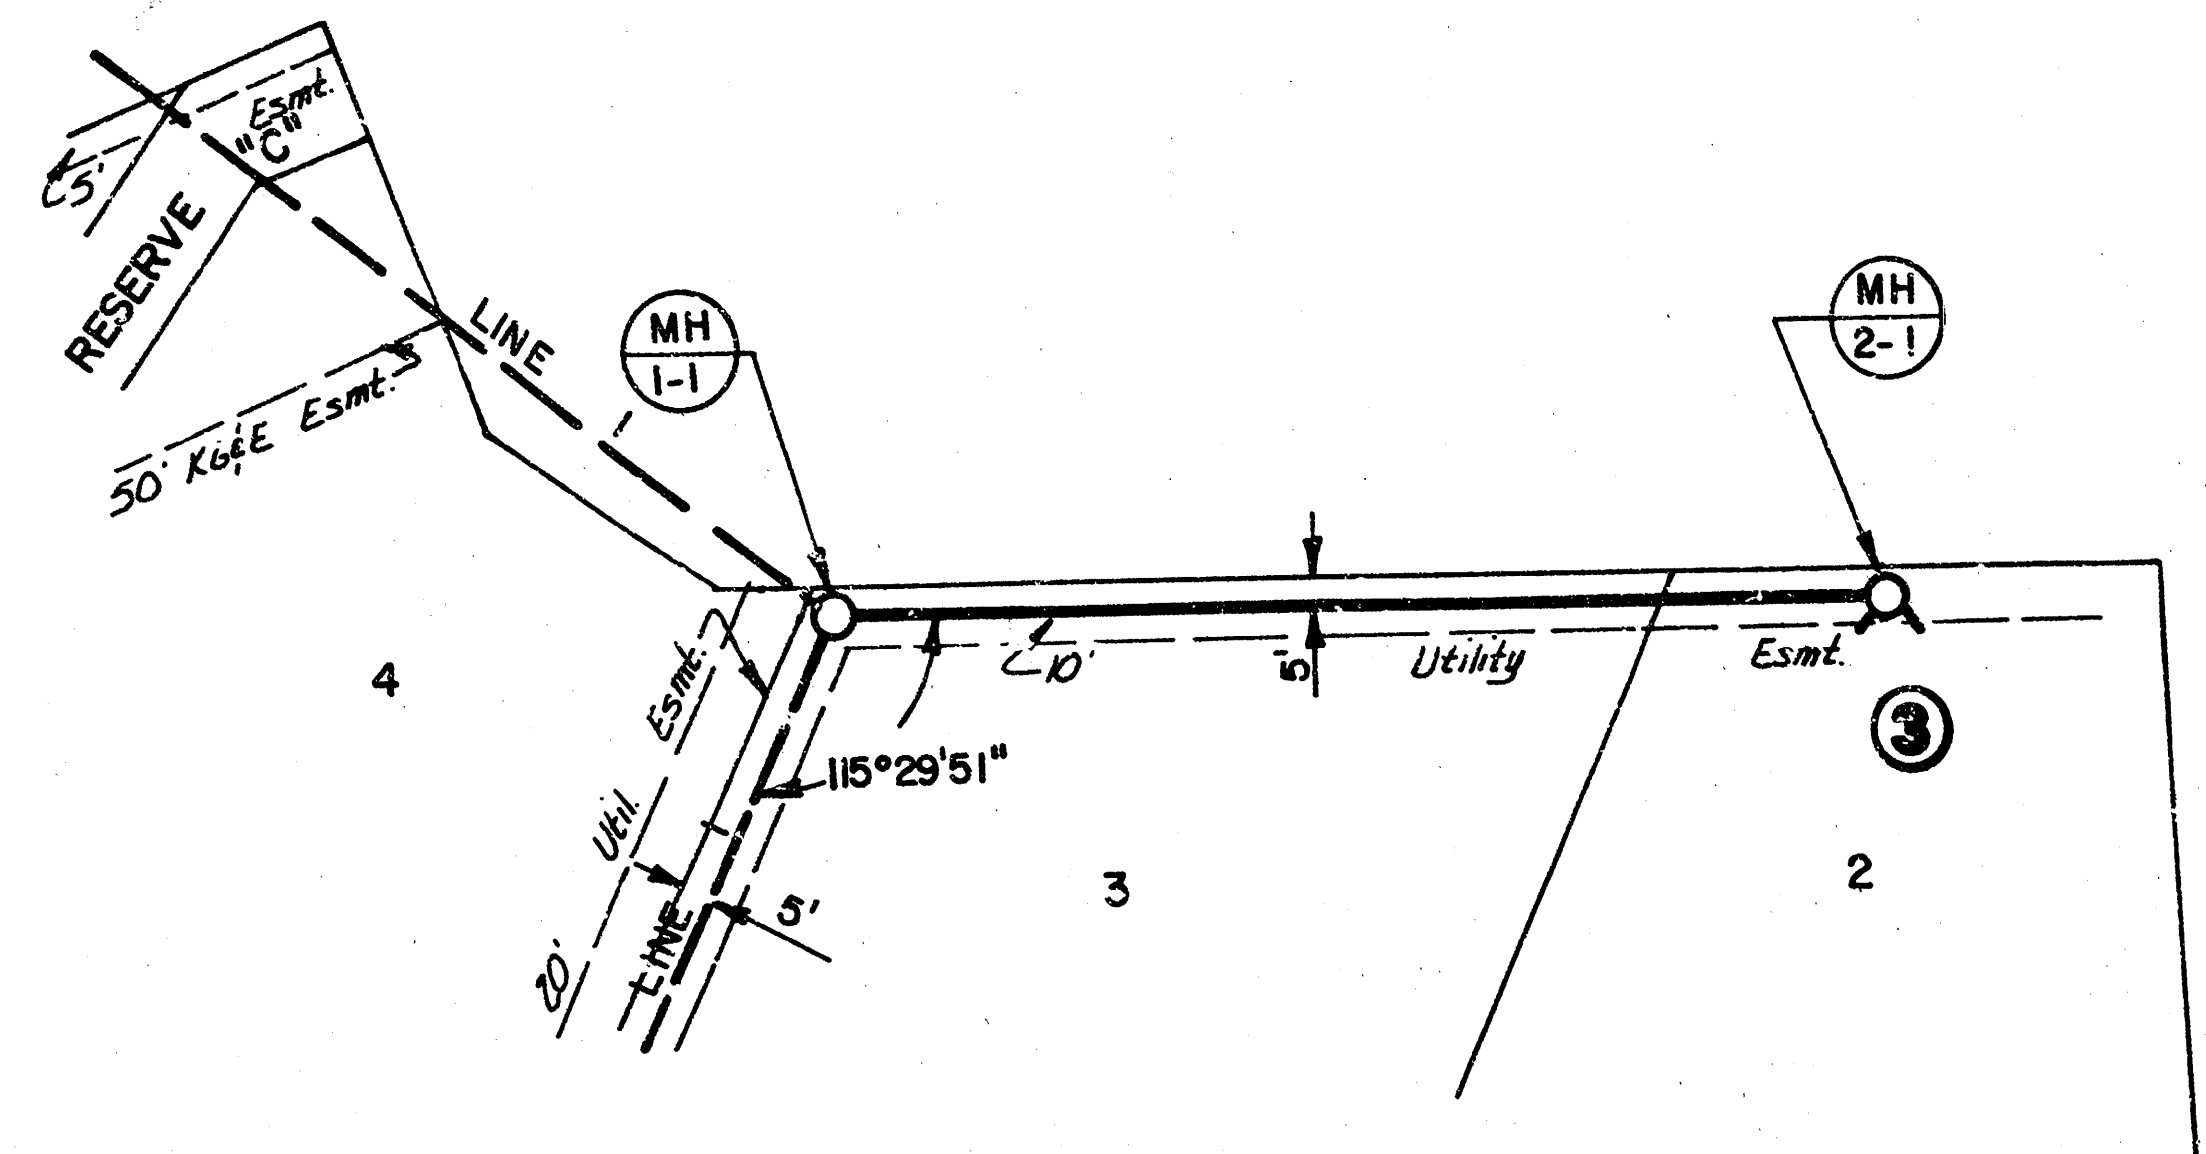

PLAN LINE 2

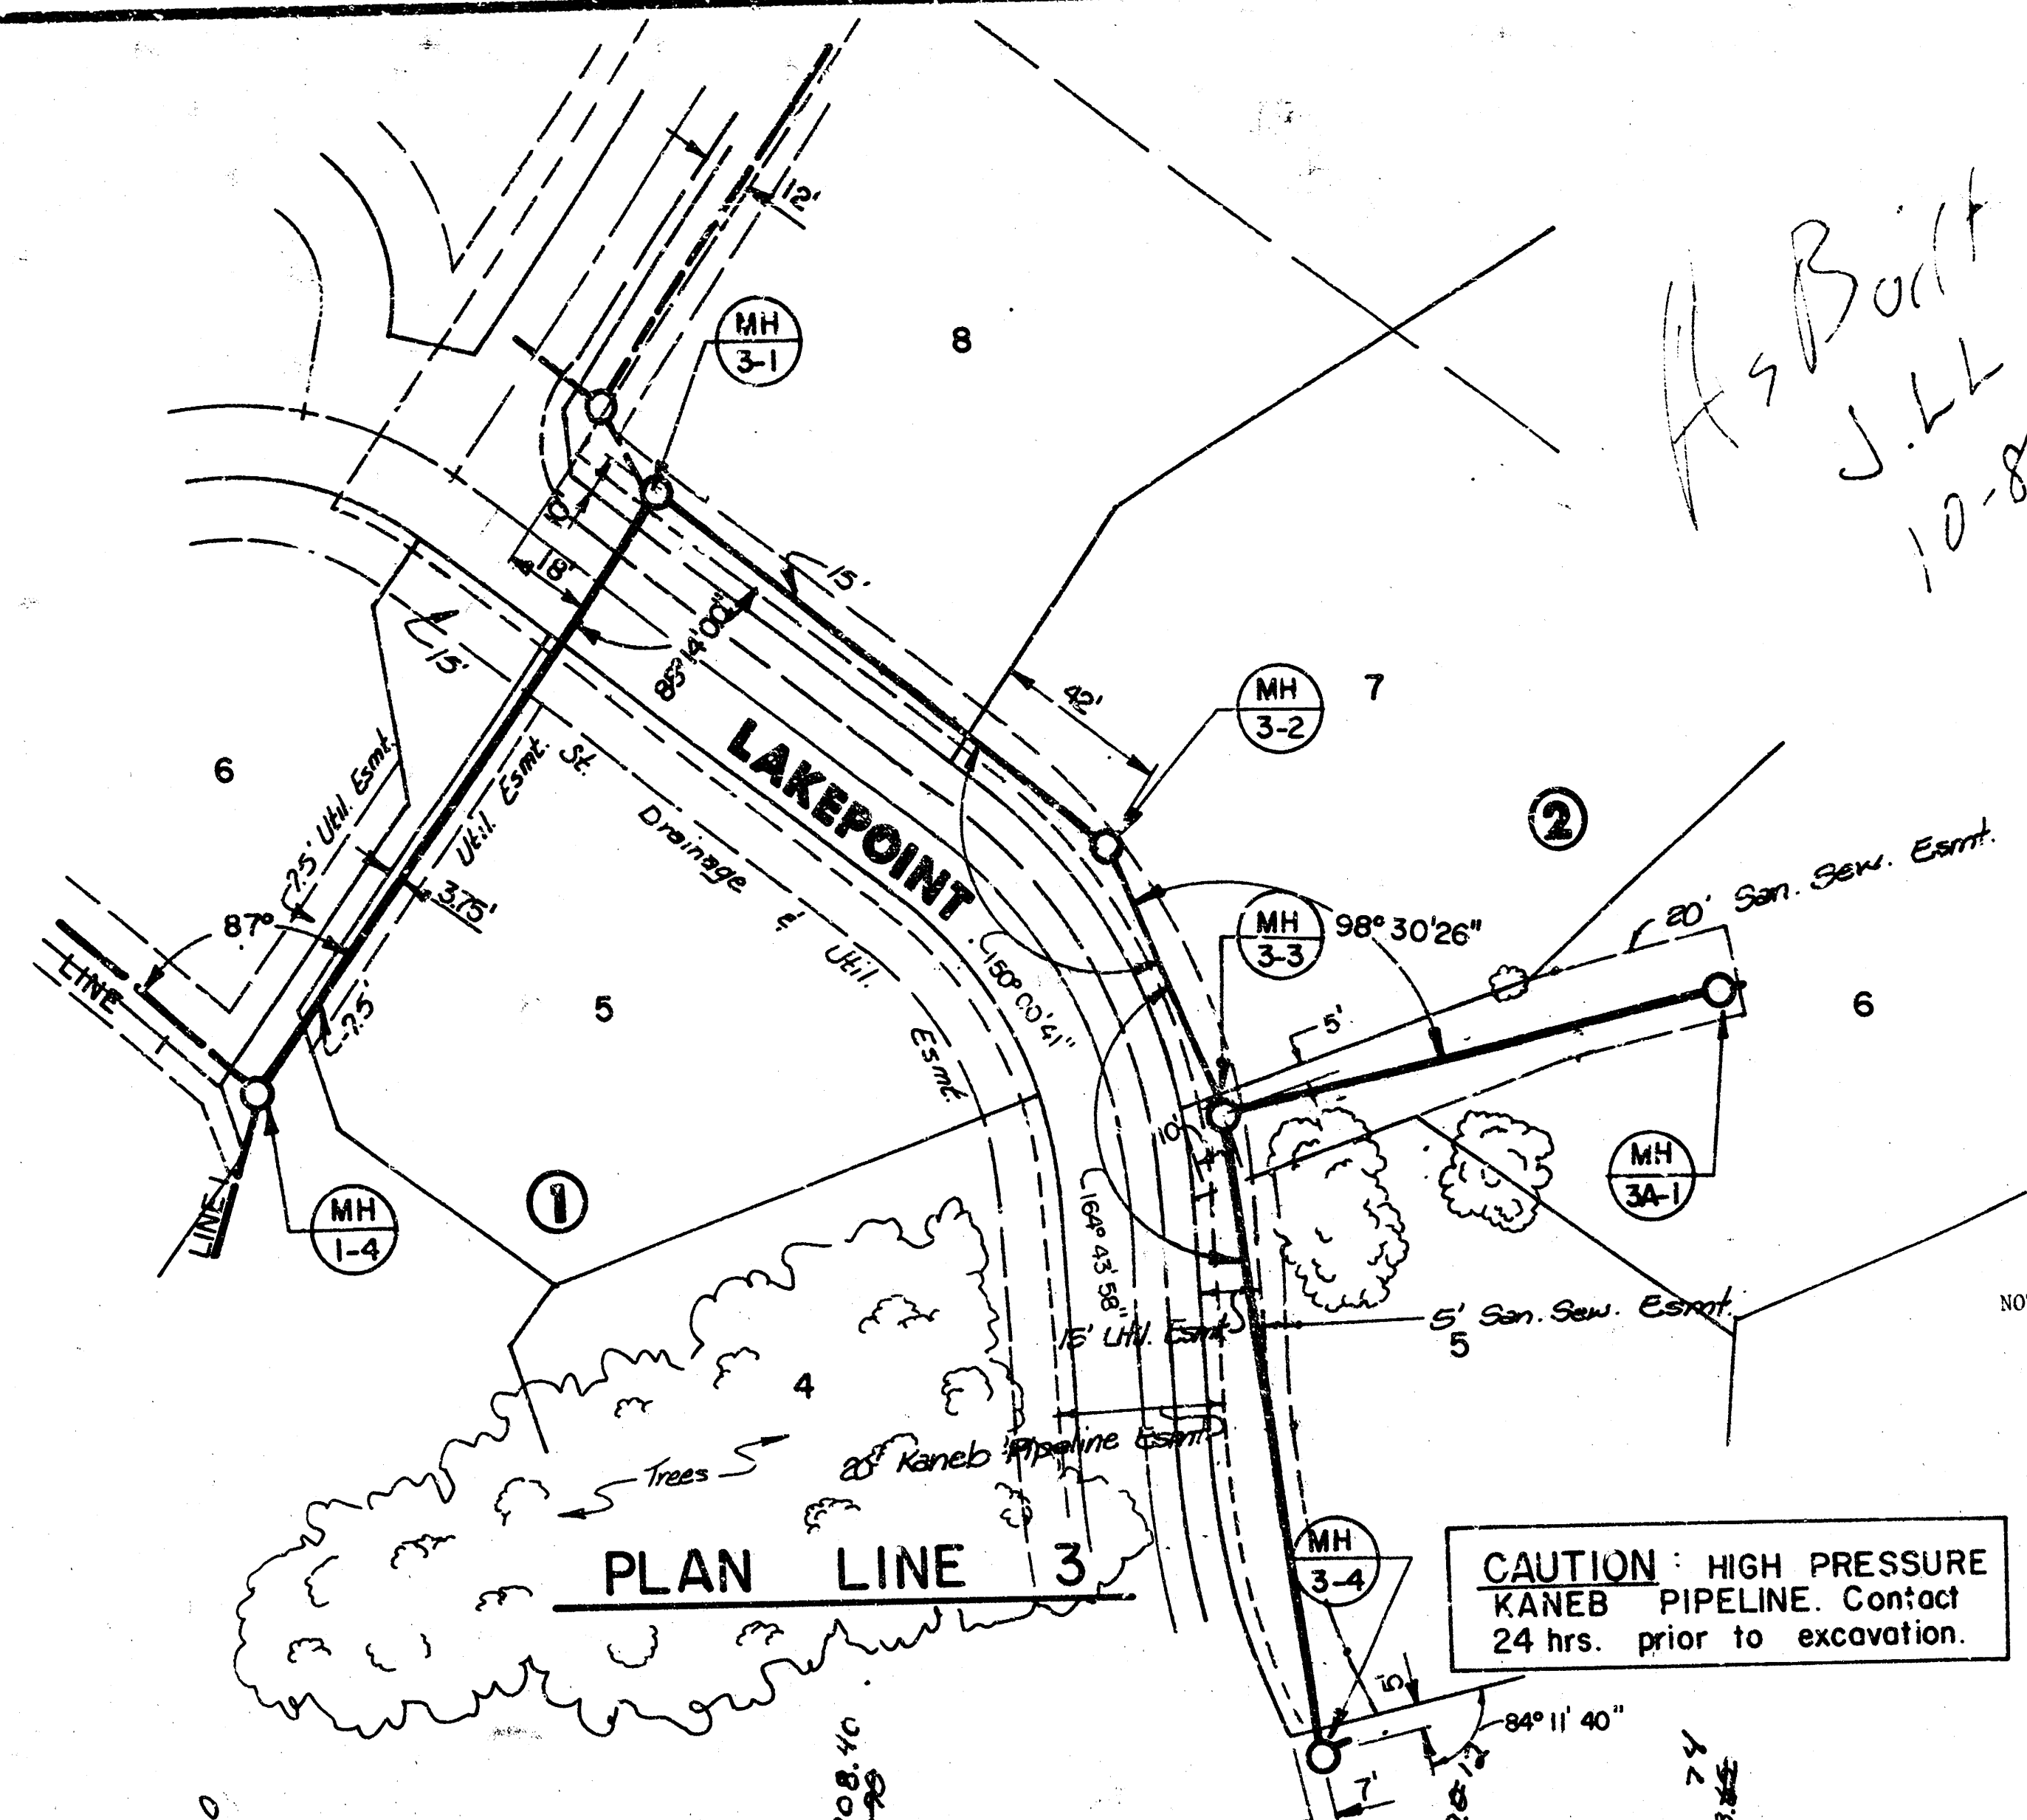


PLAN LINE 3

NOTE: Contractor shall not remove any trees shown on this sheet without the written consent of the City. Any trees removed shall be replaced in size and type.
Date: 7-20-83

CAUTION: HIGH PRESSURE KANAB PIPELINE. Contact 24 hrs. prior to excavation.


BM 3 Square cut on southeast corner of pond dam. Elev. 267.86

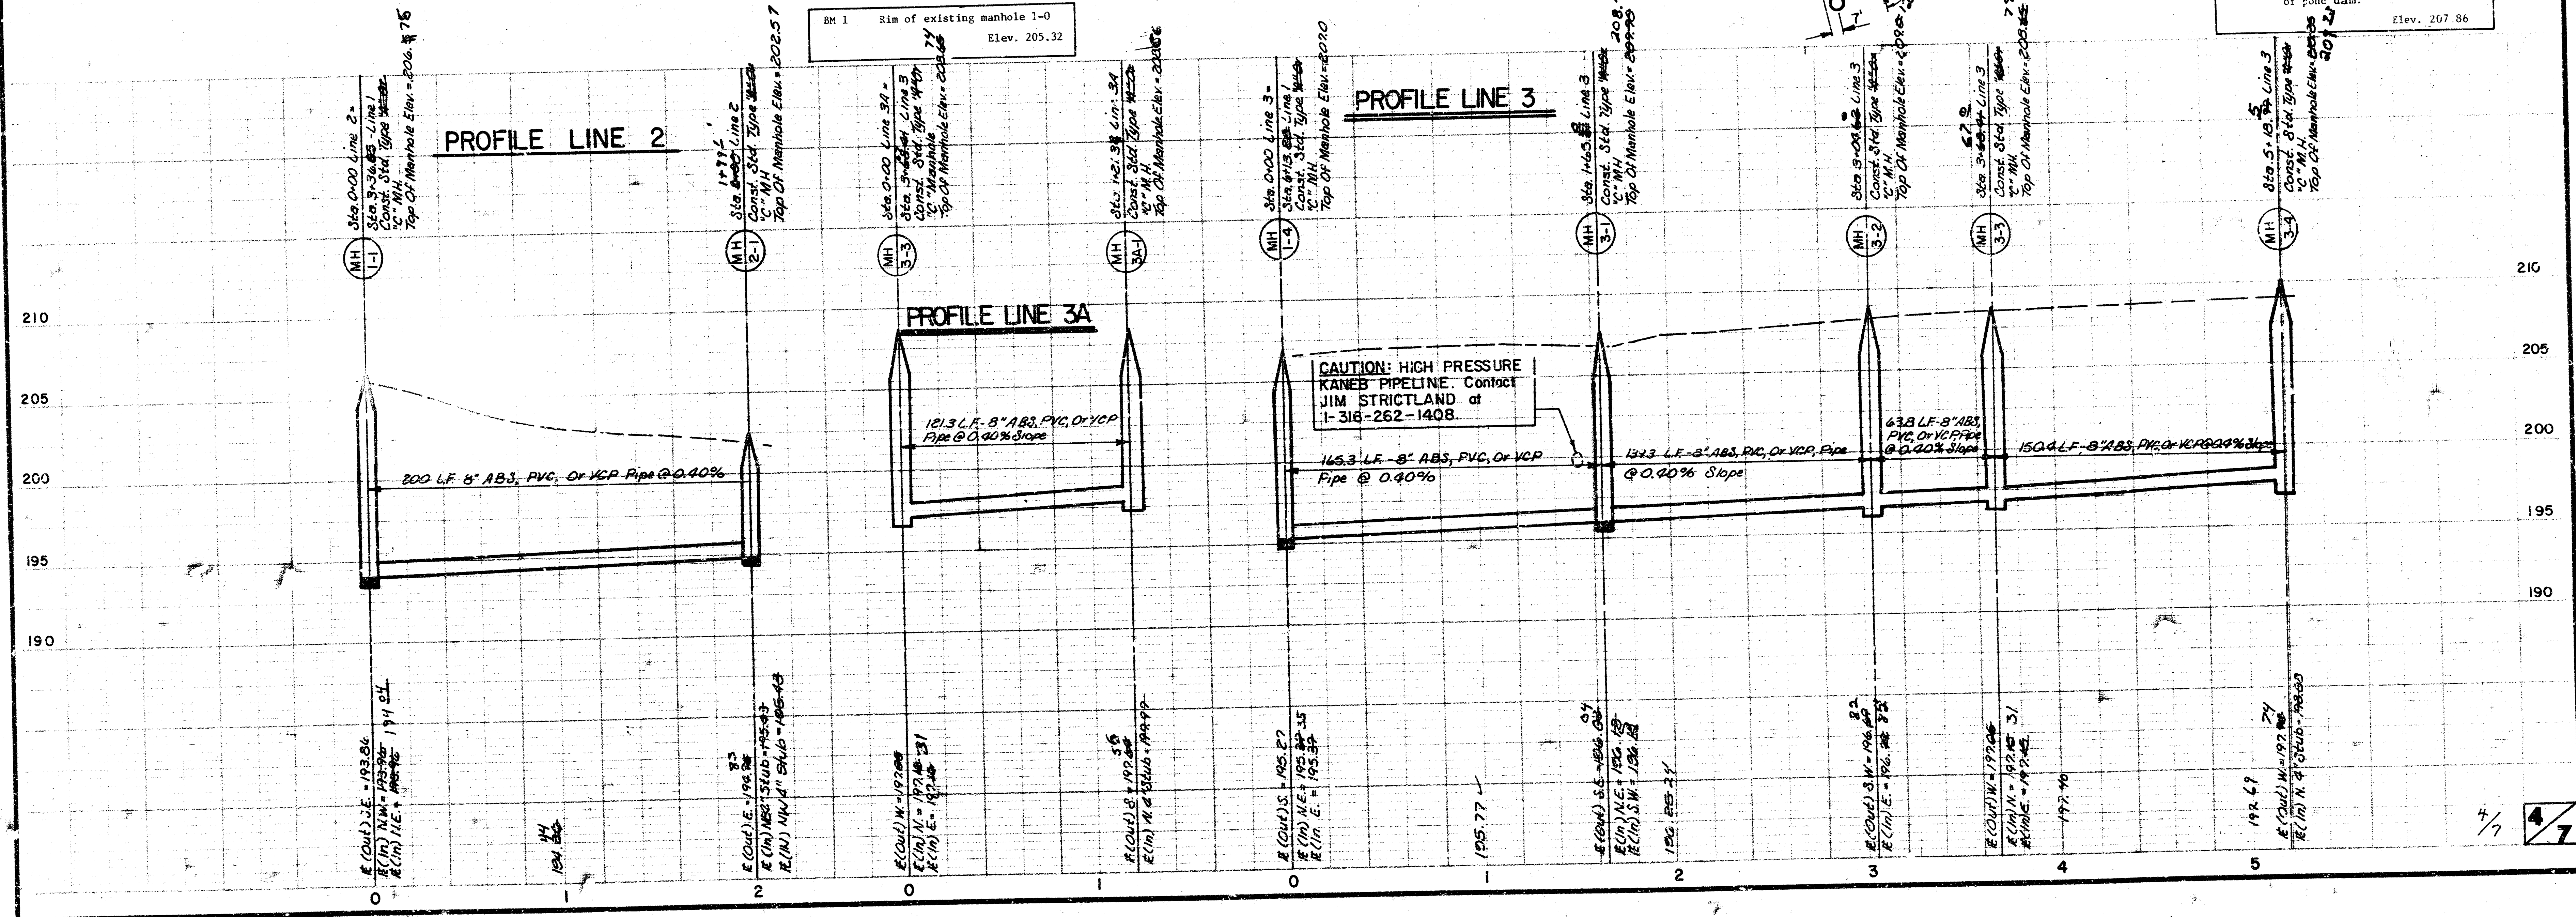

WOODSPRING LAT 20, MAIN 22, W.I.S.
PROJECT NO.
468-76-245 - 81263 - 000-000-001

THE CONTRACTOR SHALL EXCAVATE AND BACKFILL FOR THE ENCASMENT OF THE KANEB PIPELINE. THE KANEB PIPELINE COMPANY WILL INSTALL THE ENCASMENT PIPE AROUND THEIR PIPE. CONTRACTOR SHALL BE PAID FOR EXPOSING THE PIPE AND BACKFILL ONLY.


*As Built
J.L.L.
10-83*

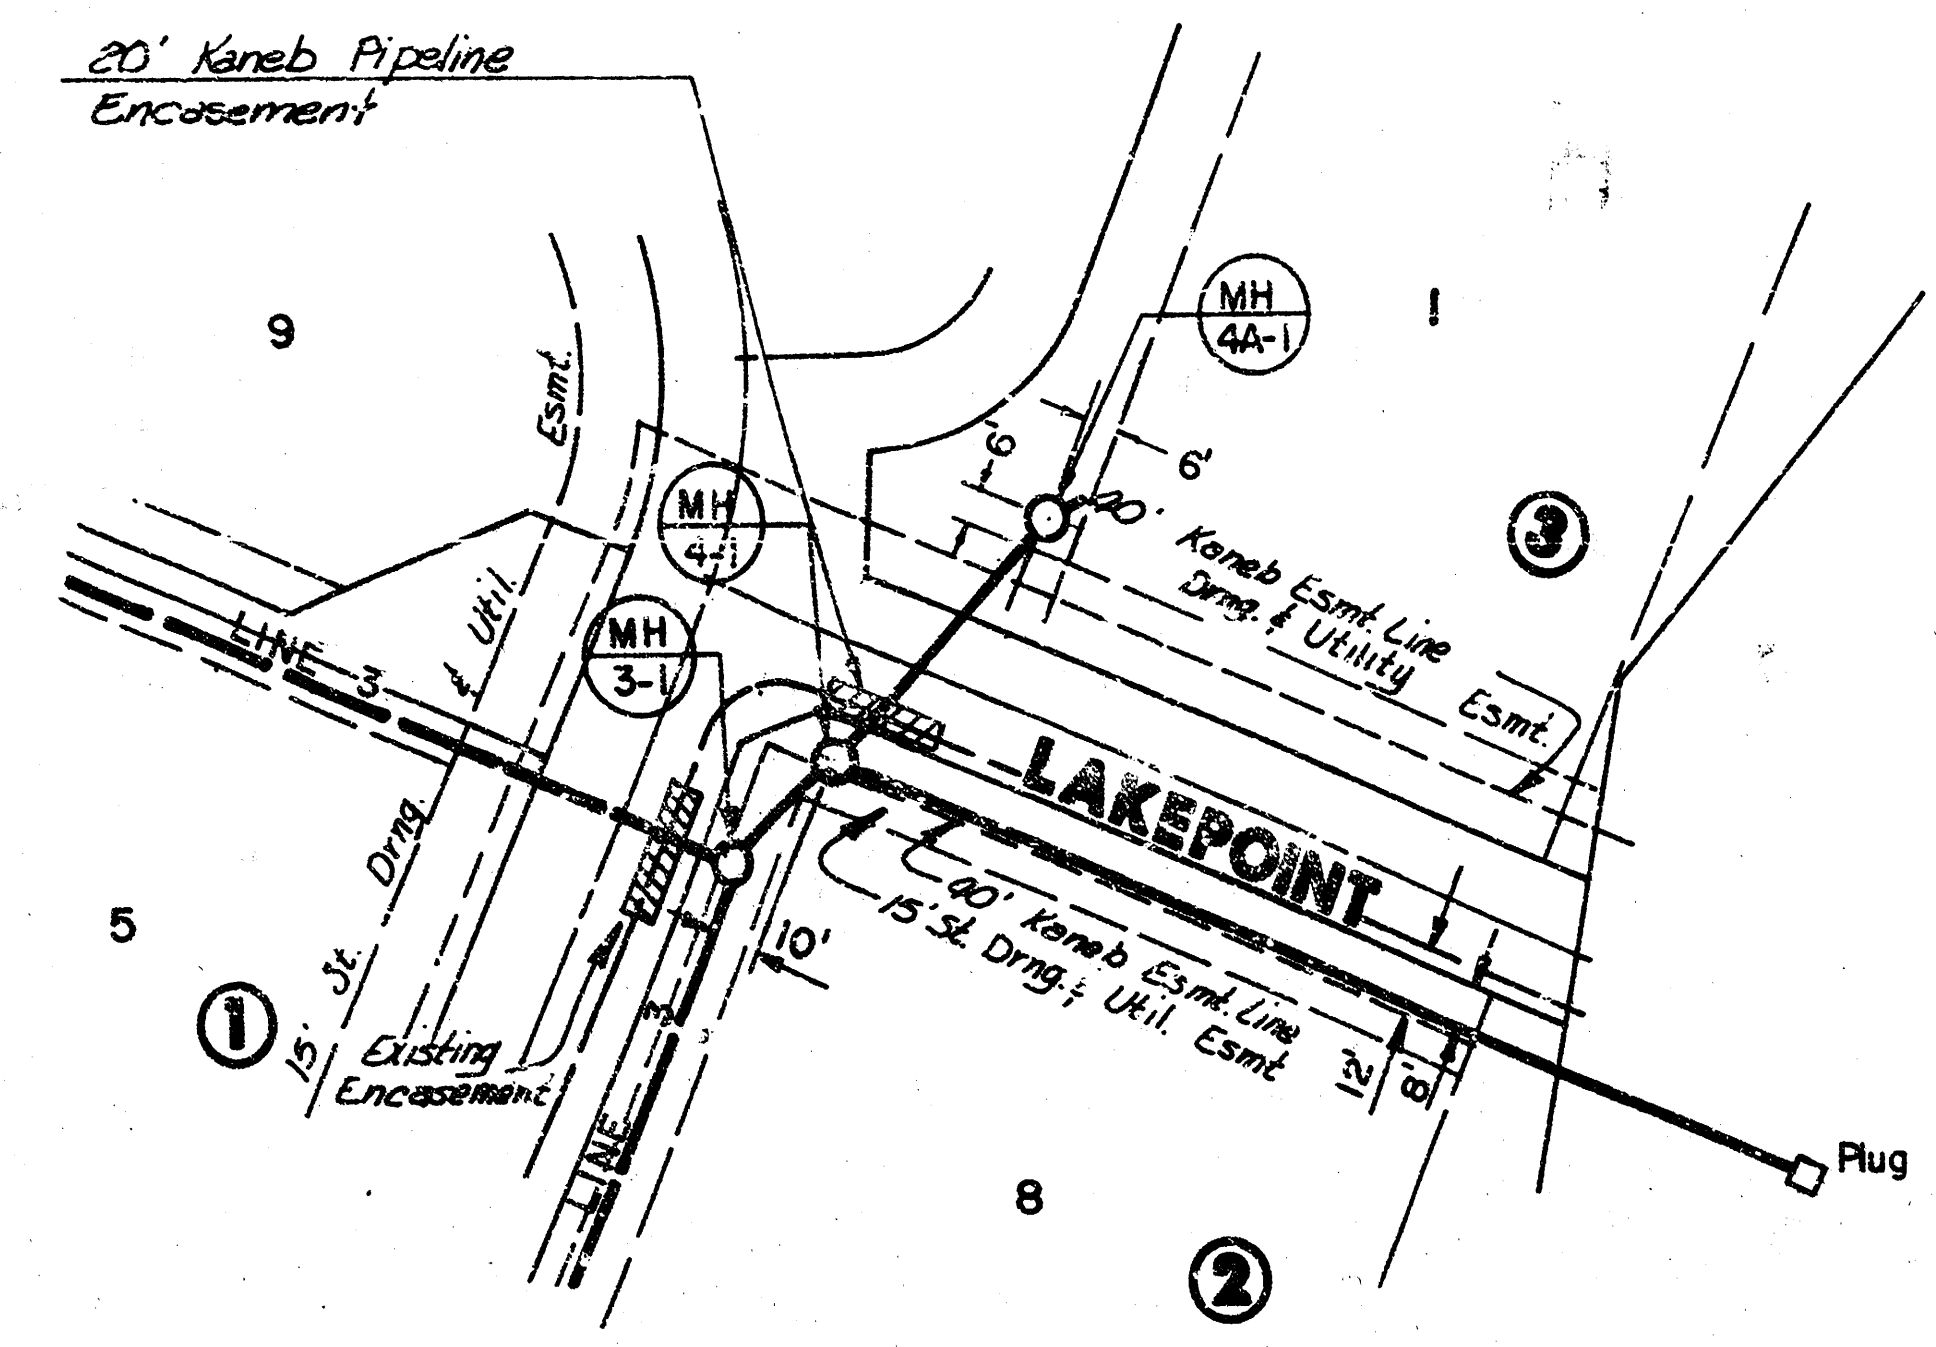


PLAN LINE 4&4A

CAUTION: HIGH PRESSURE KANEB PIPELINE CONTACT 24 HRS PRIOR TO EXCAVATION


NOTE: Design Water Surface Elev. = 206.70 (100 Yr.)

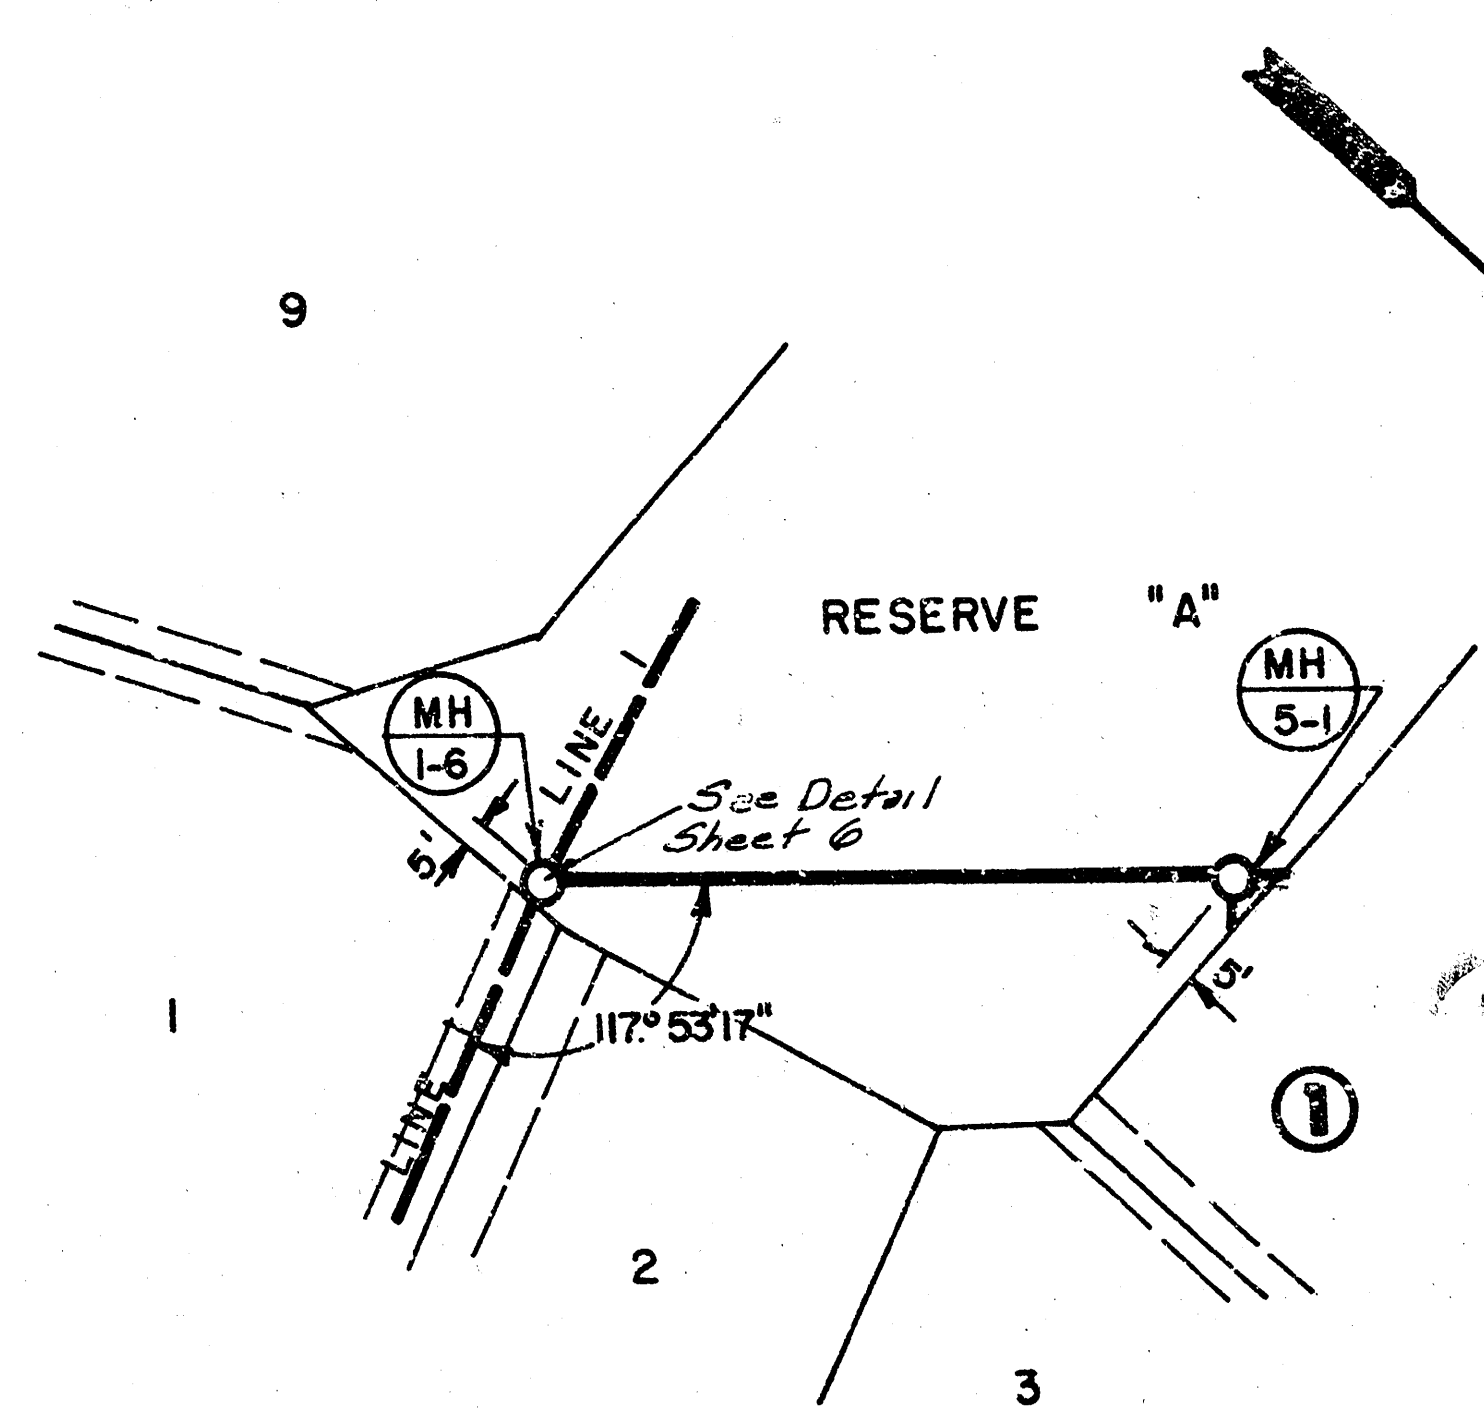

PLAN LINE 5

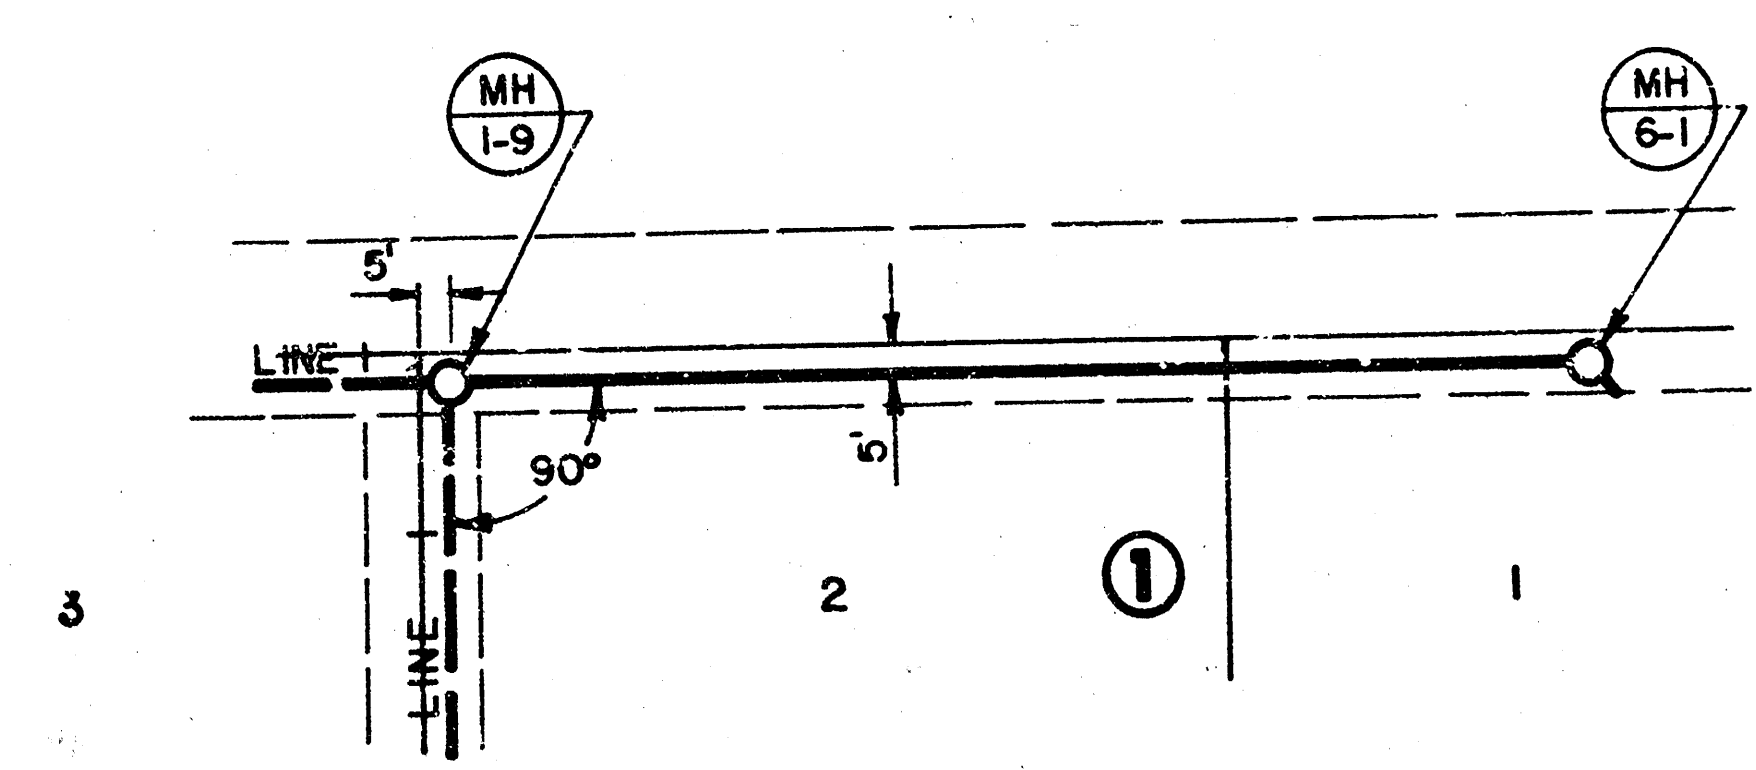


PLAN LINE 6

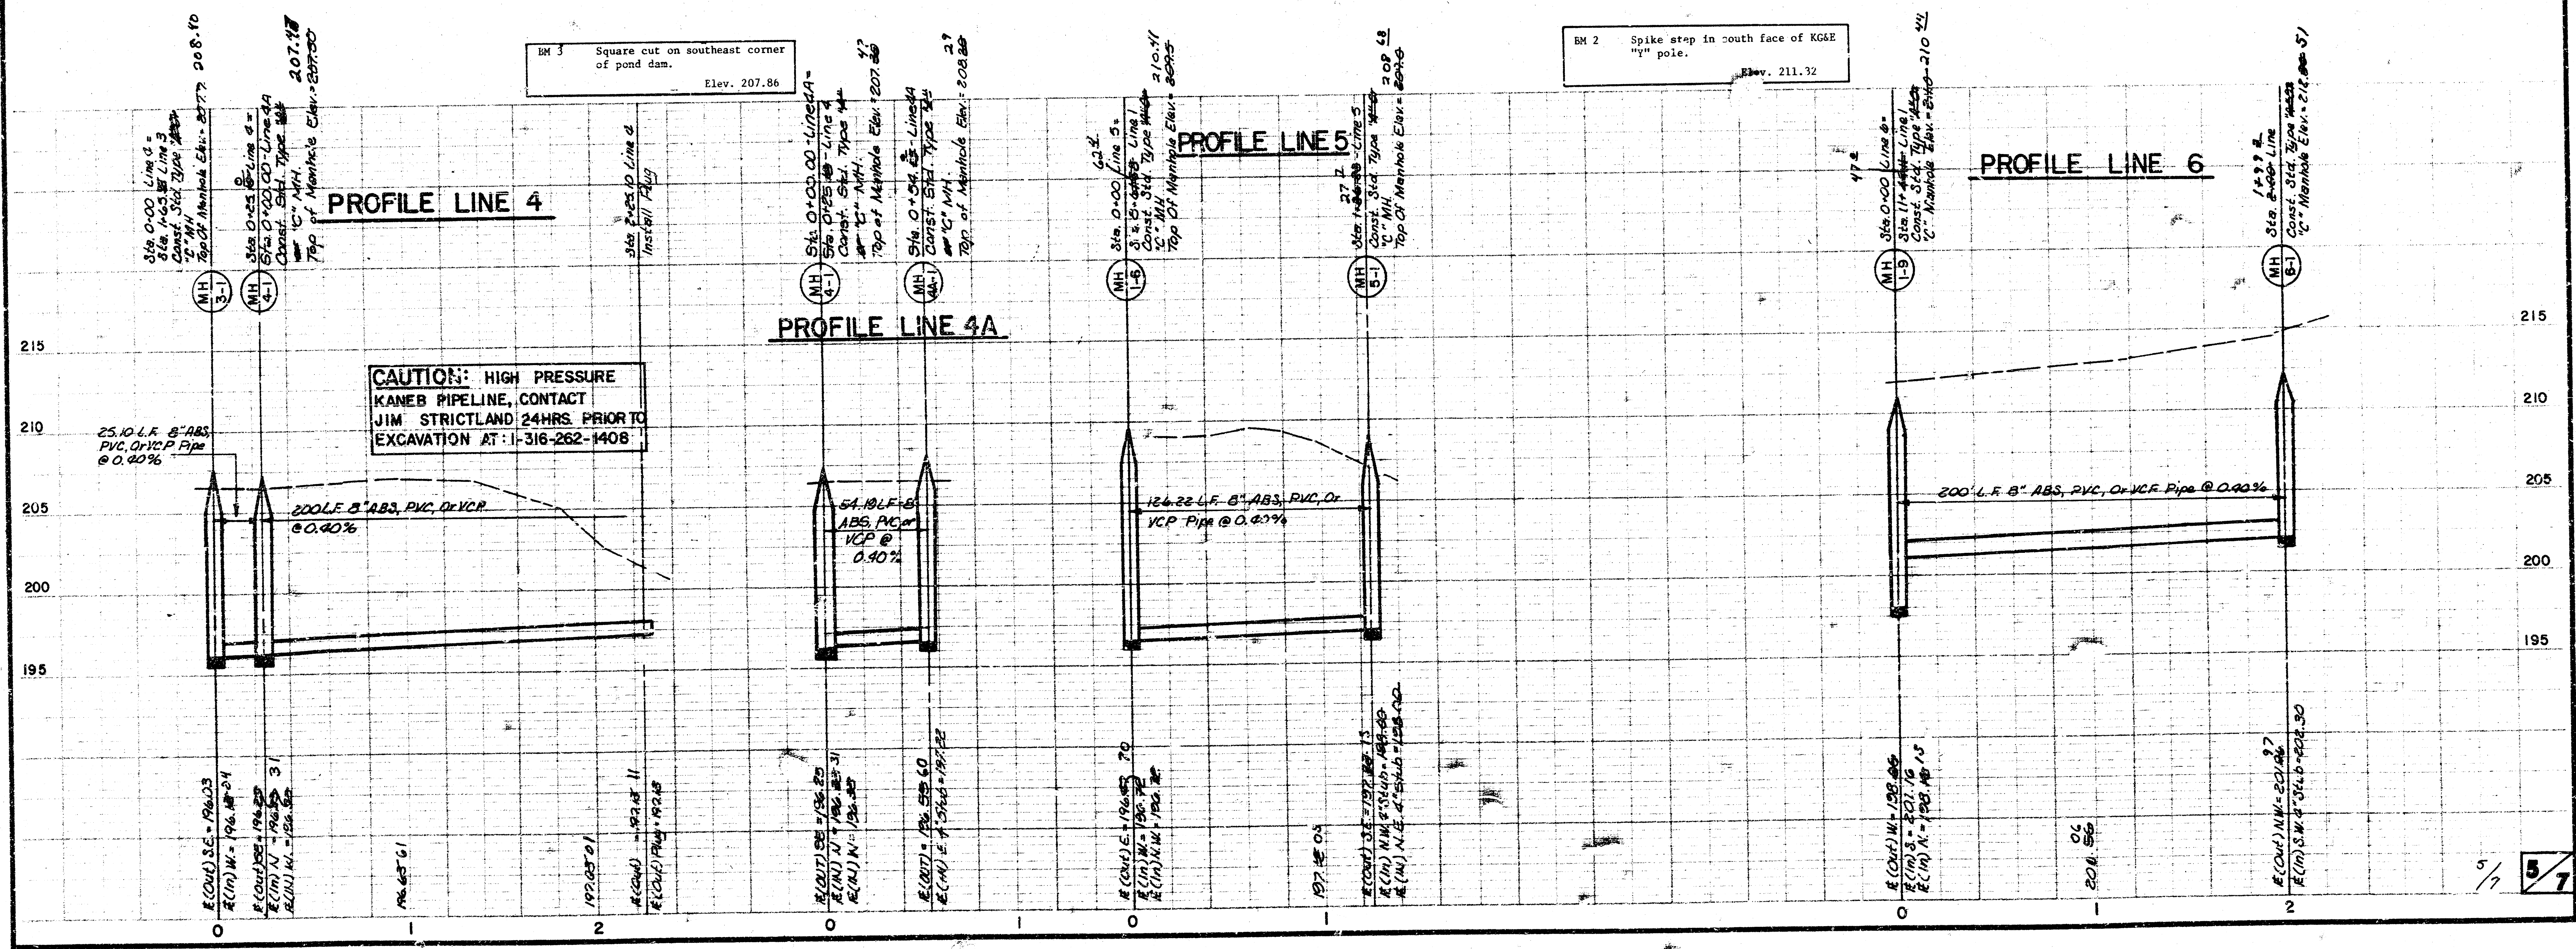

CAUTION: HIGH PRESSURE KANEB PIPELINE, CONTACT JIM STRICTLAND 24HRS. PRIOR TO EXCAVATION AT: 1-316-262-1408

TYPE "A" MANHOLE

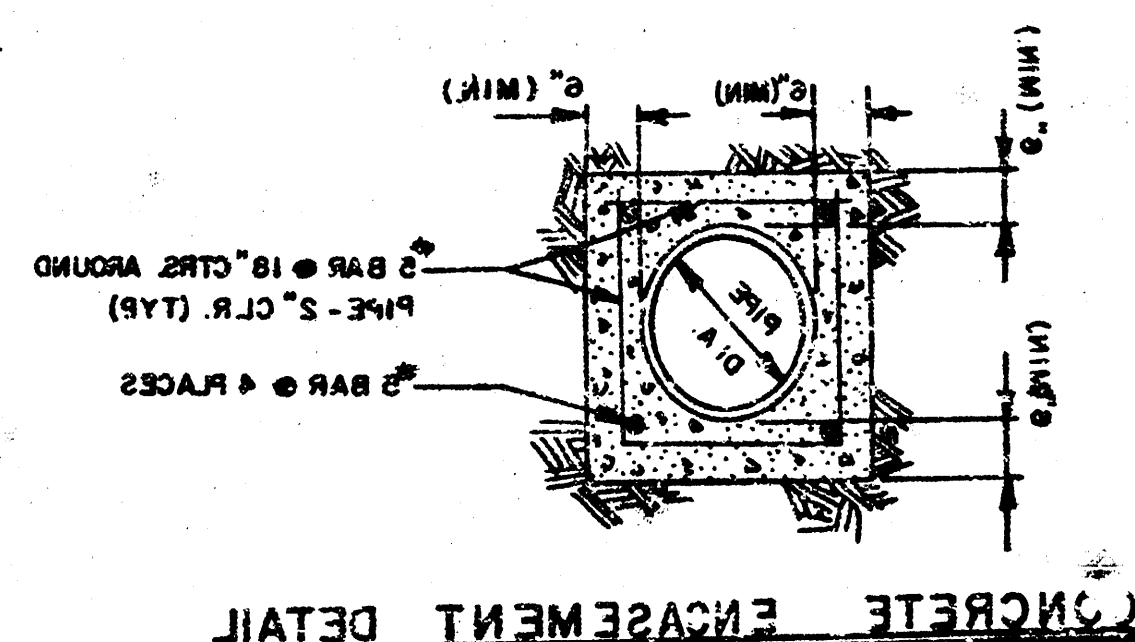

CONCRETE ENCASMENT DETAIL


GROUP DETAIL OF MH 1-6

FINAL PLAT OF

AN ADDITION TO WICHITA, SEDGWICK COUNTY, KANSAS

CAUTION:

Jim Strickland At 1-316-262-1408.
Contact SA Prior To Excavation Call
High Pressure KANE Pipeline.

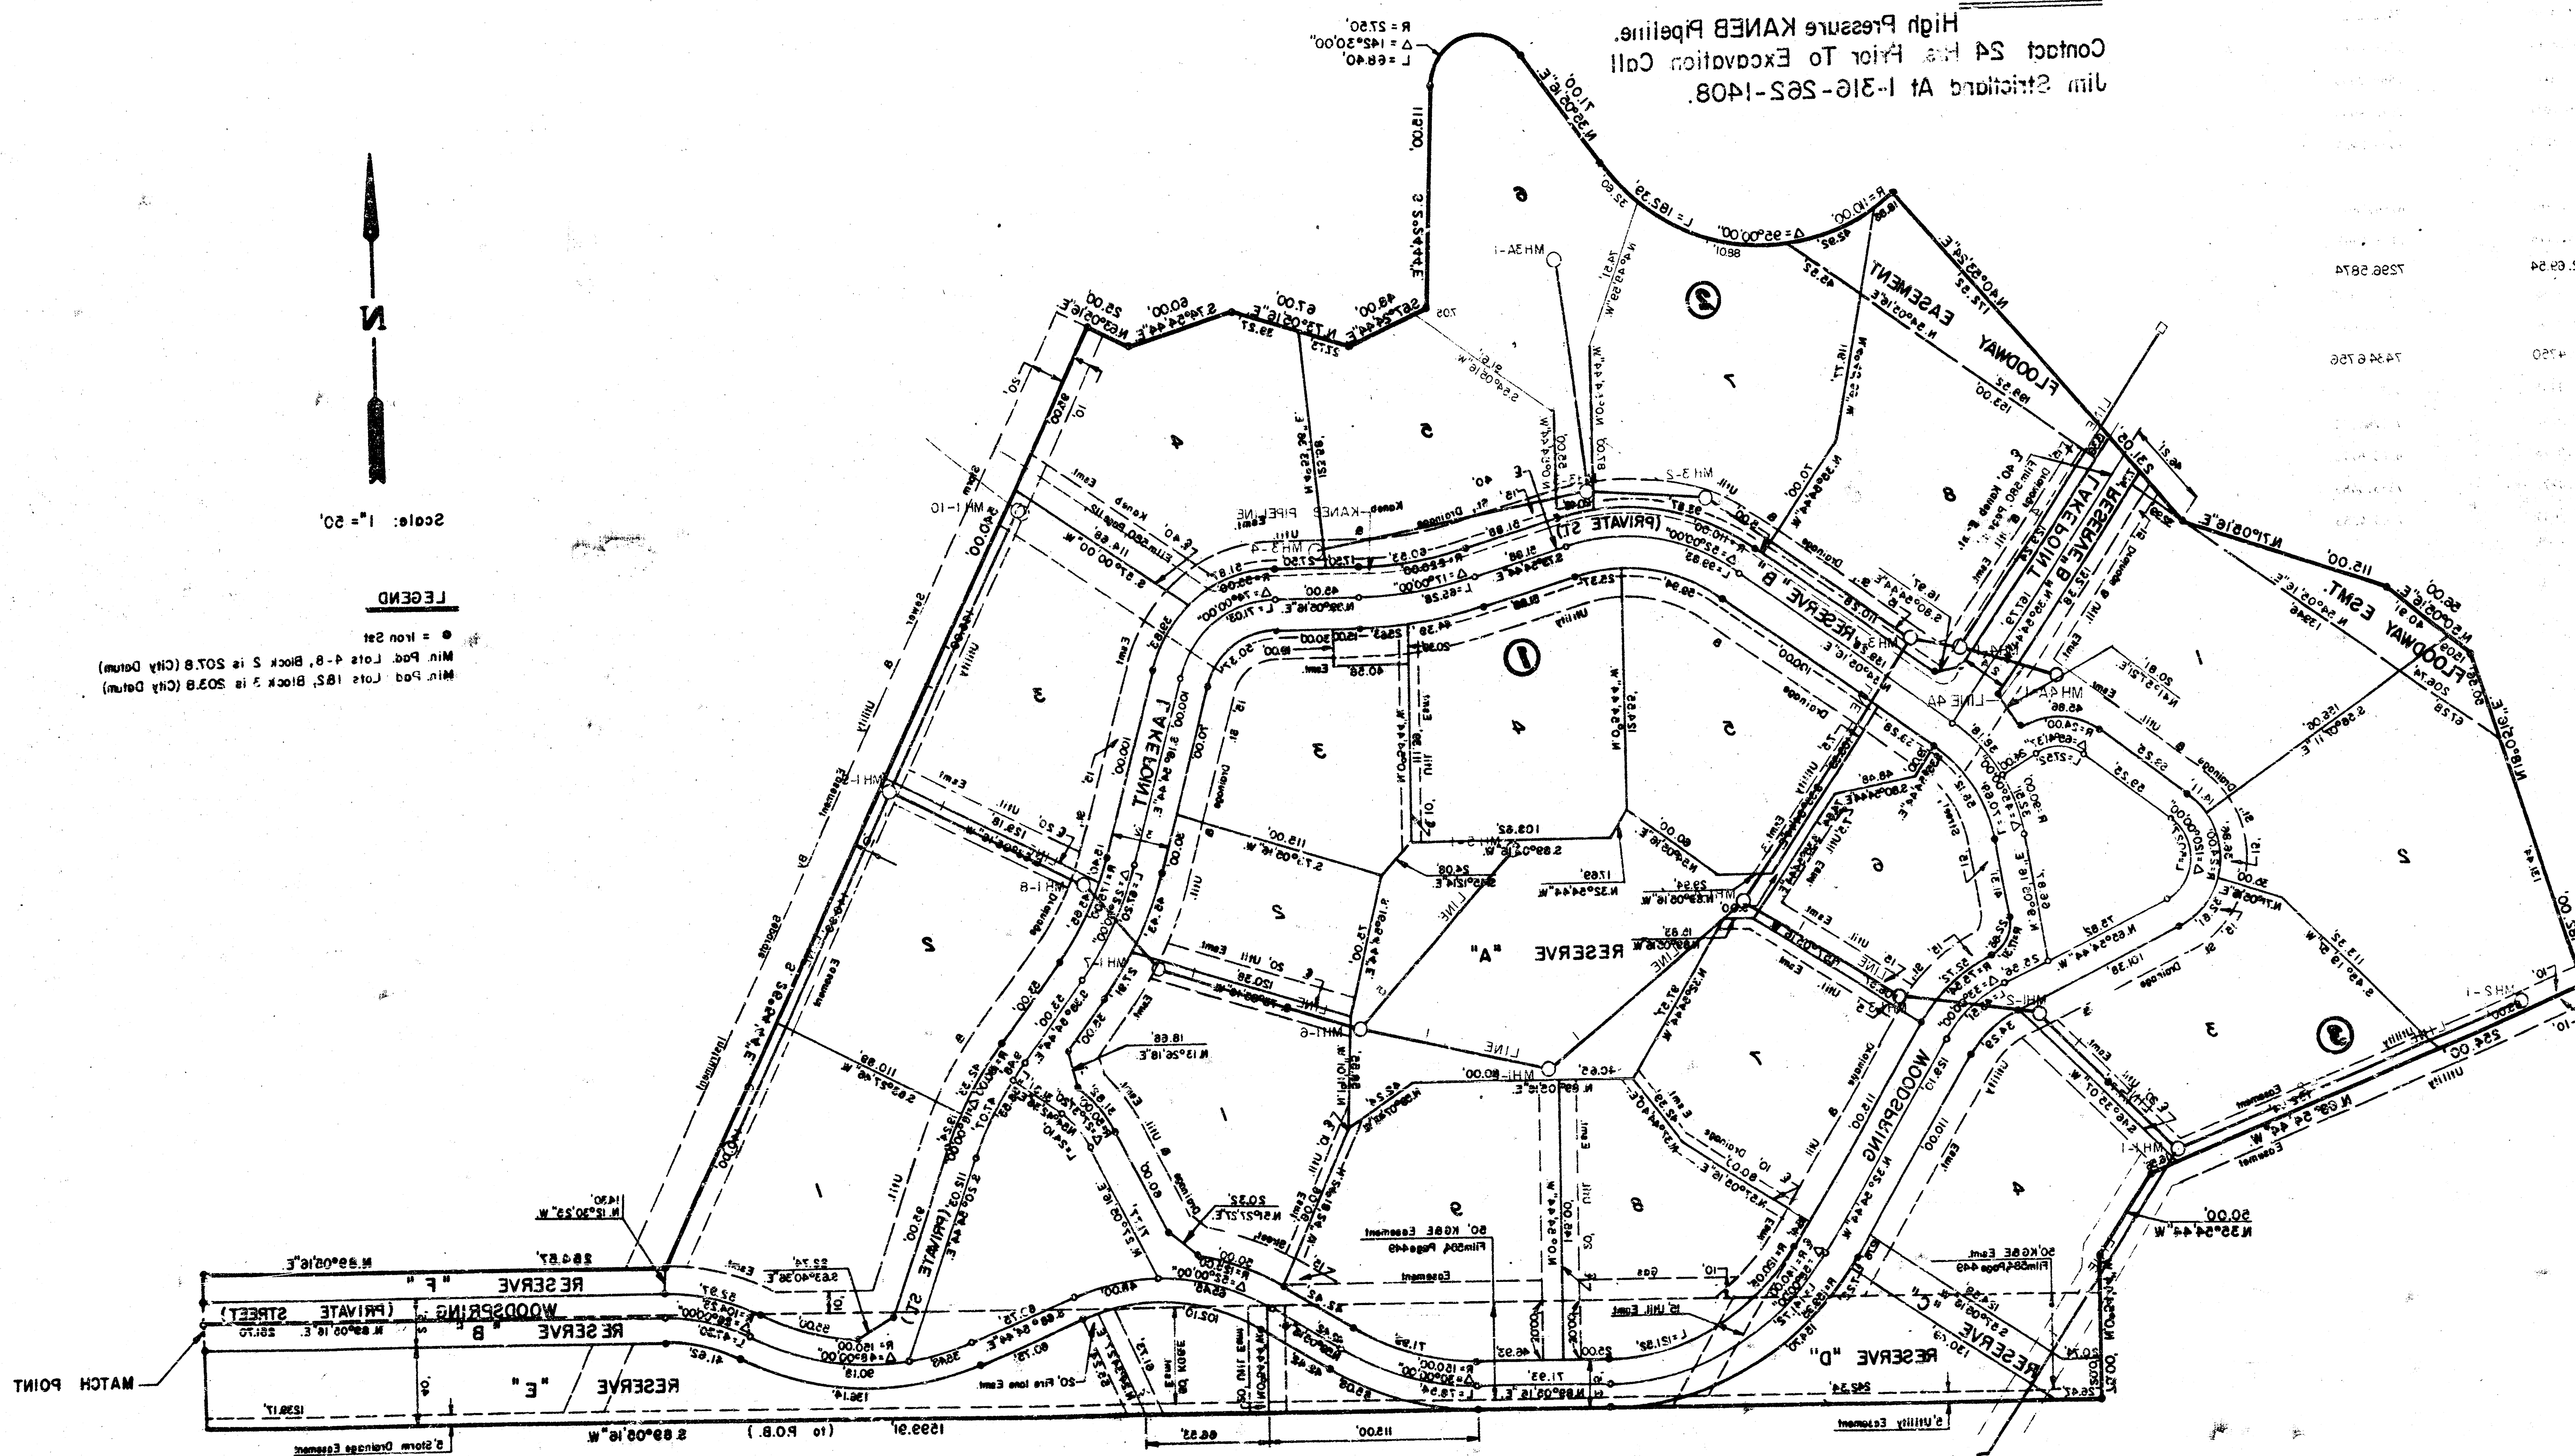

● = Iron Set

Scale: 1" = 20'

W

FILMED FROM THE BEST
AVAILABLE COPY

14 4 1 12