

# LATERAL 33 MAIN 22 WIS



## PROJECT NO. 468-76-245-81368-000-000-001

### TO SERVE LOT 1, SECURITY STORAGE PROPERTIES ADDITION

#### GENERAL NOTES


The contractor shall coordinate the construction of this project with the construction and contractor of S.W.S. No. 266 which also is to serve this property.

The contractor shall contact the necessary utility companies in order to have any underground utilities located in the field prior to proceeding with construction of this project.

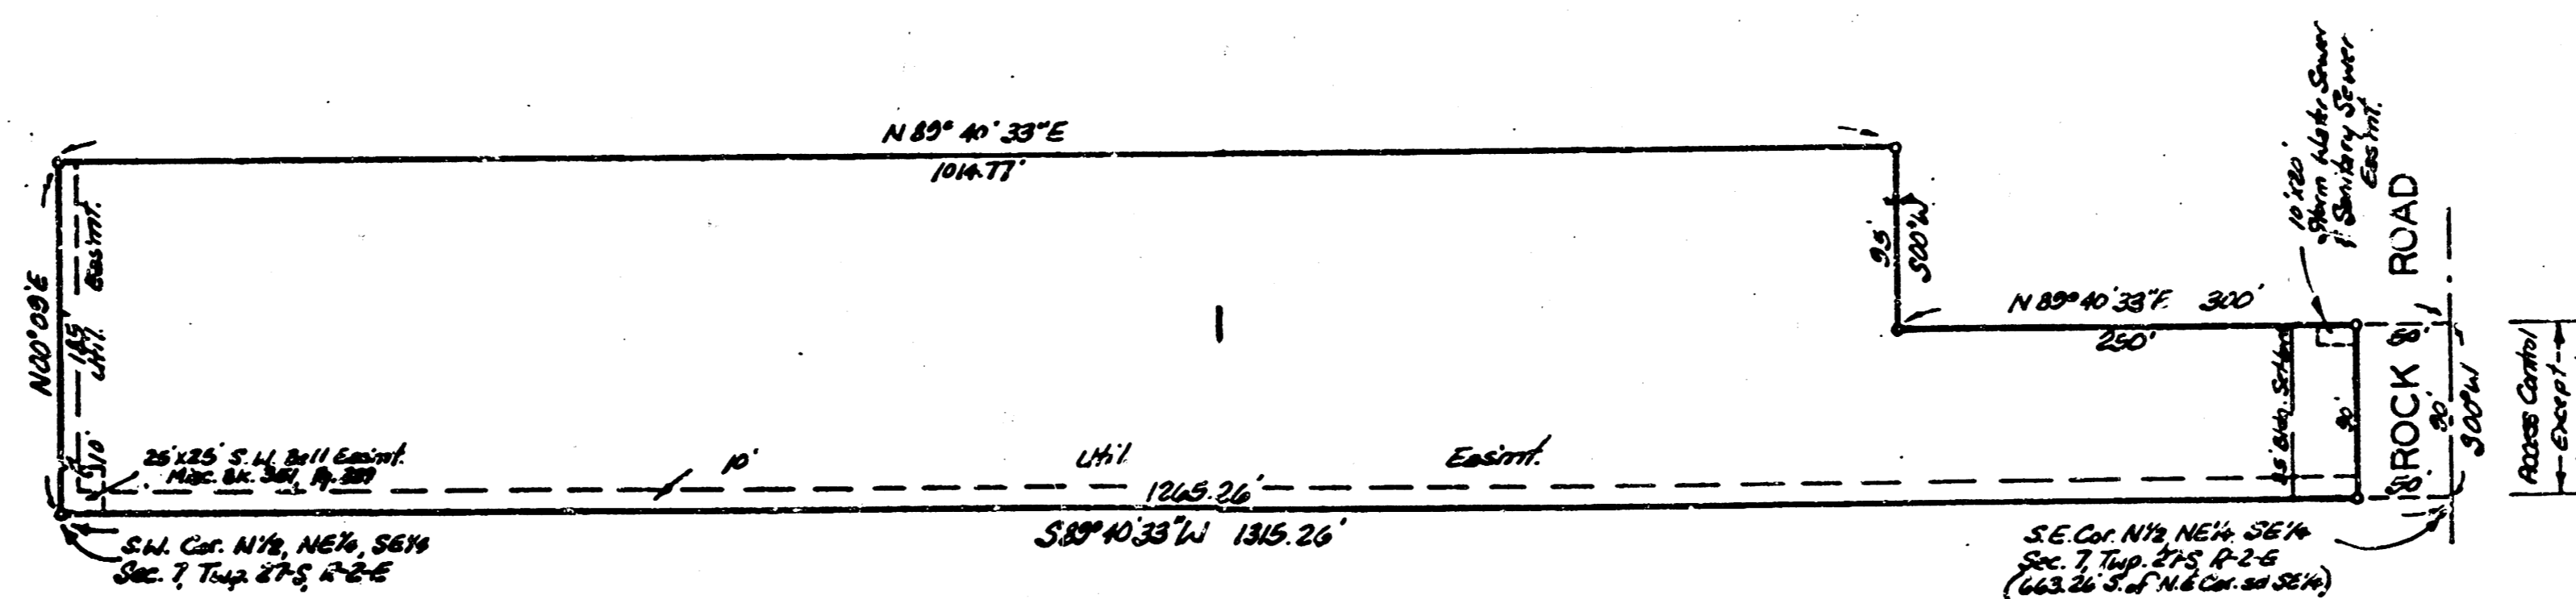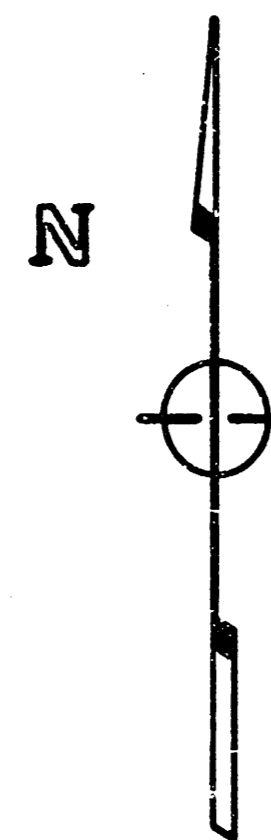

BENEFIT DISTRICT

**CITY OF WICHITA, KANSAS**  
**MICHAEL E. LINDEBAK**  
CITY ENGINEER

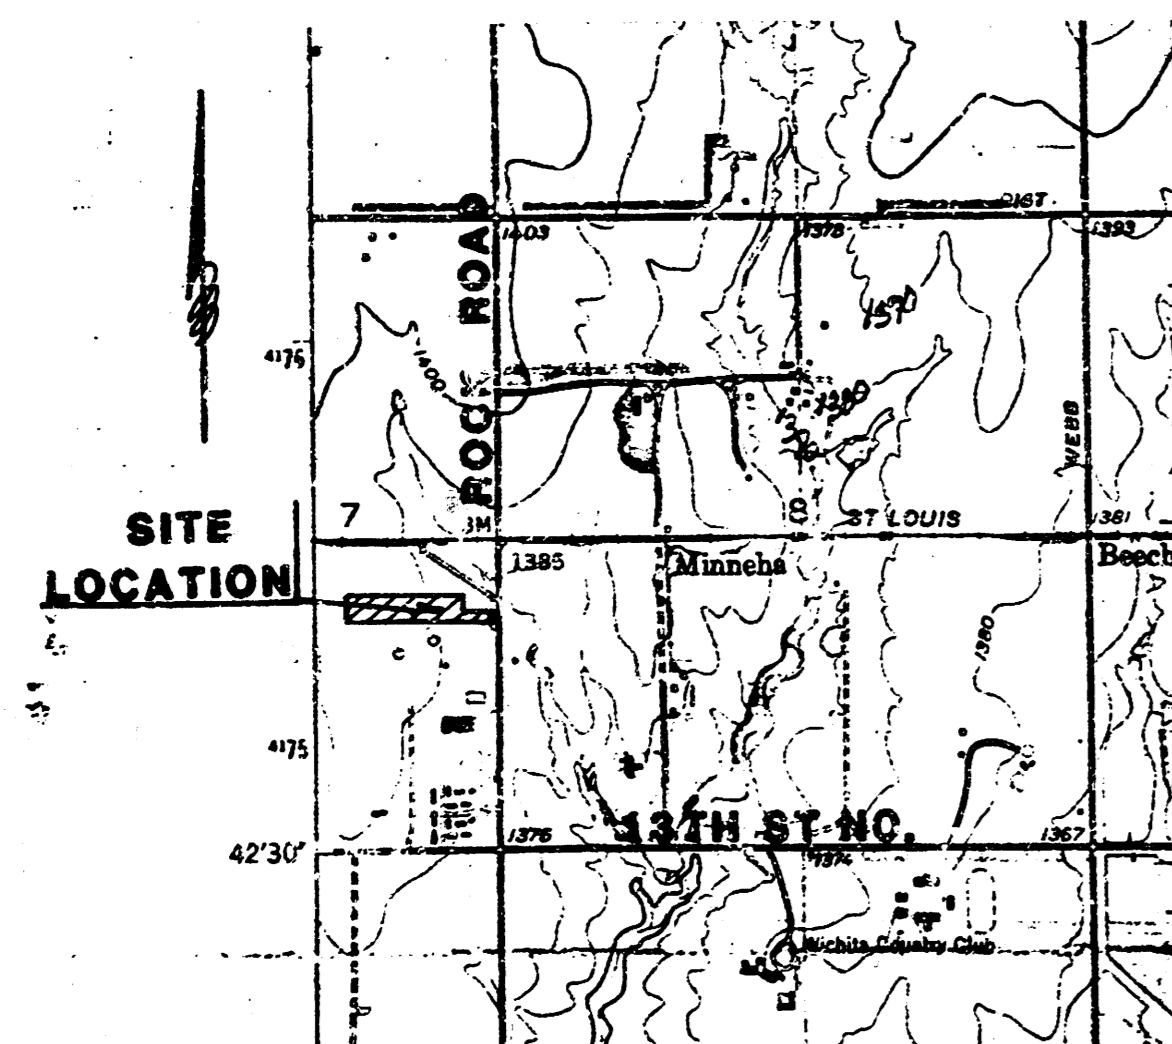

LOCATION MAP




MARCH 1985

**MB BAUGHMAN COMPANY, P.A.**  
SURVEYING & ENGINEERING  
316-262-7271 • 300 LAURA • WICHITA, KANSAS 67211



FILMED FROM THE BEST  
AVAILABLE COPY

BENCH MARK: CITY DISC @ ROCK ROAD & 17TH ST. NORTH 20' E. of @ ROCK ROAD & 61' NORTH OF @ R.R. TRACKS ELEV. = 129.70 CITY DATUM

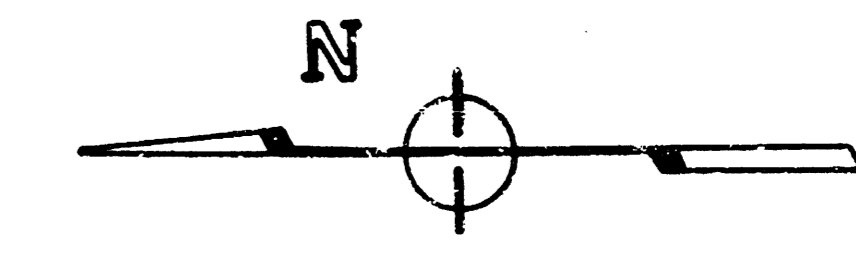

SCALE 1" = 20' HORIZ.  
1" = 5' VERT.

*As Built  
8/82  
7-85*

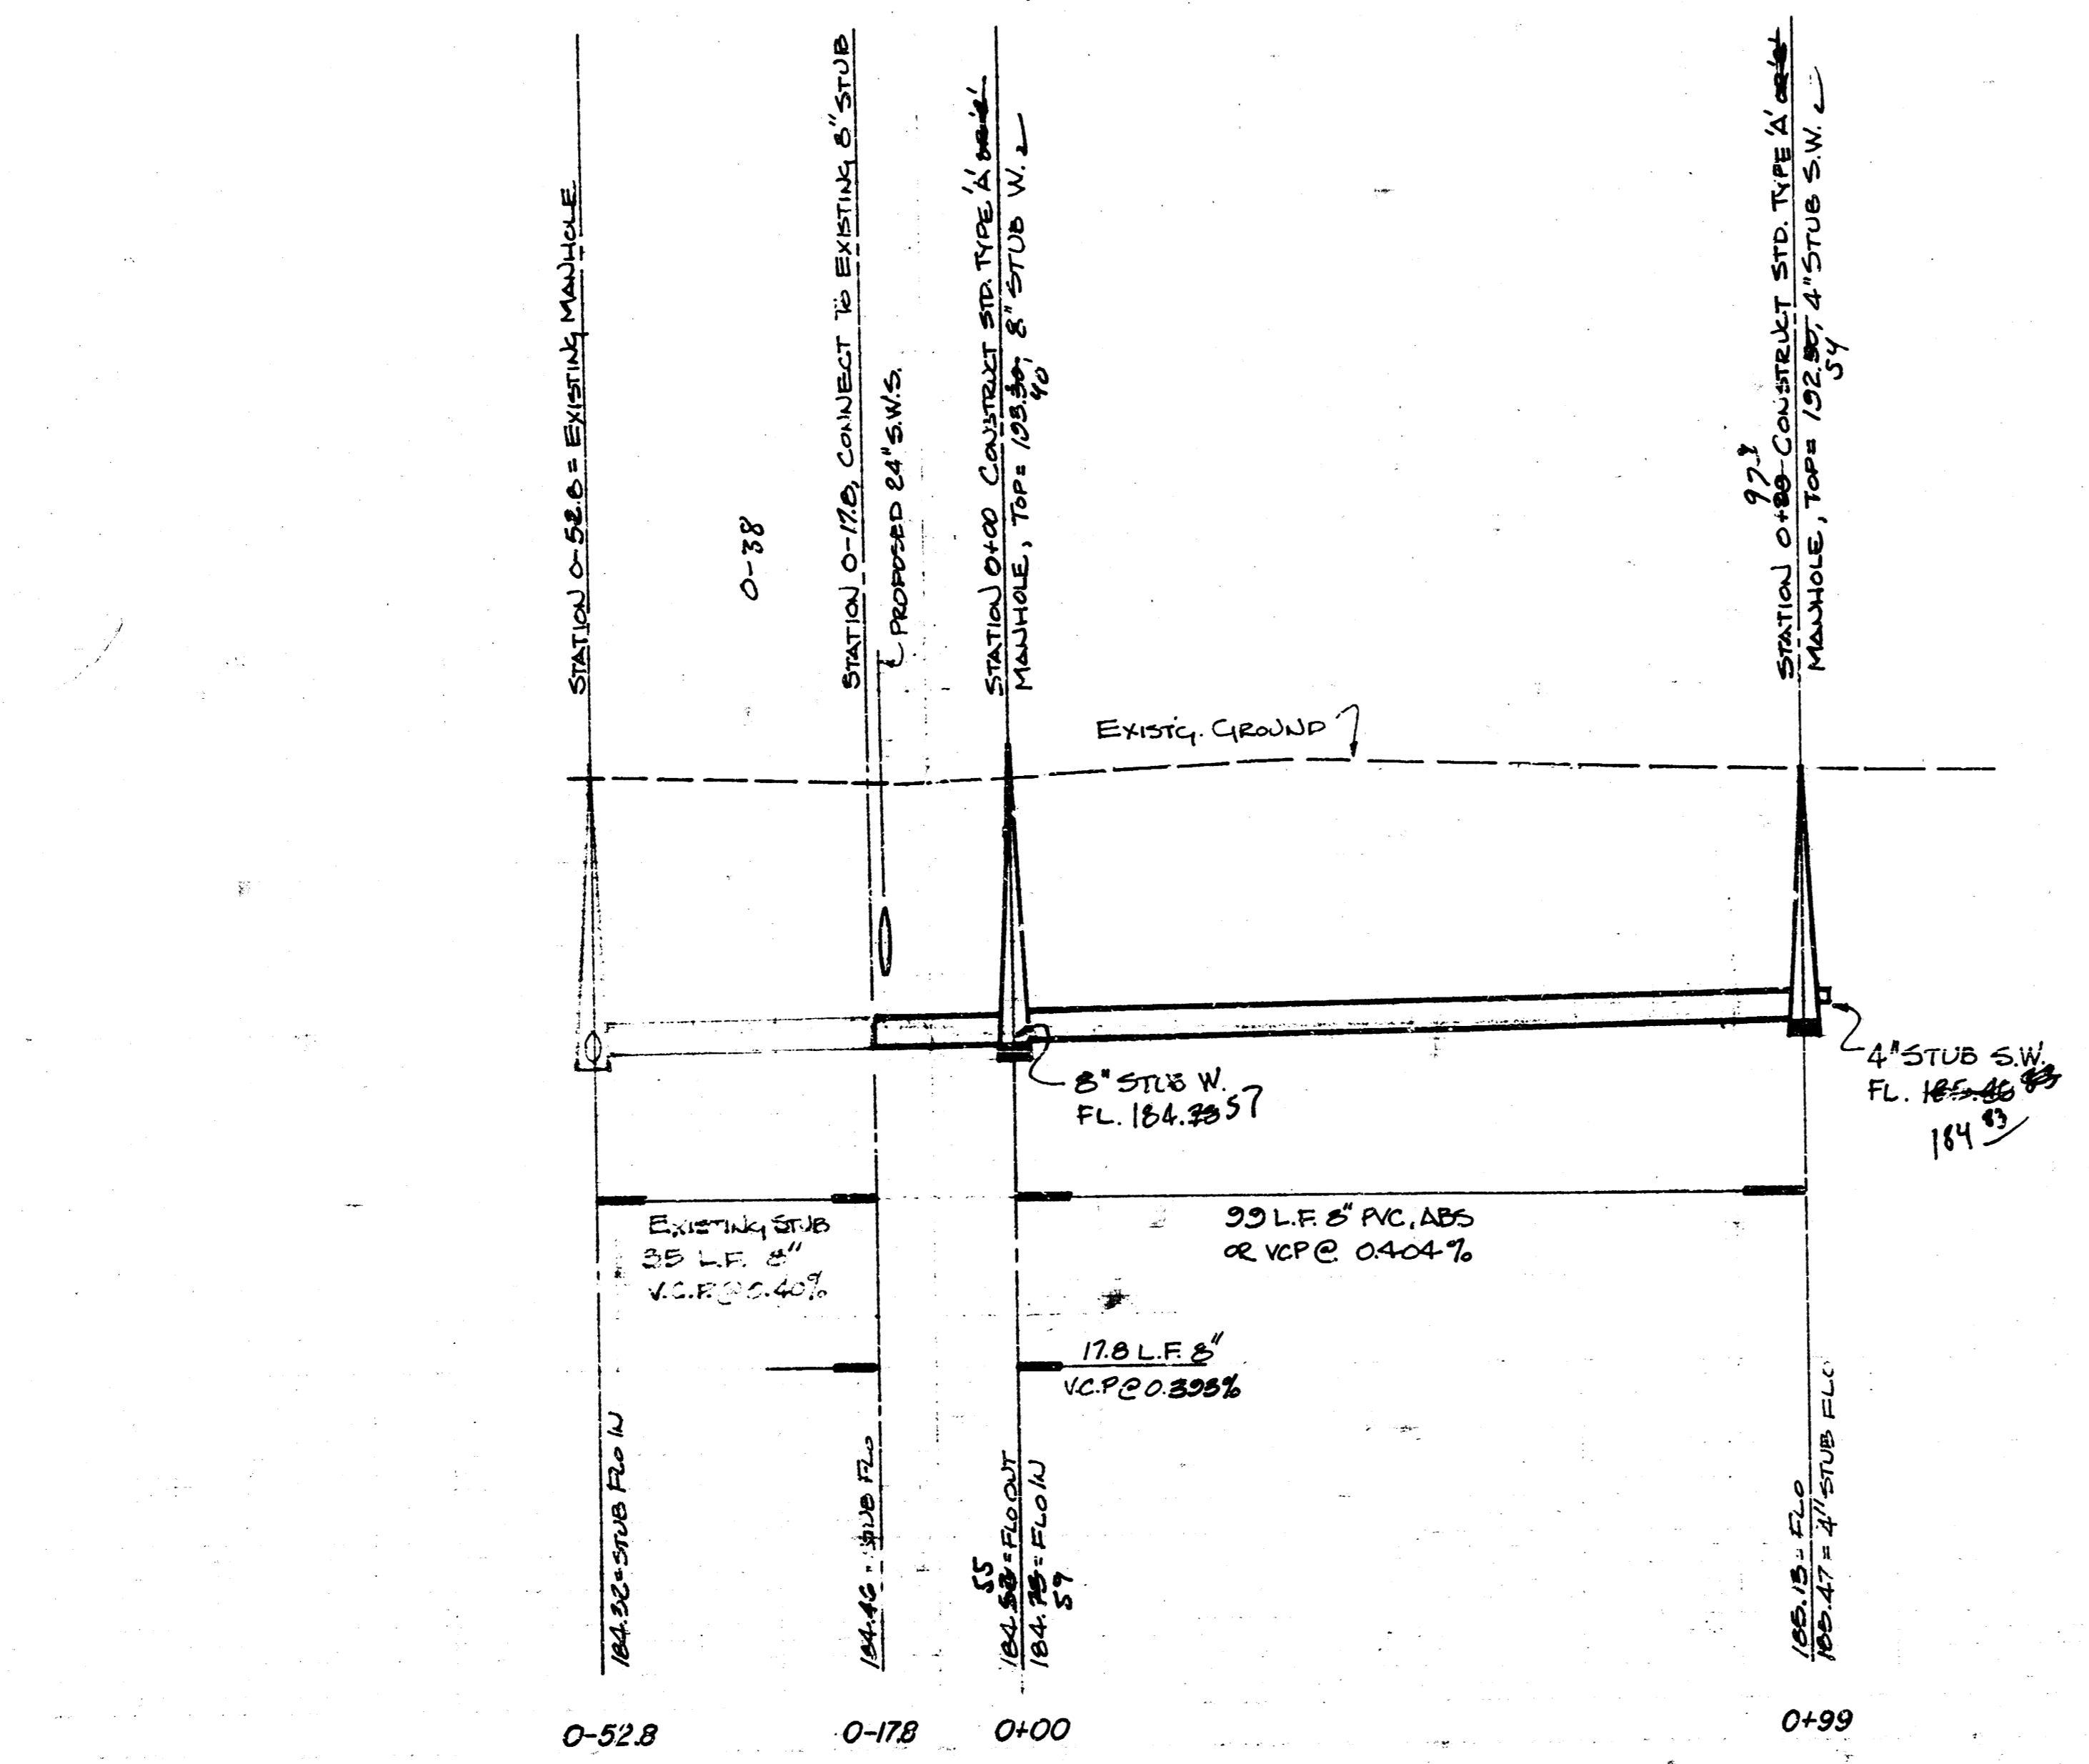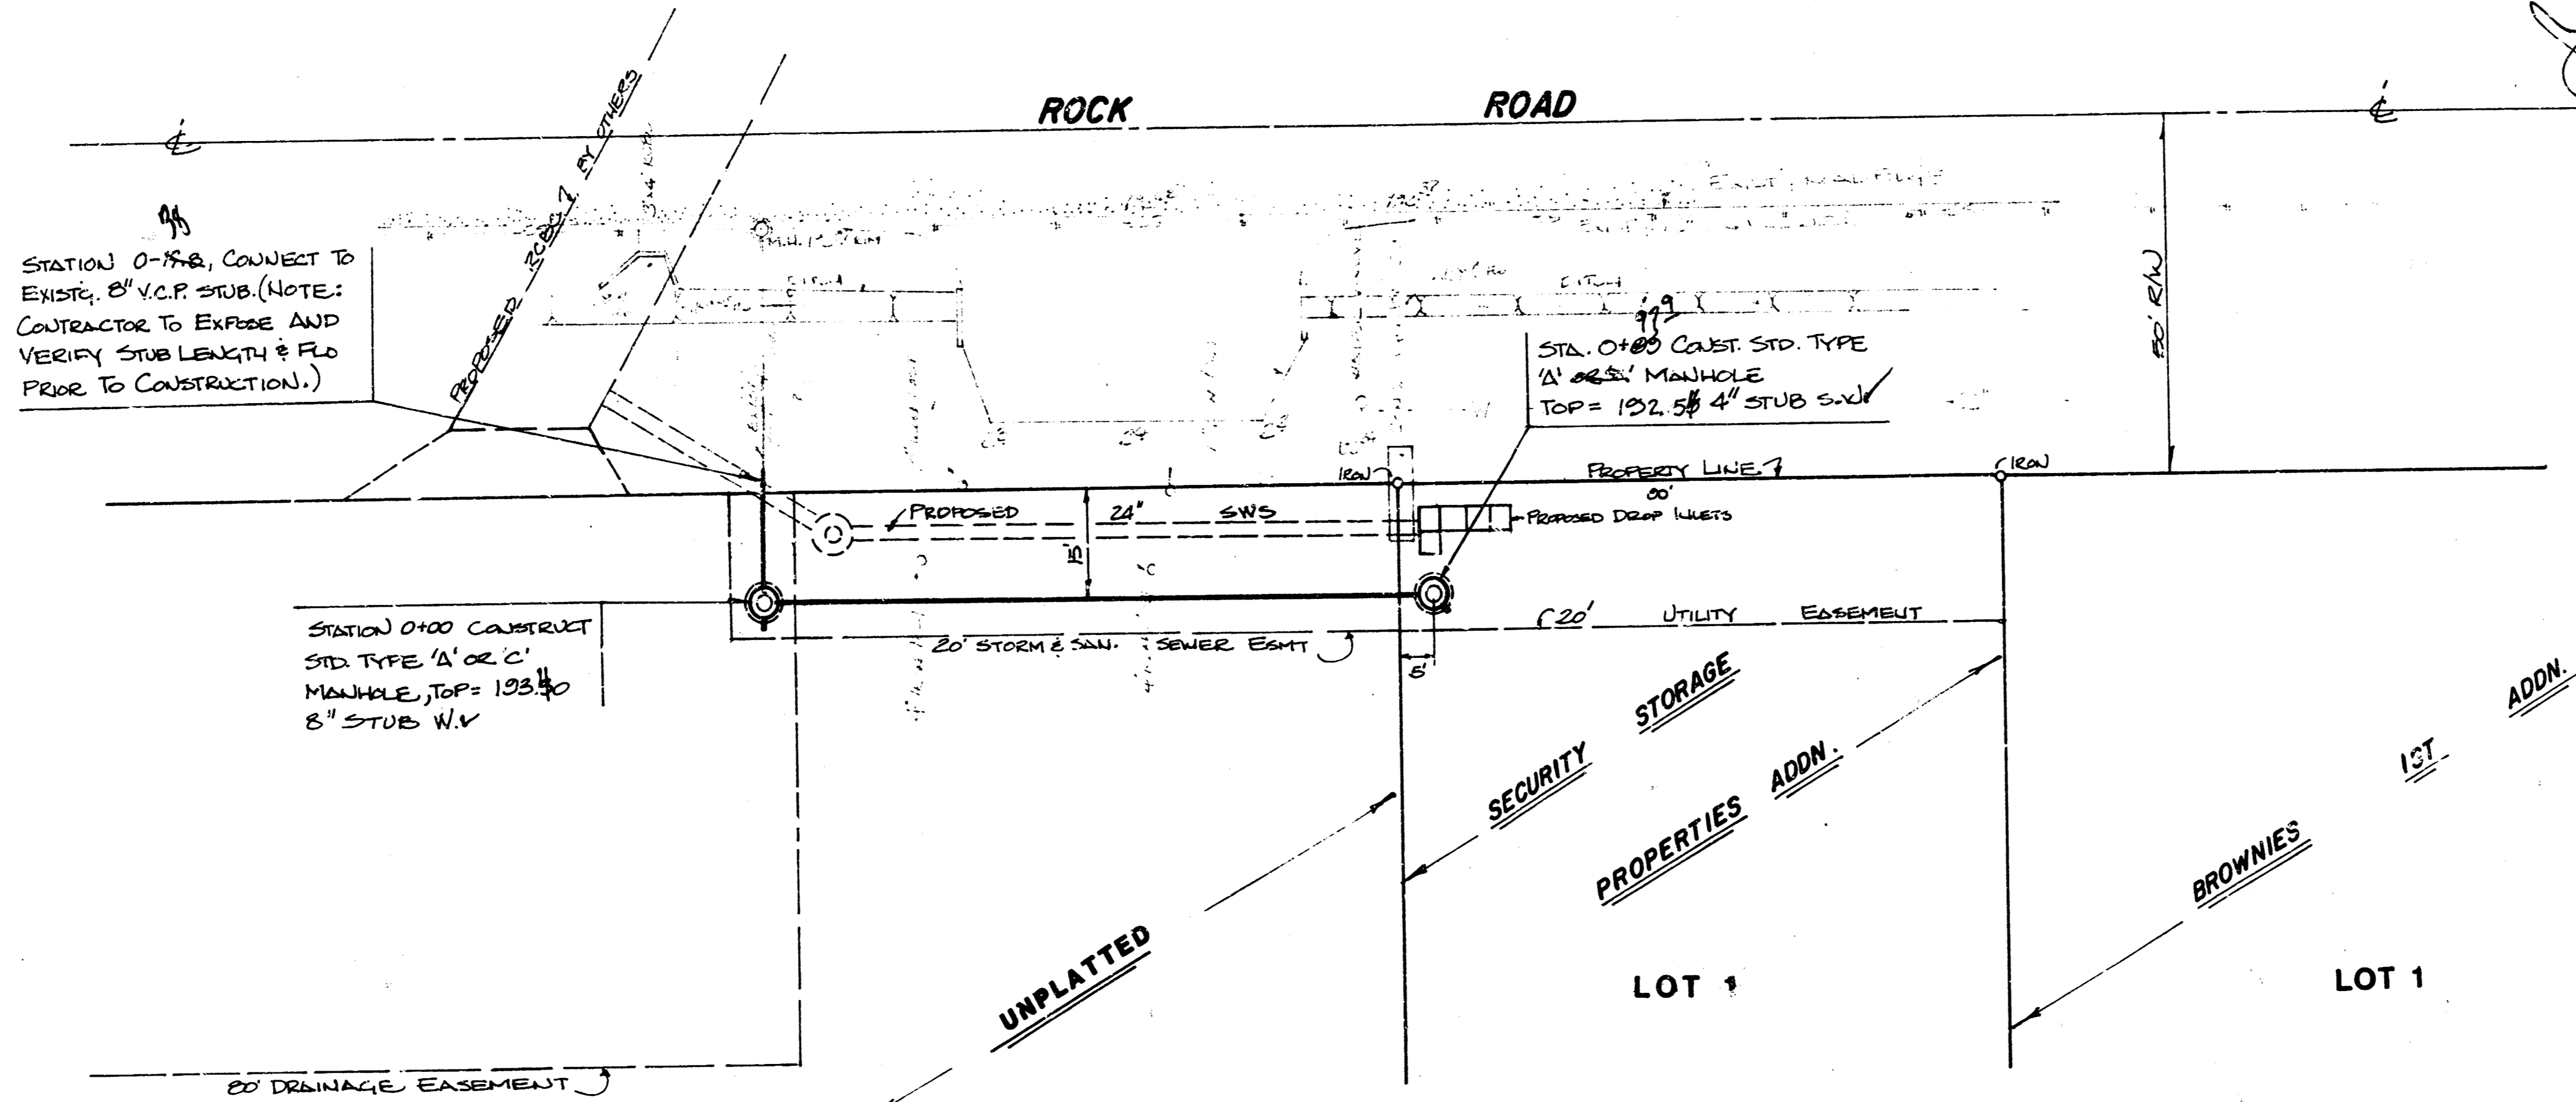

190  
185  
180

**LATERAL 33, MAIN 22. W.I.S.**  
TO SERVE LOT 1  
SECURITY STORAGE PROPERTIES ADDITION  
PROJECT NO.  
488-76-245-81363-000-000-001  
CITY OF WICHITA, KS  
BAUGHMAN COMPANY, P.A.  
SURVEYING & ENGINEERING  
316-262-7271 • 330 LAURA • WICHITA, KANSAS 67211

FILMED FROM THE BEST AVAILABLE COPY