


LATERAL 1, MAIN 23, WAR INDUSTRIES SEWER

City of Wichita, Kansas



R. W. BRUGGEMAN: DIRECTOR OF ENGINEERING/CITY ENGINEER


DATE :

PROJECT NO. 468-76-245-80999-000-000-001

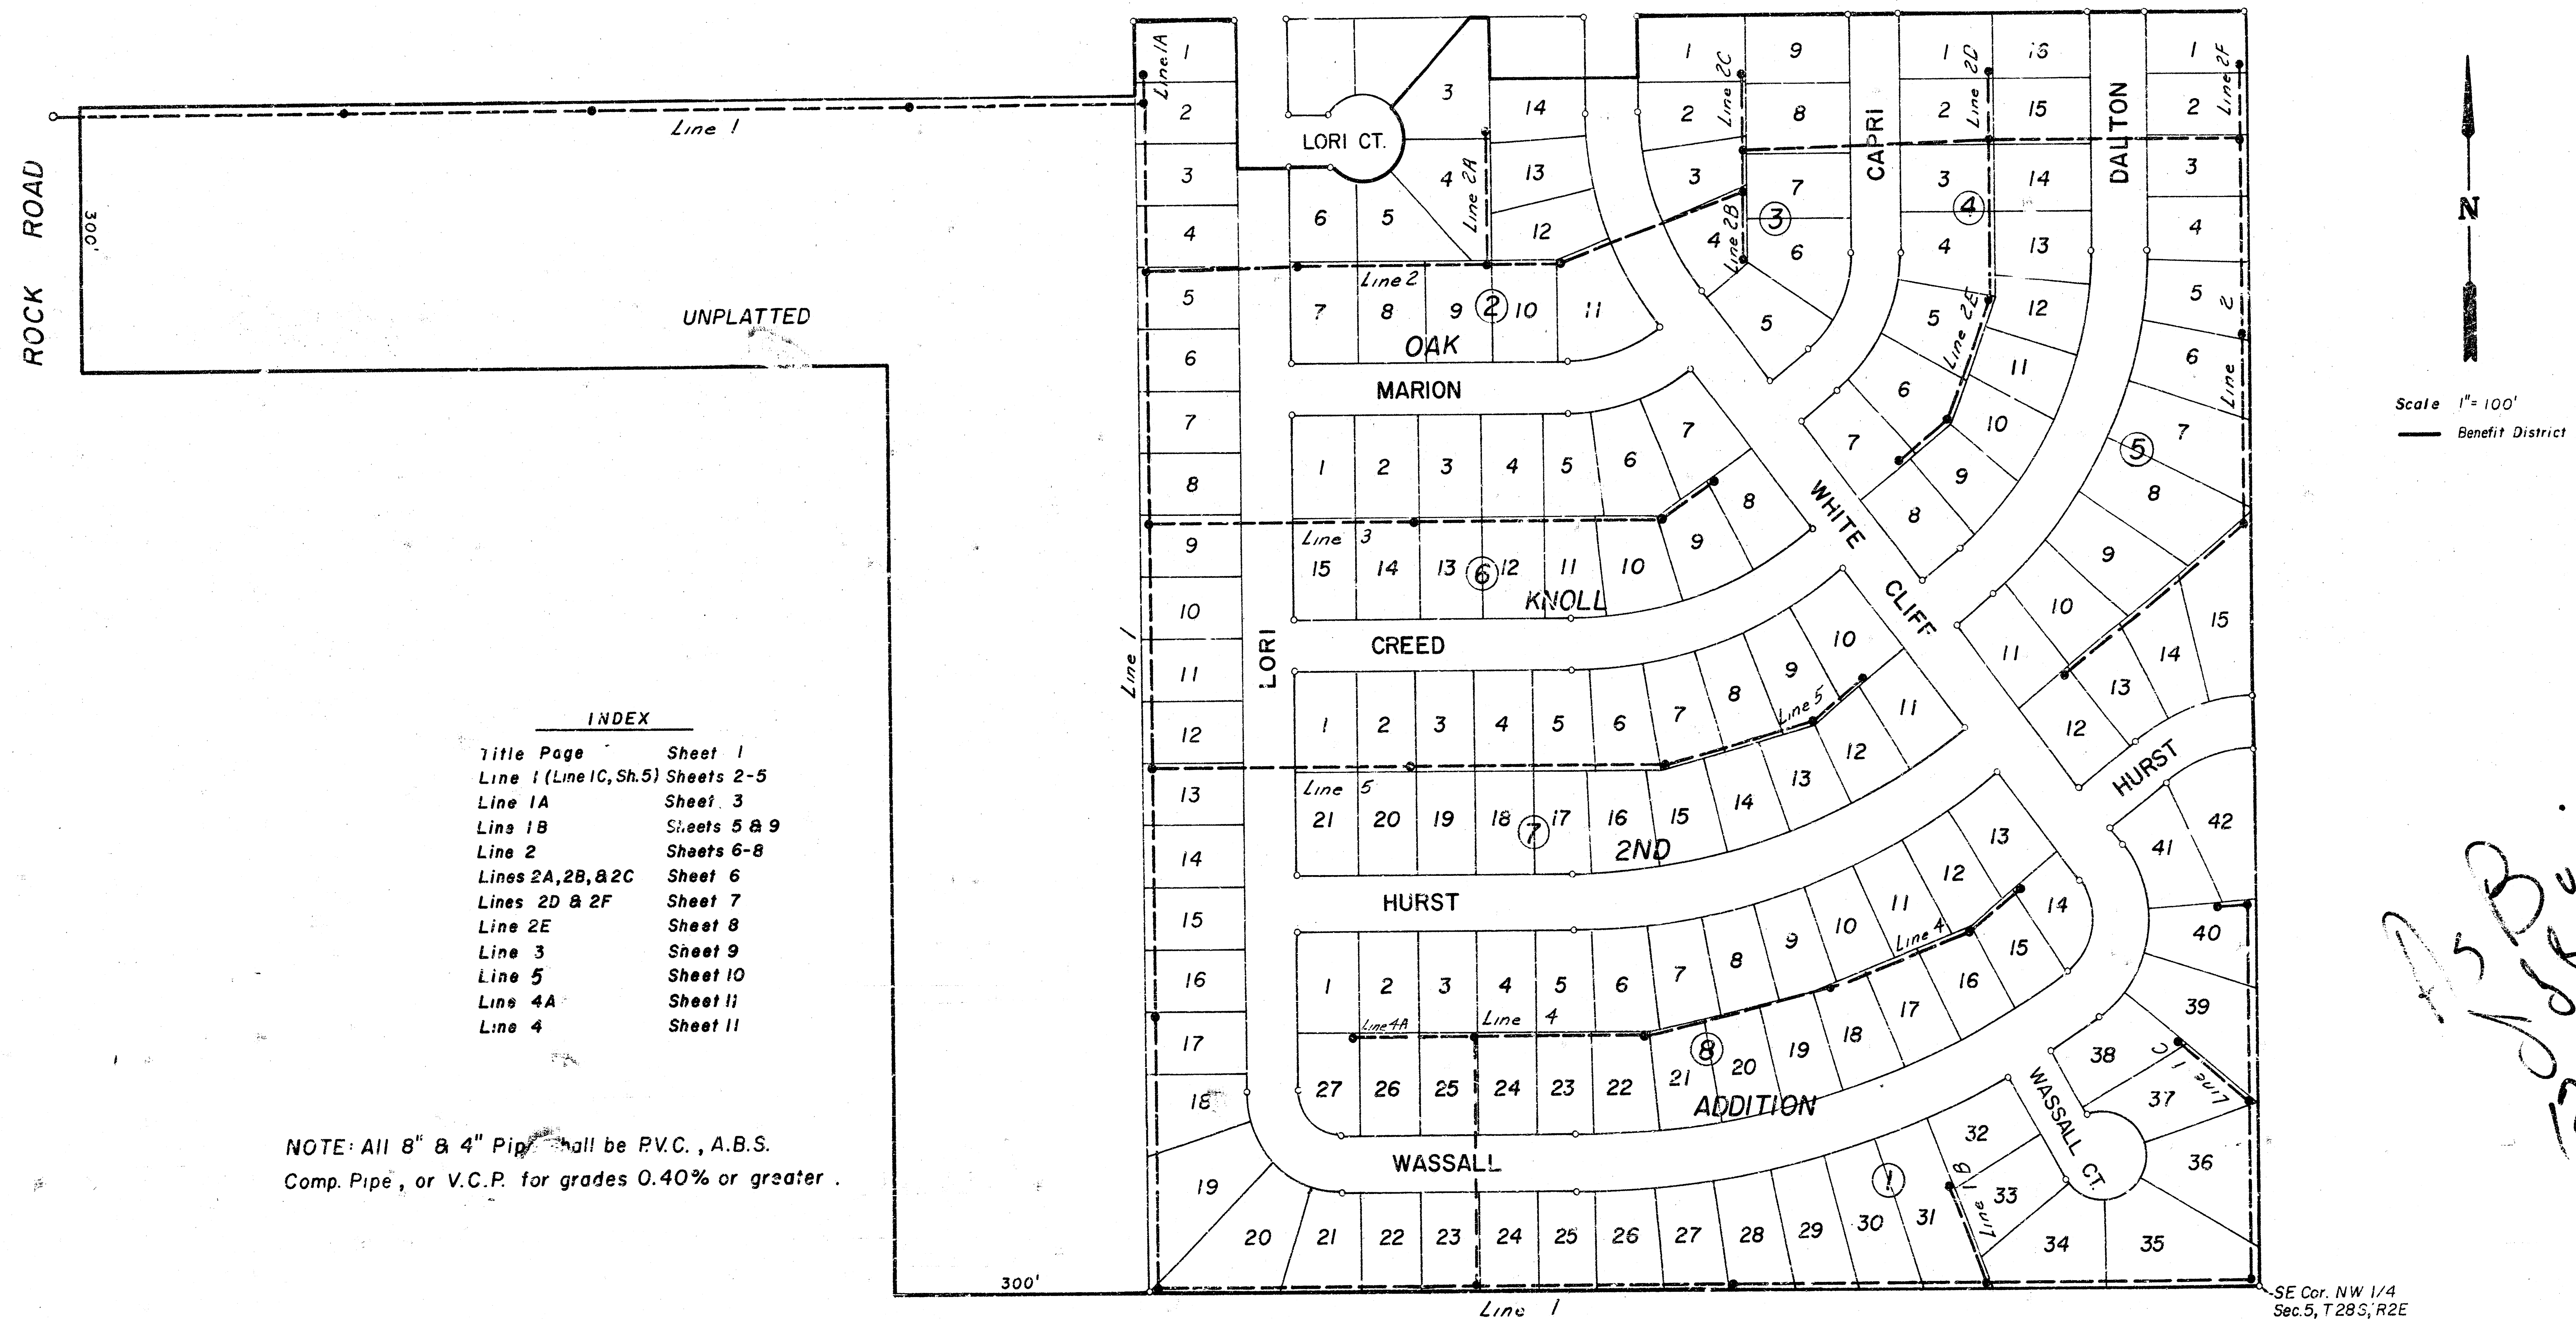

As Built
JSS
12/81

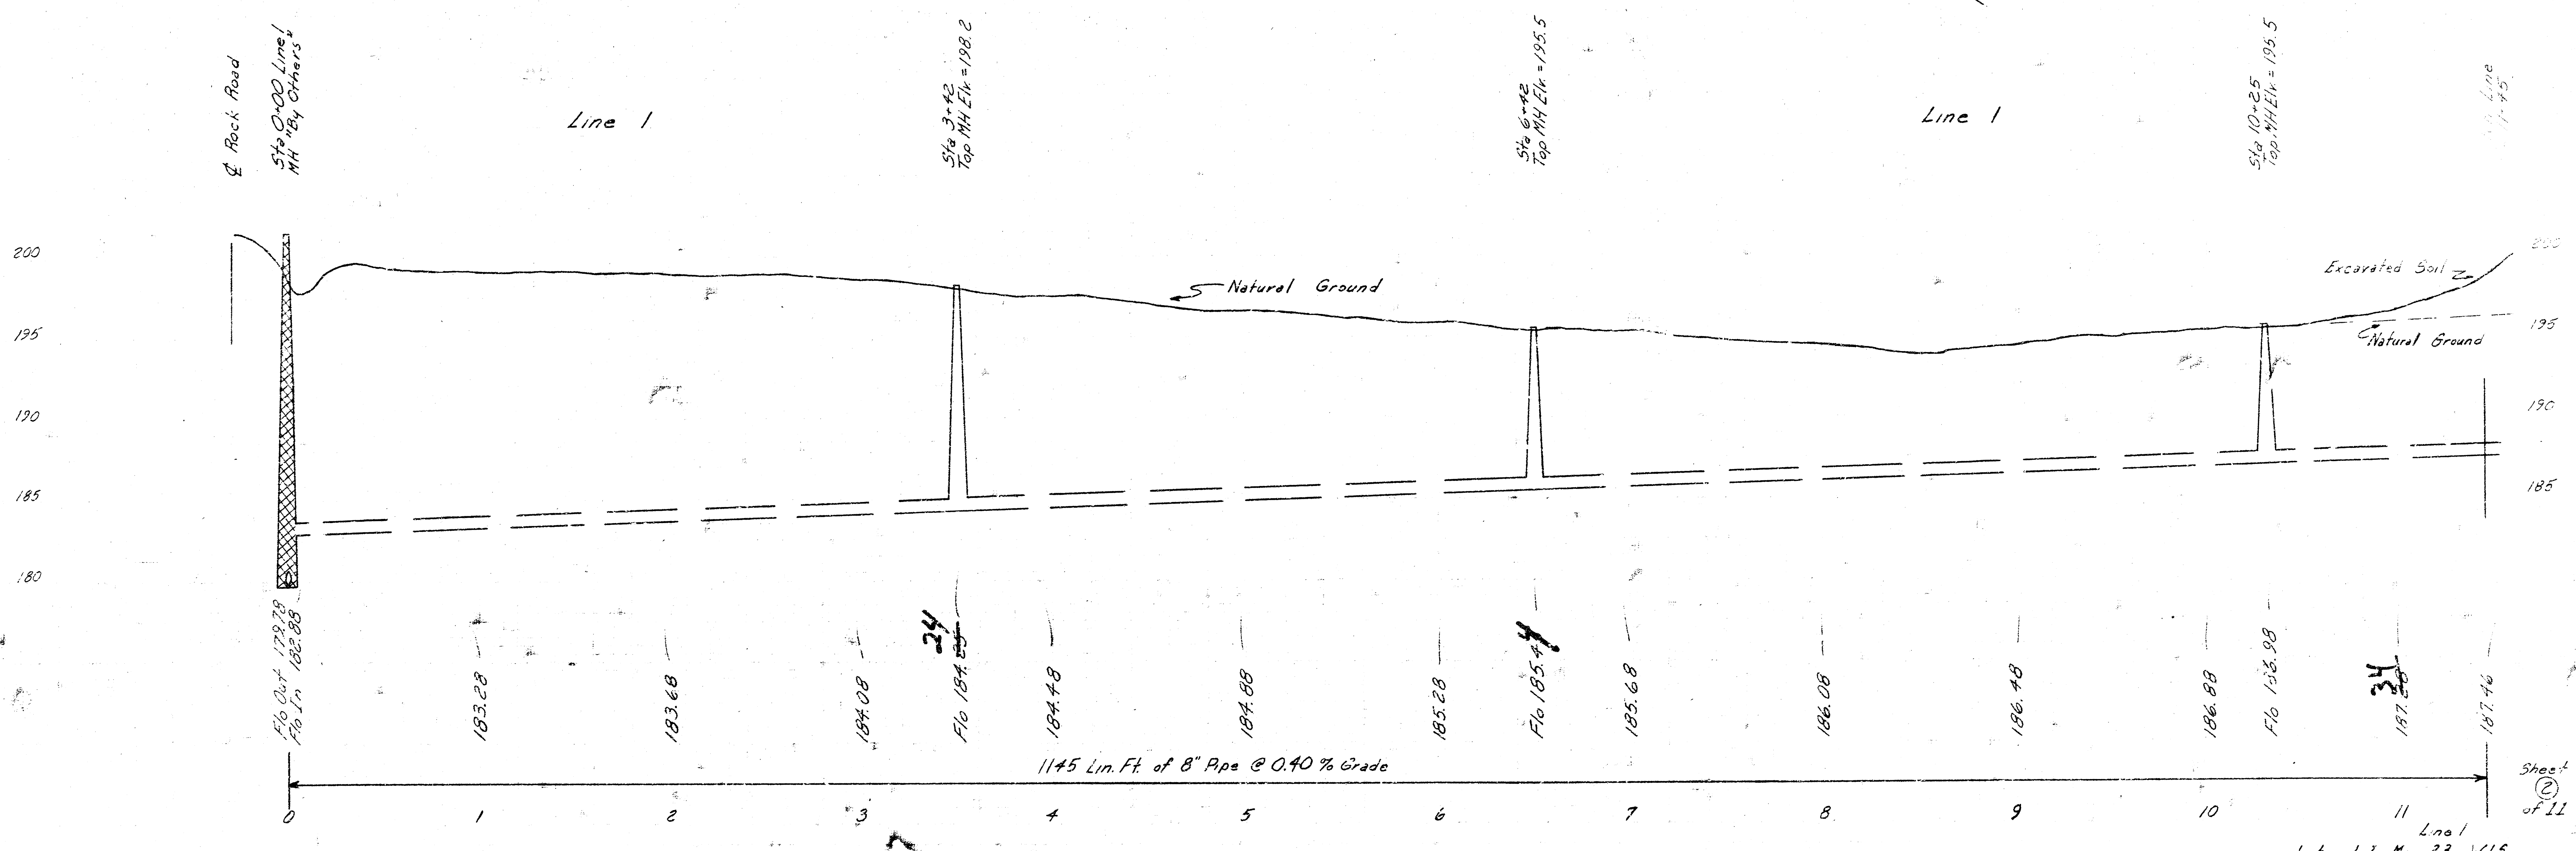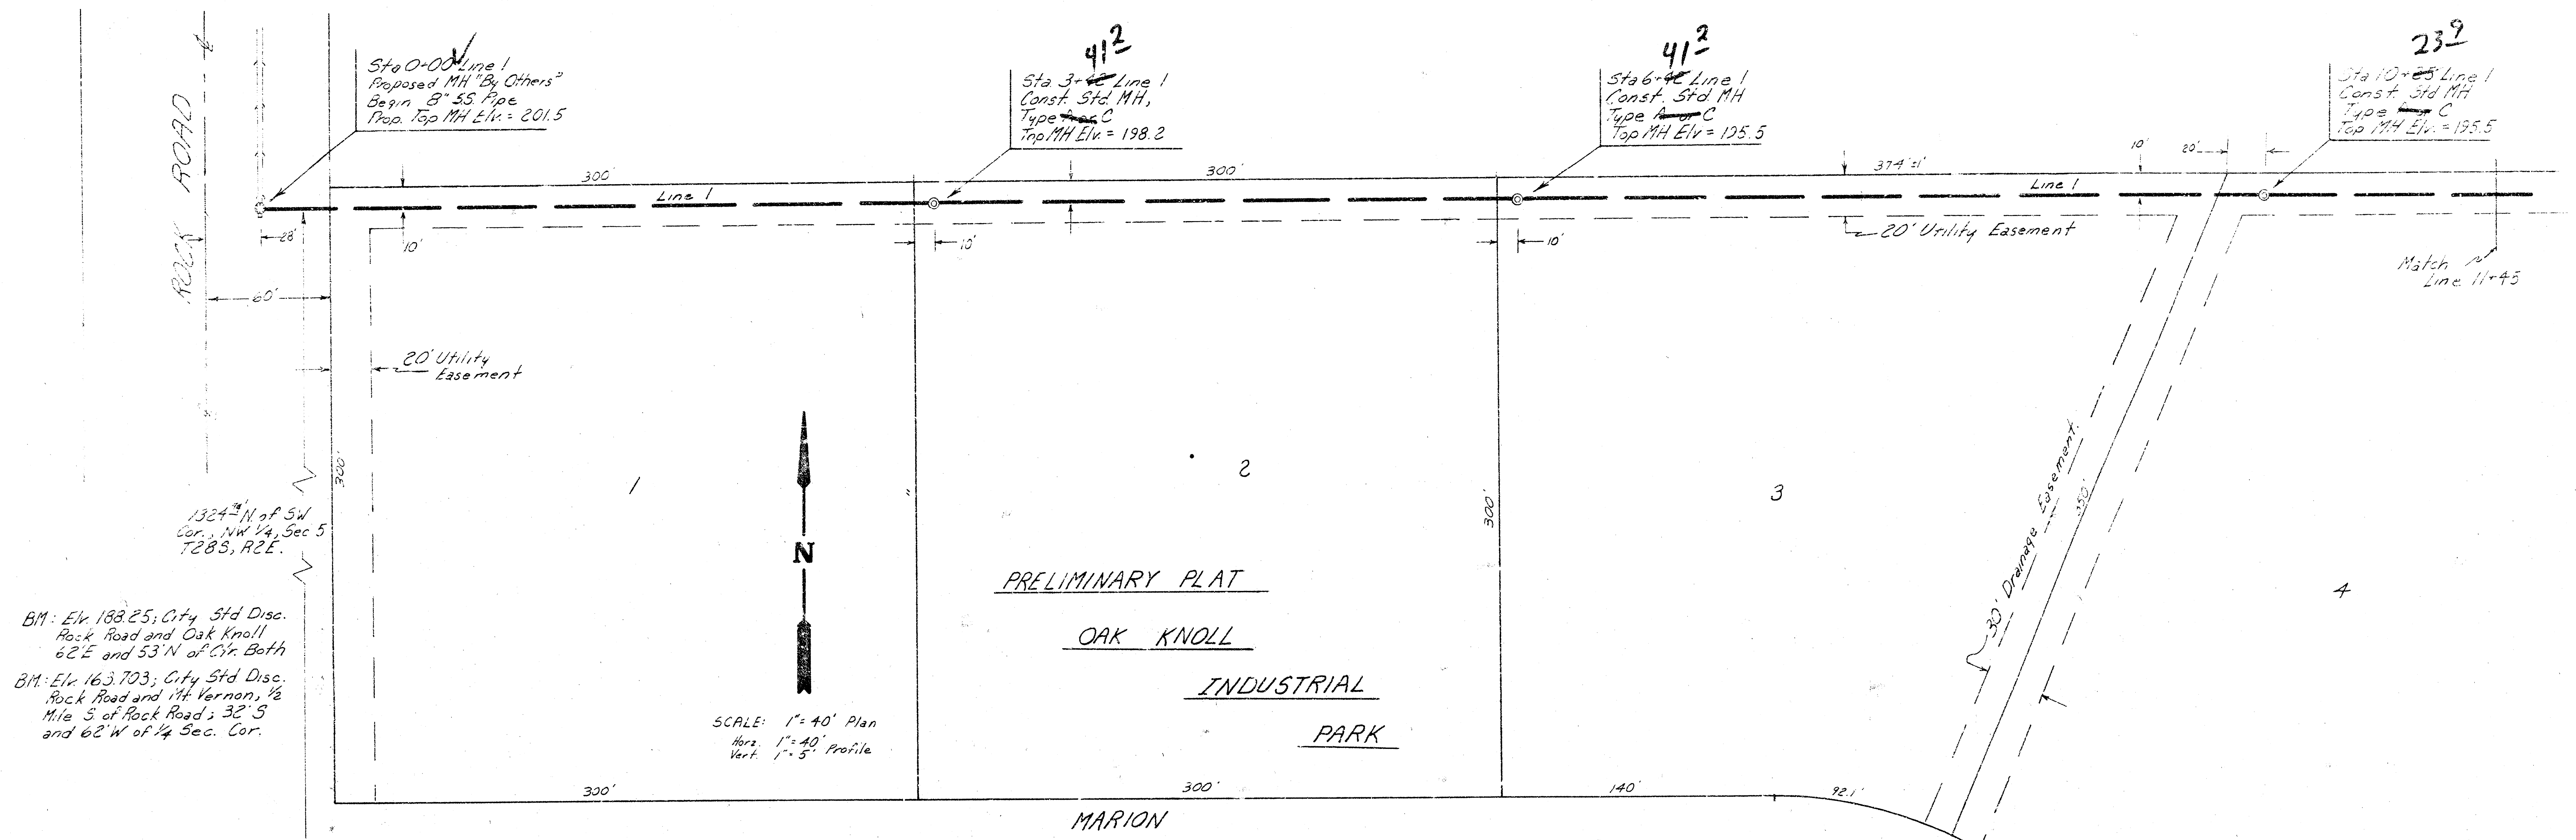


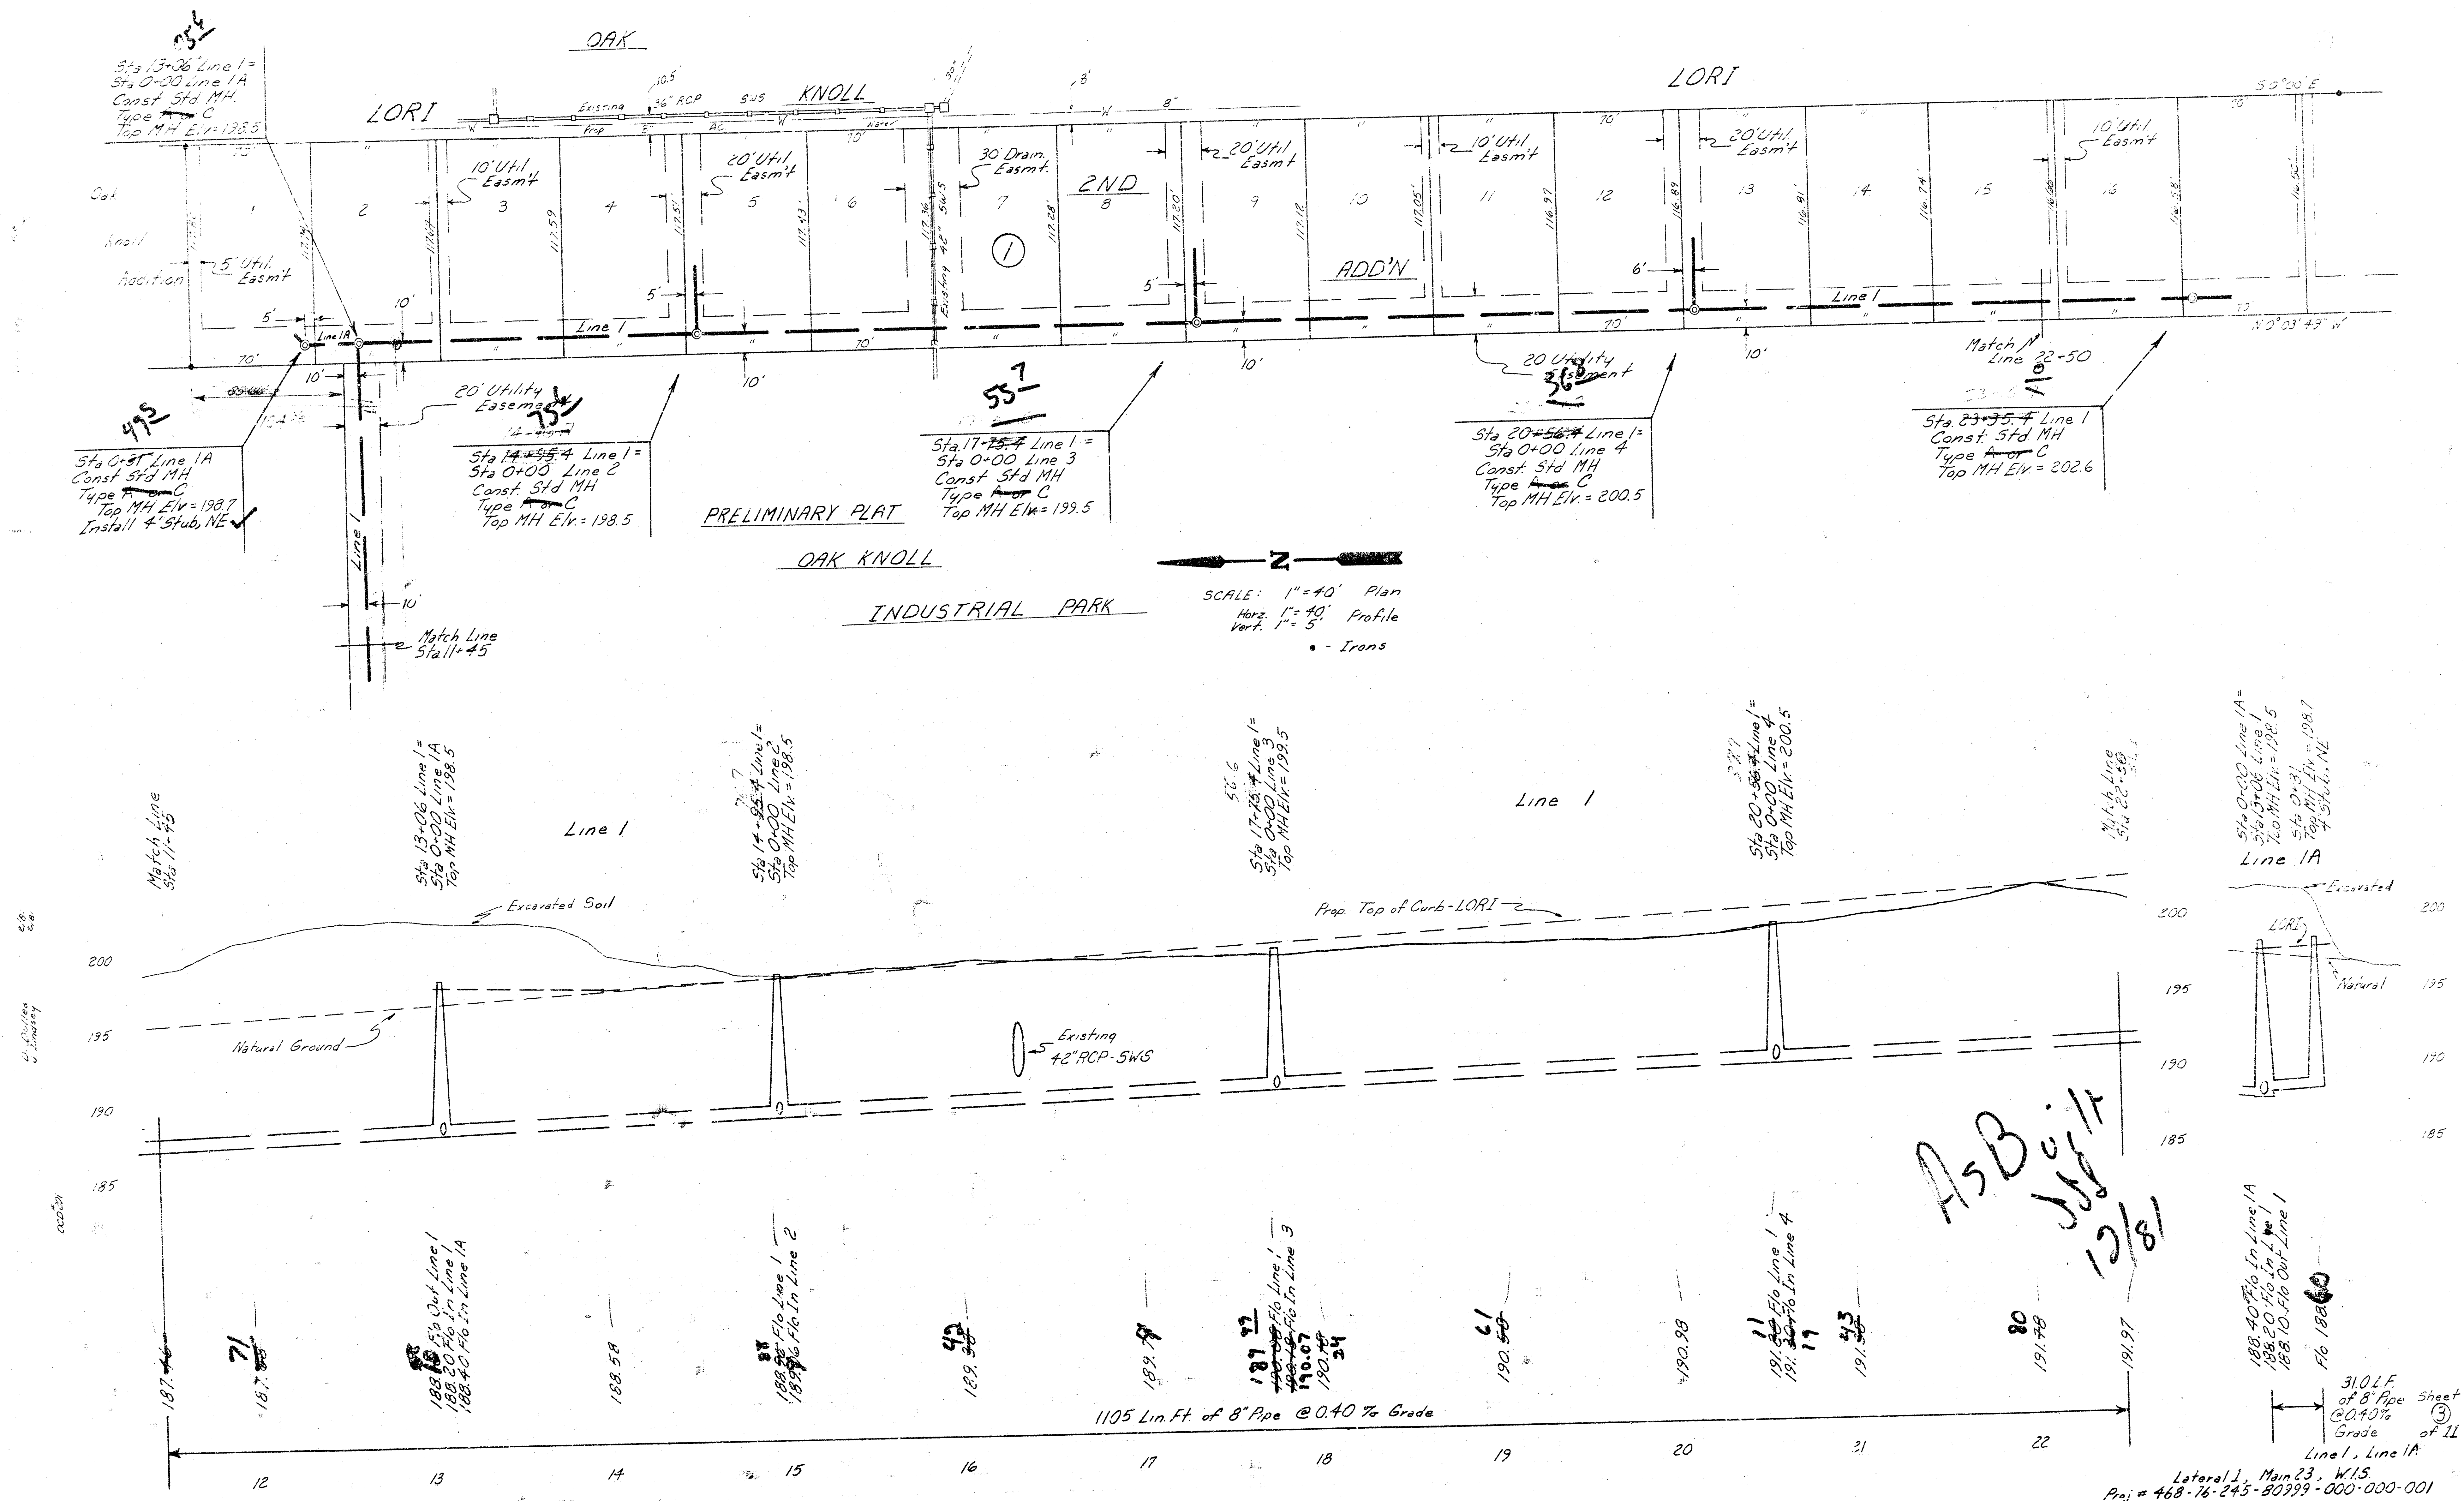


ASBuilt
5/8
12/81




188.40 Flo In Line 1A
188.20 Flo In Line 1
188.10 Flo Out Line 1
Flo 188.60

31.0 L.F.
of 8" Pipe Sheet
@ 0.40% (3)
Grade of 11
Line 1, Line 1A


Lateral 1, Main 23, W.I.S.
Proj # 468-76-245-80999-000-000-001

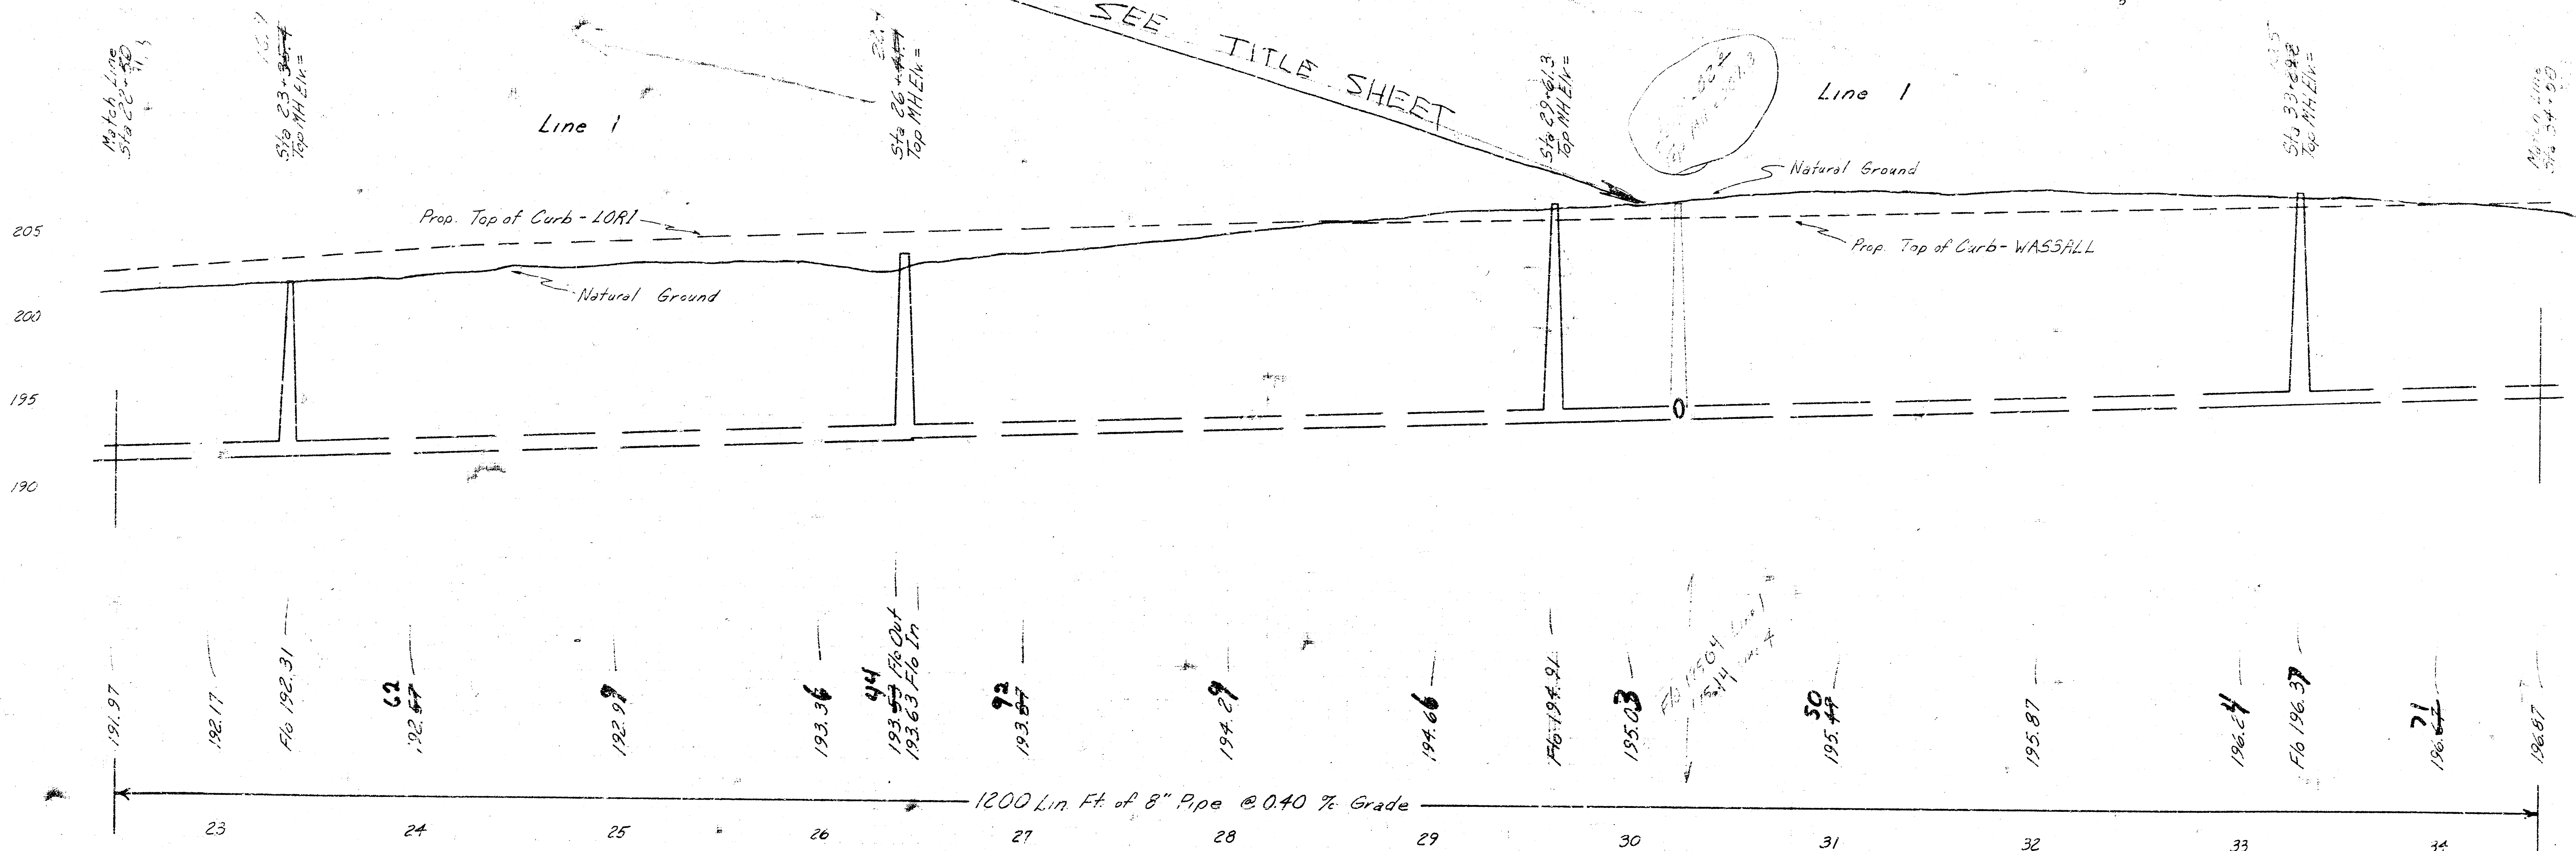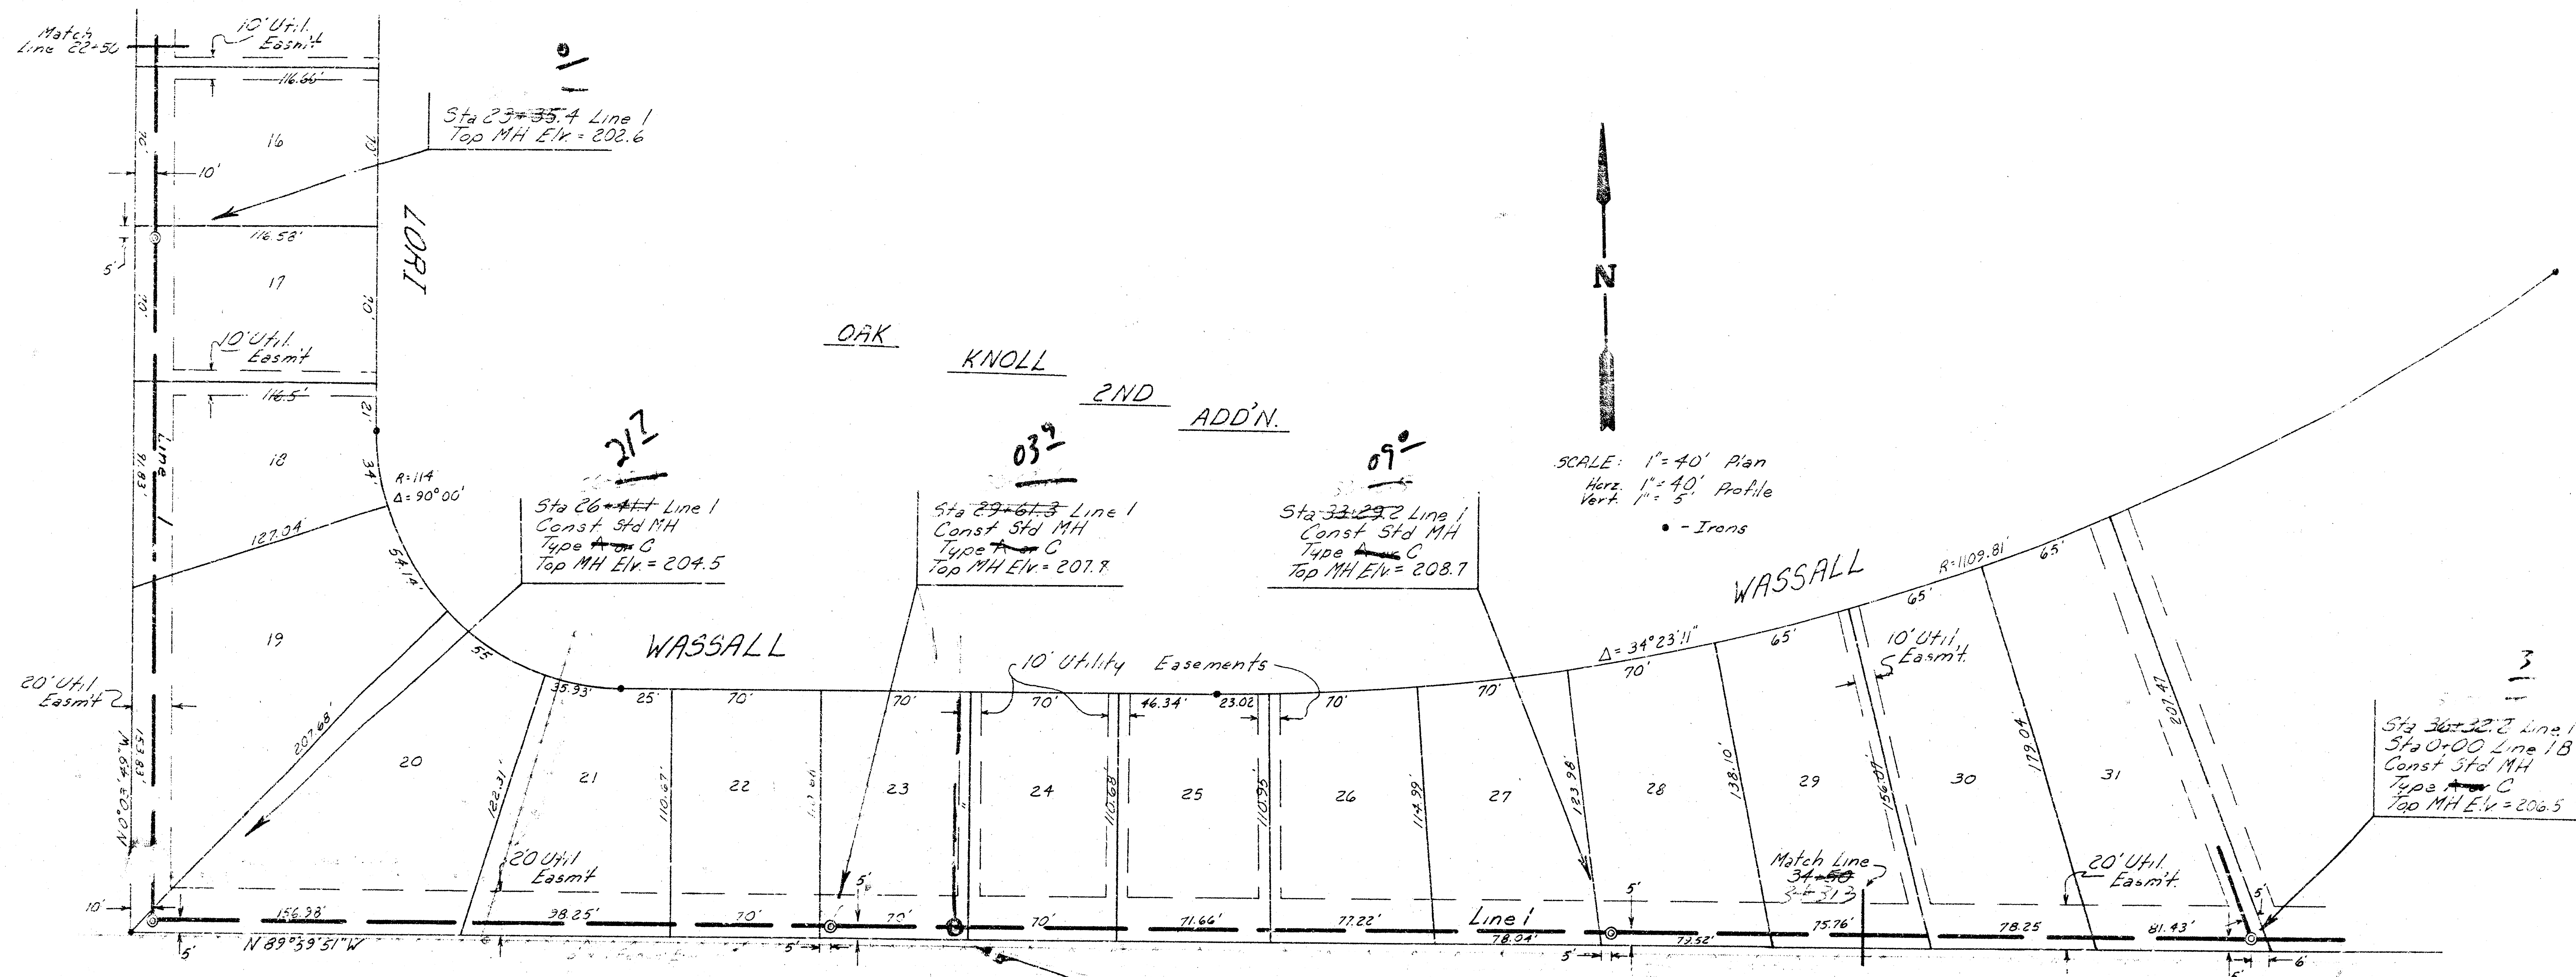


SCALE: 1" = 40' Plan
 Horiz. 1" = 40' Profile
 Vert. 1" = 5' Profile
 • - Irons

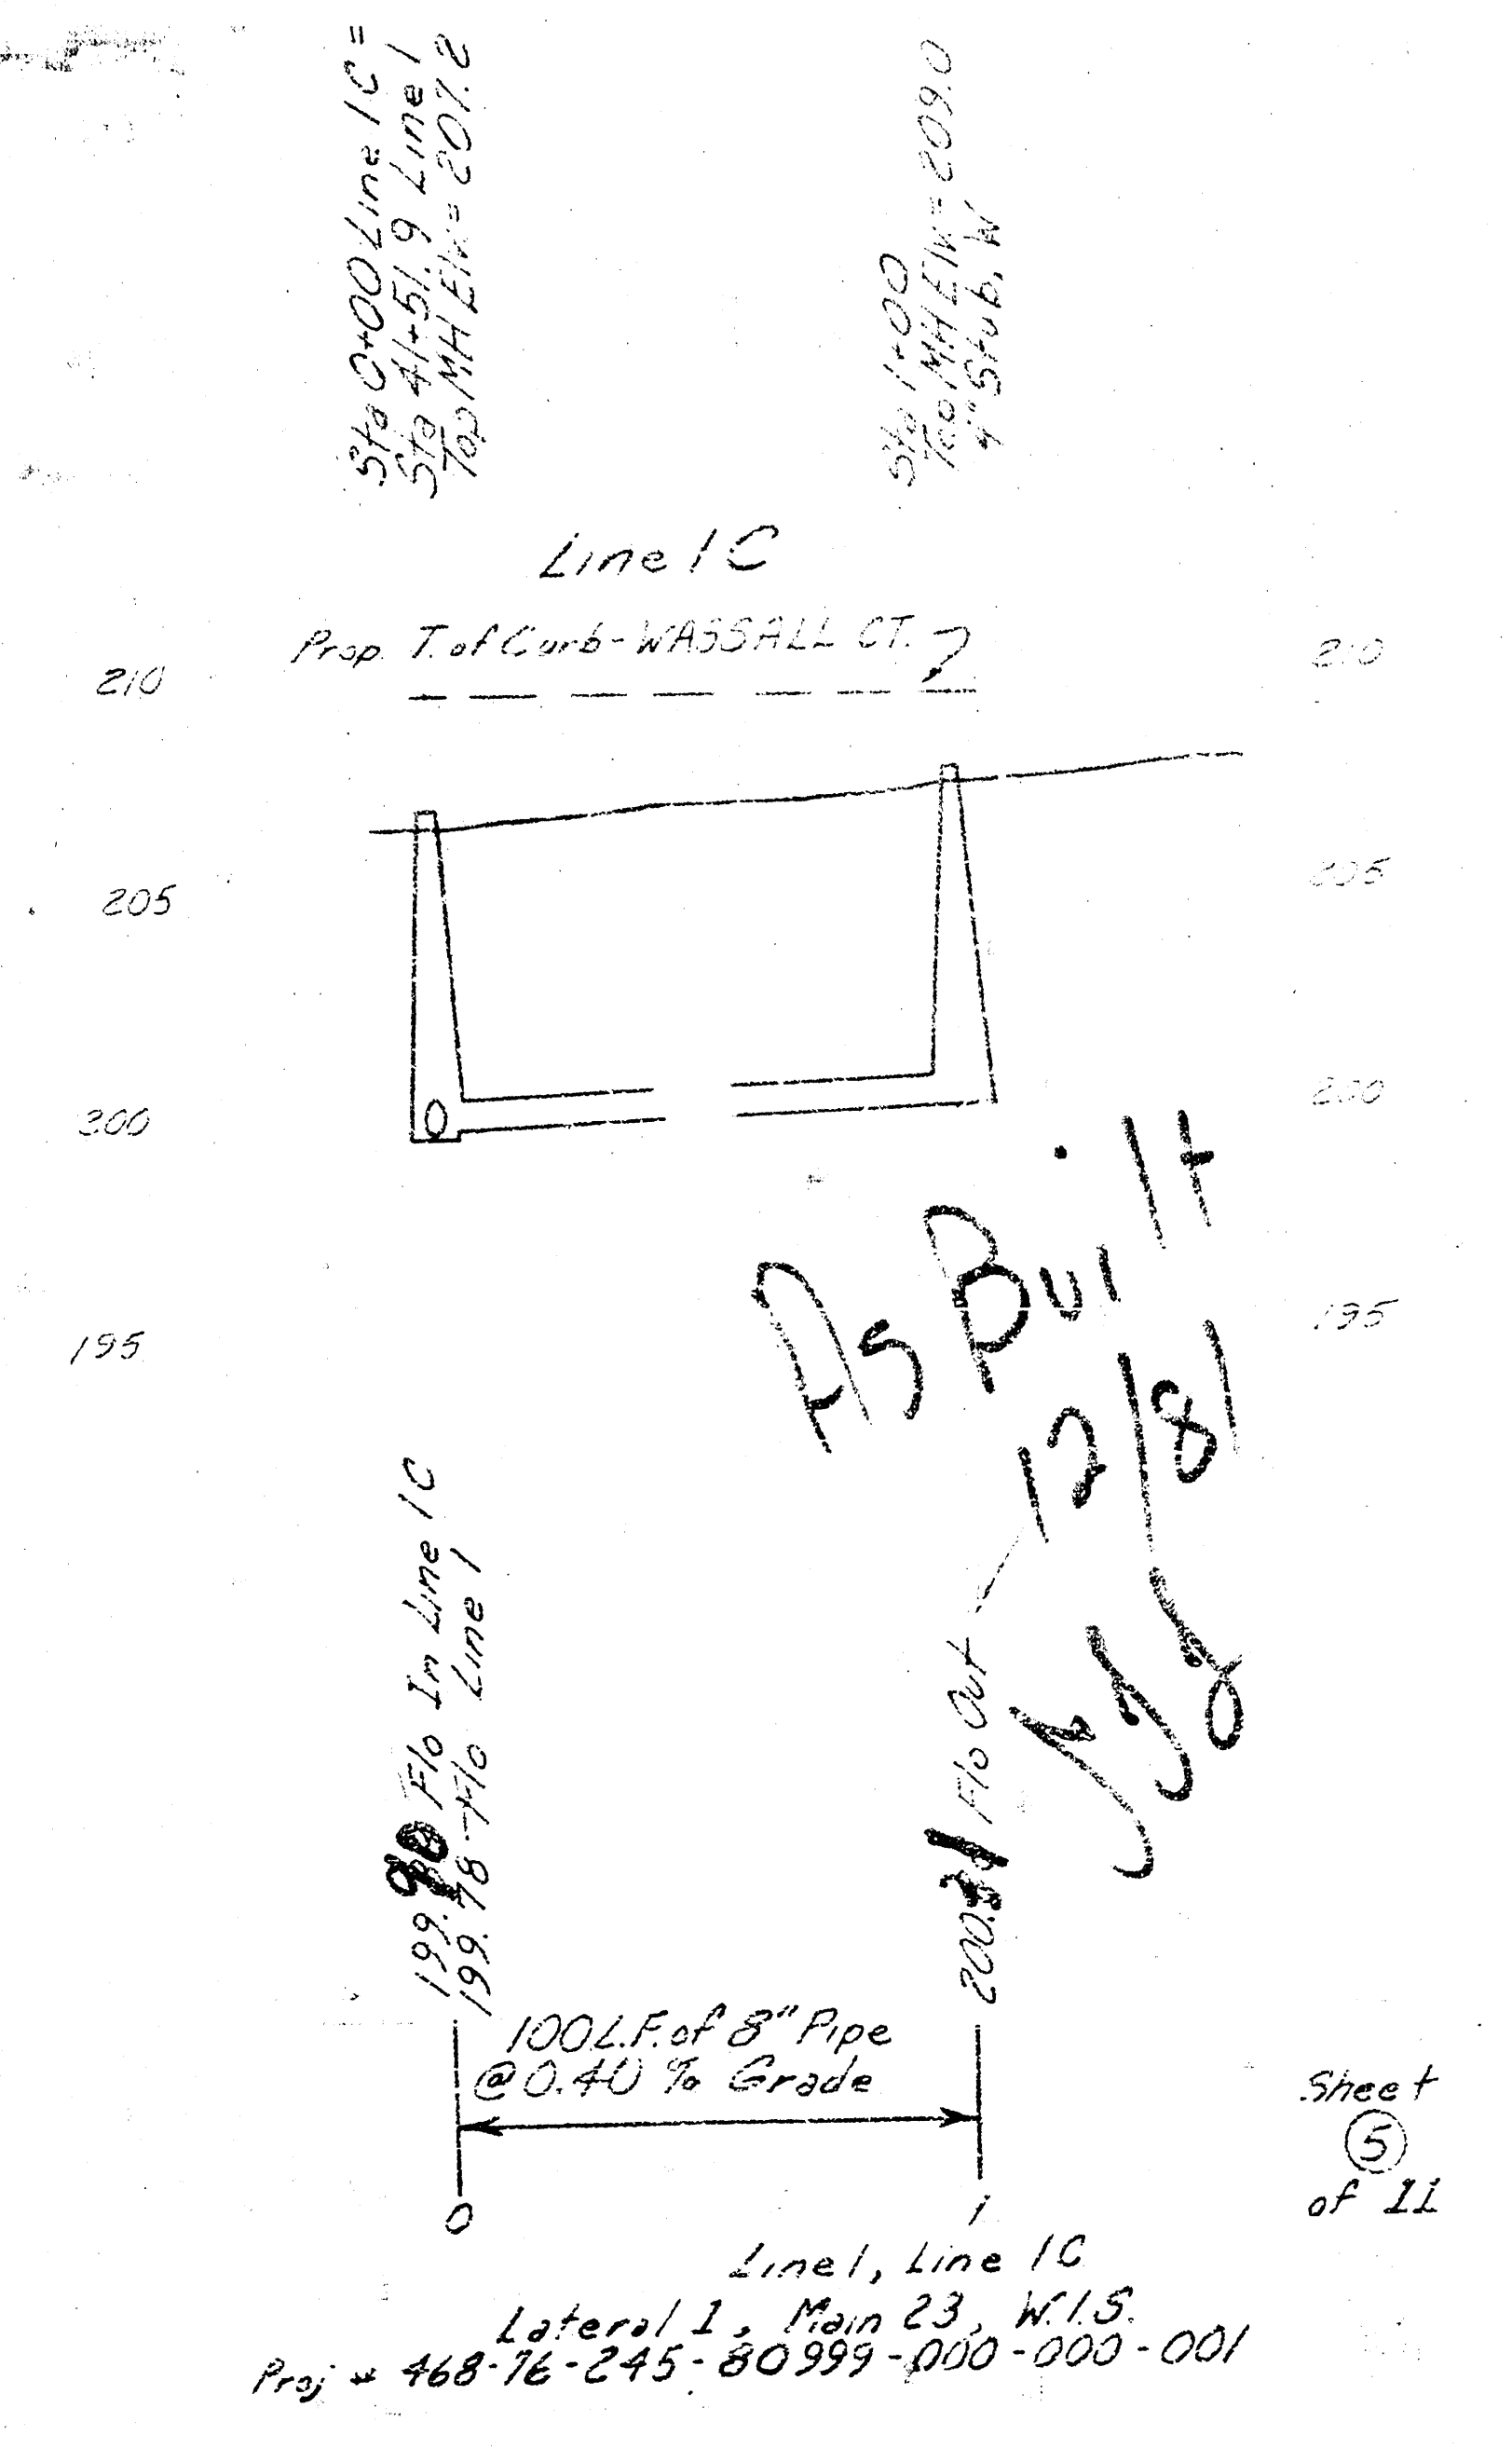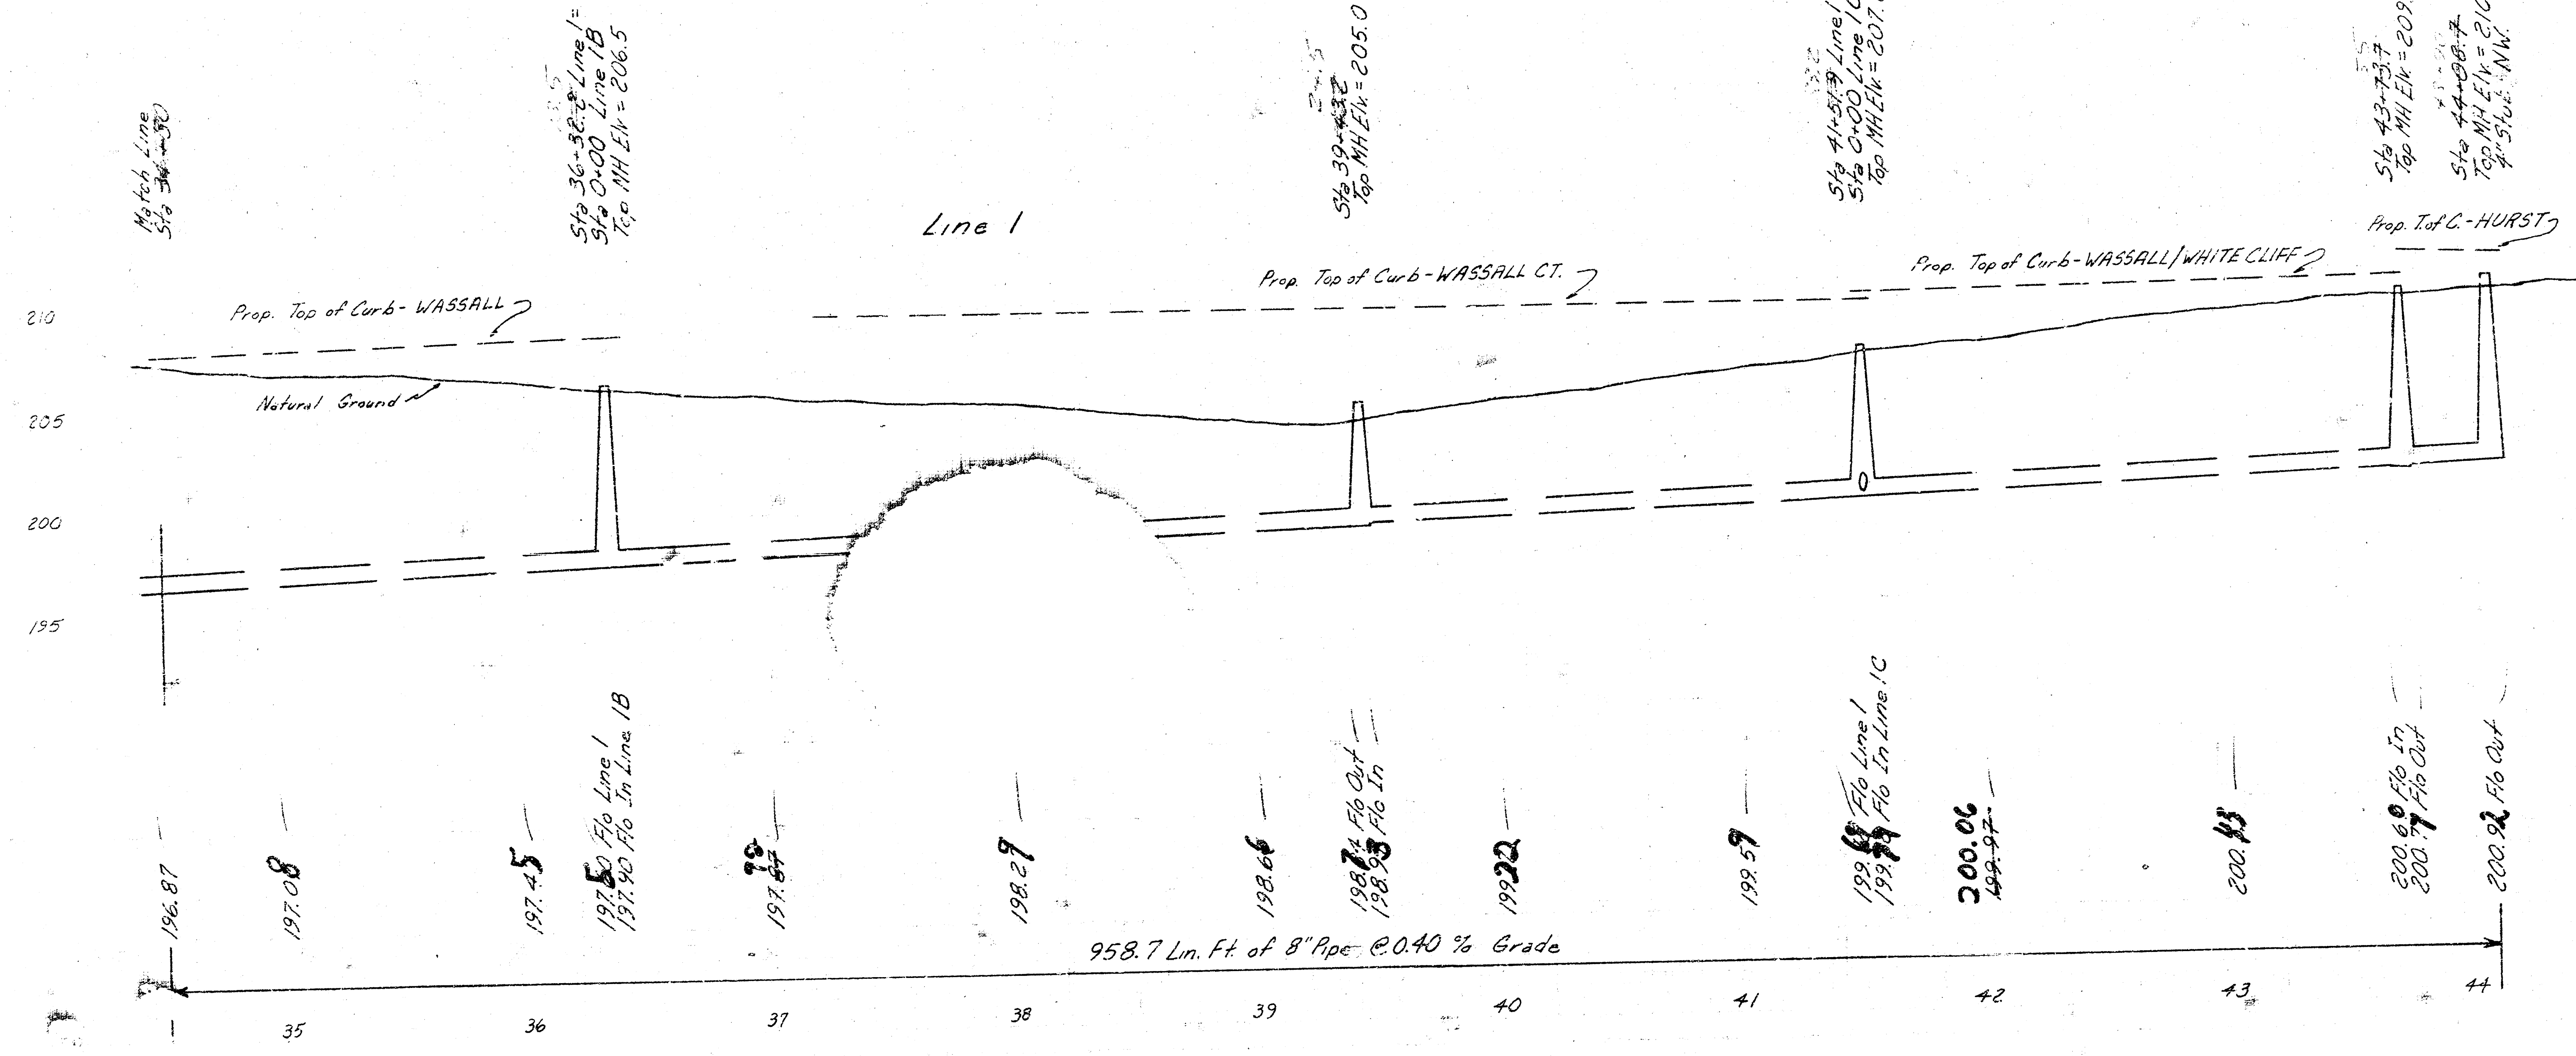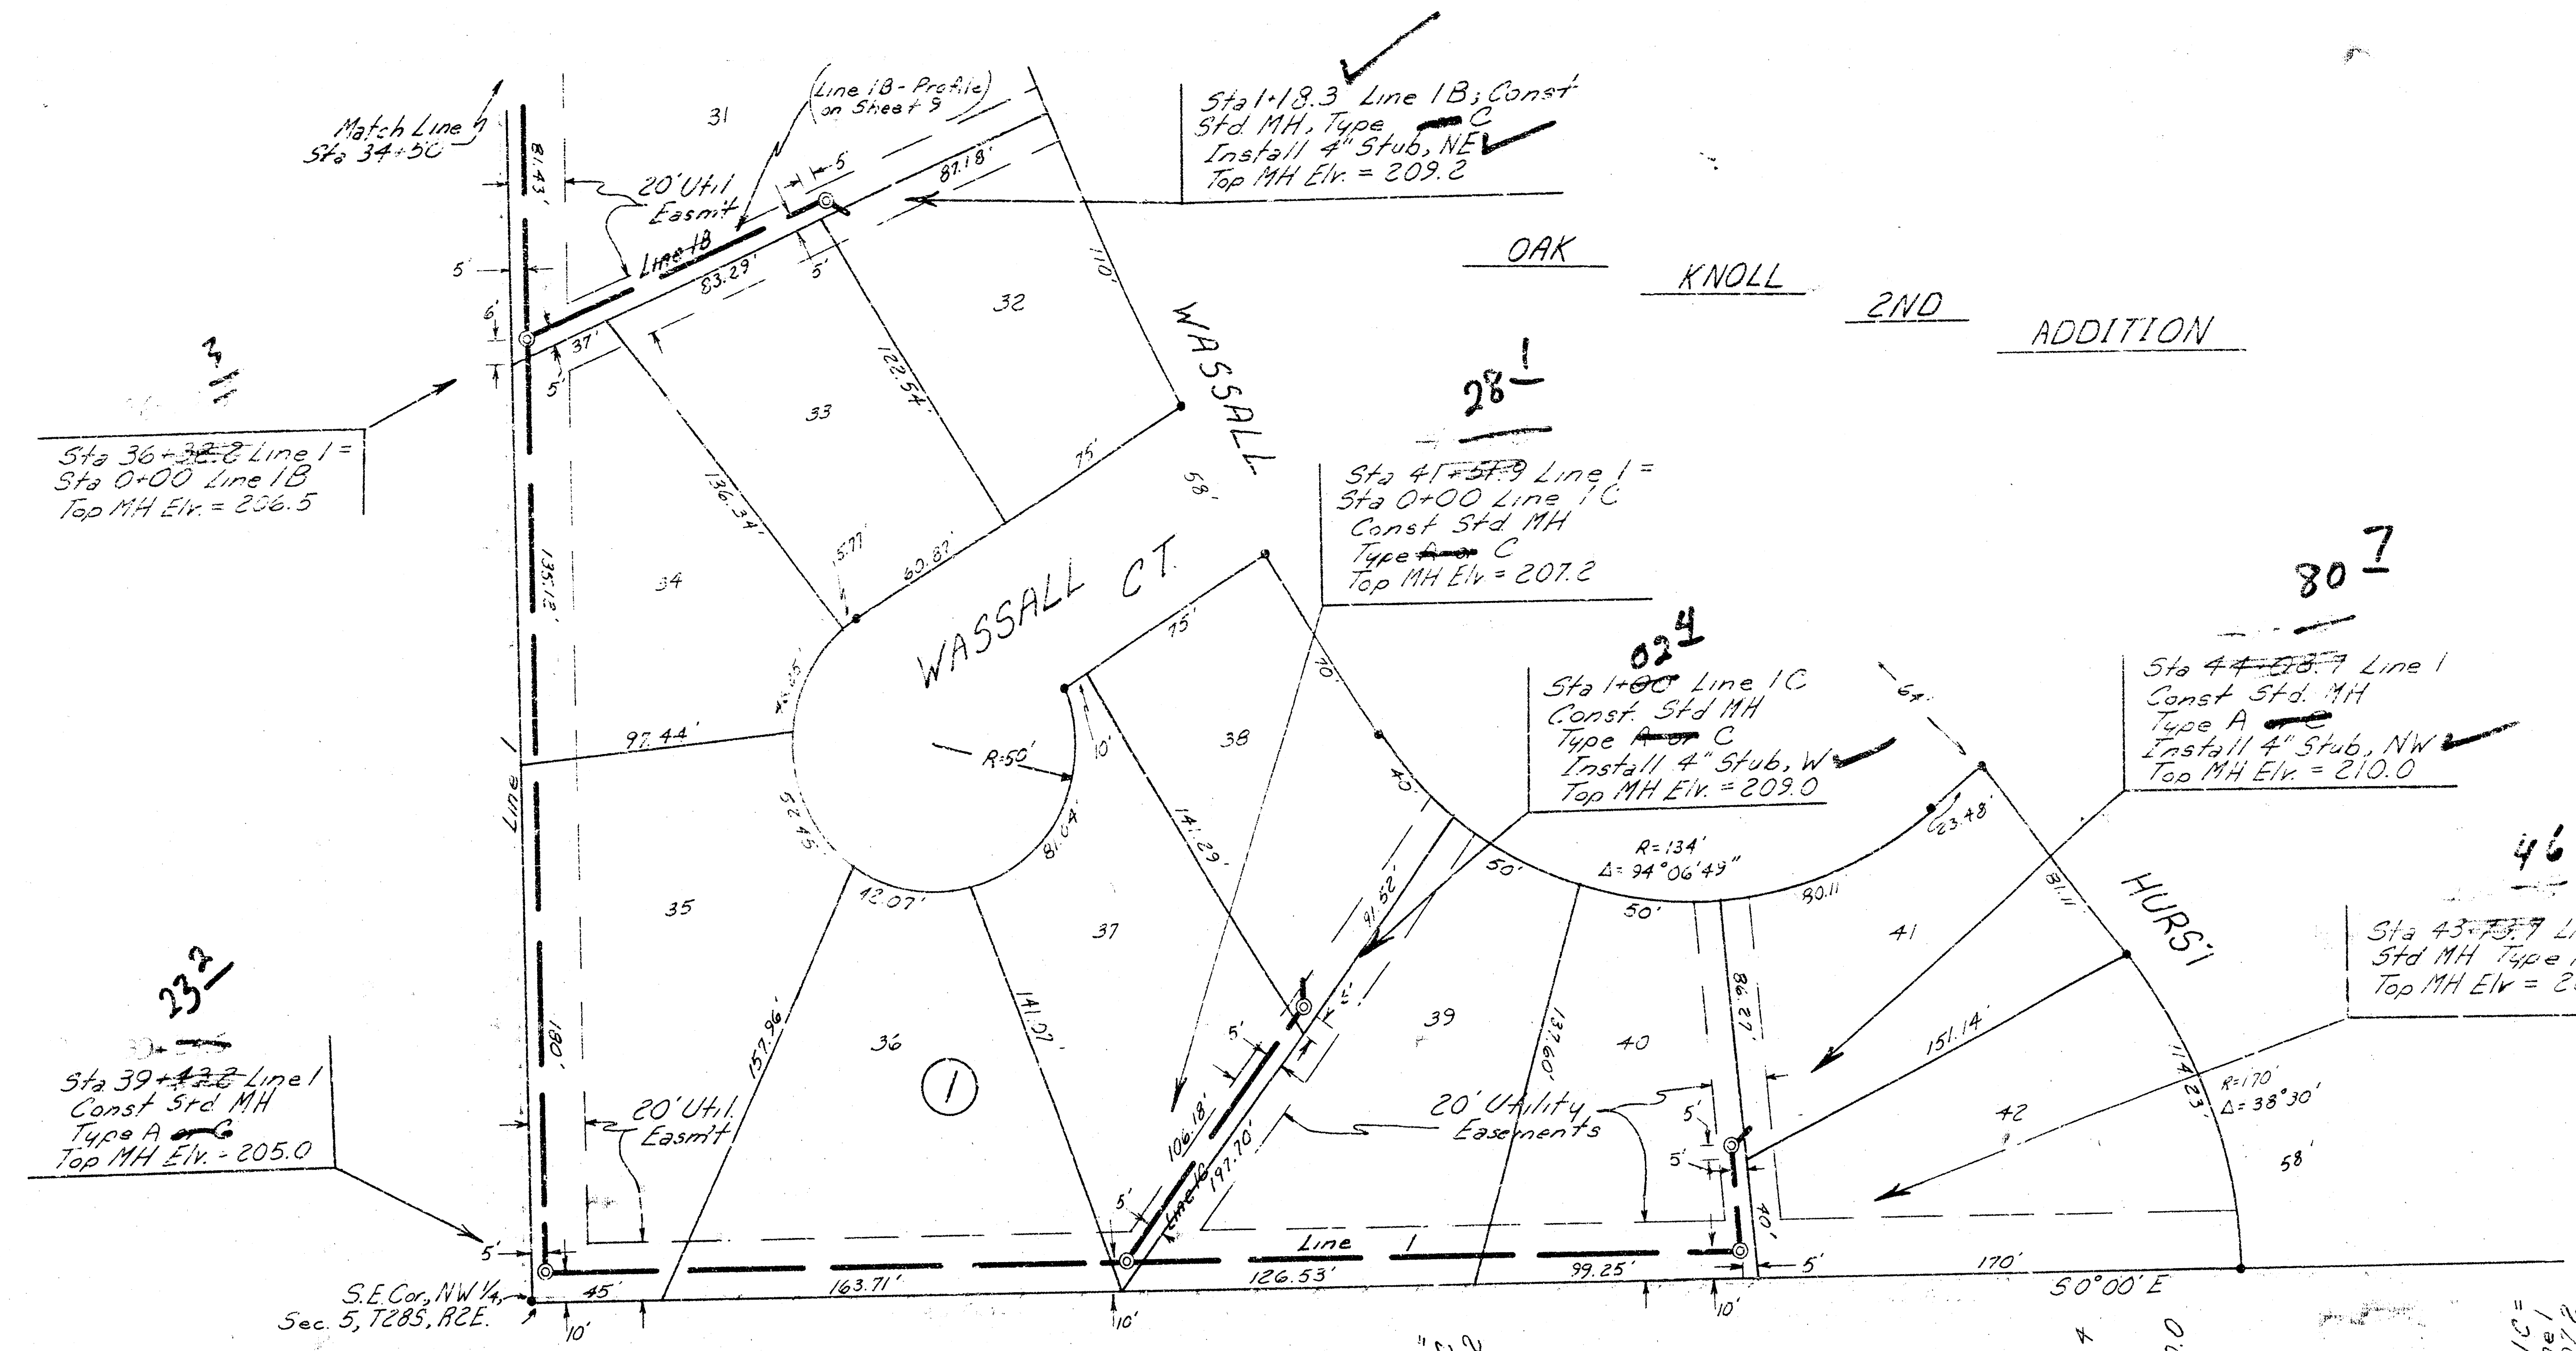


Line 1, Line 1C
 Lateral 1, Main 23, W.S.
 Proj. # 468-16-245-80999-000-000-001

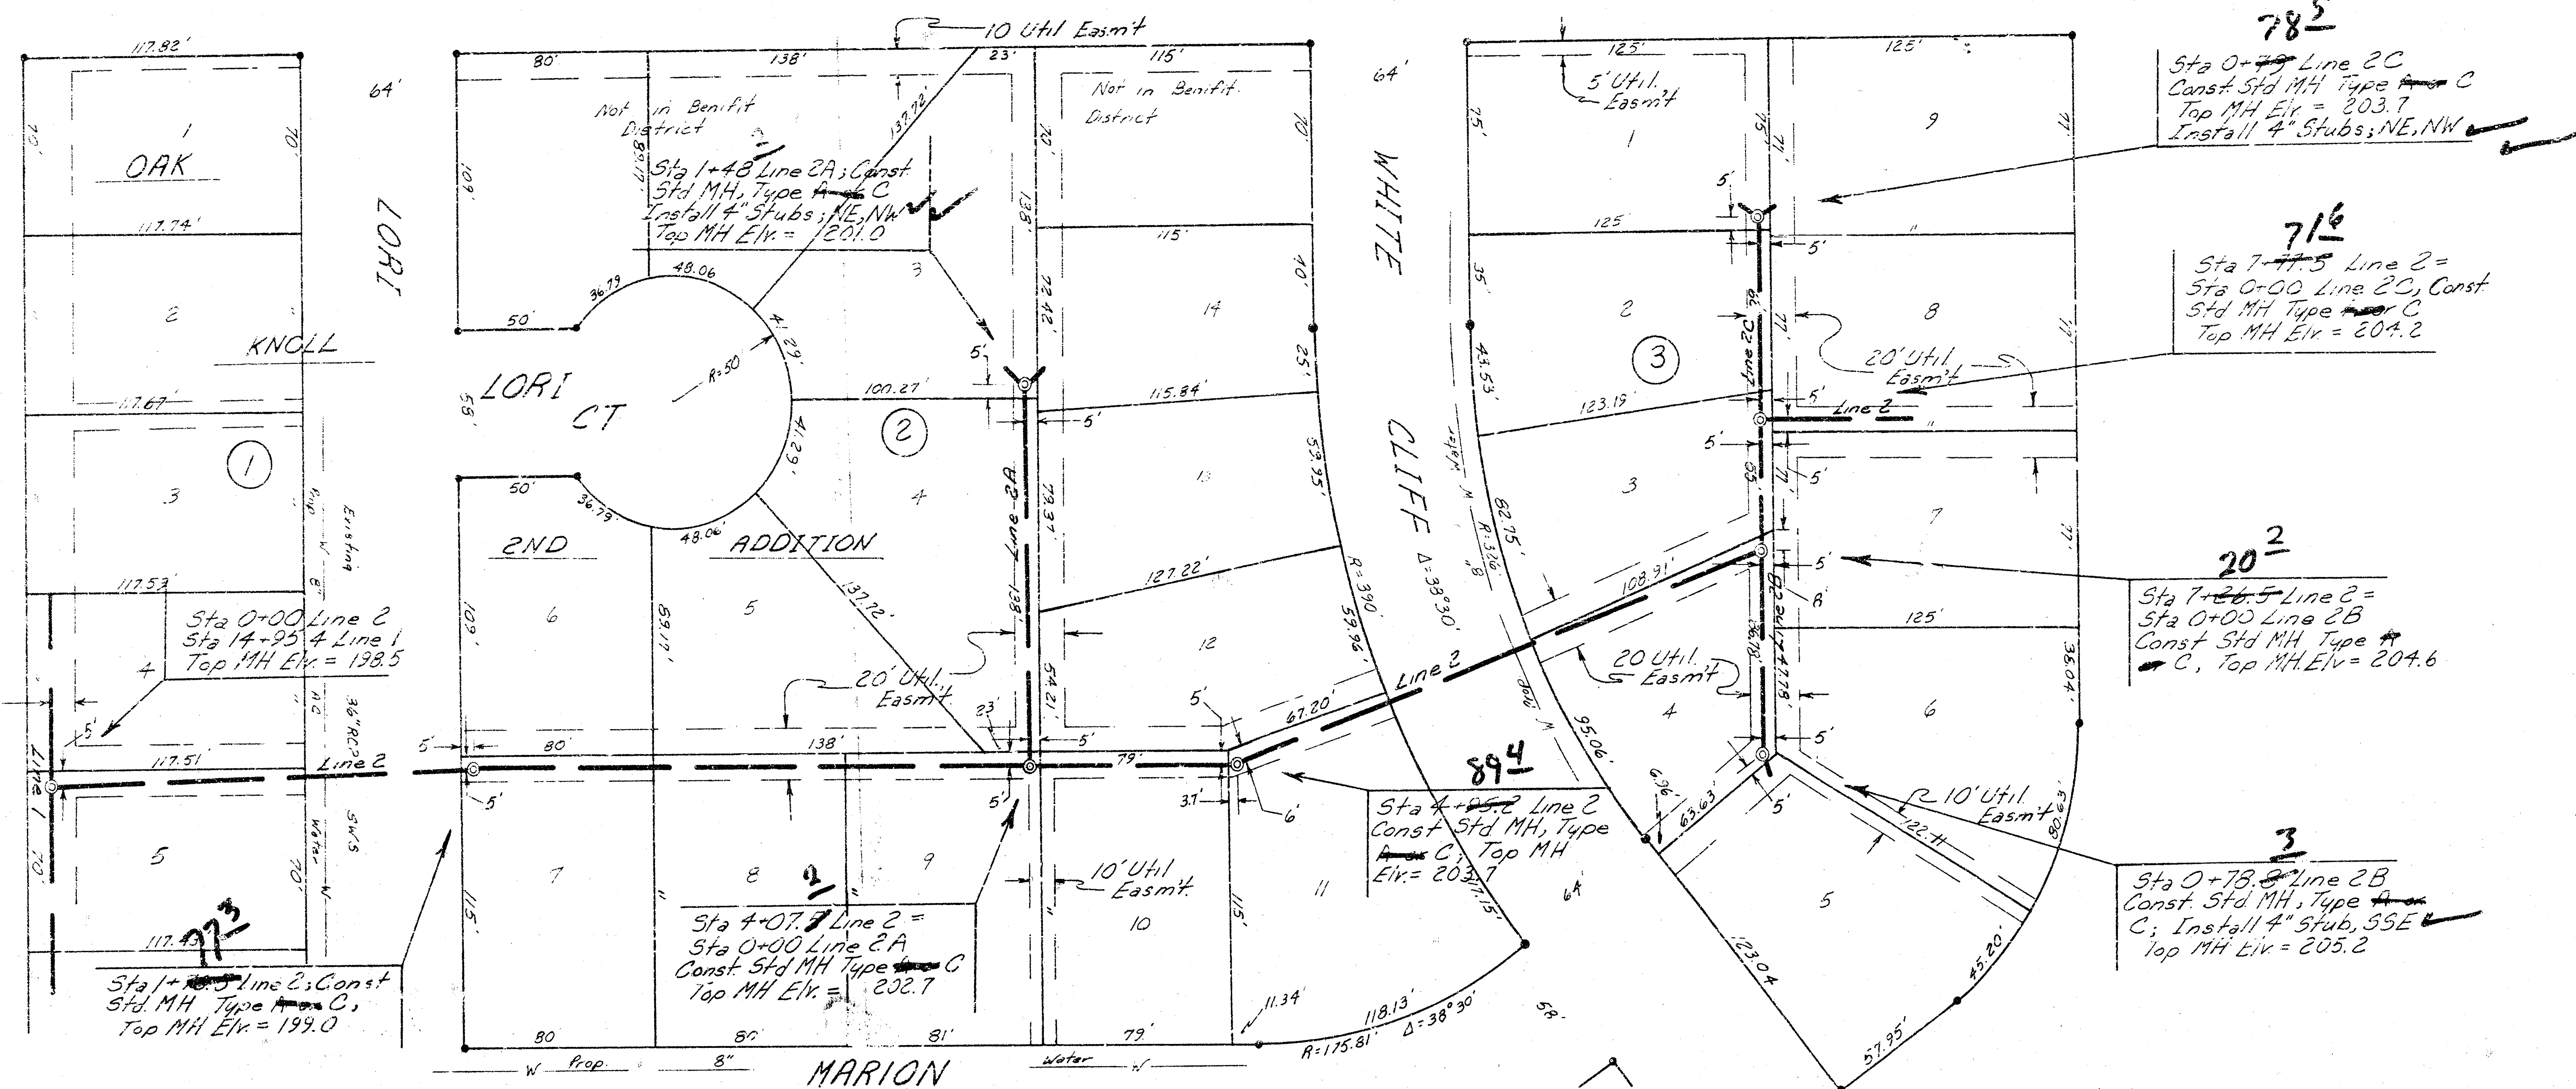

SCALE: 1" = 40' Plan
 1" = 40' Profile
 1" = 5' Vert.
 - Irons



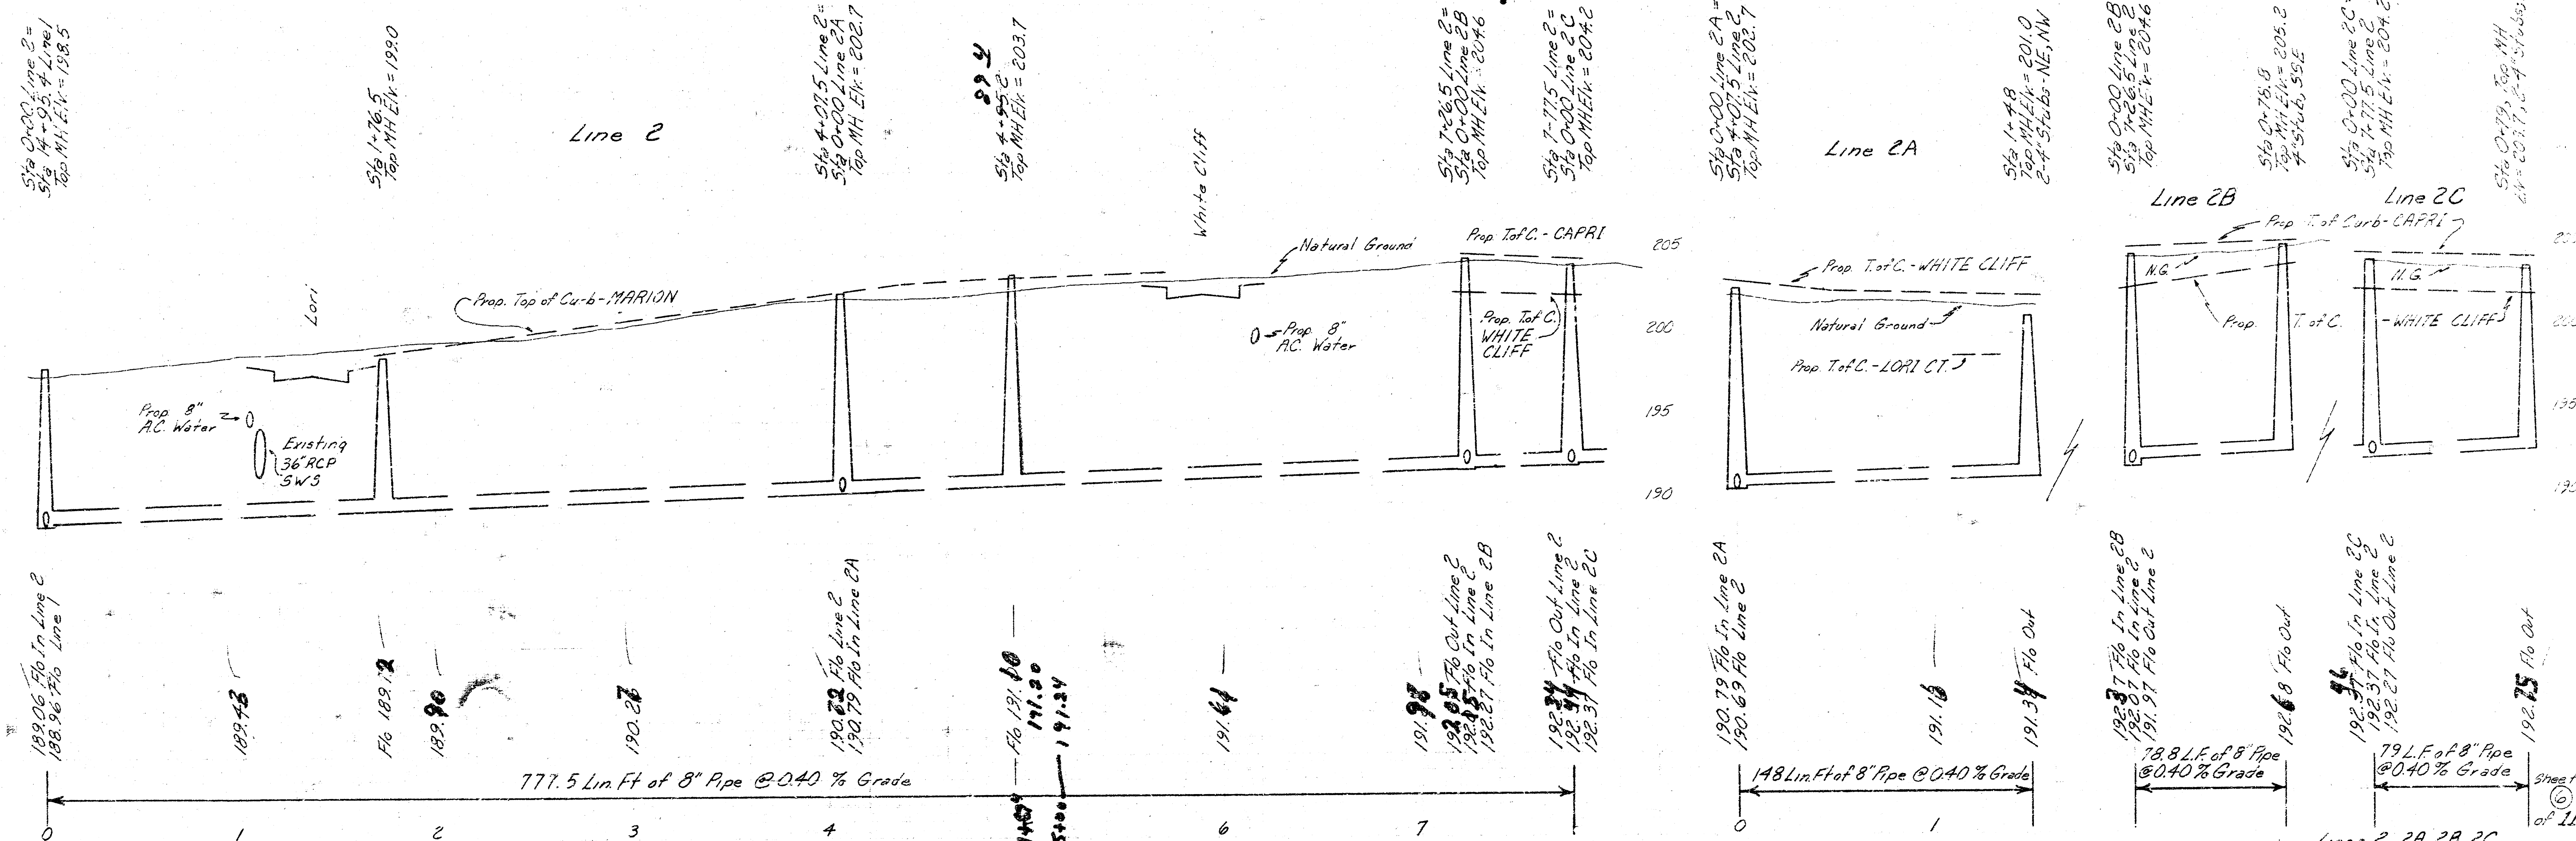


Lines 2, 2A, 2B, 2C.
 Lateral 1, Main 23, W.I.S.
 Proj # 468-76-2+5-000-000-001

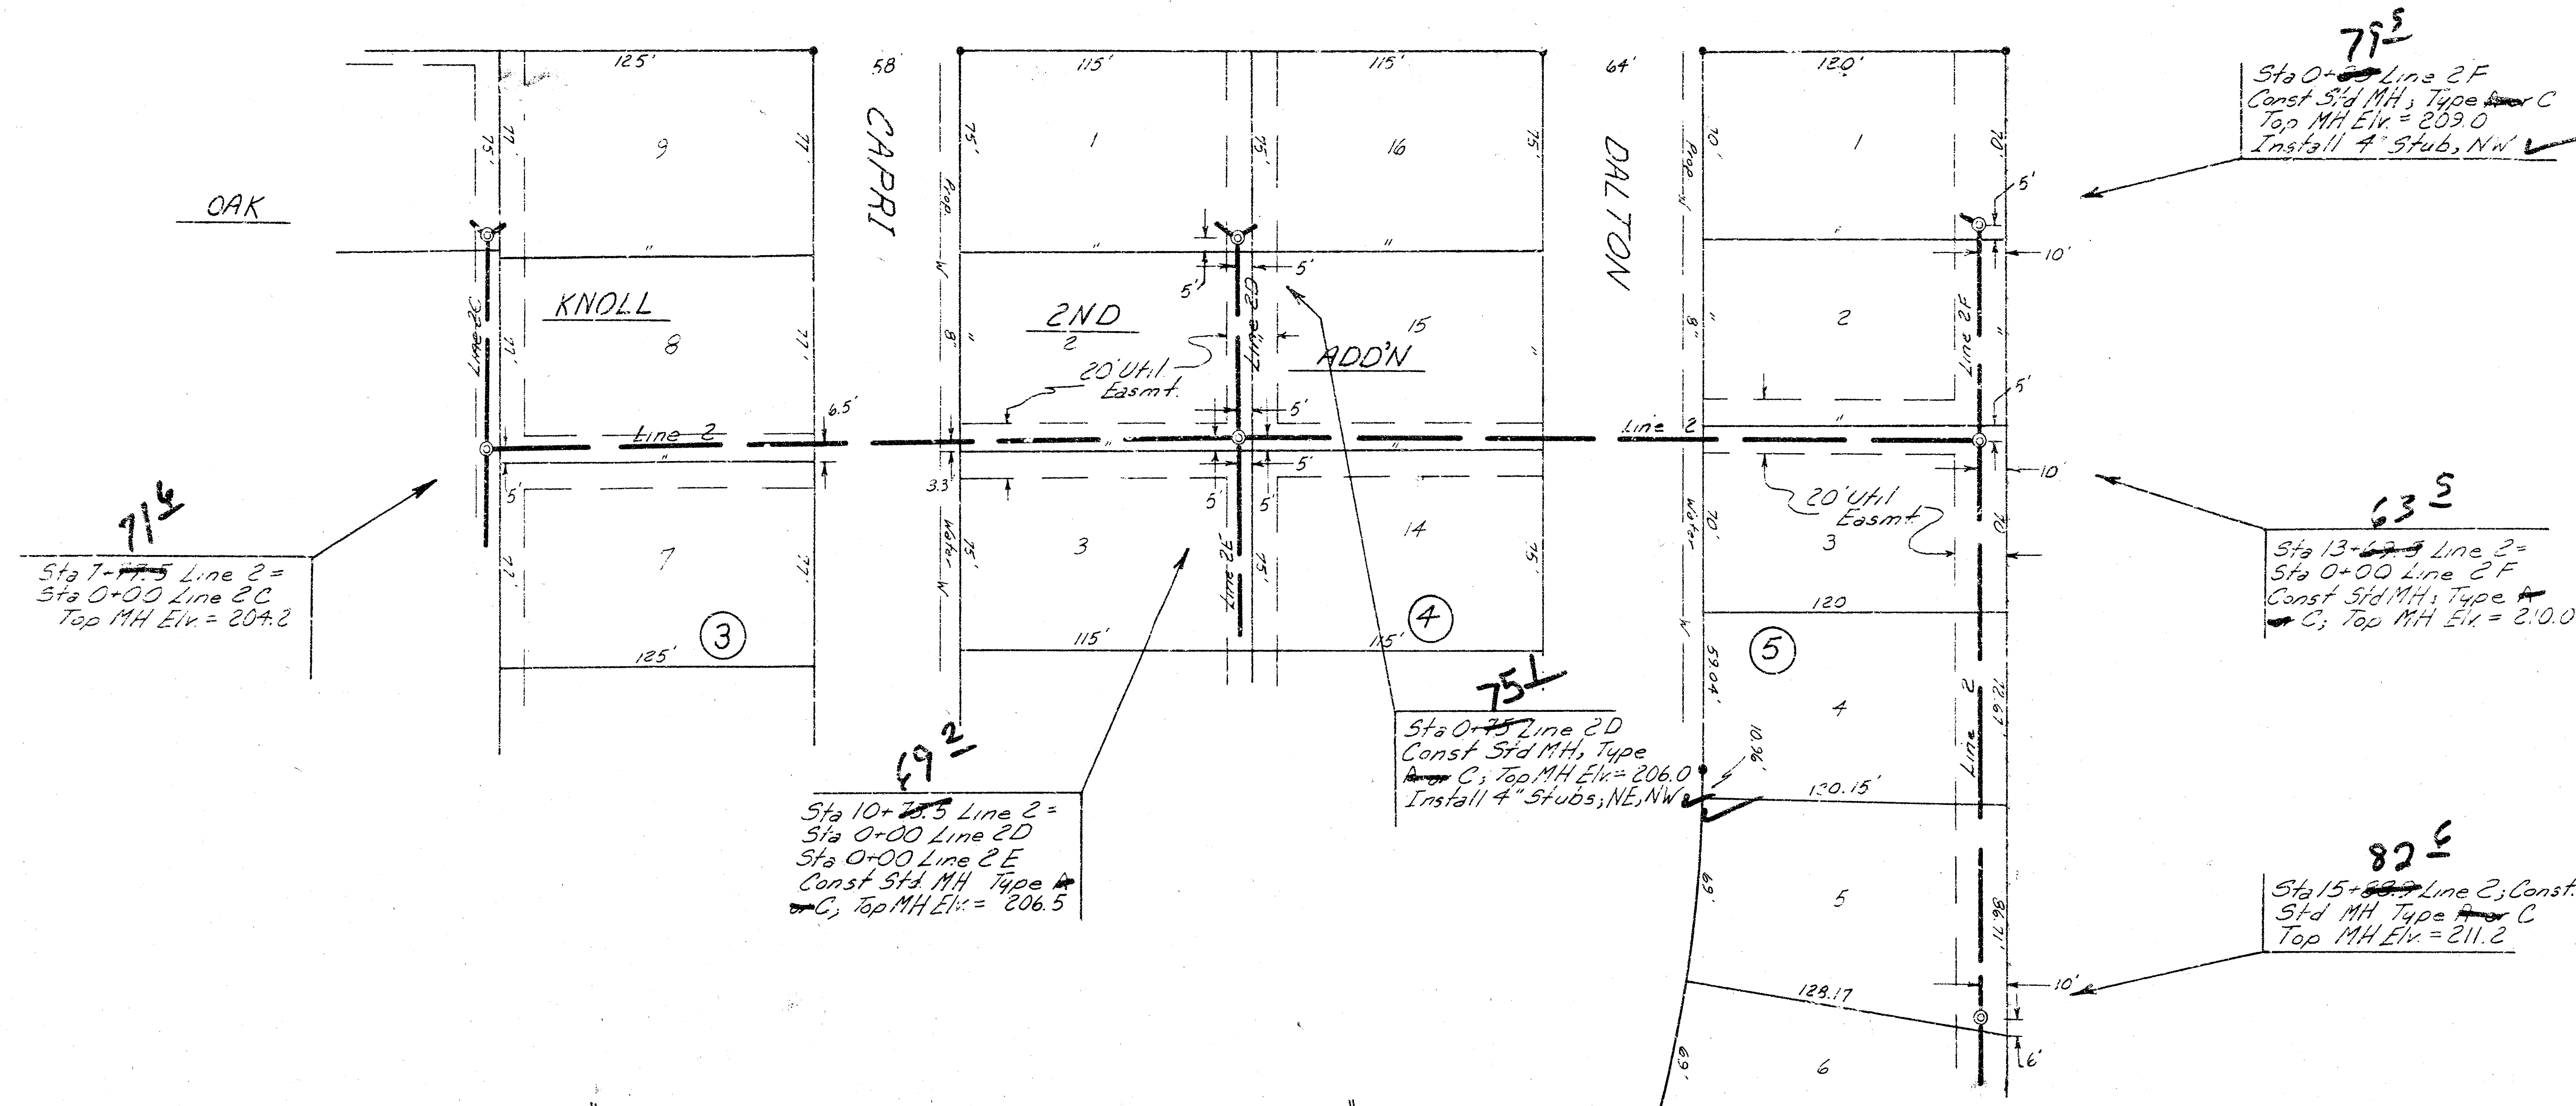





As Built
 7/5
 17/51

SCALE: 1" = 40' Plan
 1" = 40' Profile
 1" = 5' Vert.

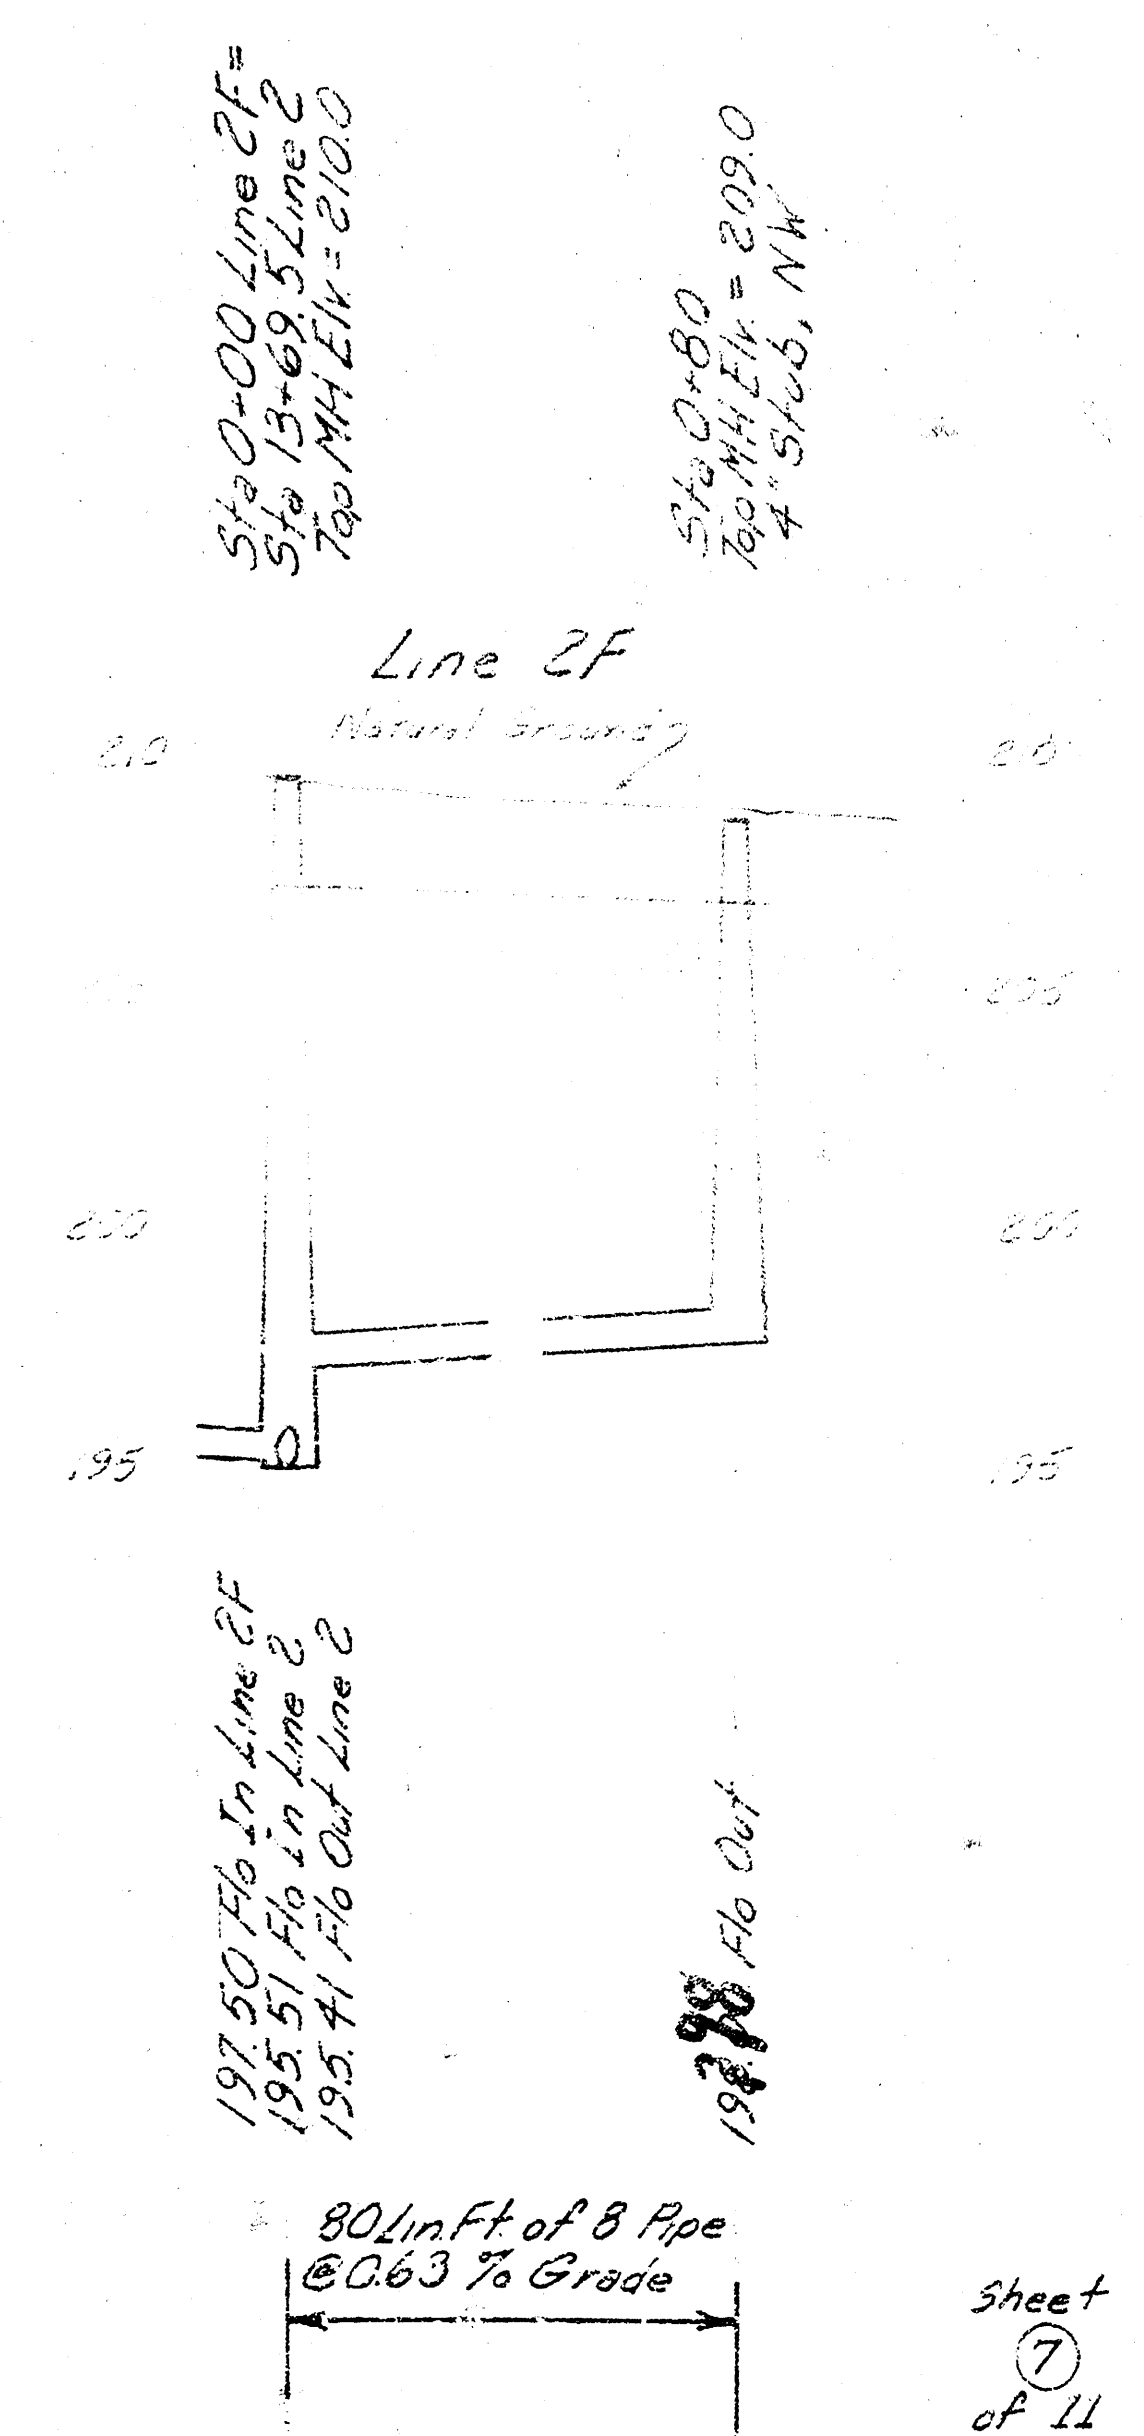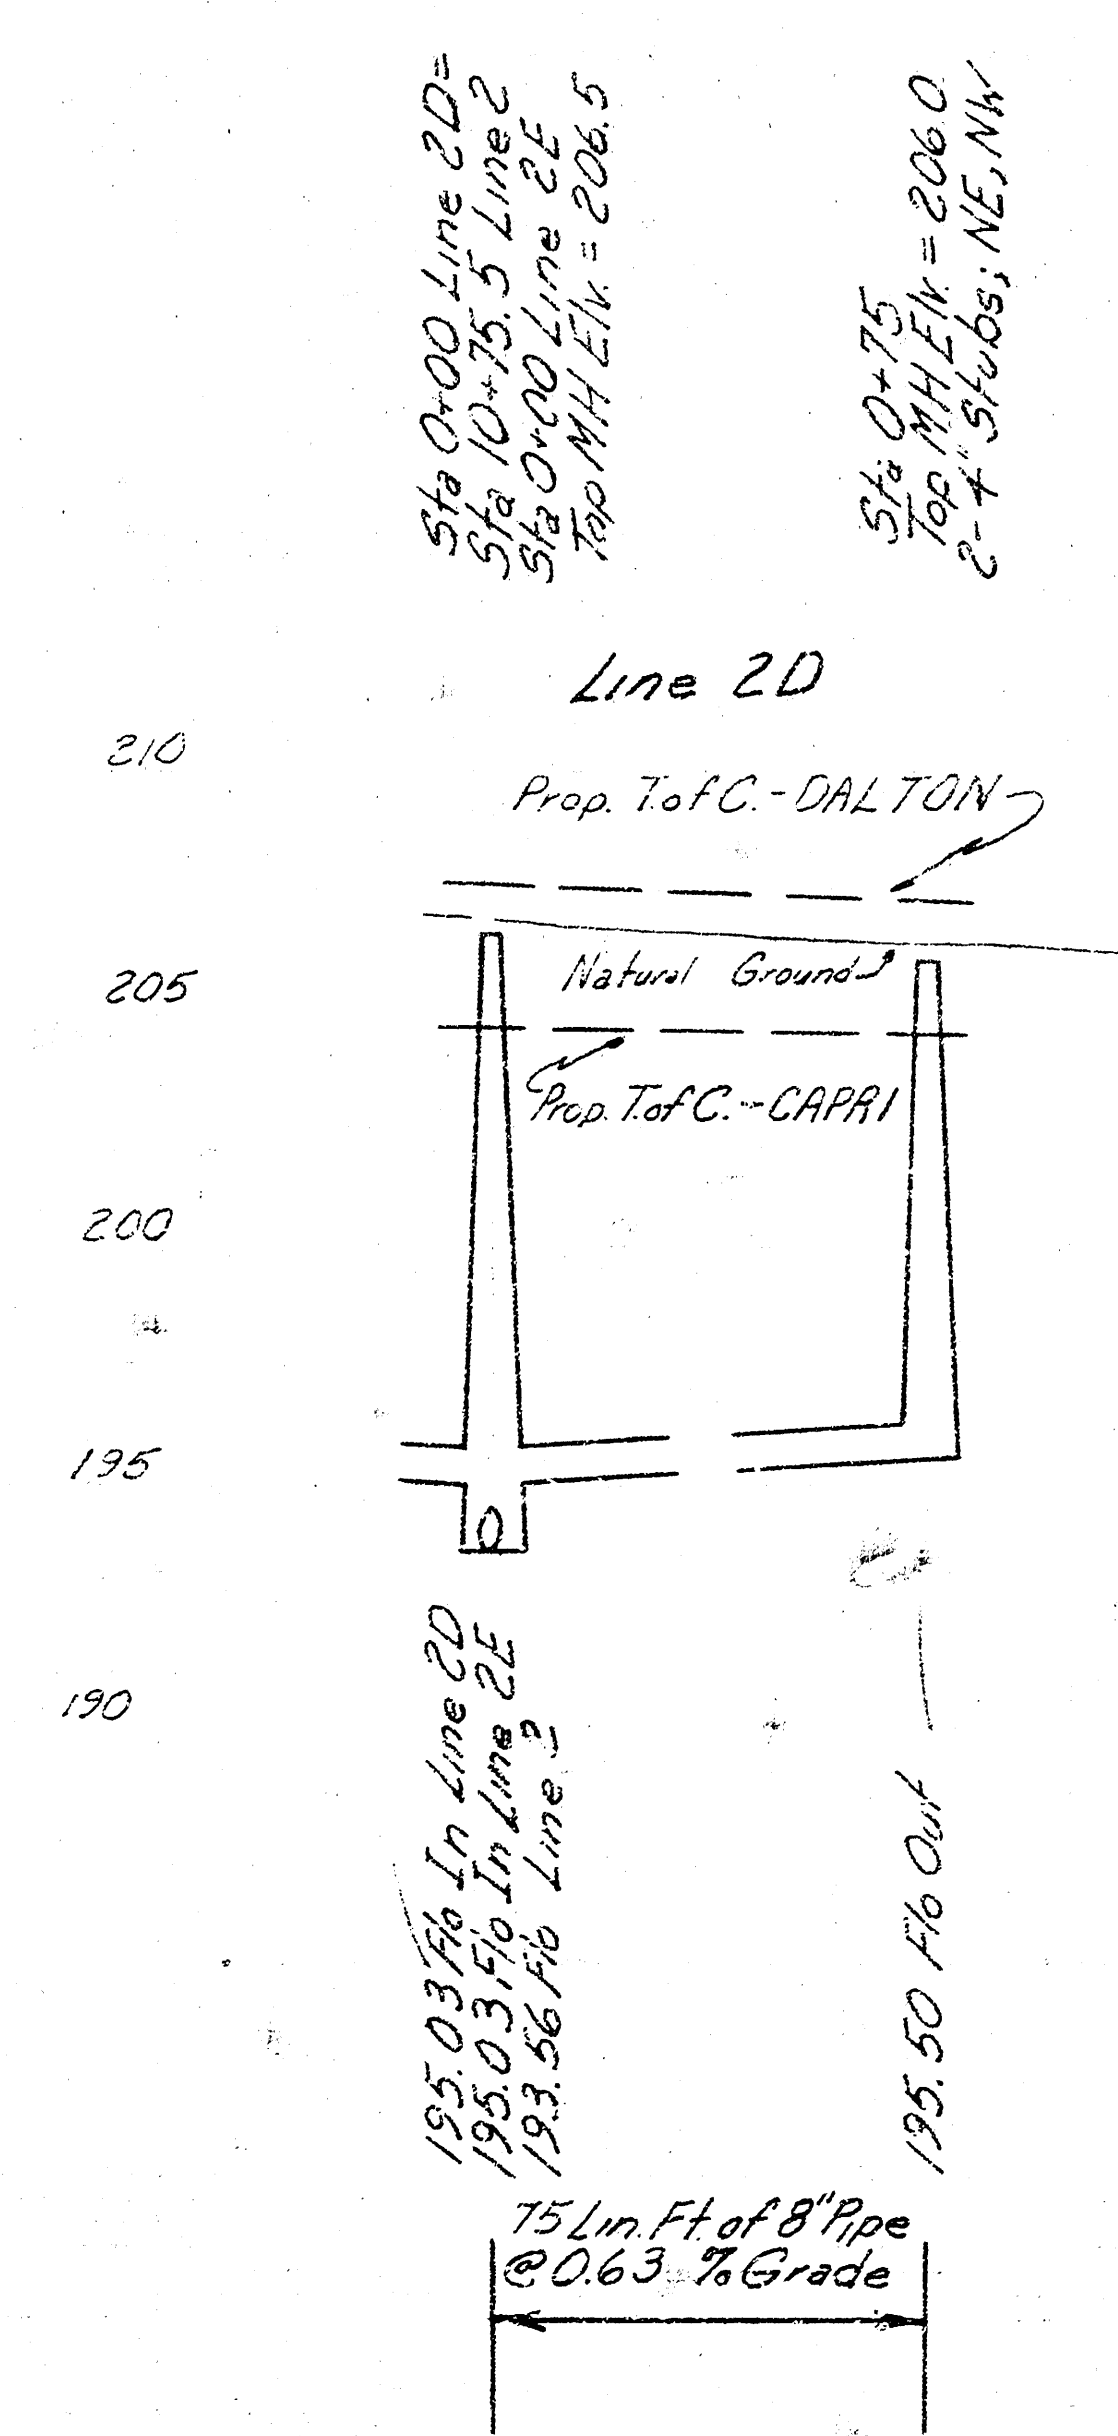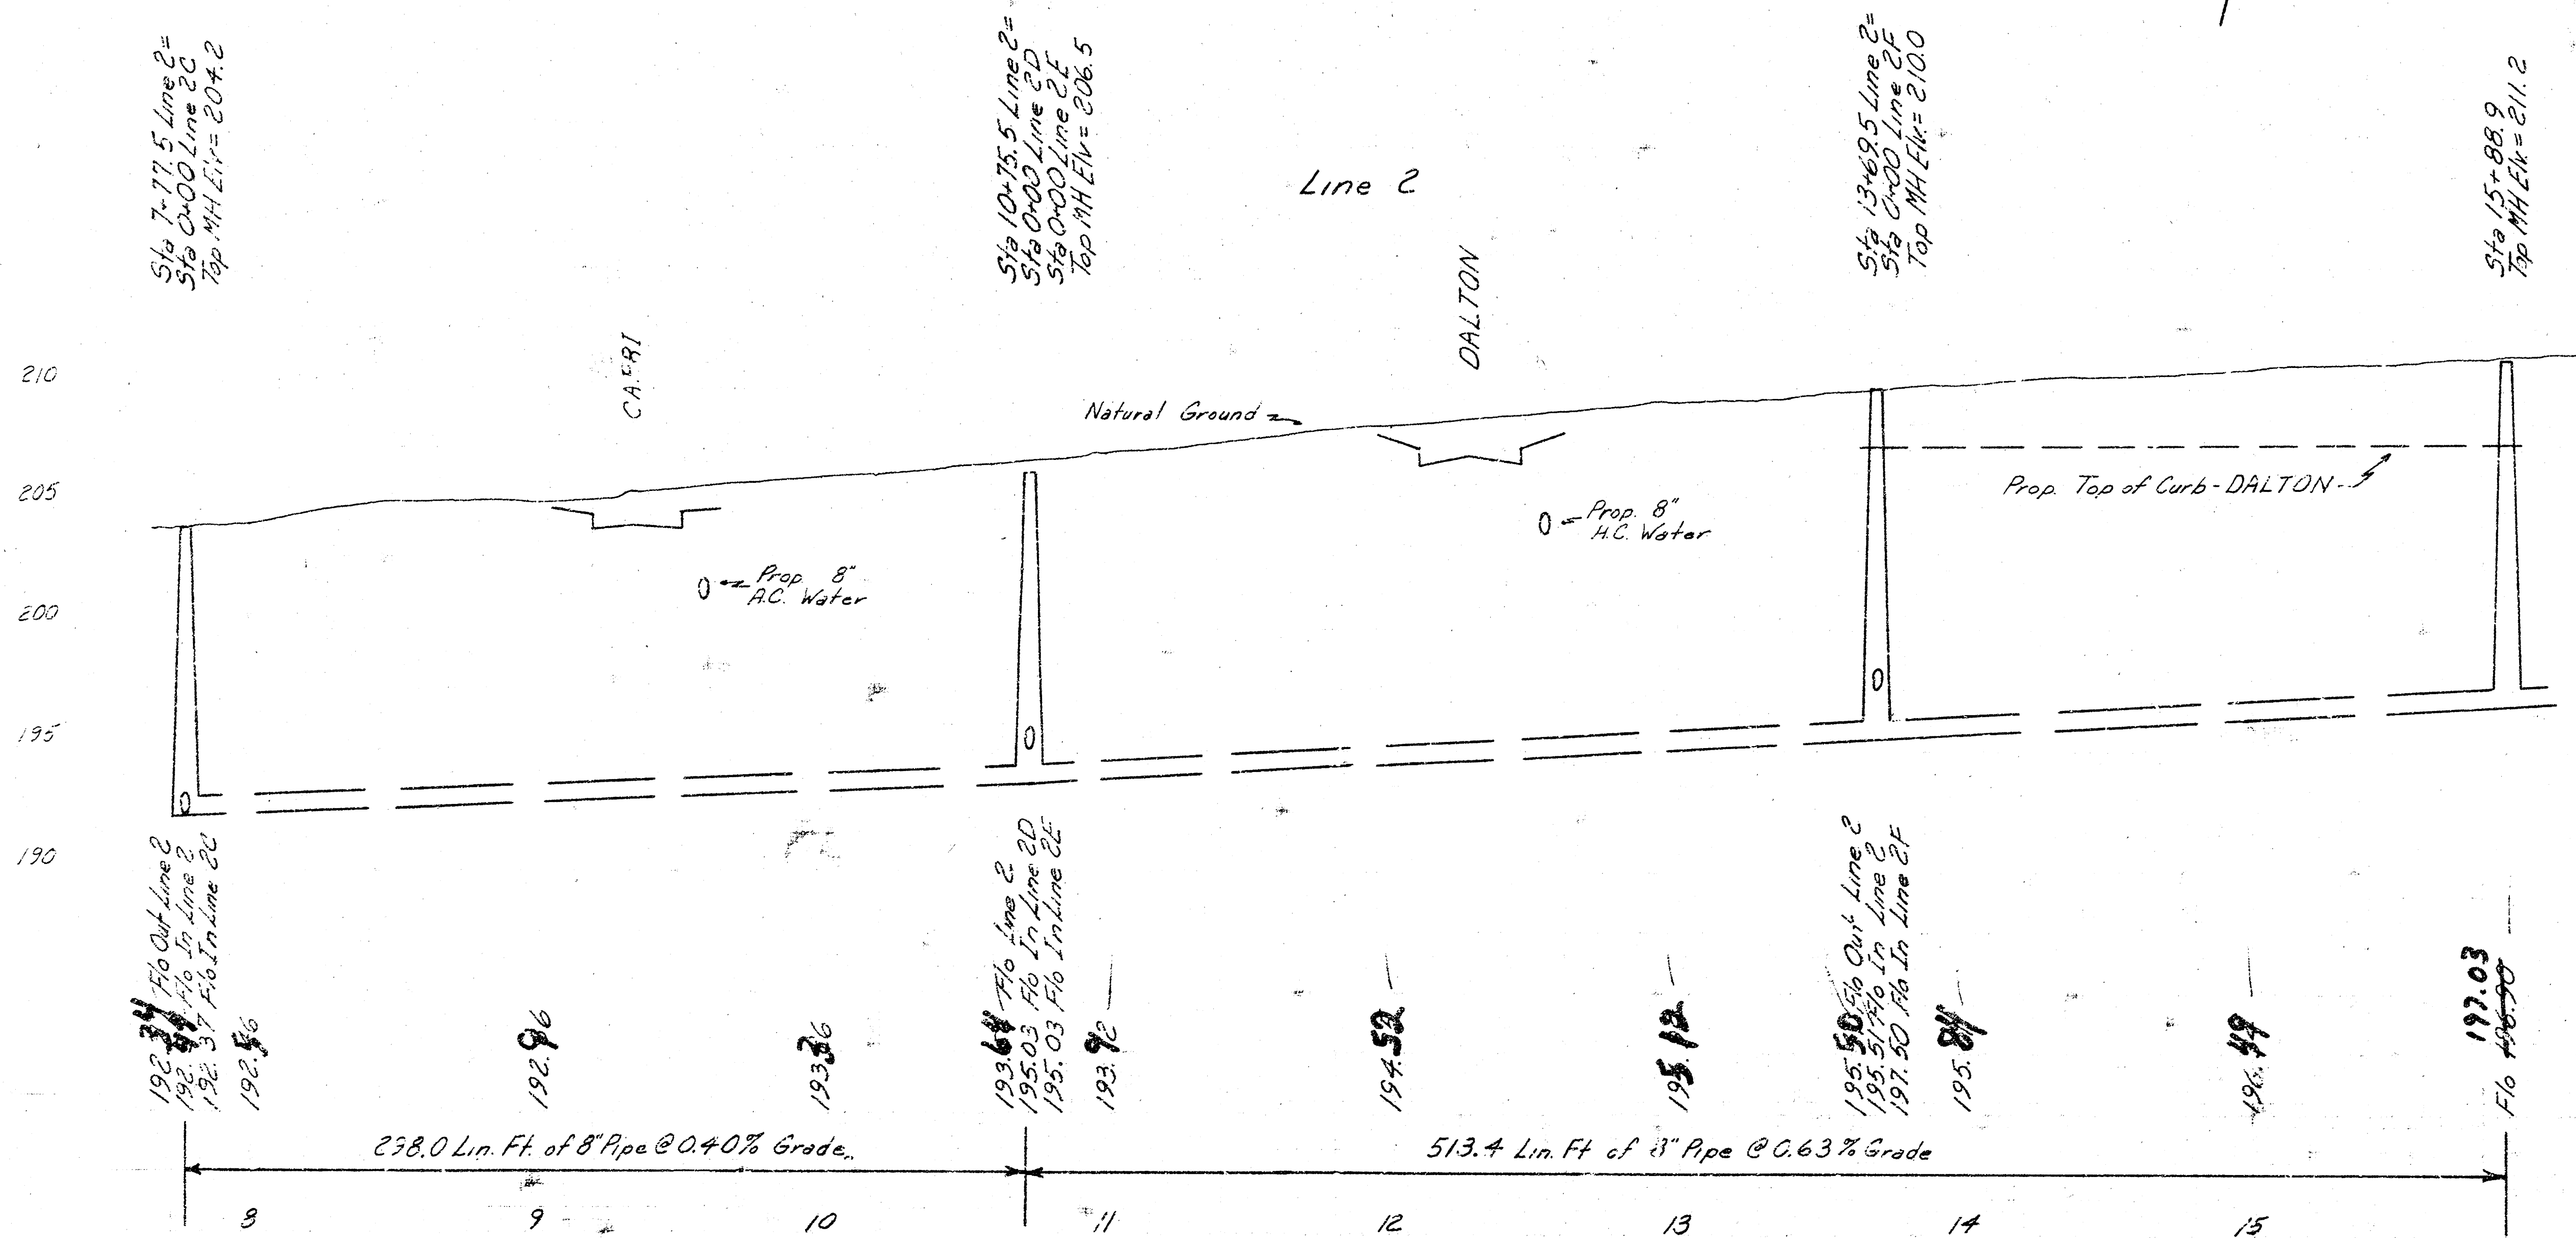




Line 2, Lins 2D, Line 2F
 Lateral 1, Main 23, W15
 Proj # 468-76-245-80999-000-000-001

FILMED FROM THE BEST
 AVAILABLE COPY.....

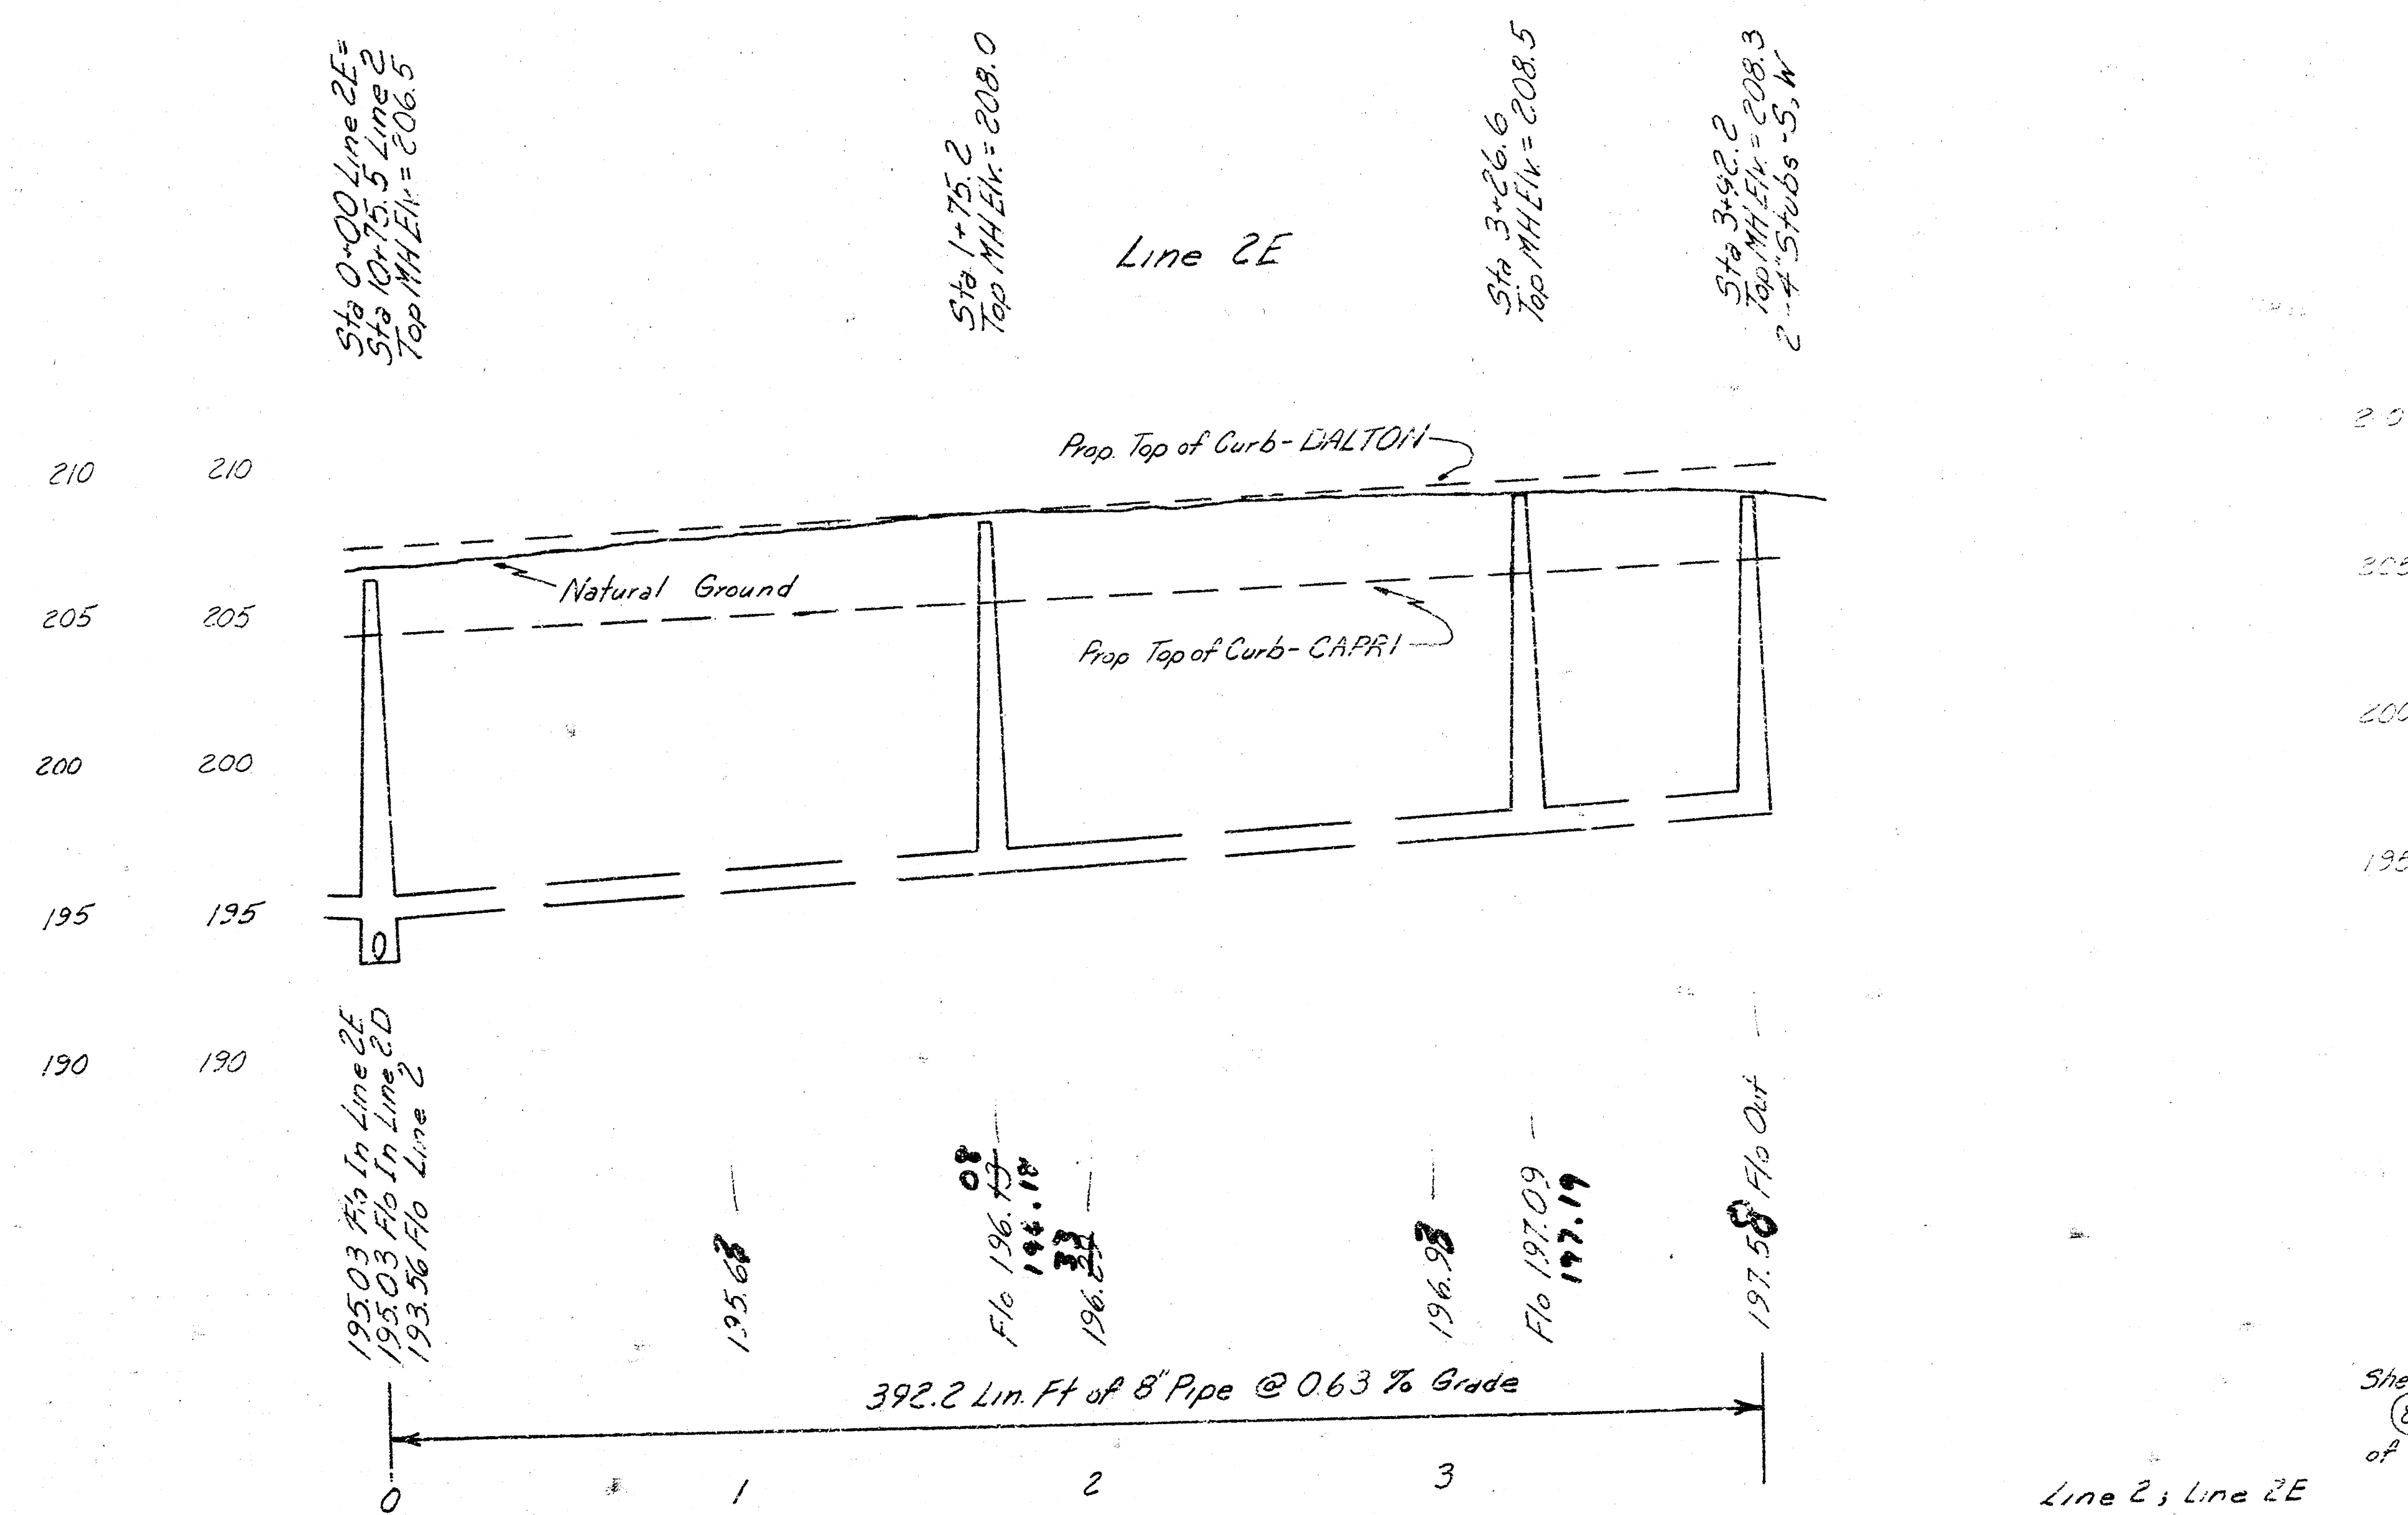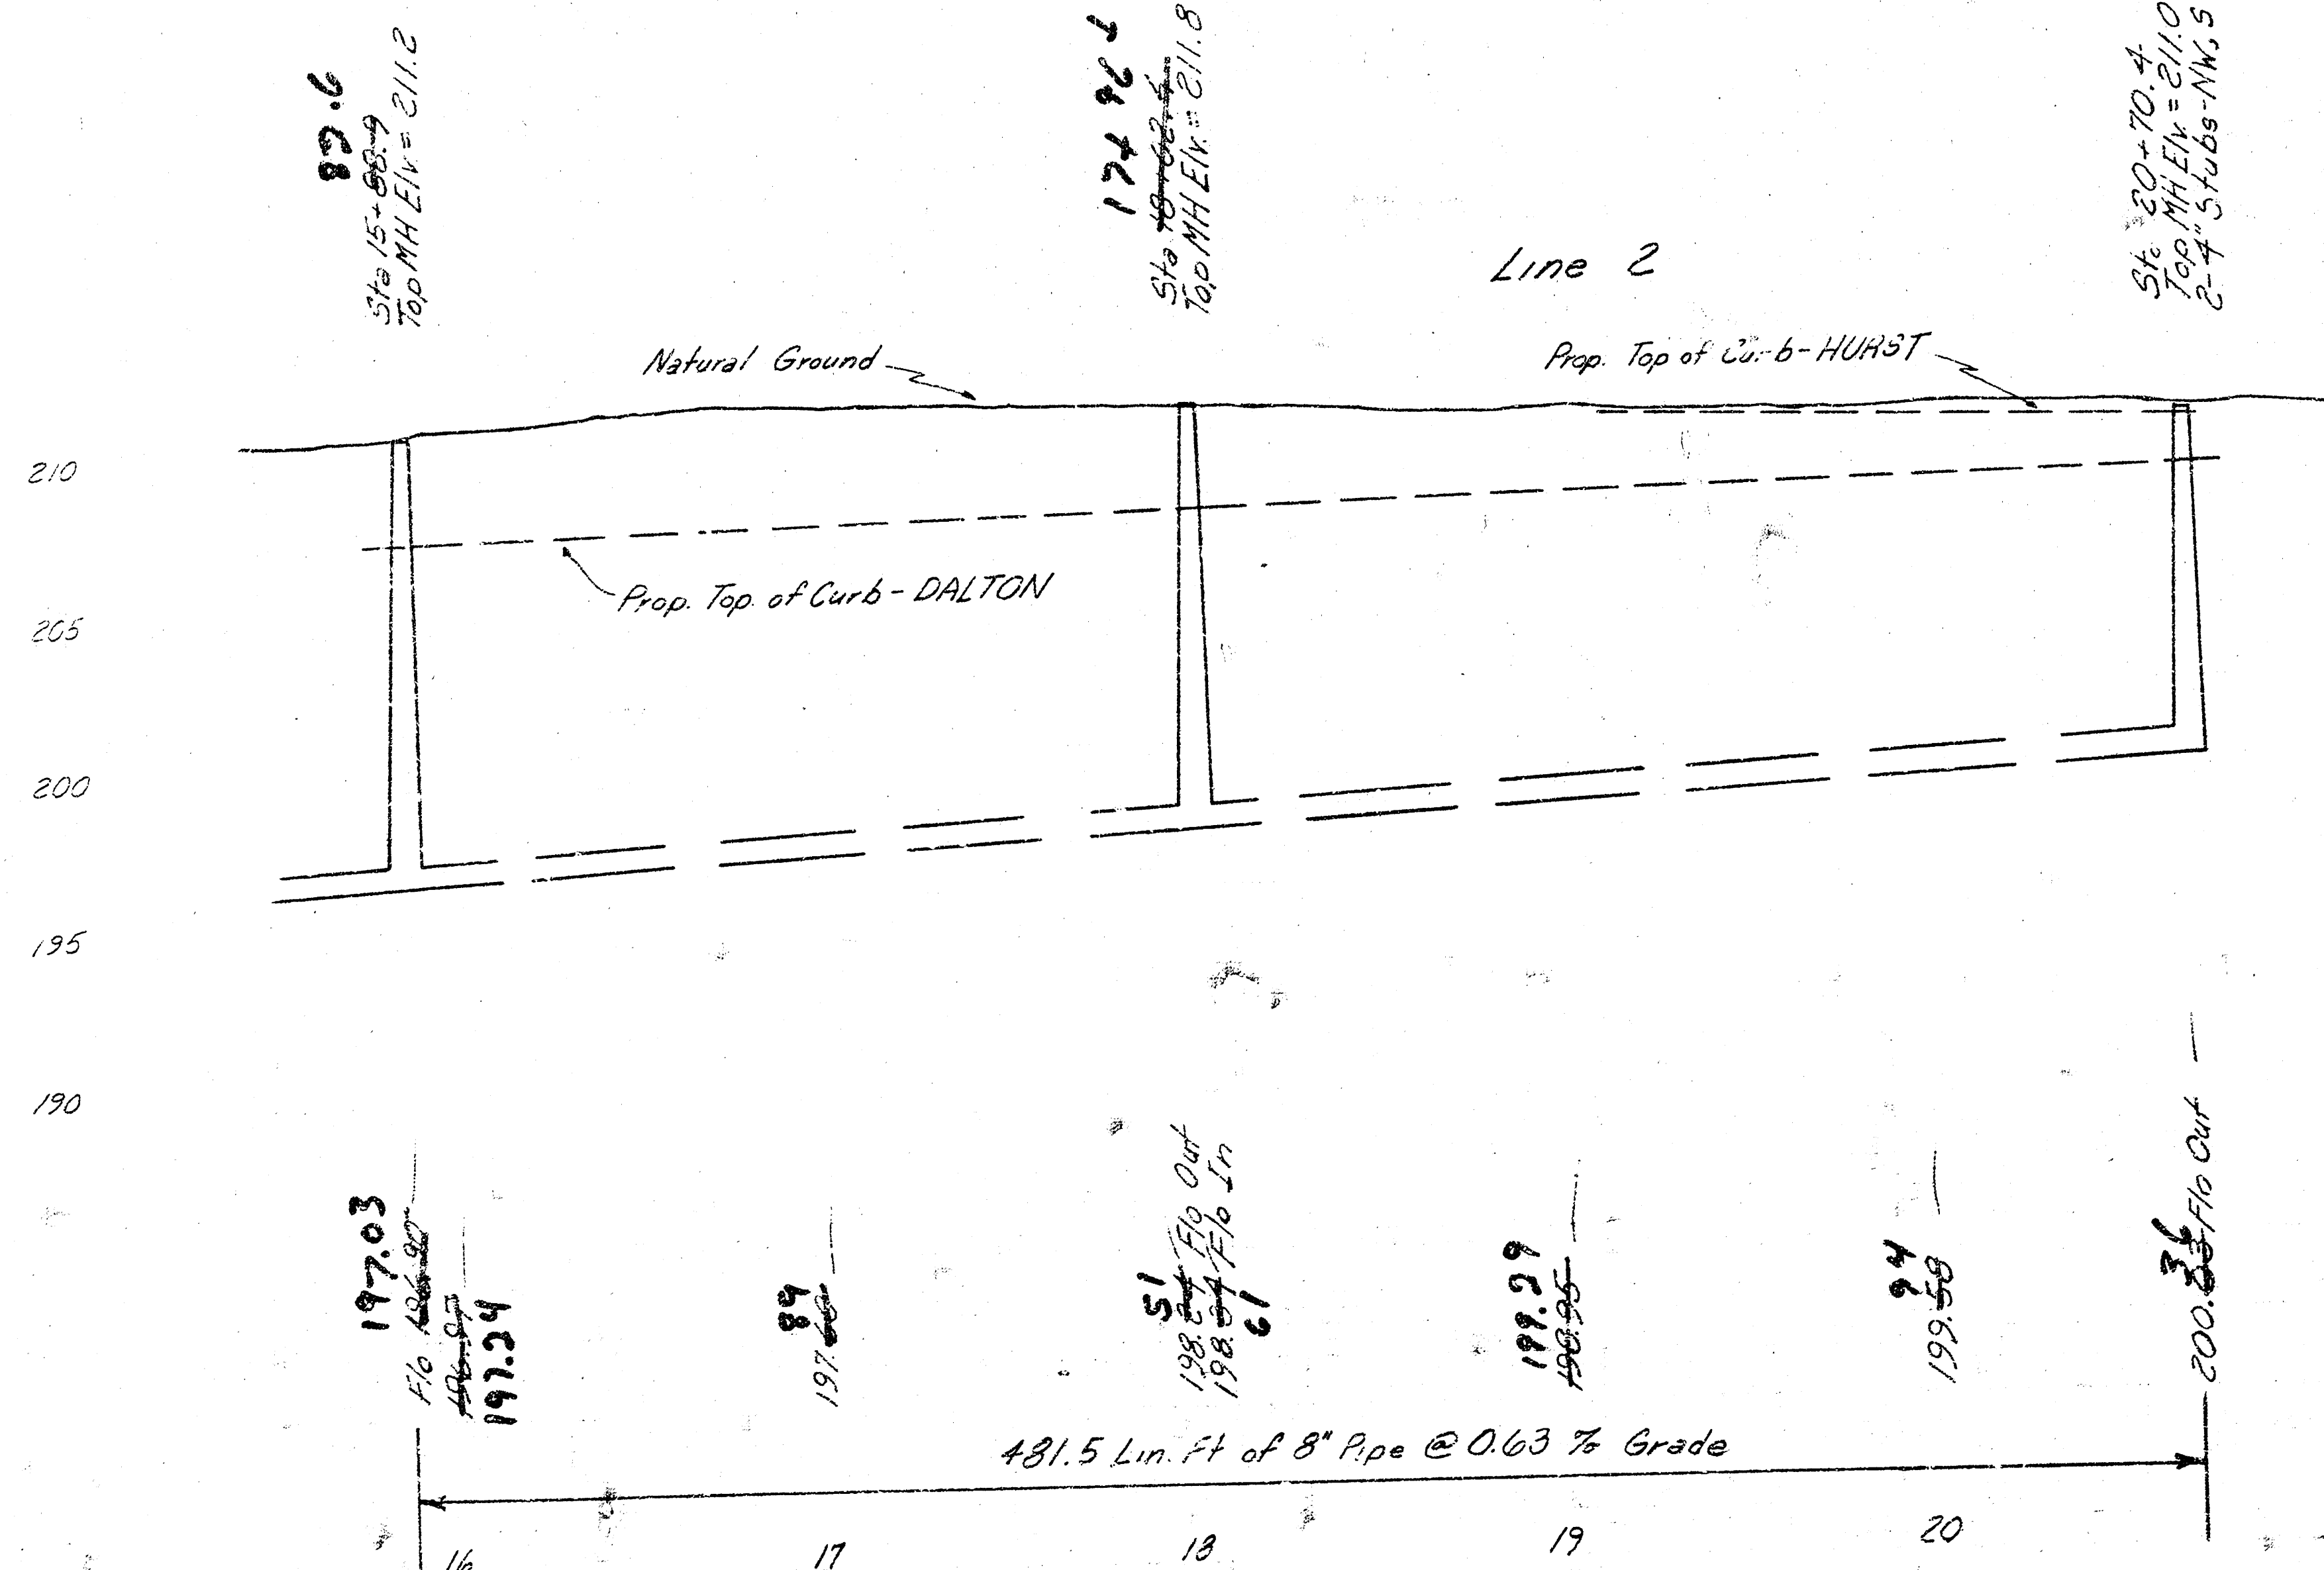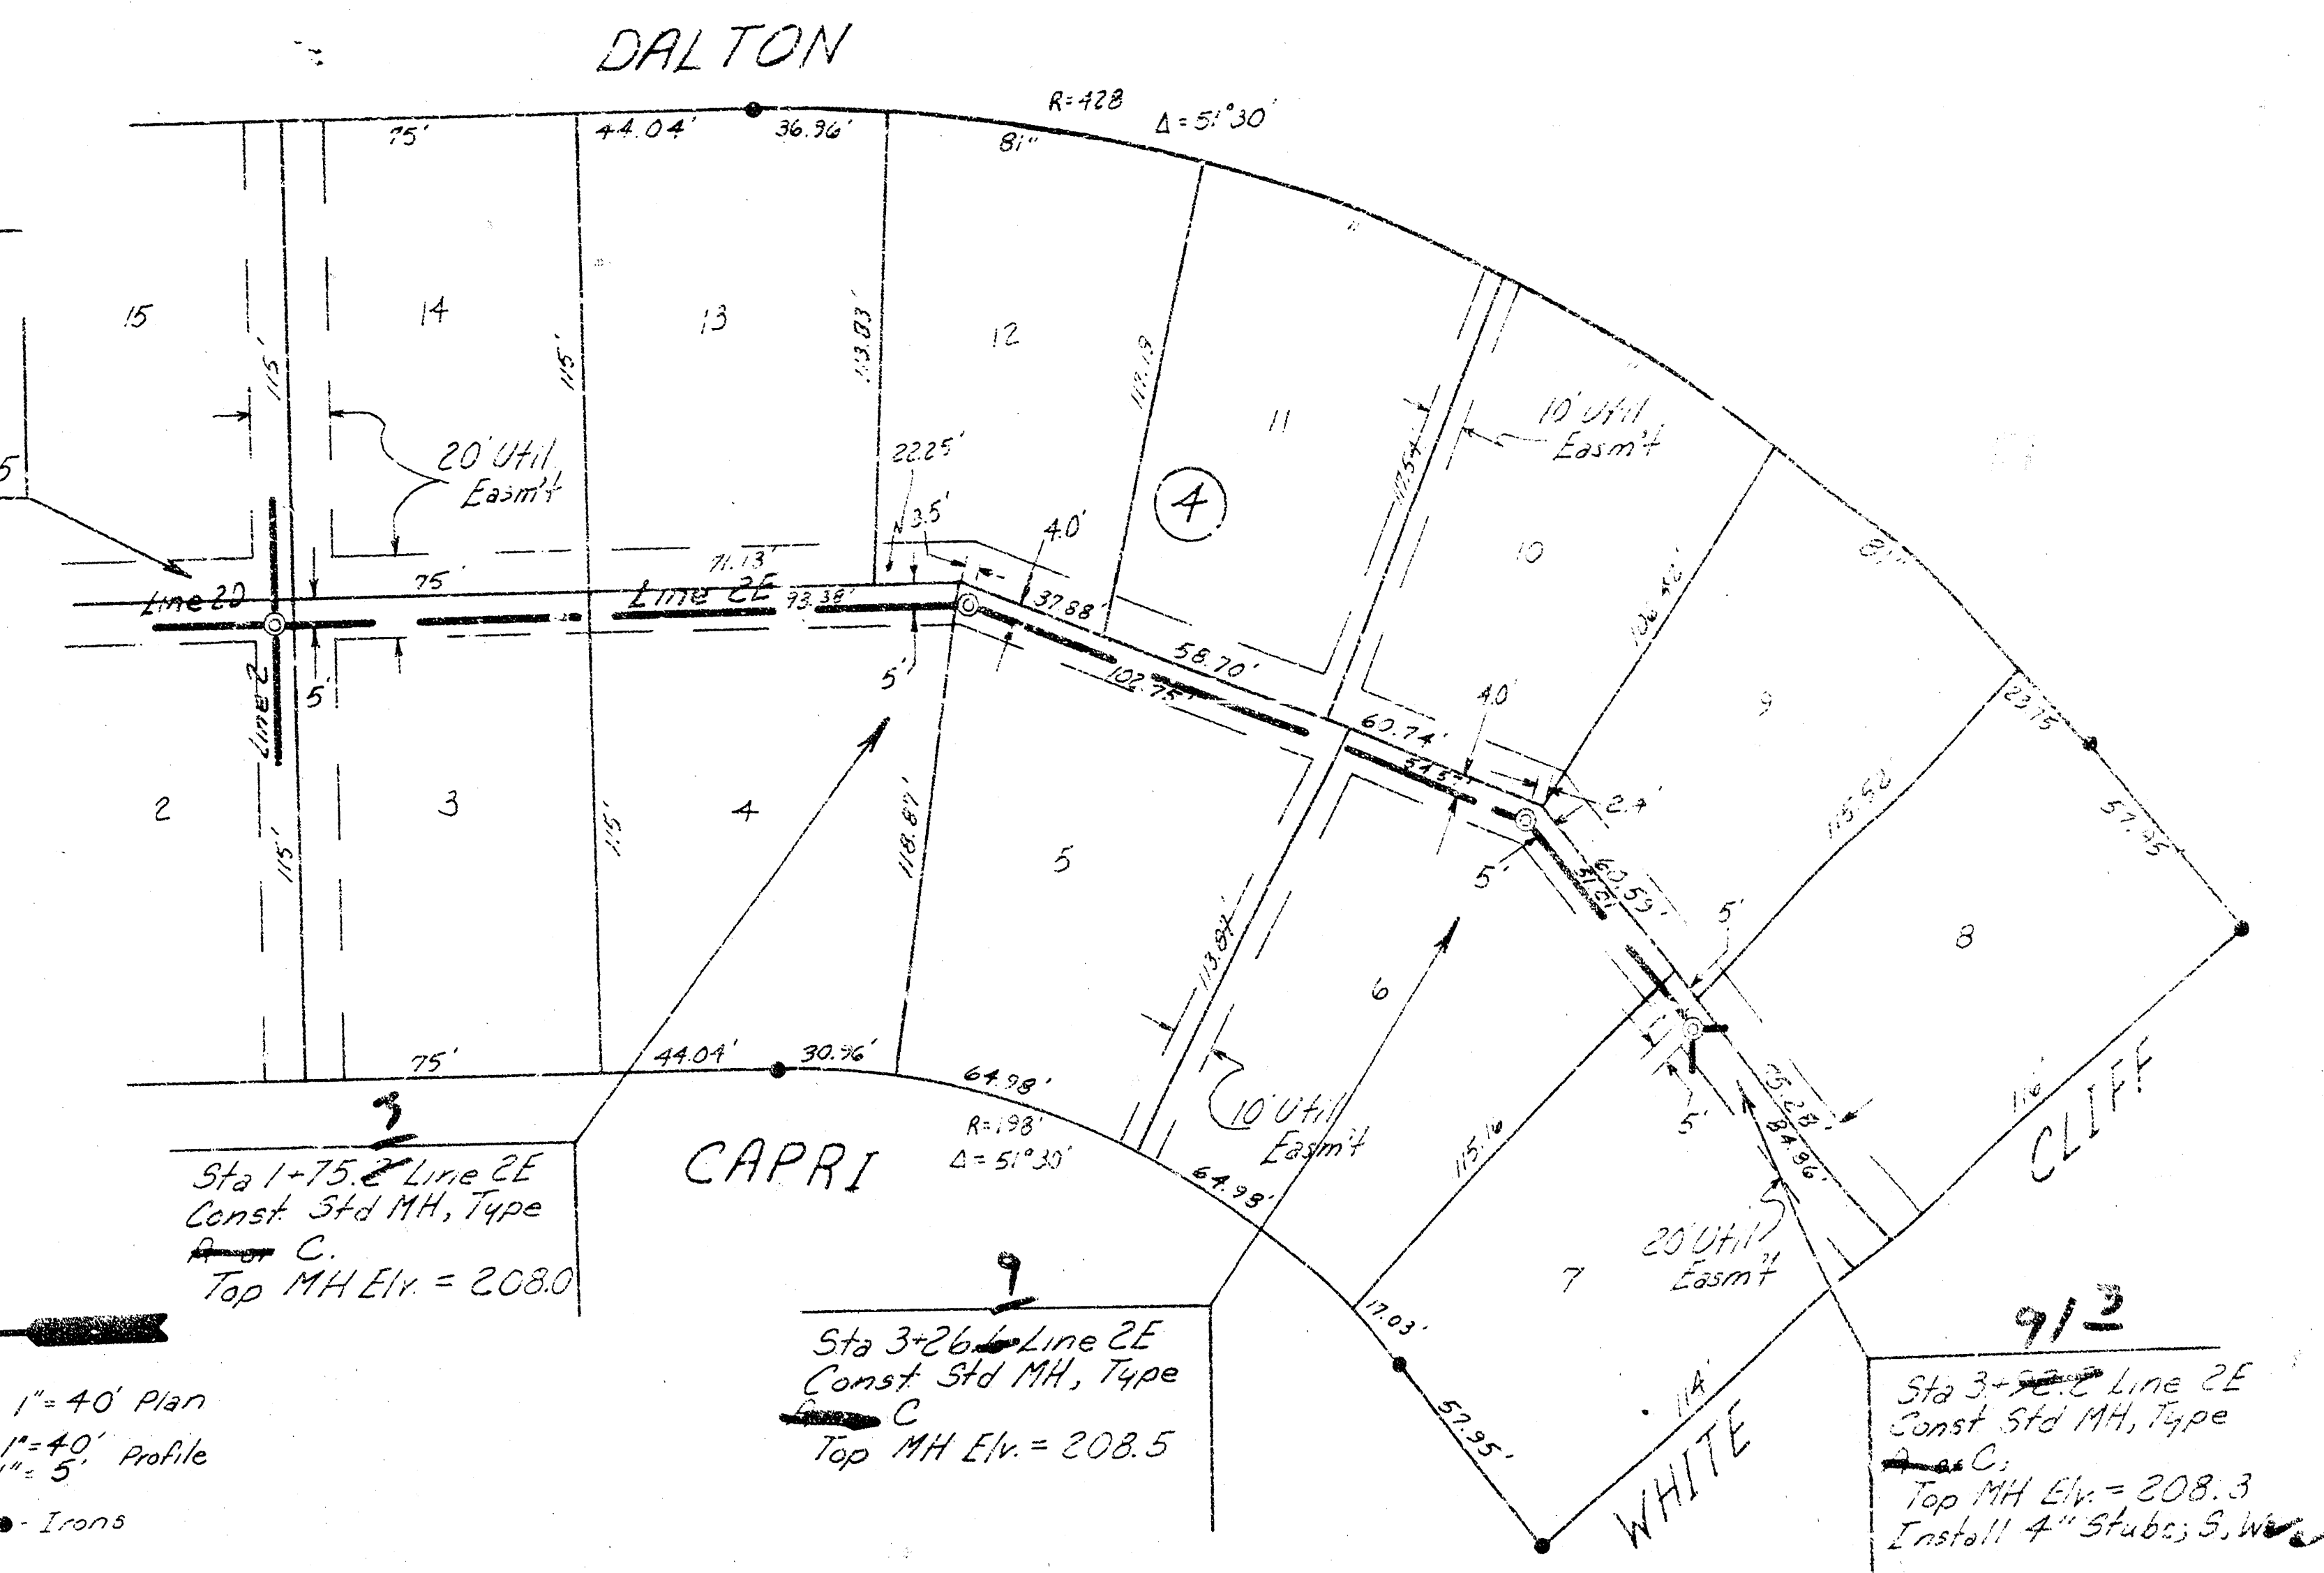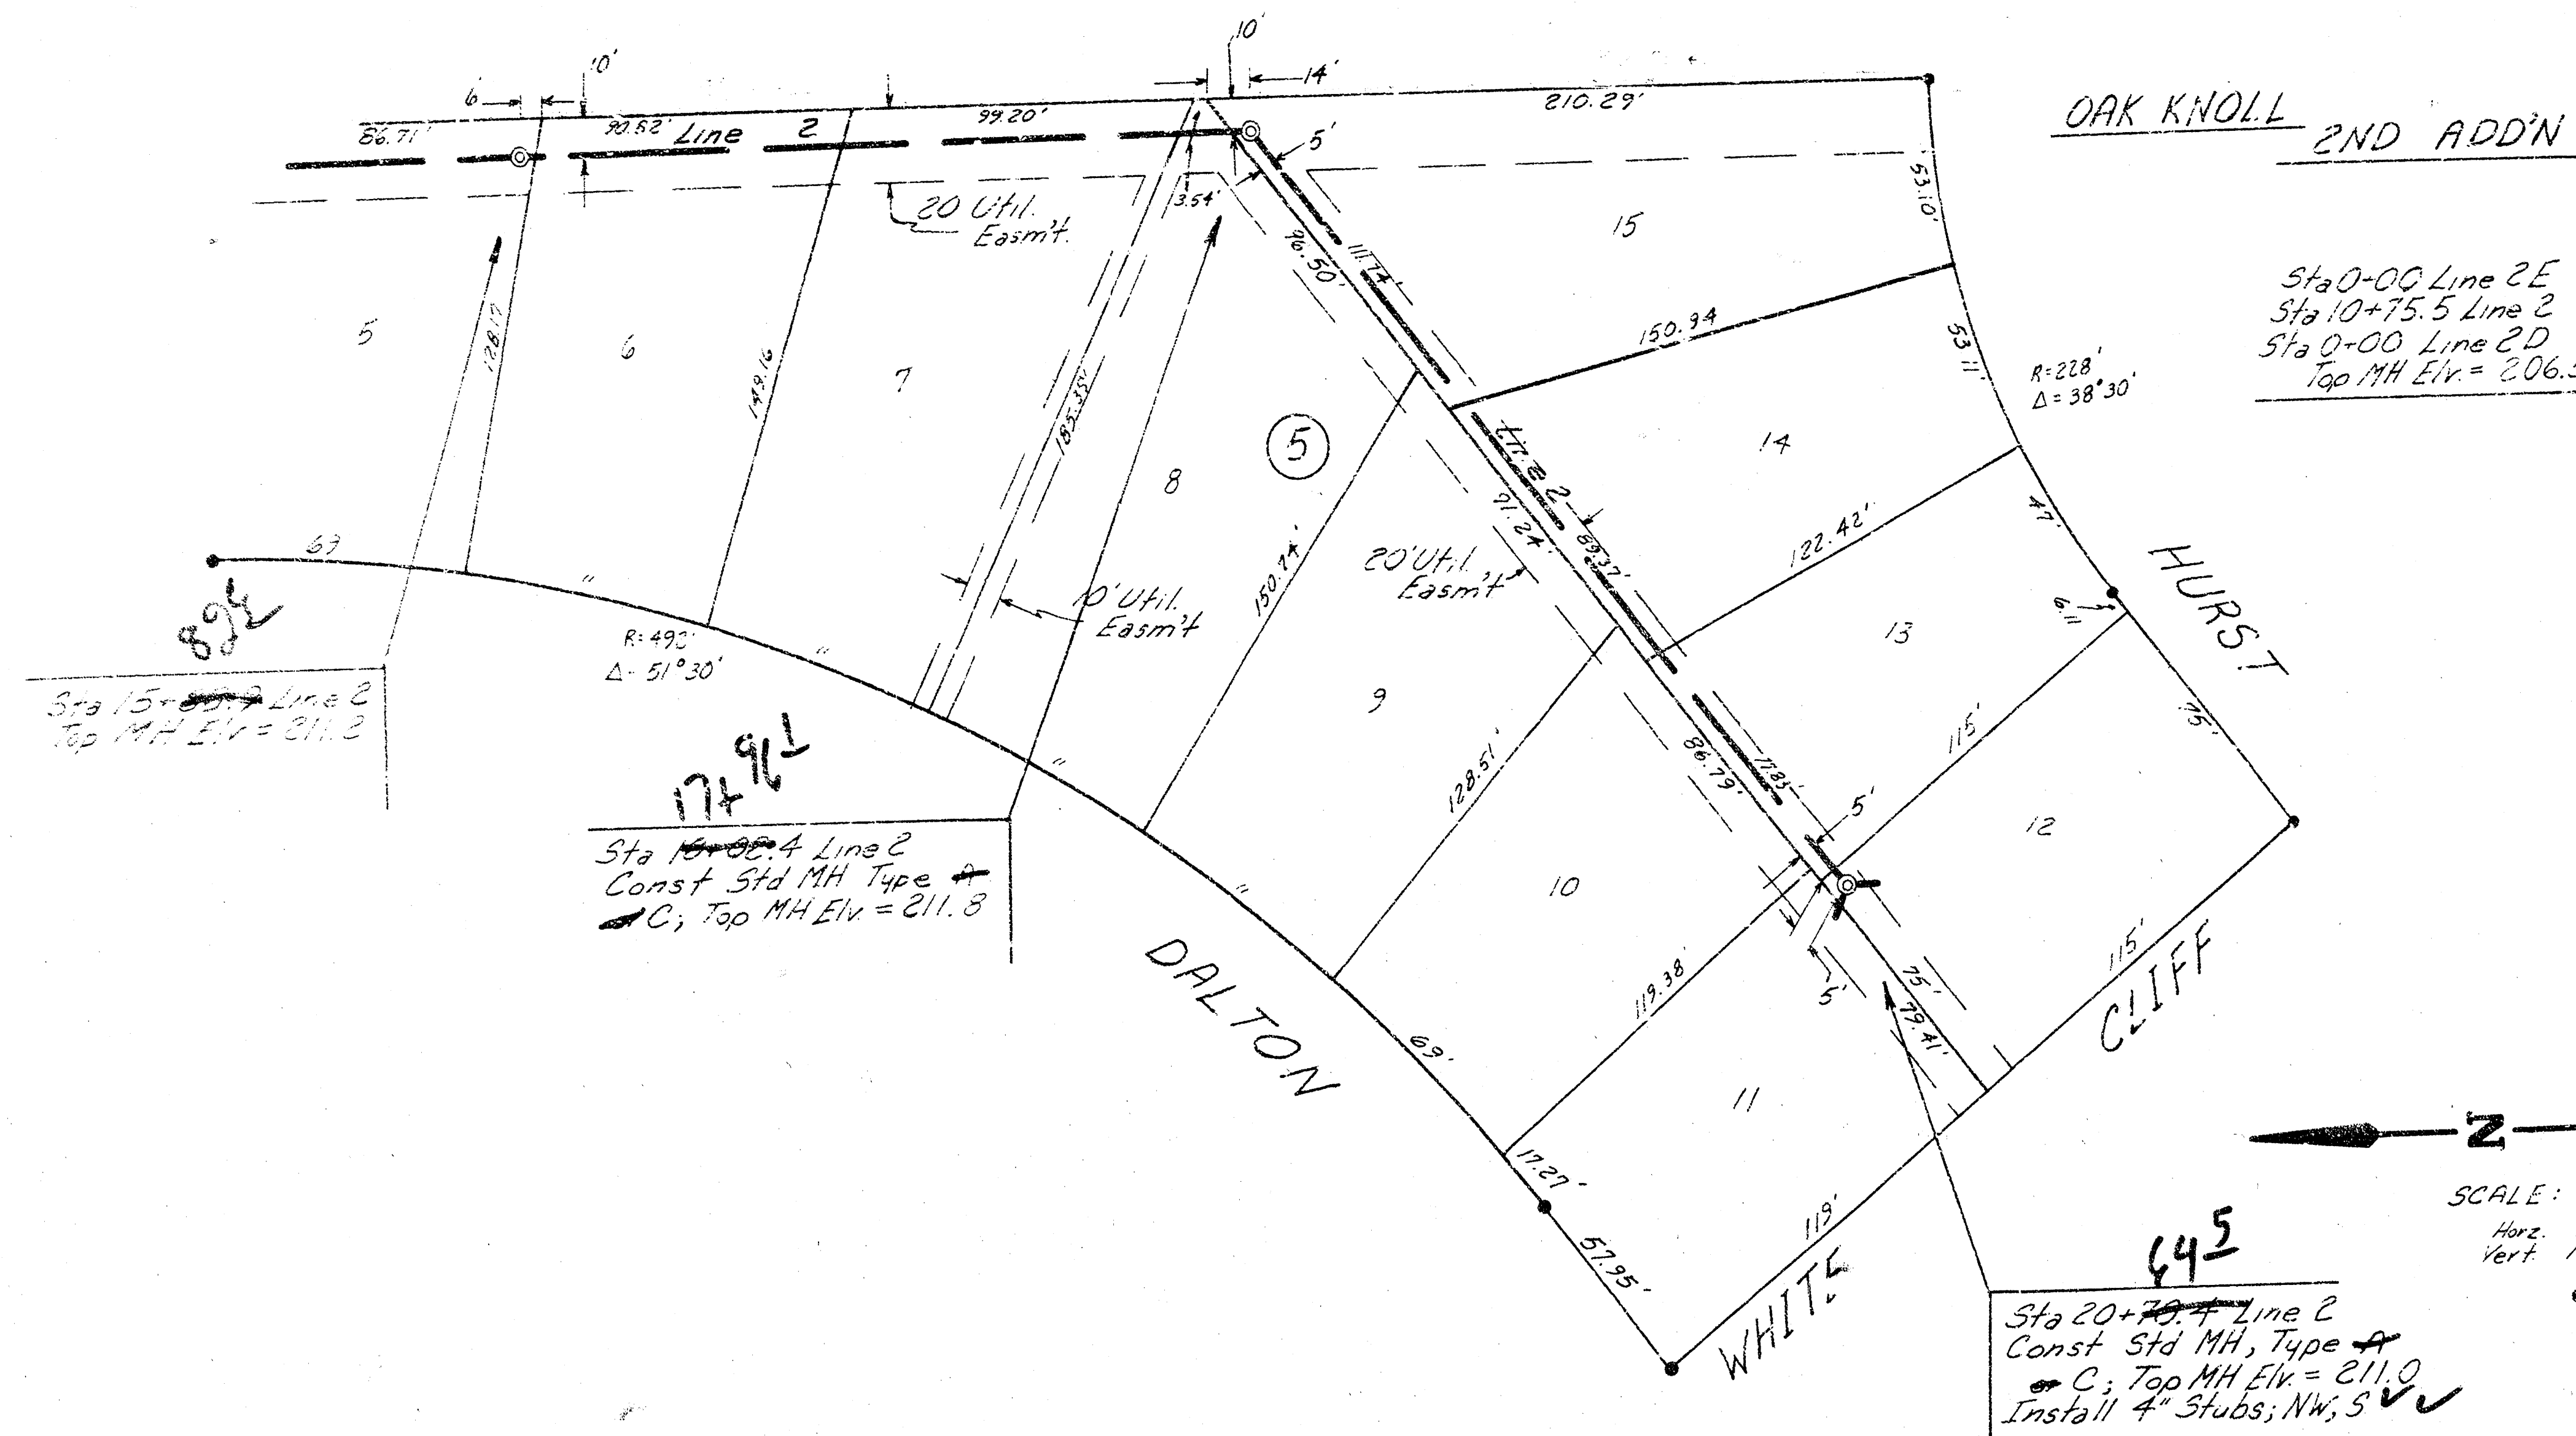

Line 2; Line 2E
Lateral 1, Main 23, W.I.S.
Proj # 468-76-245-80999-000-000-001

FILMED FROM THE BEST
AVAILABLE COPY

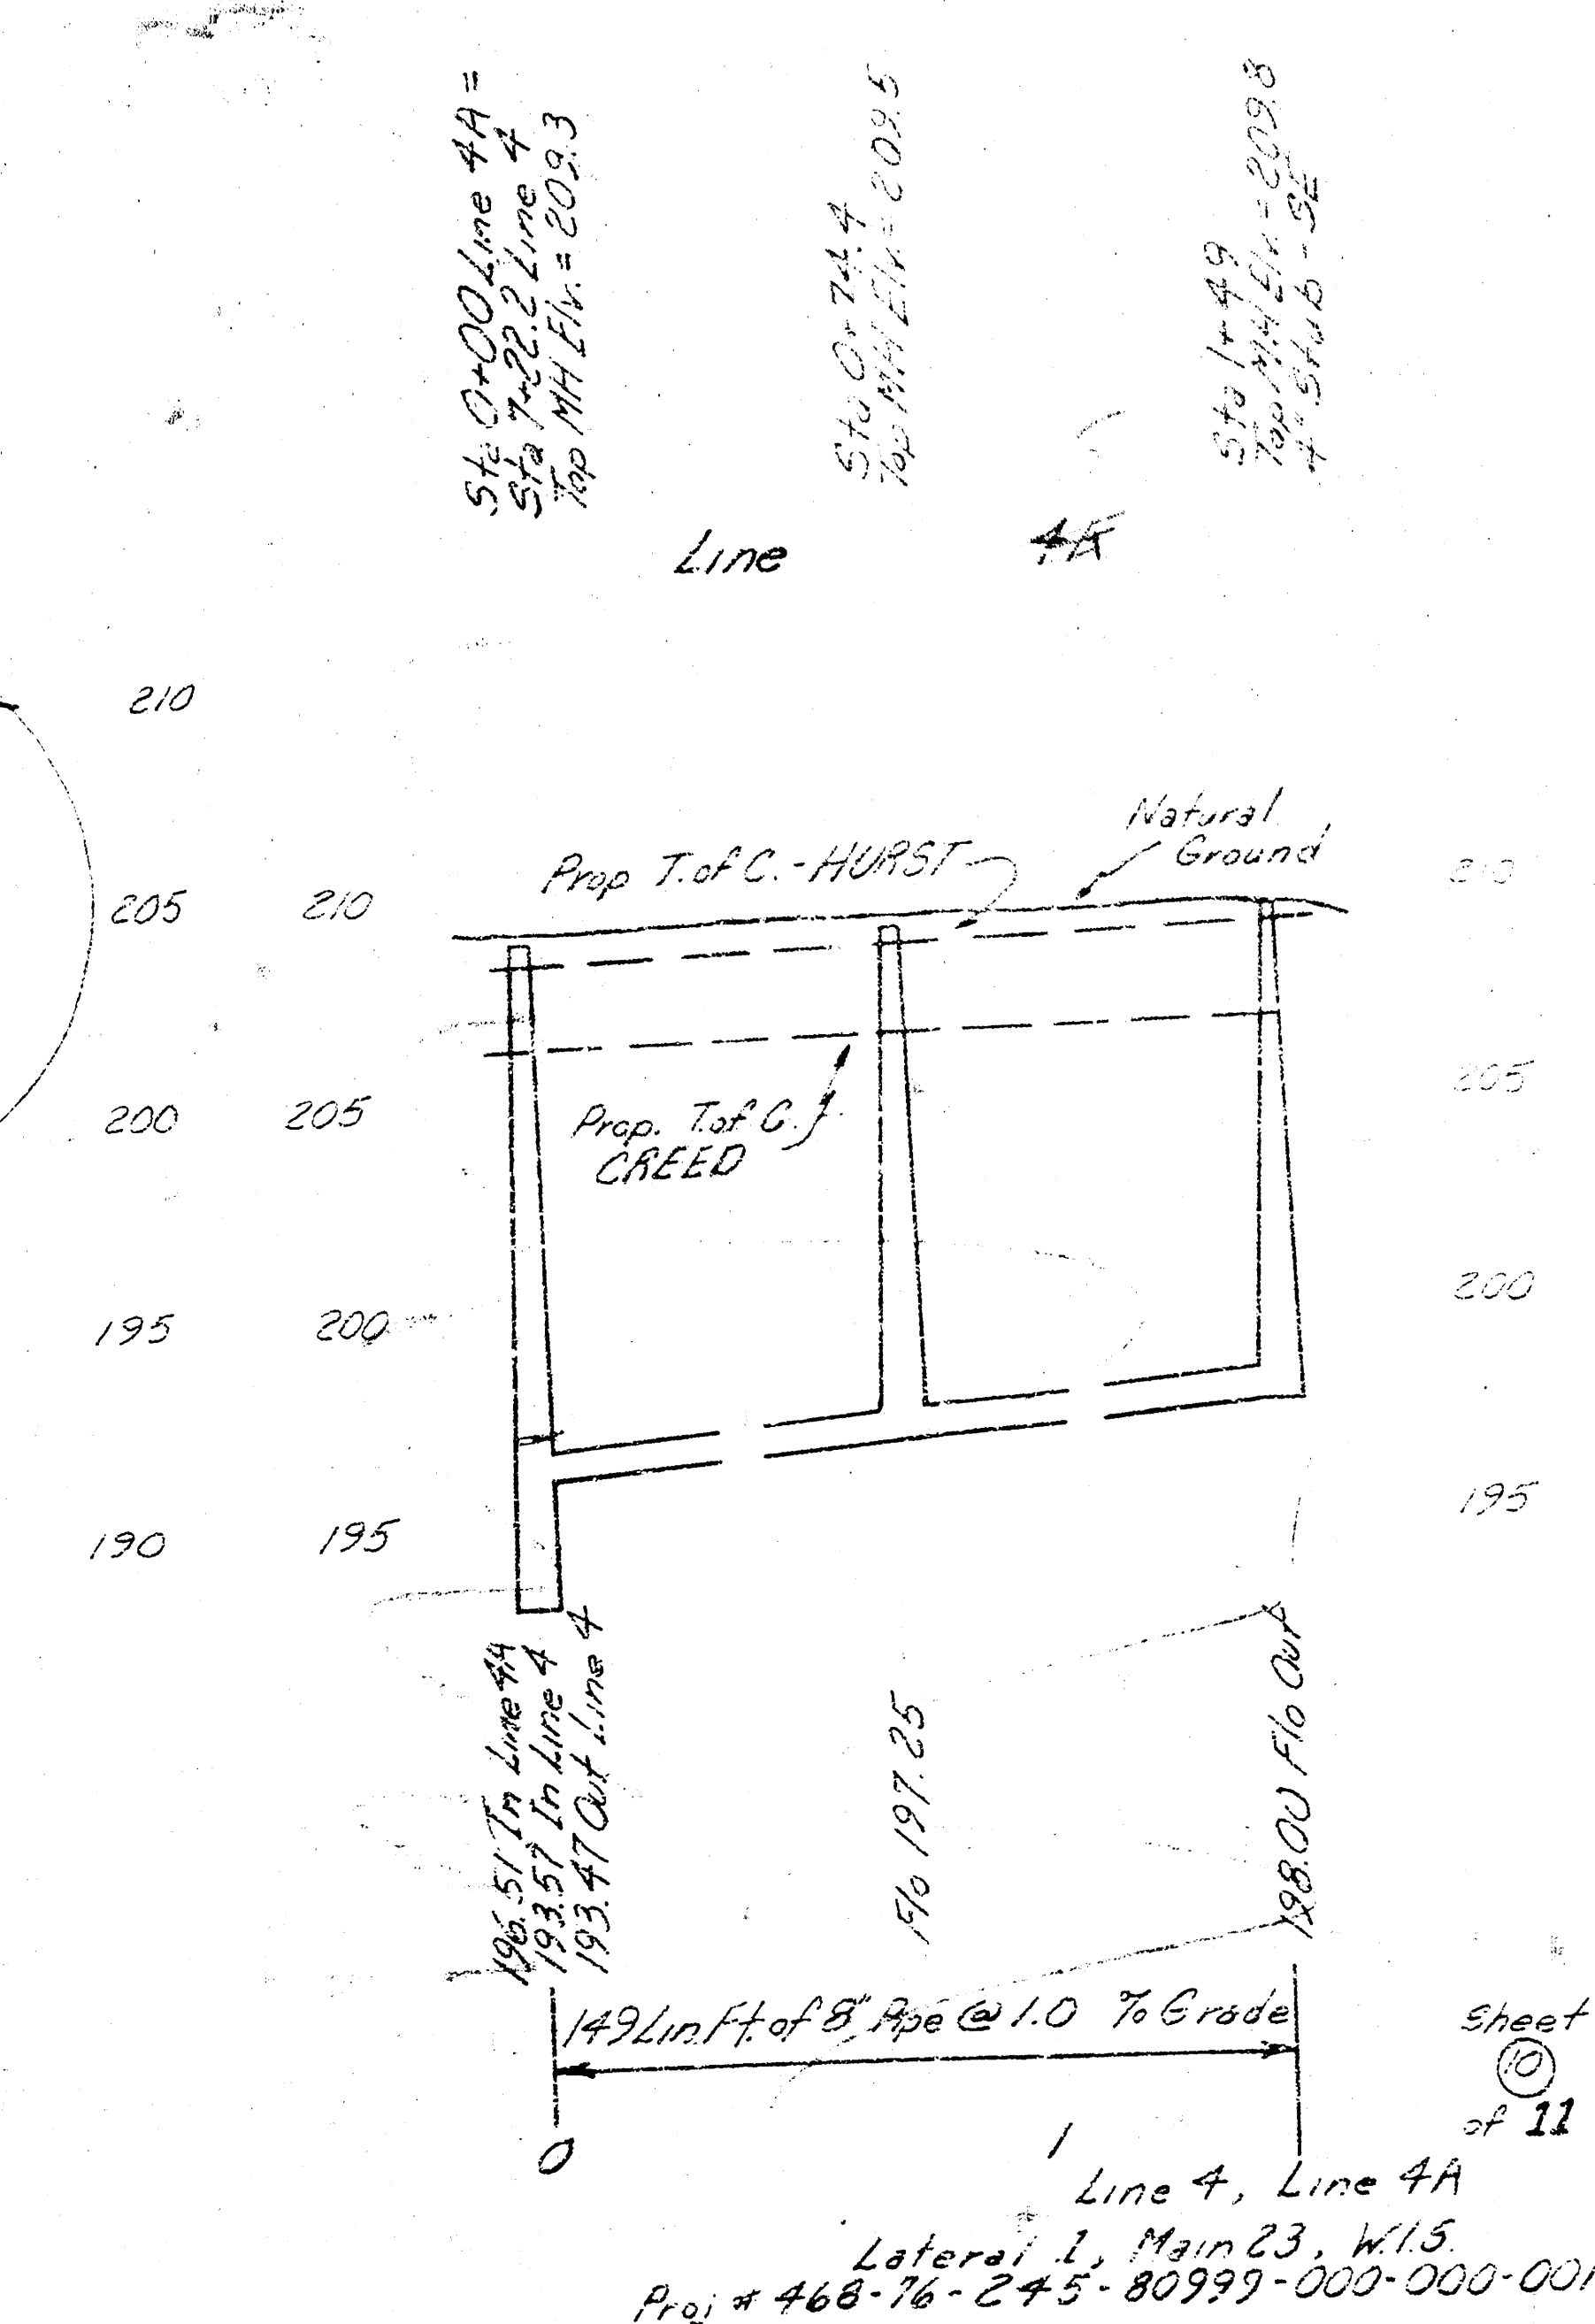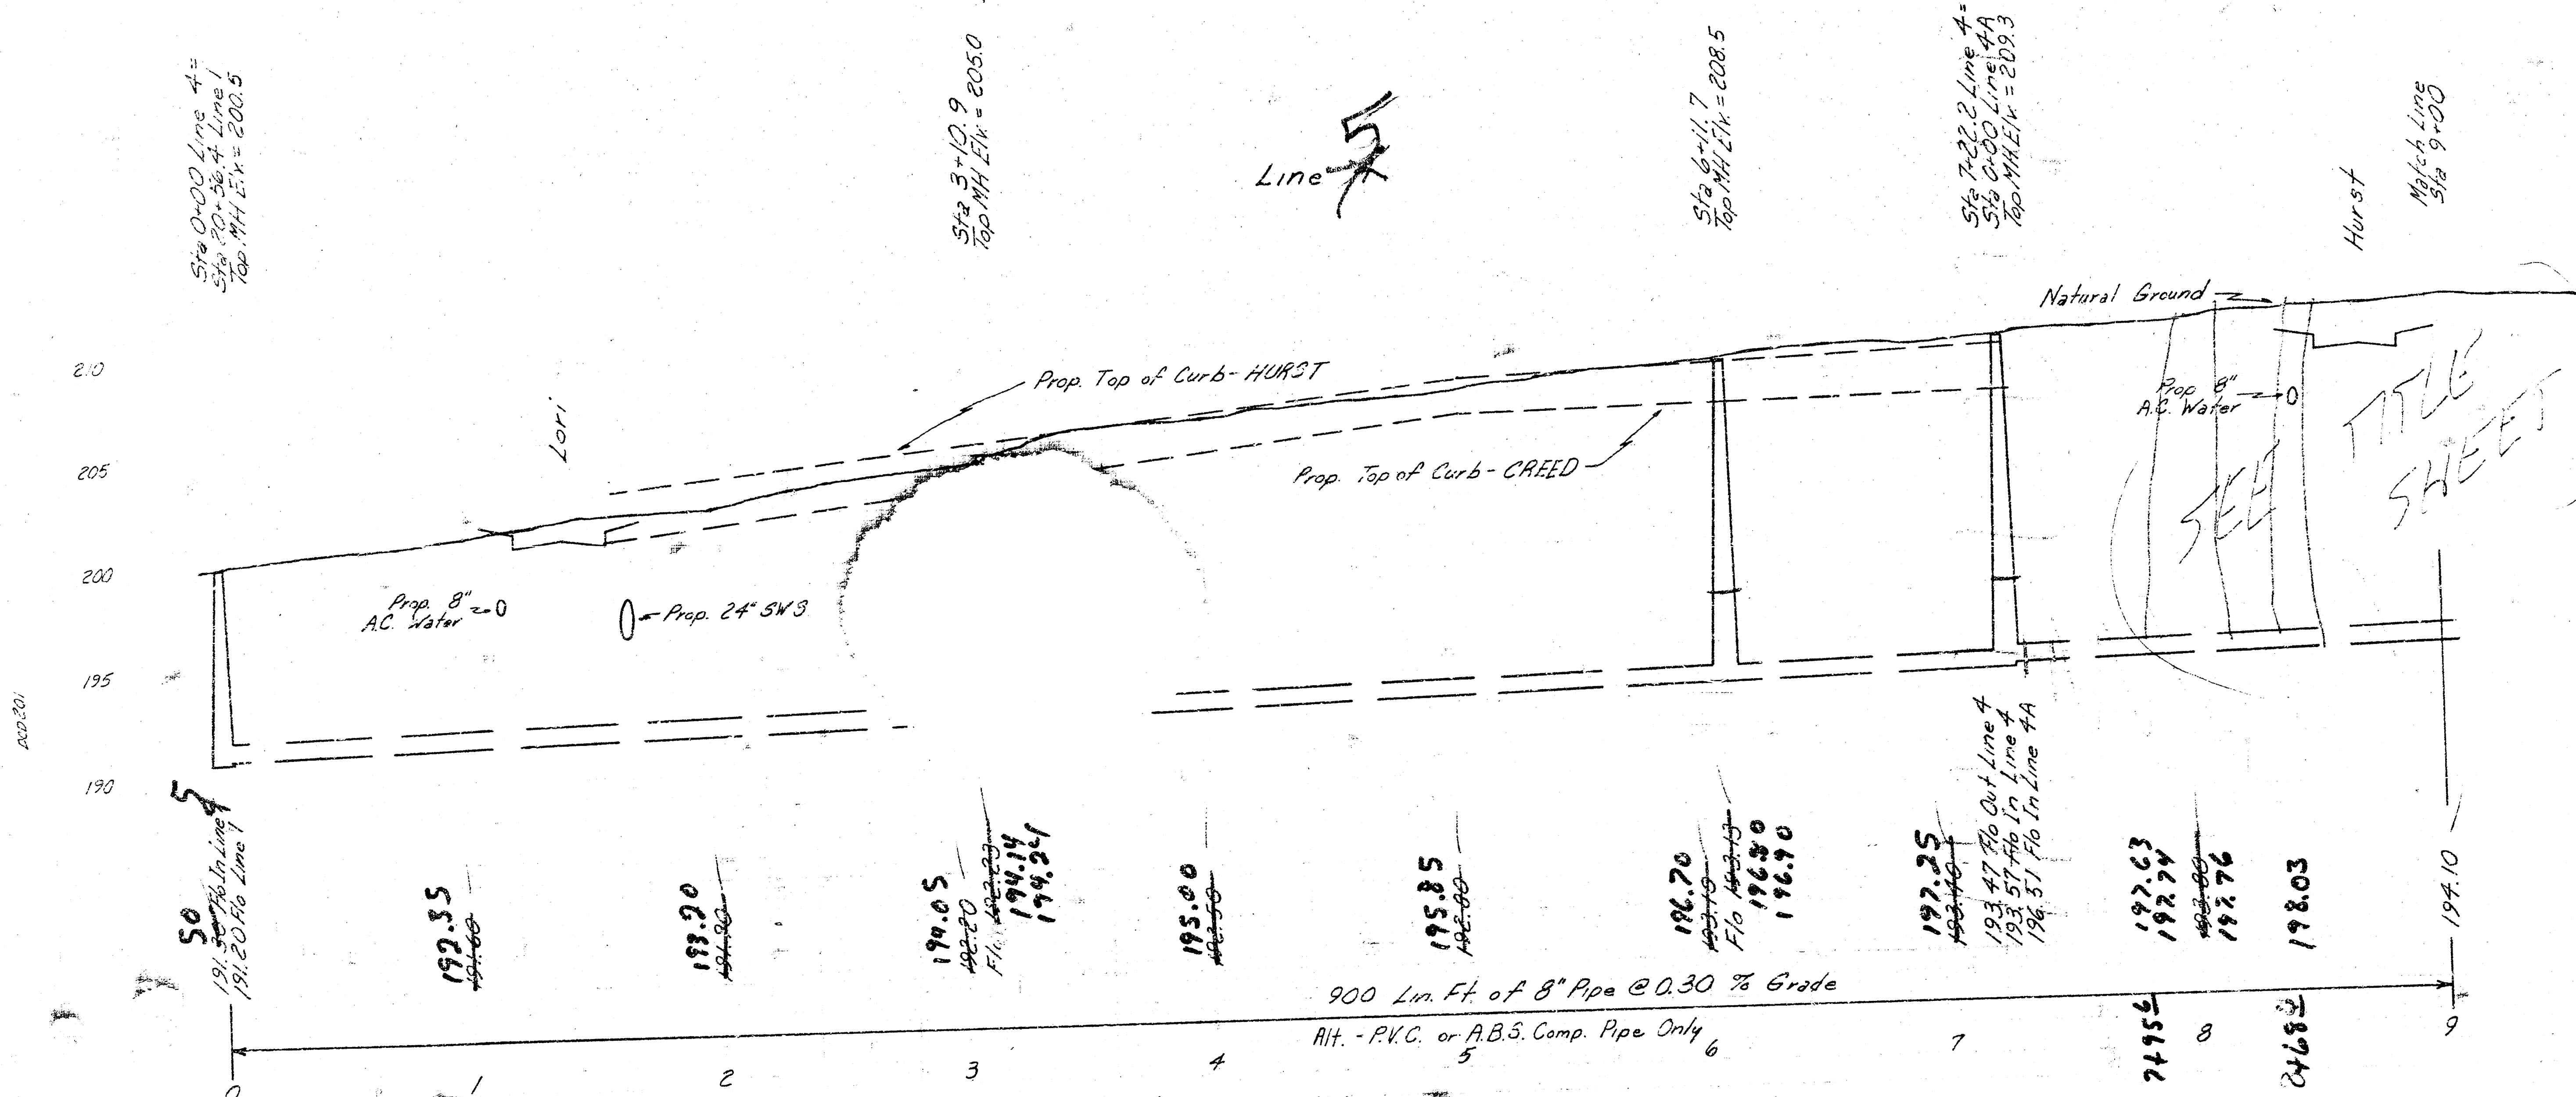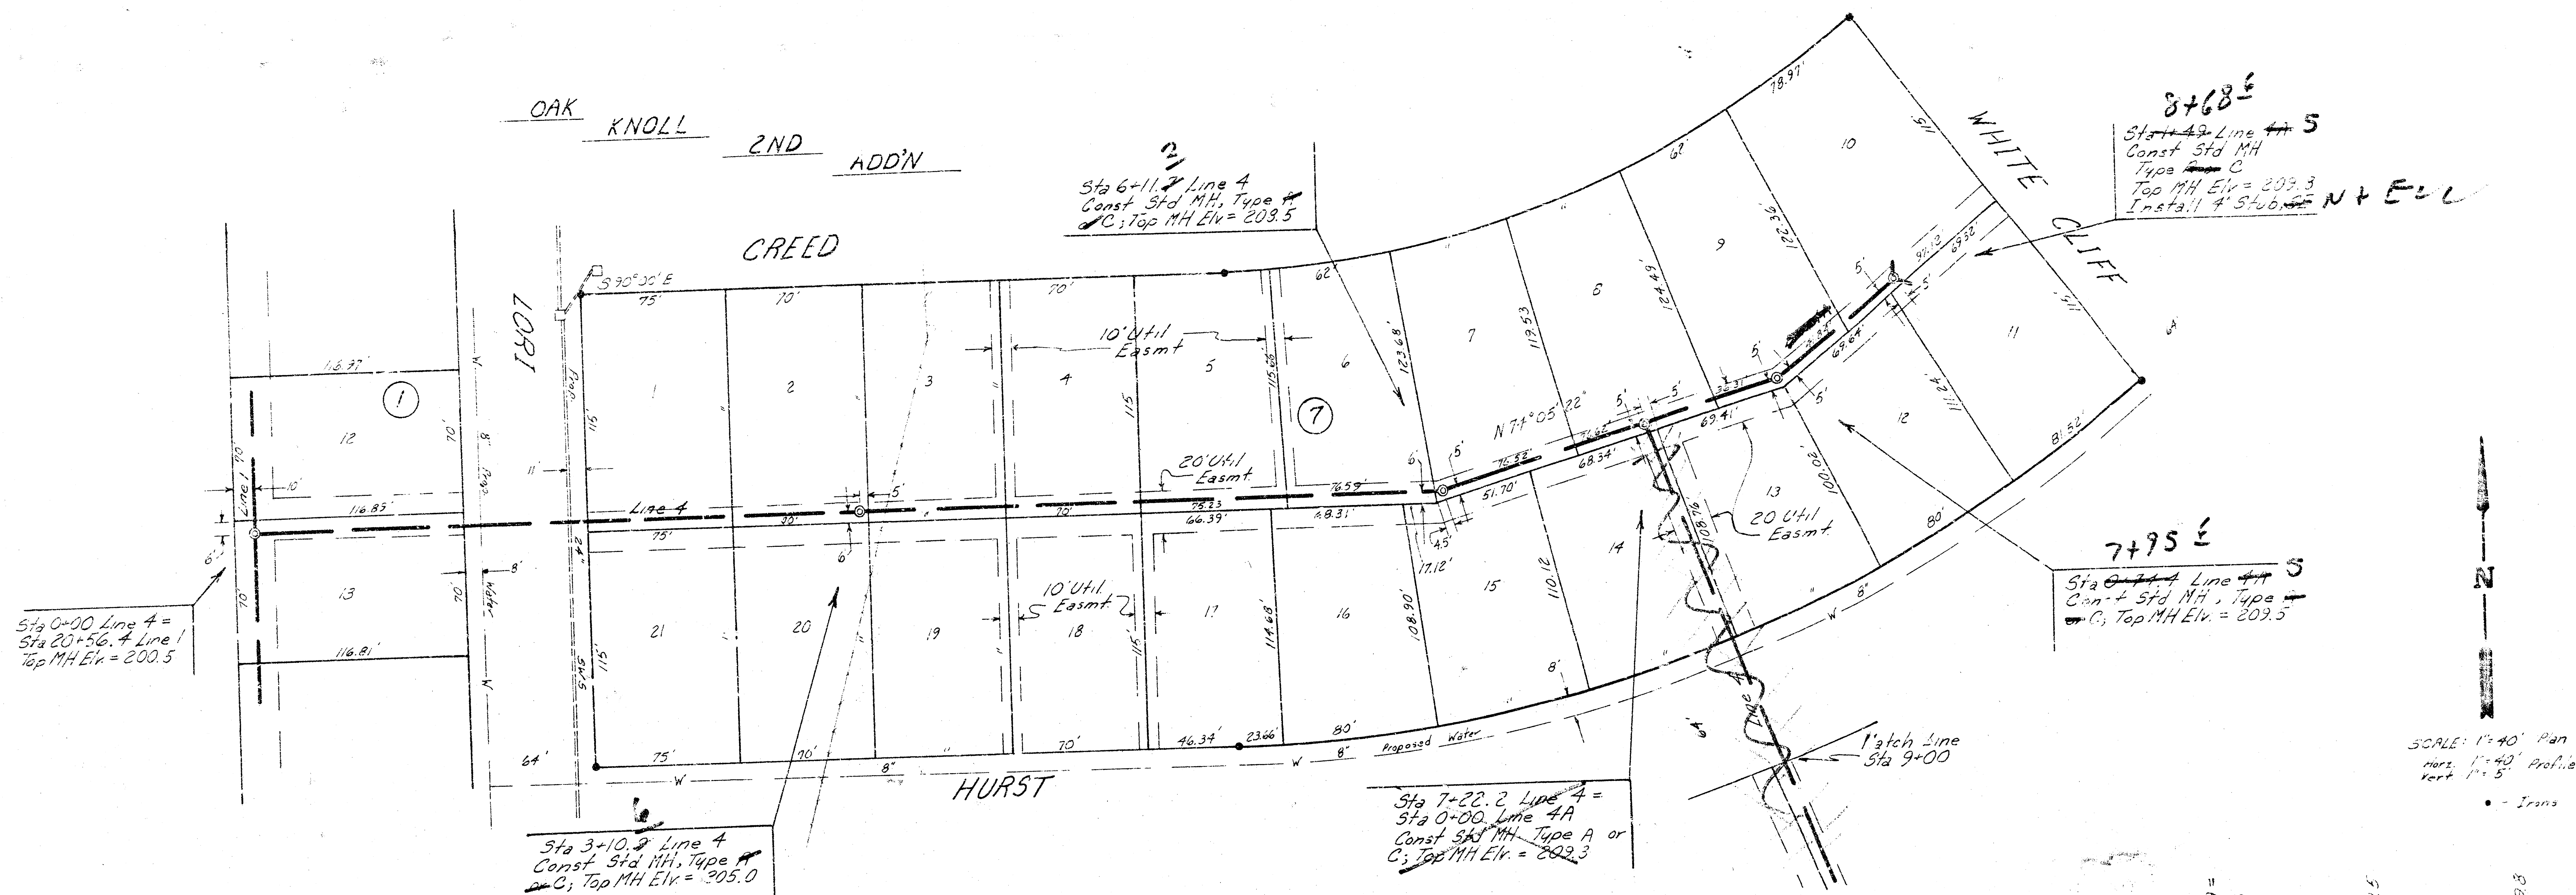

FILMED FROM THE BEST AVAILABLE COPY

9462²
Sta ~~2~~ ~~30~~ Line ~~4~~ Const
Std MH Type ~~C~~ C
Top MH Elev. = 210.7
Install 4" Stubs, N.W. SE ✓

44773
Sta ~~12+00~~ 3 Line 4
Const Std MH, Type ~~2~~ C
Top MH Elev. = 209.0

Sta. ~~100.2~~ Line 4; Const.
Std. MH; Type ~~Free C~~
Top MH Elev. = 210.6

SCALE: 1" = 40' Plan
 Horiz. 1" = 40' Profile
 Vert. 1" = 5' Profile

• - Irons

6+977
Sta ~~10+21.7~~ Line 1-
~~Sta 9+00 Line 1B~~
Const Std MH, Type A or C
Top MH Elev. = 210.4

Line 4~~5~~

Sta 2-39
Top MH Elev = 210.7
2-4" Stubs; NW, SE

Set Book H-259 For Grades

As Built
200
195
12/81

Sheet
⑪
of 11

Line 4, Line 4B
Lateral 1, Main 23, W.I.S.
Proj # 468-76-245-80999-000-000-001

FILMED FROM THE BEST