



MAIN 13, S.W. INTERCEPTOR SEWER



PROJECT NO.

468-76-245-80932-000-000-001

CITY OF WICHITA, KANSAS

DEAN SELLERS, ACTING CITY ENGINEER

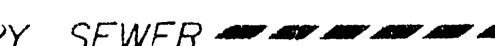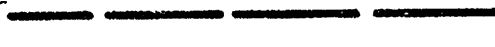LEGEND
EXISTING SANITARY SEWER 
PROPOSED SANITARY SEWER 
BENEFIT DISTRICT 

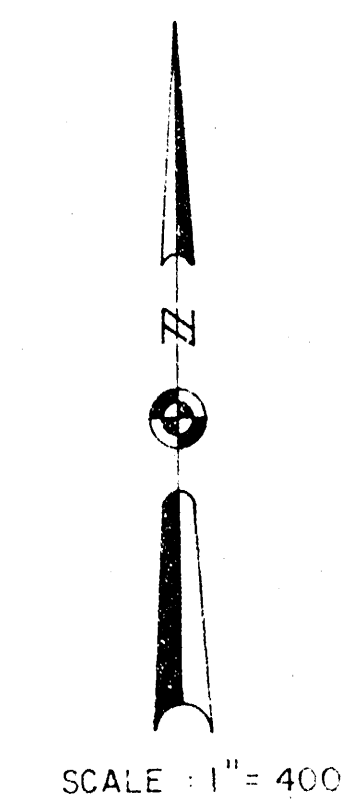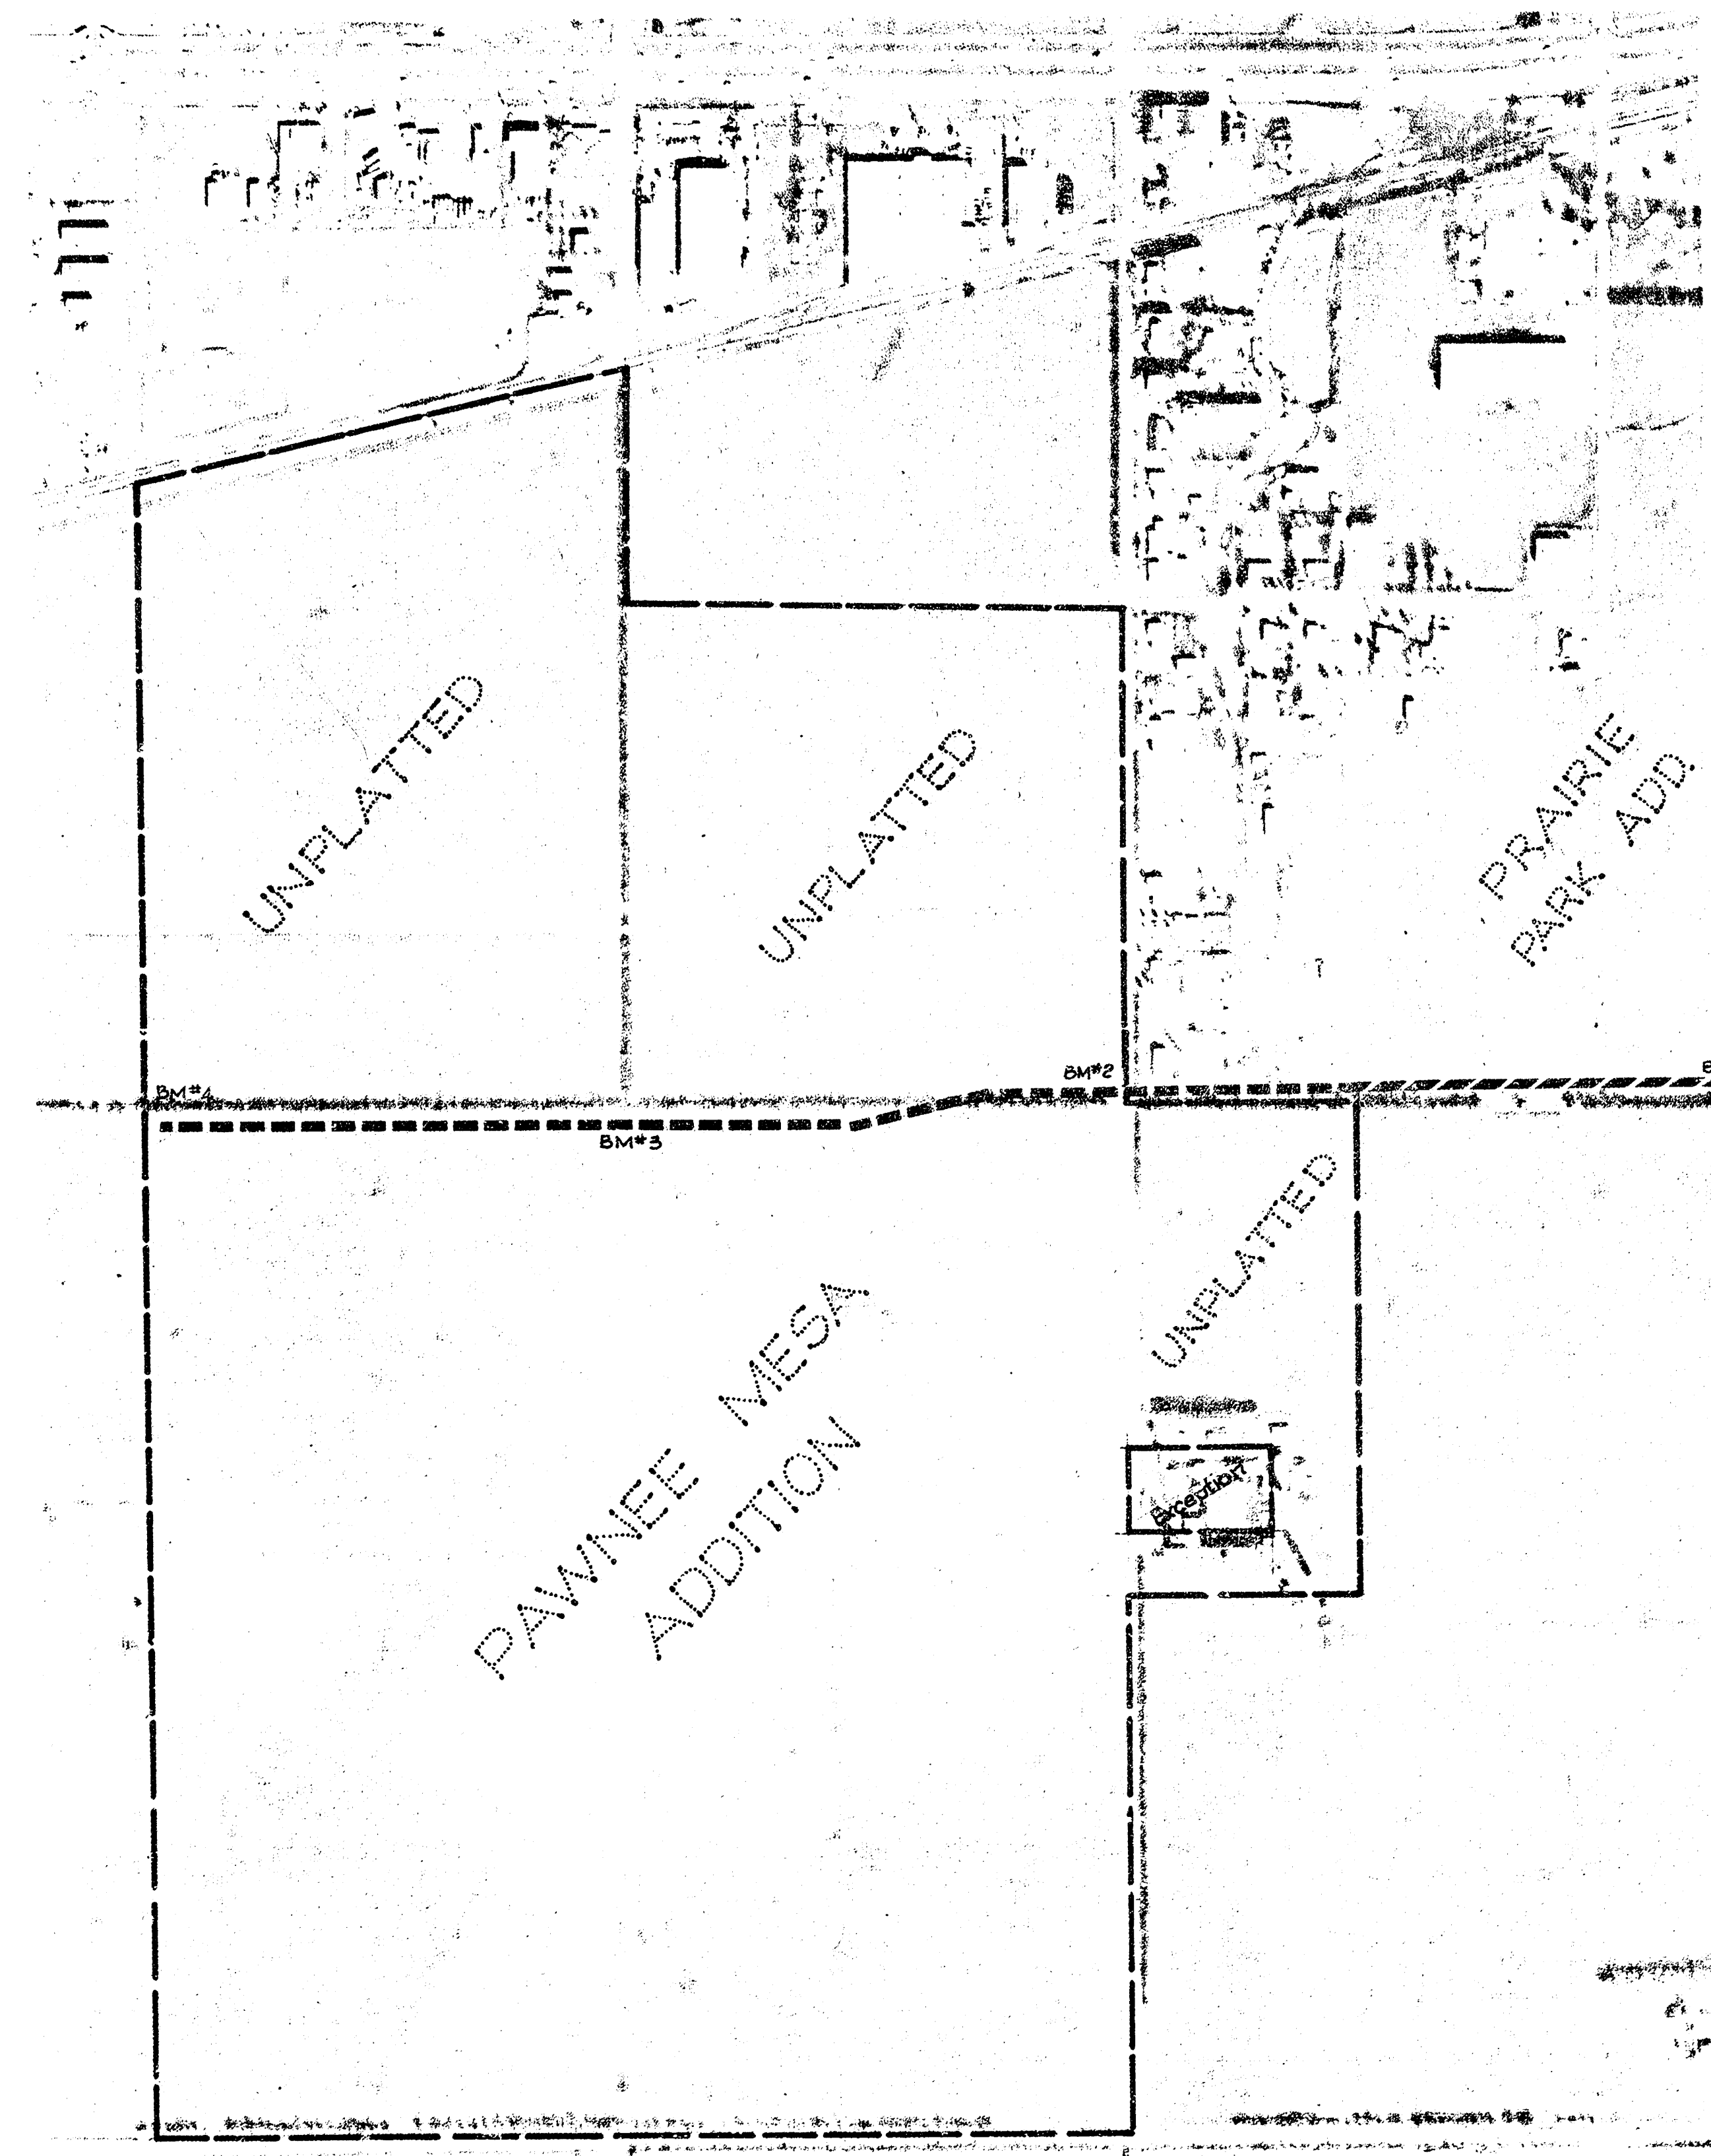

INDEX TO DRAWINGS	
SHEET NO.	DESCRIPTION
1	TITLE SHEET
2-4	PLAN & PROFILE
5-7	DETAILS

THIS DRAWING IS THE PROPERTY OF VAN DOREN - HAZARD - STALLINGS, INC. AND IS NOT TO BE REPRODUCED OR TRANSMITTED IN ANY FORM OR BY ANY MEANS, ELECTRONIC OR MECHANICAL, INCLUDING PHOTOCOPYING, RECORDING, OR BY ANY INFORMATION STORAGE AND RETRIEVAL SYSTEM, WITHOUT THE WRITTEN PERMISSION OF VAN DOREN - HAZARD - STALLINGS, INC. ANY VIOLATION OF THIS NOTICE SHALL BE SUBJECT TO LEGAL ACTION.




Van Doren - Hazard - Stallings

Engineers • Planners
Topeka • Wichita • Minneapolis

Sheet 1
of 4


PROJECT NO. :
468·76·245·80932·000·000·001

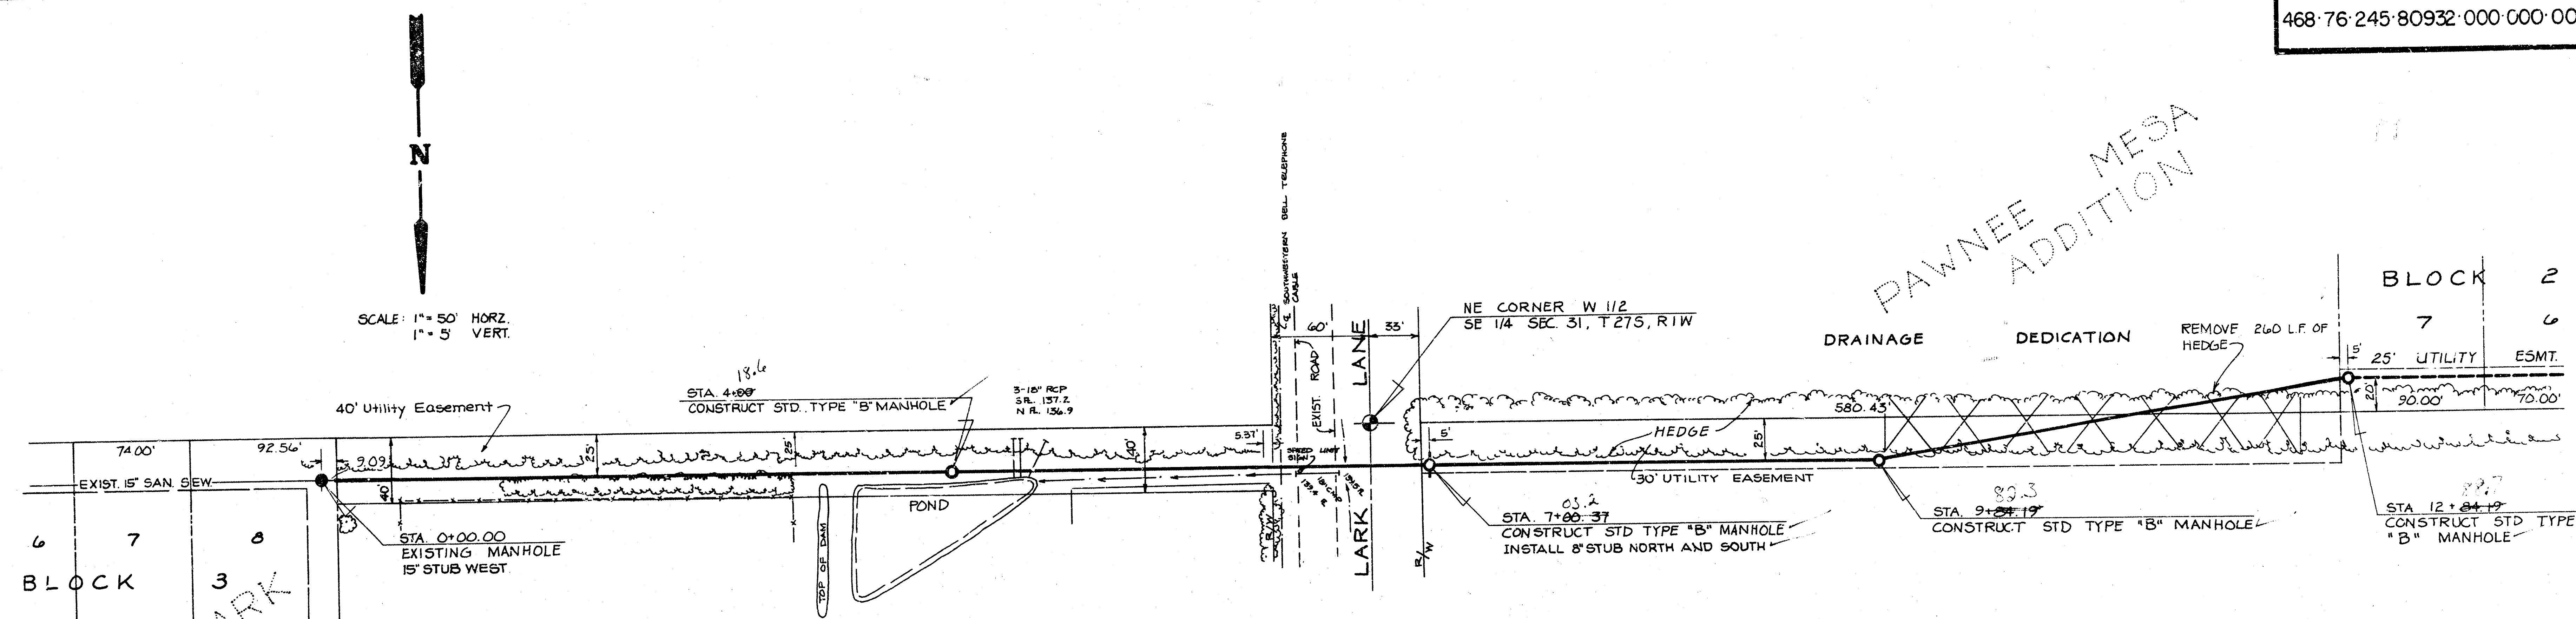

NOTE: REMOVAL AND REPLACEMENT OF 18" PIPE AT STATION 4 + 50 SHALL BE CONSIDERED AS SUBSIDIARY TO THE OTHER ITEMS OF WORK.



Bench Mark # 1
RR Spike in west face of 2nd PP north of
NE 1/4 Cor. of SE 1/4 of Sec. 31-27S-1W
on east R/W Maize Road. ELEV. 137.96'

Bench Mark # 2
Bent Spike in south face of hedge tree at
7 + 25.00. 25' left, ELEV. 142.30'

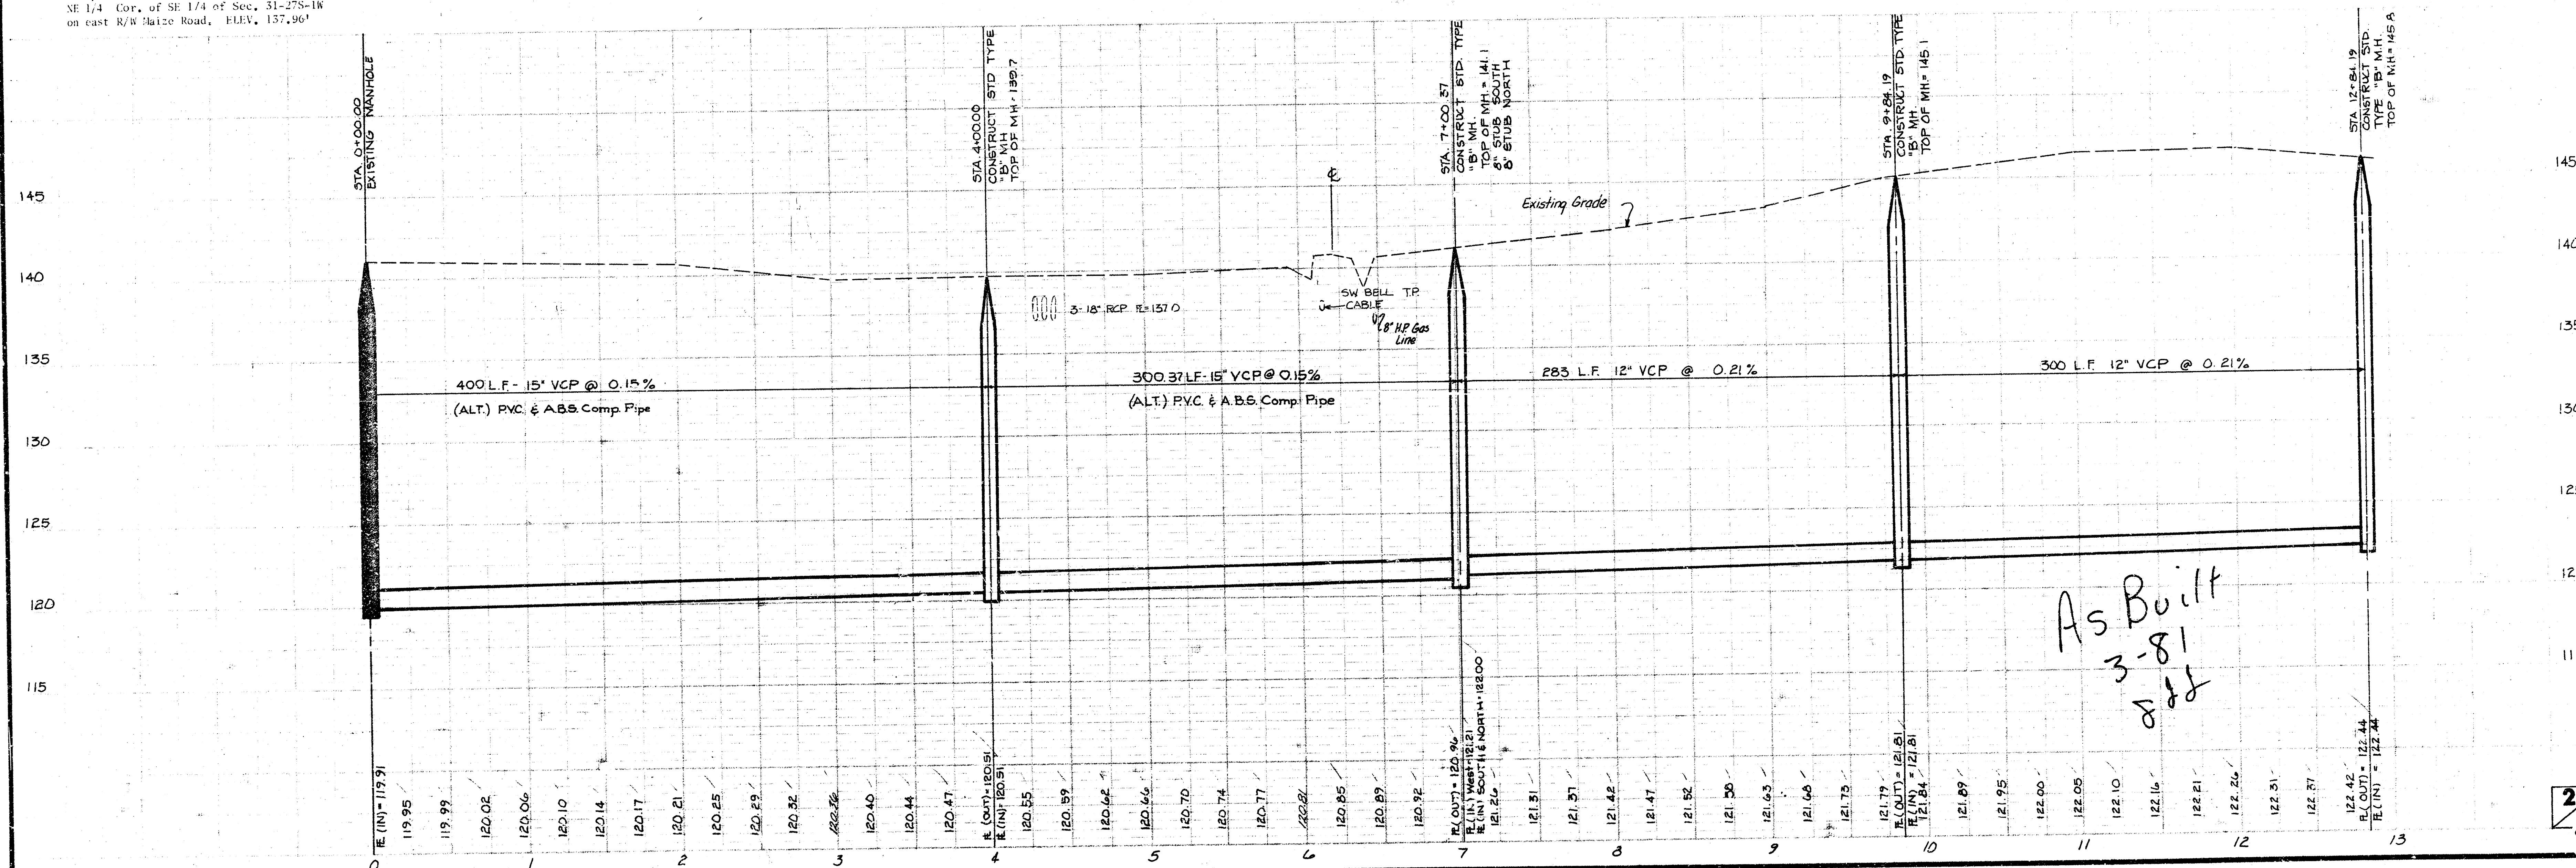


As Built
3-81
888


PROJECT NO:
468-76-245-80932-000-000-001

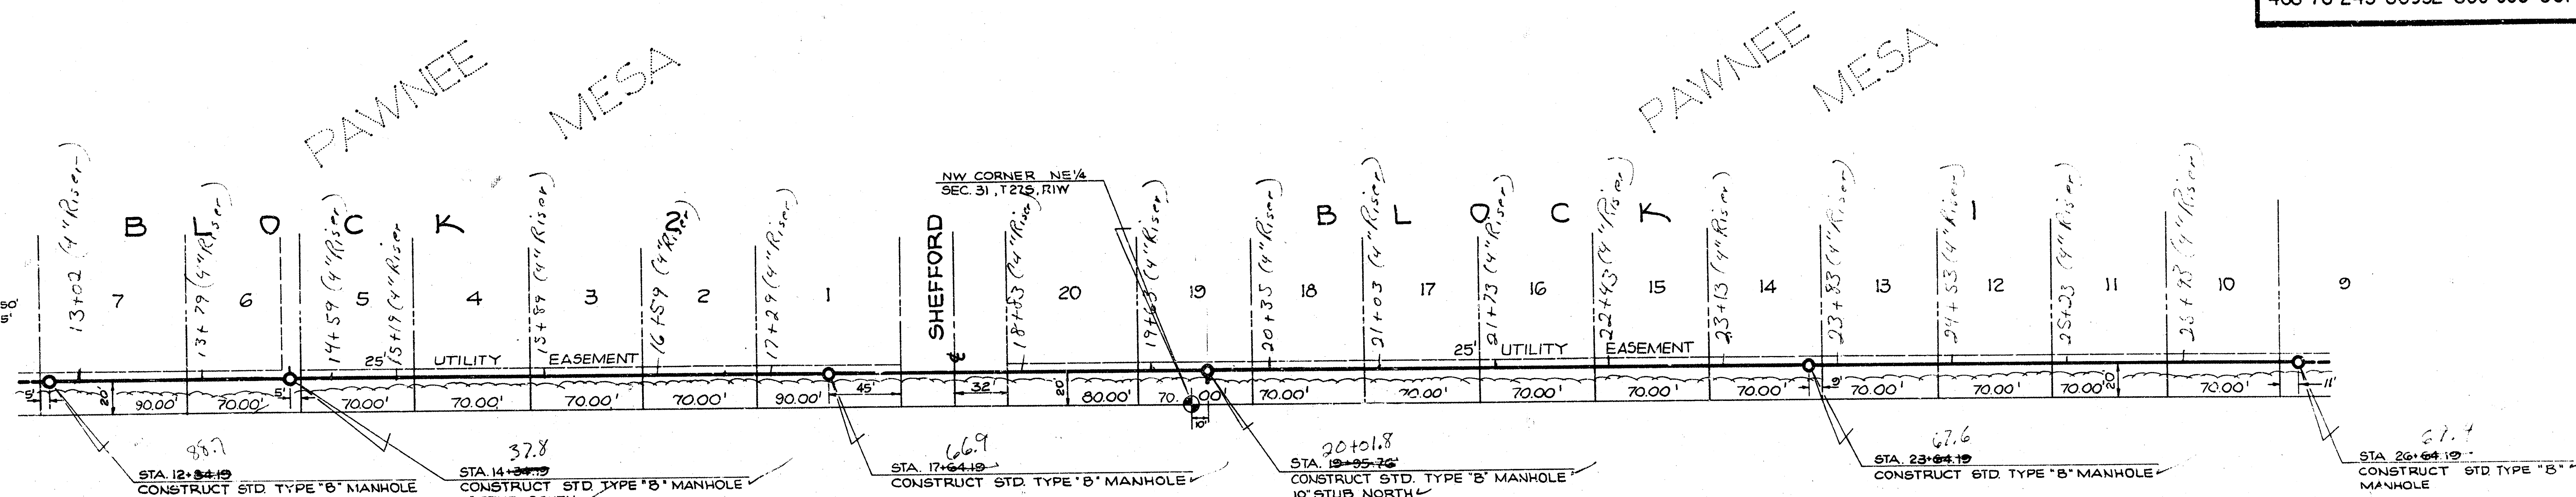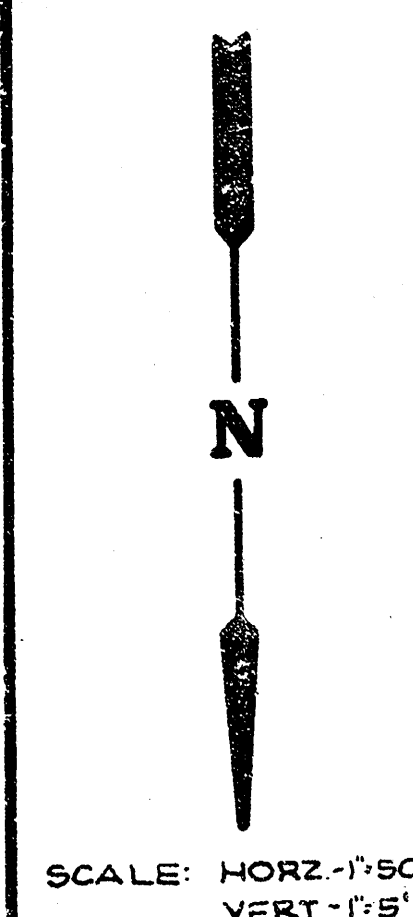

Bench Mark # 3
Top Nail in south face of hedge tree at
20 + 08.00, 20' left, ELEV. 145.55'

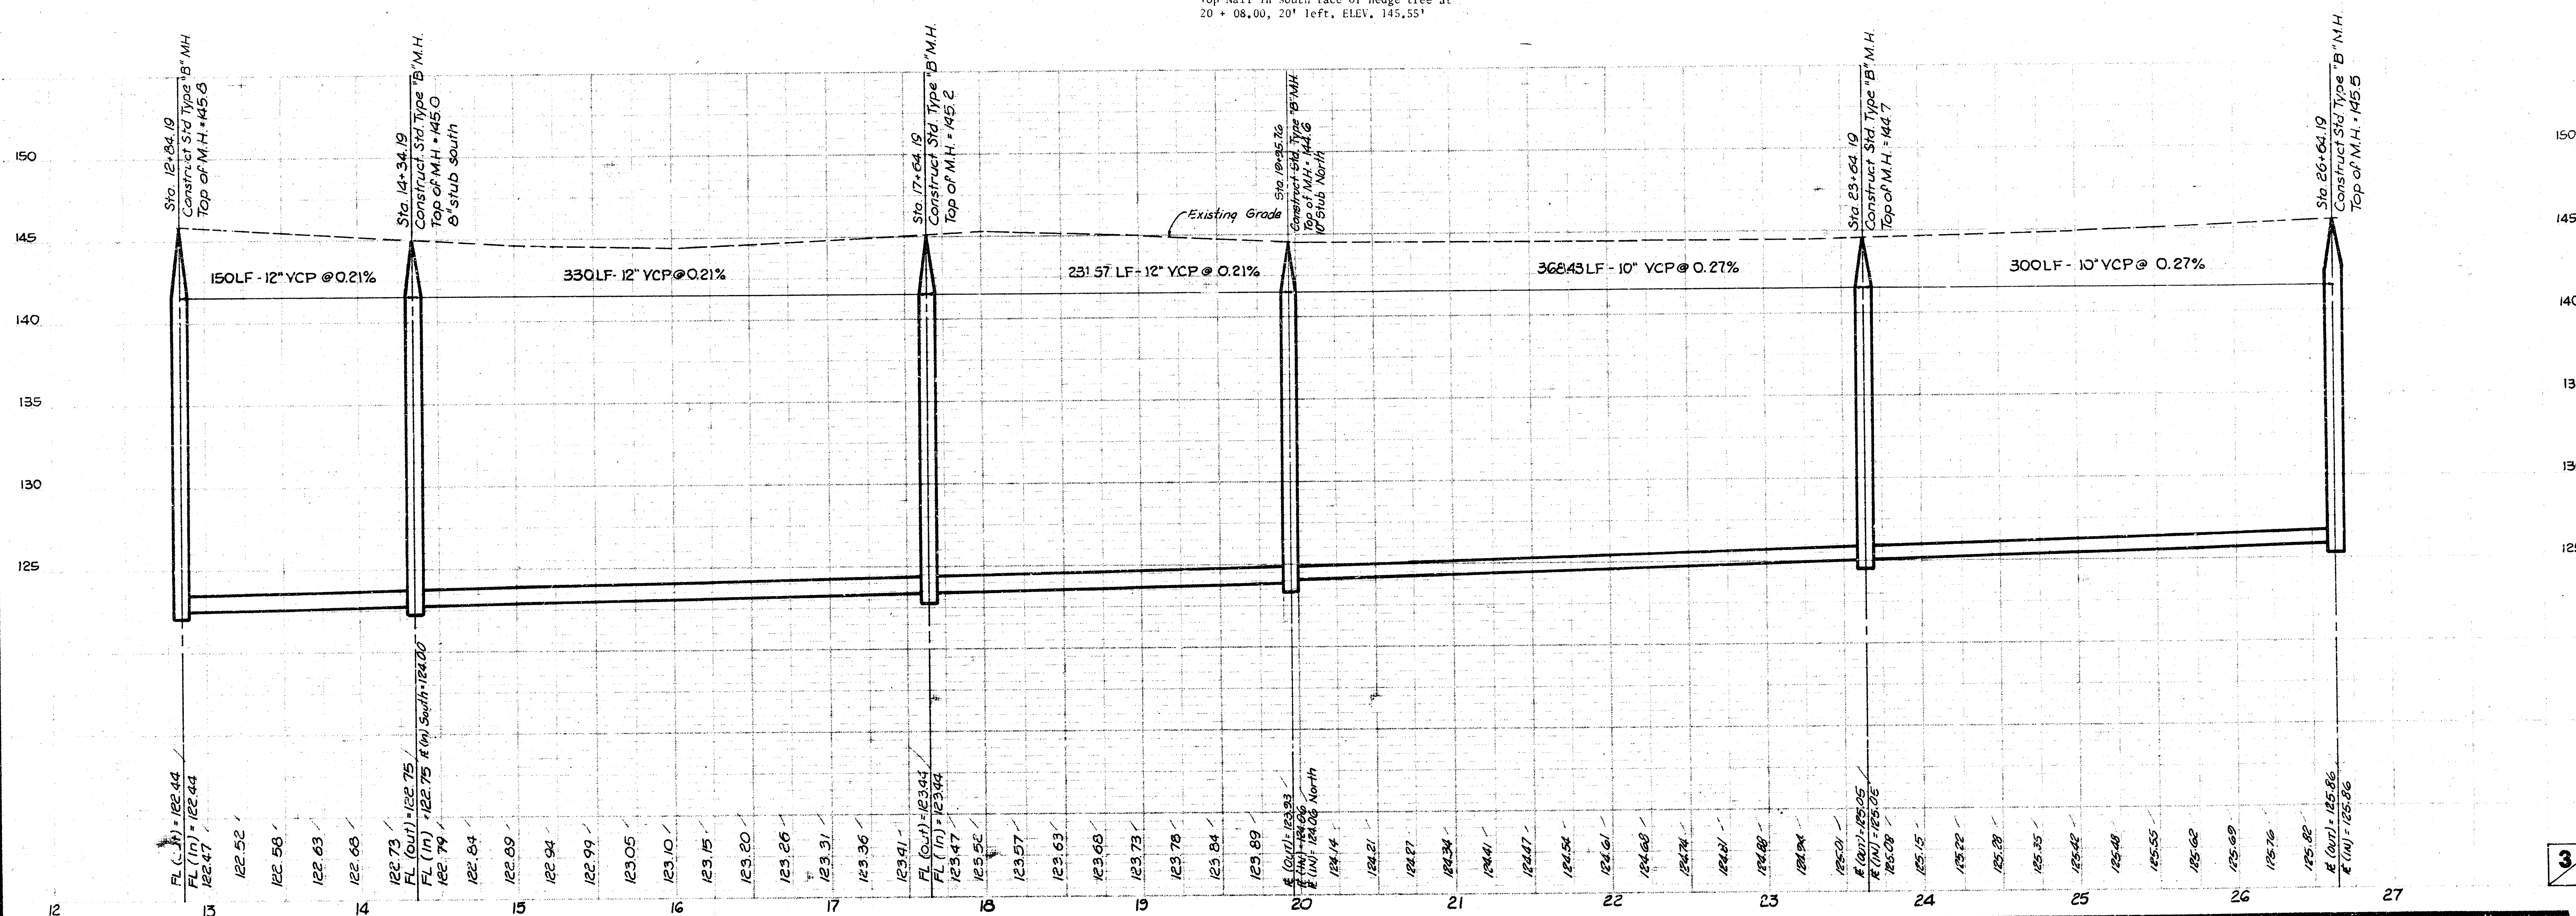

PROJECT NO:
468-76-245-80932-000-000001

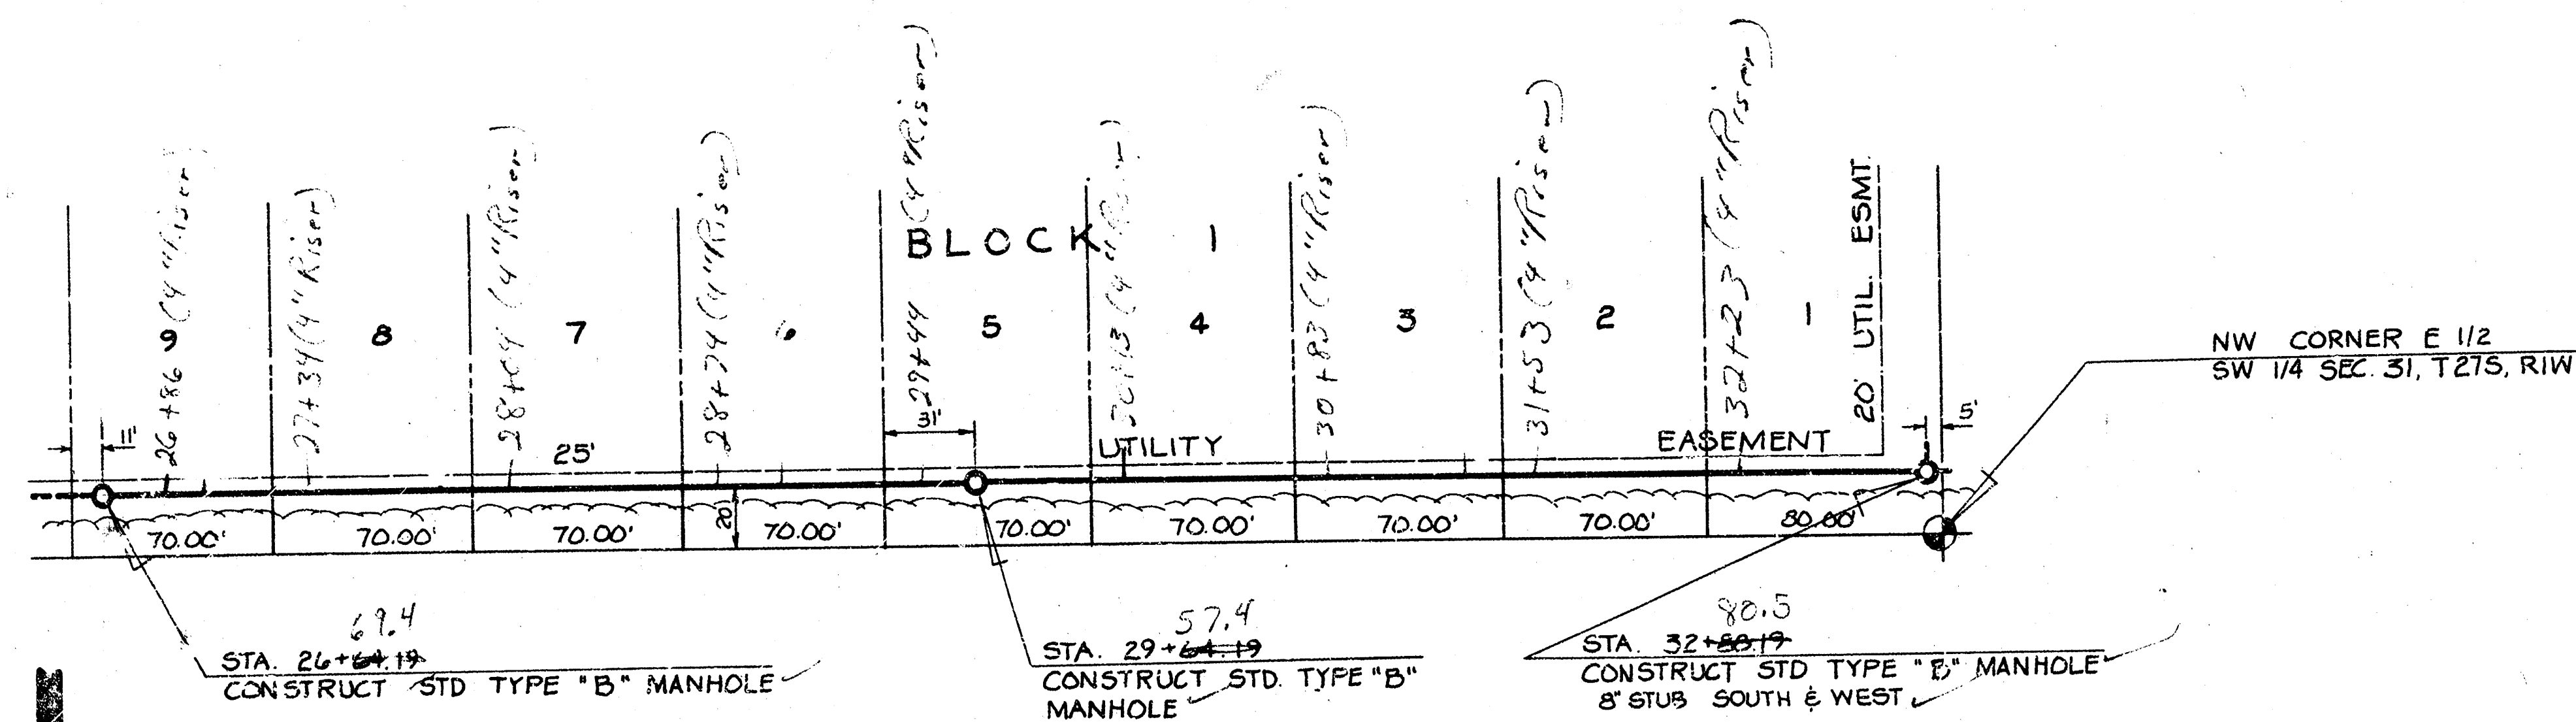

N
SCALE: 1" = 50' HORIZ.
1" = 5' VERT.

Bench Mark # 4
RR Spike in south face of hedge tree at
32 + 25.00, 20' right, ELEV. 145.91

