


82308

CONSTRUCTION PLANS FOR
LATERAL 10, MAIN 17
 OF THE
SOUTHWEST INTERCEPTOR SEWER
 IN
THE CITY OF WICHITA,
 SEDGWICK COUNTY, KANSAS
 MICHAEL E. LINDEBAK, P.E. - CITY ENGINEER

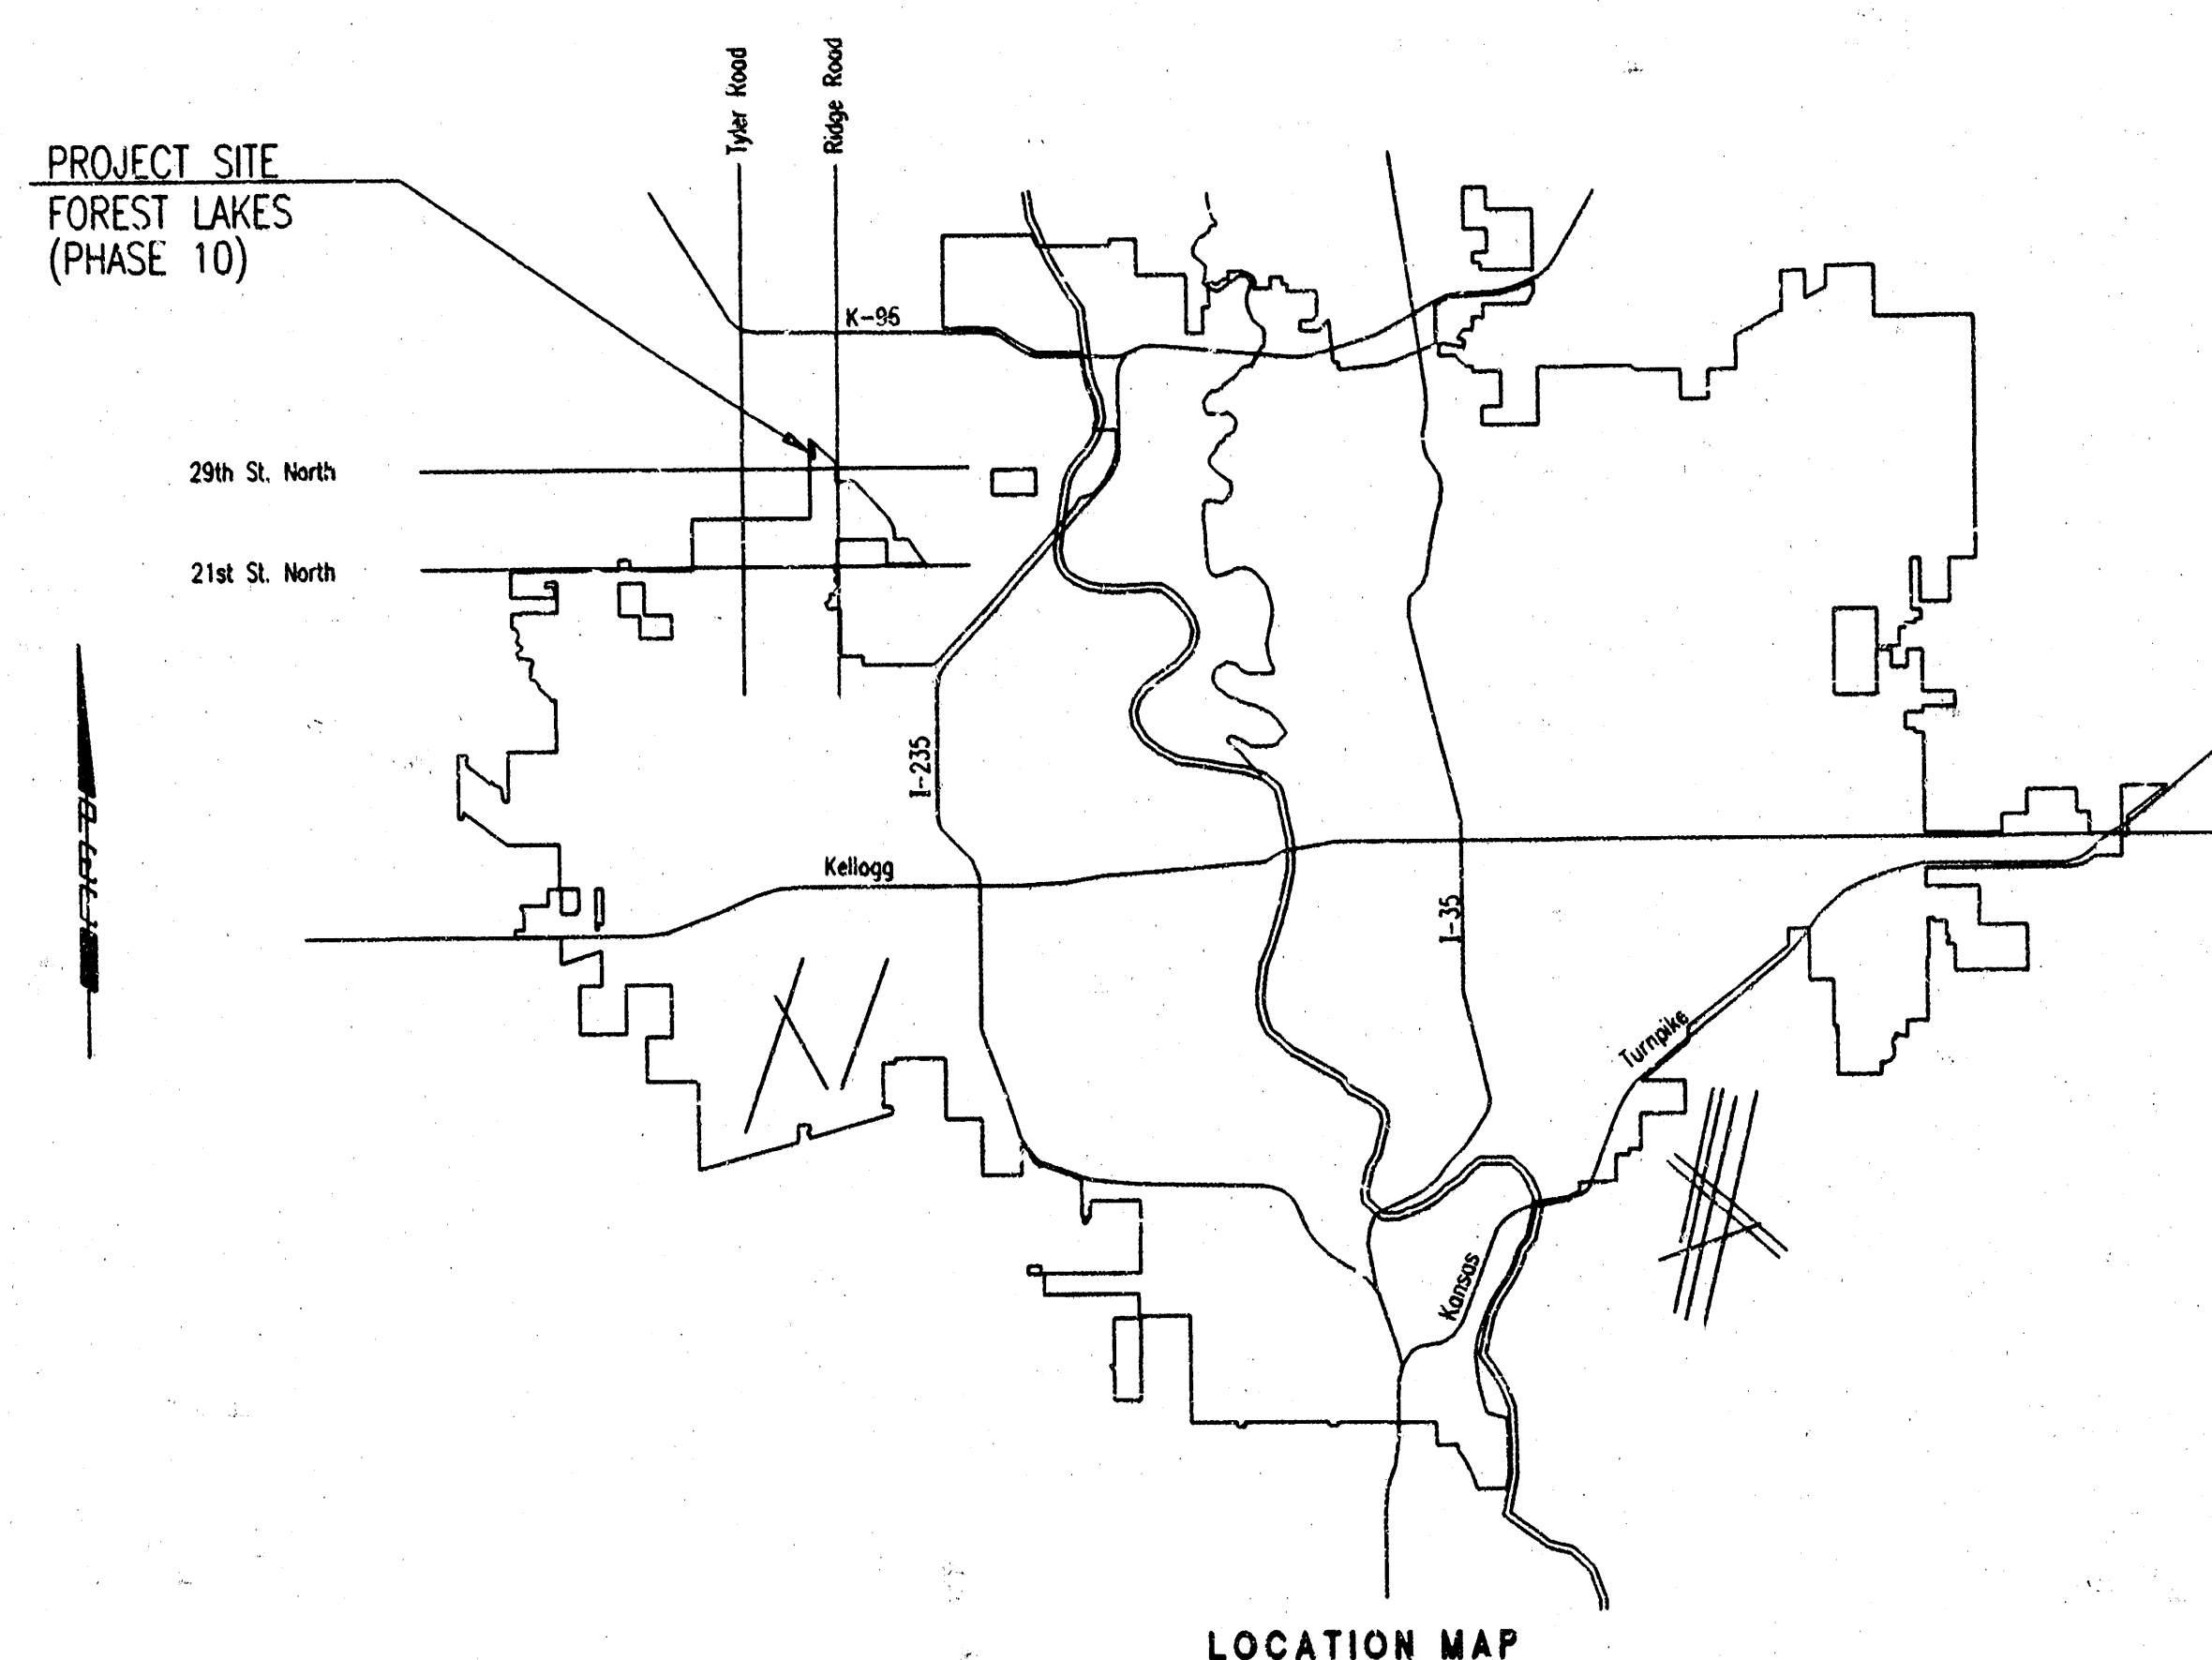

INDEX OF SHEETS

SHEET NO. 1	TITLE SHEET
SHEET NO. 2	KEY MAP
SHEET NO. 3	EASEMENT GRADING PLAN
SHEET NO. 4	PLAT
SHEET NO. 5-6	PLAN/PROFILE
SHEET NO. 7	TYPE "P" MANHOLE DETAILS
SHEET NO. 8	FRAME AND COVER DETAILS
SHEET NO. 9	RISE DETAILS

INDEX CODE 743790
 CITY OF WICHITA PROJECT NO. 468-76-245-82308-000-000-001

MARCH 1999


PLANS PREPARED BY
PROFESSIONAL ENGINEERING CONSULTANTS, P.A.
 ENGINEERS
 WICHITA, KANSAS



RECORD DRAWING

CITY OF WICHITA PROJECT NO. 468-76-245-82308-000-000-001

DSNR: RFL OPER: JLM SCALE: 1"=150.00
01/1997/97852/002/SSKEYMAP 03-31-1999 08:44:04 am

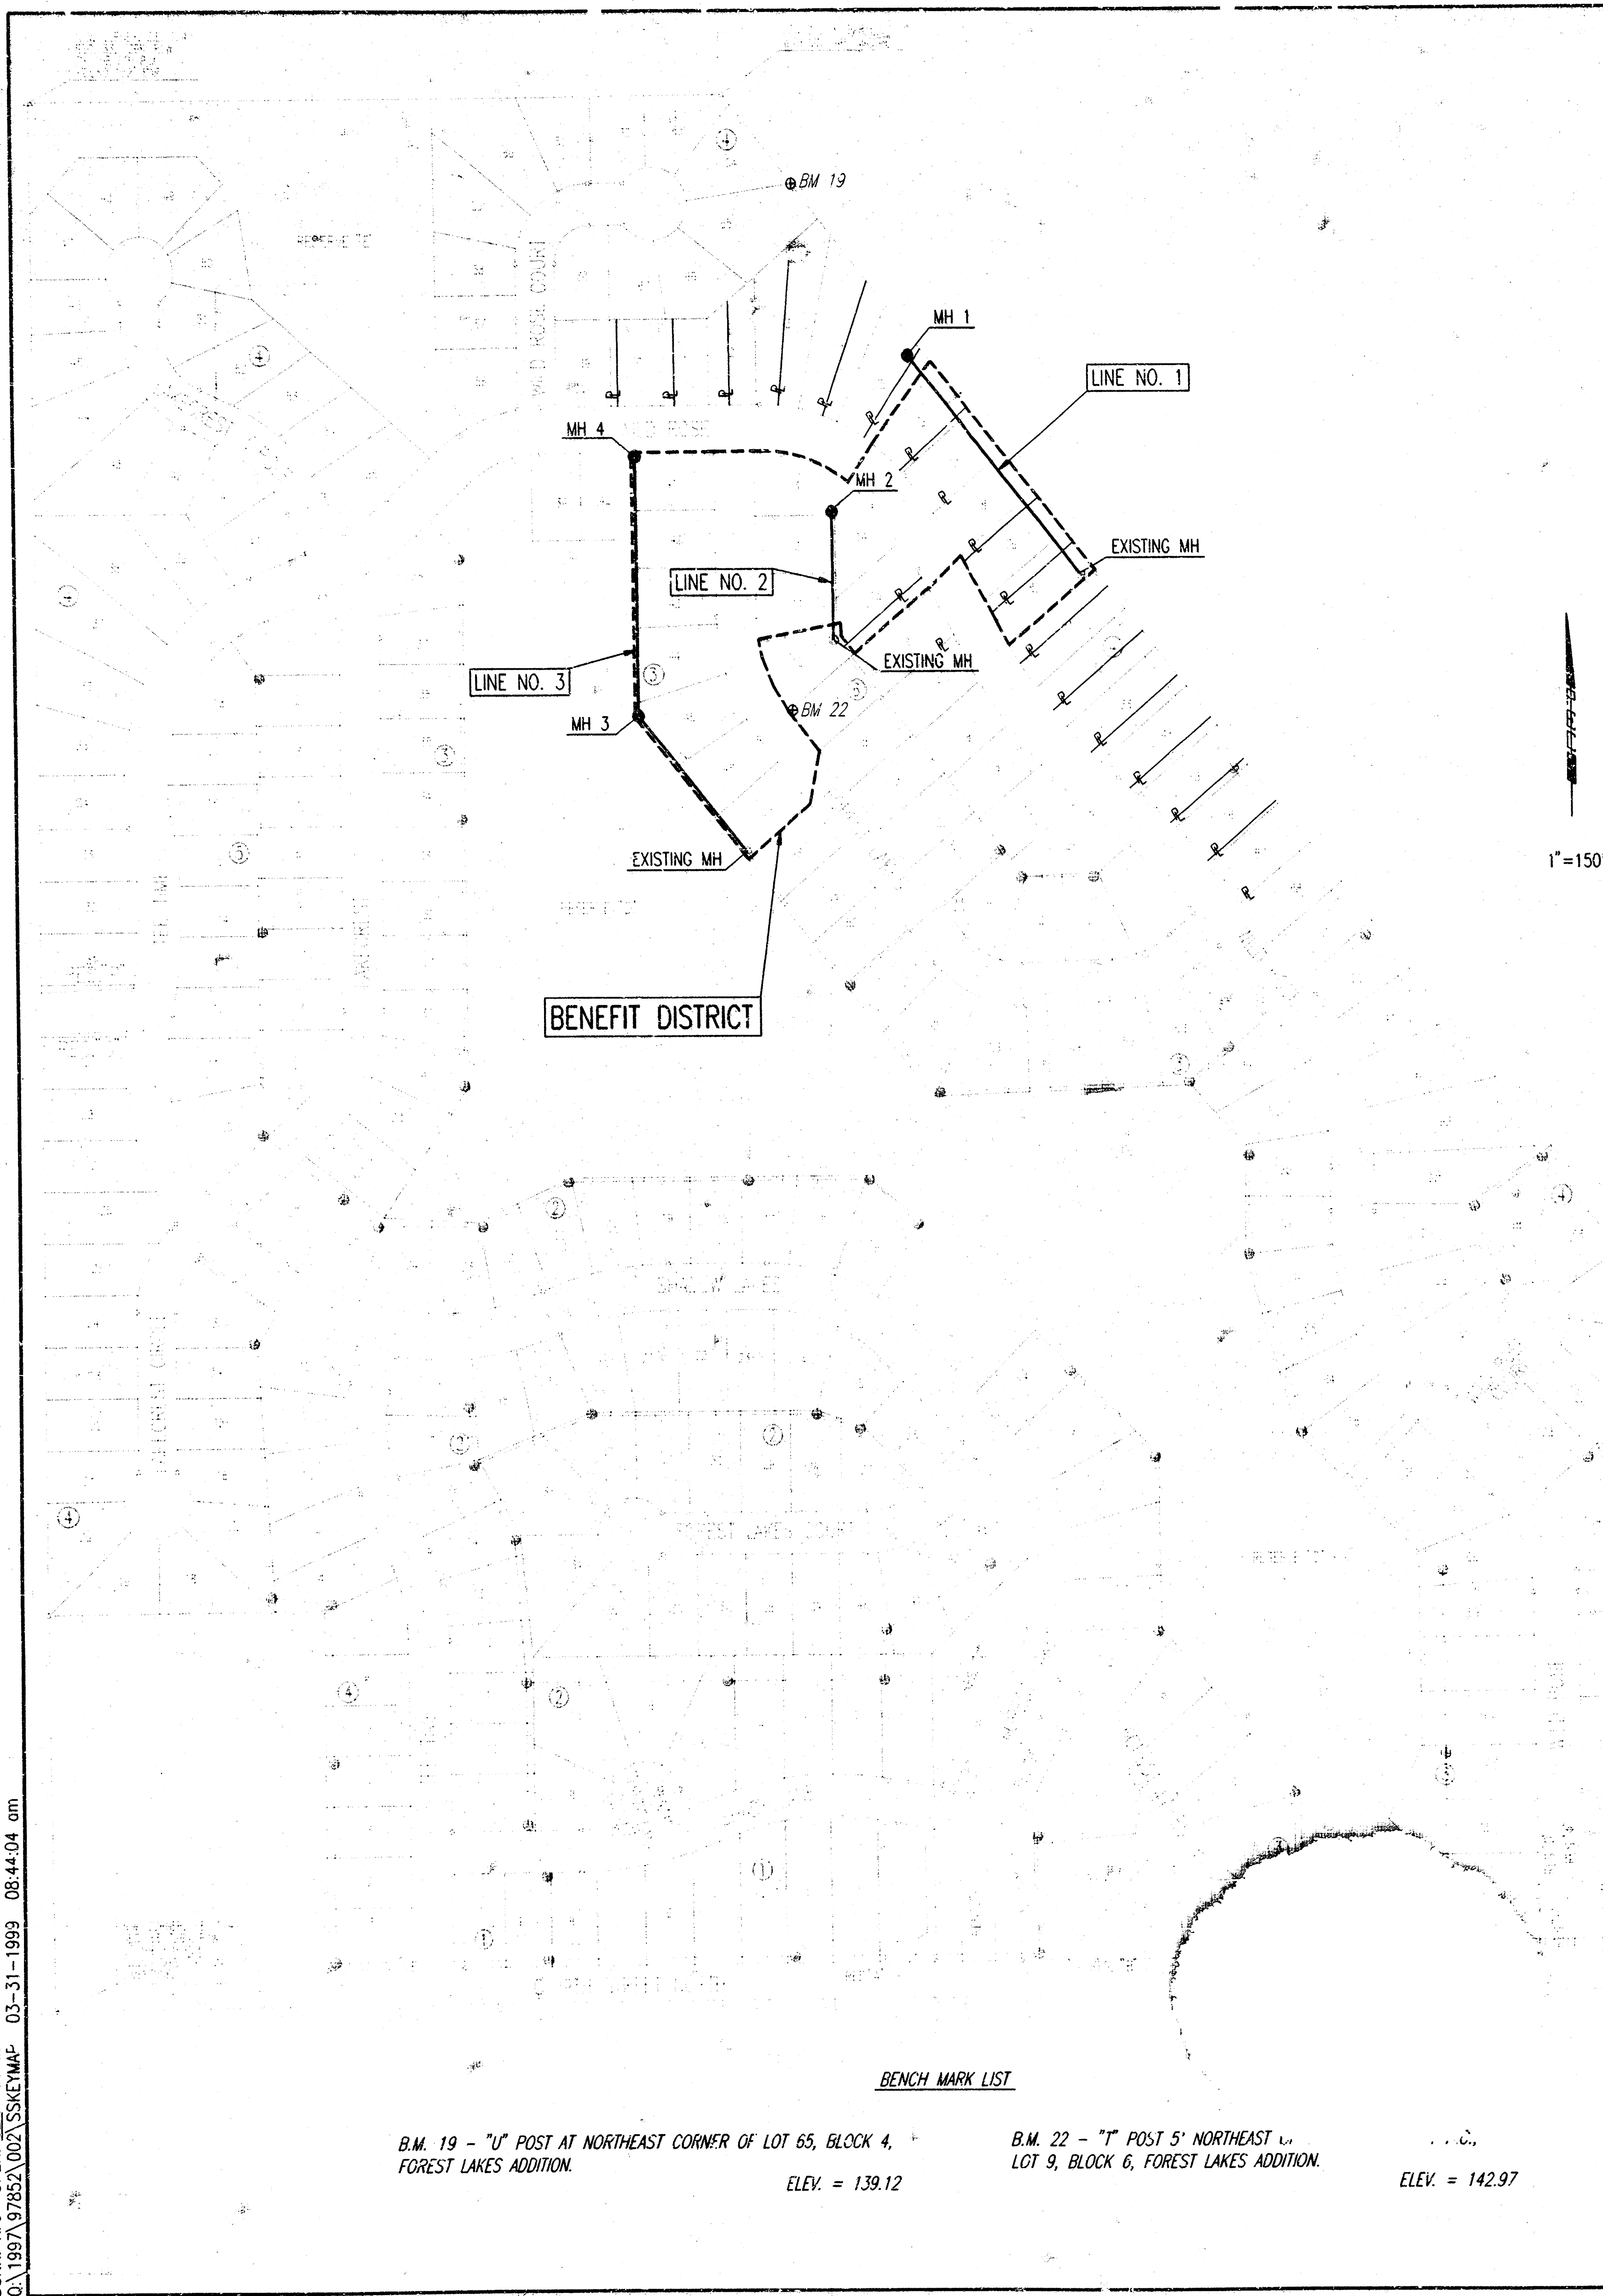

BENCH MARK LIST

B.M. 19 - "U" POST AT NORTHEAST CORNER OF LOT 65, BLOCK 4,
FOREST LAKES ADDITION.
ELEV. = 139.12

B.M. 22 - "T" POST 5' NORTHEAST
LOT 9, BLOCK 6, FOREST LAKES ADDITION.

ELEV. = 142.97

GENERAL NOTES

- ALL CONSTRUCTION AND MATERIALS TO COMPLY WITH CITY OF WICHITA SPECIFICATIONS AND STANDARDS.
- ALL ELEVATIONS SHOWN ARE BASED ON CITY OF WICHITA DATUM.
- THE CONTRACTOR SHALL LIMIT THE EXTENT OF TRENCH TO REMAIN OPEN OVERNIGHT AND WEEKENDS TO LESS THAN 50 FEET.
- AT LEAST 72 HOURS PRIOR TO BEGINNING EXCAVATION (EXCLUDING WEEKENDS AND HOLIDAYS), THE CONTRACTOR SHALL CONTACT THE KANSAS ONE-CALL SYSTEM, A UTILITY LOCATION SERVICE, AT (316) 687-2470 TO REQUEST THE LOCAL UTILITY COMPANIES MARK ANY EXISTING LINES WITHIN THE PROJECT AREA.
- UNDERGROUND UTILITY SERVICE LINES AND OVERHEAD UTILITY POLE LINES ARE TO BE ADJUSTED AS NECESSARY BY OTHERS PRIOR TO CONSTRUCTION UNLESS THE PLANS SPECIFICALLY CALL FOR THEIR ADJUSTMENT BY THE CONTRACTOR OR UNLESS THE PLANS SPECIFICALLY IDENTIFY A UTILITY TO BE ADJUSTED BY ITS OWNER DURING CONSTRUCTION. EXISTING UTILITIES AND THEIR LOCATIONS, AS SHOWN ON THE PLANS, REPRESENT THE BEST INFORMATION OBTAINABLE FOR THE DESIGN. THE CONTRACTOR WILL BE REQUIRED TO WORK AROUND EXISTING UTILITIES WITHIN THE RIGHT-OF-WAY WHICH DO NOT CONFLICT WITH PROPOSED CONSTRUCTION.
- THE CONTRACTOR SHALL BE RESPONSIBLE FOR PRESERVING PROPERTY IRONS. THE CONTRACTOR WILL BE REQUIRED TO RE-ESTABLISH ANY PROPERTY IRONS WHICH ARE DAMAGED OR DESTROYED BY HIS CONSTRUCTION OPERATIONS. SUCH IRONS SHALL BE RE-ESTABLISHED BY A LICENSED LAND SURVEYOR IN ACCORDANCE WITH STATE LAWS. ALL COSTS FOR THIS WORK SHALL BE SUBSIDIARY TO THE LUMP SUM PRICE BID FOR "SITE RESTORATION".
- CONTRACTOR SHALL PROVIDE POSITIVE DRAINAGE AWAY FROM ALL MANHOLE COVERS.
- MANHOLES SHALL BE TYPE "P" MANHOLES. MANHOLES SHALL BE CONSTRUCTED IN ACCORDANCE WITH THE STANDARD SPECIFICATIONS AND THE STANDARD DETAIL DRAWINGS.
- ALL LAWN/TURF AREAS DISTURBED BY CONSTRUCTION OF THE PROPOSED IMPROVEMENTS SHALL BE RESTORED WITH THE SAME GRASS/SOD AS EXISTING. RESTORATION OF DISTURBED AREAS SHALL INCLUDE, BUT NOT BE LIMITED TO, TOP SOIL PREPARATION, SEEDING, MULCH, AND/OR RESEEDING. ALL SEEDING/SODING WORK SHALL BE IN ACCORDANCE WITH THE CITY OF WICHITA STANDARD SPECIFICATIONS AND THE CITY OF WICHITA ADMINISTRATIVE REGULATION NO. A778 WHICH GOVERNS CLEANUP AND RESTORATION OR REPLACEMENT FOLLOWING CONSTRUCTION. ALL COSTS FOR THIS WORK SHALL BE SUBSIDIARY TO THE LUMP SUM PRICE BID FOR "SITE RESTORATION".
- RUBBLE FROM THE REMOVAL OF MISCELLANEOUS STRUCTURES INCLUDING ANY TREES, REMOVED, TREE TRIMMINGS, AND EXCESS EXCAVATION WHICH IS TO BE WASTED SHALL BE DISPOSED OF ON SITES PROVIDED BY THE CONTRACTOR. THESE SITES SHALL ALSO BE APPROVED BY THE ENGINEER AS TO SUITABILITY, APPEARANCE, AND SITE LOCATION. LOCATIONS THAT IN THE OPINION OF THE ENGINEER WILL LEAVE AN UNSIGHTLY APPEARANCE WILL NOT BE APPROVED. ALL DISPOSAL SITES MUST BE APPROVED BY THE KANSAS DEPARTMENT OF HEALTH AND ENVIRONMENT. MATERIAL EITHER STOCKPILED OR DISPOSED OF IN A FLOOD PLAIN WILL REQUIRE A KANSAS STATE BOARD OF AGRICULTURE PERMIT. ANY MATERIAL DUMPED IN WATERS OF THE UNITED STATES OR WETLANDS IS SUBJECT TO U.S. CORPS OF ENGINEERS PERMITTING REGULATIONS. ANY MATERIAL BURIED OR STOCKPILED BEYOND APPROVED CONSTRUCTION LIMITS MAY REQUIRE ARCHAEOLOGICAL INVESTIGATIONS UNLESS BURIED IN A PREVIOUSLY APPROVED DISPOSAL LOCATION.
- THE CONTRACTOR SHALL AVOID REMOVAL OR TRIMMING OF ANY TREES OR SHRUBS WHERE POSSIBLE. WHERE THE CONTRACTOR BELIEVES THE REMOVAL OR TRIMMING IS UNAVOIDABLE, HE SHALL COORDINATE SUCH WORK WITH THE ENGINEER. COSTS FOR TREE/SHRUB REMOVAL AND TRIMMING REGARDLESS OF SIZE SHALL BE CONSIDERED SUBSIDIARY TO THE LUMP SUM PRICE BID FOR "SITE CLEARING".
- CONTRACTOR SHALL GRADE THE SANITARY SEWER ALIGNMENT TO THE PROFILE AND ELEVATIONS SHOWN ON THE EASEMENT GRADING PLAN. ALL COSTS FOR EASEMENT GRADING SHALL BE SUBSIDIARY TO THE LUMP SUM PRICE BID FOR "EASEMENT GRADING".
- THE CONTRACTOR SHALL PREVENT ANY CONSTRUCTION DEBRIS FROM ENTERING THE EXISTING SANITARY SEWER DURING CONSTRUCTION.
- THE CONTRACTOR SHALL GIVE ALL PROPERTY OWNERS AND/OR TENANTS OF DEVELOPED PROPERTY ADJACENT TO THE CONSTRUCTION OF THIS PROJECT A MINIMUM OF TEN (10) DAYS ADVANCE NOTICE PRIOR TO START OF CONSTRUCTION.
- ALL APPROVED EXCESS EXCAVATION WHICH IS TO BE WASTED SHALL BE STOCKPILED WITHIN FOREST LAKES AT NO ADDITIONAL COST TO THE OWNER. STOCKPILE LOCATIONS SHALL BE AS DIRECTED BY MR. MARVIN SCHELLENBERG, AT (316) 721-2153 AND IN ACCORDANCE WITH GENERAL NOTE NO. 10 ABOVE.
- CONTRACTOR IS REQUIRED TO MAINTAIN CONTINUOUS FLOW OF SEWAGE IN EXISTING MAINS AT ALL TIMES.
- THE CONTRACTOR SHALL SEED ALL AREAS DISTURBED BY CONSTRUCTION ACTIVITIES WITH TEMPORARY RYE GRASS. RYE GRASS SEED SHALL BE PLANTED AT A MINIMUM RATE OF SIX (6) POUNDS PER ONE THOUSAND (1,000) SQUARE FEET. THIS TEMPORARY SEEDING MAY BE OMITTED ONLY IF OTHER SEEDING IS REQUIRED IN ACCORDANCE WITH GENERAL NOTE NO. 9 ABOVE. TEMPORARY SEEDING OR PERMANENT SEEDING/SODING SHALL BE APPLIED WITHIN 14 DAYS AFTER THE AREA HAS BEEN DISTURBED.
- INTERURBAN TRAFFIC GENERATED OUTSIDE THE PROJECT AREA AND LOCAL BUSINESS OR RESIDENTIAL TRAFFIC GENERATED WITHIN THE PROJECT AREA ARE TO BE CARRIED THROUGH CONSTRUCTION AS FURTHER PROMULGATED BY PROJECT SPECIAL PROVISIONS.


SEWER SERVICE TABLE
(See detail and notes, sheet no. 9)

SEWER SERVICE TABLE											
(See detail and notes, sheet no. 5)											
NO.	TYPE	LOCATION				FOR INFORMATION ONLY		RECORD INFORMATION			NO.
		LOT NO.	BLOCK NO.	LINE NO.	STATION/DIRECTION	APPROXIMATE LENGTH 4" PIPE		(TO BE COMPLETED BY PROJECT INSPECTOR)			
						VERTICAL	HORIZONTAL	DISTANCE FROM NEAREST MANHOLE			
								UPSTREAM	DOWNSTREAM		
1	8"x4" Tee Saddle	80	4	1	0+15/LI	3'	4'	376.6' To MH 1	15.0' To	1	
2	8"x4" Tee Saddle	79	4	1	0+85/LI	3'	4'	306.6' To MH 1	85.0' To Exist. MH	2	
3	8"x4" Tee Saddle	78	4	1	1+55/LI	3'	4'	226.6' To MH 1	135.0' To Exist. MH	3	
4	8"x4" Tee Saddle	77	4	1	2+25/LI	3'	4'	166.6' To MH 1	225.0' To Exist. MH	4	
5	8"x4" Tee Saddle	76	4	1	3+05/LI	3'	4'	86.6' To MH 1	305.0' To Exist. MH	5	
6	8"x4" Tee Saddle	15	6	2	0+20/RI	3'	14'			6	
7	8"x4" Tee Saddle	11	6	2	0+45/LI	3'	± 5'	131.0' To MH 2	450.0' To Exist. MH	7	
8	8"x4" Tee Saddle	14	6	2	0+95/RI	3'	14'	83.0' To MH 2	94.0' To Exist. MH	8	
9	8"x4" Tee Saddle	12	6	2	1+20/LI	3'	± 5'	52.0' To MH 2	120.0' To Exist. MH	9	
10	MH Service Connection	13	6	2	1+76.1/NW	3'	7'		6.0' To Exist. MH	10	
11	8"x4" Tee Saddle	47	3	3	0+15/NECH 17/RI	3'	14'	227.0' To MH 3	17.0' To Exist. MH	11	
12	8"x4" Tee Saddle	46	3	3	0+95/RI	3'	14'	148.0' To MH 3	95.0' To Exist. MH	12	
13	8"x4" Tee Saddle	45	3	3	1+85/NECH 14 87/RI	3'	14'	57.0' To MH 3	186.0' To Exist. MH	13	
14	8"x4" Tee Saddle	44	3	3	2+55/NECH 41 87/RI	3'	14'	313.0' To MH 4	48.0' To MH 3	14	
15	8"x4" Tee Saddle	43	3	3	3+95/RI	3'	14'	210.0' To MH 4	150.0' To MH 3	15	
16	8"x4" Tee Saddle	42	3	3	4+25/NECH 41 72/RI	3'	14'	132.0' To MH 4	229.0' To MH 3	16	
17	8"x4" Tee Saddle	40	3	3	5+15/LI	3'	4'	91.0' To MH 4	270.0' To MH 3	17	
18	8"x4" Tee Saddle	41	3	3	5+55/NECH 51 58/RI	3'	14'	47.0' To MH 4	314.0' To MH 3	18	

NOTES:



- Vertical Riser Pipe shall be extended to 2' minimum above ground water elevation and 4' maximum below proposed ground elevation.

RECORD DRAWING

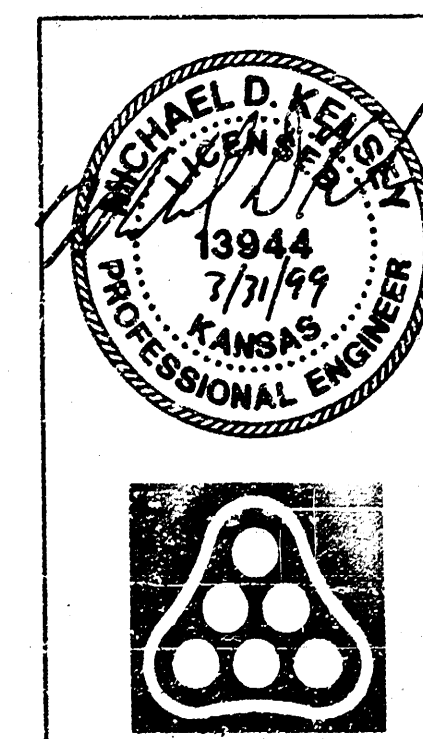

No.	Revision	By	Date
	LATERAL 10, MAIN 17 SOUTHWEST INTERCEPTOR SEWER		
KEY MAP			
MICHAEL E. LINDEBAK, P.E. - CITY ENGINEER C.O.W. Proj. No. 468-76-245-82308-000-000-001			
Professional Engineering Consultants, P.A. 303 S. TOPEKA - WICHITA, KANSAS 67202 316-262-5091 • FAX 316-262-3003			
Designed by	MDK	Job No.	34-97852-2
Drawn by	DMM	Date	August 1997
		Sh.	2 of 9

DSNR: REJ OFFER: JLM SCALE: 1"=100.00
 0\1997\97852\002\ESMGSD 03-31-1999 08:47:23 am

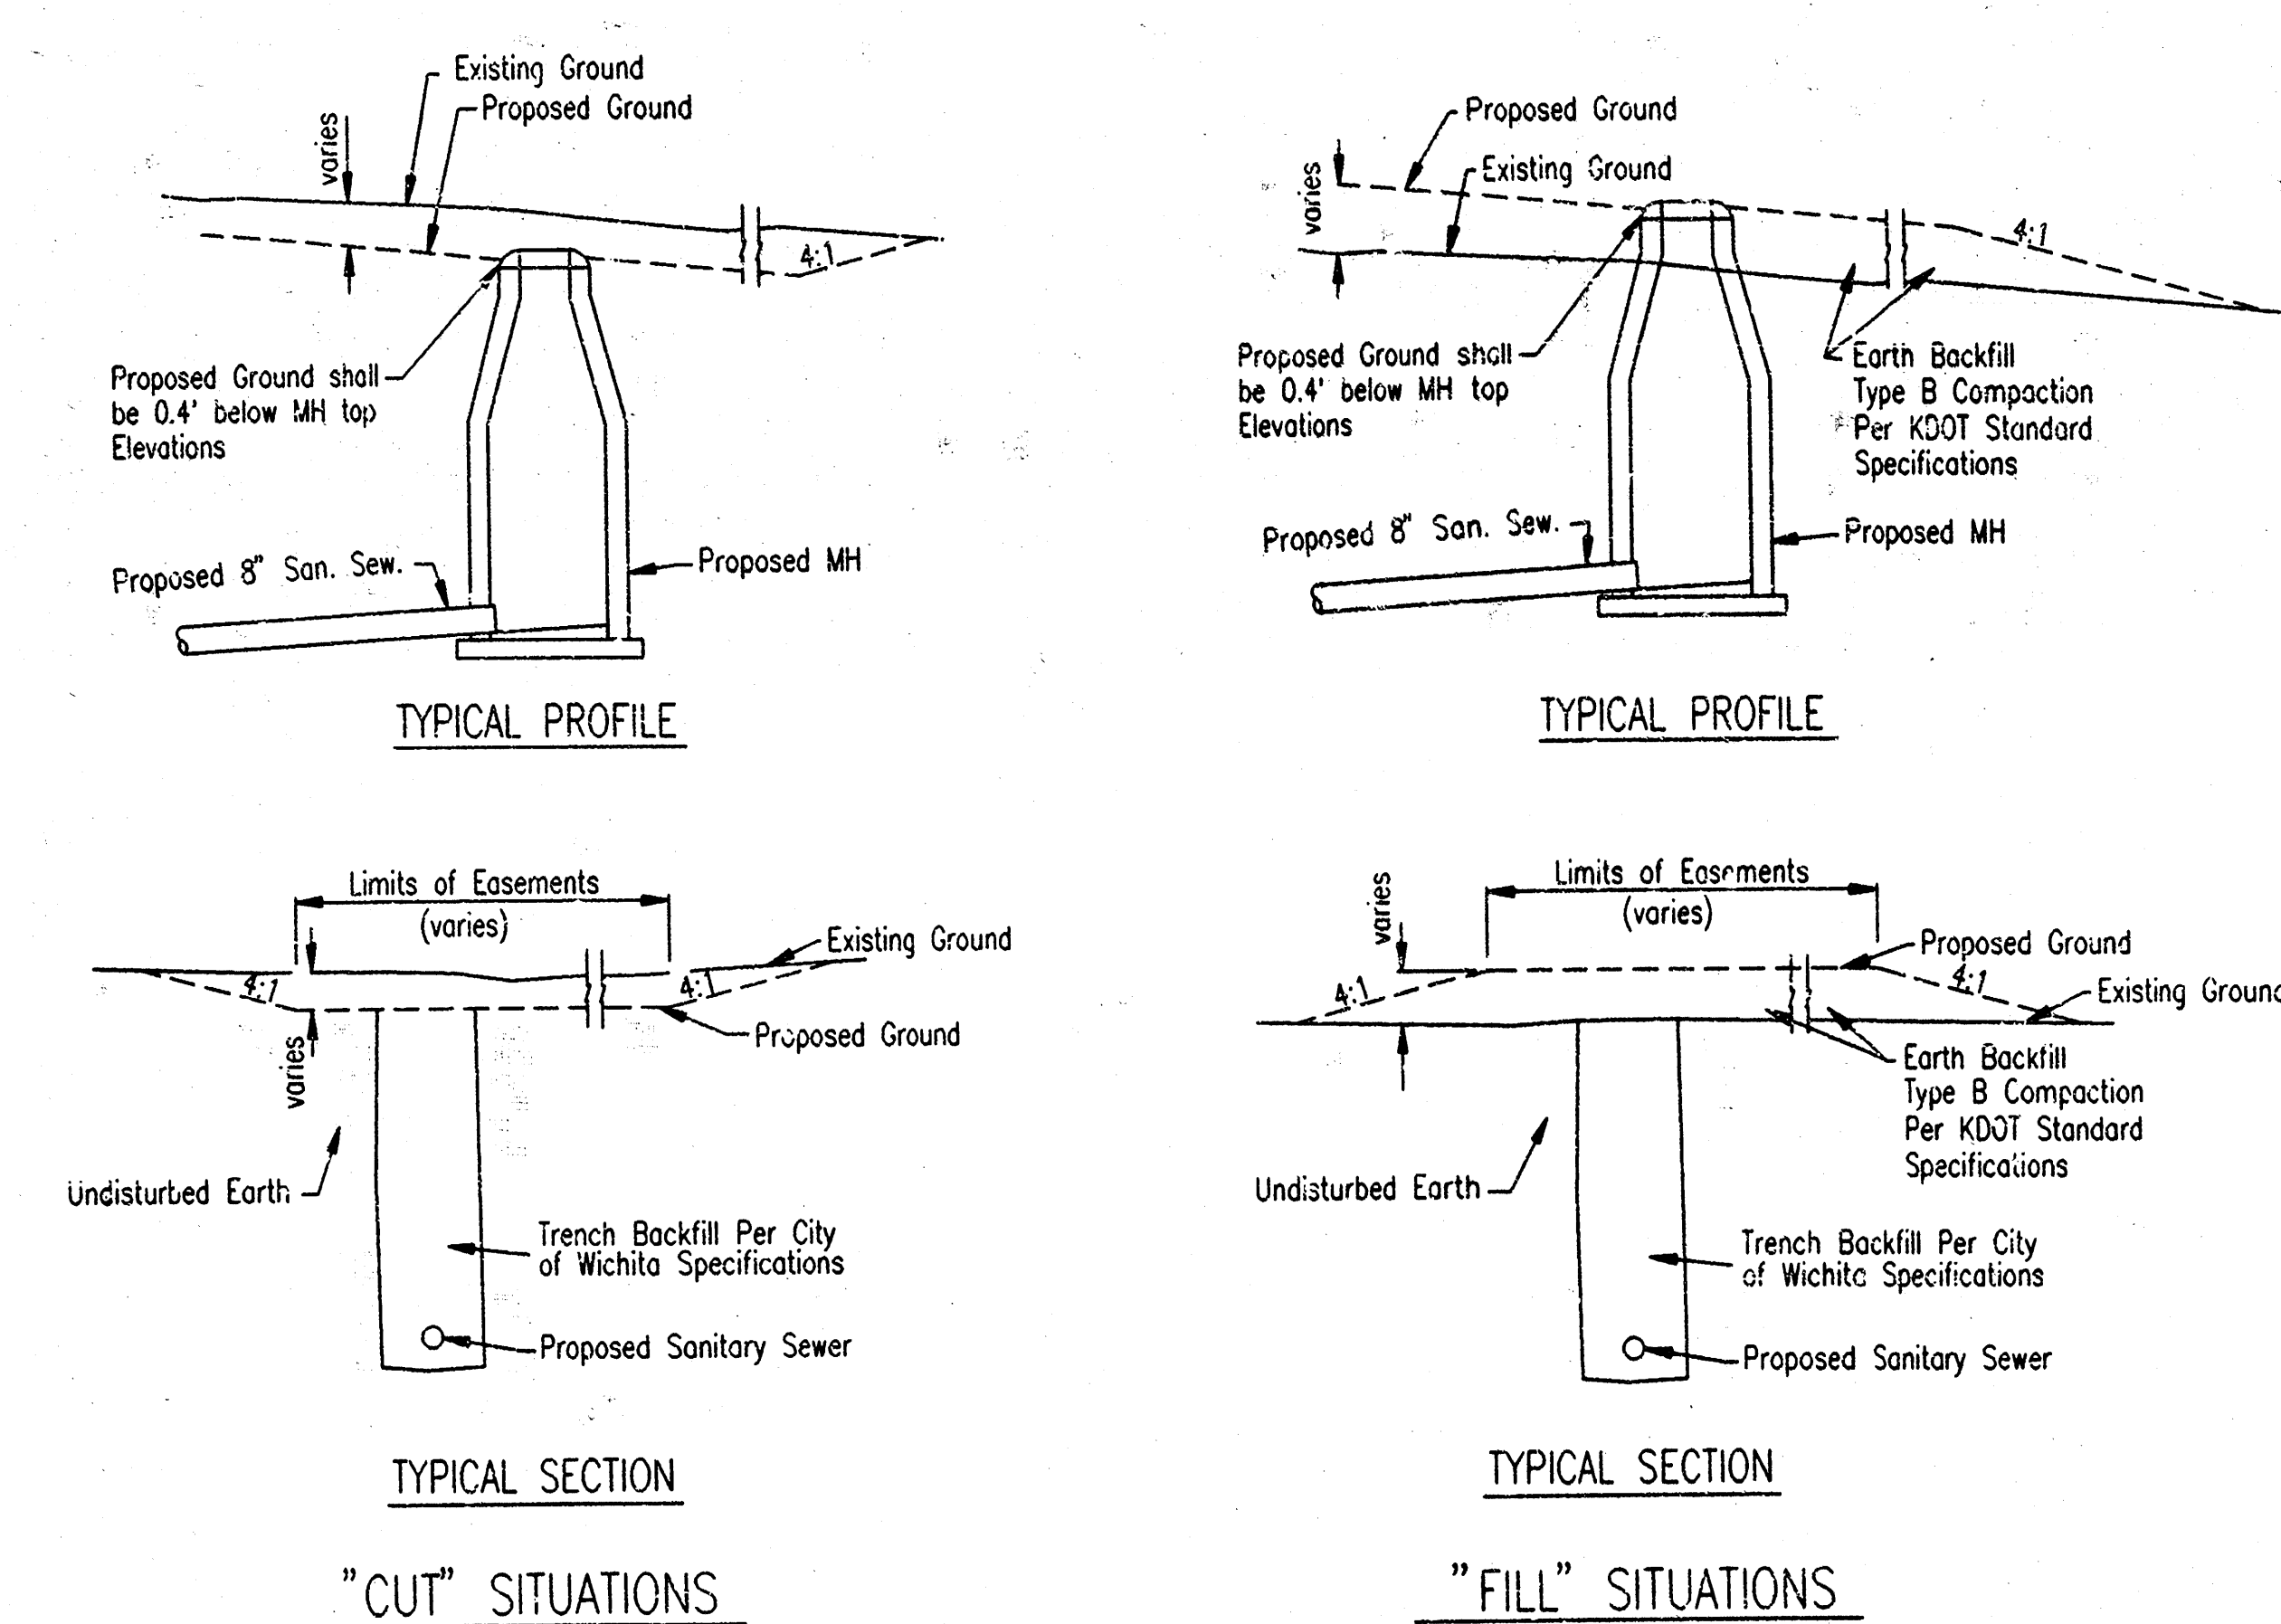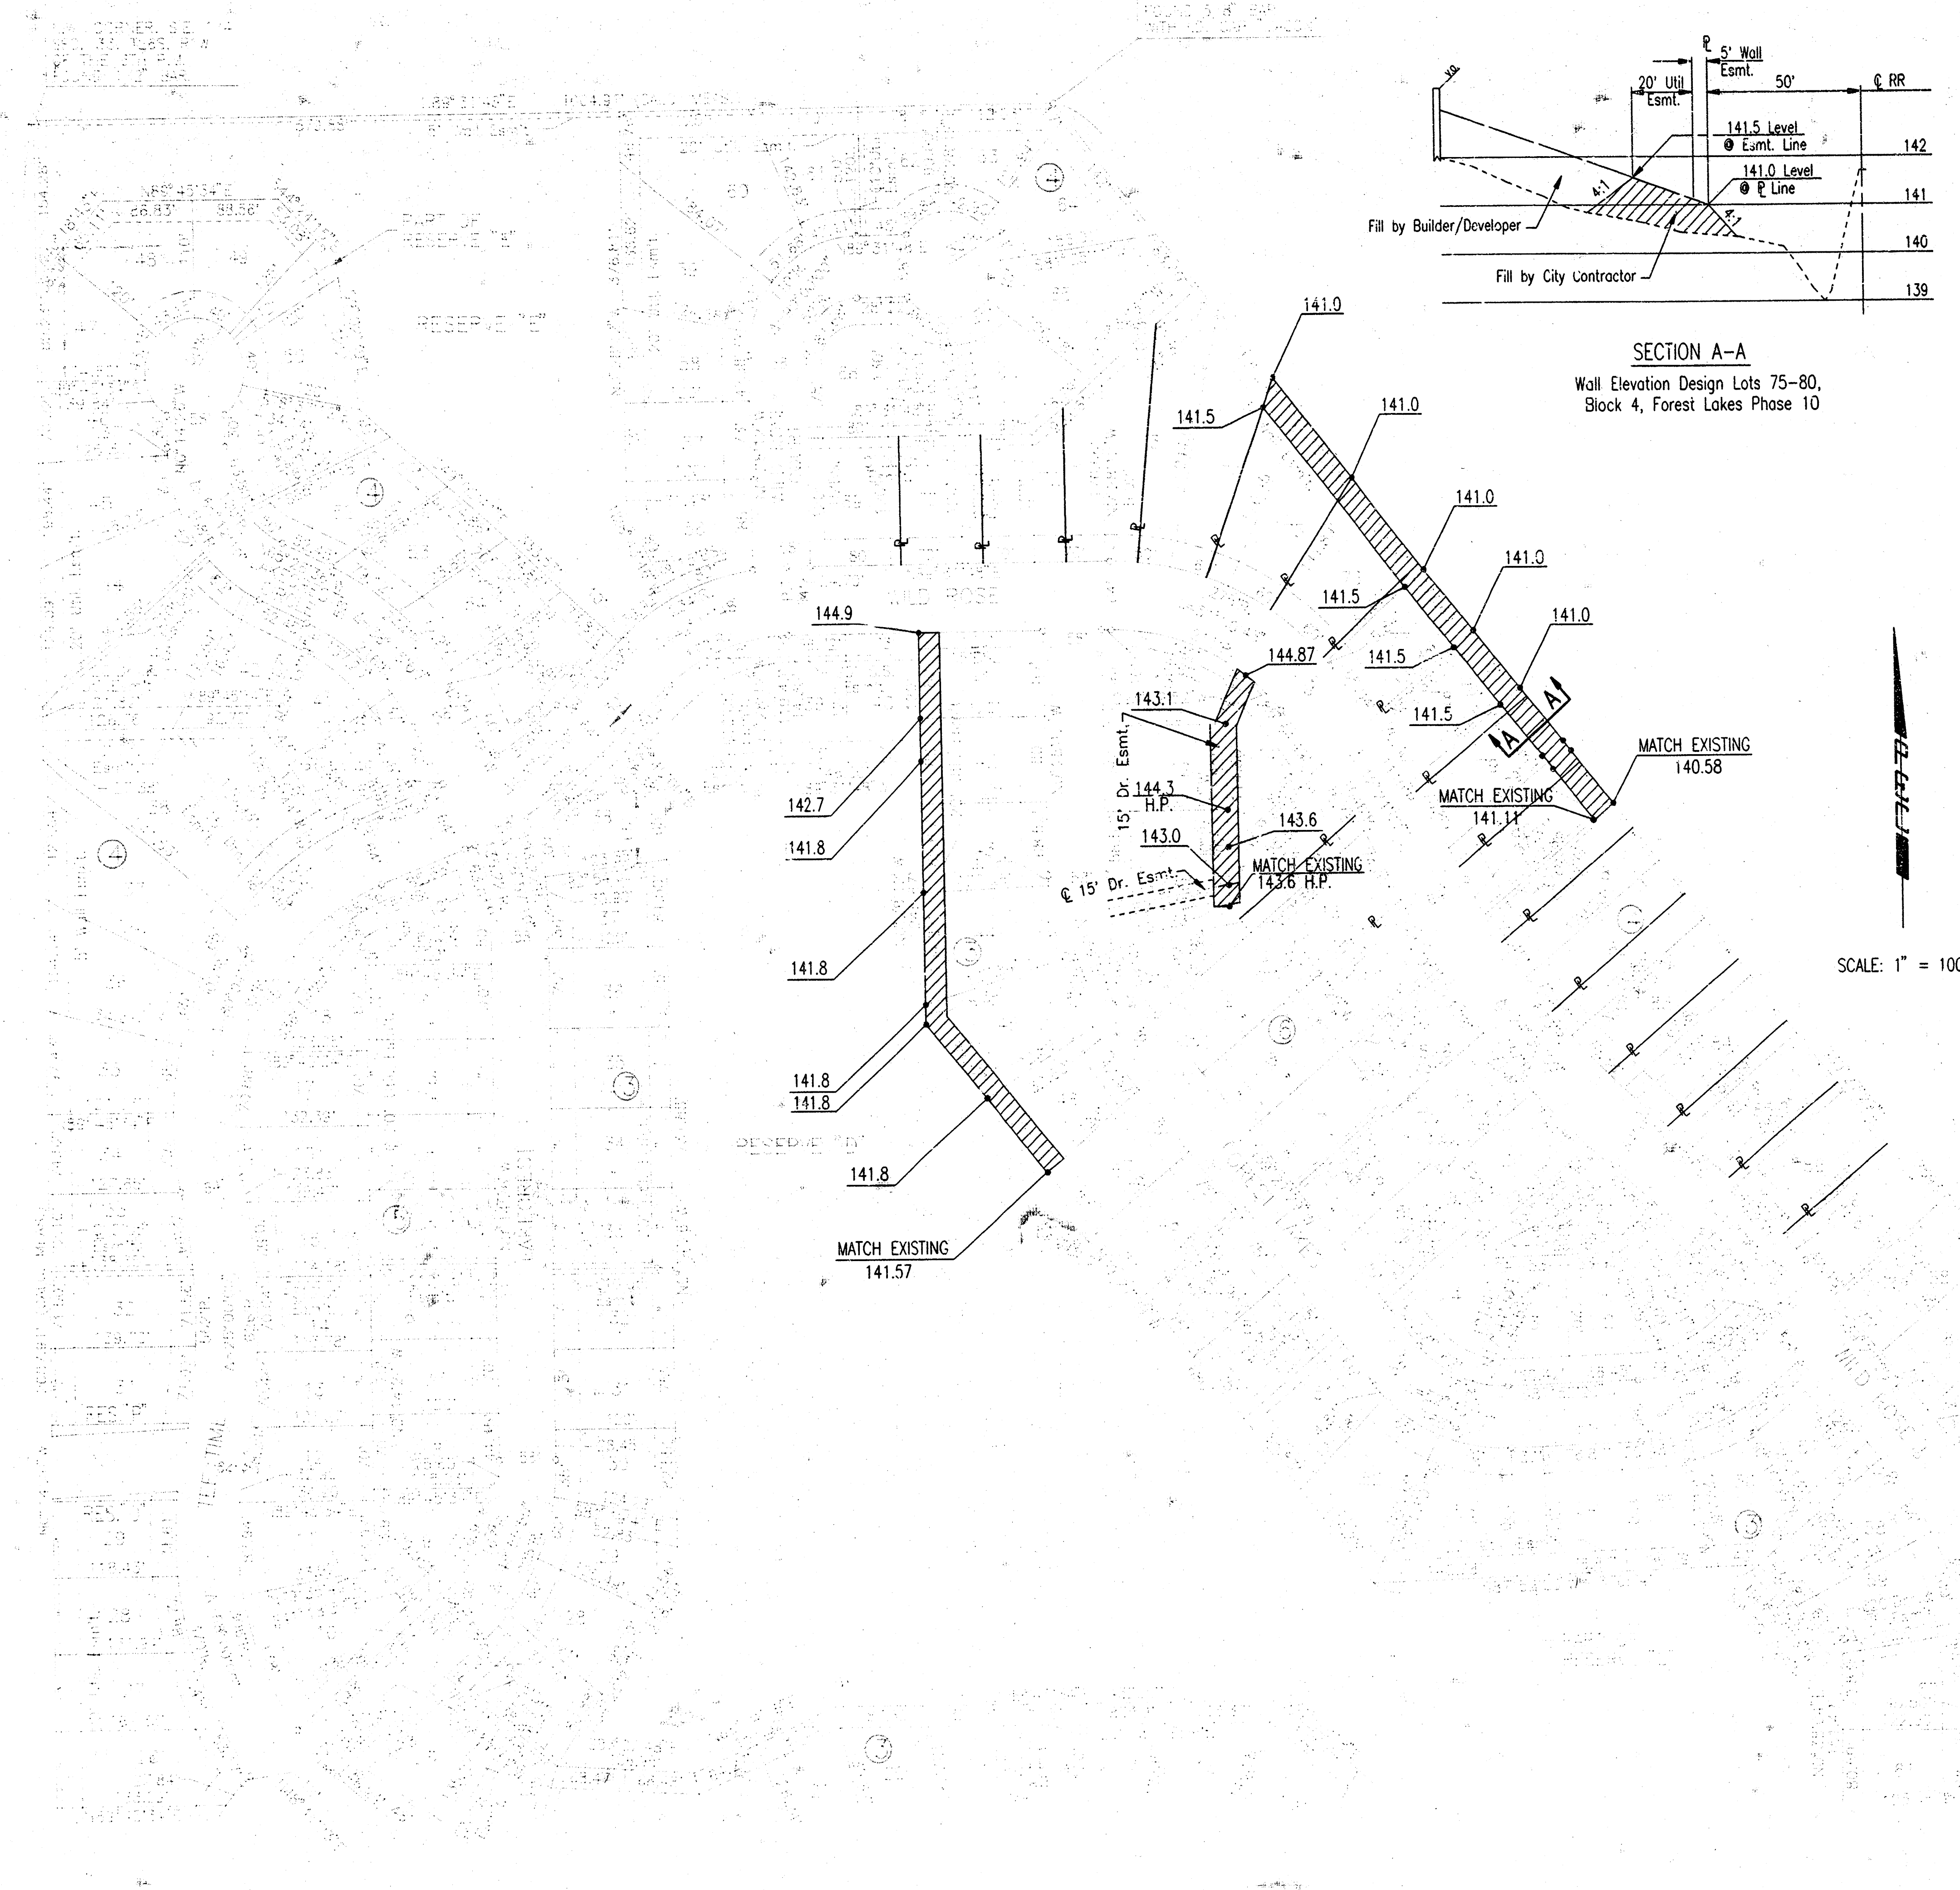

EASEMENT GRADING DETAILS

= AREAS TO BE GRADED
 H.P. = HIGH POINT
 M.E. = MATCH EXISTING

Easement Grading will be bid on a lump sum basis for grading the easements to the profile and elevations shown on the Easement Grading Plan (this sheet). Approximate quantities of earthwork for easement grading are shown below. These approximate quantities are given for information only. The Contractor should verify the quantities when preparing the proposal.
 Cut 458 C.Y. (Approximate)
 Fill 730 C.Y. (Approximate)

RECORD DRAWING

	Revision		By	Date
	LATERAL 10, MAIN 17 OF THE SOUTHWEST INTERCEPTOR SEWER EASEMENT GRADING PLAN MICHAEL E. LINDEBAK, P.E. - CITY ENGINEER CITY OF WICHITA PROJECT NO. 458-76-245-82308-000-001 Professional Engineering Consultants, P.A. 303 S. TOPEKA • WICHITA, KANSAS 67202 316-262-2691 • FAX 316-262-3003			
	Designed by	MDK	Job No.	34-97852-2
	Drawn by	DMM	Date	August 1997
				Sheet 3 of 9

N.W. CORNER, S.E. 1/4
SEC. 33, T26S, R1W
OF THE 6TH P.M.
FOUND 1/2" BAR.

FOUND 5/8" BAR
WITH I.D. CAP "MACON"

○ = 3/4" IRON PIPE WITH I.D. CAP("PEC PA")
SET UNLESS OTHERWISE NOTED.

DATUM BM - CHISELED "X" ON NE CORNER OF EAST HEADWALL OF RCB
UNDER RIDGE RD. AT 200'+ NORTH OF EAST 1/4 CORNER,
SEC. 4, T27S, R1W.

BM F.L.-2 - CHISELED "X" ON NORTH END OF WEST HEADWALL OF RCB
UNDER WILD ROSE ON SOUTH SIDE OF 29TH STREET NORTH.

BM F.L.-8 - RAILROAD SPIKE IN SOUTH FACE OF 18" ELM IN NORTH TO
SOUTH TREE ROW AT 25± EAST AND 125± NORTH OF EAST
CORNER OF LOT 26, BLOCK 2, FOREST LAKES ADDITION.
ELEV. 141.61

ALL BUILDING SETBACK LINES ARE
25' UNLESS OTHERWISE LABELED.

MINIMUM PAD ELEVATIONS (LOWEST OPENING) SHALL BE AS FOLLOWS:

BLOCK	LOTS	CITY DATUM	M.S.L.
4	47 THROUGH 60	144.82	1332.0
3	1 THROUGH 14	140.32	1327.5
3	54 THROUGH 74	140.32	1327.5
3	15 THROUGH 53	141.82	1329.0

RECORD DRAWING


No.	Revision	By	Date
LATERAL 10, MAIN 17 OF THE SOUTHWEST INTERCEPTOR SEWER PLAT MICHAEL E. LOEBACK, P.E. - CITY ENGINEER CITY OF WICHITA PROJECT NO. 468-76-245-82308-000-000-001 <i>Professional Engineering Consultants, P.A.</i> 303 S. TOPEKA • WICHITA, KANSAS 67202 316-262-2391 • FAX 316-262-9003			
Designed by	Job No. 34-97852-2	Sht. 4 of 9	
Drawn by DEP	Date August 1997		

DSNR: RFJ OPER: JLM SCALE: 1=100.00
Q: 1997/97852/002\PLAT-1 03-31-1999 08:42:37 am

PLAN	CHECKED	DATE

PROFILE	CHECKED	DATE


DSNR: RE: OFFR: JLM SCALE: 1=40.00
C:\1997\07852\002\pp1_03-31-1999 08:49:50 am

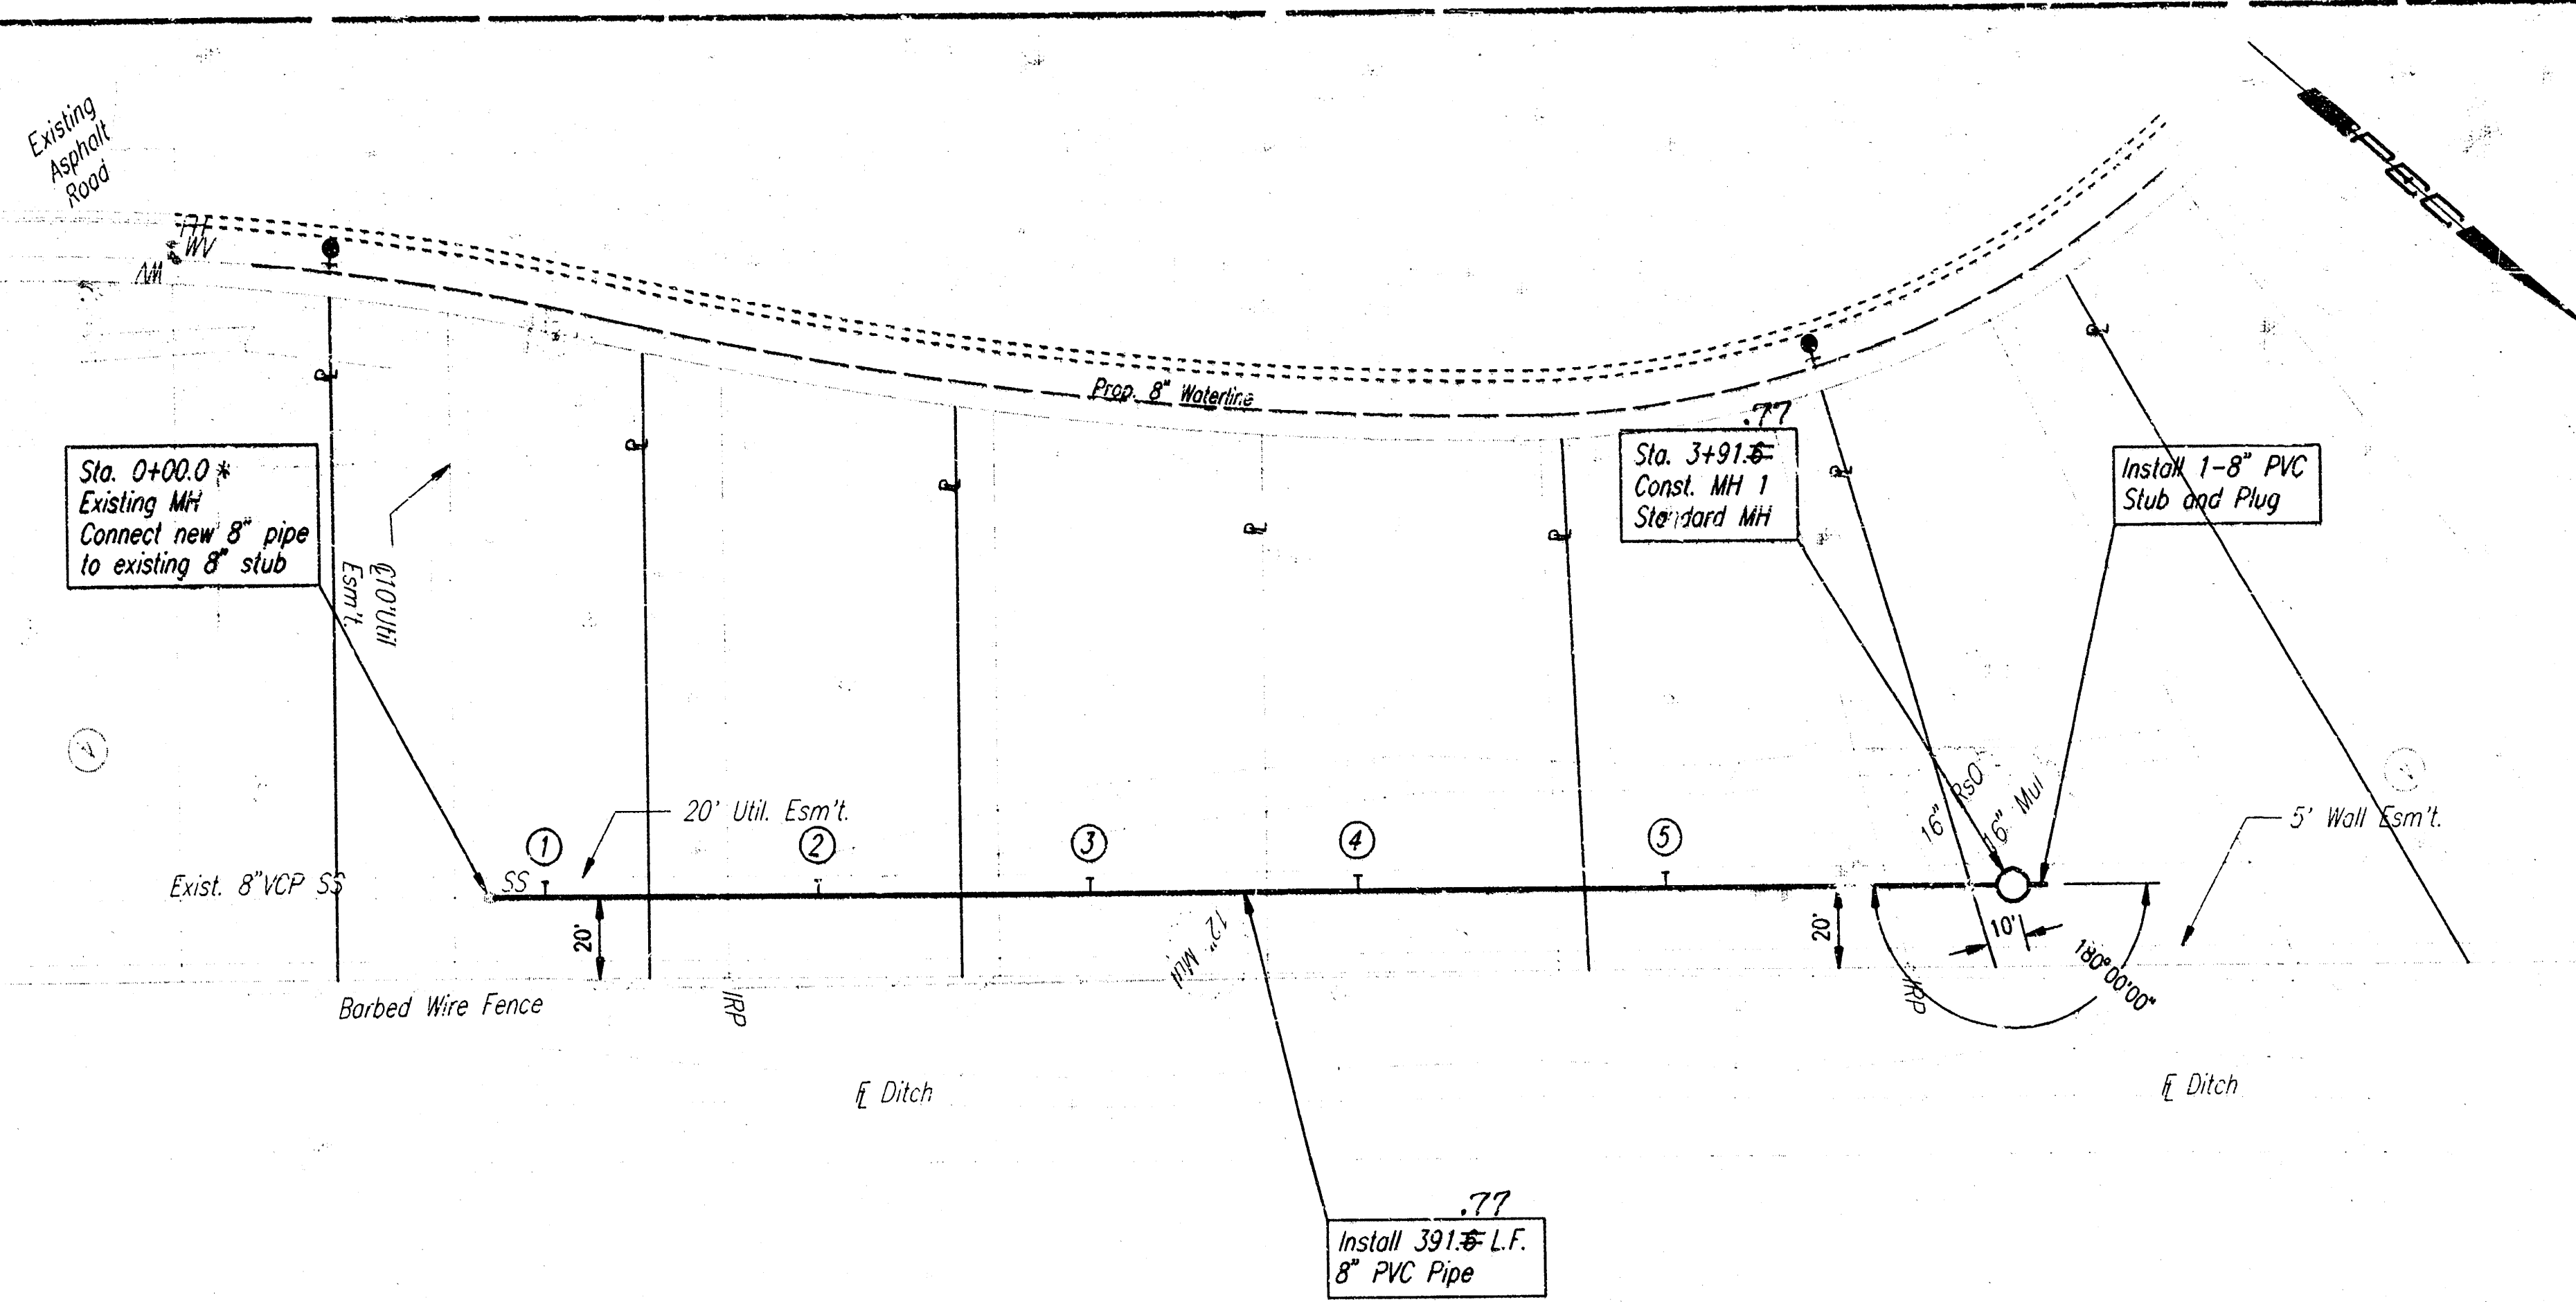

① ②
DENOTES SEWER SERVICE.
SEE SHEET NO. 2 FOR SEWER
SERVICE SCHEDULE AND DETAILS


LINE NO. 1

* PRIOR TO BEGINNING CONSTRUCTION, THE CONTRACTOR SHALL EXCAVATE THE EXISTING 8" STUB AT SANITARY SEWER STATION 0+00.0 LINE NO. 1 AND LINE NO. 2 TO VERIFY ITS HORIZONTAL AND VERTICAL LOCATION. THE PIPE LOCATION SHALL BE REPORTED TO THE ENGINEER SO THAT ANY NECESSARY PLAN MODIFICATIONS CAN BE MADE. ANY ADDITIONAL LABOR OR MATERIALS NECESSARY TO COMPLETE THE CONNECTION SHALL BE CONSIDERED SUBSIDIARY TO THE PROJECT.

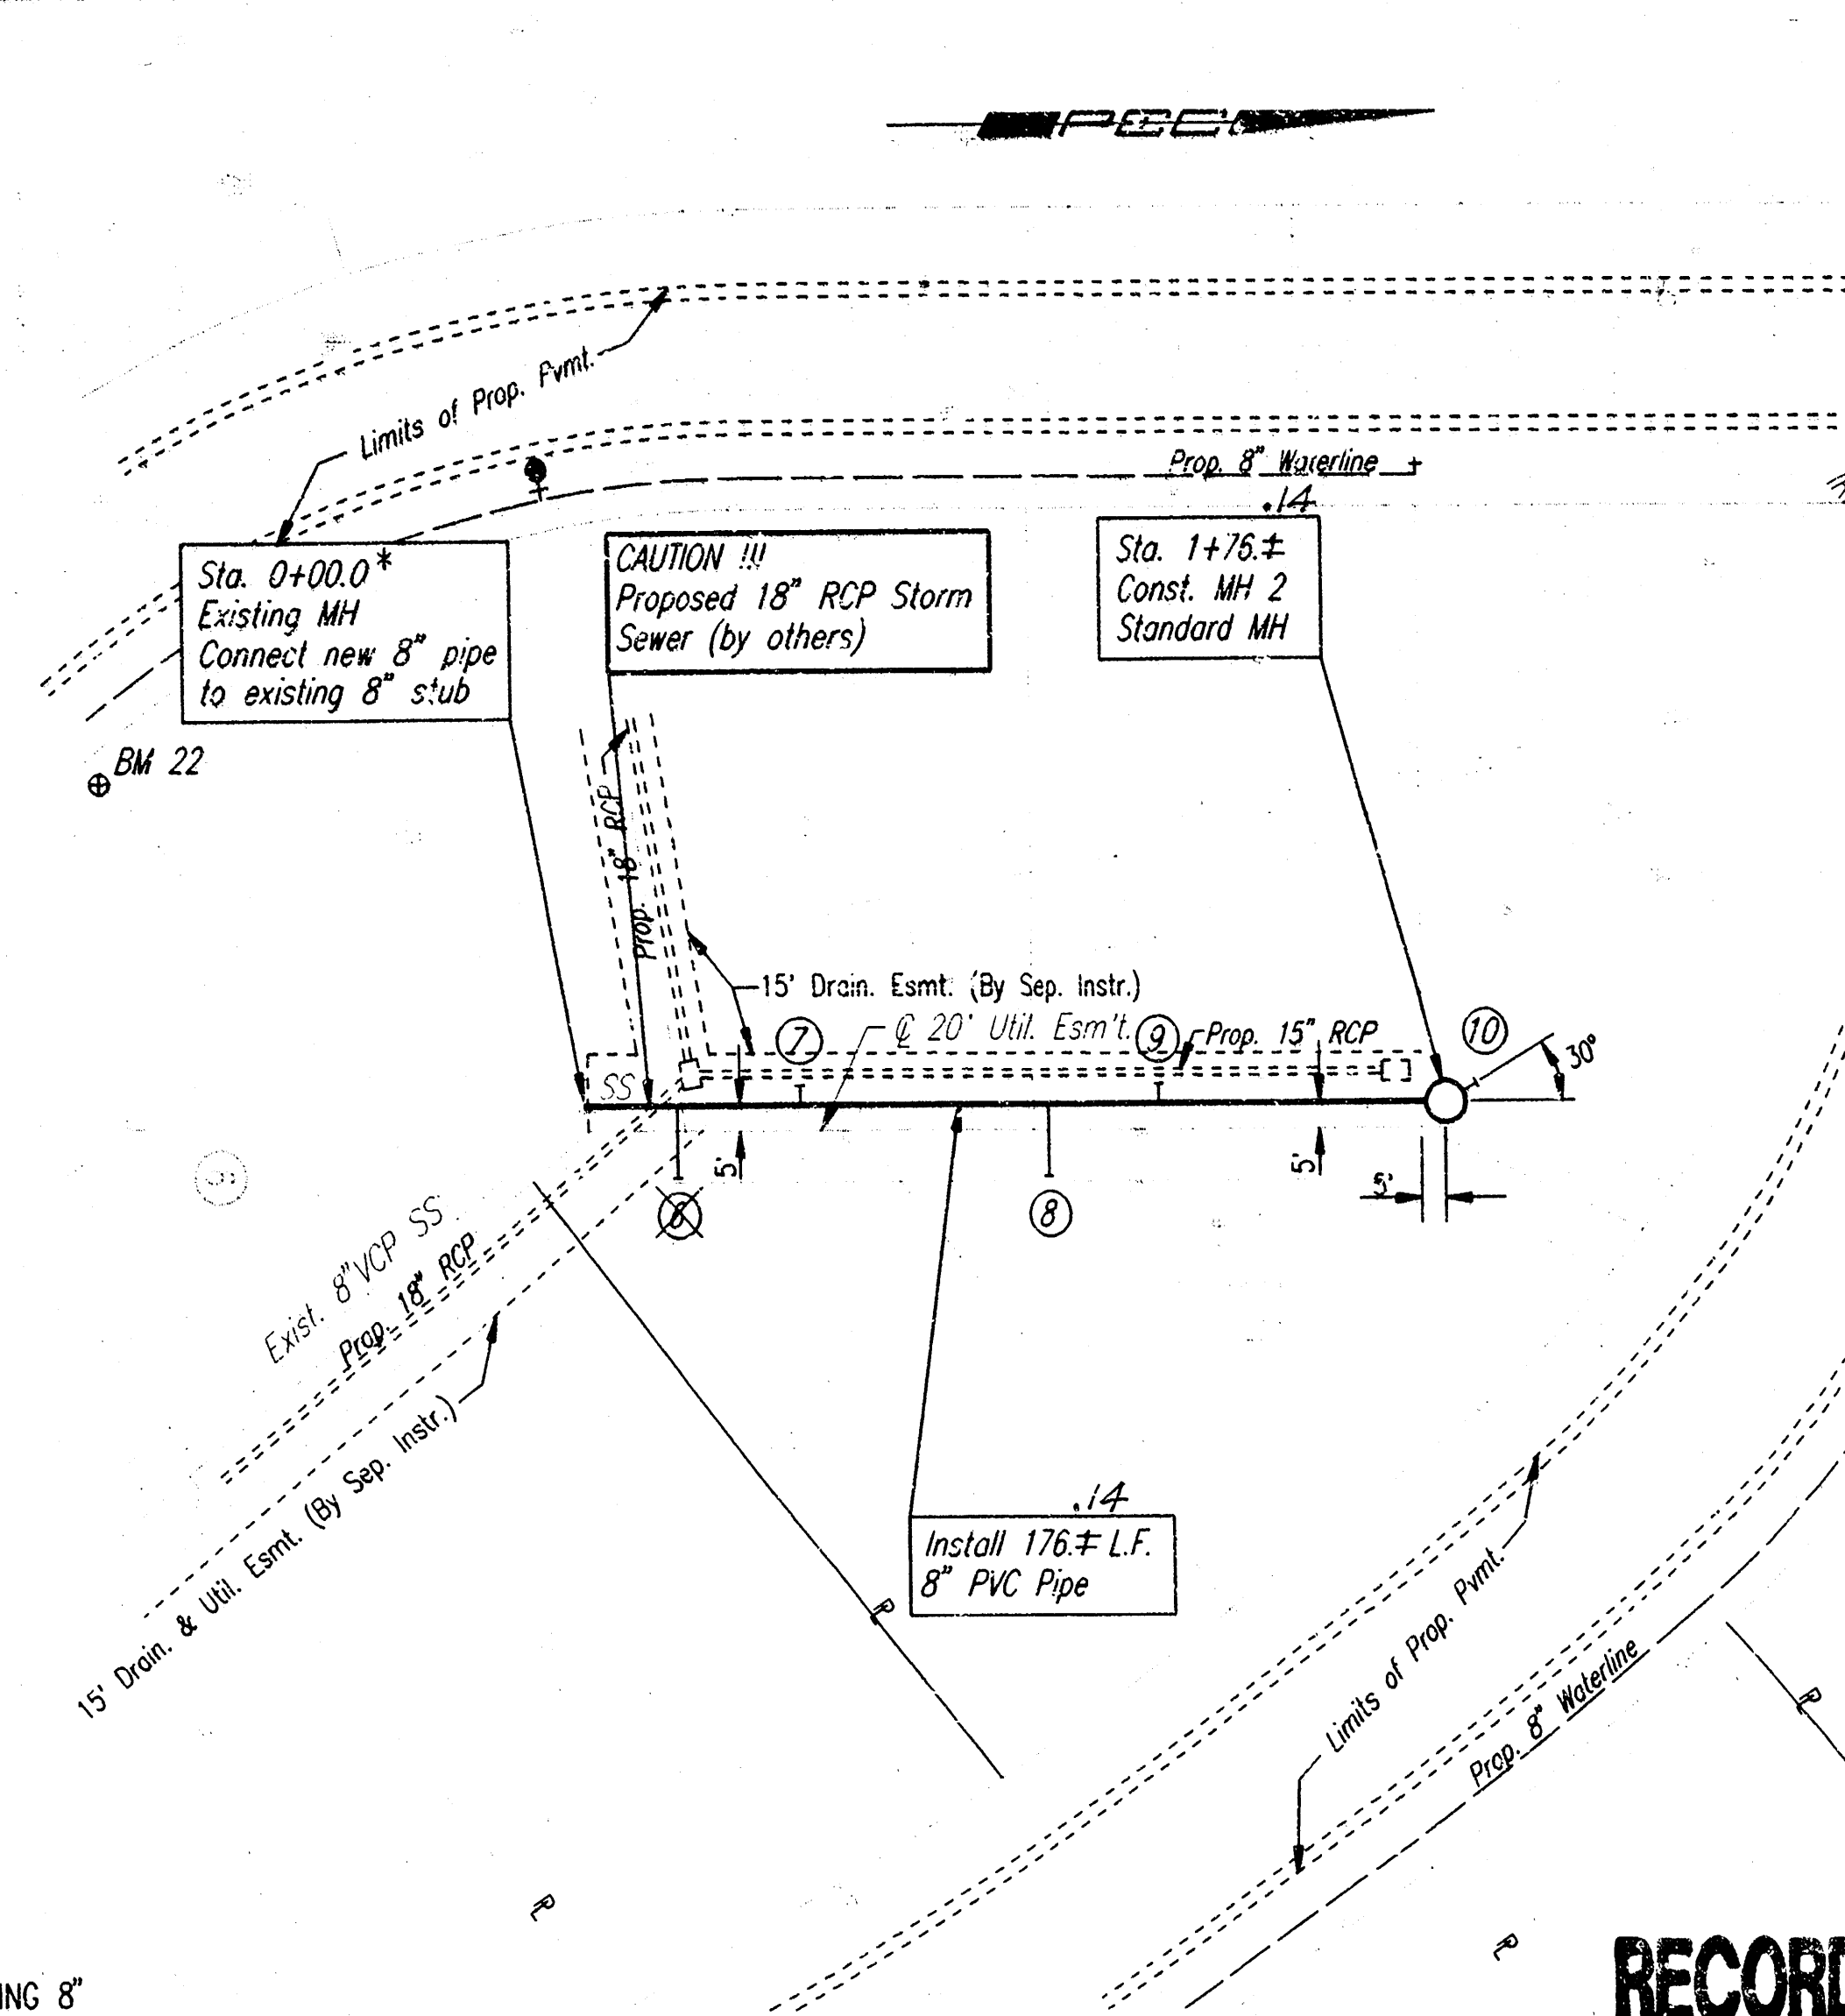

LINE NO. 2

RECORD DRAWING
David J. Eide

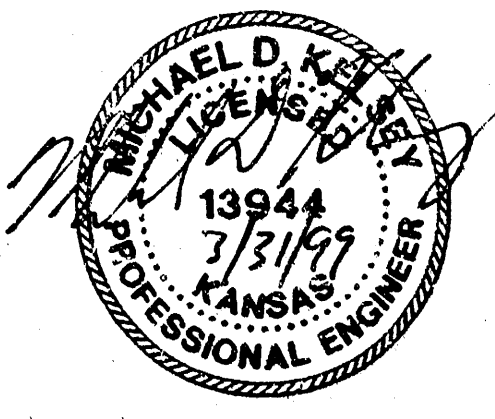


LATERAL TO MAIN 17
SOUTHWEST INTERCEPTOR SEWER
LINE NO. 1 AND 2

MICHAEL E. UNDERBANK, P.E. - CITY ENGINEER
CITY OF WICHITA PROJECT NO. 445-15-45-82303-000-001

Professional Engineering Consultants, P.A.
303 S. TOPICKA • WICHITA, KANSAS 67202
316-262-2691 • FAX 316-262-3003

Designed By: MEX
Drawn By: DMM
Job No.: 34-07852-2
Date: August 1997


Sheet 5 of 5

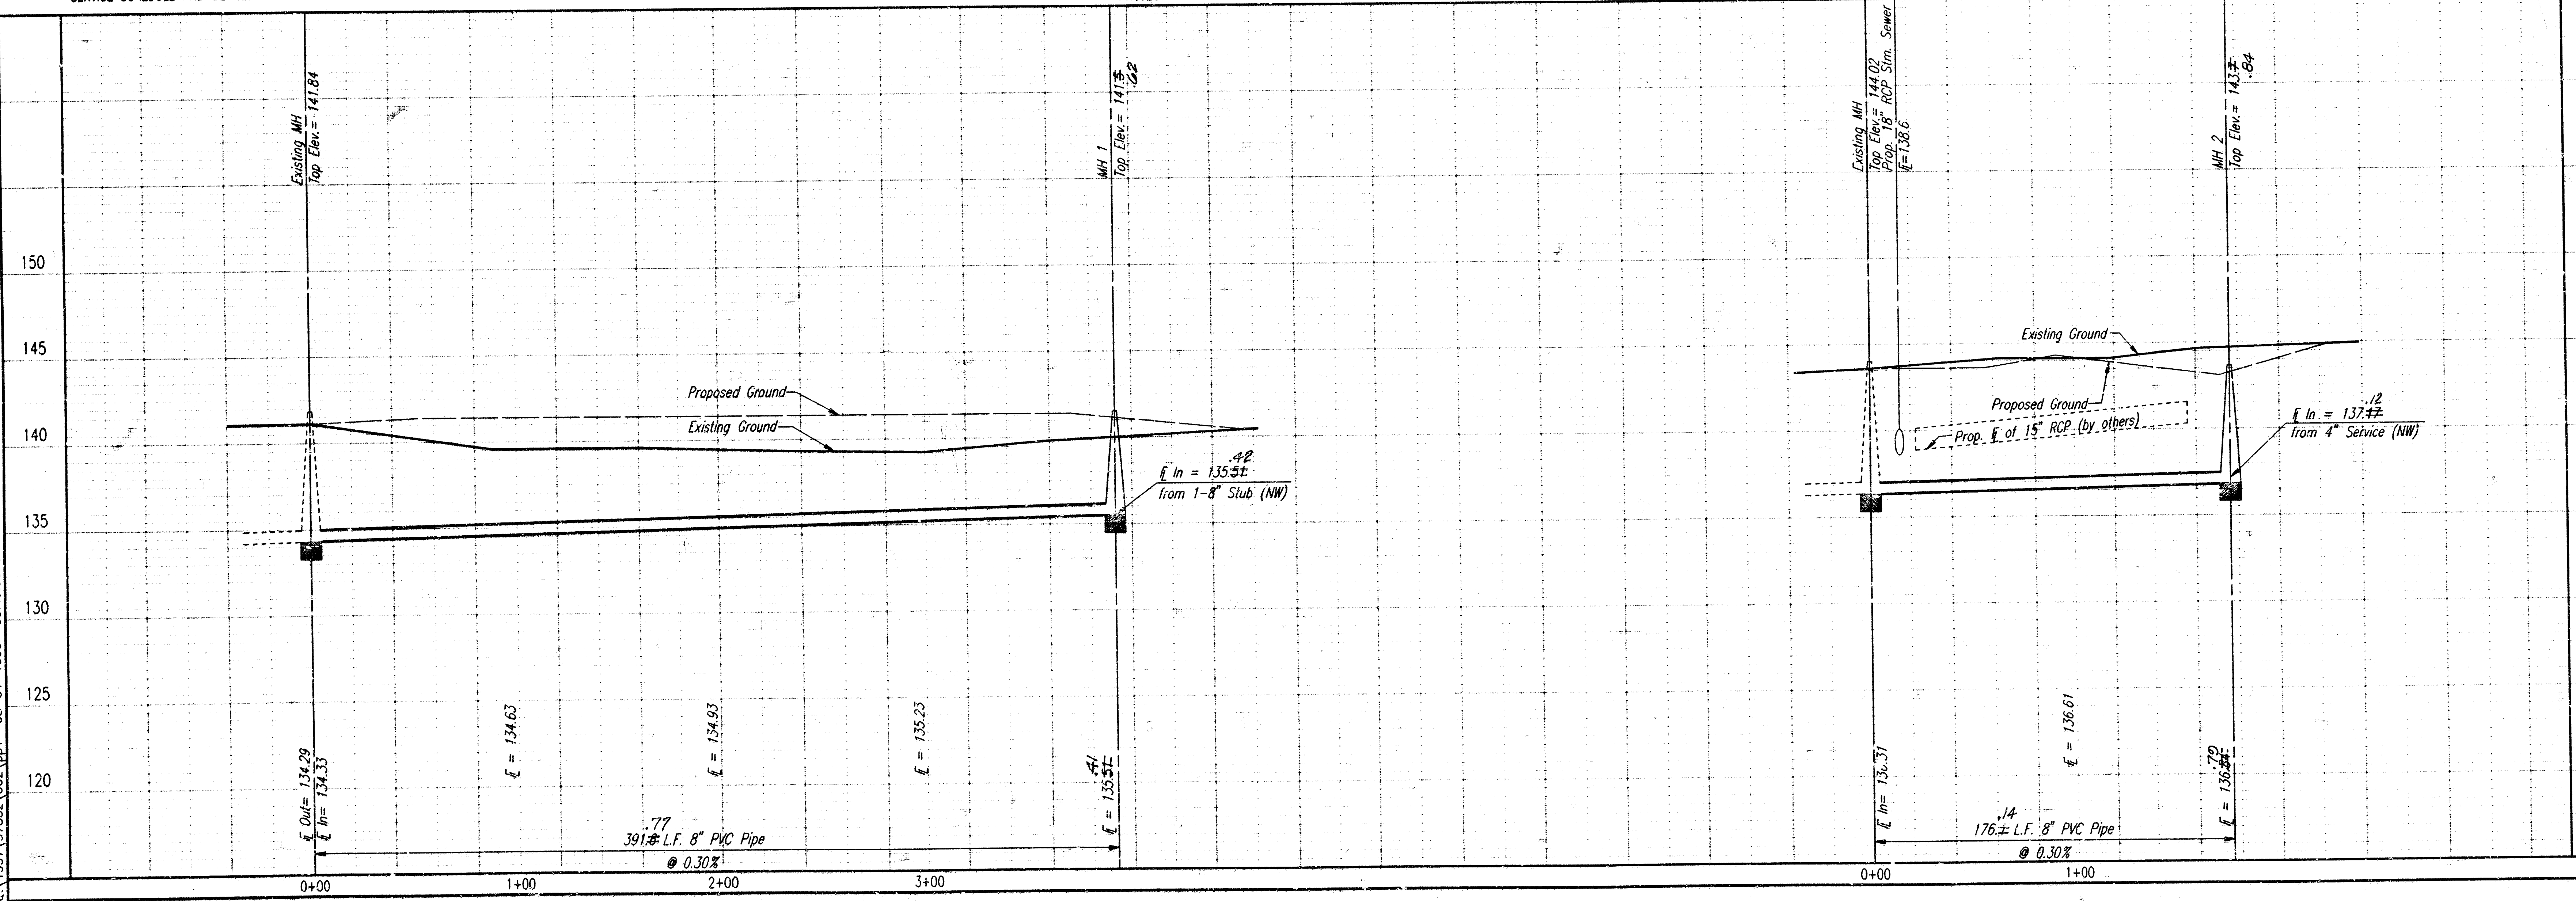

PLAN	CHECKED	DATE

PROFILE	CHECKED	DATE

DSNR REF. OPER. JLM SCALE: 1"=40.00'
Q:\1997\17852\02\1997 03-31-1999 08:40:47 am

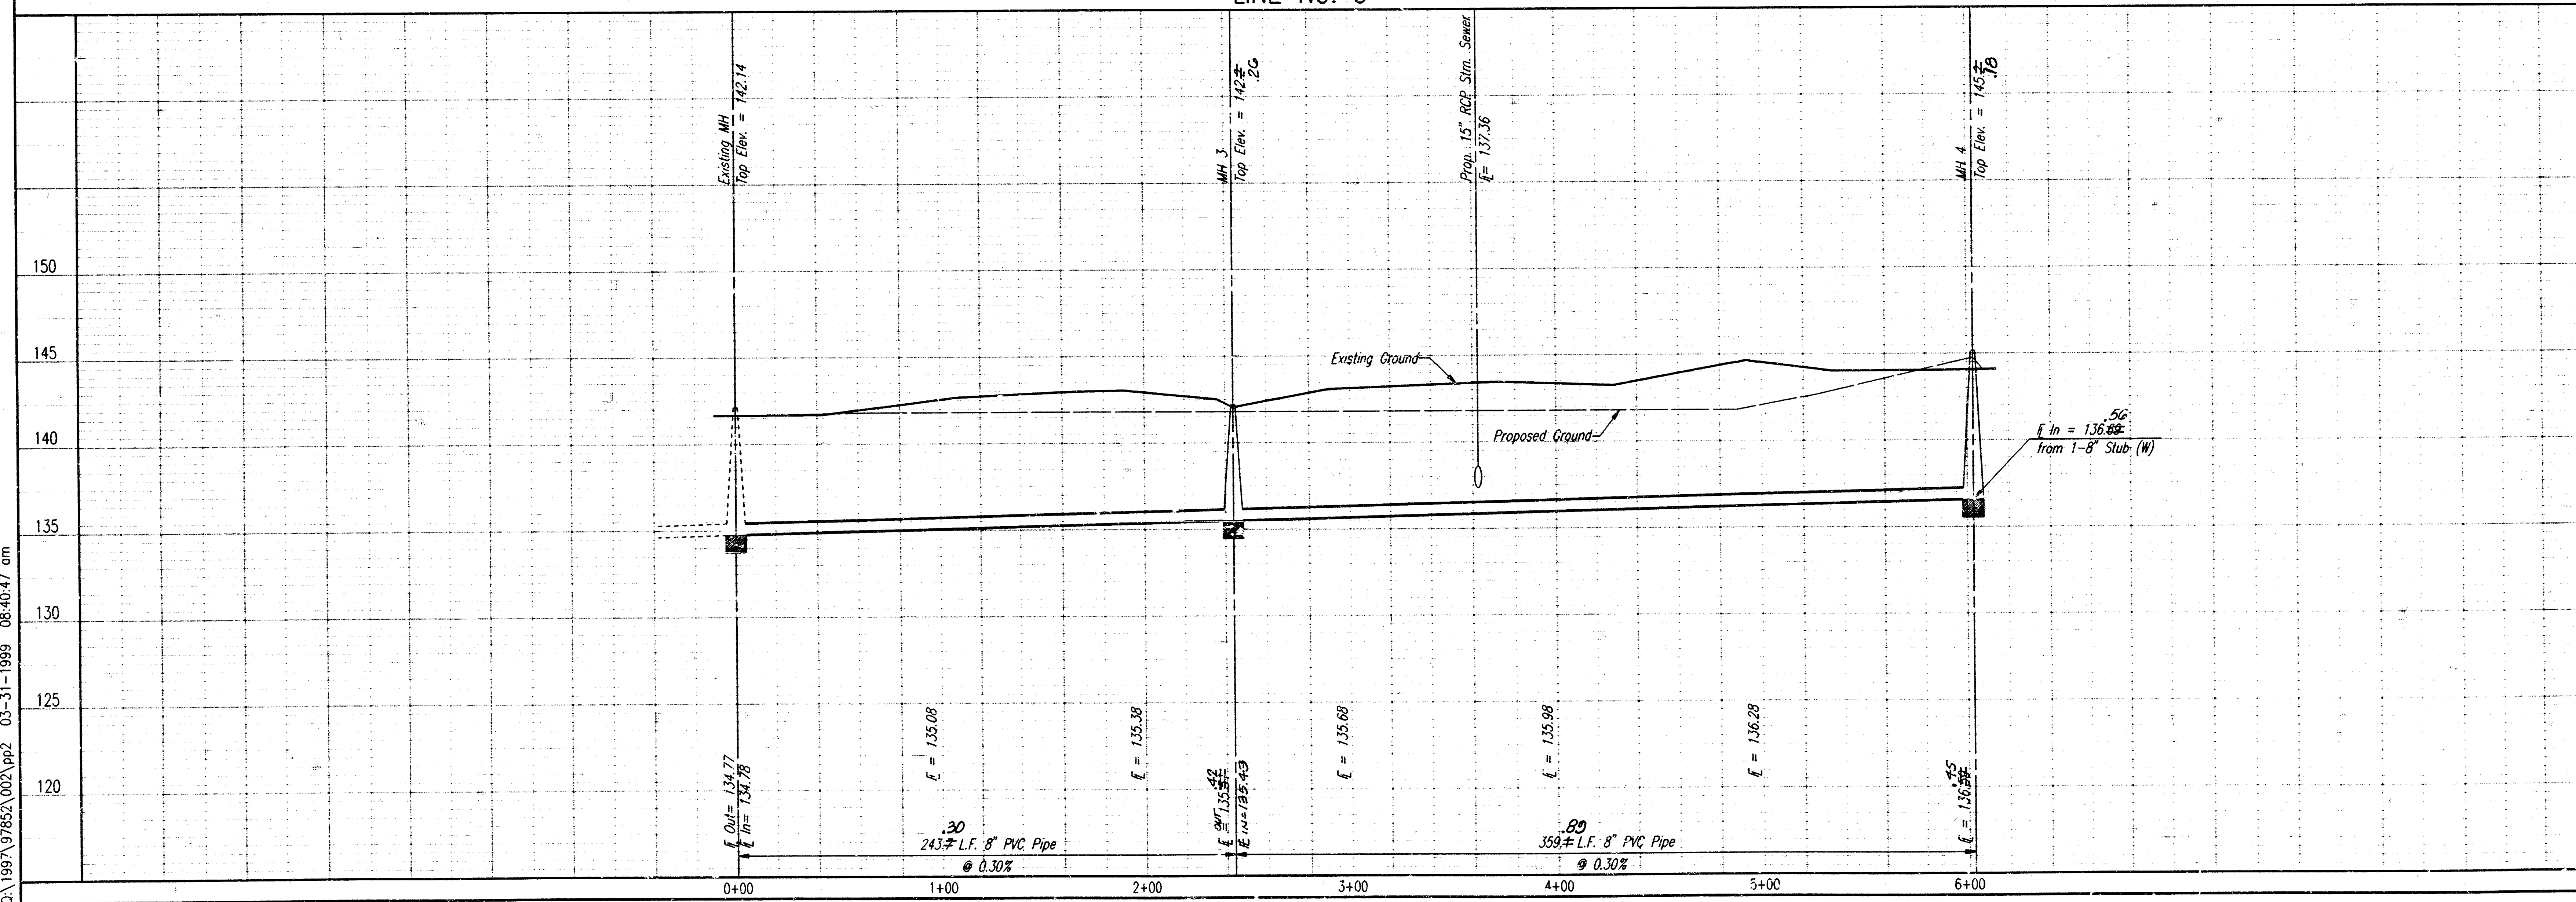

① ②
DENOTES SEWER SERVICE
SEE SHEET NO. 2 FOR SEWER
SERVICE SCHEDULE AND DETAILS

Sta. 0+00.0 *
Existing MH
Connect new 8" pipe
to existing 8" stub

Sta. 2+43.7
Const. MH 3
Standard MH With
Self-Sealing Lid


Install 243' L.F.
8" PVC Pipe

CAUTION !!!
Proposed 15' RCP Storm
Sewer (by others)

Install 359' L.F.
8" PVC Pipe


Sta. 6+03.19
Const. MH 4
Standard MH

Install 1-8" PVC
Stub and Plug

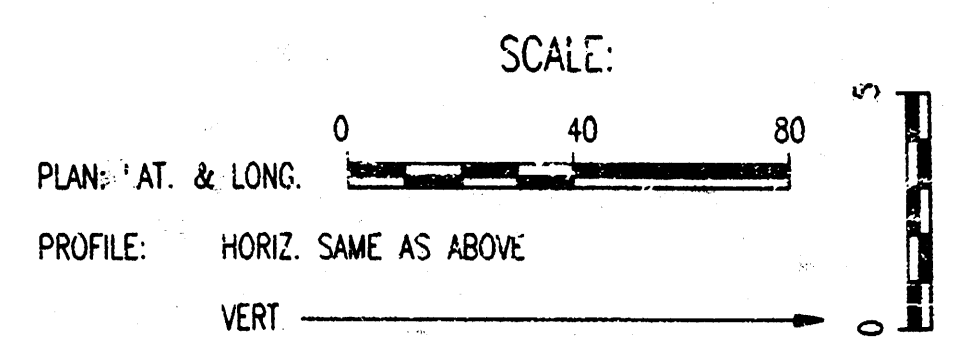

* PRIOR TO BEGINNING CONSTRUCTION, THE CONTRACTOR SHALL EXCAVATE THE EXISTING 8" STUB AT SANITARY SEWER STATION 0+00.00 TO VERIFY ITS HORIZONTAL AND VERTICAL LOCATION. THE PIPE LOCATION SHALL BE REPORTED TO THE ENGINEER SO THAT ANY NECESSARY PLAN MODIFICATIONS CAN BE MADE. ANY ADDITIONAL LABOR OR MATERIALS NECESSARY TO COMPLETE THE CONNECTION SHALL BE CONSIDERED SUBSIDIARY TO THE PROJECT.

RECORD DRAWING

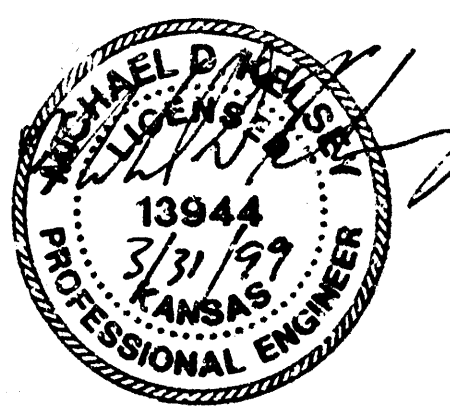


LATERAL 10, MAIN 17
SOUTHWEST INTERCEPTOR SEWER
LINE NO. 3

Professional Engineering Consultants, P.A.
303 S. TOPEKA AVE., TOPEKA, KANSAS 67202
316-262-2691 • FAX 316-262-3003


Designed By: MJK
Drawn By: DUK
Job No.: 34-97852-2
Date: August 1997

MICHAEL E. UNICEBAK, P.E. - CITY ENGINEER
CITY OF WICHITA PROJECT NO. 465-76-245-8708-002-000-001


SEWER APPURTENANCES DETAILS

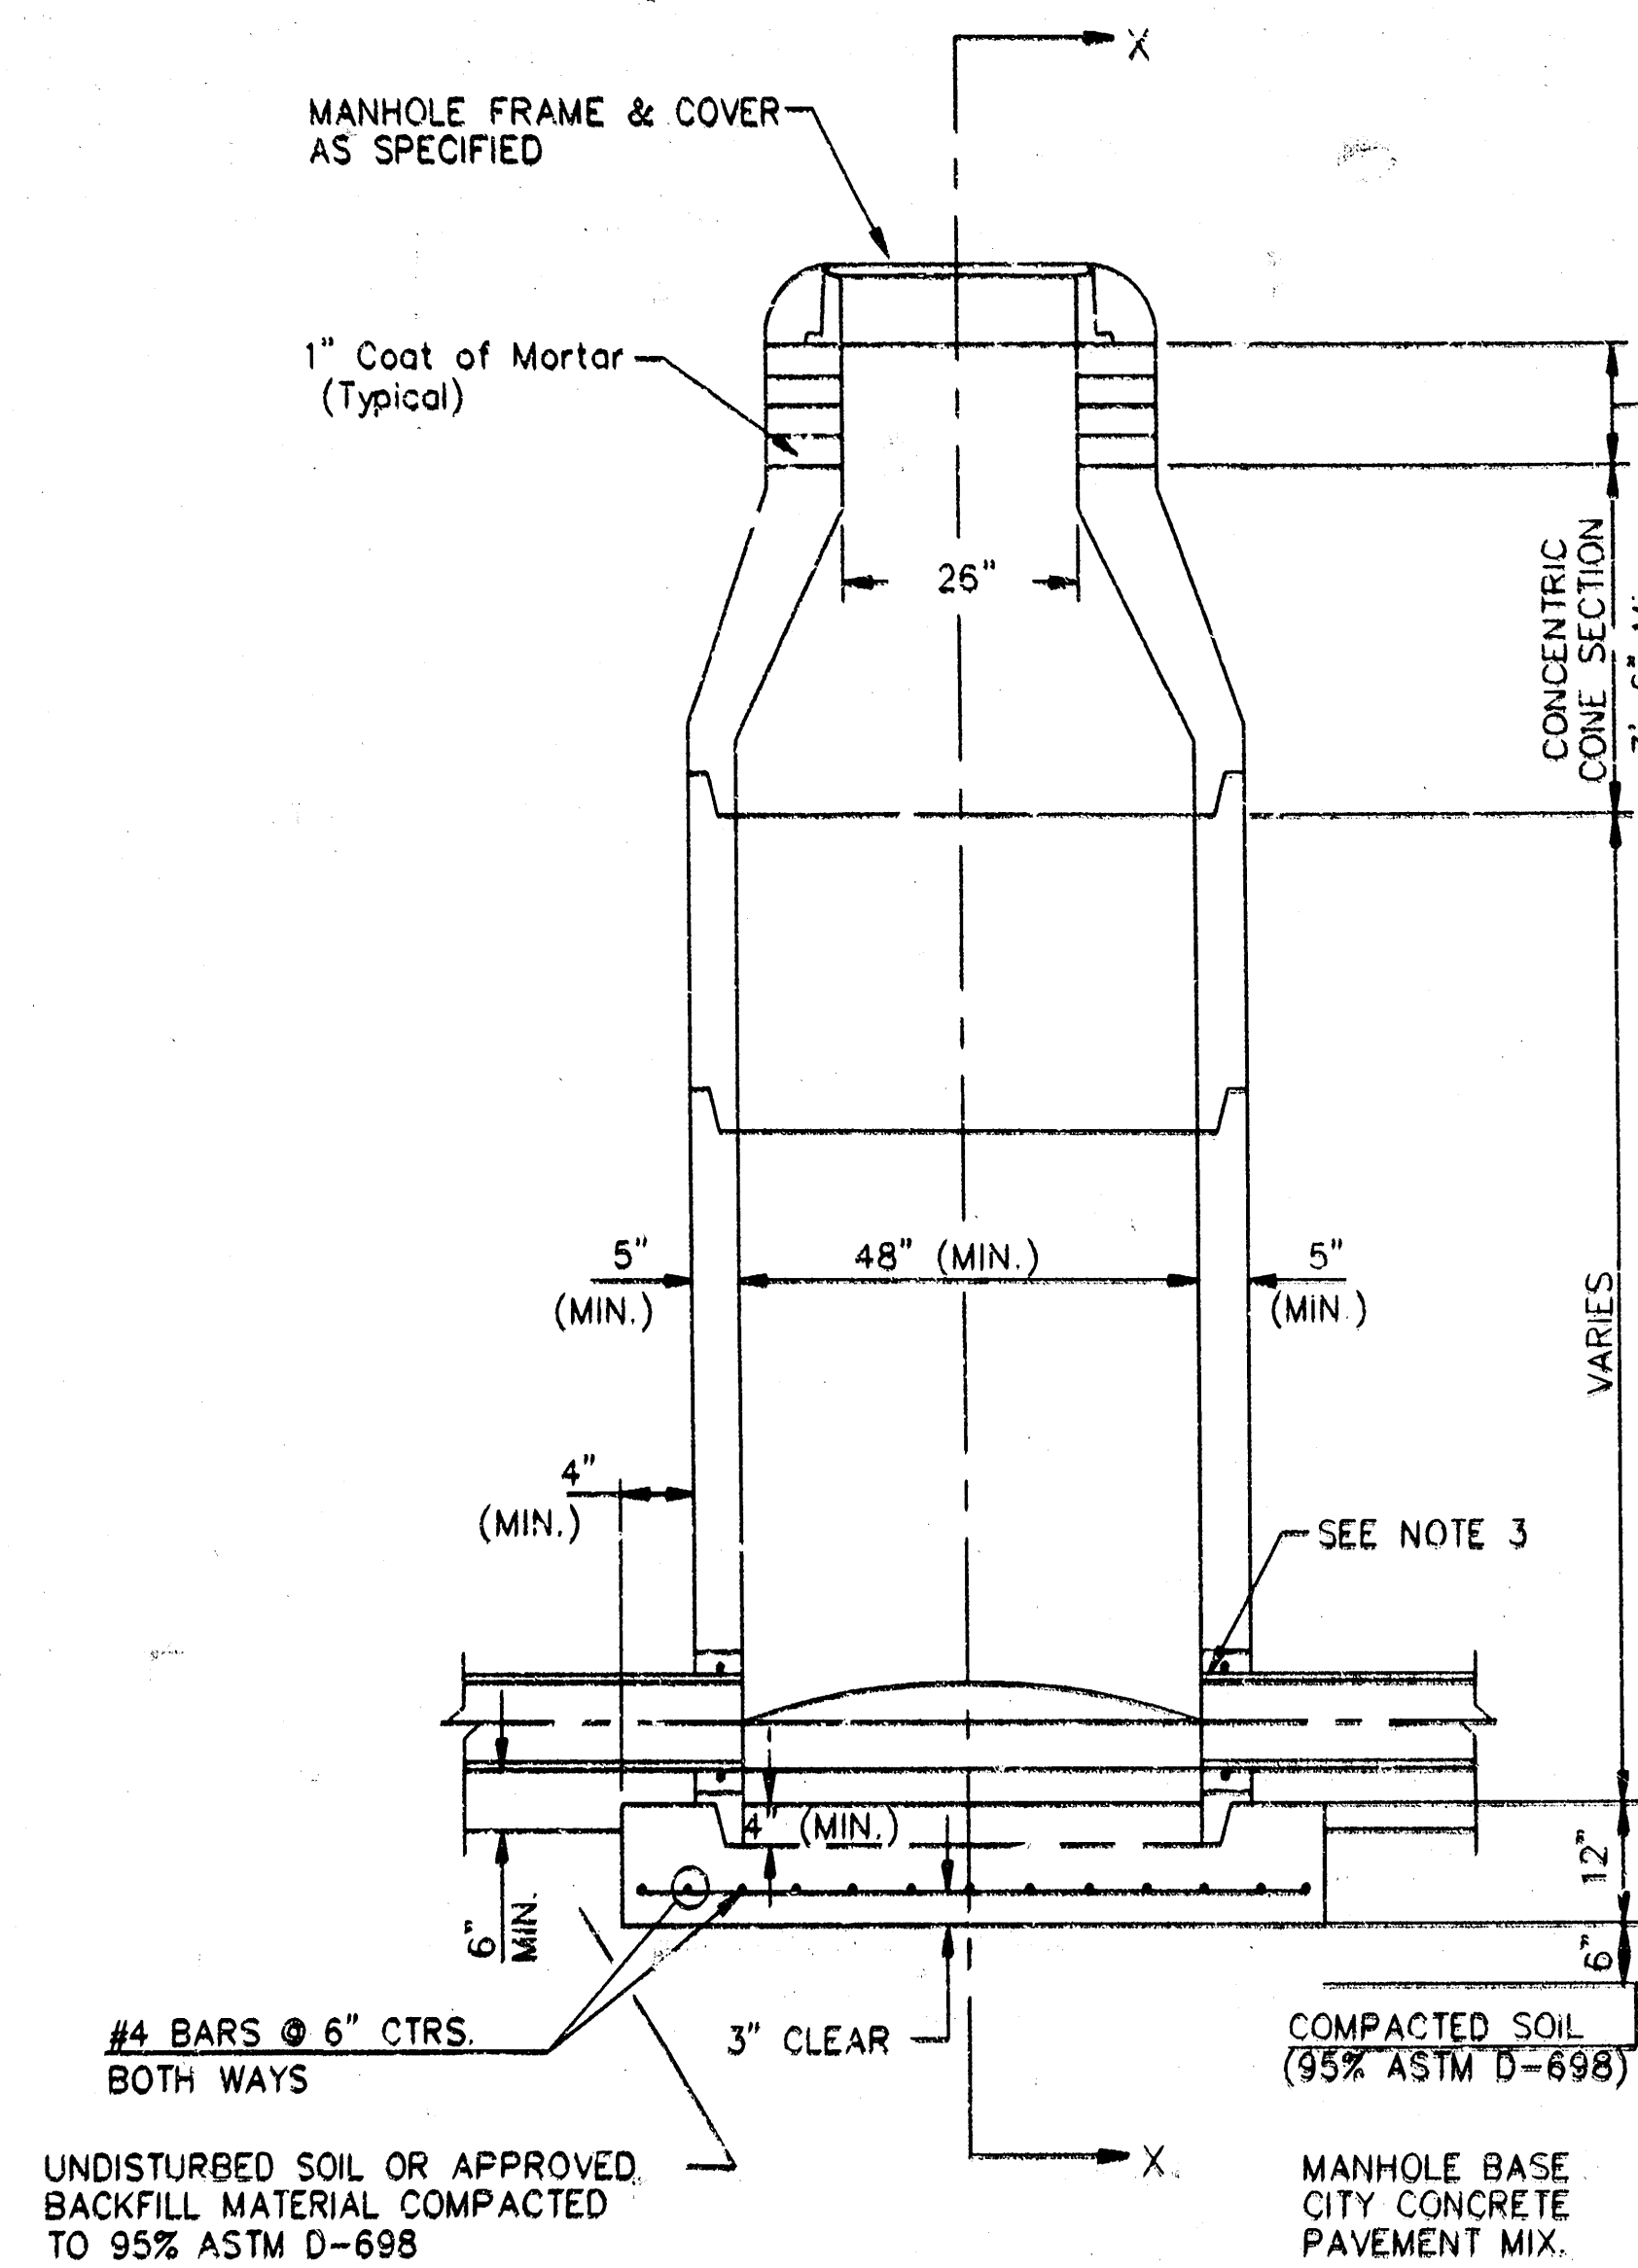


TYPE P
STANDARD MANHOLE

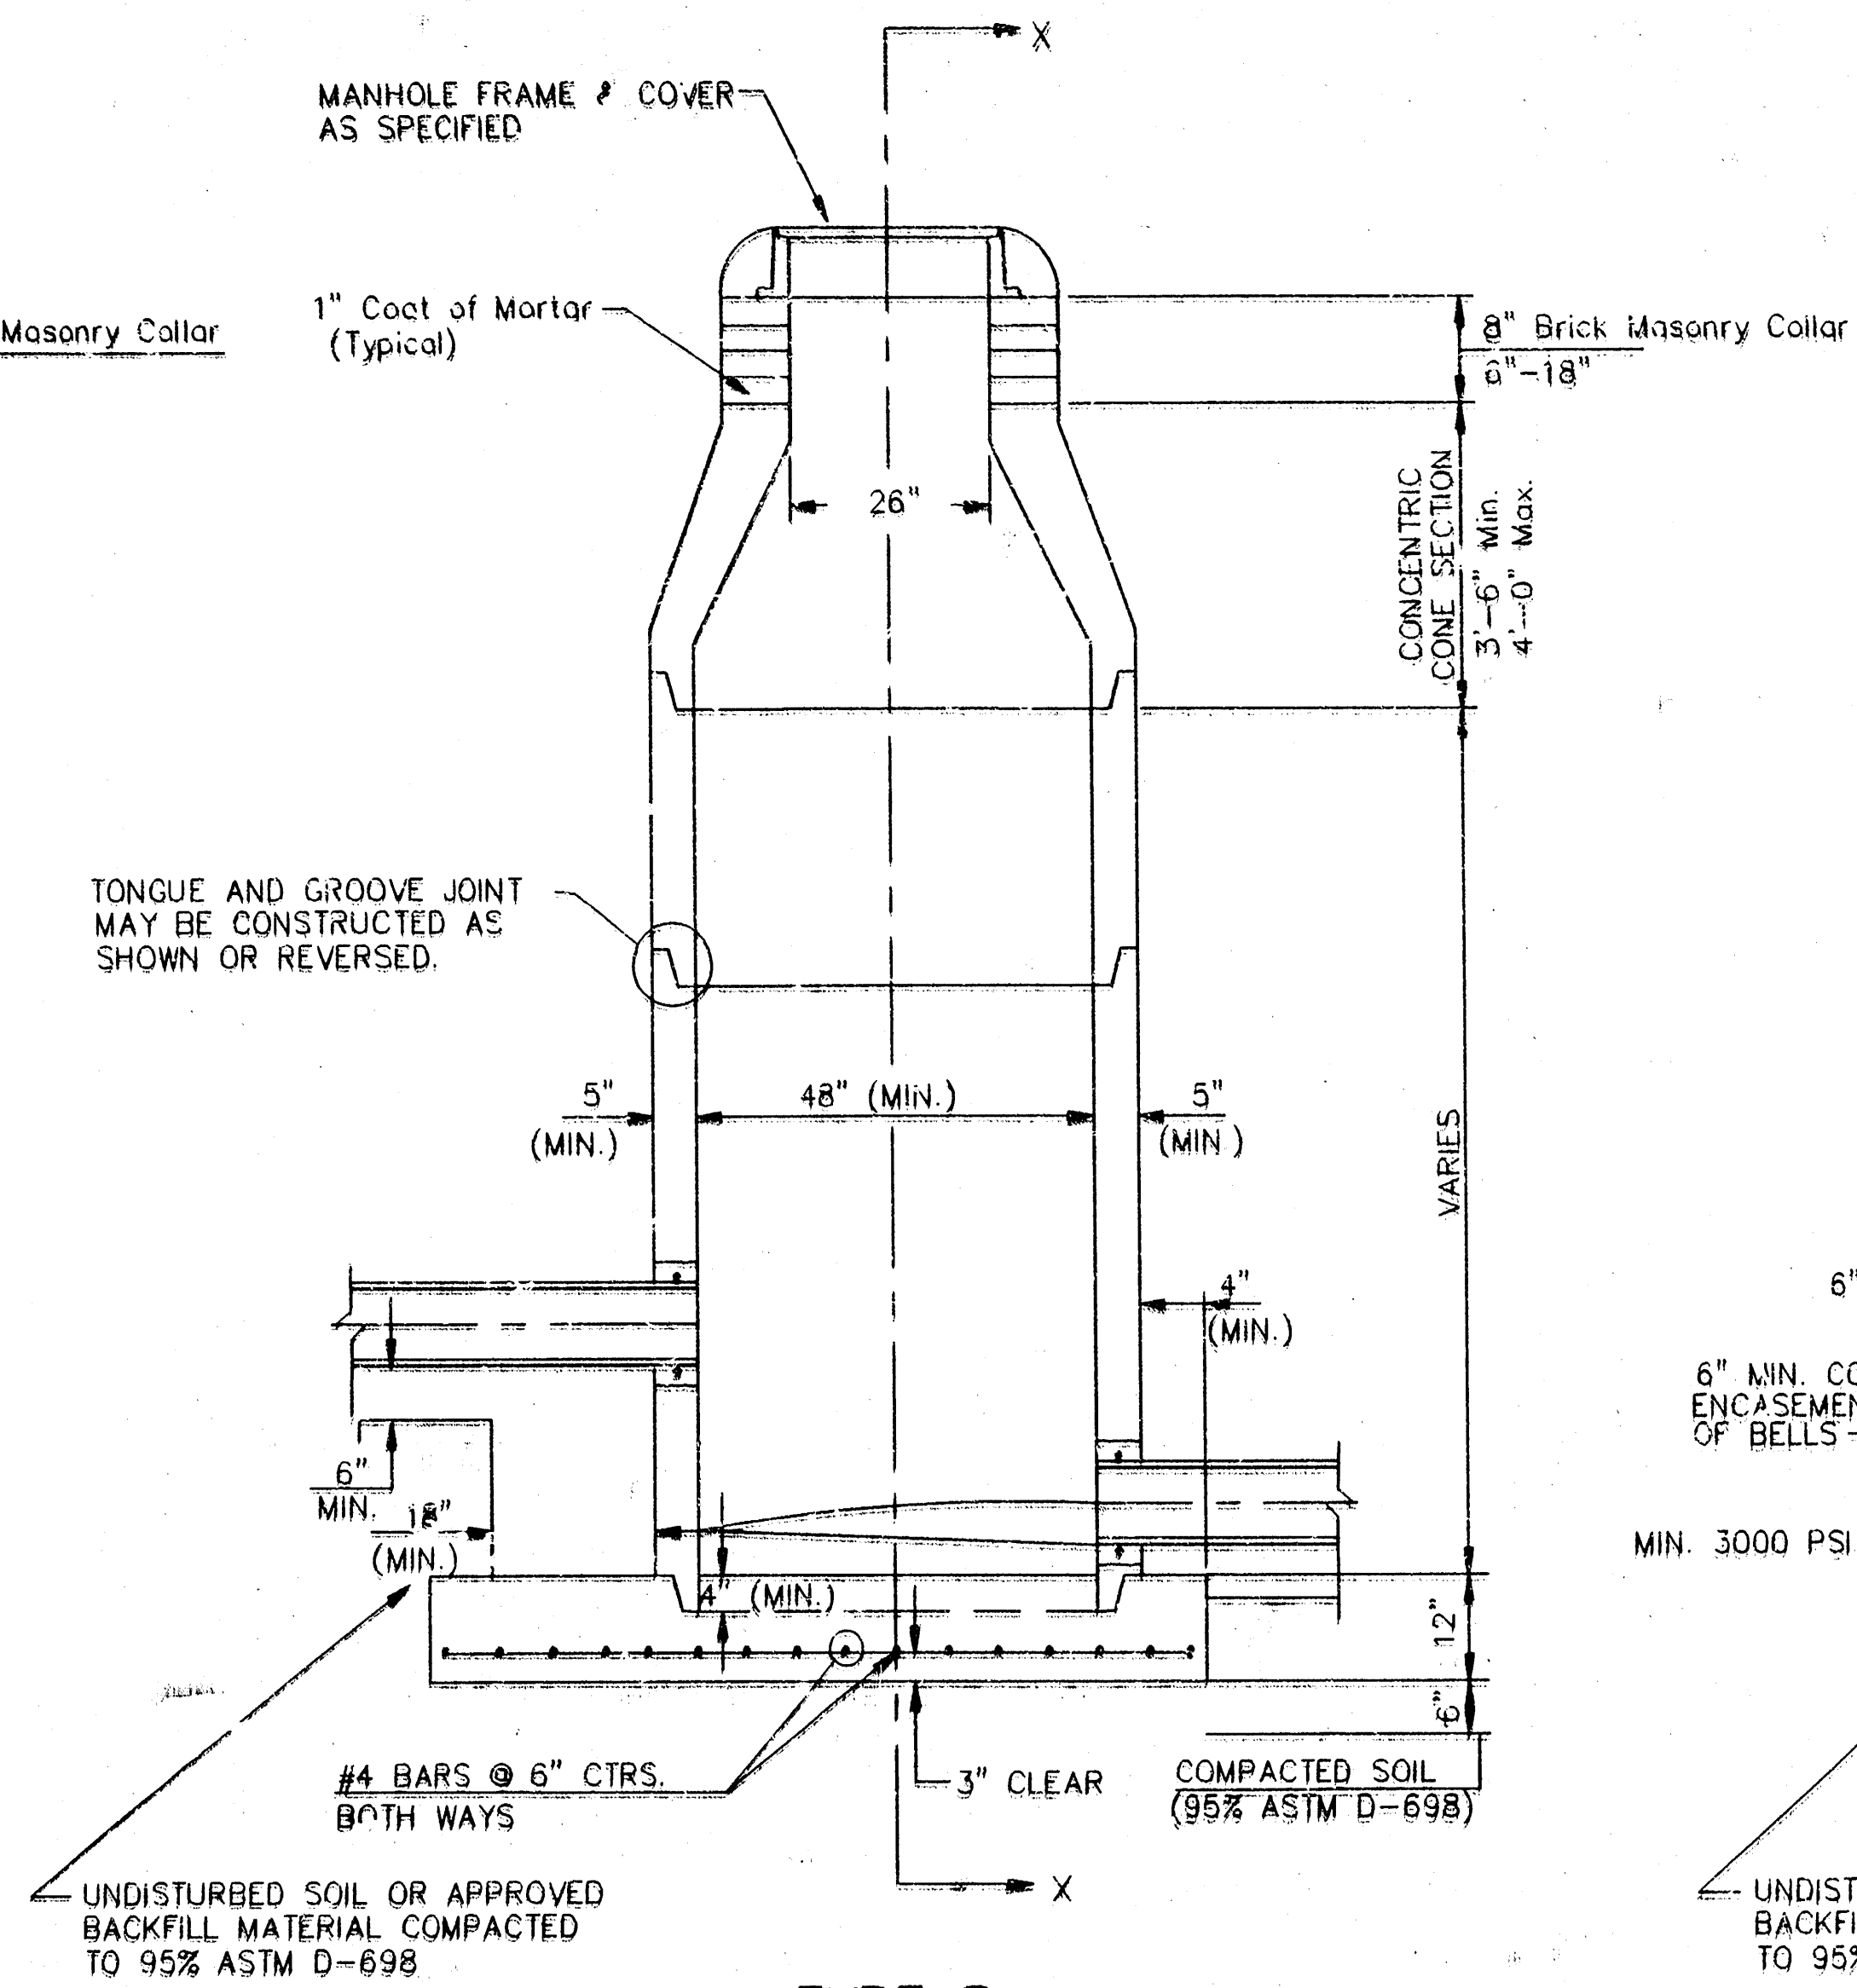

TYPE P
INSIDE DROP MANHOLE

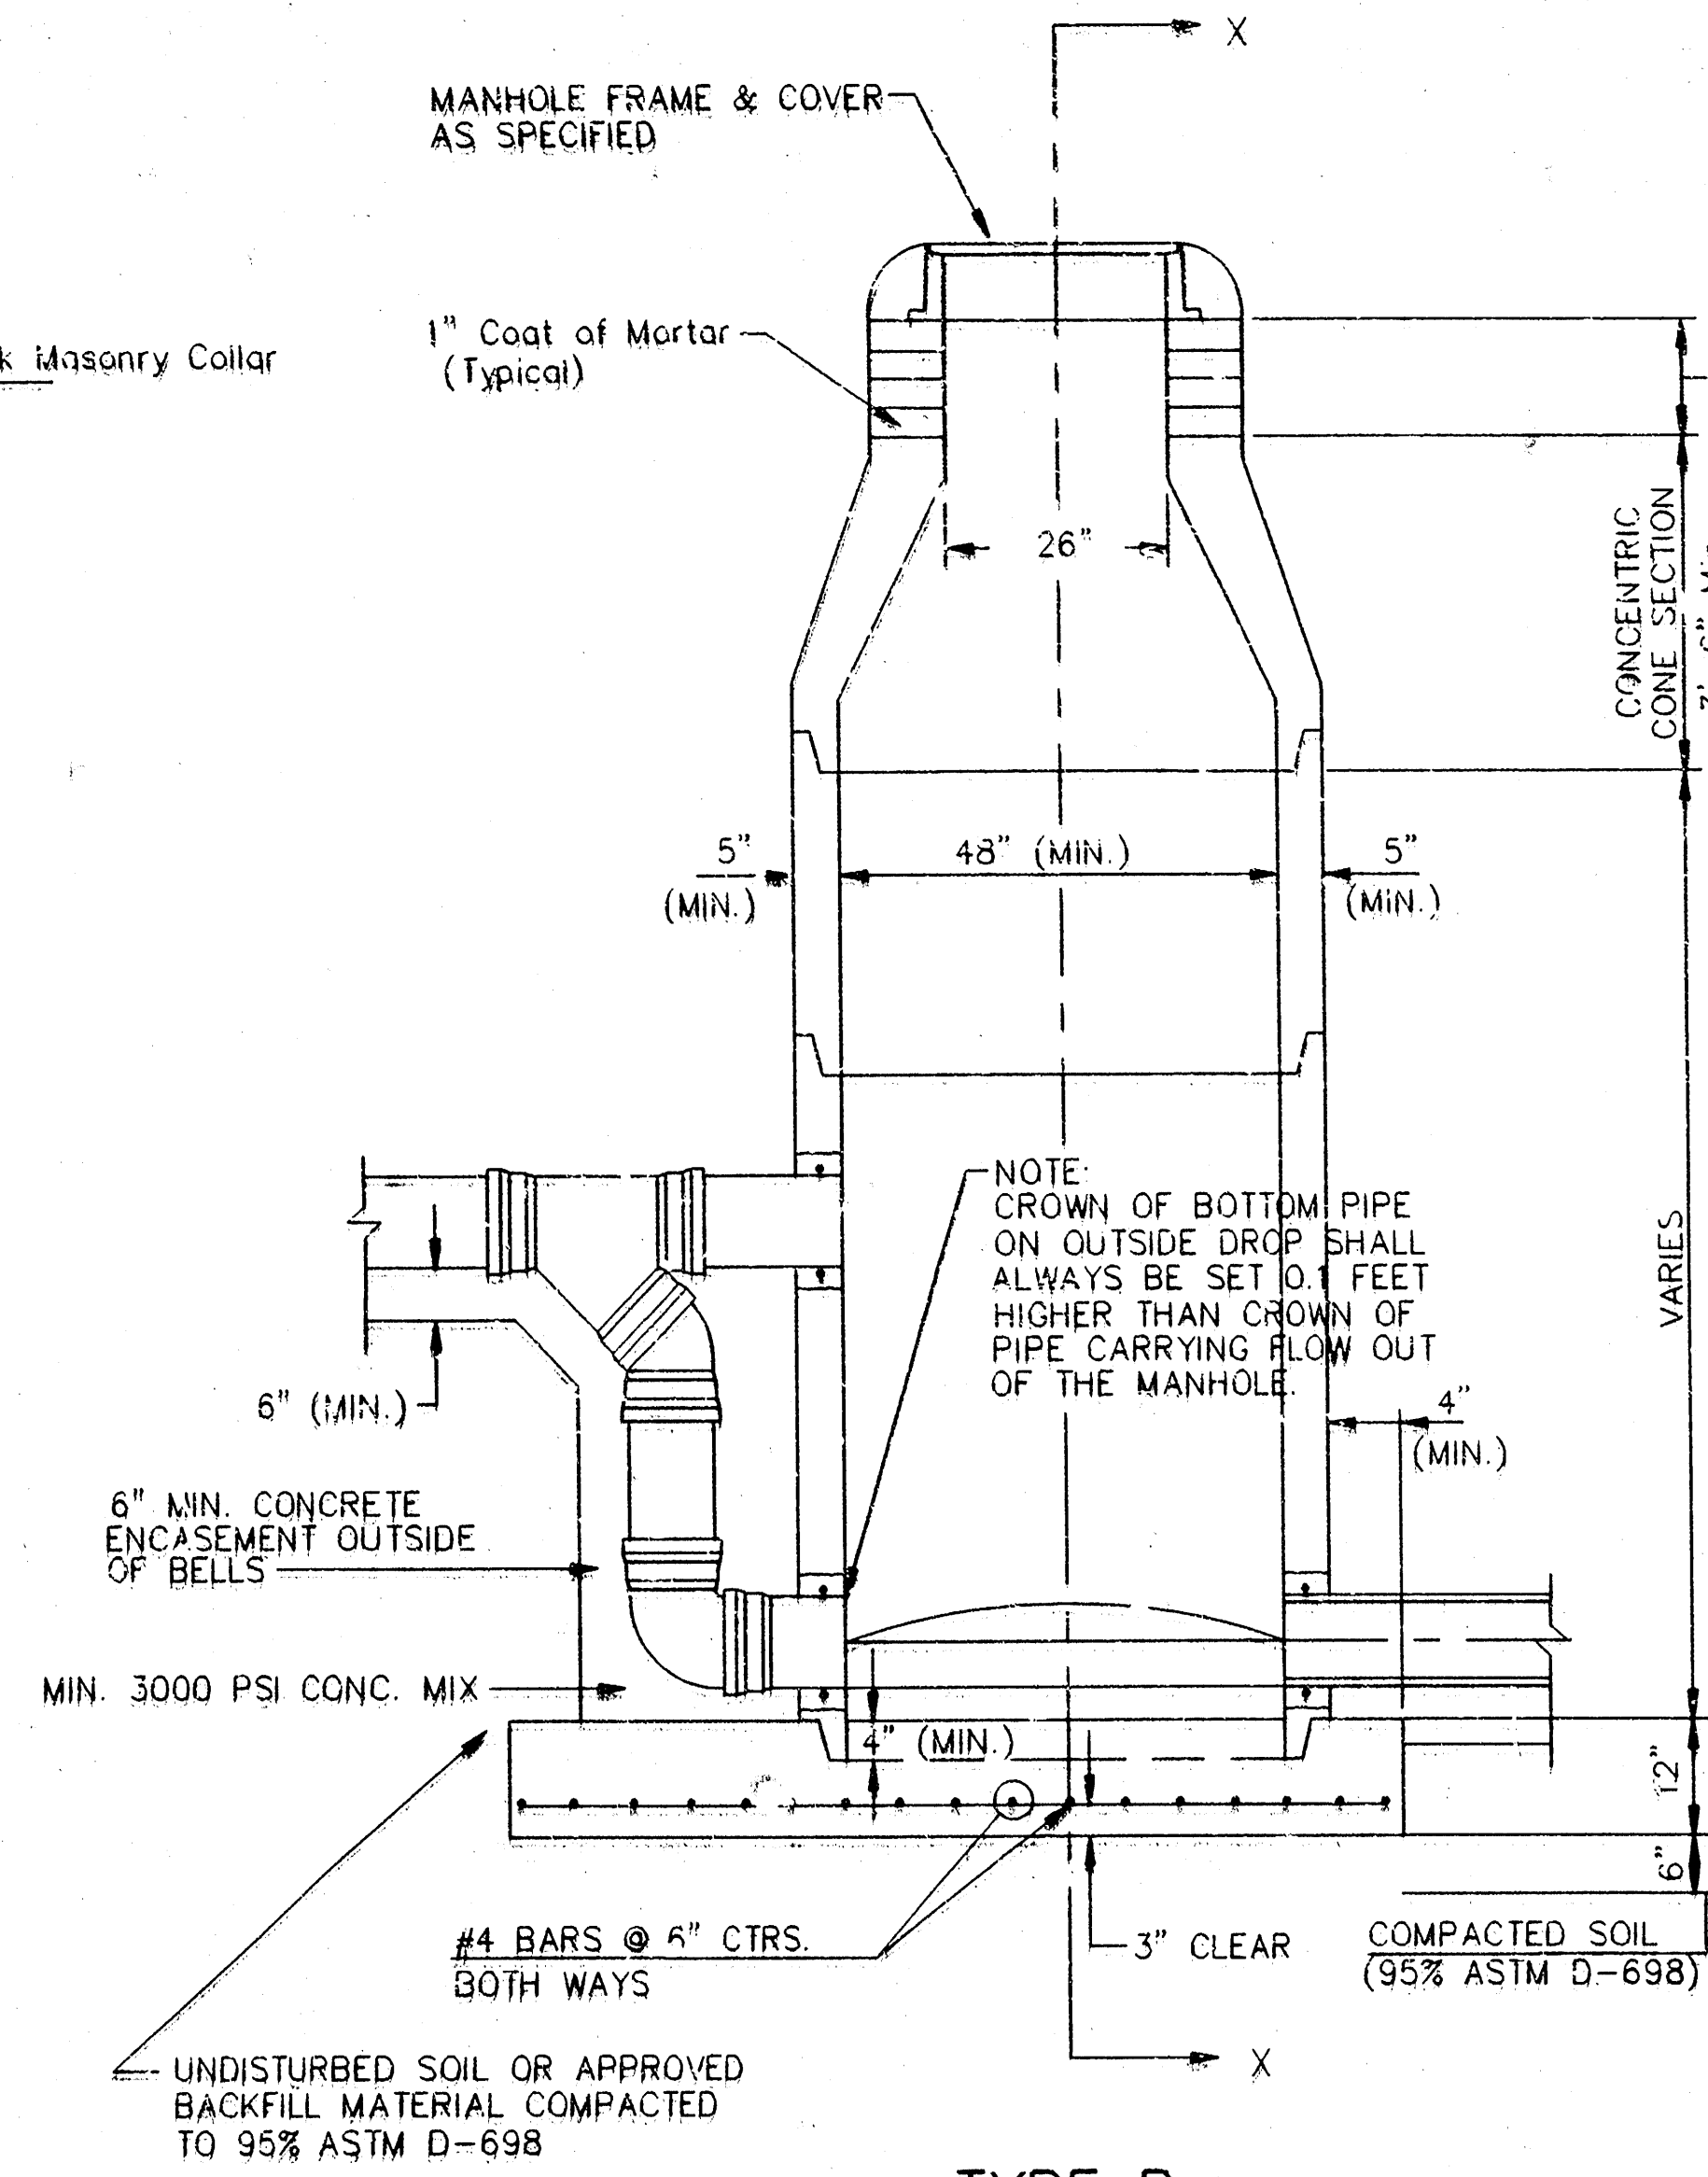

TYPE P
OUTSIDE DROP MANHOLE

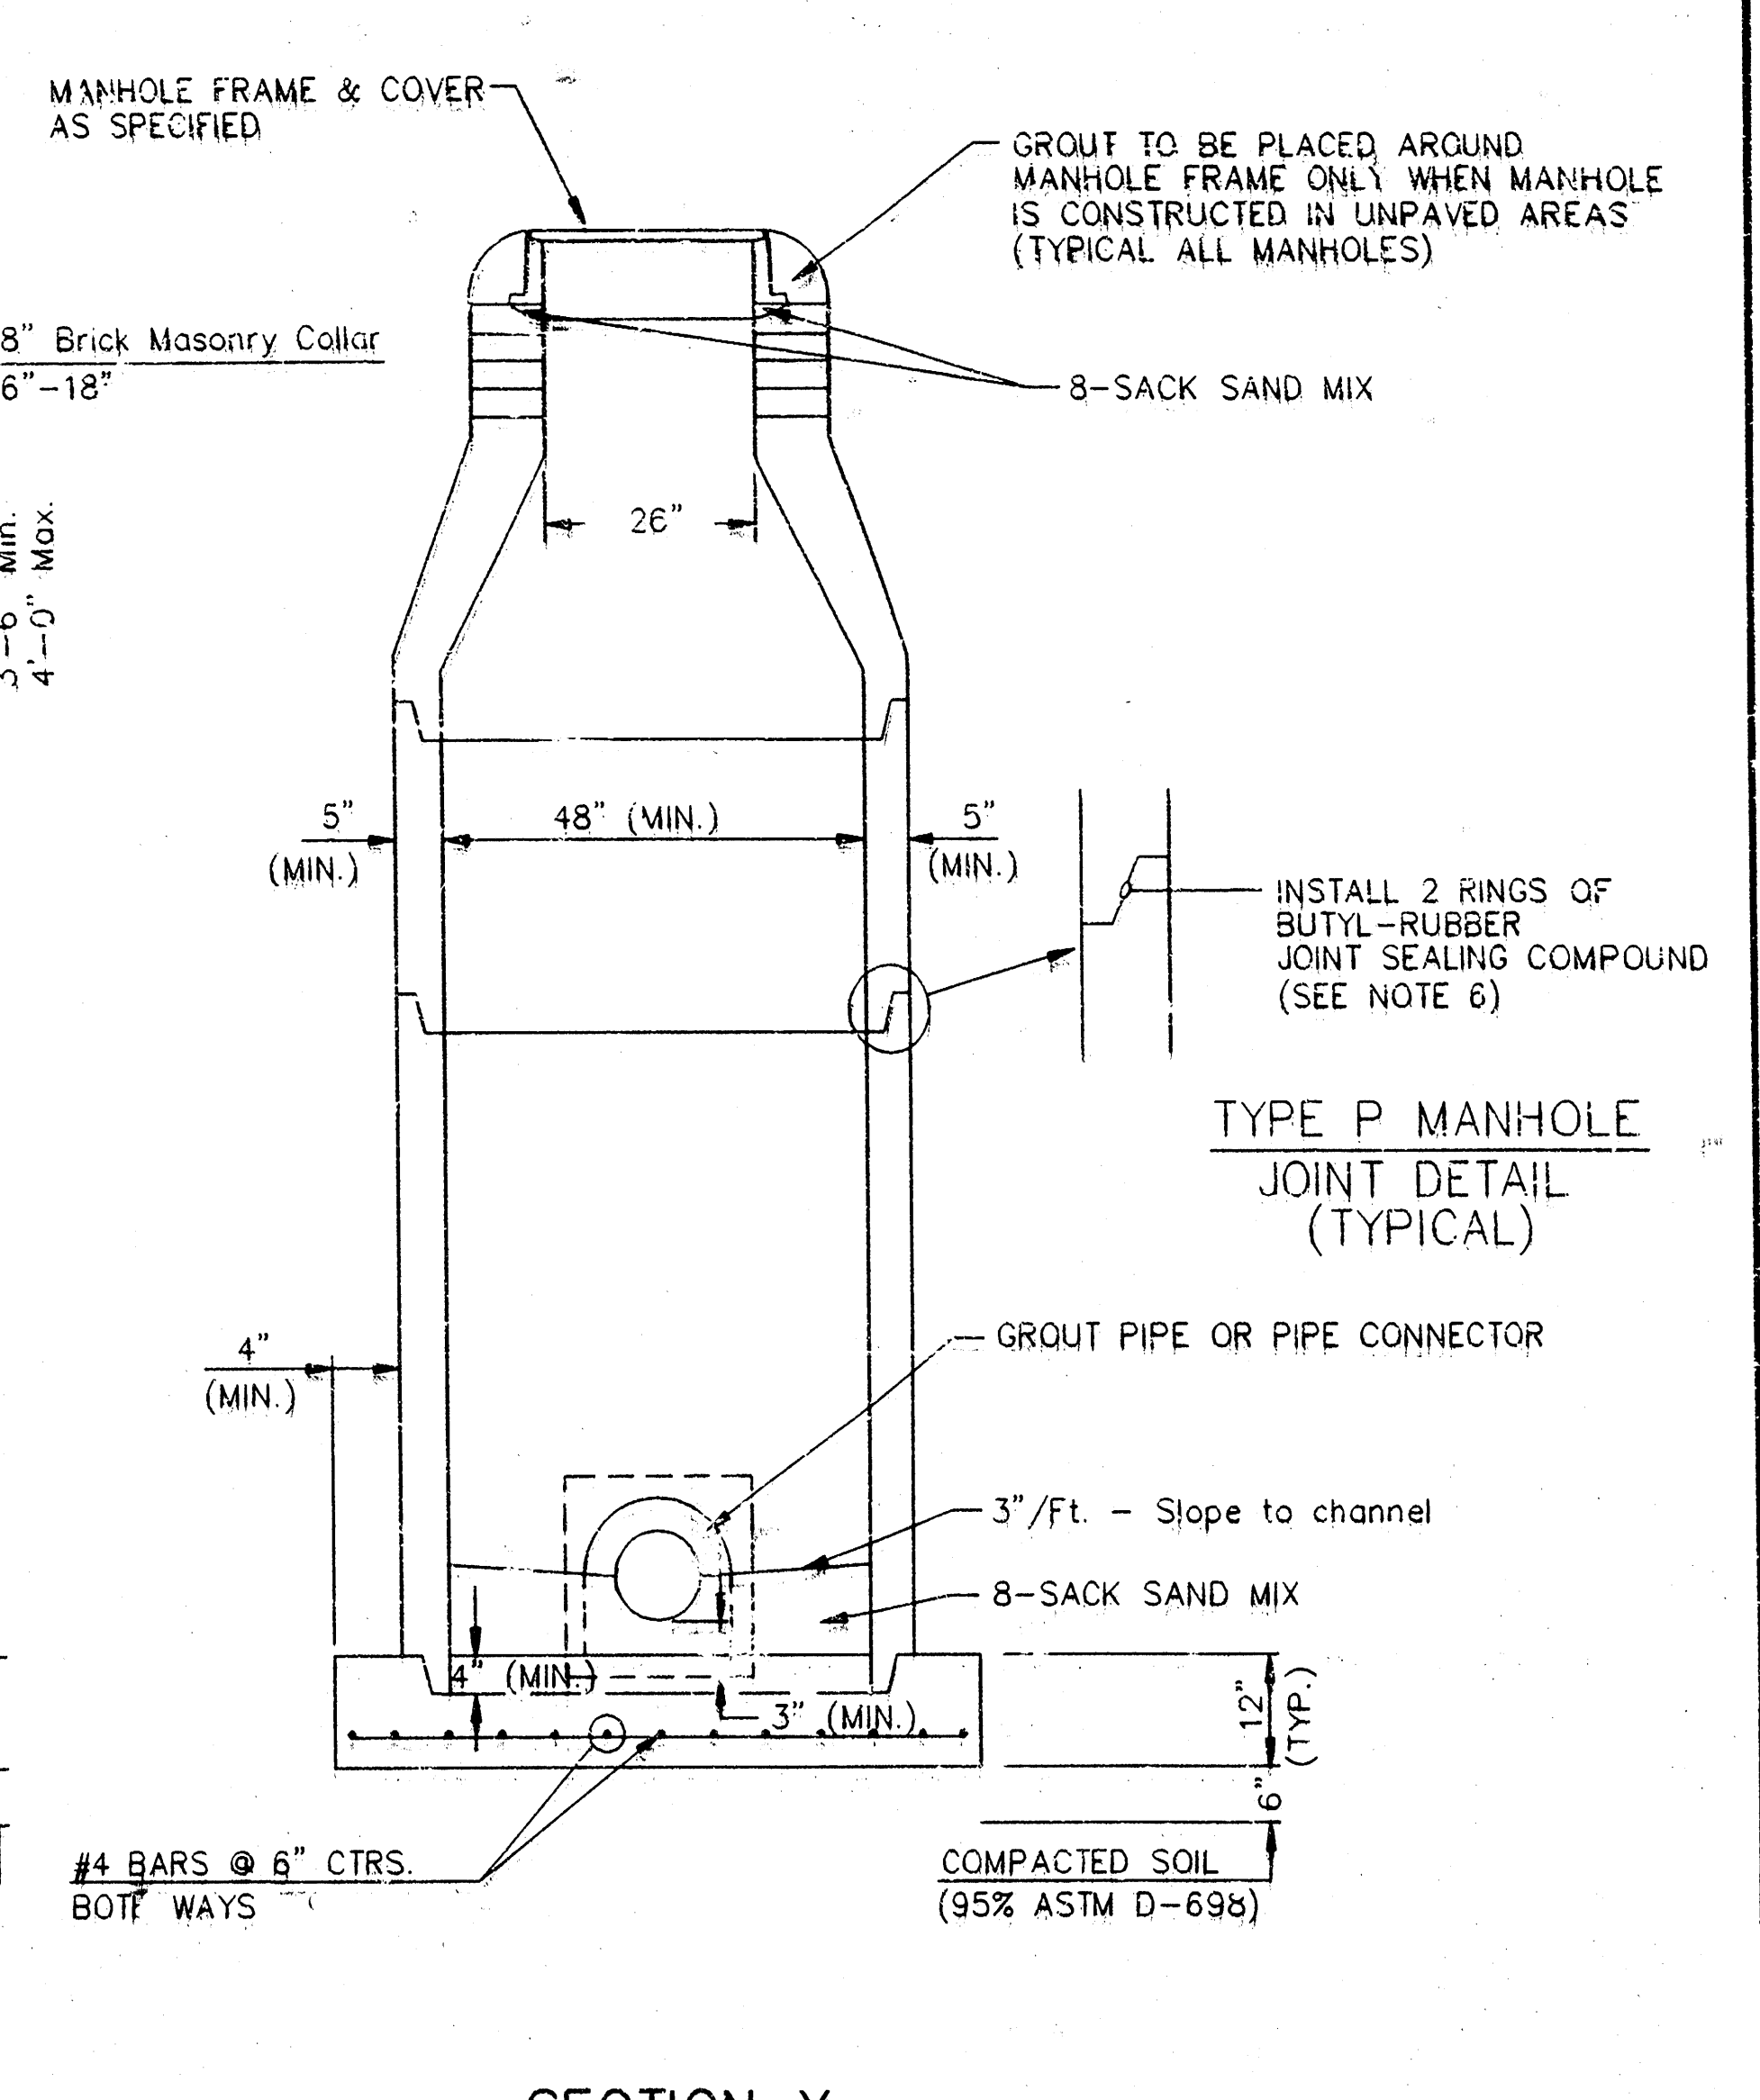

SECTION X
(TYPICAL)


GENERAL NOTES
CAST MANHOLE N

1. ALL PRECAST CONCRETE MANHOLE SECTIONS SHALL CONFORM TO THE LATEST REVISIONS OF A.S.T.M. C478 AS MODIFIED BY THE SPECIFICATIONS.
2. NON-SHRINK GROUT SHALL BE NON-METALLIC TYPE.
3. APPROVED FLEXIBLE WATERSTOP GASKETS SHALL BE INSTALLED TO JOIN THE SEWER TO THE MANHOLE WALL WHEN A.B.S. COMPOSITE PIPE V.C.P. PIPE IS USED. FOR OTHER TYPES OF PIPE THE SEWER SHALL BE GROUTED IN PLACE WITH NON-SHRINK GROUT. THE SEWER PIPE SHALL BE SUPPORTED WITH CONCRETE ENCASEMENT A MINIMUM OF 3 FEET FROM THE MANHOLE WALL AND TO THE FIRST JOINT FOR V.C.P. SUCH THAT THE JOINT REMAINS FLEXIBLE.
4. ALL INSIDE SURFACES OF THE CONCRETE MANHOLE WHICH WOULD BE EXPOSED TO SEWER GAS SHALL BE COATED WITH 2 COATS INEMEC SERIES 66 HI-BUILD EPOXOLINE, DRY THICKNESS OF 8 MILS (MIN.).
5. EXTERIOR MANHOLE WALLS SHALL BE COATED WITH 1 COAT MOBILARMA 633 BITUMINOUS COATING.
6. JOINT SEALING COMPOUND SHALL BE KENT SEAL NO. 2 OR APPROVED EQUAL.
7. PRECAST MANHOLES SHALL BE SET AT LEAST 4 INCHES INTO THE MANHOLE BASE.
8. TOP OF MANHOLE FLOOR SLAB SHALL BE AT LEAST 3 INCHES BELOW THE FLOW LINE OF THE OUTLET PIPE TO INSURE SUFFICIENT MINIMUM THICKNESS OF SHAPED INVERT.
9. LIFTING HOLES SHALL BE FILLED WITH NON-SHRINK GROUT AND THE INTERIOR SURFACE COATED AS SPECIFIED.
10. MORTAR USED IN MASONRY CONSTRUCTION SHALL CONTAIN 8 SACKS OF CEMENT PER CUBIC YARD. CONCRETE USED IN MANHOLE BASES SHALL CONFORM TO THE REQUIREMENTS OF CONCRETE FOR CONCRETE PAVEMENT CONSTRUCTION AS SPECIFIED IN THE CITY STANDARD PAVING. SEWER JOINTS USING JOINT CONCRETE PAVEMENT MIX WITHOUT AIR ENTRAINING ADJUNCTURE. MORTAR SHALL BE PLACED AROUND THE MANHOLE BASE AS SHOWN ON THE DRAWINGS WHEN MANHOLES ARE CONSTRUCTED IN UNPAVED AREAS. MANHOLES CONSTRUCTED WHERE PIPE SIZES ARE SMALLER THAN 24" SHALL HAVE AN INSIDE DIAMETER OF 4". MANHOLES CONSTRUCTED WHERE PIPE SIZES ARE 24" OR LARGER SHALL HAVE AN INSIDE DIAMETER OF 5". COMPLETED MANHOLE SHALL BE WITHOUT LEAKS AND WATER TIGHT.

1. REINFORCING STEEL SHALL BE INSTALLED IN THE MANHOLE BASES AND SHALL CONSIST OF NO. 4 BARS PLACED ON 6" CENTERS IN BOTH DIRECTIONS. THE MANHOLE BASE REINFORCEMENT SHALL BE PLACED AT LEAST 3" ABOVE THE BOTTOM OF THE MANHOLE BASE. ALL COSTS FOR FURNISHING AND INSTALLING REINFORCING STEEL SHALL BE INCLUDED IN THE UNIT PRICE BID FOR THE MANHOLE.
2. OPENINGS SHALL BE CUT INTO THE MANHOLE WALL WHEN OUTSIDE DROPS ARE CONSTRUCTED ON EXISTING MANHOLES. SUCH OPENINGS SHD BE MADE EXISTING MANHOLES SHALL BE AS SMALL AS PRACTICAL TO FACILITATE INSTALLING AND GROUTING THE NEW PIPE IN PLACE. WATERSTOP GASKETS SHALL BE USED WITH P.V.C. AND A.B.S. COMPOSITE PIPE. THE NEW PIPE SHALL BE GROUTED INTO THE OPENING USING AN APPROVED NON-SHRINK GROUT FOR THE FULL MANHOLE WALL THICKNESS. THE EXTERIOR OF THE COMPLETED CONNECTION SHALL BE SEALED WITH AN APPROVED BITUMINOUS COATING SUCH THAT THE CONNECTION WILL BE WATER TIGHT. FLOOR OF MANHOLE SHALL BE MODIFIED TO FORM NEW FLOW CHANNEL FOR THE NEW CONNECTION AS INDICATED BY THE DRAWING THIS WORK, INCLUDING MODIFICATION OF MANHOLE FLOOR, SHALL BE PAID FOR AT THE UNIT PRICE BID FOR OUTSIDE DROP STACK CONSTRUCTED ON EXISTING MANHOLE.
3. THE FLOORS OF ALL MANHOLES SHALL BE SHAPE WITH FLOW CHANNELS SUCH THAT THE MANHOLES WILL BE FREE FROM STAGNANT WATER WHERE SOLIDS COULD BE ACCUMULATED. THE FLOW CHANNELS SHALL BE FORMED TO THE DOWNSTREAM SIDE OF THE MANHOLE. FOR INCLINE DROPS, MANHOLES SHALL HAVE FLOW CHANNELS OUTSIDE THE MANHOLE. FLOWS THROUGH THE FLOW CHANNELS THE INFLOWING WATERS EXCEPT DRAINAGE DROPPING IN THE FLOW CHANNELS SHALL BE REMOVED TO THE MANHOLE. MAINTAIN THE FLEXIBILITY OF THE JOINT. COST OF CARRYING ADJACENT TO MANHOLE SHALL BE INCLUDED IN THE UNIT PRICE BID FOR THE MANHOLE.
4. PIPES INSTALLED IN MANHOLE SHALL BE GRADED WITH CURVATURE TO MAINTAIN THE FLEXIBILITY OF THE JOINT. COST OF CARRYING ADJACENT TO MANHOLE SHALL BE INCLUDED IN THE UNIT PRICE BID FOR THE MANHOLE.

15. MANHOLE COVER CASTINGS AND MANHOLE FRAME CASTINGS SHALL CONFORM TO THE REQUIREMENTS AS INDICATED IN THE STANDARD SPECIFICATIONS AND AS SHOWN IN THE STANDARD DETAIL DRAWING.
16. THE VERTICAL DROP IN INSIDE DROP MANHOLES SHALL NOT EXCEED 2' FOR INFLUWING PIPES SIZED 12" OR SMALLER AND 2' FOR INFLUWING PIPES LARGER THAN 12". THE SLOWS OF INFLUWING PIPES SHALL NEVER BE SET LOWER THAN THE CROWN OF THE OUTFLOWING PIPE.
17. STANDARD MANHOLES AND STANDARD INSIDE DROP MANHOLES SHALL BE BID AS STANDARD MANHOLES FOR THE TYPE AND DIAMETER INDICATED. OUTSIDE DROP MANHOLES SHALL BE BID AS STANDARD OUTSIDE DROP MANHOLES FOR THE TYPE AND DIAMETER INDICATED. ALL MANHOLE DIAMETERS WILL BE 4' UNLESS INDICATED OTHERWISE.
18. A BRICK MASONRY COLLAR SHALL BE INSTALLED BETWEEN THE CAST IRON FRAME AND THE CONCENTRIC CONE. THE COLLAR WILL HAVE 8" COLLARS AND A VERTICAL HEIGHT OF 6" MINIMUM AND 18" MAXIMUM. A 1" COAT OF PORTLAND CEMENT PLASTERED ON THE OUTSIDE OF THE COLLAR. THE USE OF PRE-CAST CONCRETE SPACERS FOR MANHOLE TOP ADJUSTMENT IS ALSO ALLOWED.

RECORD DRAWING

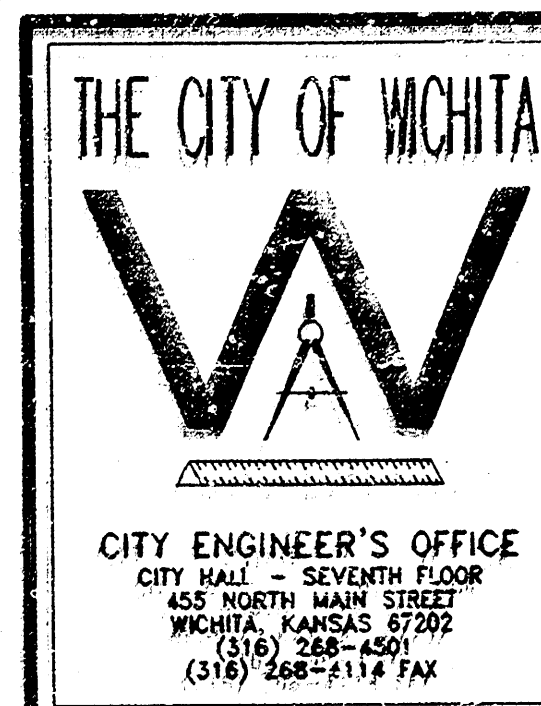

**STANDARD
TYPE 'P'
MANHOLES**


M. E. LINDEBAK P.E. - CITY ENGINEER

PROJECT NUMBER	INDEX CODE
468-82308	743790


DATE
MAR 96

SHEET 7 OF 9


MANHOLE COVER
Weight = 180 Lbs.

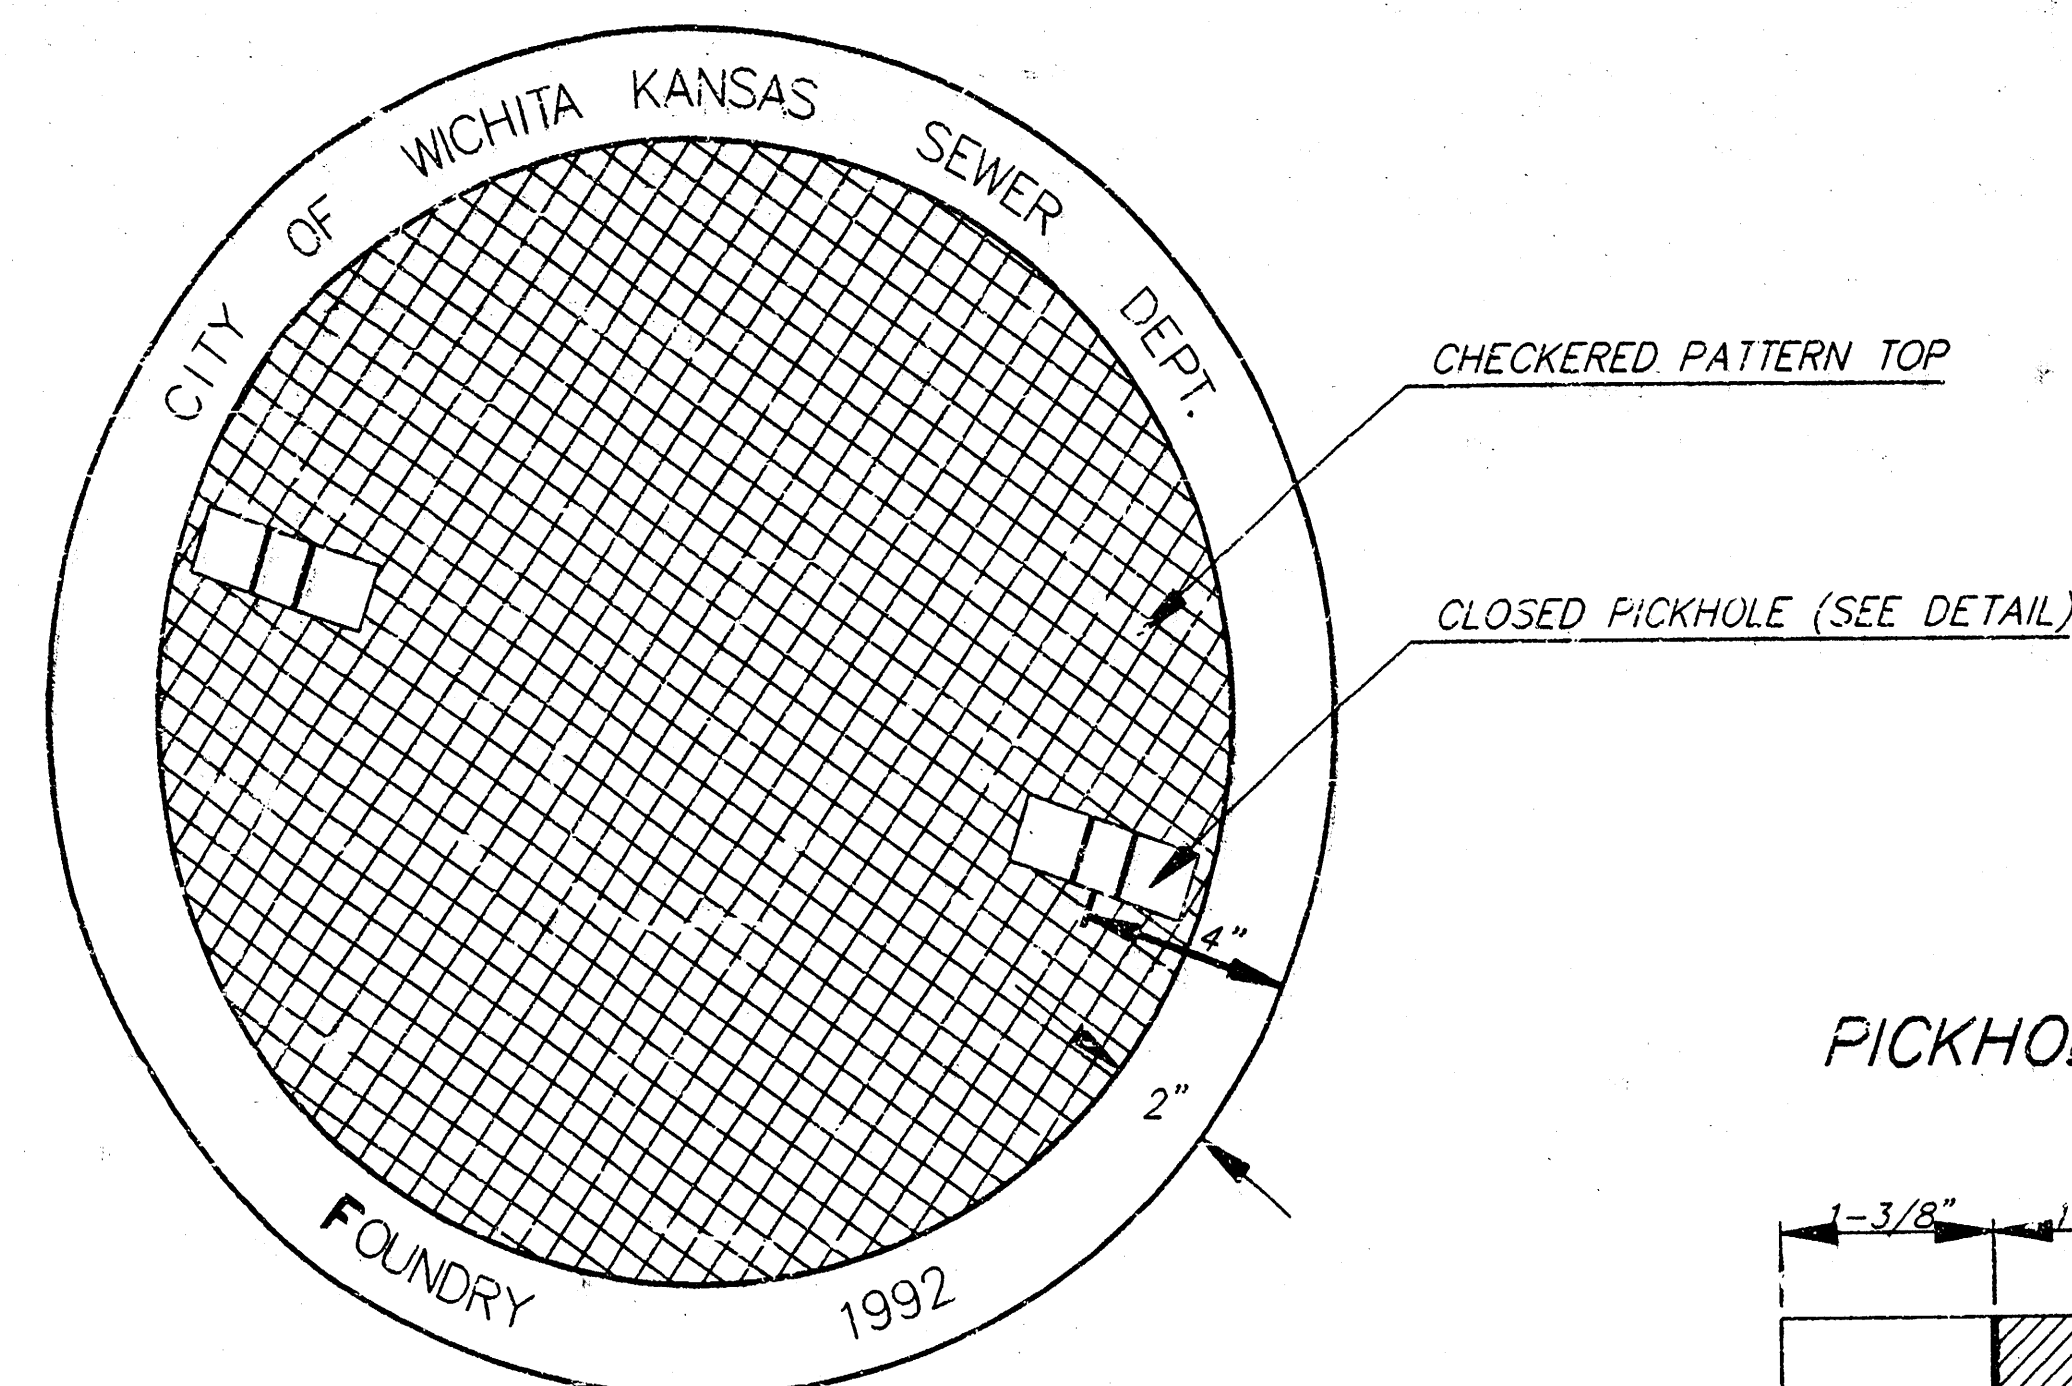

TOP VIEW

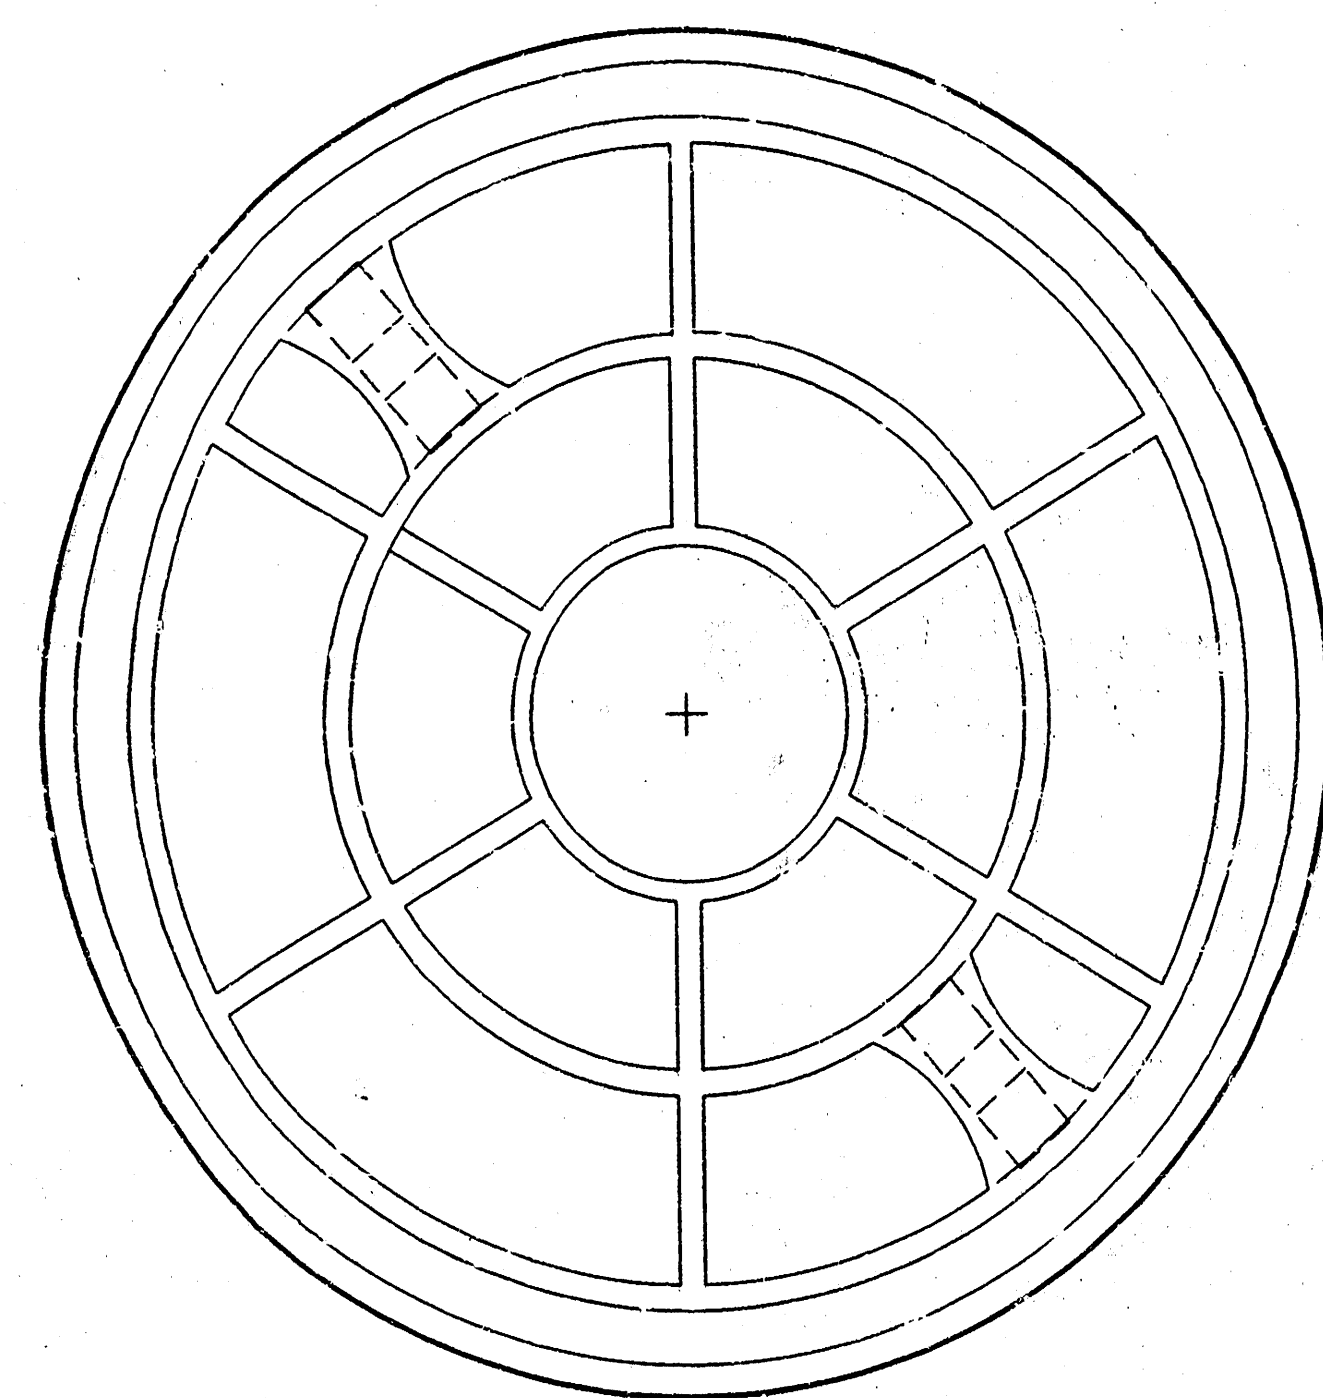


BOTTOM VIEW

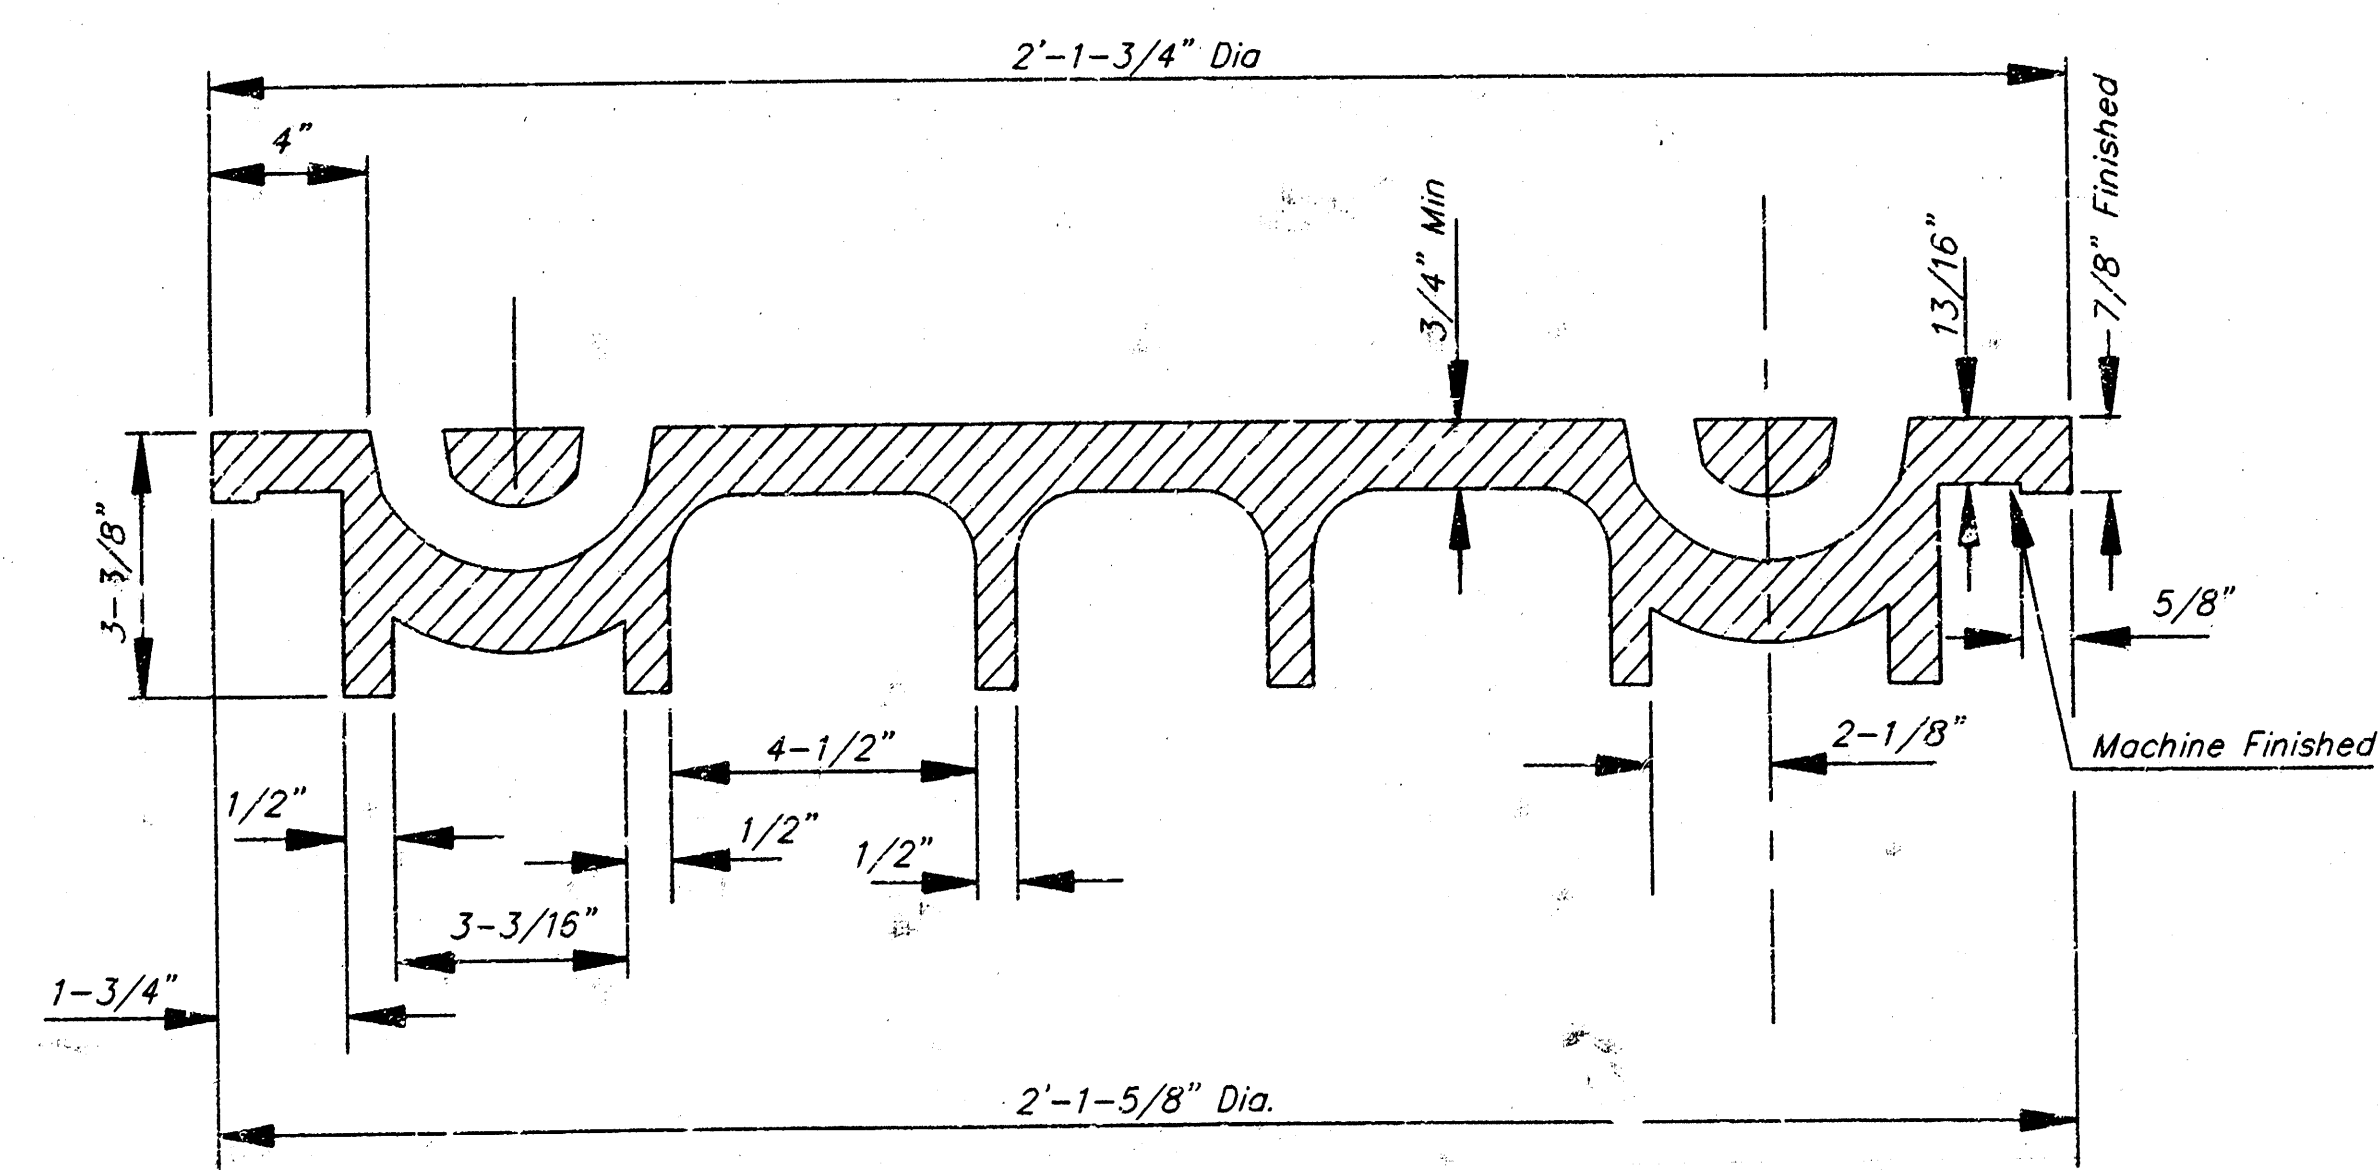


SECTION VIEW

PICKHOLE DETAIL

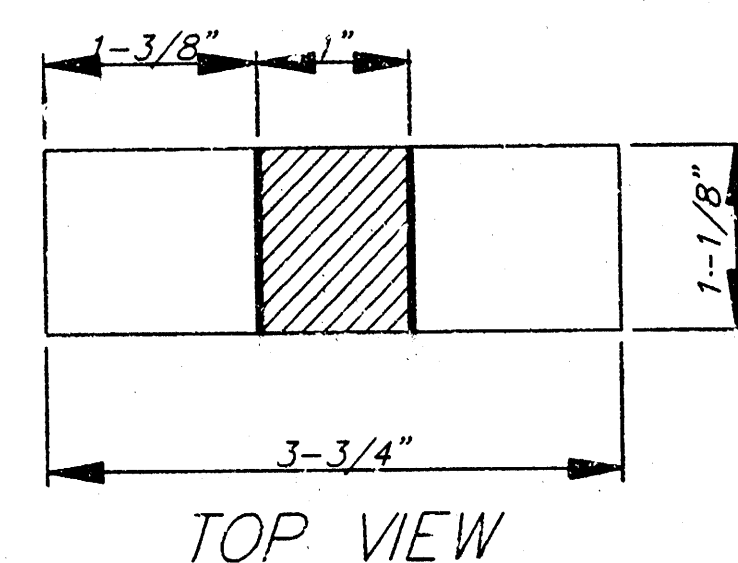

TOP VIEW

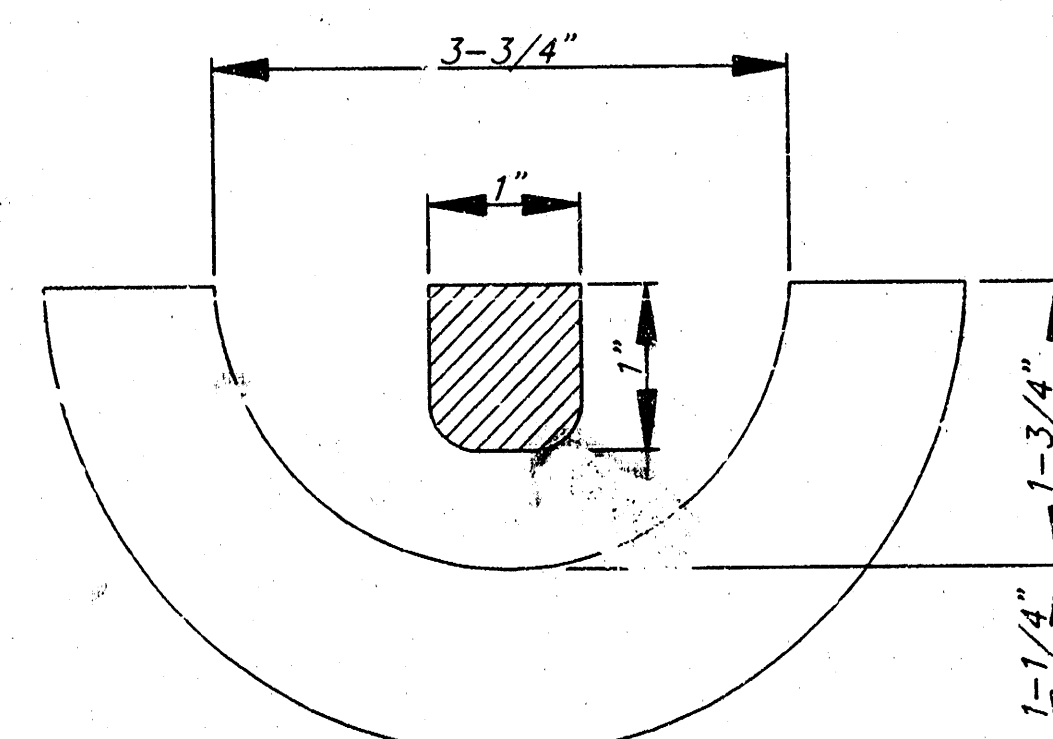


SECTION VIEW

MANHOLE FRAME AND COVER DETAIL

ADOPTED AS STANDARD DESIGN BY
CITY OF WICHITA, KANSAS


MANHOLE FRAME
Weight = 240 Lbs.

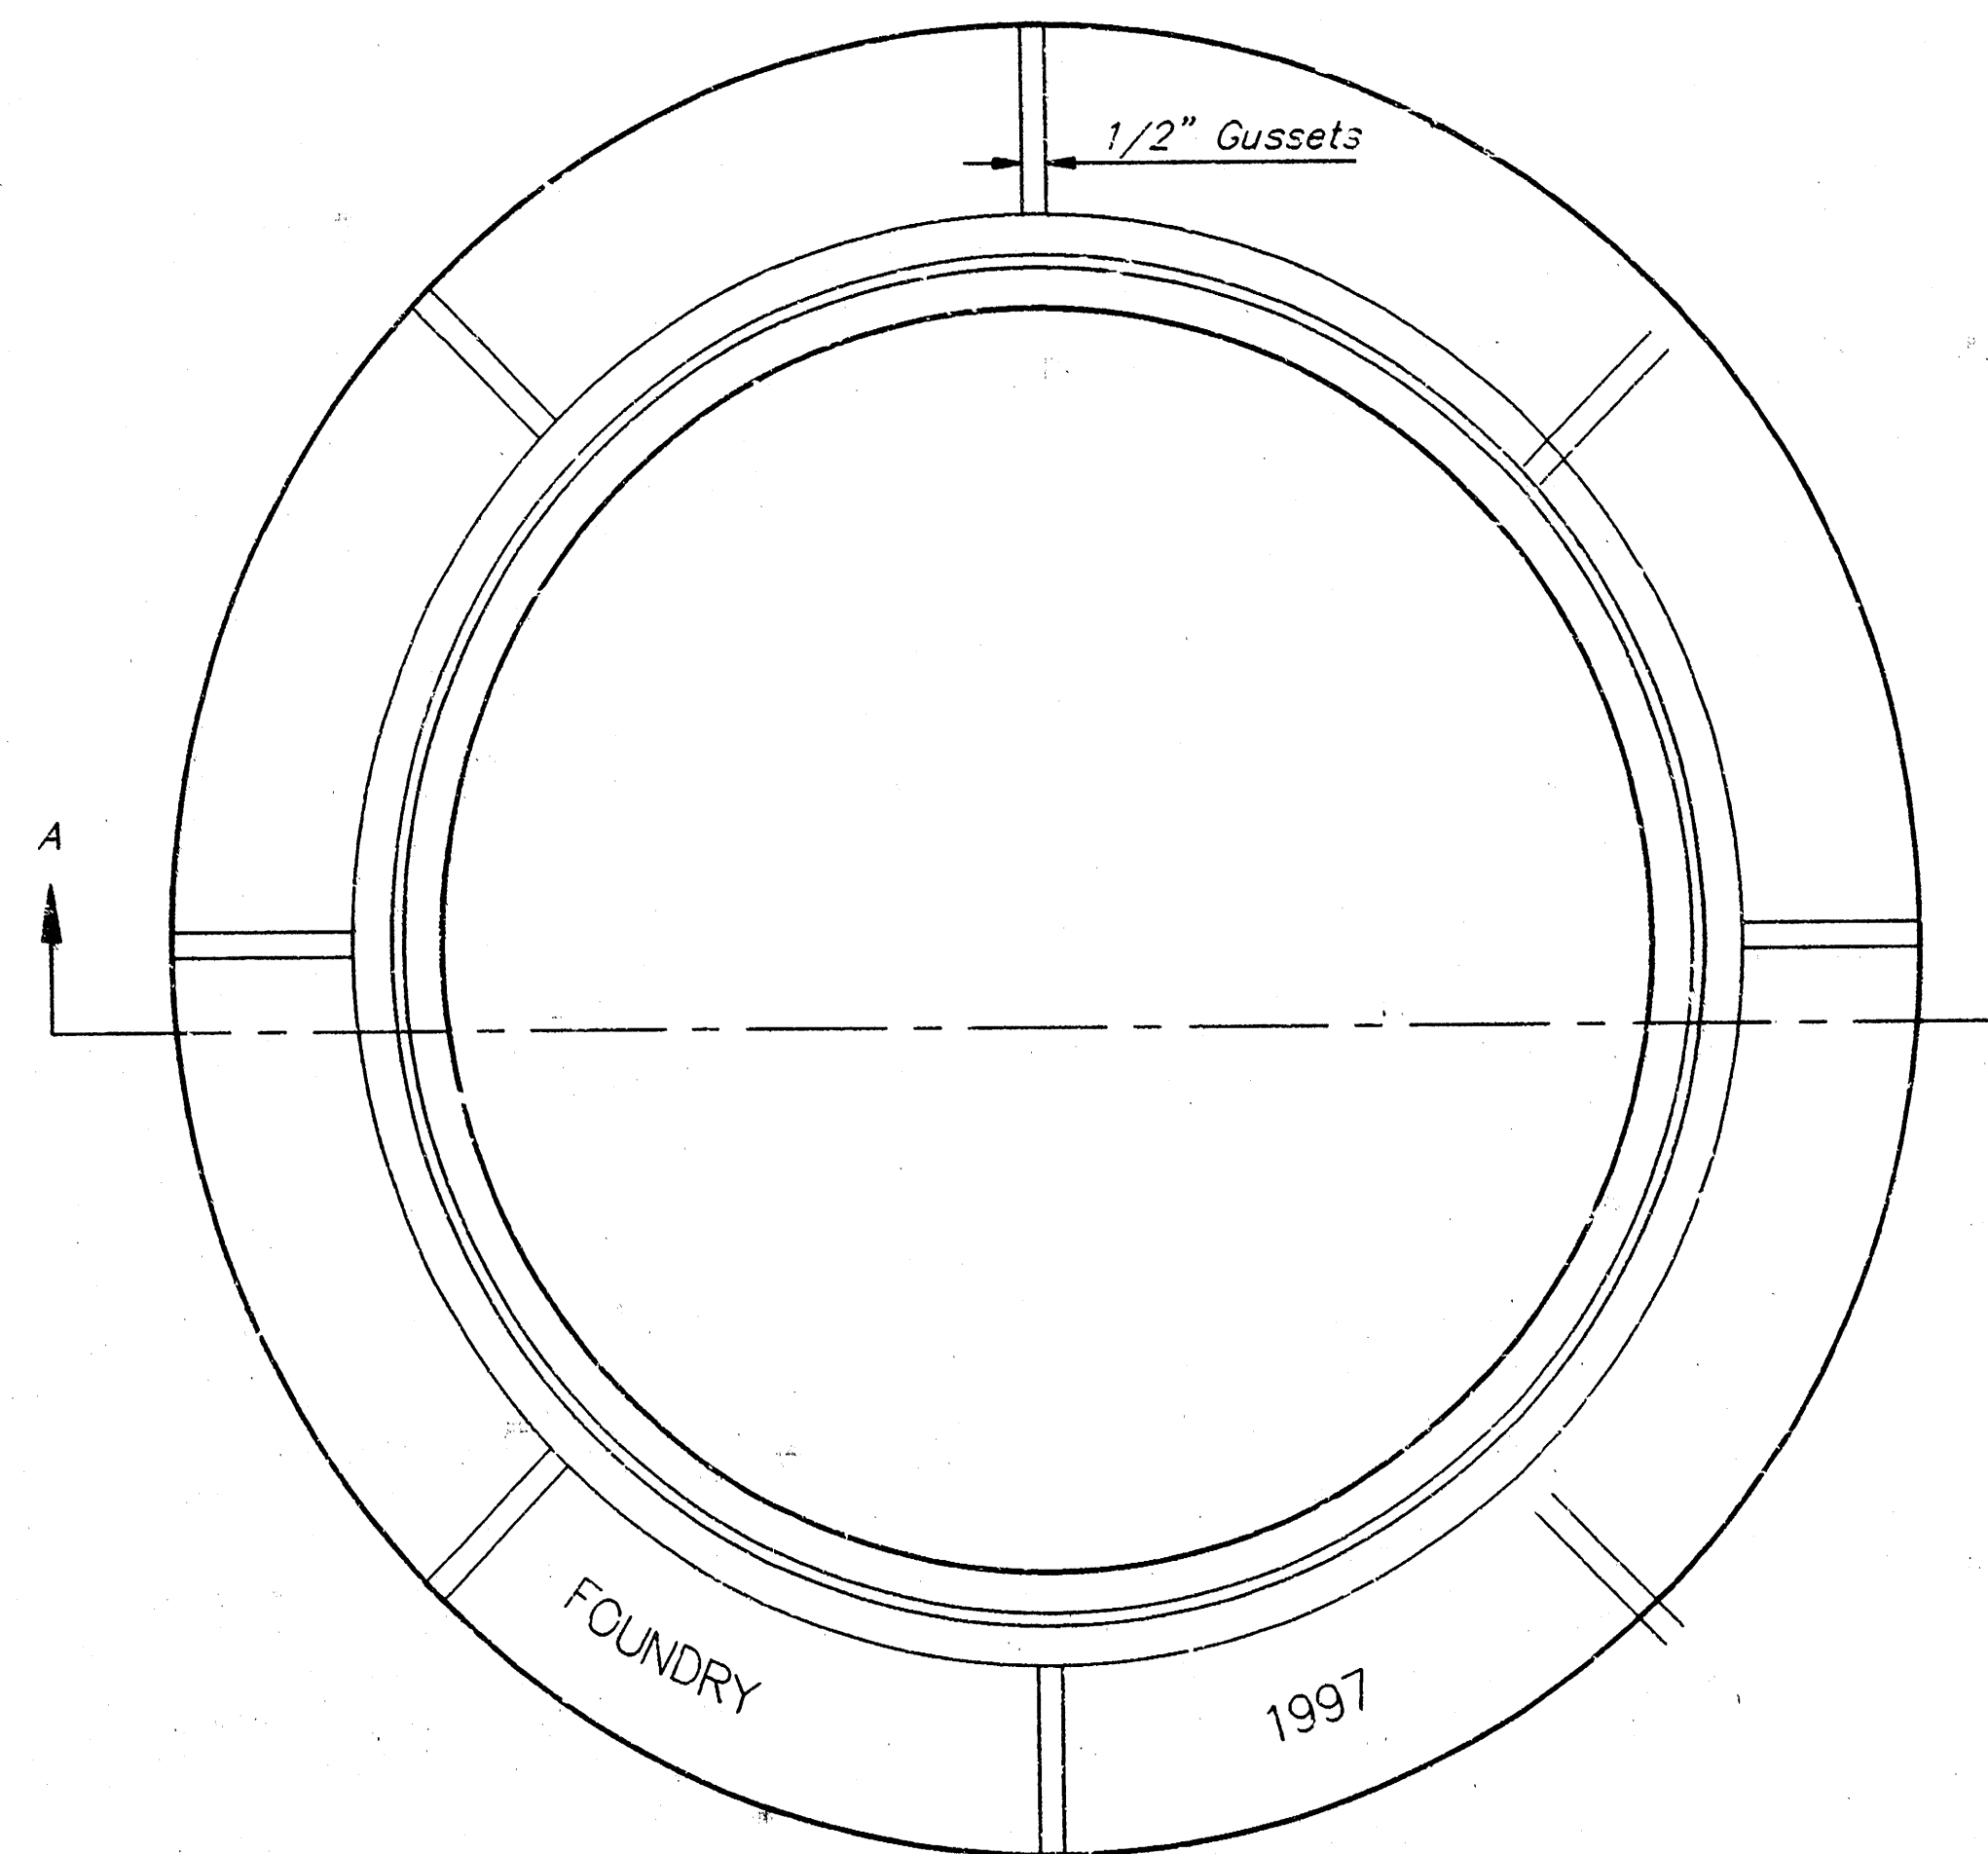


TOP VIEW

GENERAL NOTES

1. MANHOLE CASTINGS SHALL BE MANUFACTURED USING GOOD QUALITY GRAY IRON CONFORMING TO CLASS 30 OF A.S.T.M. DESIGNATION A-48. DIMENSIONS AND WEIGHTS SHOWN ON THE DETAILED DRAWINGS SHALL BE CONSIDERED AS MINIMUM REQUIREMENTS AND ANY DEVIATIONS FROM THE DIMENSIONS SHOWN MUST BE SPECIFICALLY APPROVED. THE FINISHED CASTINGS SHALL BE OF UNIFORM QUALITY, FREE FROM BLOWHOLES, POROSITY, HARD SPOTS, SHRINKAGE DISTORTIONS OR OTHER DEFECTS.
2. MANHOLE CASTINGS SHALL WEIGH A MINIMUM OF 180 POUNDS ON THE SOLID COVER AND 240 POUNDS ON THE MANHOLE RING. THIS IS A TOTAL OF 420 POUNDS ON A RING AND COVER SET. CASTINGS WEIGHING LESS THAN THE MINIMUM SPECIFICATIONS WILL NOT BE ACCEPTED.
3. MANHOLE CASTINGS SHALL BE MANUFACTURED SUCH THAT A COVER MANUFACTURED BY ANY ONE FOUNDRY WILL FIT INTERCHANGEABLY INTO A FRAME MANUFACTURED BY ANOTHER FOUNDRY AND STILL MEET ALLOWABLE CLEARANCES AND NON-ROCKING REQUIREMENTS. THIS WILL REQUIRE MANUFACTURING OF THE MATCHING FACES ON THE COVER AND THE FRAME TO CLOSE TOLERANCES.
4. THE OUTSIDE CIRCUMFERENCE OF THE VERTICAL FACE OF THE COVER AND THE INSIDE CIRCUMFERENCE OF THE VERTICAL FACE IN THE FRAME RECESS SHALL BE MANUFACTURED TO TOLERANCES SUCH THAT THE CLEARANCE BETWEEN THE COVER AND FRAME WILL NOT EXCEED 1/32\"/>

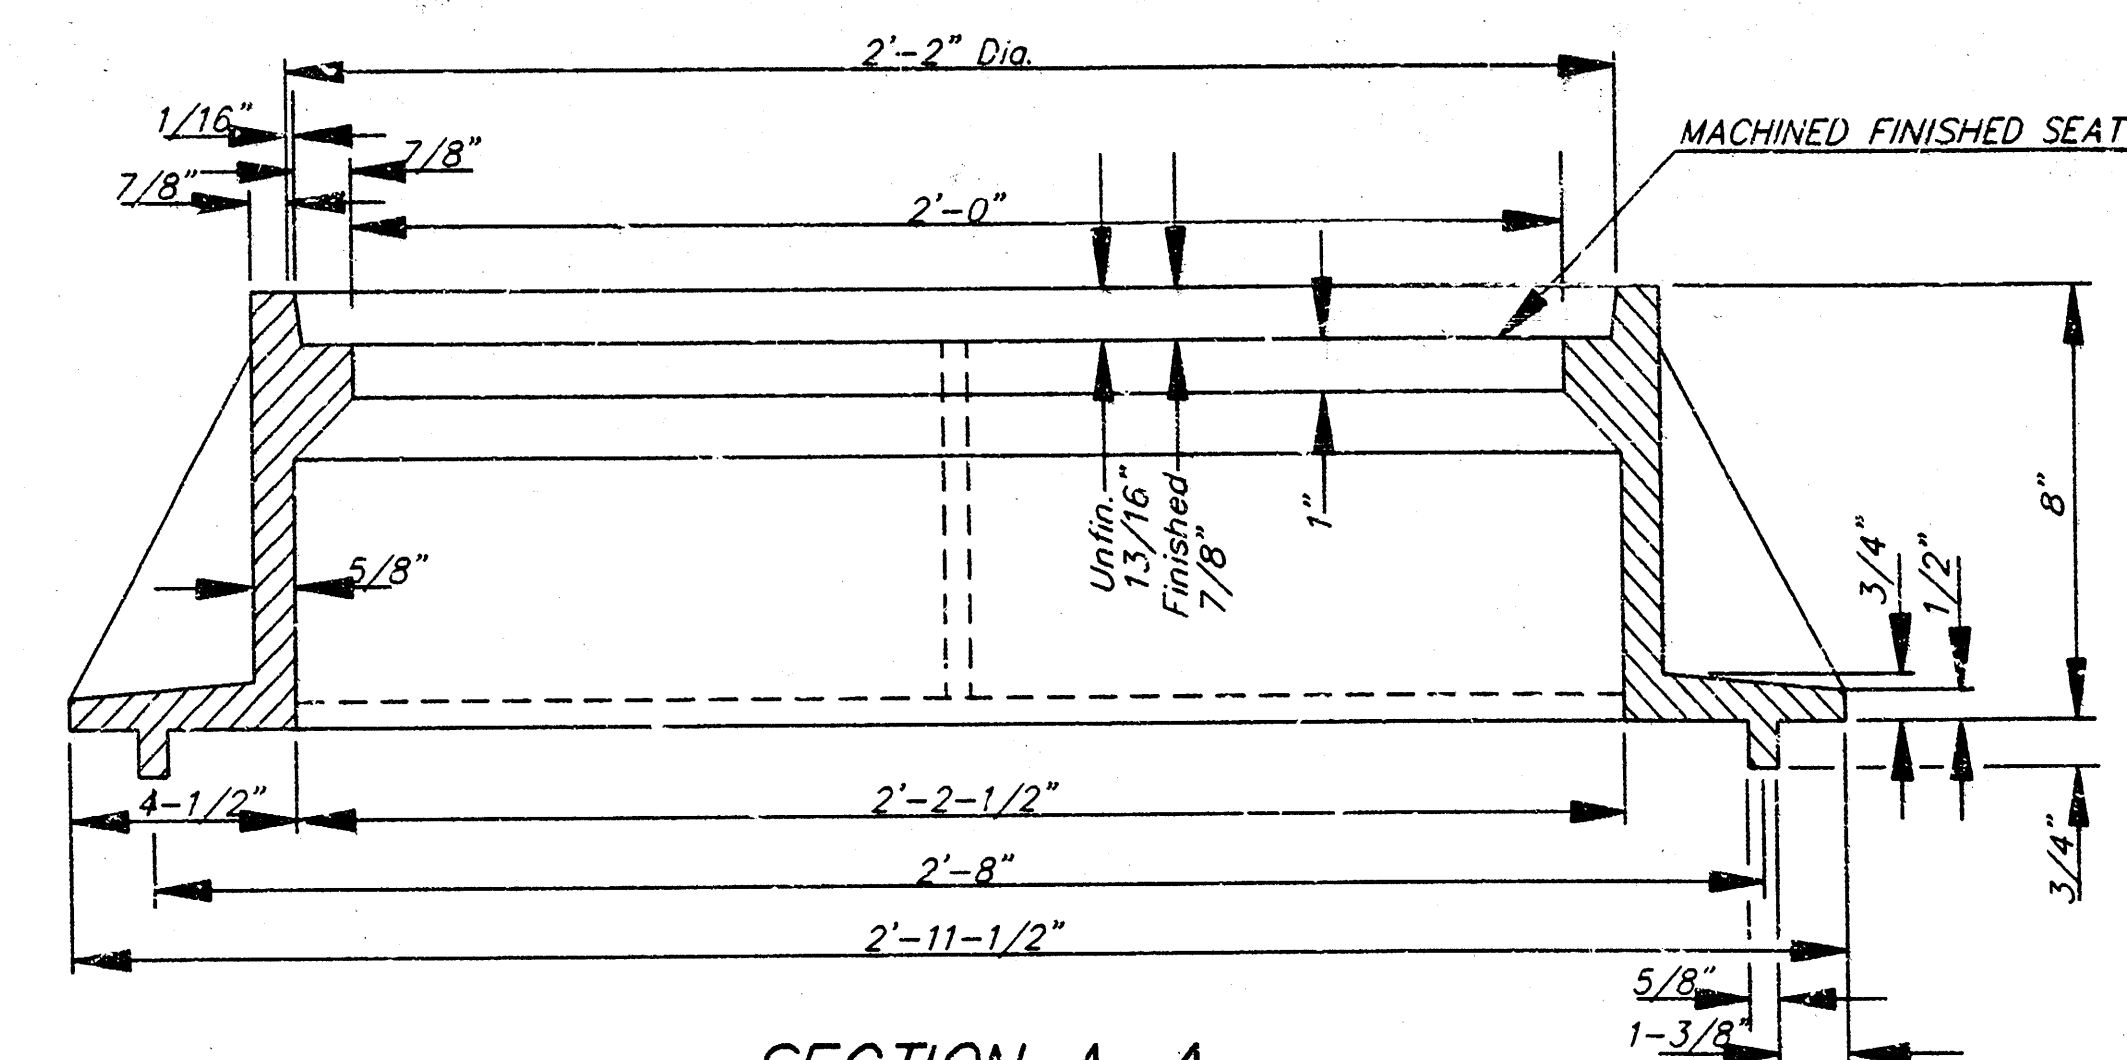


SECTION A-A
MUD RING

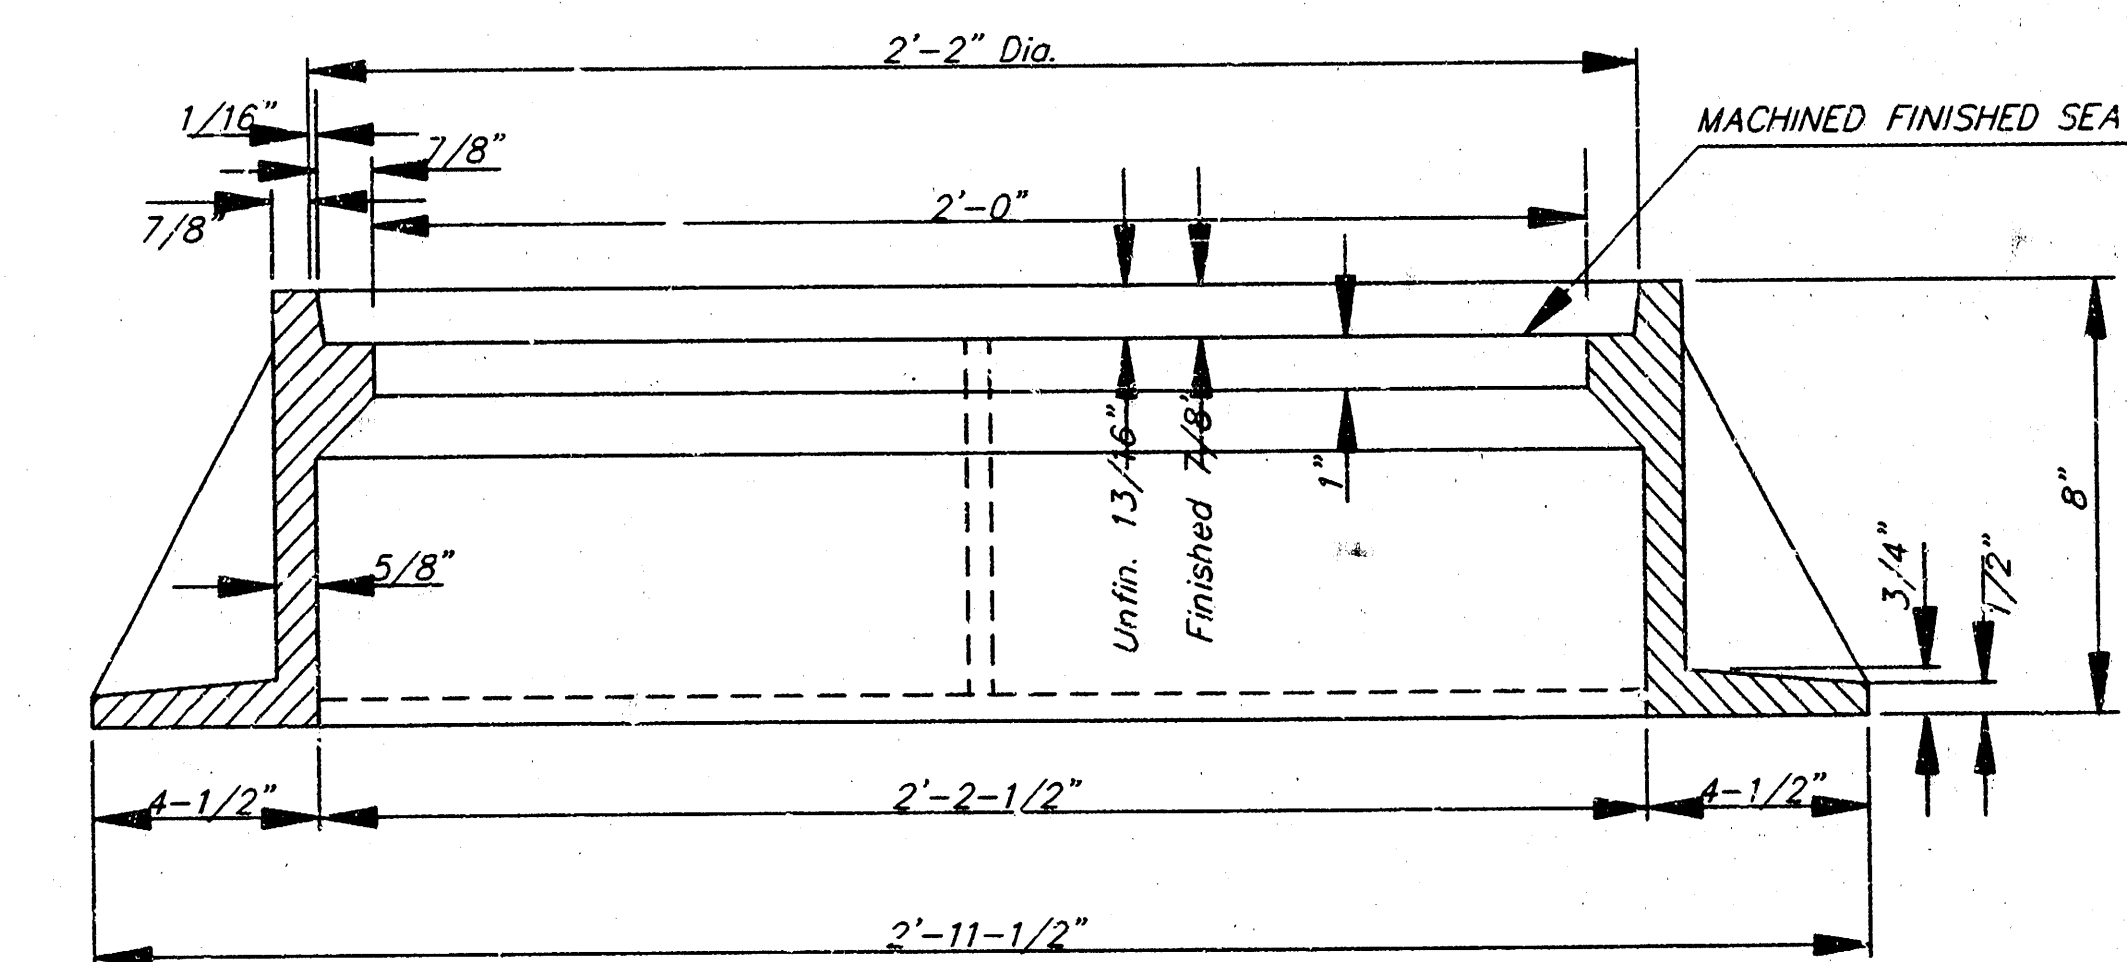

SECTION A-A

RECORD DRAWING

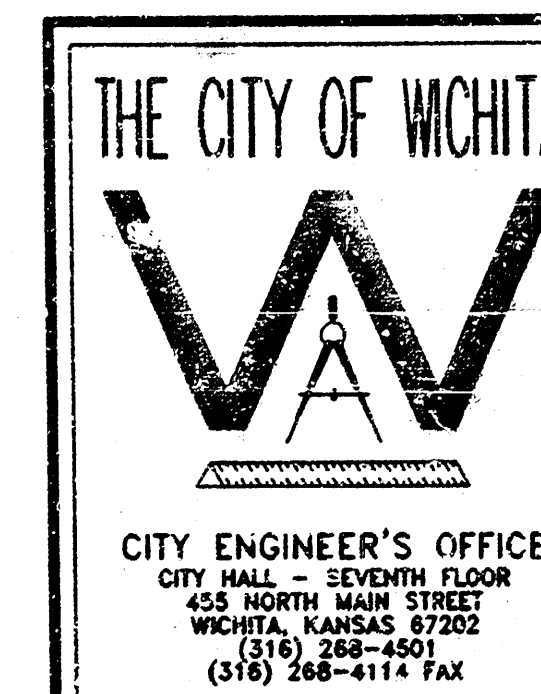

MANHOLE FRAME
AND COVER

M. E. LINDEBAK P.E. - CITY ENGINEER

PROJECT NUMBER
458-82308



INDEX CODE
743790

DATE
MAR 96

SHEET 8 OF 9




VERTICAL RISER DETAILS

ADOPTED AS STANDARD DESIGN
BY
CITY OF WICHITA, KANSAS
OCTOBER 1992

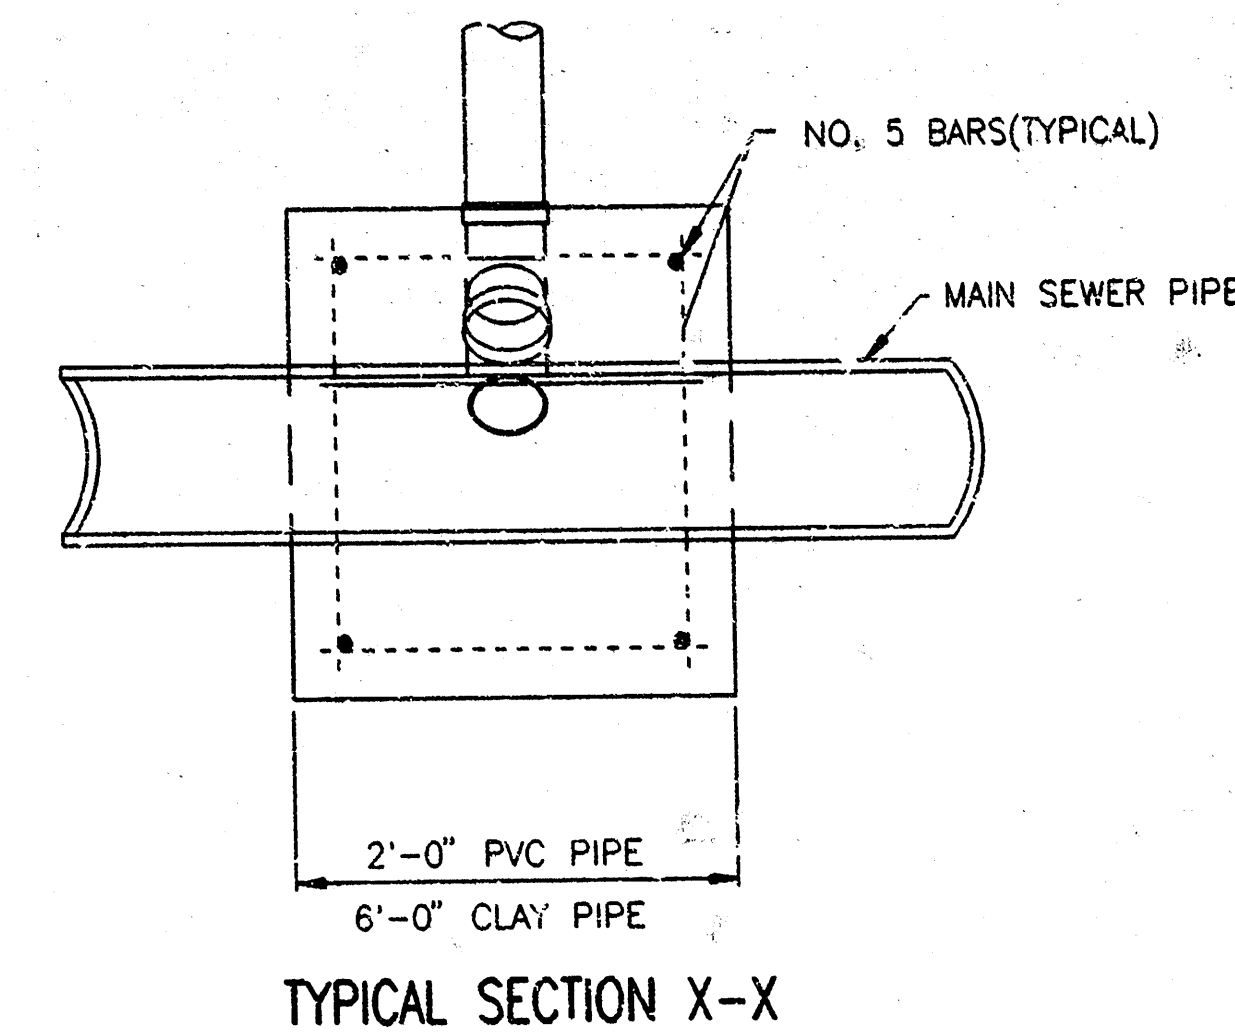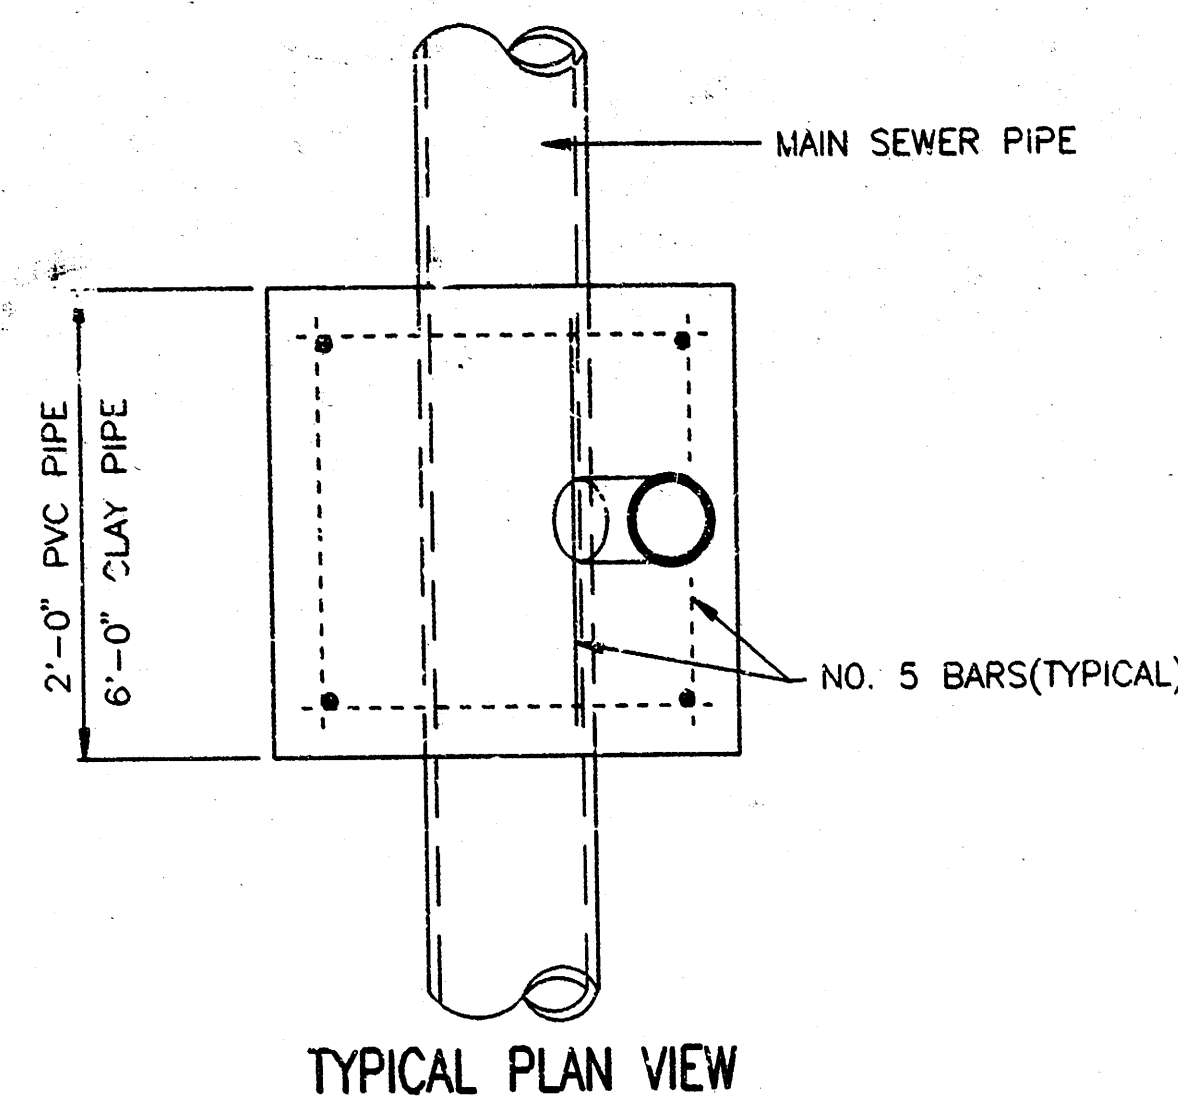

GENERAL NOTES

- RISERS.** Risers shall be installed to serve all lots or tracts where the sanitary sewer main is below the water table. Risers shall also be installed to serve all lots and tracts where the sanitary sewer main depth is greater than 12 feet below the proposed ground elevation. Installation of risers because of field conditions shall be as approved by the Construction Engineer. The location of the risers to serve developed property shall be approved by the property owner and the Construction Engineer.
- PIPE STUBS.** Pipe stubs shall be installed in manholes where locations of manholes will provide satisfactory service connection as determined by the Construction Engineer. The vertical distance between the flowline of the manhole pipe stub and the flowline of the sanitary sewer main out of the manhole shall not exceed 2 feet. Risers shall be utilized at manhole pipe stubs as indicated in Note 1. Manhole pipe stubs shall be set such that the top of the stub is not lower than the top of the sanitary sewer main.
- SIZING.** Pipe stubs and risers shall be sized according to the plans and riser table where risers are indicated by the plans. Where risers or pipe stubs are required because of field conditions, the risers and stubs shall be six-inch diameter for commercial or industrial properties and 4" or 6" diameter for residential properties, based on lot size and sanitary sewer main depth. Sizing of risers and stubs shall be approved by the Construction Engineer prior to installation.
- RISER OR STUB MATERIAL.** Risers and stubs shall be constructed of SDR 35 PVC Pipe or Schedule 40 PVC Pipe, meeting the requirements of the latest revision of A.S.T.M. All pipe joints shall be solvent welded.
- REINFORCED CONCRETE ENCASEMENT.** Riser connections to clay pipe sanitary sewers shall be reinforced concrete encased both ways from the riser centerline. The reinforced concrete encasement shall extend three feet from the riser centerline or stop at the first sanitary sewer pipe joint within three feet of the riser centerline. Riser connections to PVC Sanitary Sewer mains shall be reinforced concrete encased one foot each way from the riser centerline. The concrete encasement shall be reinforced using reinforcing steel as shown in the appropriate drawing. The concrete shall conform to the City Standard Specifications for concrete pavement.
- BEDDING.** Bedding around the sanitary sewer riser shall be compacted Pipe Bedding Type 1 or 2. The bedding shall be placed and compacted from the depth of the sanitary sewer main to the top of the sanitary sewer riser pipe. Compacted Pipe Bedding Type 1 or 2 shall be required for all risers whether constructed in vertical wall or sloped wall trenches. Bedding material and construction practices shall be approved by the Construction Engineer prior to installation.
- SUPPORT OF RISERS.** Sanitary sewer riser pipe shall be supported during trench backfill. The riser pipe shall be held in a vertical position at all times until trench backfill and compaction has been completed. Contractor's methods for supporting and backfilling the riser pipe shall be approved by the Construction Engineer.
- PLUGGING.** The ends of the riser pipes and manhole stubs shall be plugged using an airtight solvent welded cap or plug. Cap or plug fittings shall be approved by the Construction Engineer prior to installation. Caps or plugs which do not provide an airtight seal will not be accepted.
- TOP OF THE RISER PIPE.** The top elevation of the sanitary sewer riser pipe shall be built per plan elevations, unless otherwise directed by the Construction Engineer. Where riser elevations are not shown on the plans, the top of the risers shall be set at an elevation four feet below the proposed ground surface. If ground water is encountered, the top of the riser pipe shall be set at an elevation two feet (min.) above the maximum water table elevation, regardless of the riser elevation shown on the plans.
- MARKING.** Locations of the ends of the sanitary sewer riser pipe shall be marked by fastening green colored plastic tape to the end of the riser. The tape shall be supported by a length of wooden 2 x 4, extending from the top of the riser pipe to the proposed ground surface. The green tape shall be visible and extend one foot above the proposed ground surface. The green tape shall be 4 mil Polyethylene film with a minimum width of three inches, specifically manufactured for the purpose of identification of underground sewers.
- LOCATION MEASURES.** The project inspector shall record and document the location of all risers constructed as measured from the nearest manhole, indicating the direction from the manhole, the direction and distance from the main, riser size, and elevation of the top of the riser.
- RISER LOCATION.** The riser shall be located per plan if shown. If not shown on the plan, the riser shall be located at the center of the lot, within one foot of the property side of the easement for the lot being served. All riser locations shall be approved by the Construction Engineer prior to installation.
- PAYMENT.** "Sanitary sewer riser" shall be paid for at the contract unit price per each, which shall be full compensation for all pipe, fittings, bedding, support during backfill, backfill, labor, site restoration, and any other items necessary to complete the work.
"Manhole stubs" shall be paid for at the contract unit price per each, which shall be full compensation for all labor, material, and incidentals necessary to complete the work including all pipe, fittings, reinforced concrete encasement, and all other items as required and listed for "Sanitary Sewer Risers".

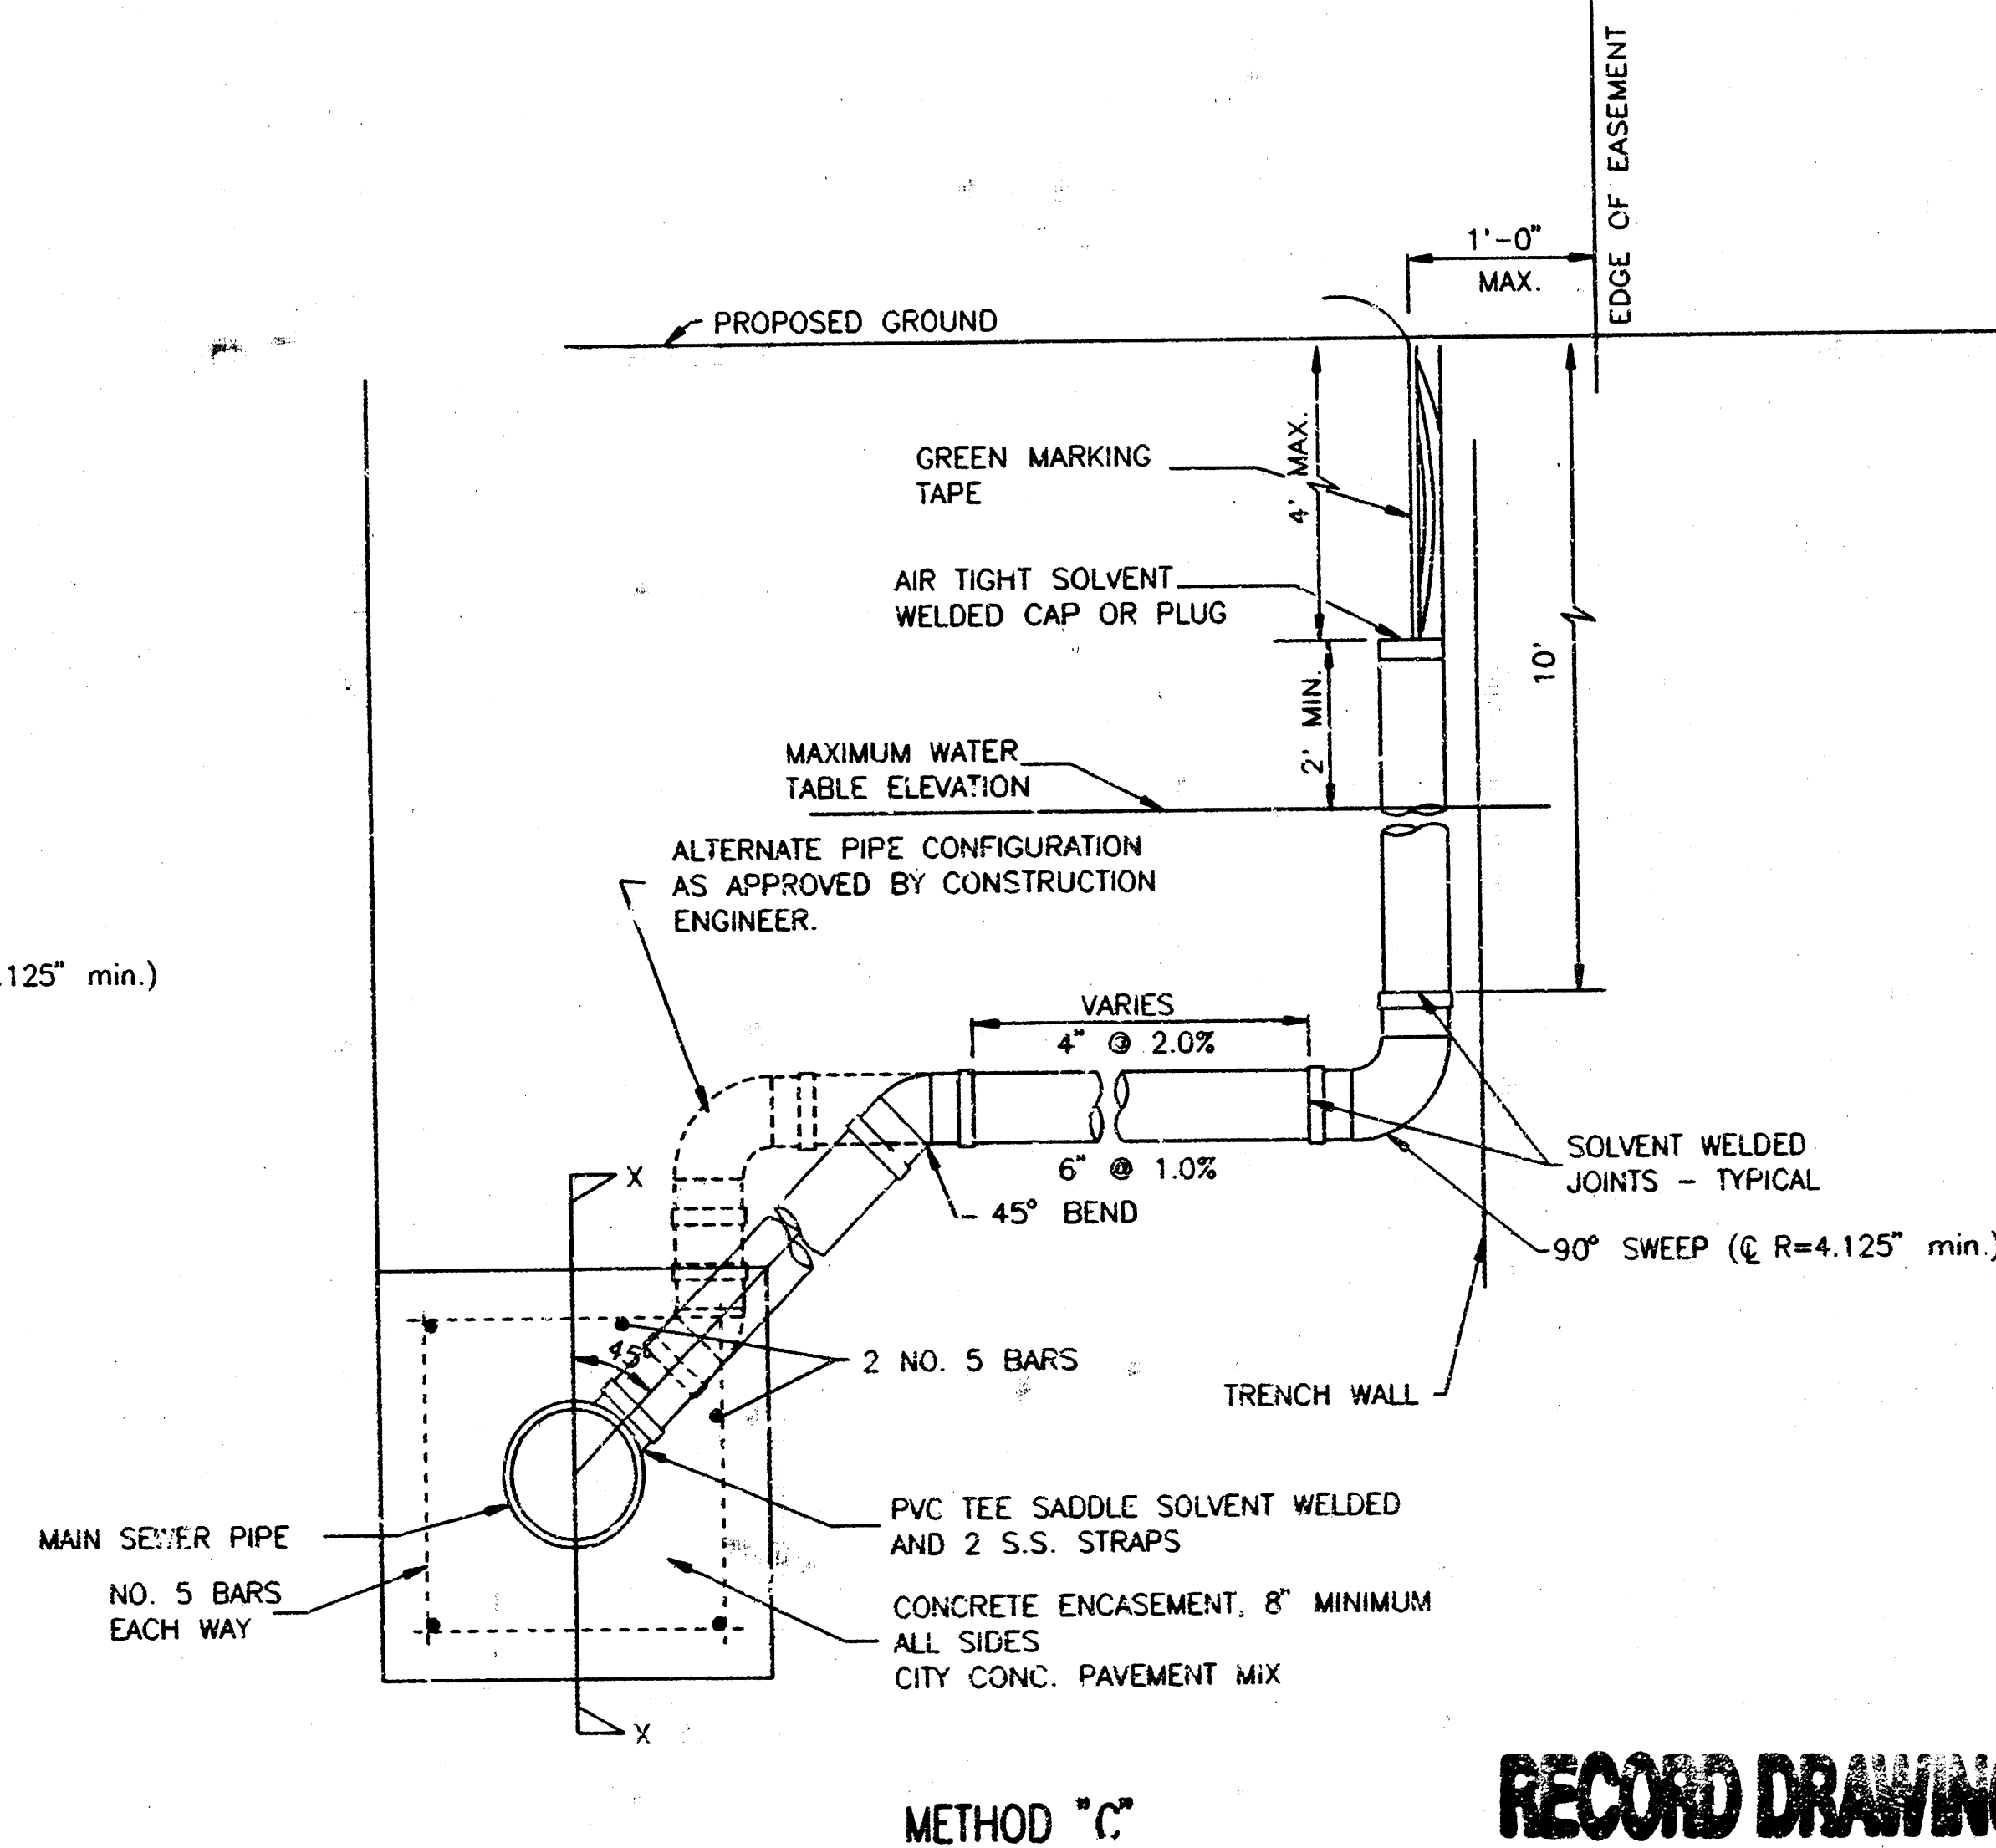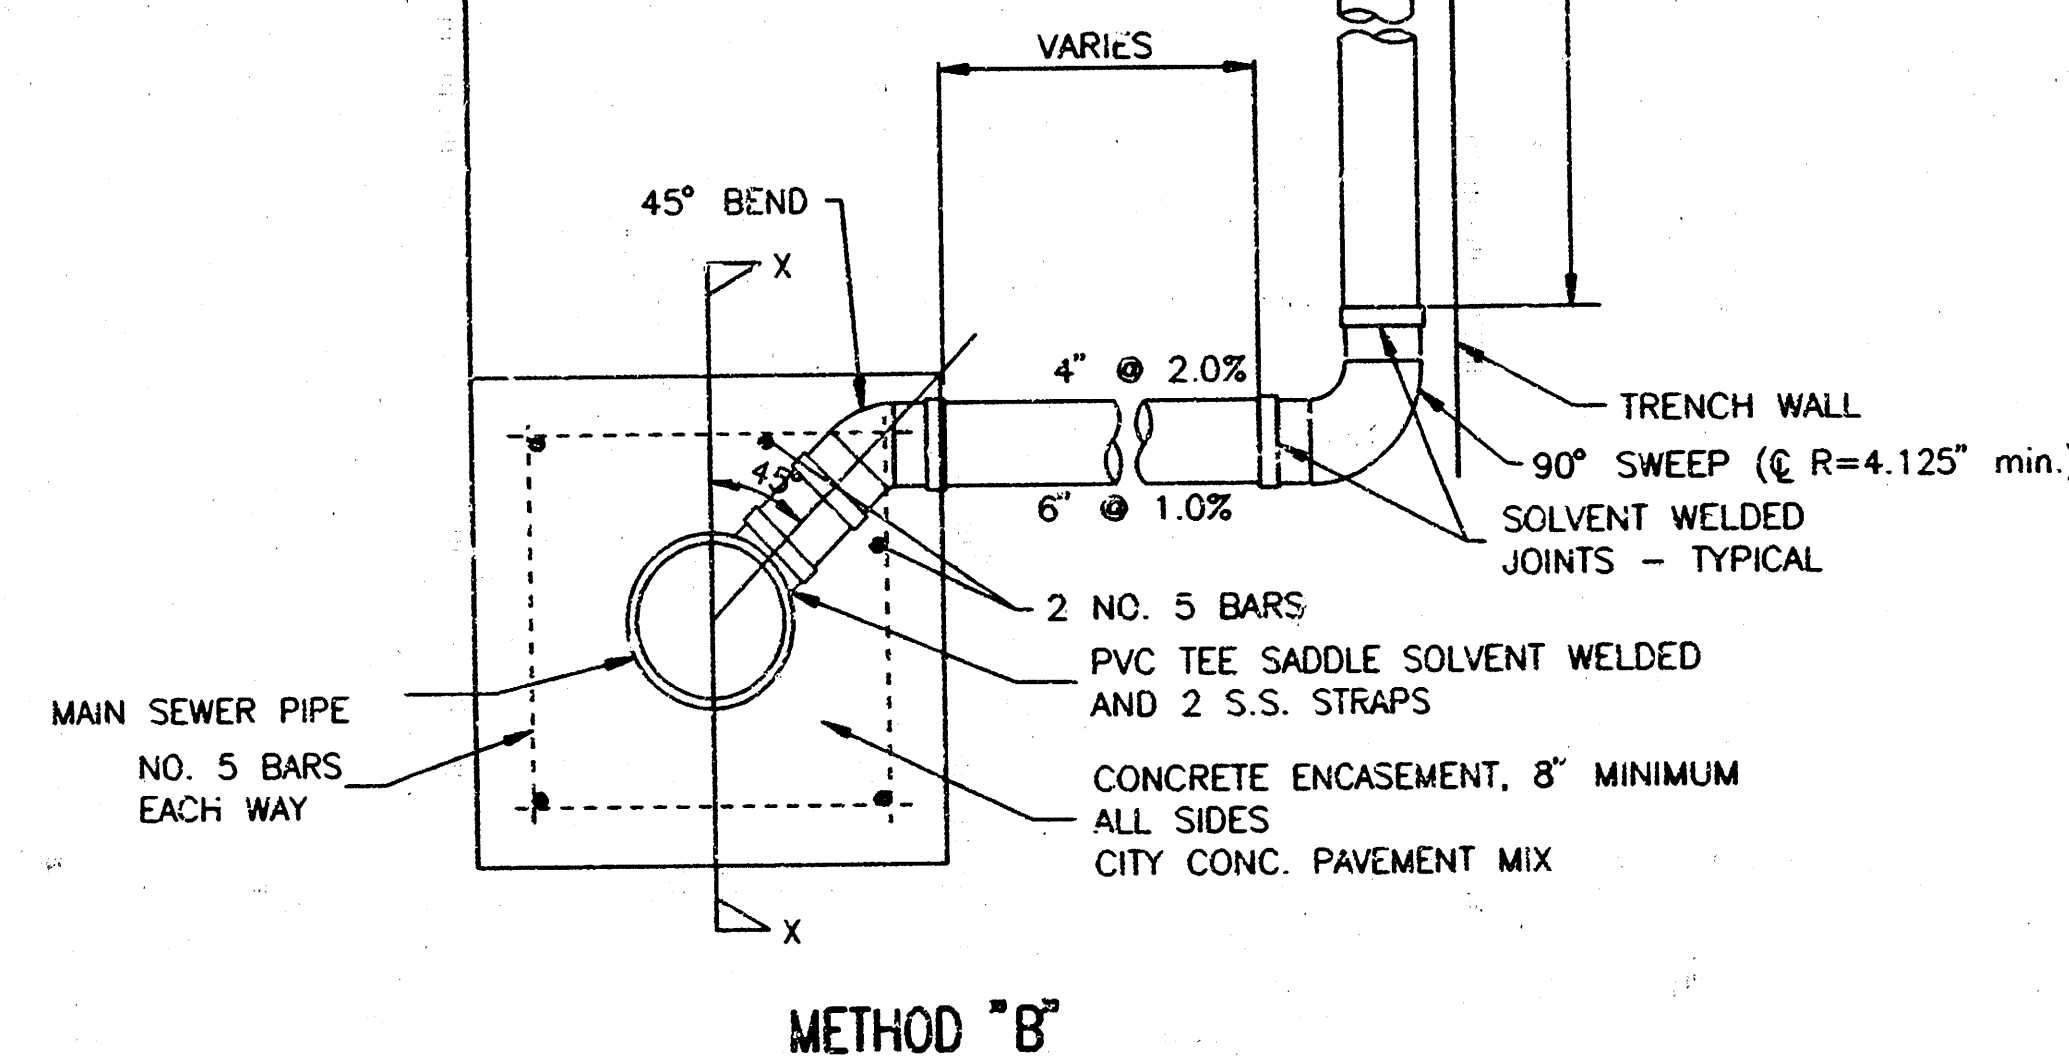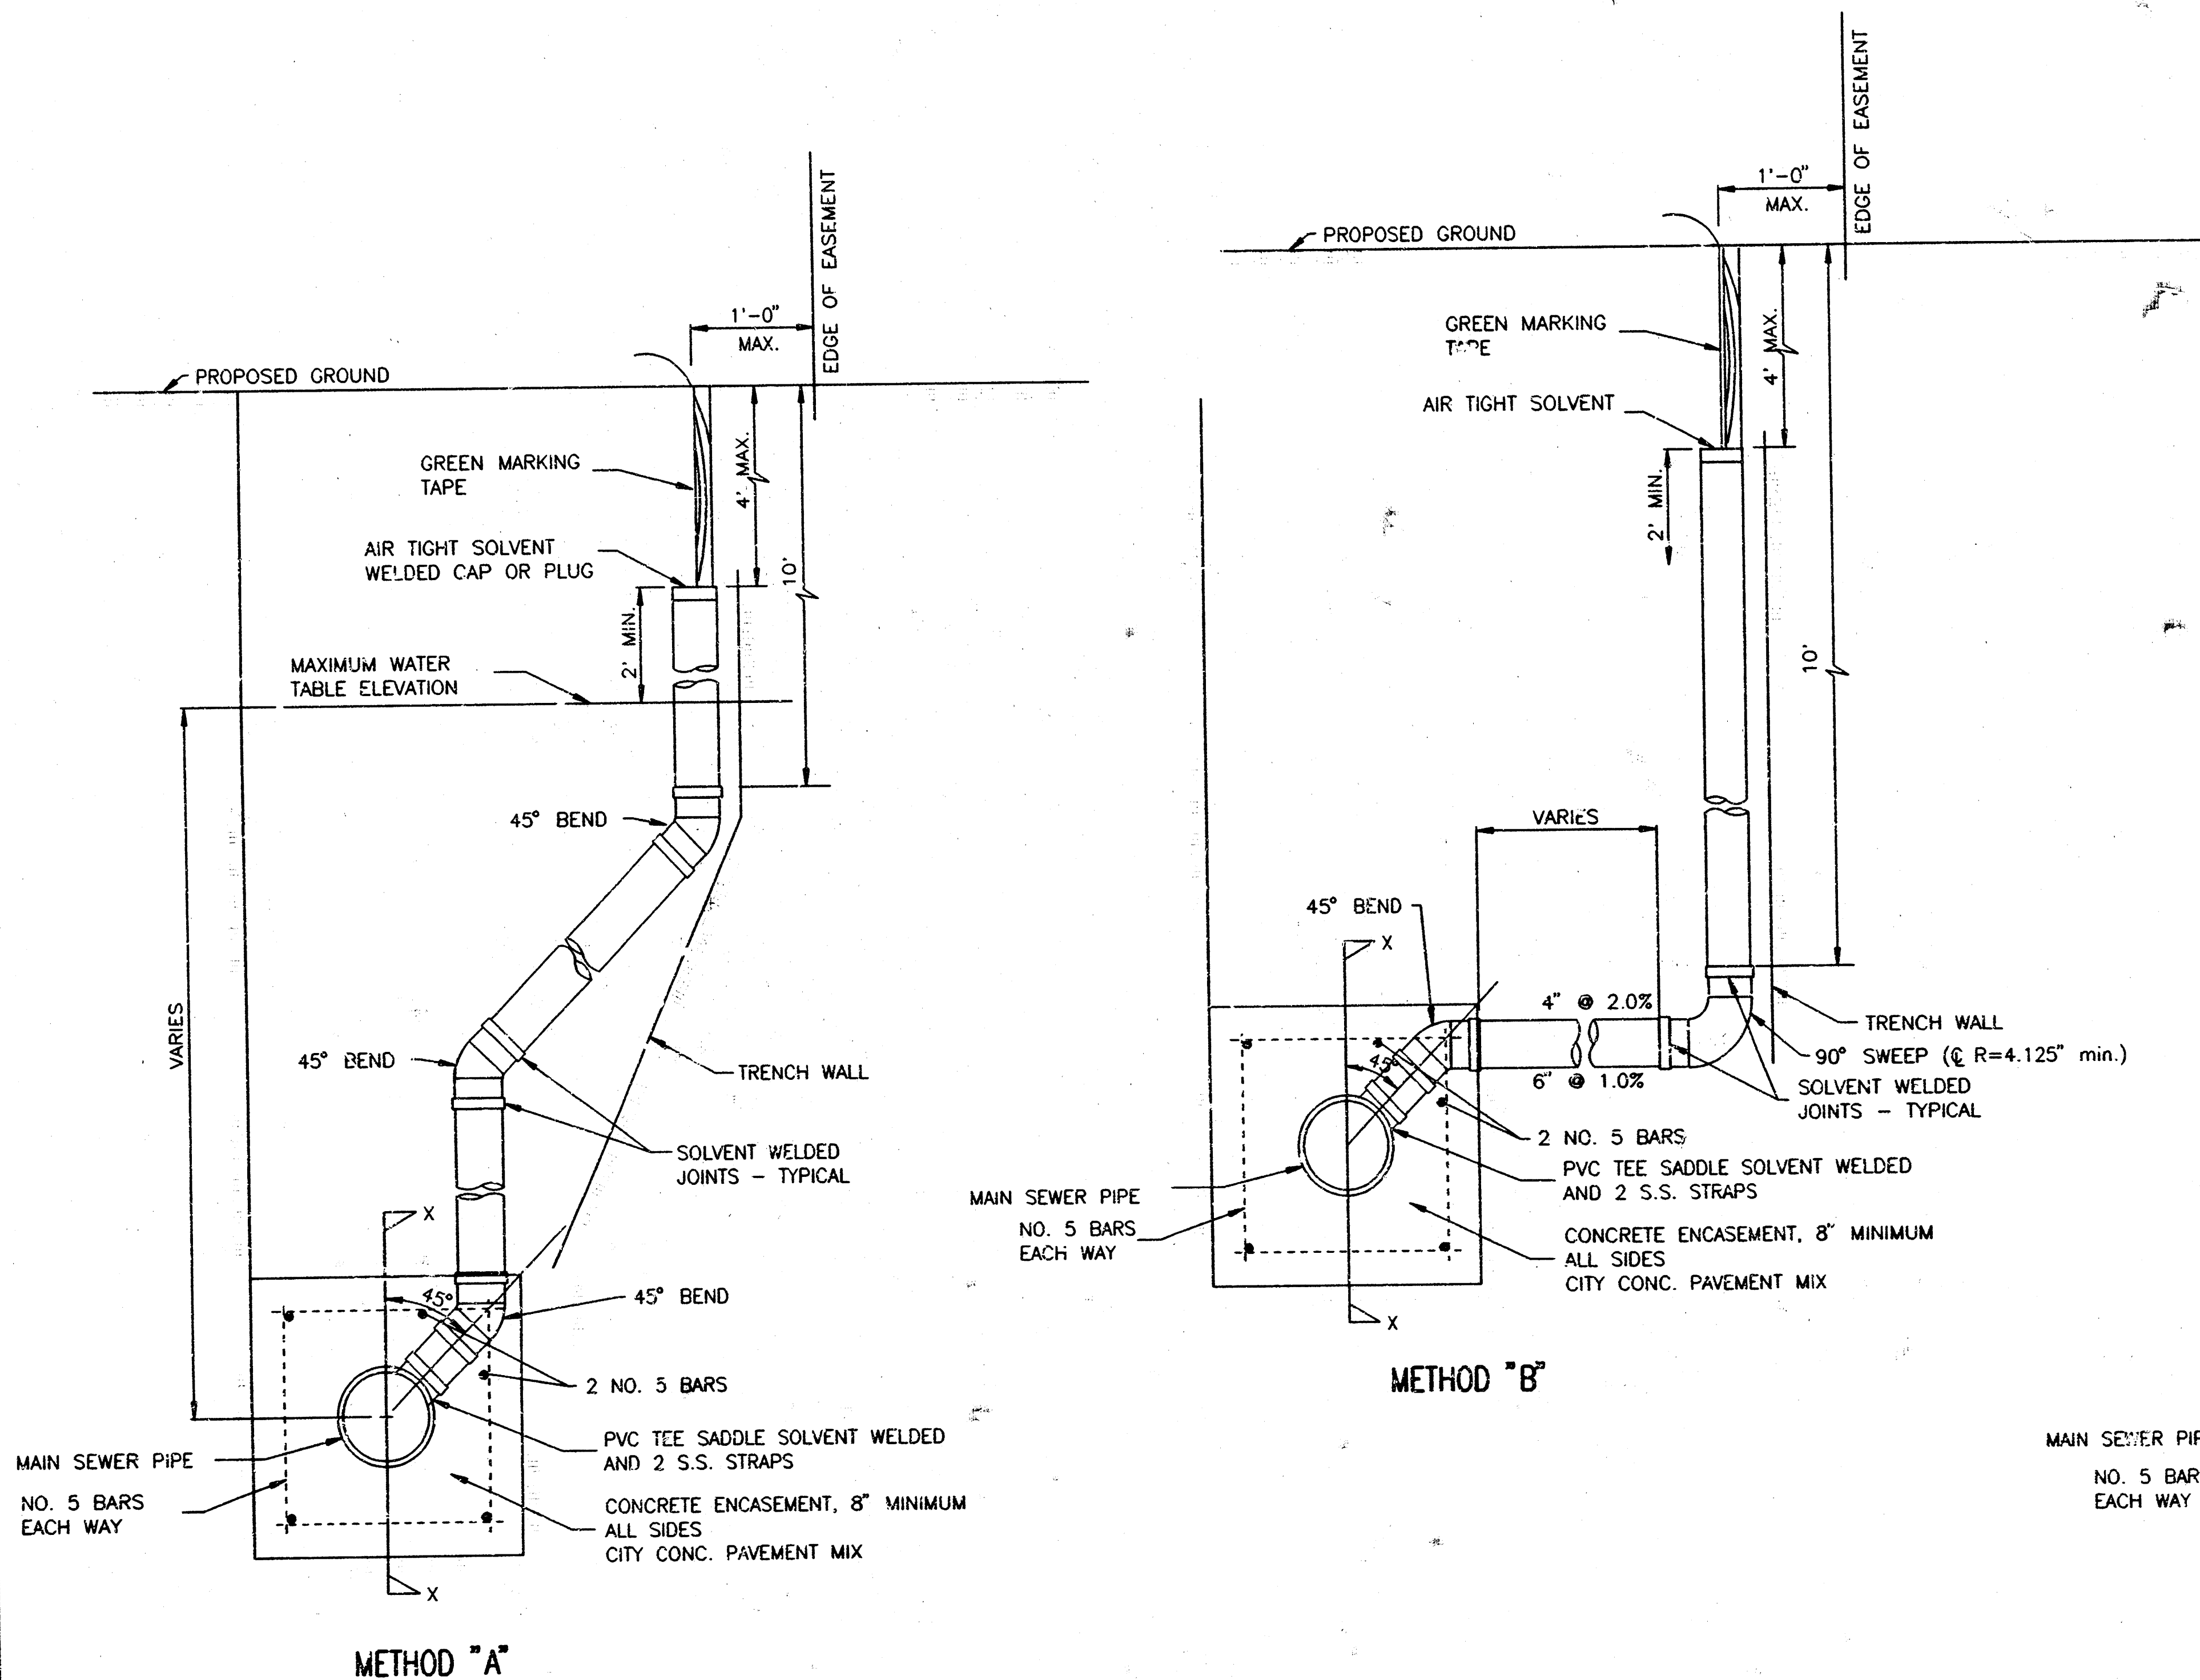

RECORD DRAWING

NOTE: RISER PIPE REQUIREMENTS AT MANHOLE STUBS SHALL BE SIMILAR TO THOSE SHOWN ABOVE.

THE CITY OF WICHITA CITY ENGINEER'S OFFICE CITY HALL - SEVENTH FLOOR 425 NORTH MAIN STREET WICHITA, KANSAS 67202 (316) 268-4114 FAX		VERTICAL RISER DETAIL M. E. LINDERAK P.E. - CITY ENGINEER PROJECT NUMBER: 468-82308 INDEX CODE: 743790 DATE: MAR 96 SHEET 9 OF 9	
--	--	---	--

DSNR: MOK OPER JLM SCALE: 1"=1.00' 01/1997/97852/002 RISERDITL 08:53:01 am