

Lat. 3, Main 18, S.W.I.
SANITARY SEWER IMPROVEMENTS

to serve
**Hickory Creek Estates
Phase II**

CITY OF WICHITA, KANSAS

Michael E. Lindelak, P.E. City Engineer

Project Number

488-76-245-82882-000-000-001

Index Code:

743047

Sheet Index

Title Sheet	1
Lines 1 & 2	2
Lines 3 & 4	3
Line 5	4
Easement Grading Plan	5-6
Standard Manhole Detail	7
Shallow Manhole Detail	8
Ring & Cover Detail	9
4" Vertical Riser Detail	10
Copy of Plat	11

BENCHMARKS:

□ Cut on Top of Curb Return at Southwest Corner of Hickory Creek and Hickory Creek Ct. at Northeast Corner of Lot 26, Block 2.

Elevation = 160.01 City Datum

□ Cut on Top of Curb at PC on Hickory Creek at East Side of Lot 9, Block 3.

Elevation = 162.21 City Datum

□ Cut on South Edge of Concrete Entrance to Lift Station 0.5± East of East Edge of Manhole Adjacent to Northwest Corner of Lot 1, Block 5.

Elevation = 155.60 City Datum


GENERAL NOTES:

- Contractor will be required to provide notice to utility companies a minimum of twenty-four (24) hours prior to any excavation, as follows:
Kansas One-Call 687-2470
The Contractor must notify the following in case of an emergency:
Multimedia Cablesation 262-0861
K.P.L. Gas Service Company 383-8650
Kansas Gas & Electric Company 383-8600
Peoples Gas Company 942-8350
Southwestern Bell Telephone Company 1-571-2611
City of Wichita Water Dept. 268-4909
City of Wichita Traffic Engineering 269-4446
- Underground utility service lines and overhead utility pole lines are to be adjusted as necessary by others prior to construction unless the plans specifically call for their adjustment by the Contractor or unless the plans specifically identify a utility to be adjusted by its owner during construction. Existing utilities and their location, as shown on the plans, represent the best information obtainable for design. The Contractor will be required to work around existing utilities within the right-of-way which do not conflict with proposed construction.
- Trees and shrubs in public right-of-way which are in direct conflict with proposed new construction shall be removed by the Contractor with the Engineer's approval. Trees and shrubs which are not in direct conflict with proposed new construction shall be saved and protected from damage.
- The Contractor shall give all property owners and/or tenants of developed property abutting the construction of this project a minimum of ten (10) days advance notice prior to start of construction.
- The Contractor shall be responsible for preserving property irons. The Contractor will be required to re-establish any property irons which are damaged or destroyed by his construction operations. Such irons shall be re-established by a licensed land surveyor in accordance with state laws.
- Contractor shall grade the sanitary sewer alignment to the profile and elevations shown on the easement grading plans. All costs for grading shall be paid as lump sum for easement grading.
- All areas disturbed by construction operations shall be seeded with rye grass at a rate of 300 lbs/acre immediately following construction in that area. Prior to seeding, area shall be prepared per City specs.
- When connecting to existing manhole or stub, the contractor shall reshape manhole bottom or adjust the existing stub's alignment or elevation as necessary. Cost shall be subsidiary to project.
- The Contractor shall be responsible for maintaining continuous flow of sewage through construction. Contractor's proposed method for maintaining sewage flow shall be approved by the Engineer. Cost of maintaining flow of sewage through construction will not be paid for directly and this cost shall be considered as subsidiary to the other pay items of work.


Booked
N. 268
8/20/97
RDL

Scale: 1" = 150'


Benefit District

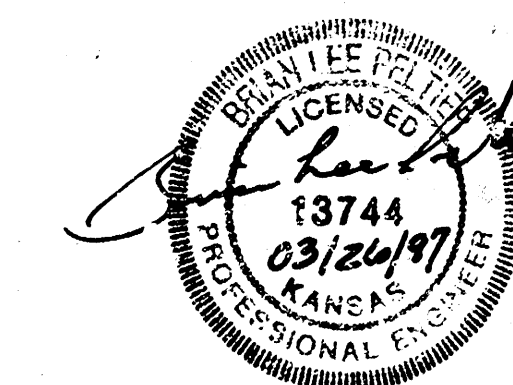

PROJECT INSPECTOR L. AMERL - BAUGHMAN CO., P.A.
REGISTERED 6/14/97 BY BAUGHMAN CO., P.A.
BAUGHMAN COMPANY P. A.
ENGINEERING & SURVEYING
316/282-7271 • 315 ELLIS • WICHITA, KANSAS 67211

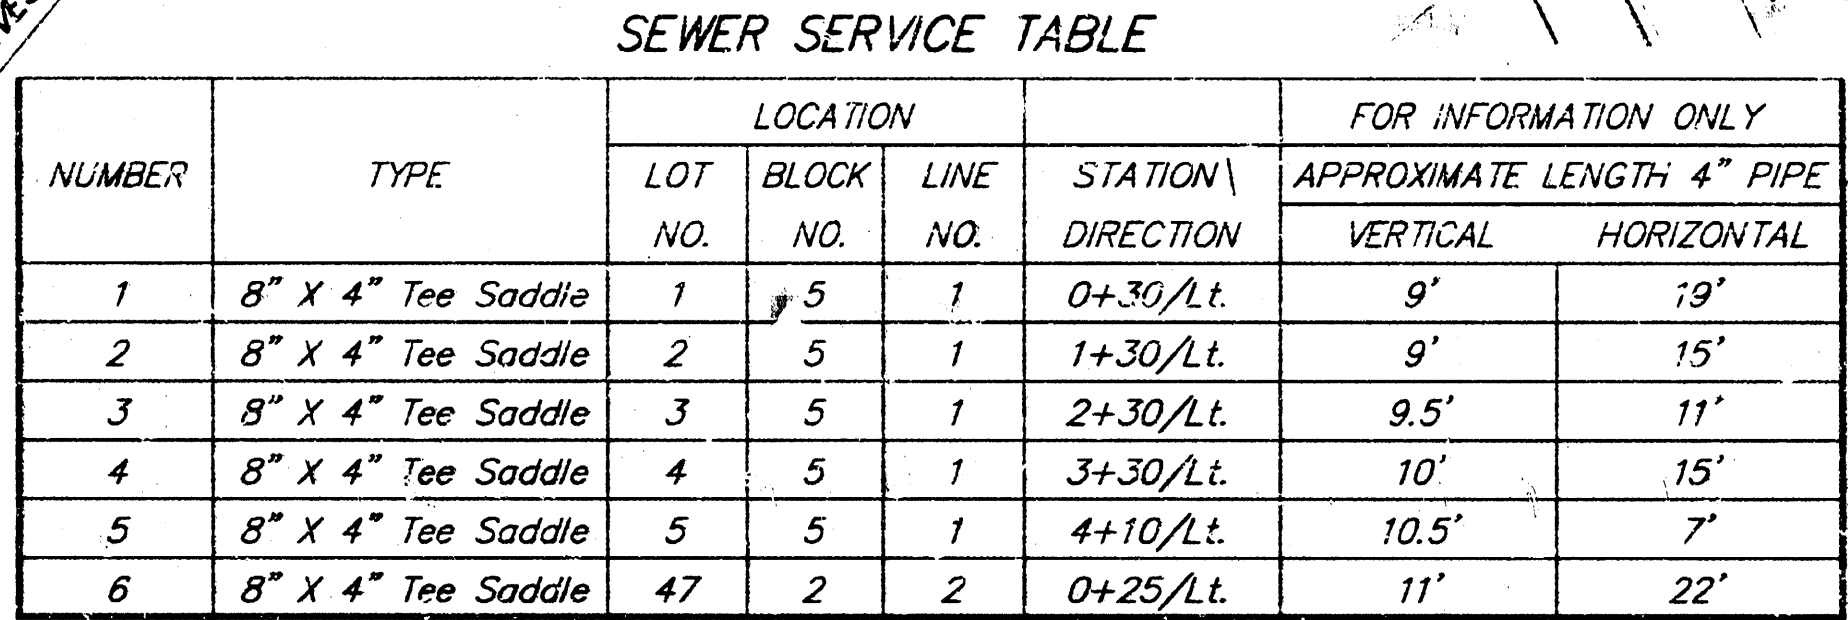

NOTE: Vertical Riser Pipe shall be extended to 2' minimum above ground water elevation and 4' maximum below proposed ground elevation.

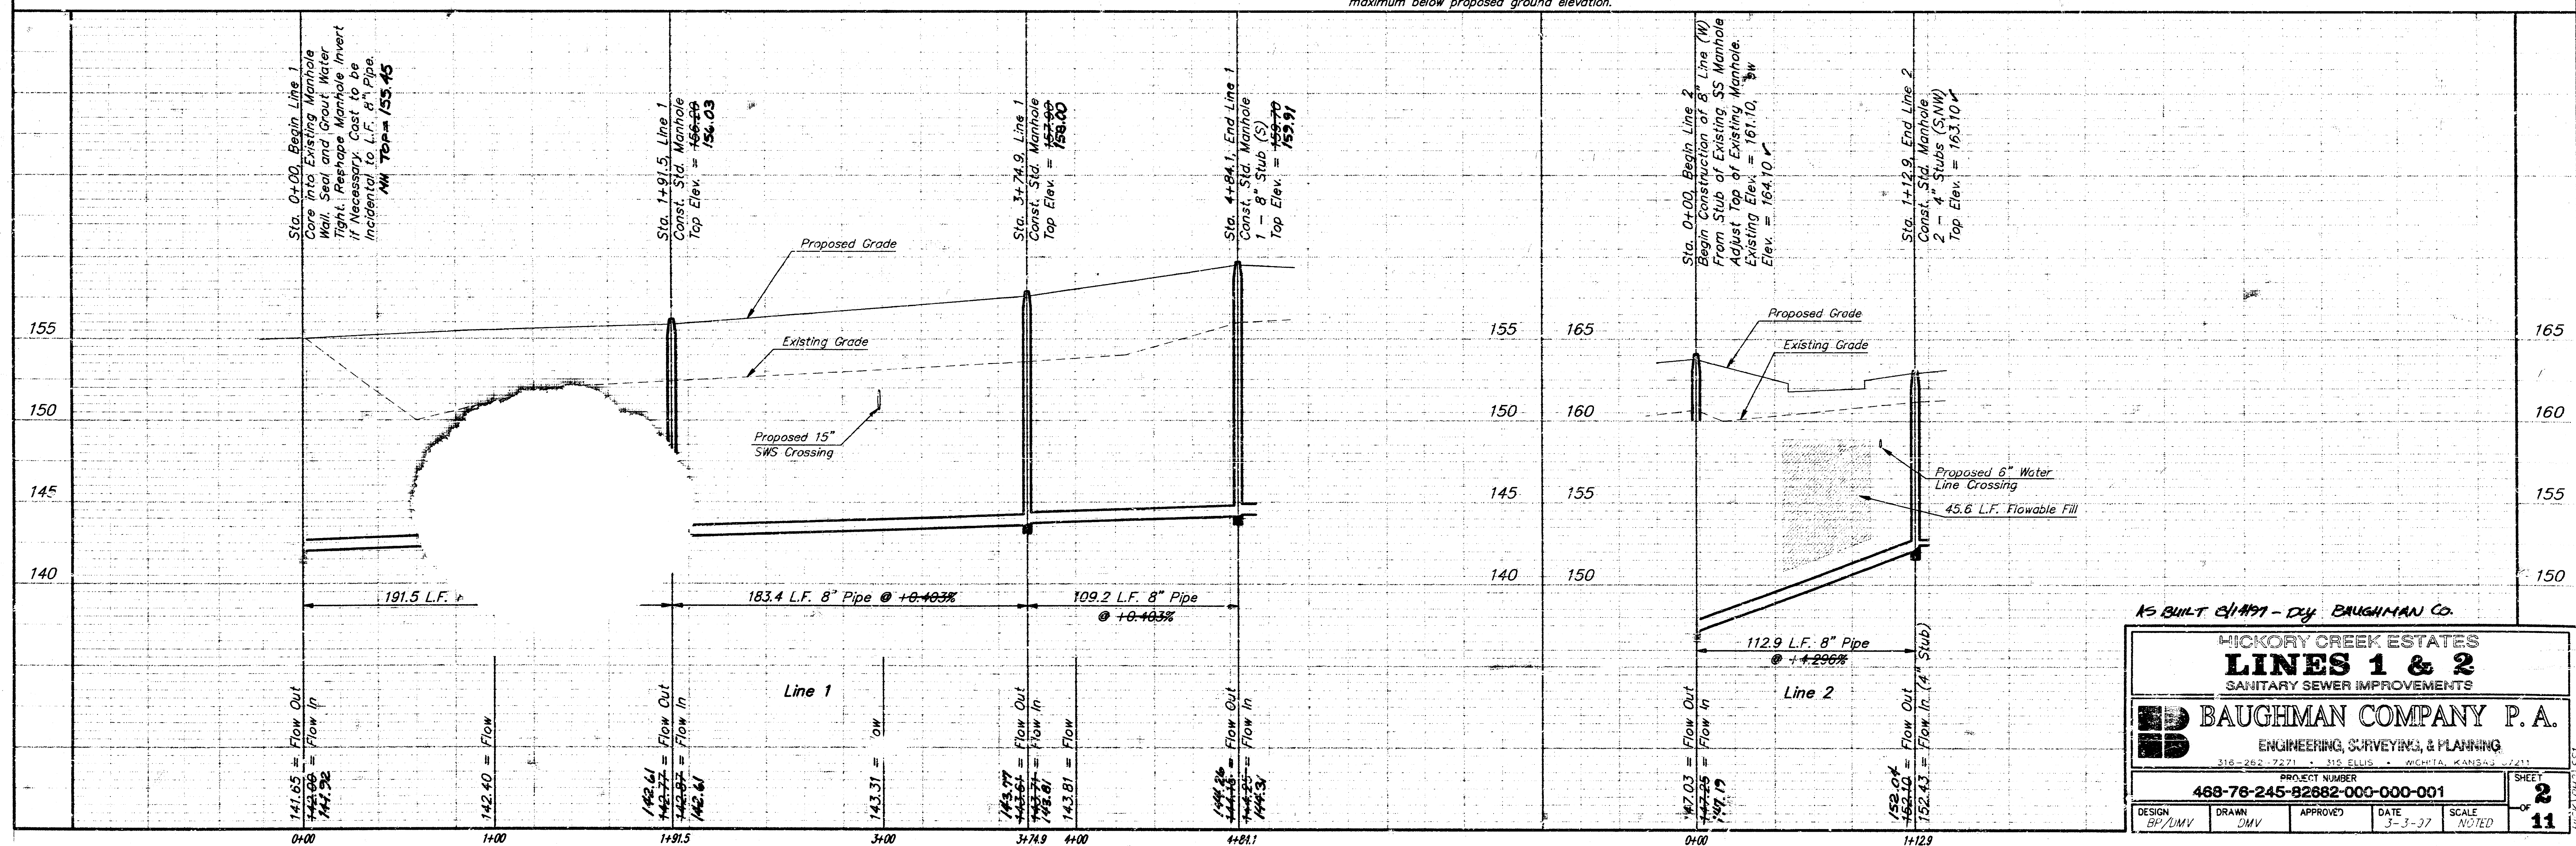

Benchmarks:


Nail in Highline Pole Located
600' West and 31' North of the
North 1/4 Corner, Section 13,
TWP. 27-S, R-2-W.

Elevation = 153.56 City Datum

"Cut on East Cap of North
Side of Bridge Located 1350'
East of North 1/4 Corner,
Section 13, TWP. 27-S, R-2-W.

Elevation = 150.03 City Datum

Scale: 1" = 40' Horizontal
1" = 5' Vertical
• = Iron

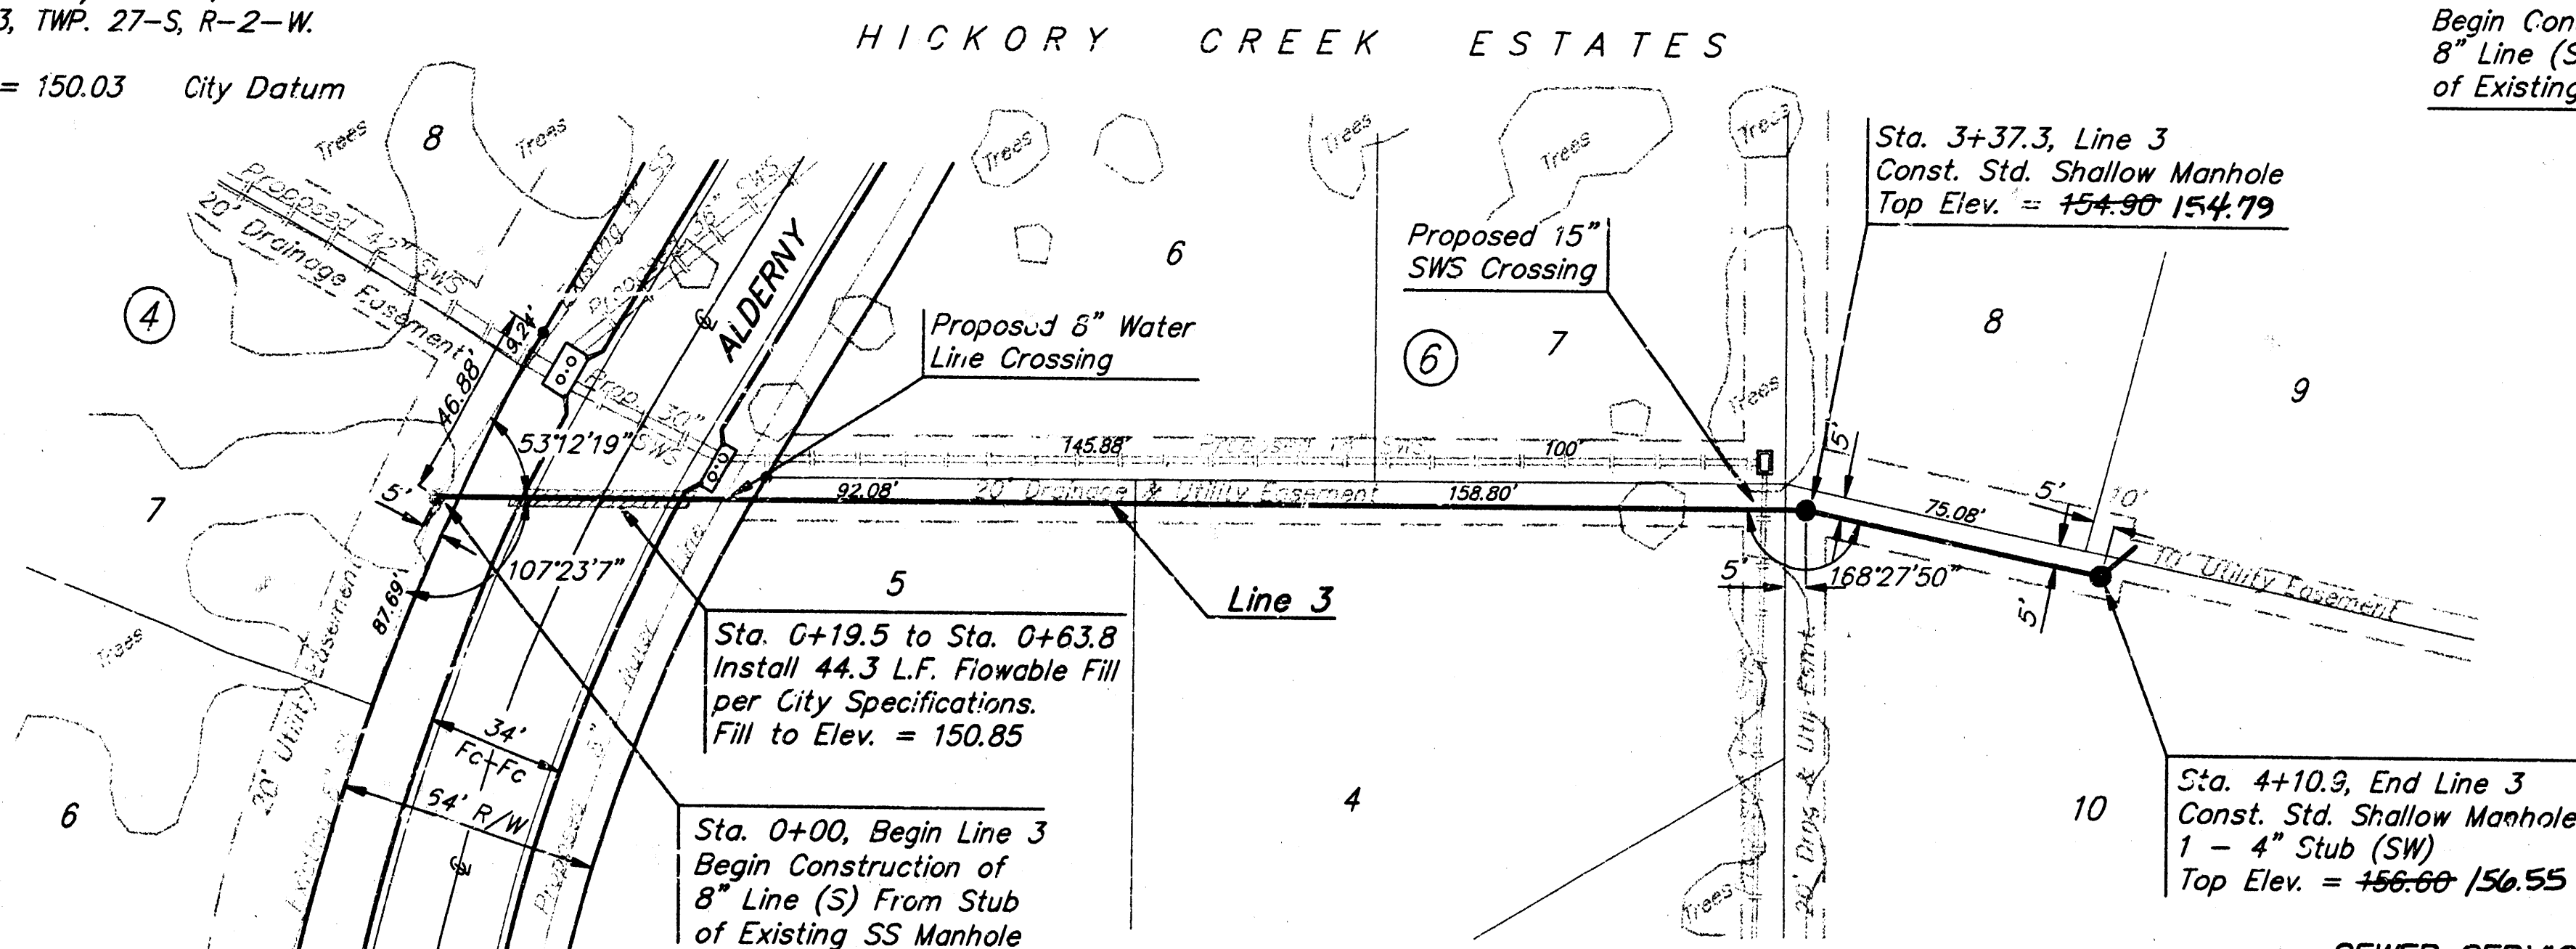


SEWER SERVICE TABLE

NUMBER	TYPE	LOCATION		STATION\ DIRECTION	FOR INFORMATION ONLY	
		LOT NO.	BLOCK NO.		APPROXIMATE LENGTH 4" PIPE	
7	8" X 4" Tee Saddle	1	6	1+00/Lt.	10.5'	4.1'
8	8" X 4" Tee Saddle	14	5	1+40/Rt.	9.5'	16.3'
9	8" X 4" Tee Saddle	2	6	1+60/Lt.	9'	3.6'


NOTE: Vertical Riser Pipe shall be extended to 2' minimum above ground water elevation and 4' maximum below proposed ground elevation.

HICKORY CREEK ESTATES

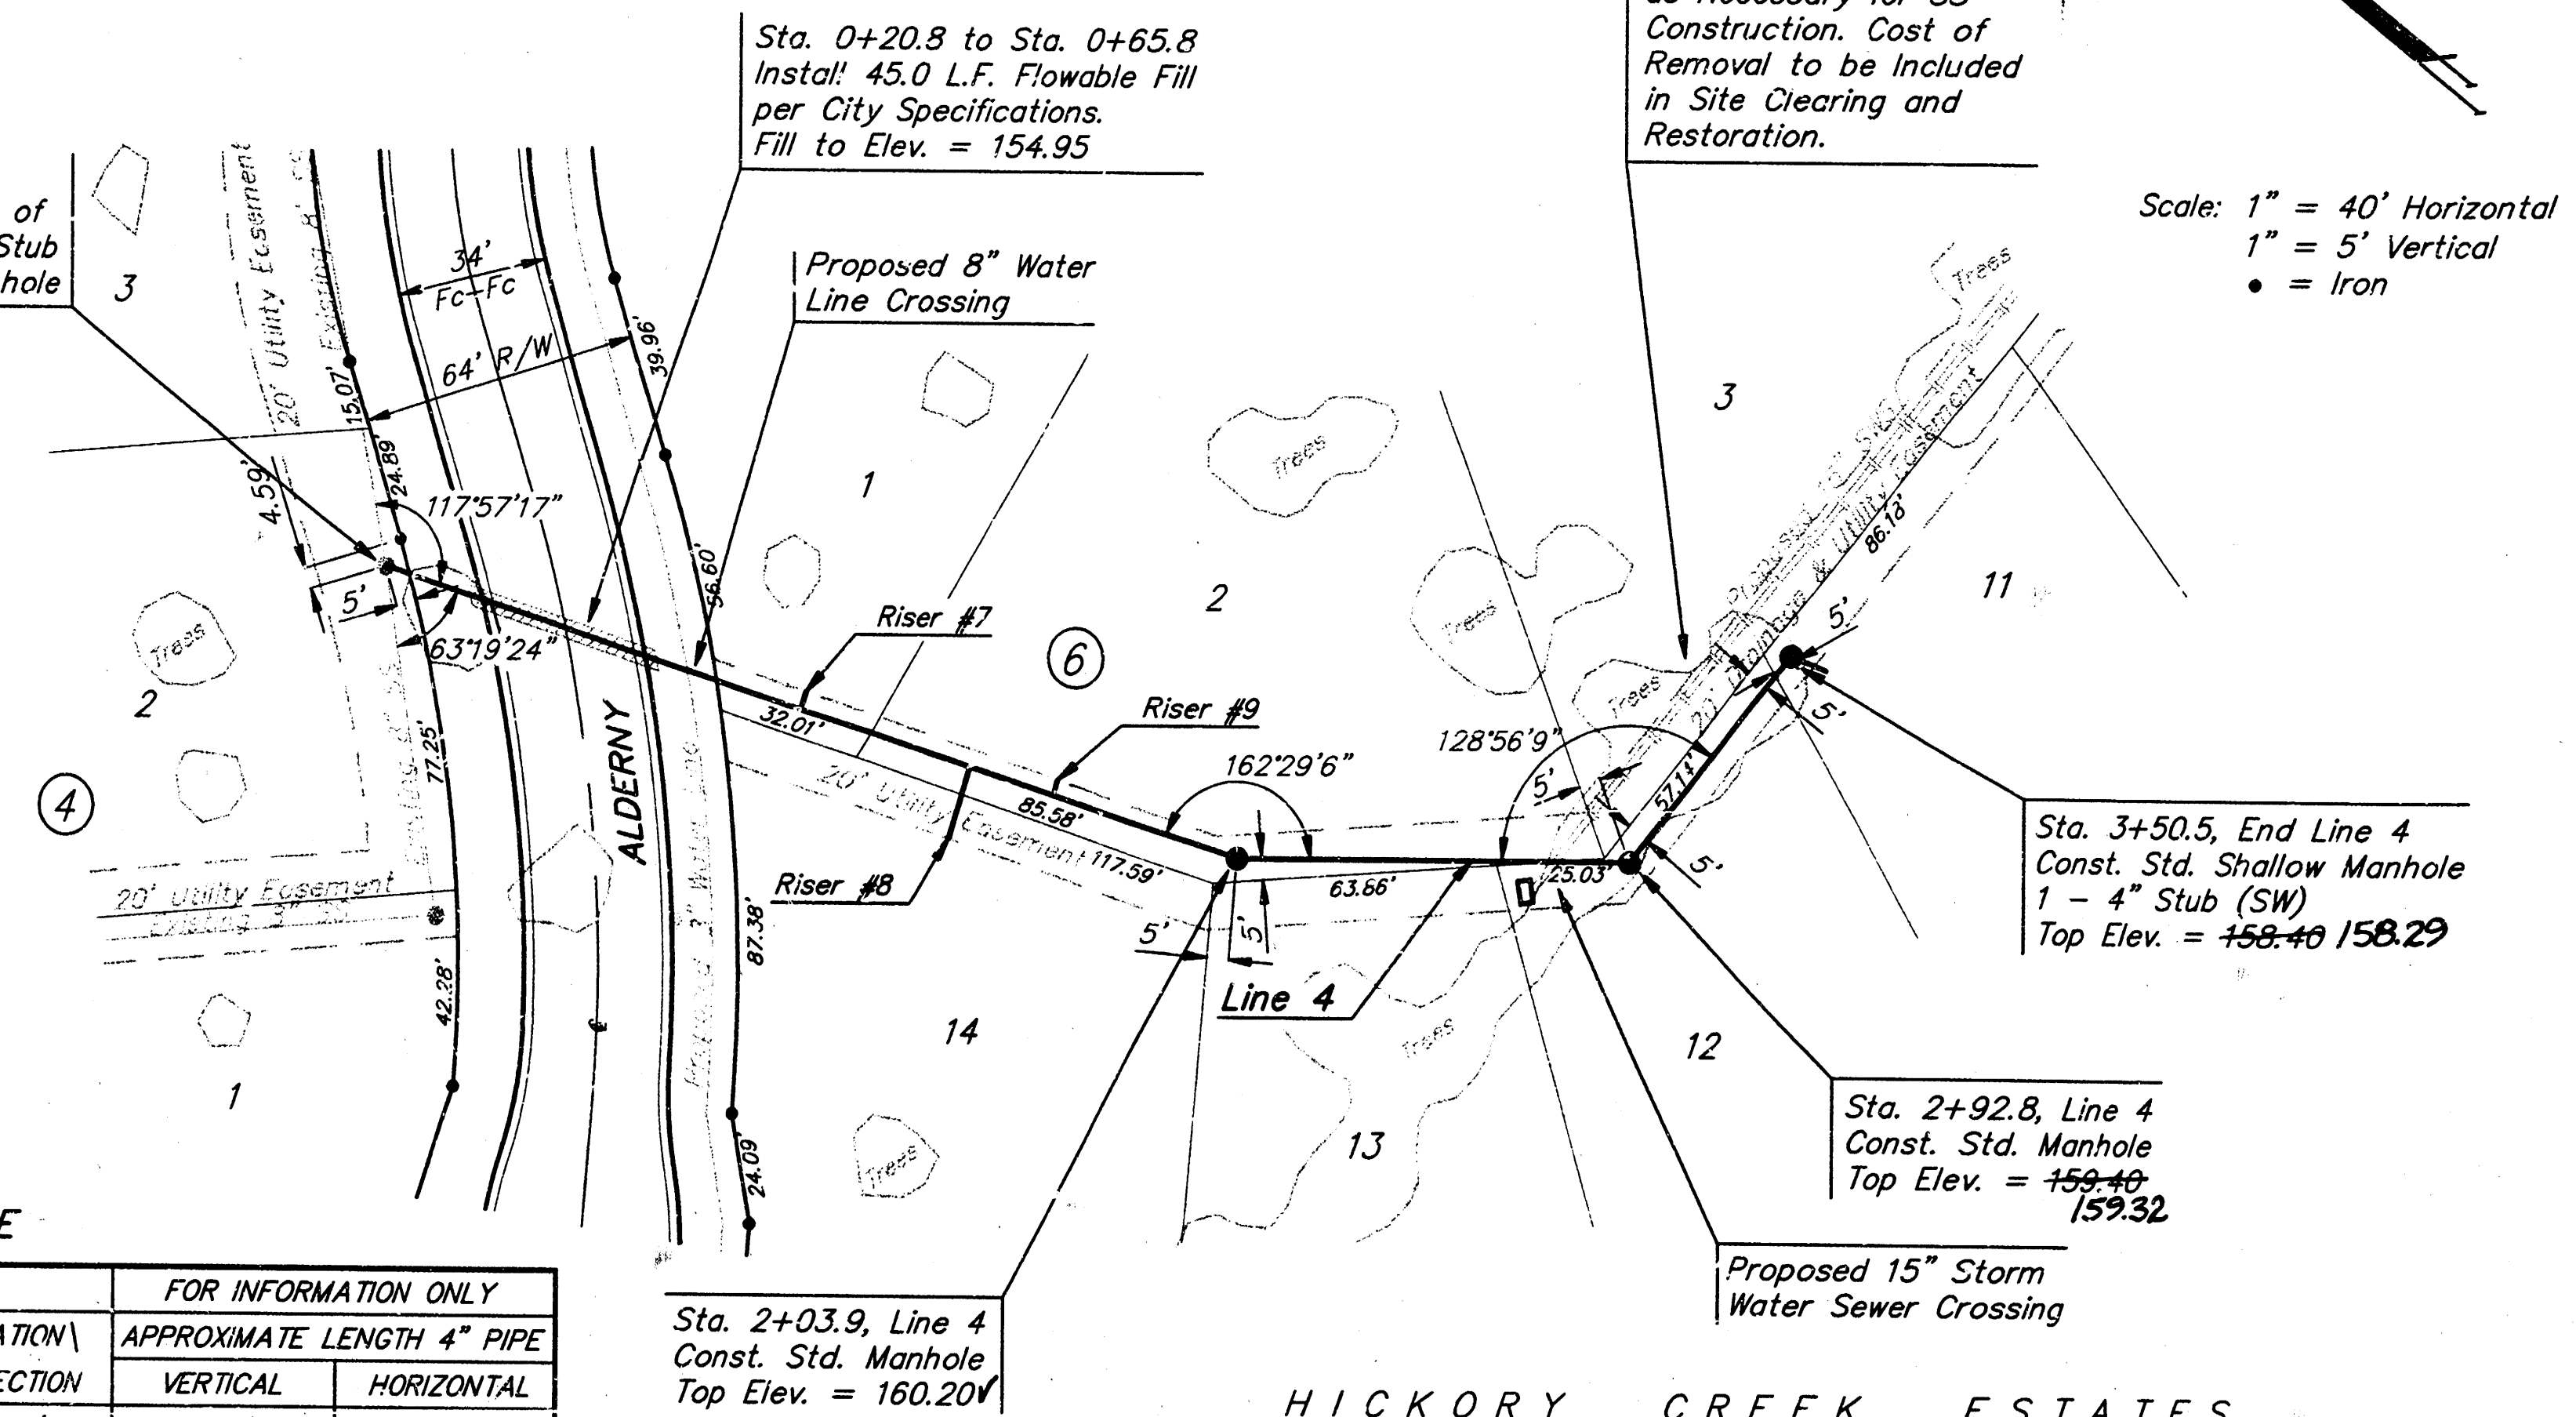

Scale: 1" = 40' Horizontal
1" = 5' Vertical
• = Iron

HICKORY CREEK ESTATES

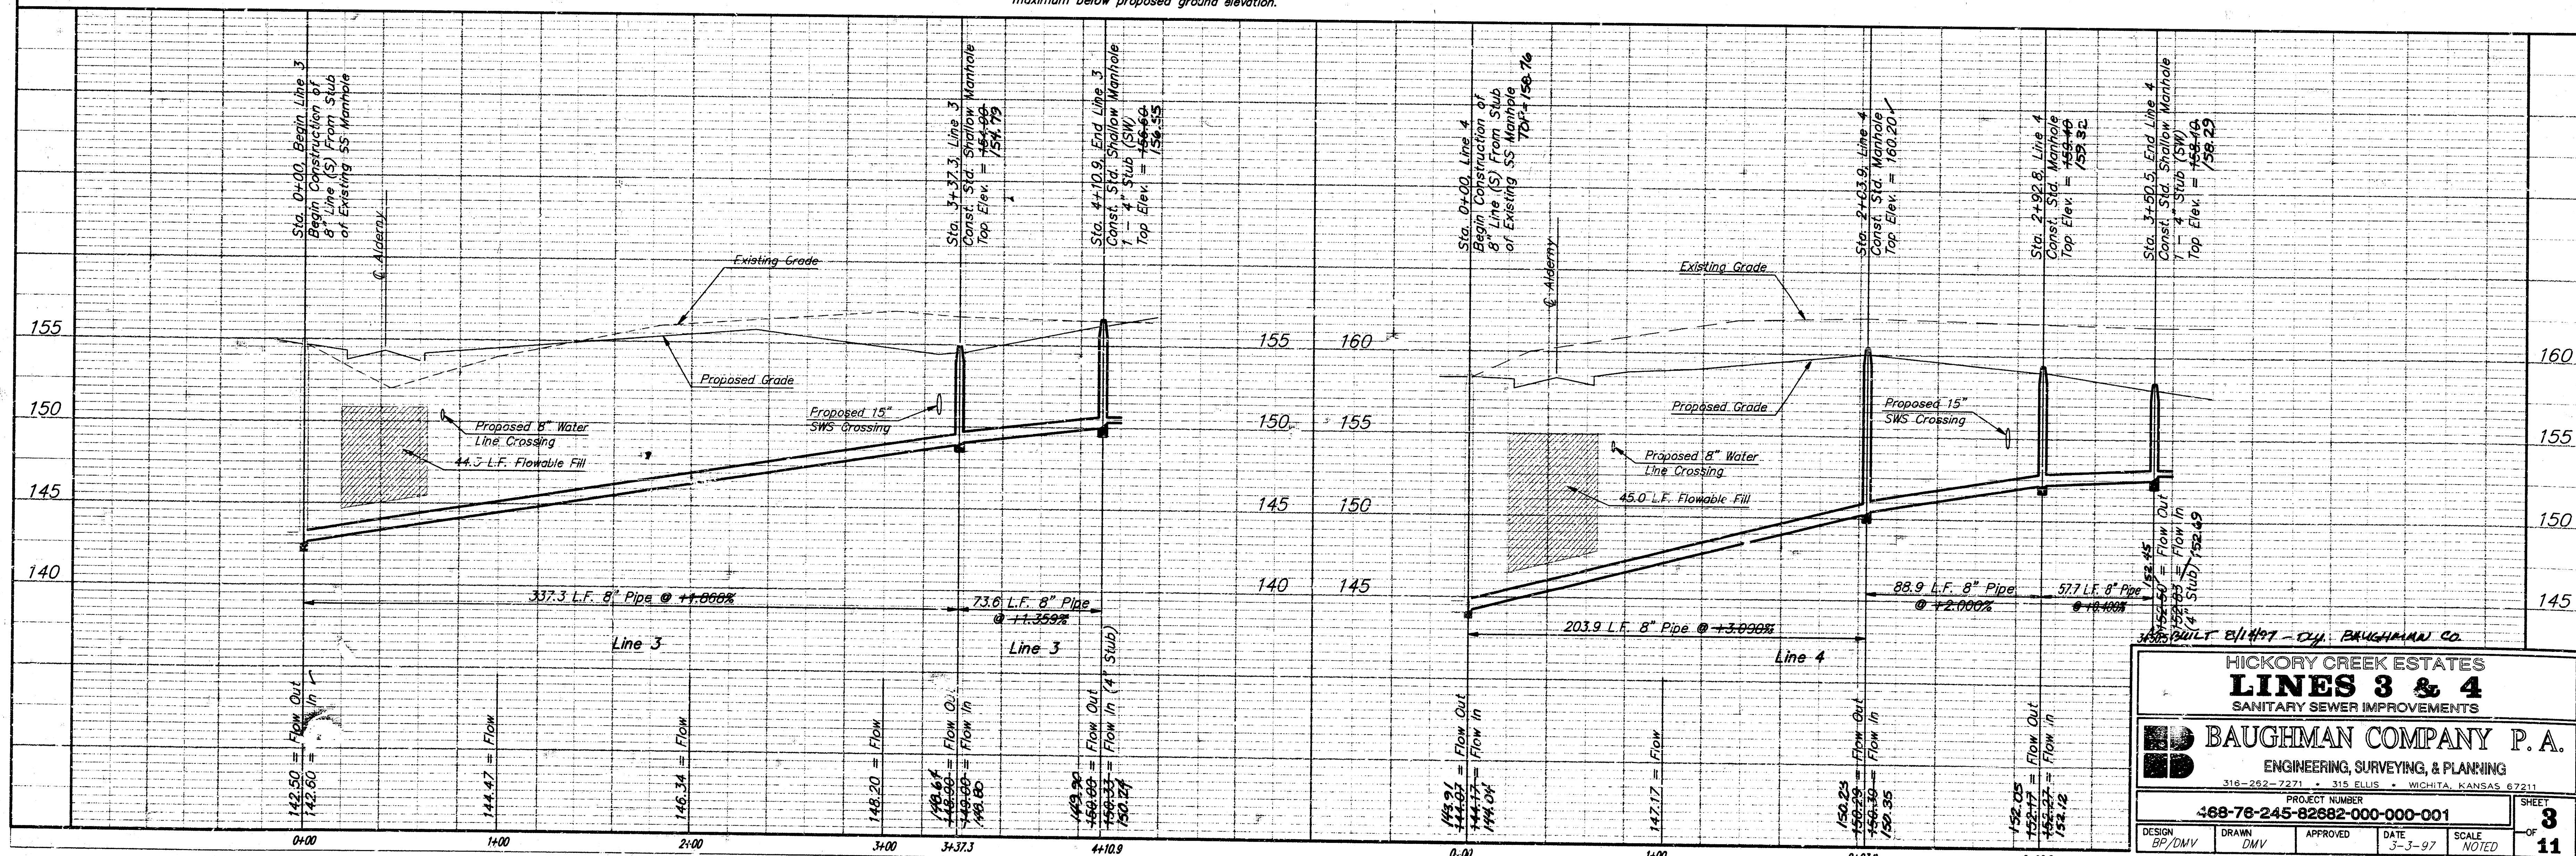

HICKORY CREEK ESTATES LINES 3 & 4 SANITARY SEWER IMPROVEMENTS			
BAUGHMAN COMPANY P.A. ENGINEERING, SURVEYING, & PLANNING 318-282-7371 1115 ELLIS • WICHITA, KANSAS 67211			
PROJECT NUMBER 468-76-245-82682-000-001		SHEET 3 OF 11	
DESIGN BP/DMV	DRAWN DMV	APPROVED	DATE 3-3-97
SCALE NOTED			


Benchmarks:

Neil in Highline Pole Located
600' West and 31' North of the
North 1/4 Corner, Section 13,
TWP. 27-S, R-2-W.


Elevation = 153.56 City Datum

"C" Cut on East Cap of North
Side of Bridge Located 1350'
East of North 1/4 Corner,
Section 13, TWP. 27-S, R-2-W.

Elevation = 150.03 City Datum

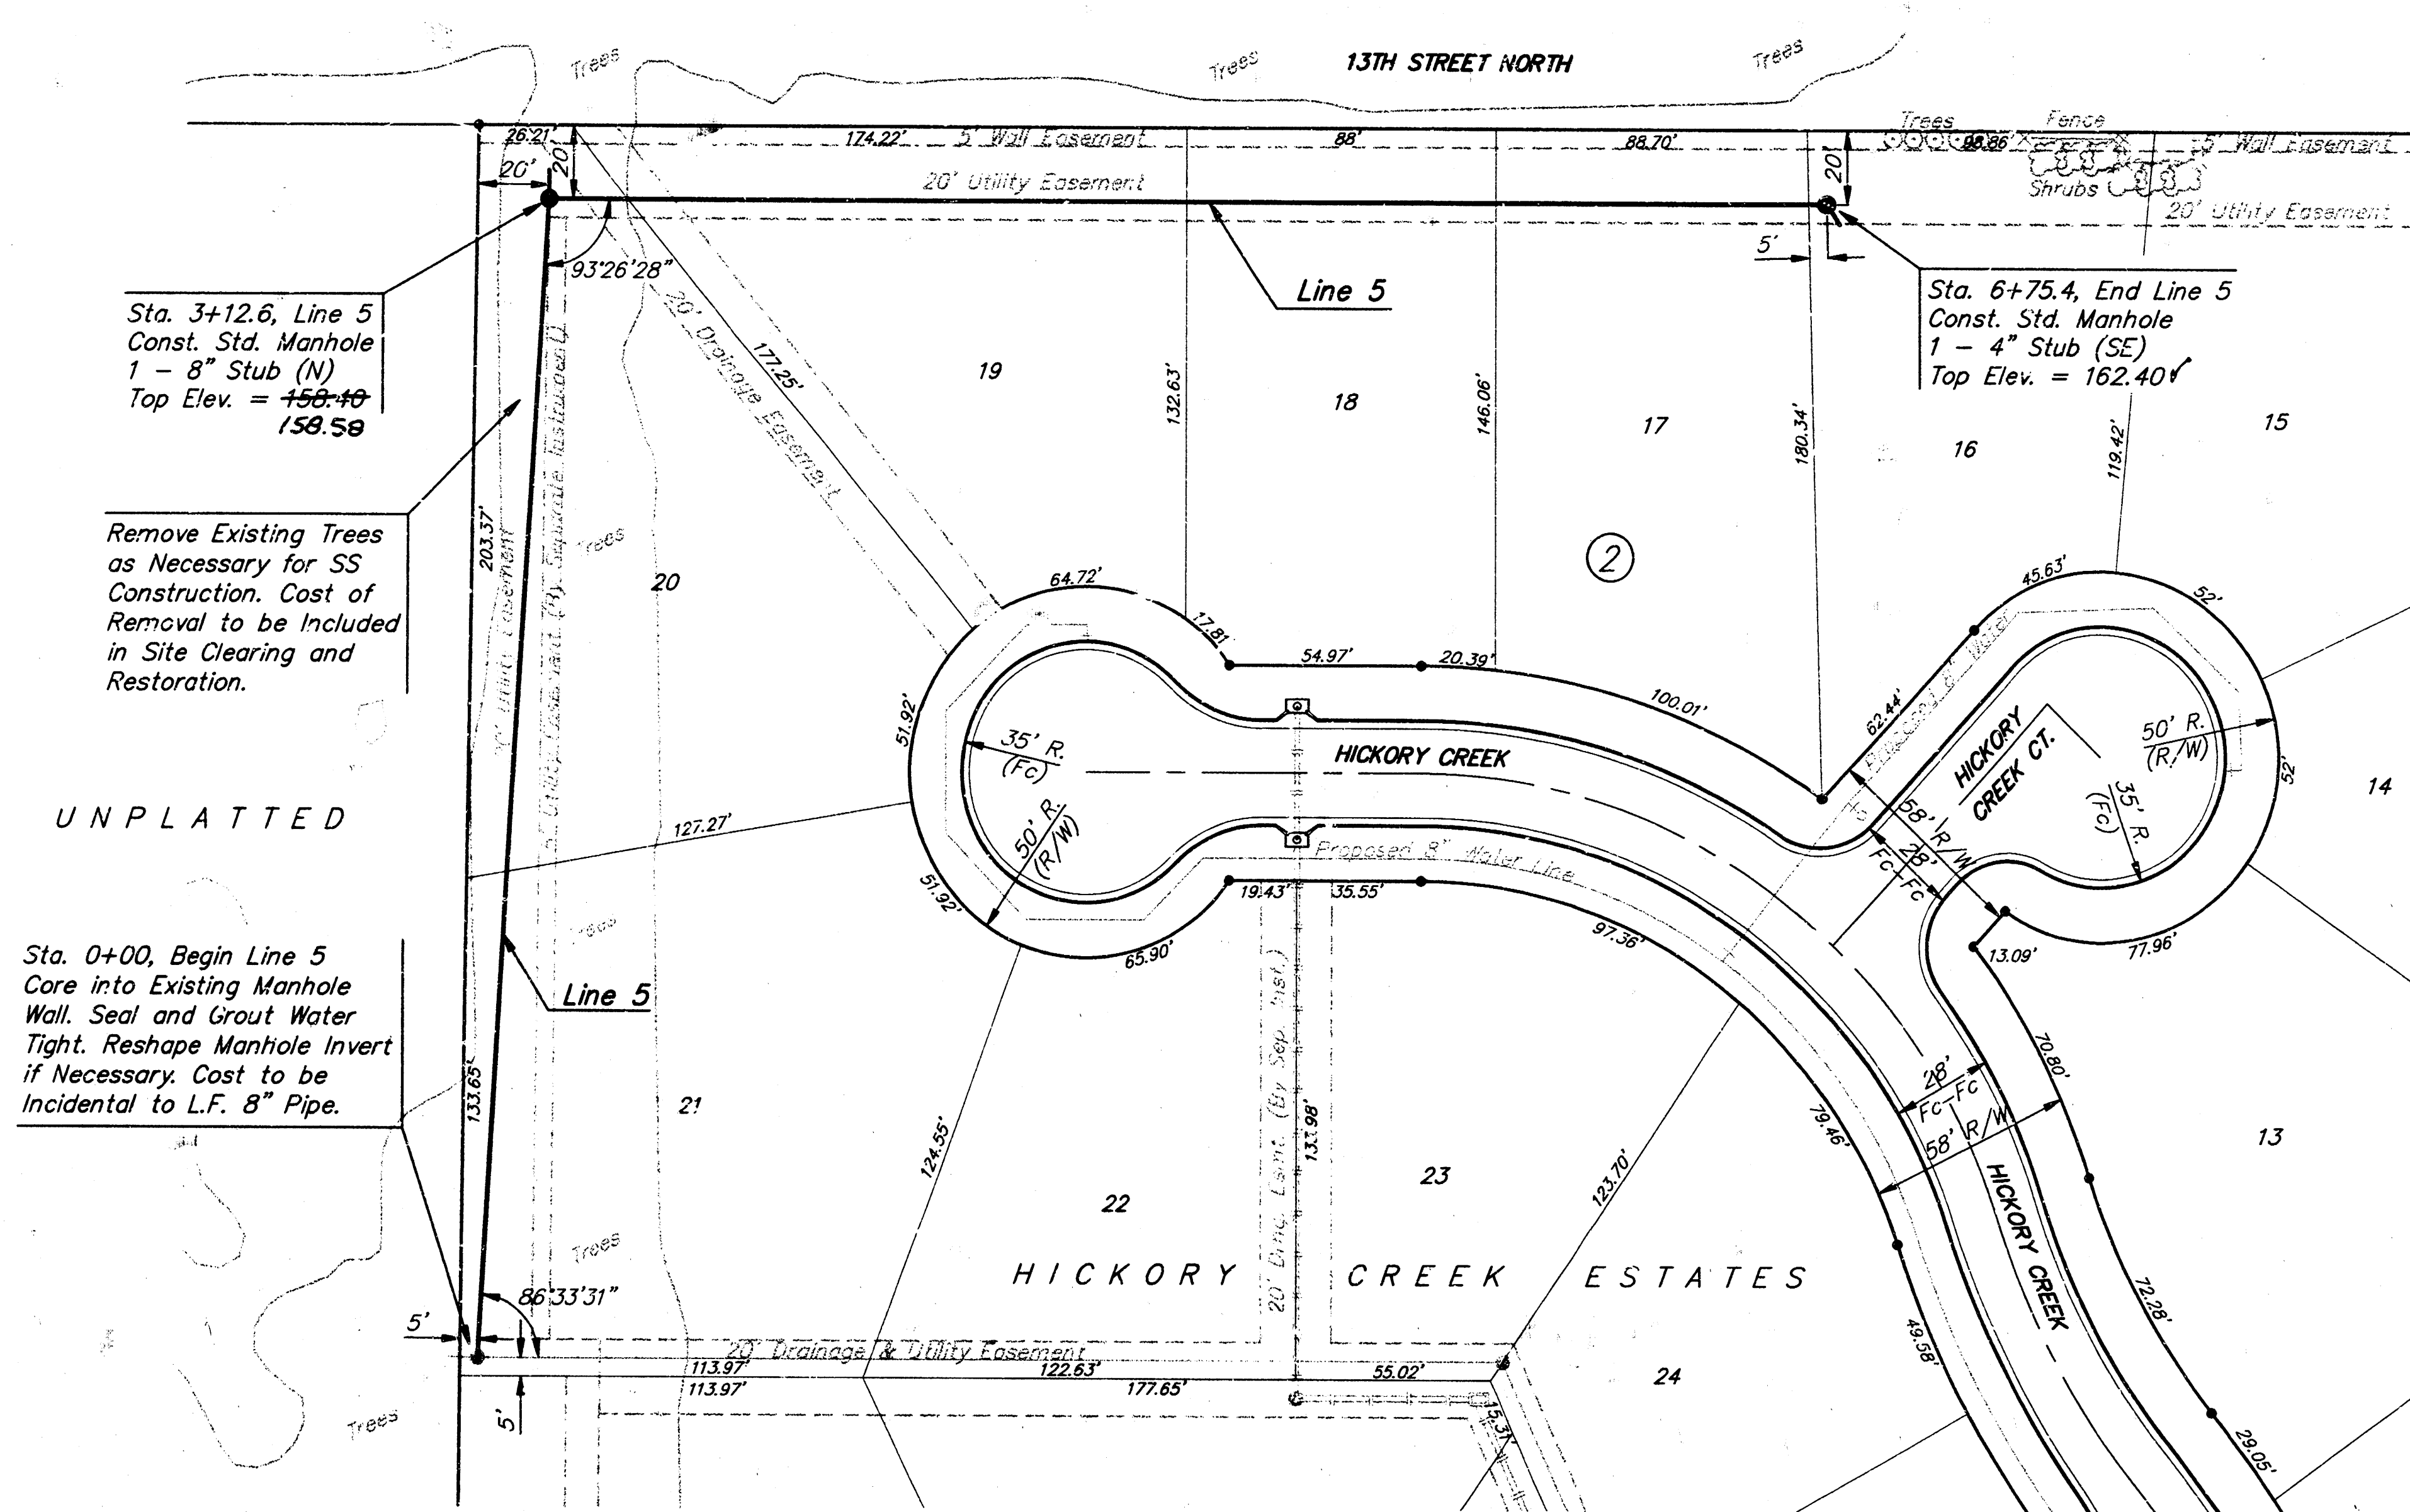

Scale: 1" = 40' Horizontal
1" = 5' Vertical
• = Iron

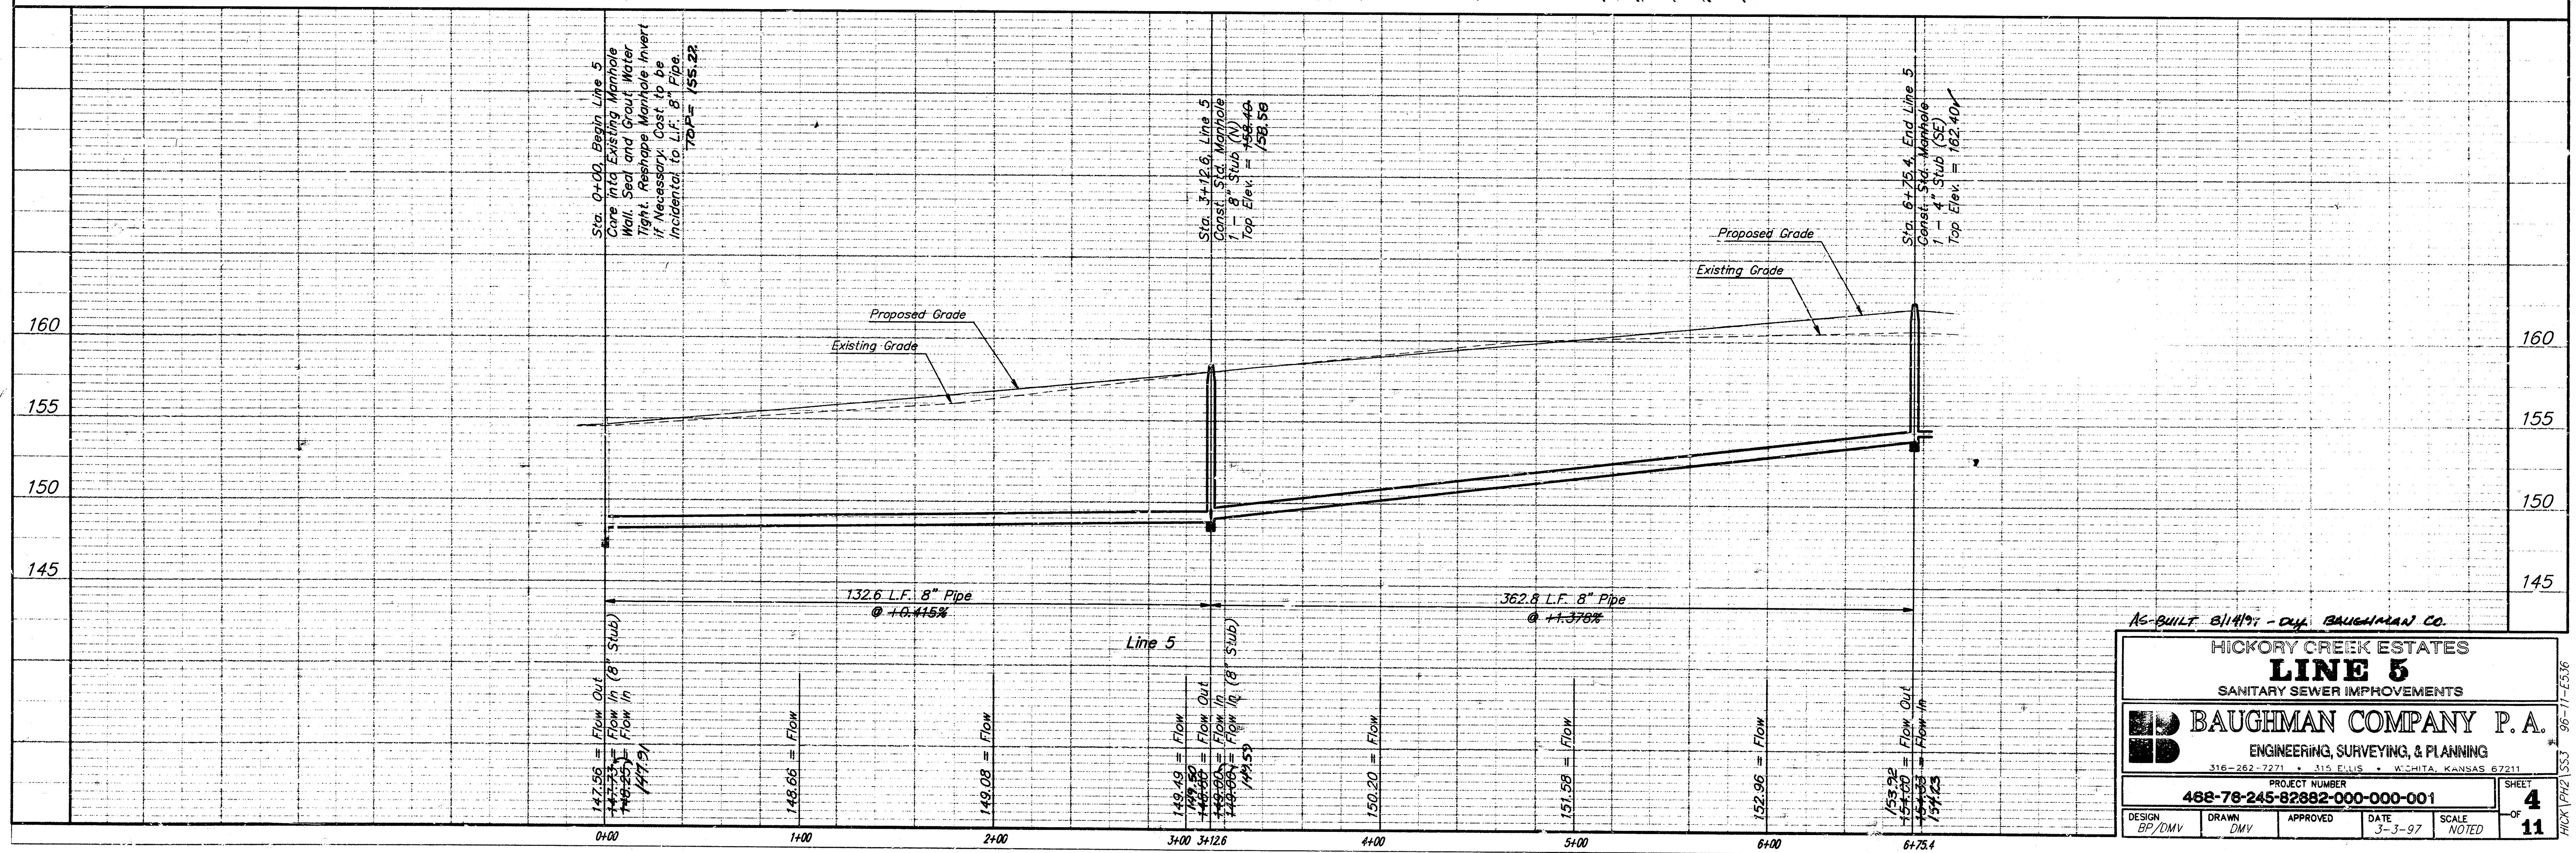


As-Built 8/14/97 - D.M. BAUGHMAN CO.

HICKORY CREEK ESTATES
LINE 5
SANITARY SEWER IMPROVEMENTS

BAUGHMAN COMPANY P.A.
ENGINEERING, SURVEYING, & PLANNING
316-262-7271 • 1115 FULLER • WICHITA, KANSAS 67211

PROJECT NUMBER
488-78-245-82882-000-000-001



DESIGN BP/DMV	DRAWN DMV	APPROVED	DATE 3-3-97	SCALE NOTED	SHEET 4 OF 11
------------------	--------------	----------	----------------	----------------	------------------

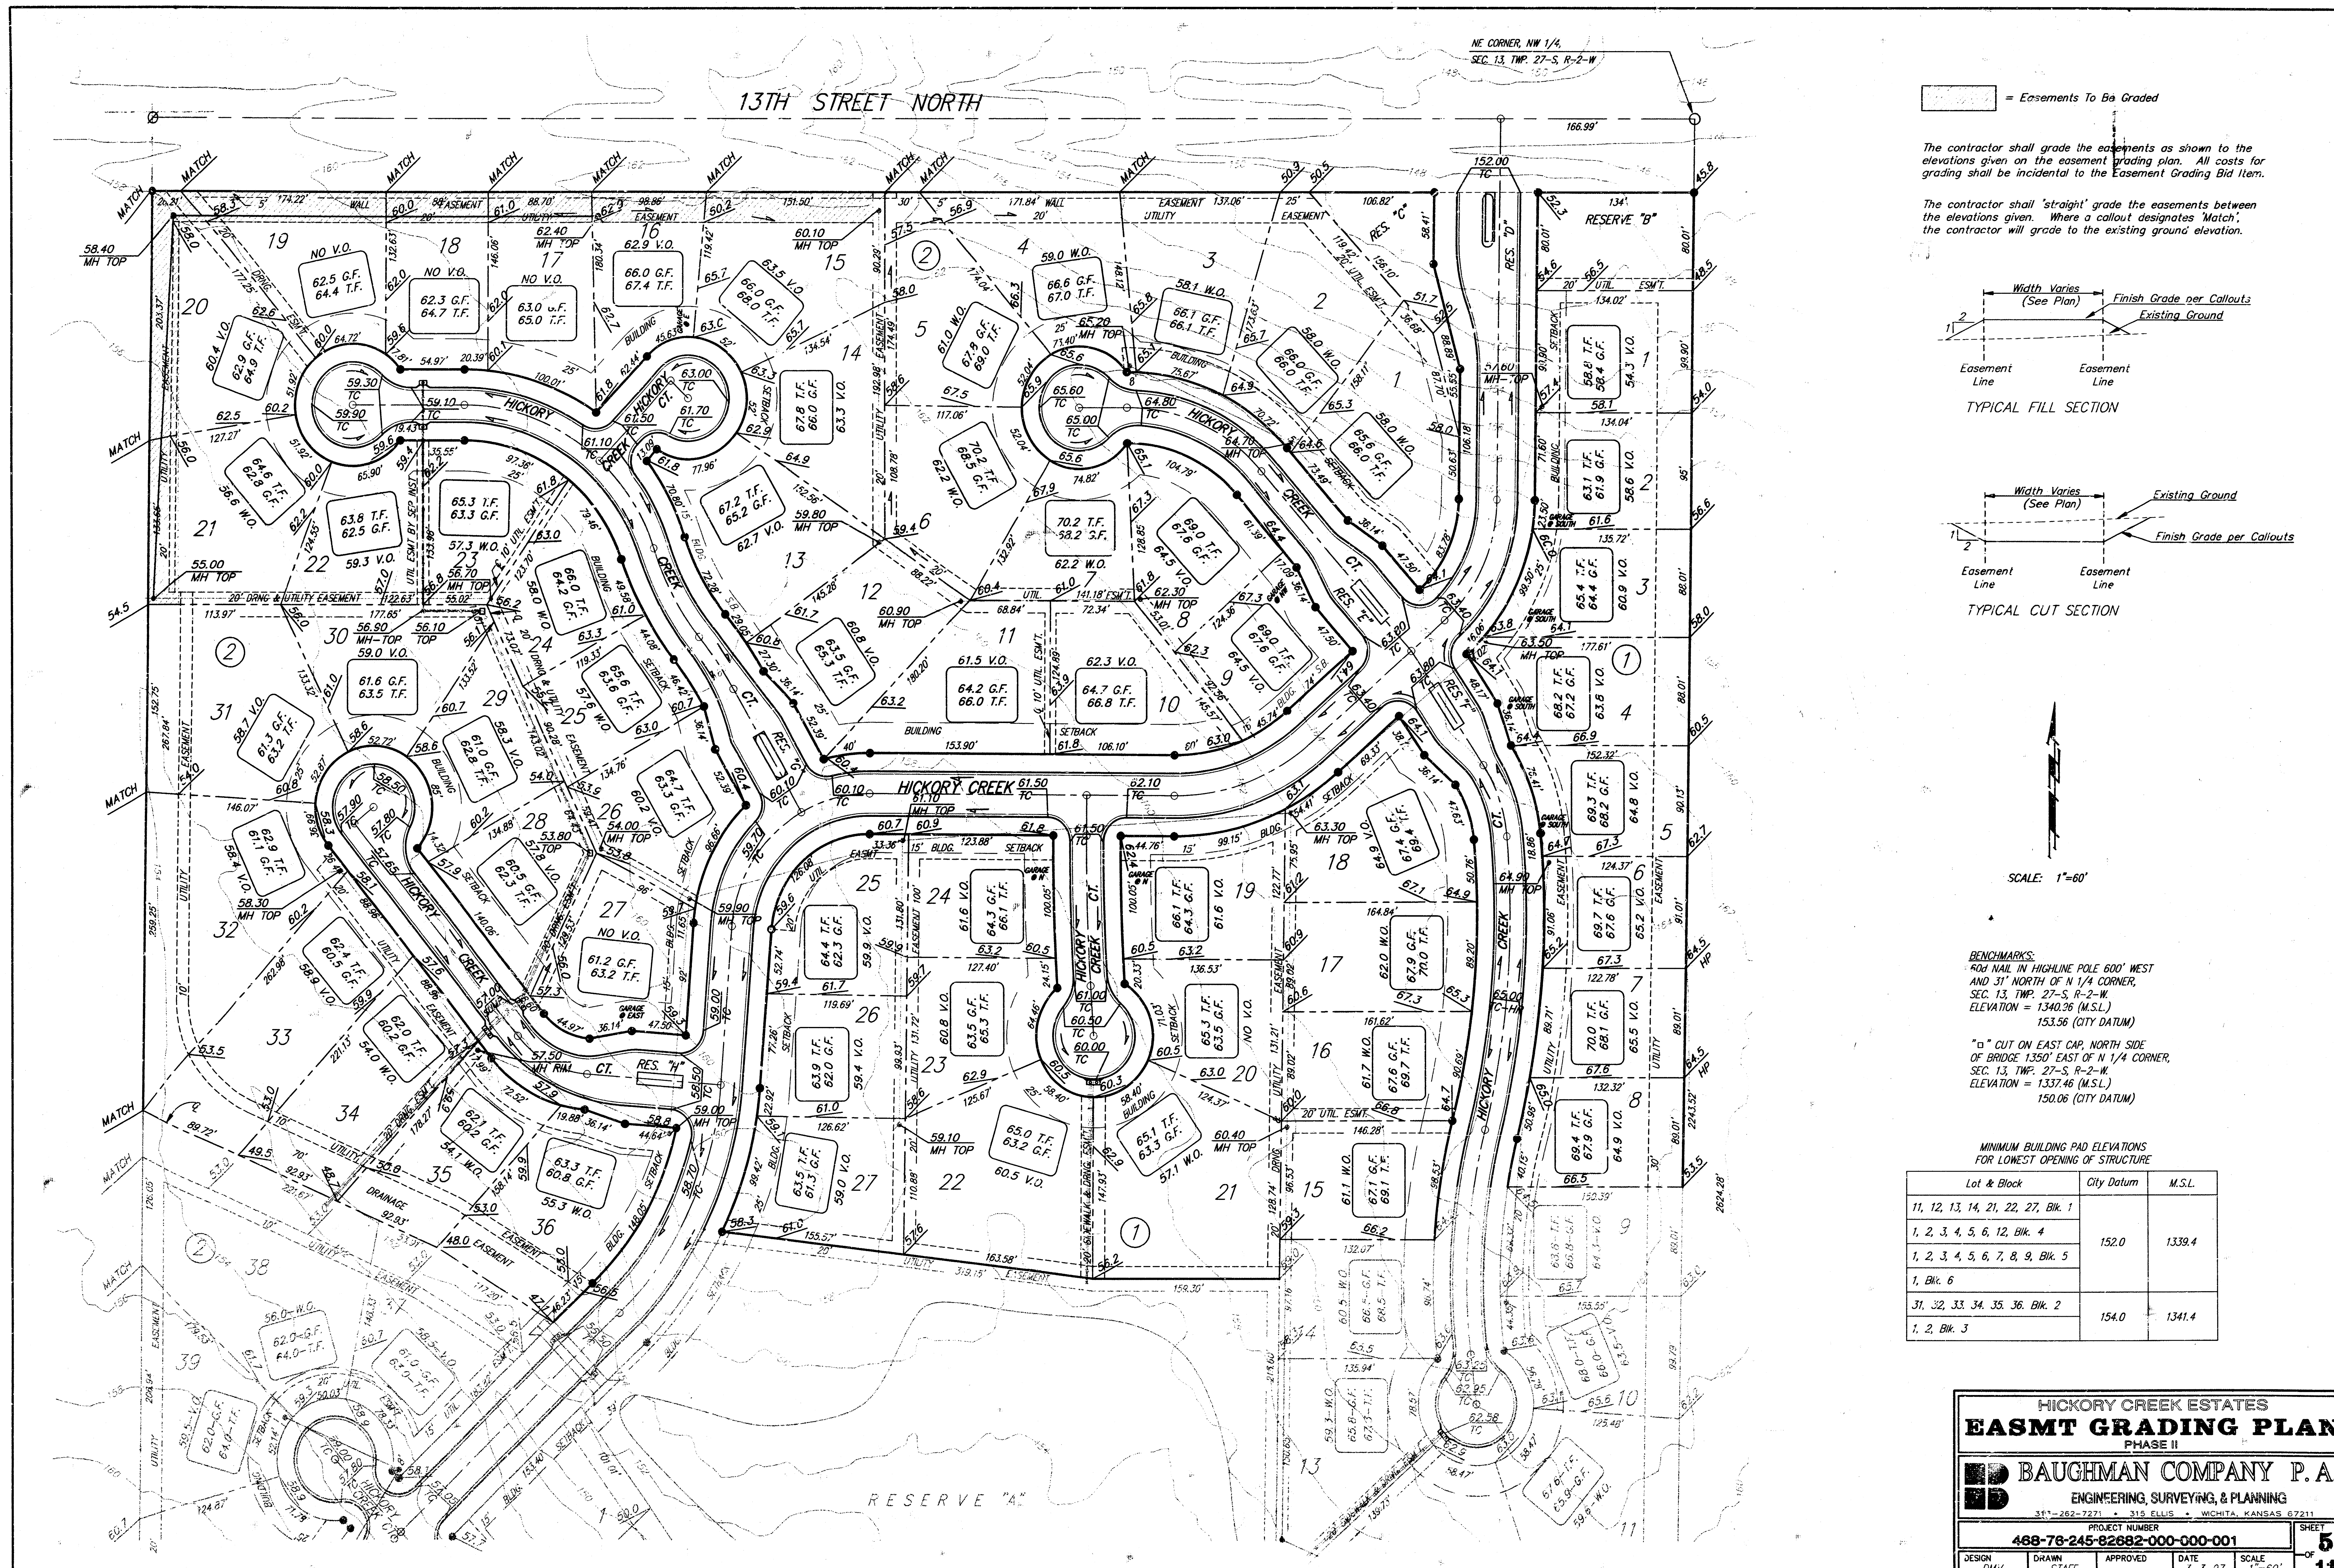

Easements To Be Graded

The contractor shall grade the easements as shown to the elevations given on the easement grading plan. All costs for grading shall be incidental to the Easement Grading Bid Item.

The contractor shall "straight" grade the easements between the elevations given. Where a callout designates "Match", the contractor will grade to the existing ground elevation.

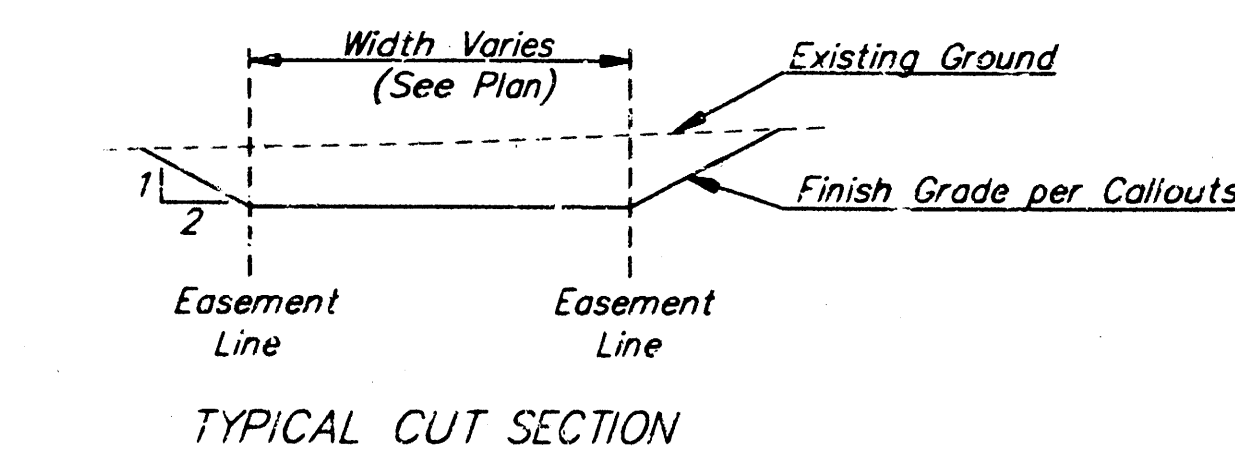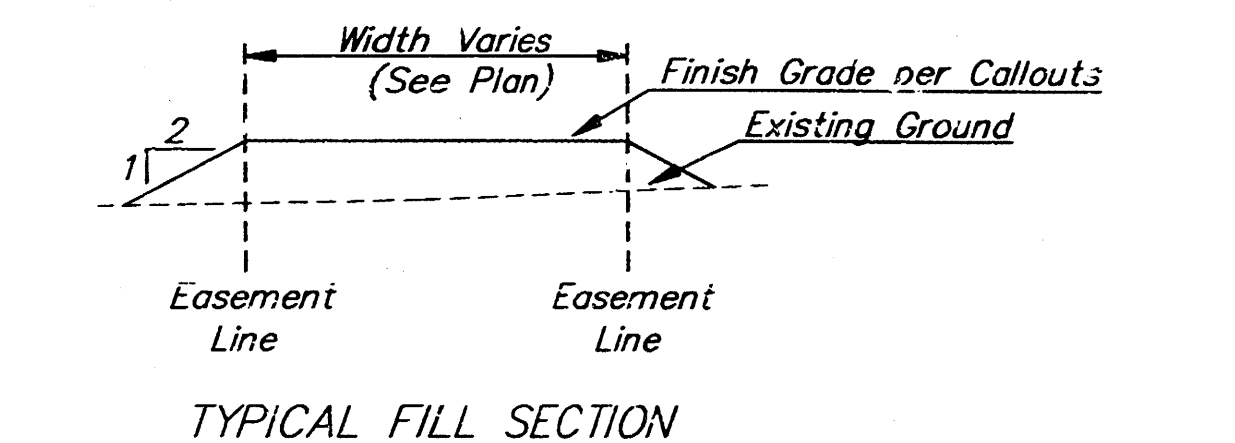

BENCHMARKS:
 ROD NAIL IN HIGHLINE POLE 600' WEST
 AND 31' NORTH OF N 1/4 CORNER,
 SEC. 13, TWP. 27-S, R-2-W.
 ELEVATION = 1340.36 (M.S.L.)
 153.56 (CITY DATUM)

"□" CUT ON EAST CAP, NORTH SIDE
 OF BRIDGE 1350' EAST OF N 1/4 CORNER,
 SEC. 13, TWP. 27-S, R-2-W.
 ELEVATION = 1337.46 (M.S.L.)
 150.06 (CITY DATUM)

MINIMUM BUILDING PAD ELEVATIONS
 FOR LOWEST OPENING OF STRUCTURE


Lot & Block	City Datum	M.S.L.
11, 12, 13, 14, 21, 22, 27, Bk. 1		
1, 2, 3, 4, 5, 6, 12, Bk. 4	152.0	1339.4
1, 2, 3, 4, 5, 6, 7, 8, 9, Bk. 5		
1, Bk. 6		
31, 32, 33, 34, 35, 36, Bk. 2	154.0	1341.4
1, 2, Bk. 3		

HICKORY CREEK ESTATES
EASMT GRADING PLAN
 PHASE II

BAUGHMAN COMPANY P.A.
 ENGINEERING, SURVEYING, & PLANNING
 311-262-7271 • 315 ELLIS • WICHITA, KANSAS 67211




PROJECT NUMBER
468-78-245-82682-000-000-001

DESIGN: DMV DRAWN: STAFF APPROVED: [Signature] DATE: 3-3-97 SCALE: 1"=60' SHEET: **5** OF **11**

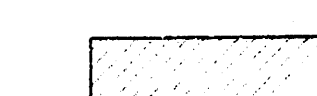 = Easements To Be Graded

The contractor shall grade the easements as shown to the elevations given on the easement grading plan. All costs for grading shall be incidental to the Easement Grading Bid Item.

The contractor shall 'straight' grade the easements between the elevations given. Where a callout designates 'Match', the contractor will grade to the existing ground elevation.

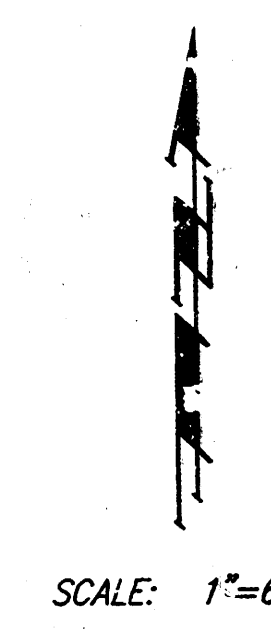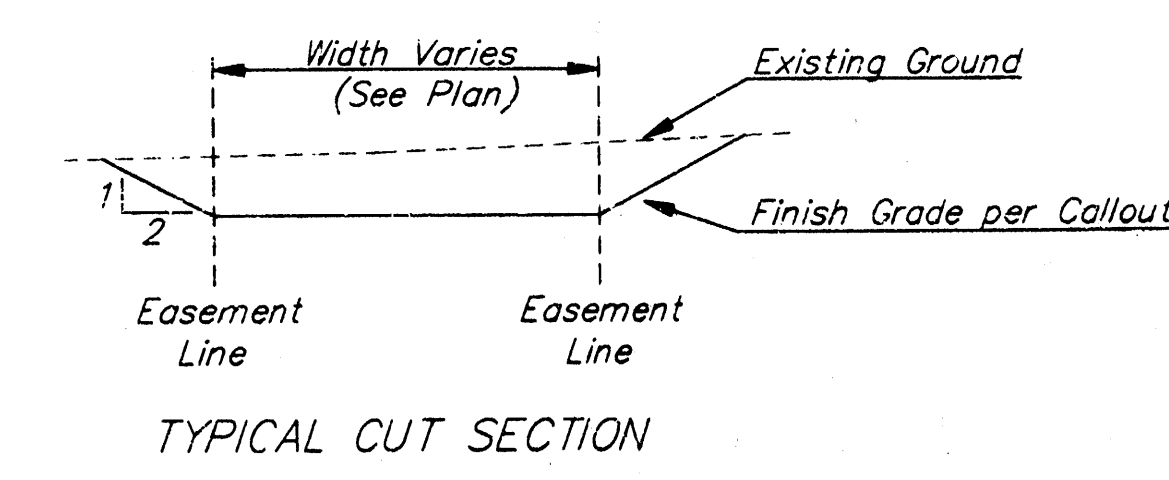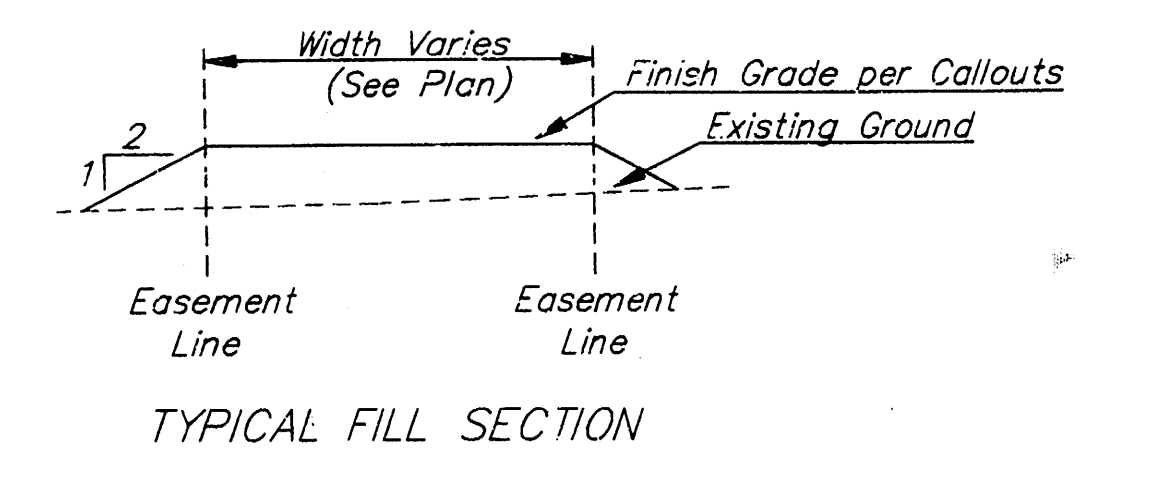

SCALE: 1"=60'

BENCHMARKS:
 600' NAIL IN HIGHLINE POLE 600' WEST
 AND 31' NORTH OF N 1/4 CORNER,
 SEC. 13, TWP. 27-S, R-2-W.
 ELEVATION = 1340.96 (M.S.L.)
 153.53 (CITY DATUM)
 * CUT ON EAST CAP, NORTH SIDE
 OF BRIDGE 1350' EAST OF N 1/4 CORNER,
 SEC. 13, TWP. 27-S, R-2-W.
 ELEVATION = 1337.46 (M.S.L.)
 150.06 (CITY DATUM)

MINIMUM BUILDING PAD ELEVATIONS
 FOR LOWEST OPENING OF STRUCTURE

Lot & Block	City Datum	M.S.L.
11, 12, 13, 14, 21, 22, 27, Blk. 1	152.0	1339.4
1, 2, 3, 4, 5, 6, 12, Blk. 4		
1, 2, 3, 4, 5, 6, 7, 8, 9, Blk. 5		
1, Blk. 6	154.0	1341.4
31, 32, 33, 34, 35, 36, Blk. 2		
1, 2, Blk. 3		


REVISED 3-12-96

HICKORY CREEK ESTATES
ESMT GRADING PLAN
 PHASE II


BAUGHMAN COMPANY P. A.
 ENGINEERING, SURVEYING, & PLANNING
 316-262-7271 • 315 ELLIS • WICHITA, KANSAS 67211

PROJECT NUMBER
489-76-245-82682-000-000-001


DESIGN	DRAWN	APPROVED	DATE	SCALE	SHEET
	STAFF		3-3-97	1"=60'	6 OF 11

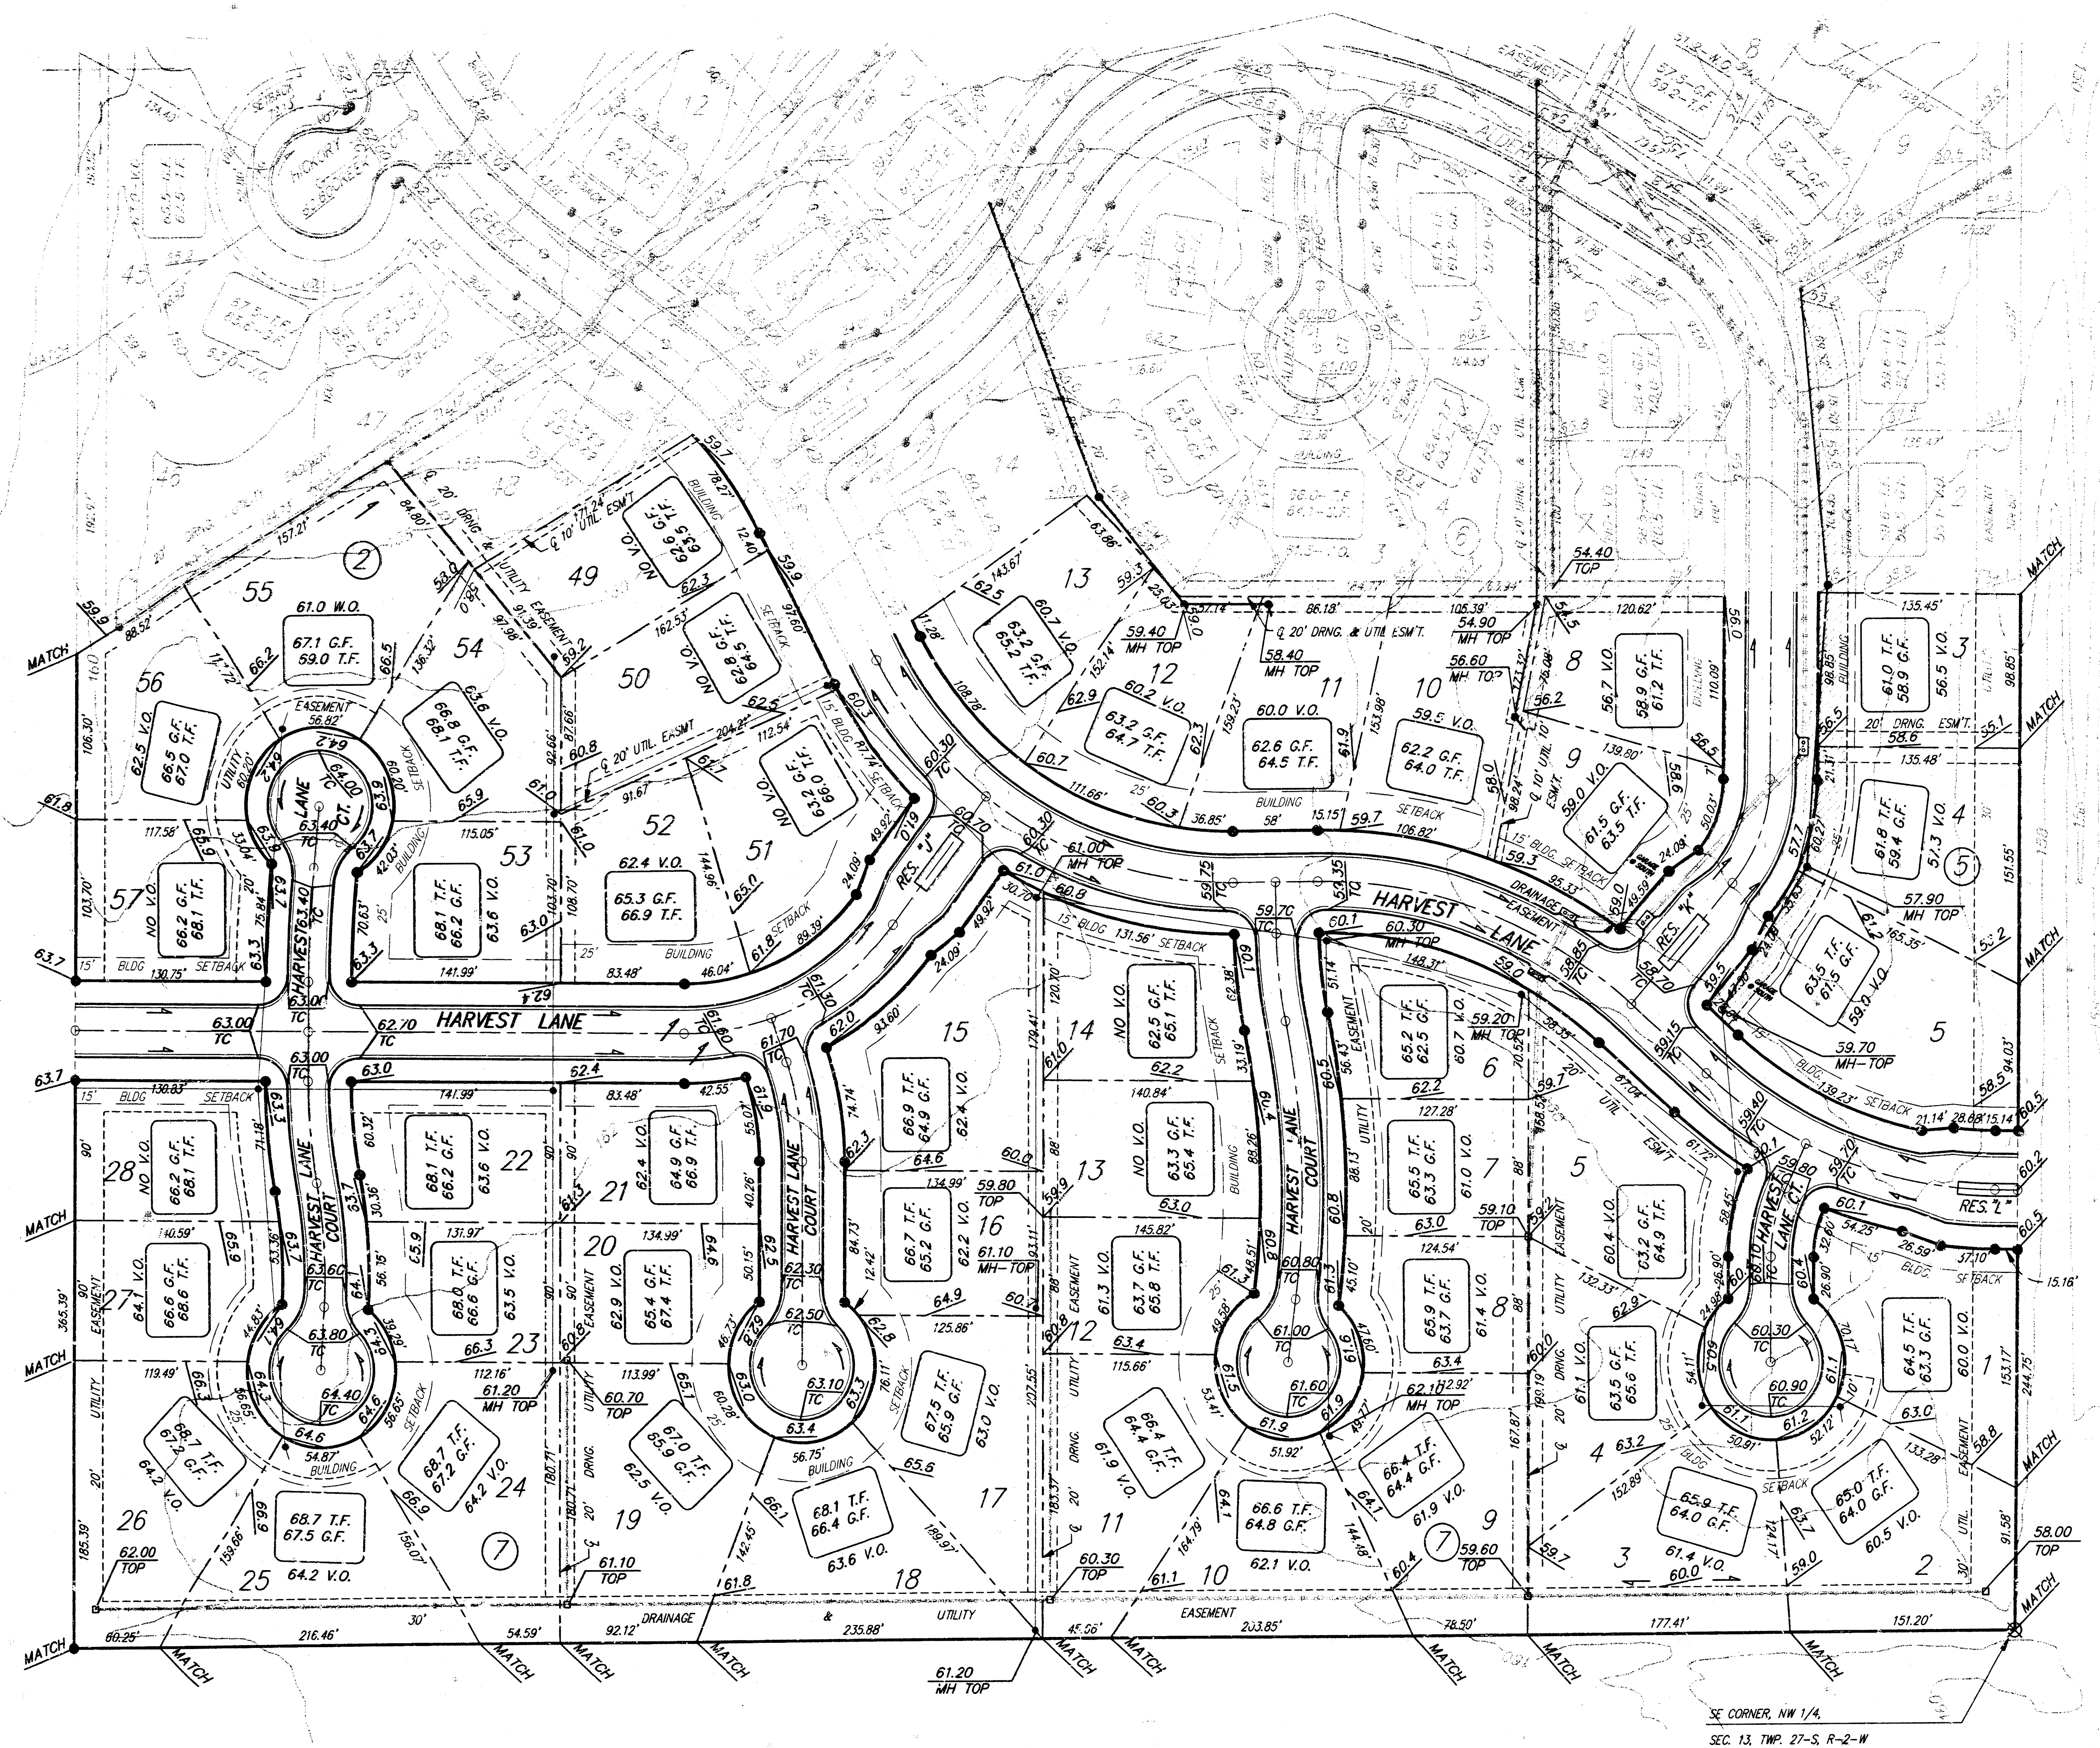


SEWER APPURTENANCES DETAILS

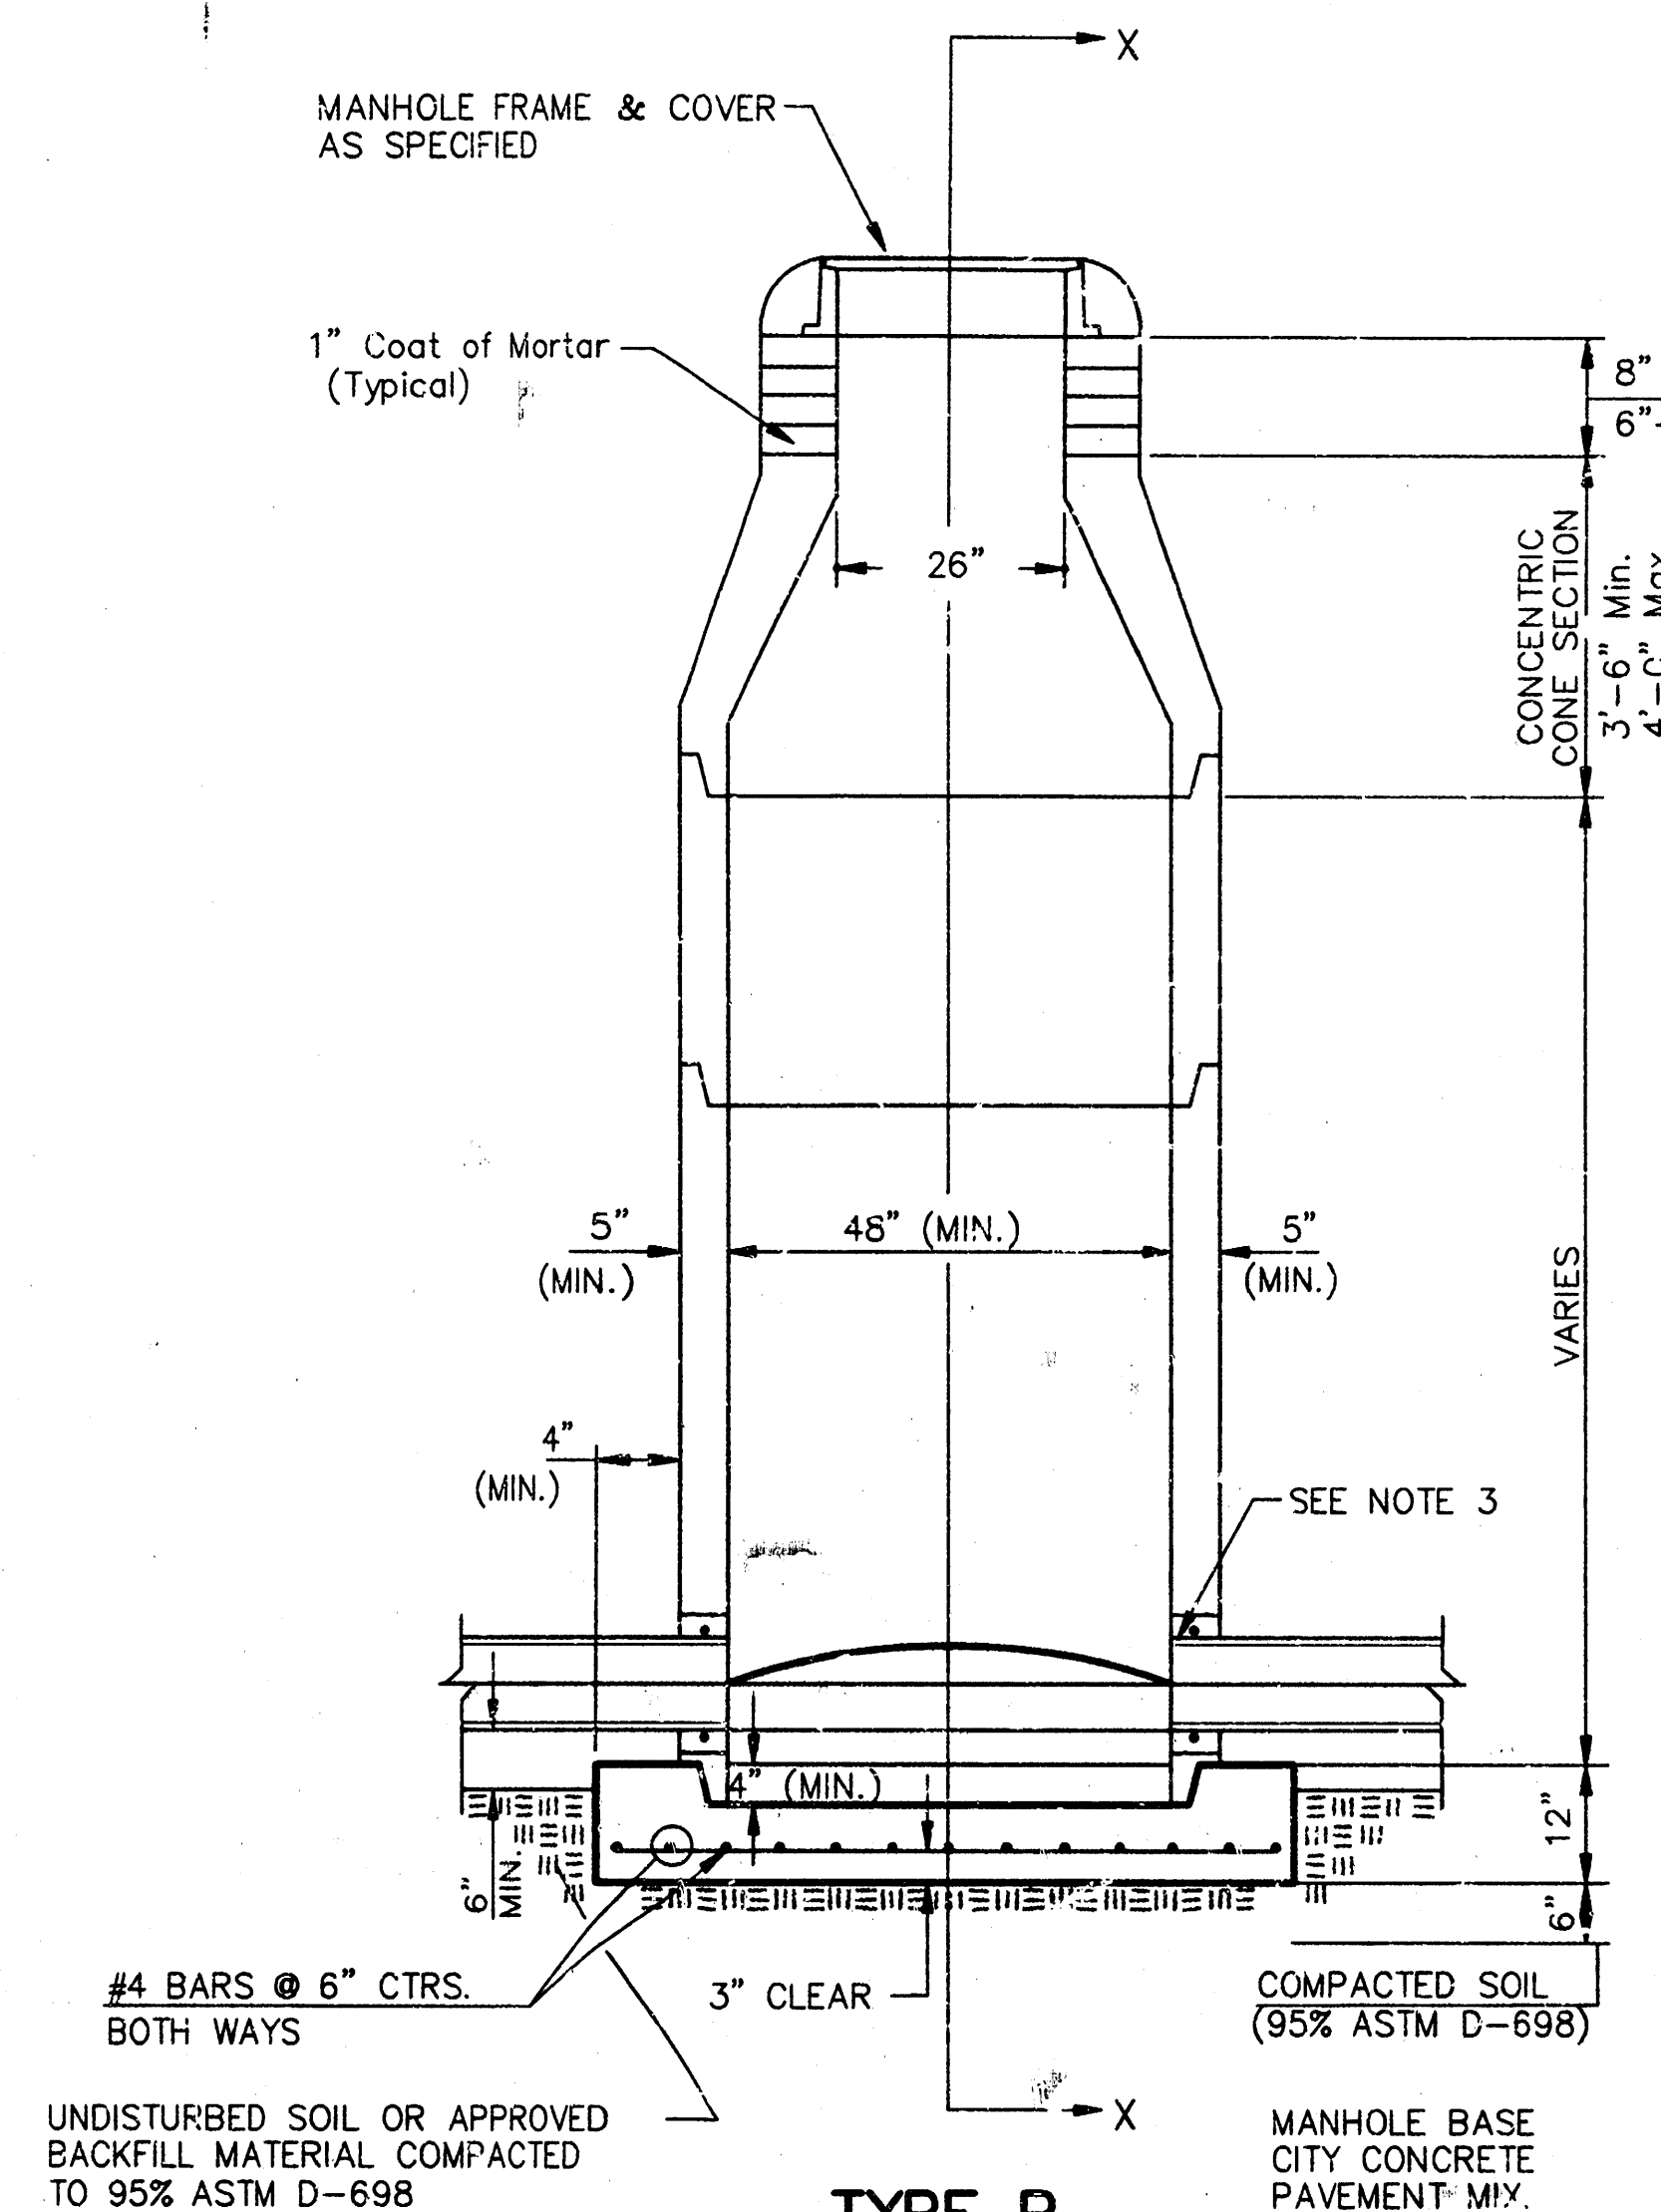


**TYPE P
STANDARD MANHOLE**

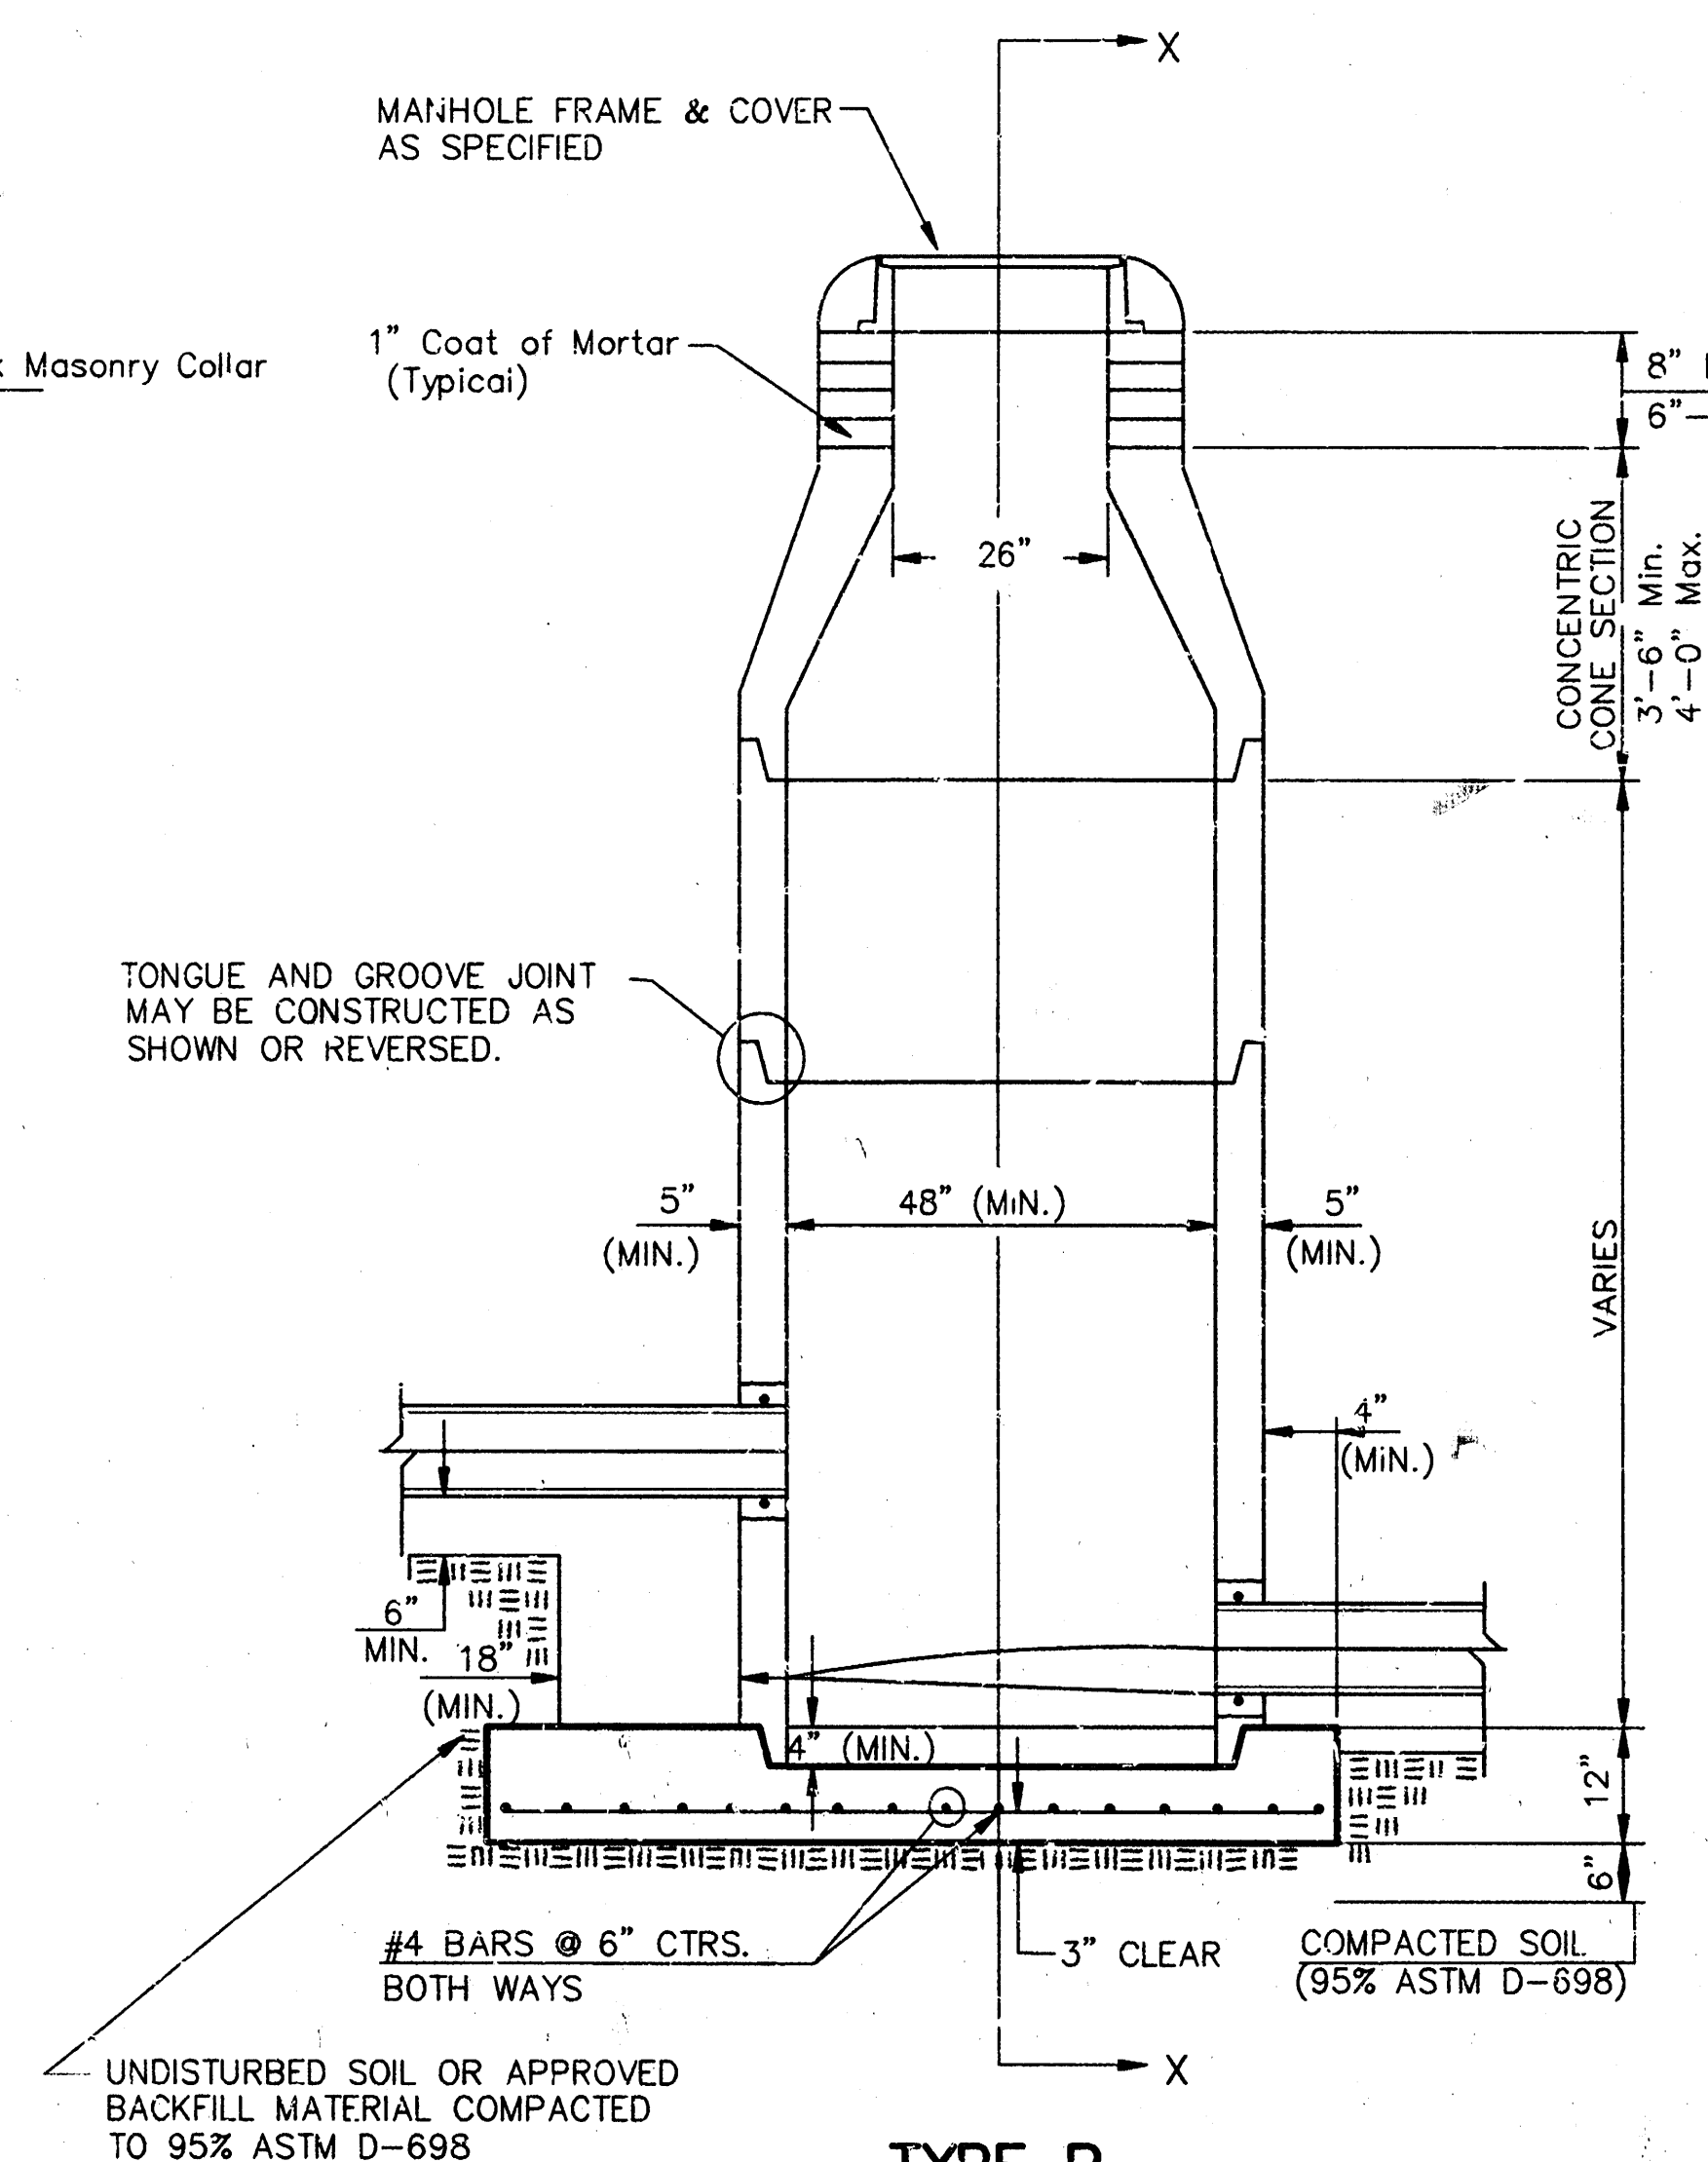

**TYPE P
INSIDE DROP MANHOLE**

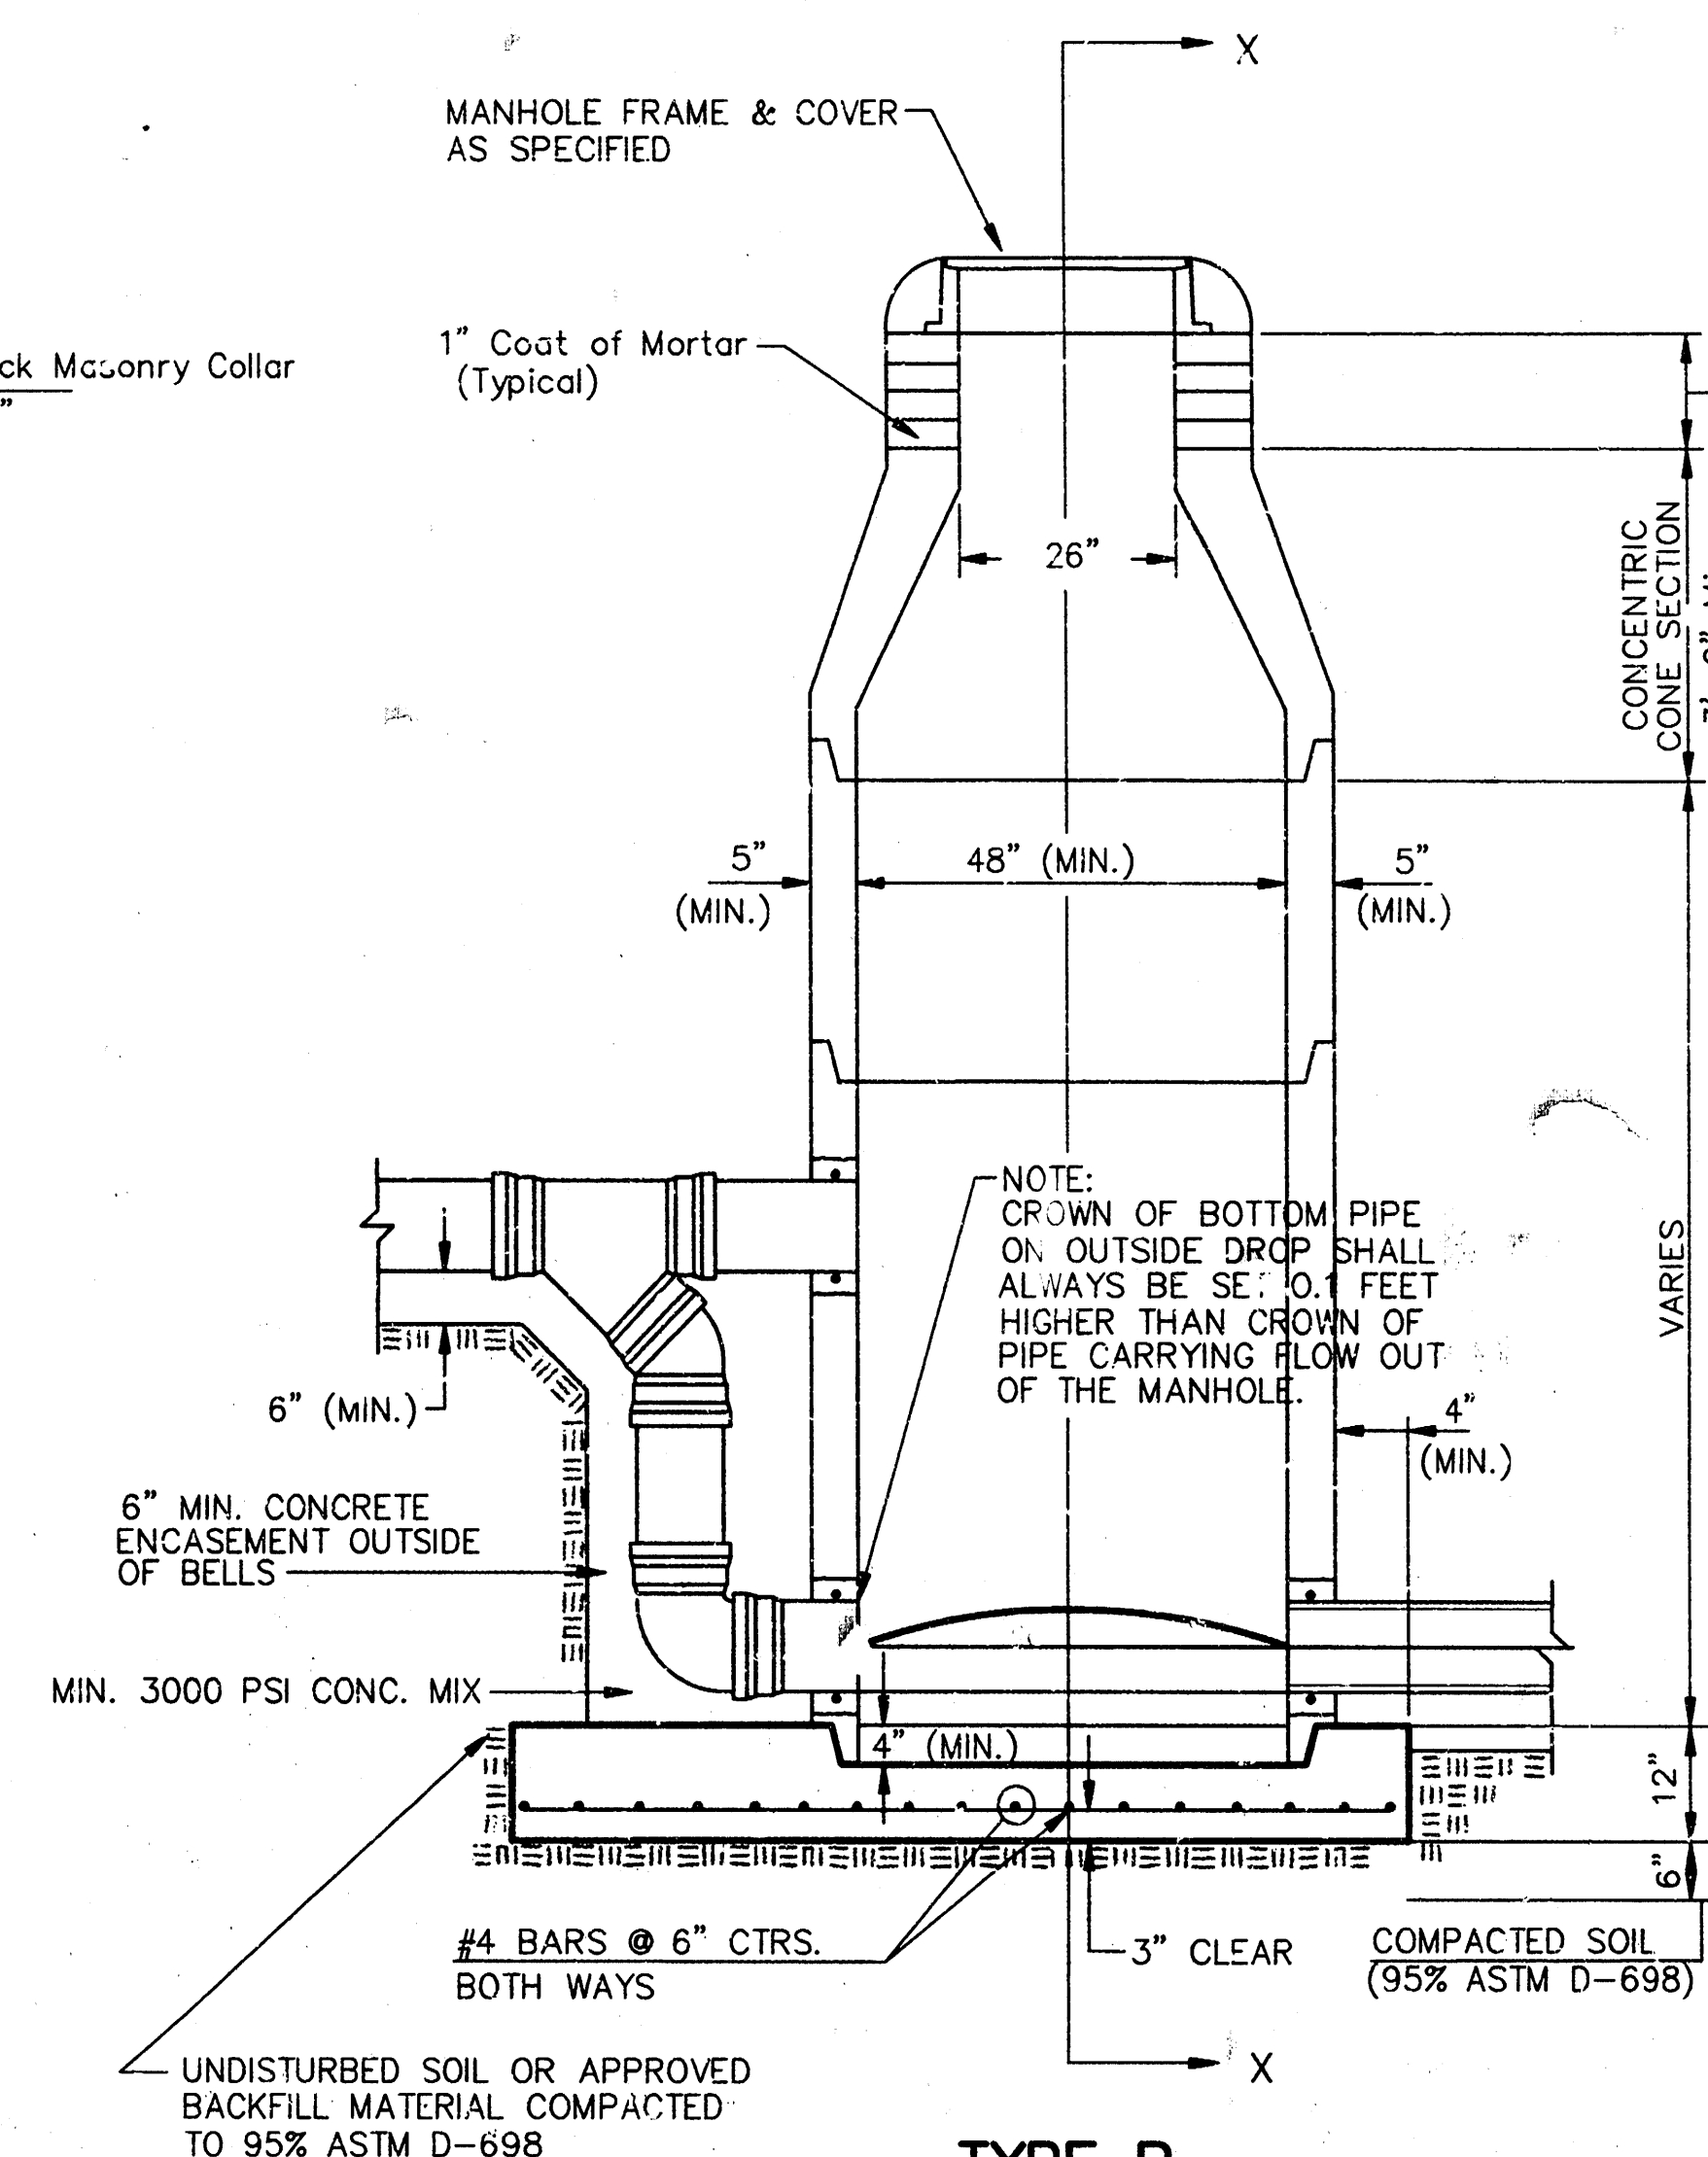

**TYPE P
OUTSIDE DROP MANHOLE**

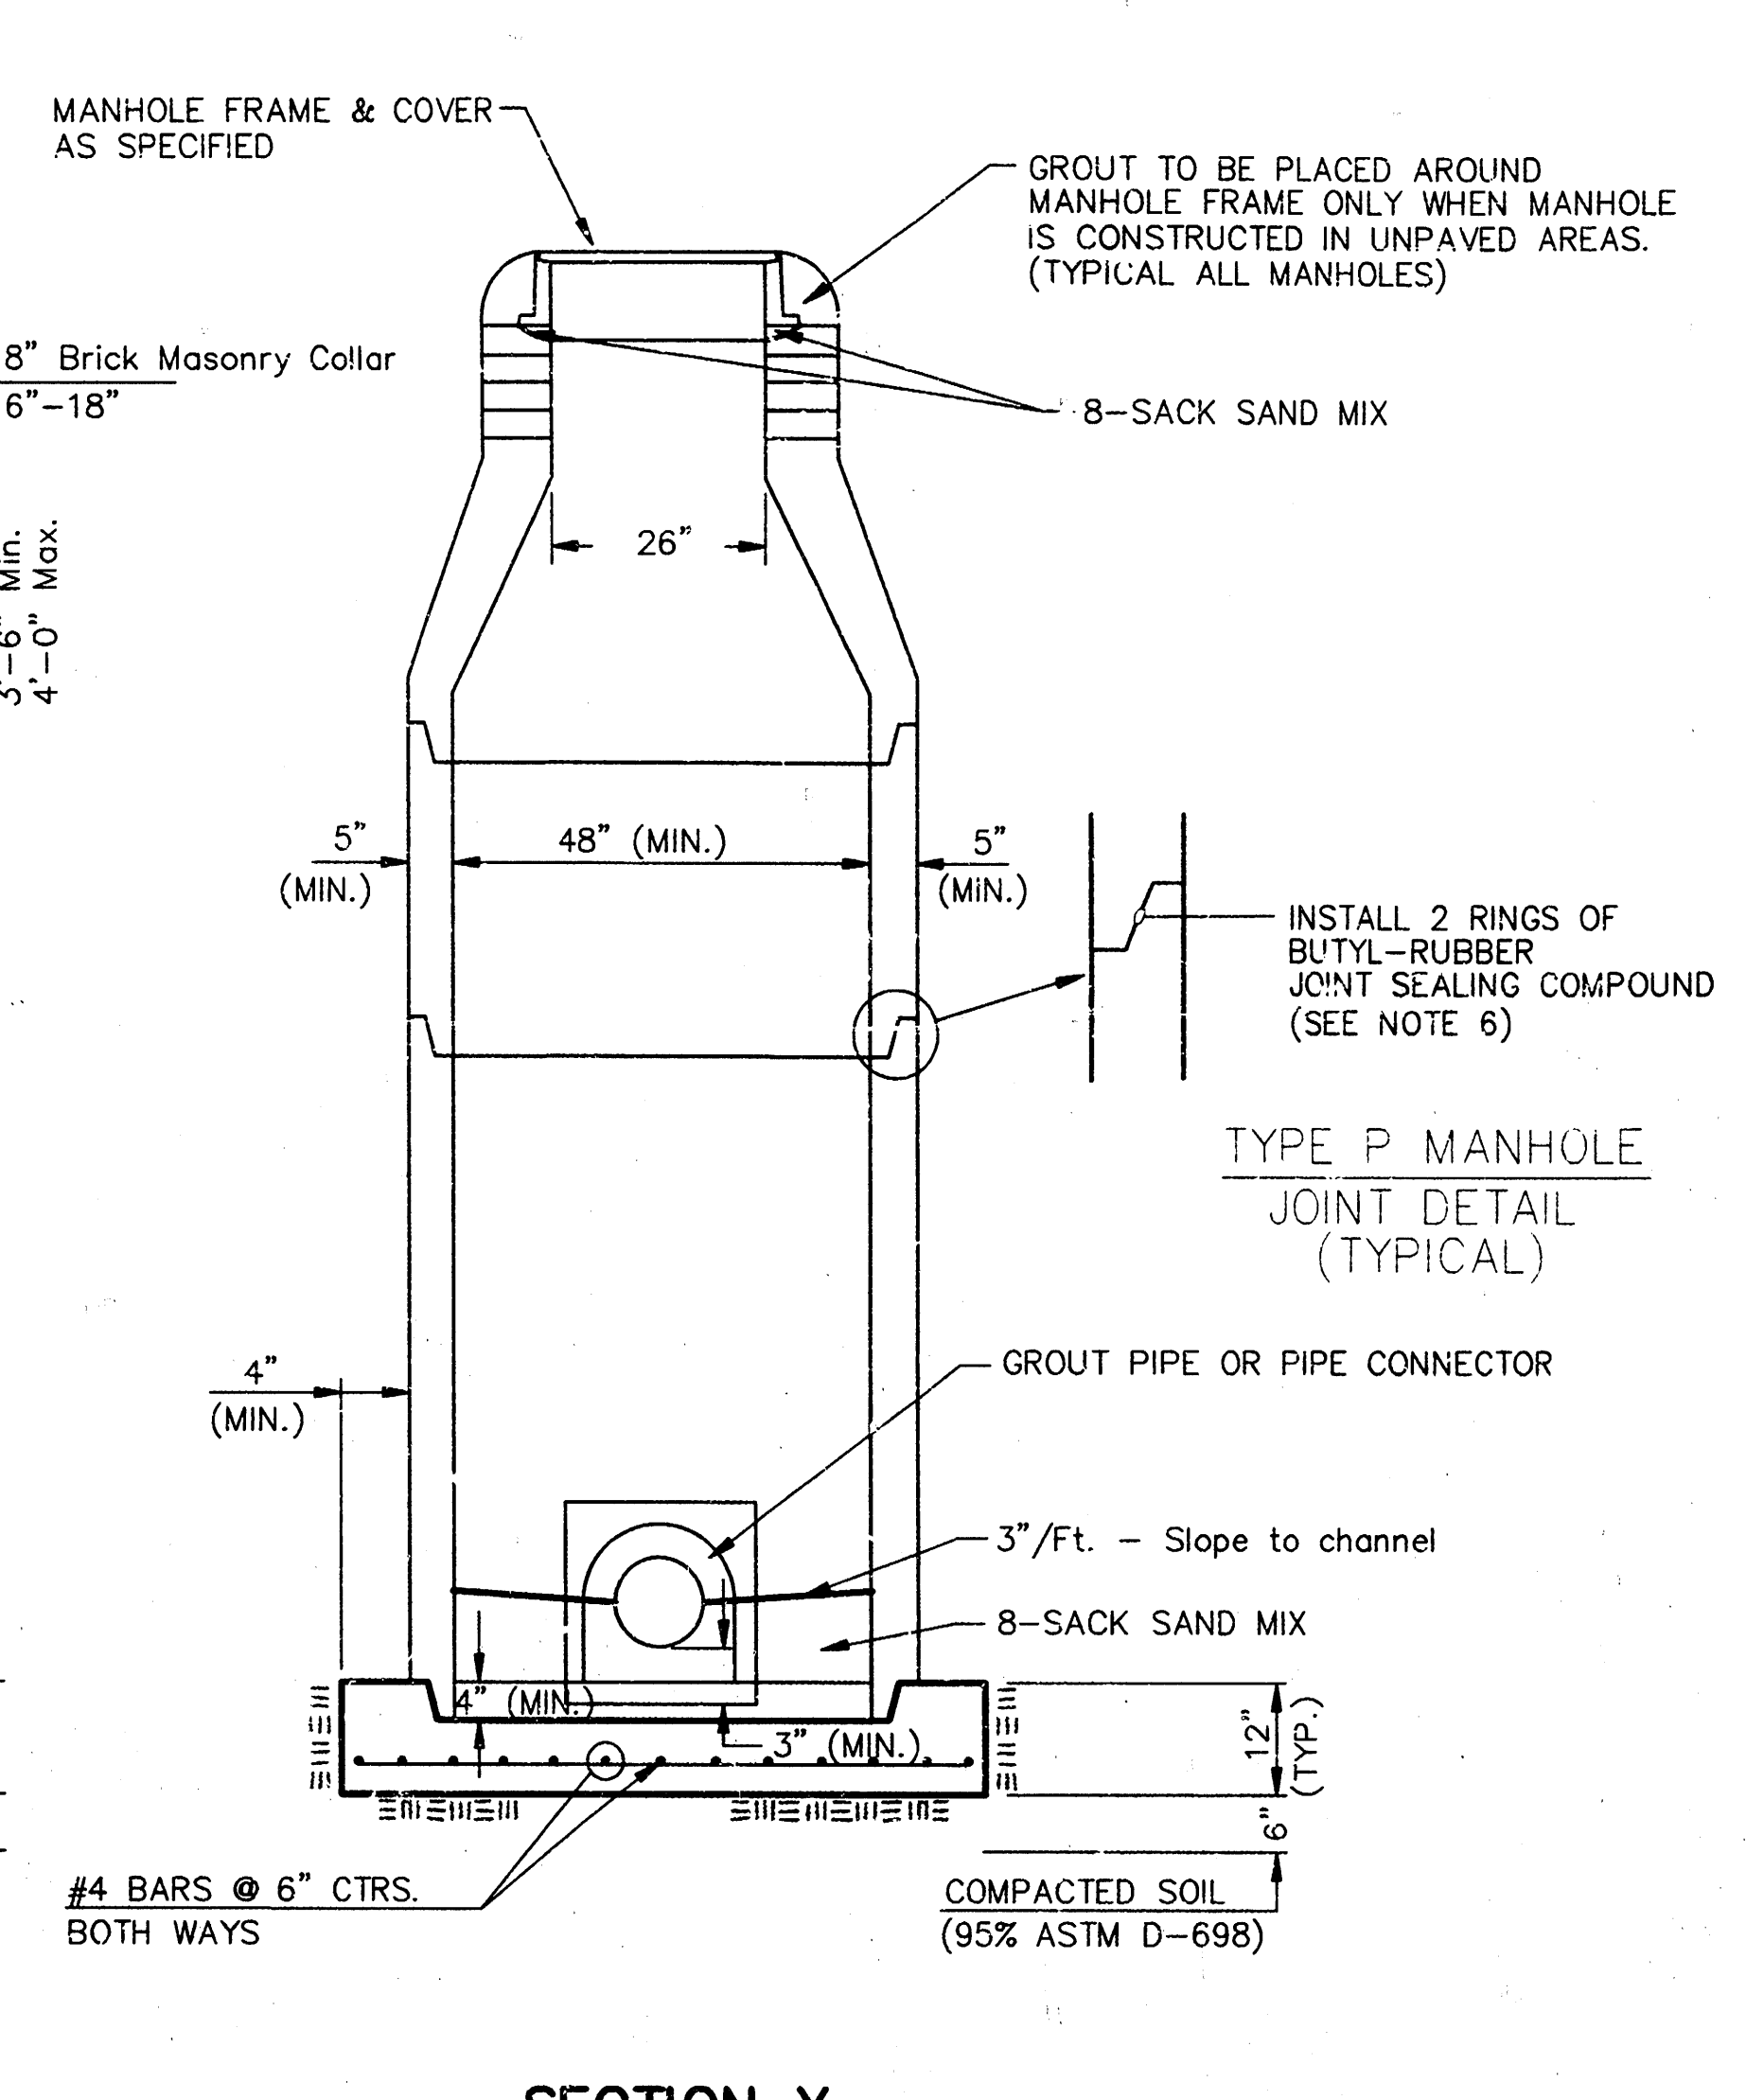


**SECTION X
(TYPICAL)**

GENERAL NOTES PRECAST MANHOLE NOTES

- ALL PRECAST CONCRETE MANHOLE SECTIONS SHALL CONFORM TO THE LATEST REVISIONS OF A.S.T.M. C478 AS MODIFIED BY THE SPECIFICATIONS.
- NON-SHRINK GROUT SHALL BE NON-METALLIC TYPE.
- APPROVED FLEXIBLE WATERSTOP GASKETS SHALL BE INSTALLED TO JOIN THE SEWER TO THE MANHOLE WALL WHEN A.B.S. COMPOSITE PIPE OR P.V.C. PIPE IS USED. FOR OTHER TYPES OF PIPE THE SEWER SHALL BE GROUTED IN PLACE WITH NON-SHRINK GROUT. THE SEWER PIPE SHALL BE SUPPORTED WITH CONCRETE ENCASEMENT A MINIMUM OF 3 FEET FROM THE MANHOLE WALL AND TO THE FIRST JOINT FOR V.C.P. SUCH THAT THE JOINT REMAINS FLEXIBLE.
- ALL INSIDE SURFACES OF THE CONCRETE MANHOLE WHICH WOULD BE EXPOSED TO SEWER GAS SHALL BE COATED WITH 2 COATS OF SERIES 66 HI-BUILD EPOXY, DRY THICKNESS OF 8 MILS.
- EXTERIOR MANHOLE WALLS SHALL BE COATED WITH 633 BITUMINOUS COATING.
- JOINT SEALING COMPOUND SHALL BE KENT EQUAL.
- PRECAST MANHOLES SHALL BE SET AT LEAST MANHOLE BASE.
- TOP OF MANHOLE FLOOR SLAB SHALL BE AT THE FLOW LINE OF THE OUTLET PIPE TO INSURE MINIMUM THICKNESS OF SHAPED INVERT.
- LIFTING HOLES SHALL BE FILLED WITH NON-SHRINKING INTERIOR SURFACE COATED AS SPECIFIED.
- MORTAR USED IN MASONRY CONSTRUCTION SHALL CONTAIN 1 CEMENT PER CUBIC YARD. CONCRETE USED IN MANHOLE BASES SHALL CONFORM TO THE REQUIREMENTS OF CONCRETE FOR CONCRETE PAVEMENT CONSTRUCTION AS SPECIFIED IN THE CITY STANDARD PAVING SPECIFICATIONS USING CITY CONCRETE PAVEMENT MIX WITHOUT AIR ENTRAINING ADMIXTURE. MORTAR SHALL BE PLACED AROUND THE MANHOLE RING AS SHOWN ON THE DRAWINGS WHEN MANHOLES ARE CONSTRUCTED IN UNPAVED AREAS. MANHOLES CONSTRUCTED WHERE PIPE SIZES ARE SMALLER THAN 24" SHALL HAVE AN INSIDE DIAMETER OF 4". MANHOLES CONSTRUCTED WHERE PIPE SIZES ARE 24" OR LARGER SHALL HAVE AN INSIDE DIAMETER OF 5". COMPLETED MANHOLE SHALL BE WITHOUT LEAKS AND WATER TIGHT.


- REINFORCING STEEL SHALL BE INSTALLED IN THE MANHOLE BASES AND SHALL CONSIST OF NO. 4 BARS PLACED AT 6" CENTERS IN BOTH DIRECTIONS. THE MANHOLE BASE REINFORCEMENT SHALL BE PLACED AT LEAST 3" ABOVE THE BOTTOM OF THE MANHOLE BASE. ALL COSTS FOR FURNISHING AND INSTALLING REINFORCING STEEL SHALL BE INCLUDED IN THE UNIT PRICE BID FOR THE MANHOLE.
- OPENINGS SHALL BE CUT INTO THE MANHOLE WALL WHEN OUTSIDE DROPS ARE CONSTRUCTED ON EXISTING MANHOLES. SUCH OPENINGS CUT INTO EXISTING MANHOLES SHALL BE AS SMALL AS PRACTICAL TO FACILITATE INSTALLING AND GROUTING THE NEW PIPE IN PLACE. WATERSTOP GASKETS SHALL BE USED WITH P.V.C. AND A.B.S. COMPOSITE PIPE. THE NEW PIPE SHALL BE GROUTED INTO THE OPENING USING AN APPROVED NONSHRINK GROUT FOR THE FULL MANHOLE WALL THICKNESS. THE EXTERIOR OF THE COMPLETED CONNECTION SHALL BE SEALED WITH AN APPROVED BITUMINOUS COATING SUCH THAT THE CONNECTION WILL BE WATER TIGHT. FLOOR OF MANHOLE SHALL BE MODIFIED TO FORM NEW FLOW CHANNEL FOR THE NEW CONNECTION AS INDICATED BY THE DRAWING. THIS WORK, INCLUDING MODIFICATION OF MANHOLE FLOOR, SHALL BE PAID FOR AT THE UNIT PRICE BID FOR OUTSIDE DROP STACK CONSTRUCTED ON EXISTING MANHOLE.
- THE FLOORS OF ALL MANHOLES SHALL BE SHAPED WITH FLOW CHANNELS SUCH THAT THE MANHOLES WILL BE SELF-CLEANING AND FREE OF AREAS WHERE SOLIDS COULD BE DEPOSITED AS SEWAGE FLOWS THROUGH THE MANHOLE FROM ALL INLET PIPES TO THE OUTLET PIPE. FLOW CHANNELS SHALL BE FORMED TO MATCH THE BOTTOM HALVES OF THE INFLOWING PIPES AND THE OUTFLOWING PIPE AS SHOWN BY THE DRAWINGS EXCEPT FOR INSIDE DROP MANHOLES. FLOW CHANNELS FOR INSIDE DROP MANHOLES SHALL BE CONSTRUCTED AS INDICATED BY THE DRAWING. MANHOLE FLOORS SHALL HAVE SLOPES OF 3 INCHES PER FOOT IN THE AREAS OUTSIDE OF THE FLOW CHANNELS SLOPED TOWARD THE FLOW CHANNELS. PIPES LAID THROUGH MANHOLES SHALL HAVE THE TOP HALF REMOVED TO NEAT LINES FOR THE FULL INSIDE DIAMETER OF THE MANHOLE. MANHOLE FLOORS SHALL THEN BE SHAPED AROUND THE BOTTOM HALF OF THE PIPE WHICH FORMS THE FLOW CHANNEL.
- PIPES INSTALLED WITHIN THE EXCAVATION MADE FOR THE MANHOLE SHALL BE GRADED WITH CONCRETE TO THE LIMITS OF THE MANHOLE EXCAVATION. WHEN CLAY PIPE IS USED, THE CRADLE SHALL EXTEND TO THE FIRST JOINT OUTSIDE THE MANHOLE. THE CRADLE SHALL BE TERMINATED AT THE CLAY PIPE JOINT IN A MANNER WHICH WILL MAINTAIN THE FLEXIBILITY OF THE JOINT. COST OF GRADE WITHIN MANHOLE EXCAVATION OR TO CLAY PIPE JOINTS ADJACENT TO MANHOLE SHALL BE INCLUDED IN THE UNIT PRICE BID FOR THE MANHOLE.

- MANHOLE COVER CASTINGS AND MANHOLE FRAME CASTINGS SHALL CONFORM TO THE REQUIREMENTS AS INDICATED IN THE STANDARD SPECIFICATIONS AND AS SHOWN IN THE STANDARD DETAIL DRAWING.
- THE VERTICAL DROP IN INSIDE DROP MANHOLES SHALL NOT EXCEED 2' FOR INFLOWING PIPES SIZED 12" OR SMALLER AND 2' FOR INFLOWING PIPES LARGER THAN 12". THE CROWNS OF INFLOWING PIPES SHALL NEVER BE SET LOWER THAN THE CROWN OF THE OUTFLOWING PIPE.
- STANDARD MANHOLES AND STANDARD INSIDE DROP MANHOLES SHALL BE BID AS STANDARD MANHOLES FOR THE TYPE AND DIAMETER INDICATED. OUTSIDE DROP MANHOLES SHALL BE BID AS STANDARD OUTSIDE DROP MANHOLES FOR THE TYPE AND DIAMETER INDICATED. ALL MANHOLE DIAMETERS WILL BE 4' UNLESS INDICATED OTHERWISE.
- A BRICK MASONRY COLLAR SHALL BE INSTALLED BETWEEN THE CAST IRON FRAME AND THE CONCENTRIC CONE. THE COLLAR WILL HAVE 8" WALLS AND A VERTICAL HEIGHT OF 6" MINIMUM AND 18" MAXIMUM. A 1" COAT OF MORTAR WILL BE PLASTERED ON THE OUTSIDE OF THE COLLAR. THE USE OF PRE-CAST CONCRETE SPACERS FOR MANHOLE TOP ADJUSTMENT IS ALSO ALLOWED.

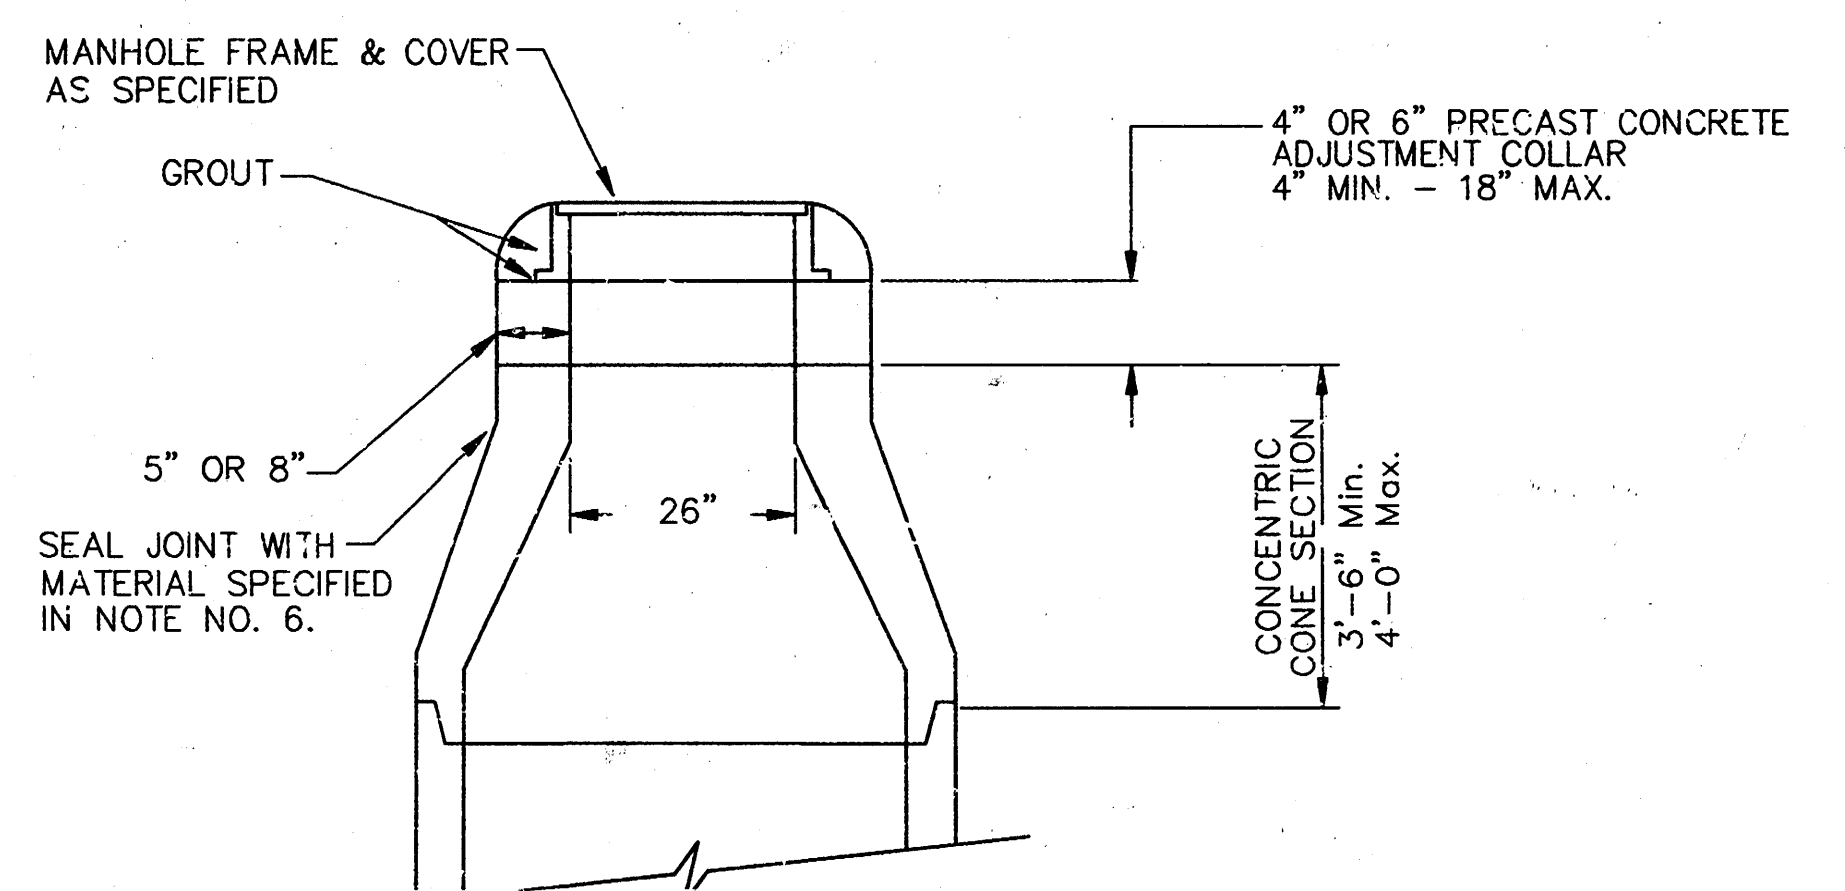


**ALTERNATE CONSTRUCTION
IN UNPAVED AREAS**



CITY OF WICHITA			
STD. MANHOLE DETAILS			
& SEWER APPURTENANCES DETAILS			
BAUGHMAN COMPANY P.A.			
ENGINEERING, SURVEYING, & PLANNING			
316-262-7271 • 315 ELLIS • WICHITA, KANSAS 67211			
PROJECT NUMBER		SHEET	
488-78-245-82682-000-000-001		7	
DESIGN	DRAWN	APPROVED	SCALE
	NOV.93		

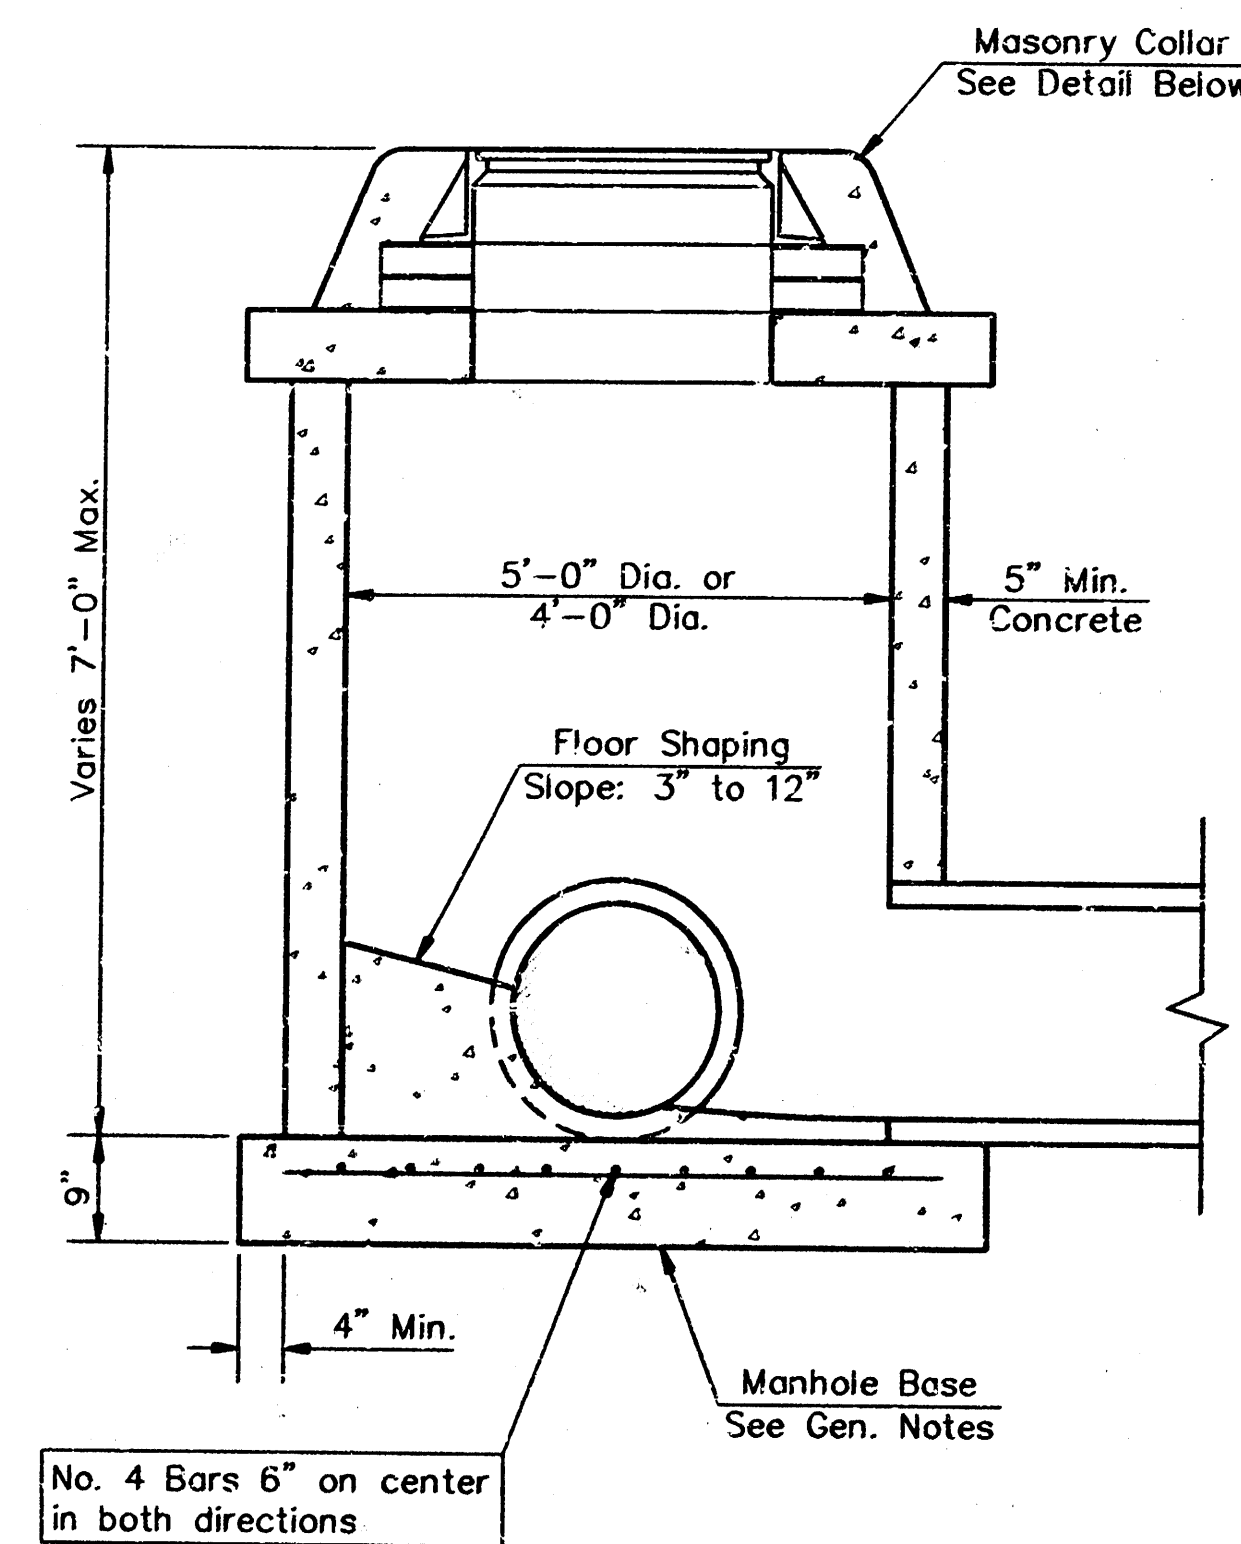

SHALLOW TYPE MANHOLE

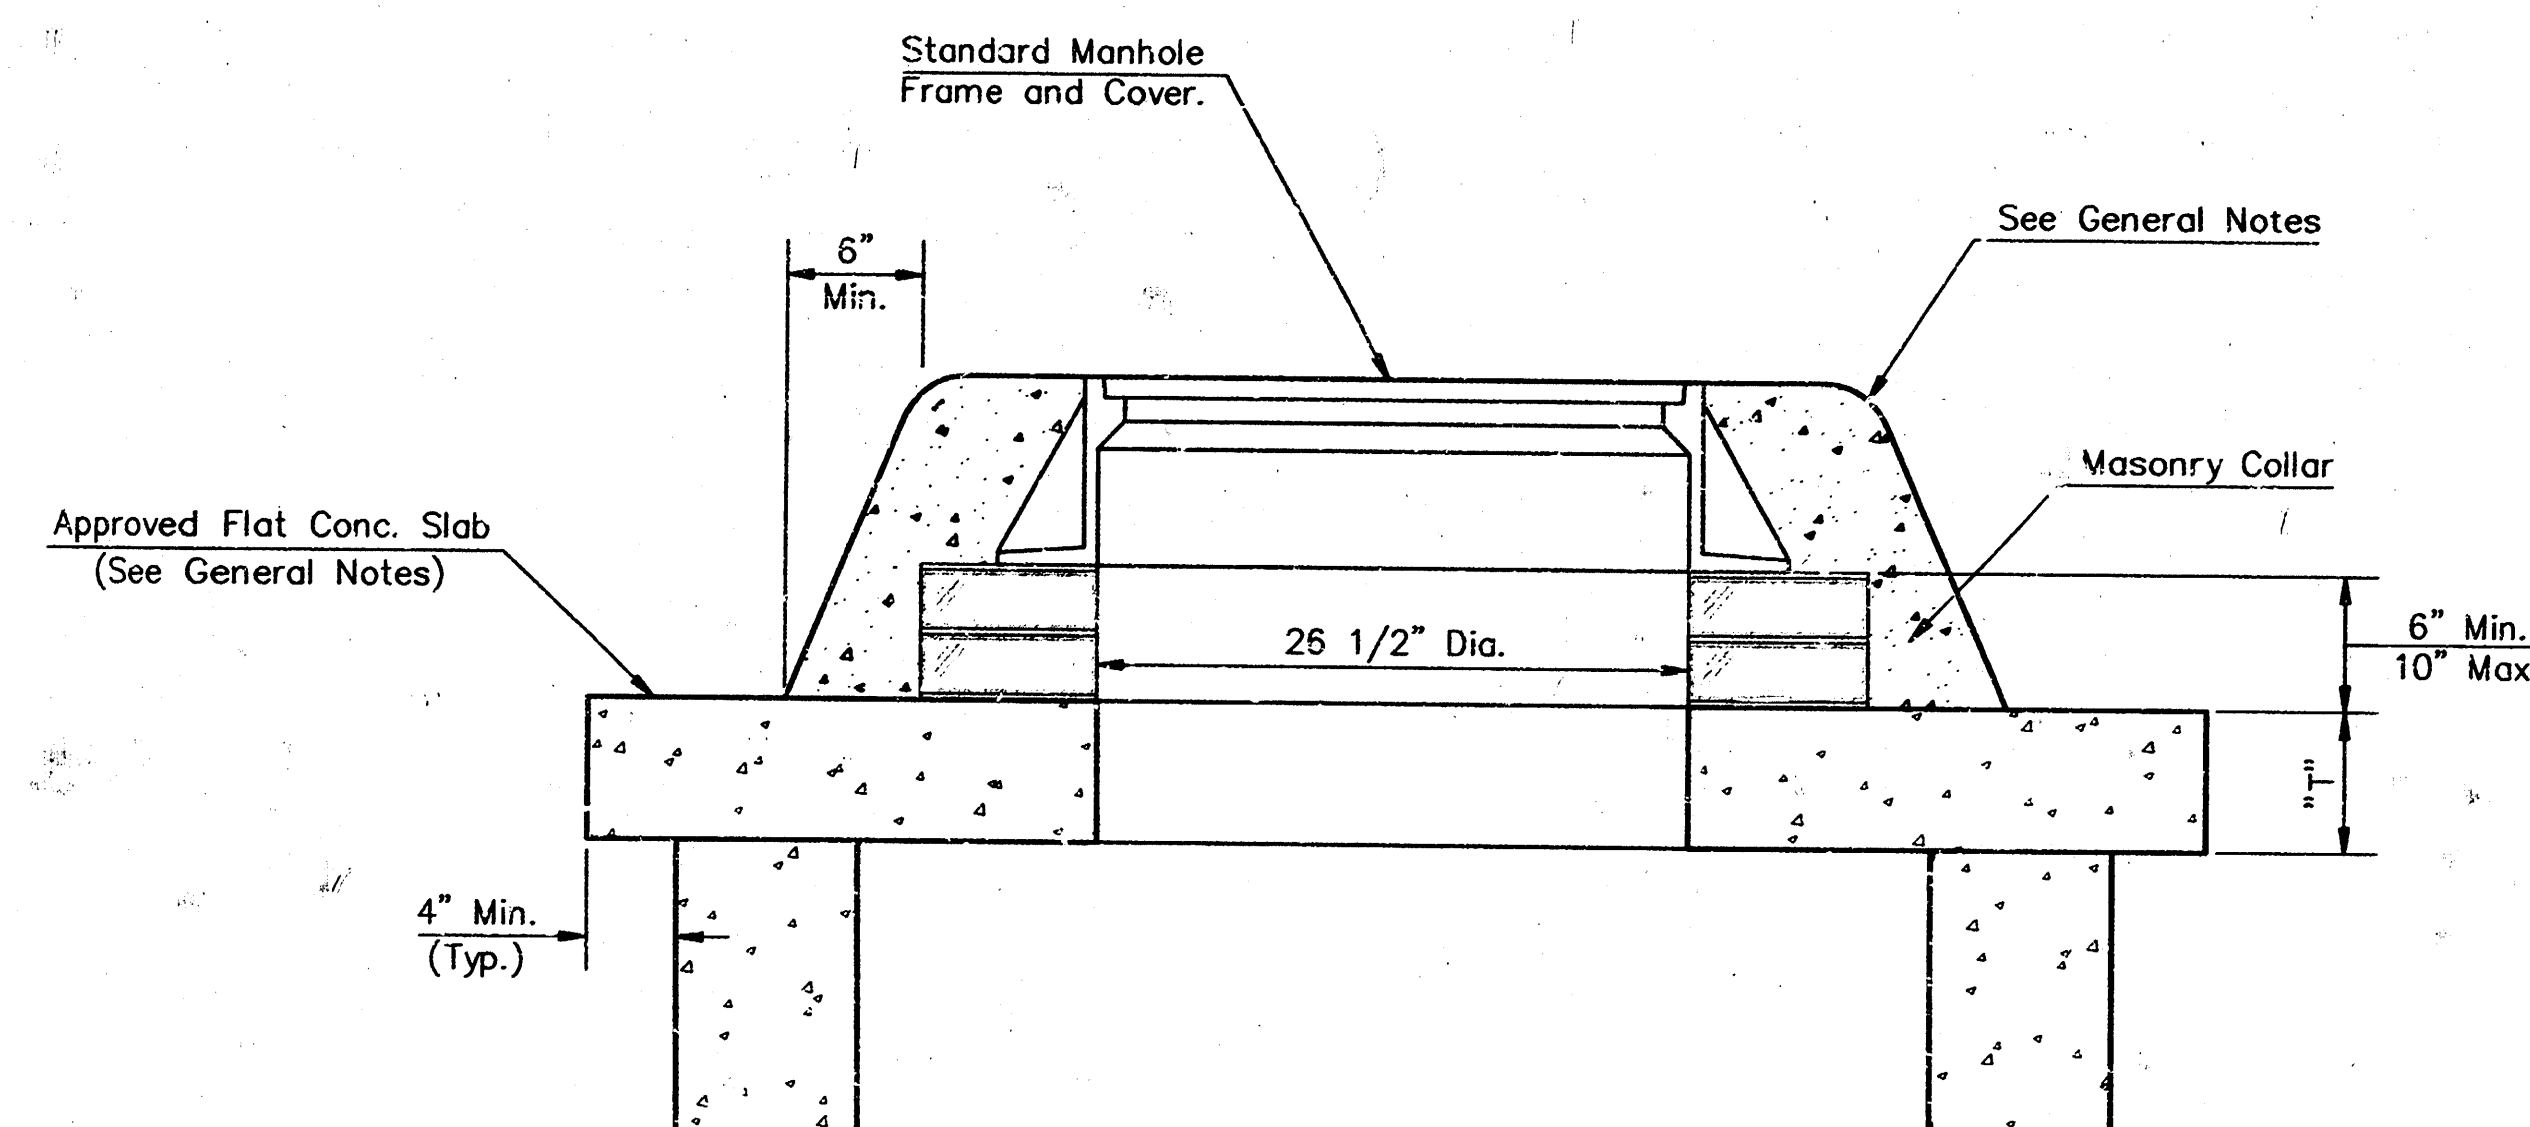

MASONRY COLLAR DETAIL

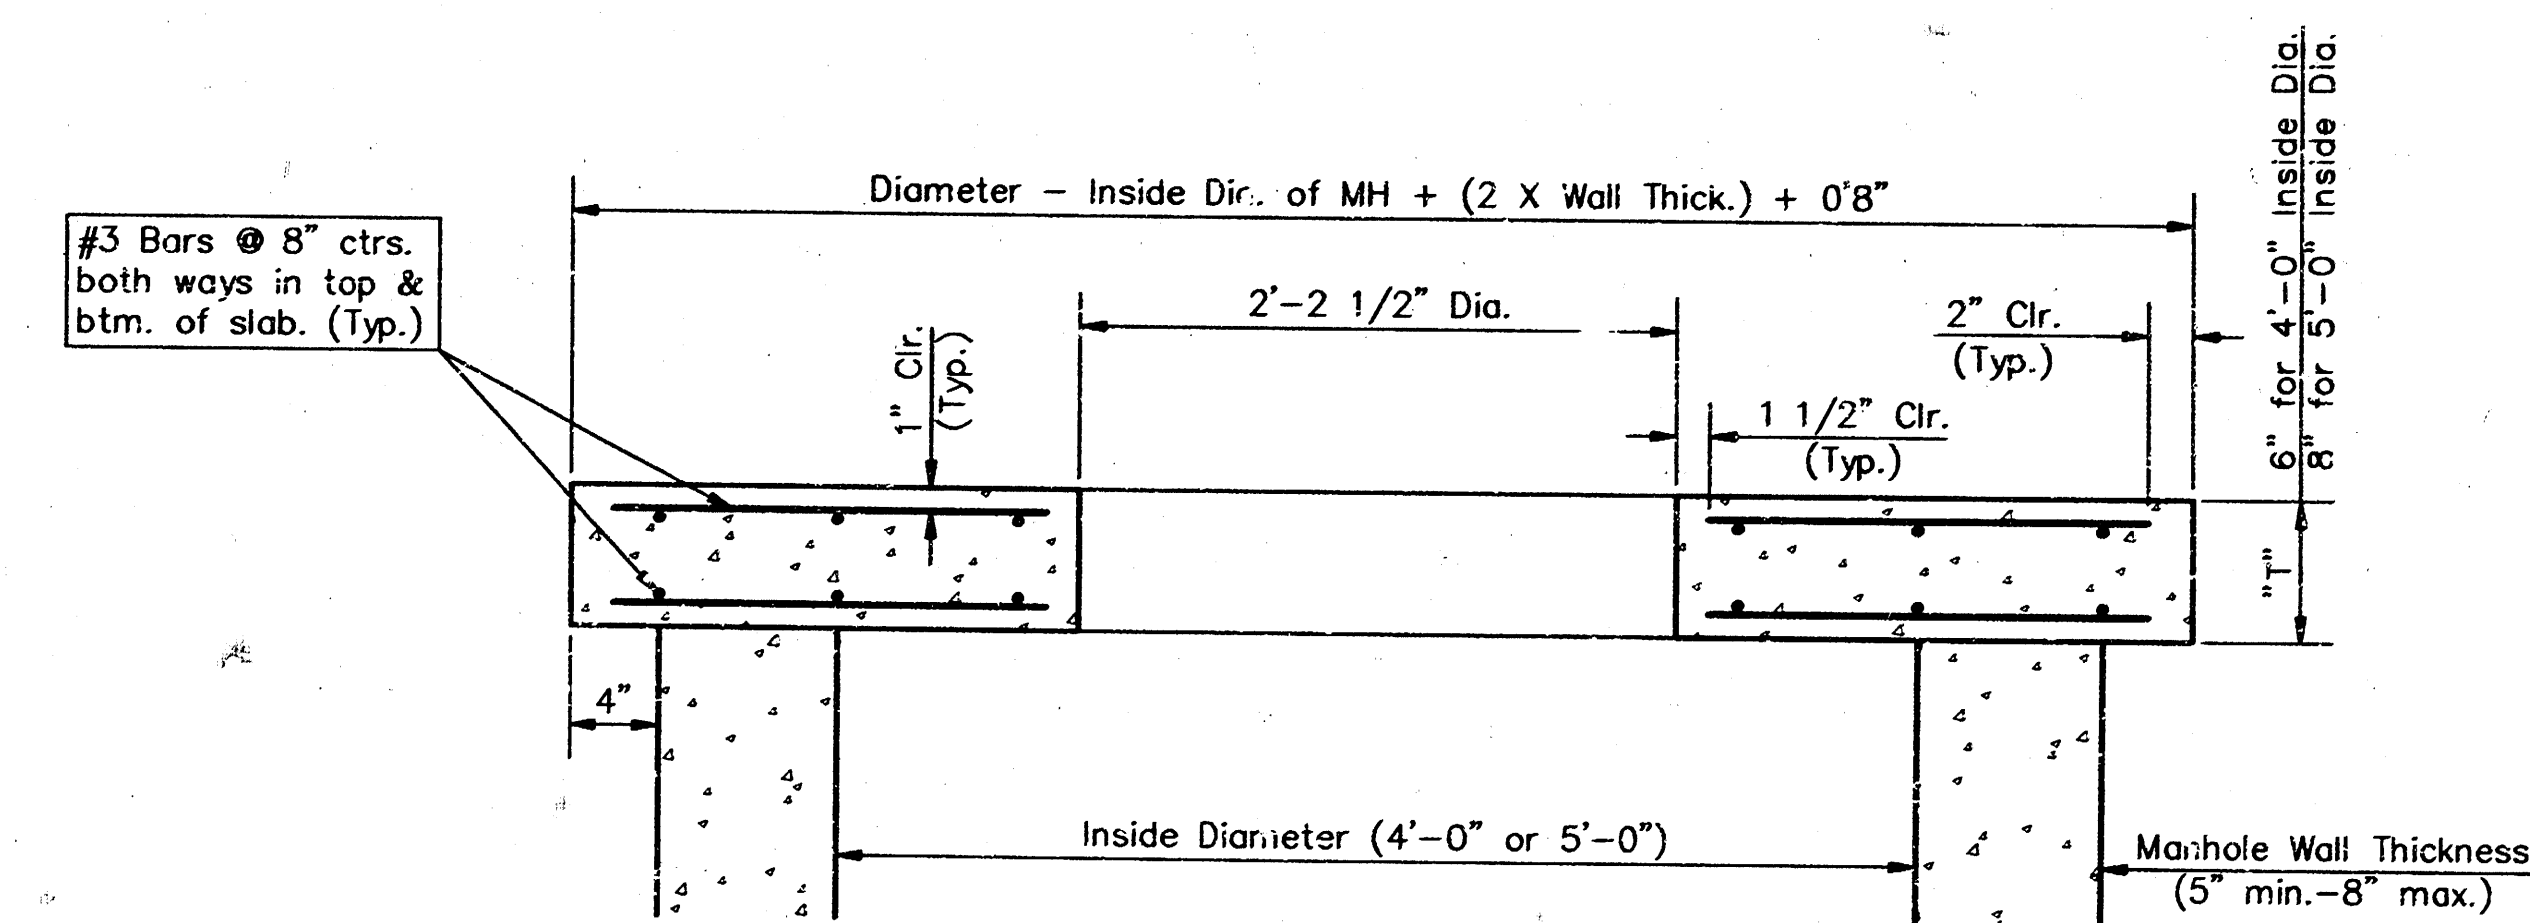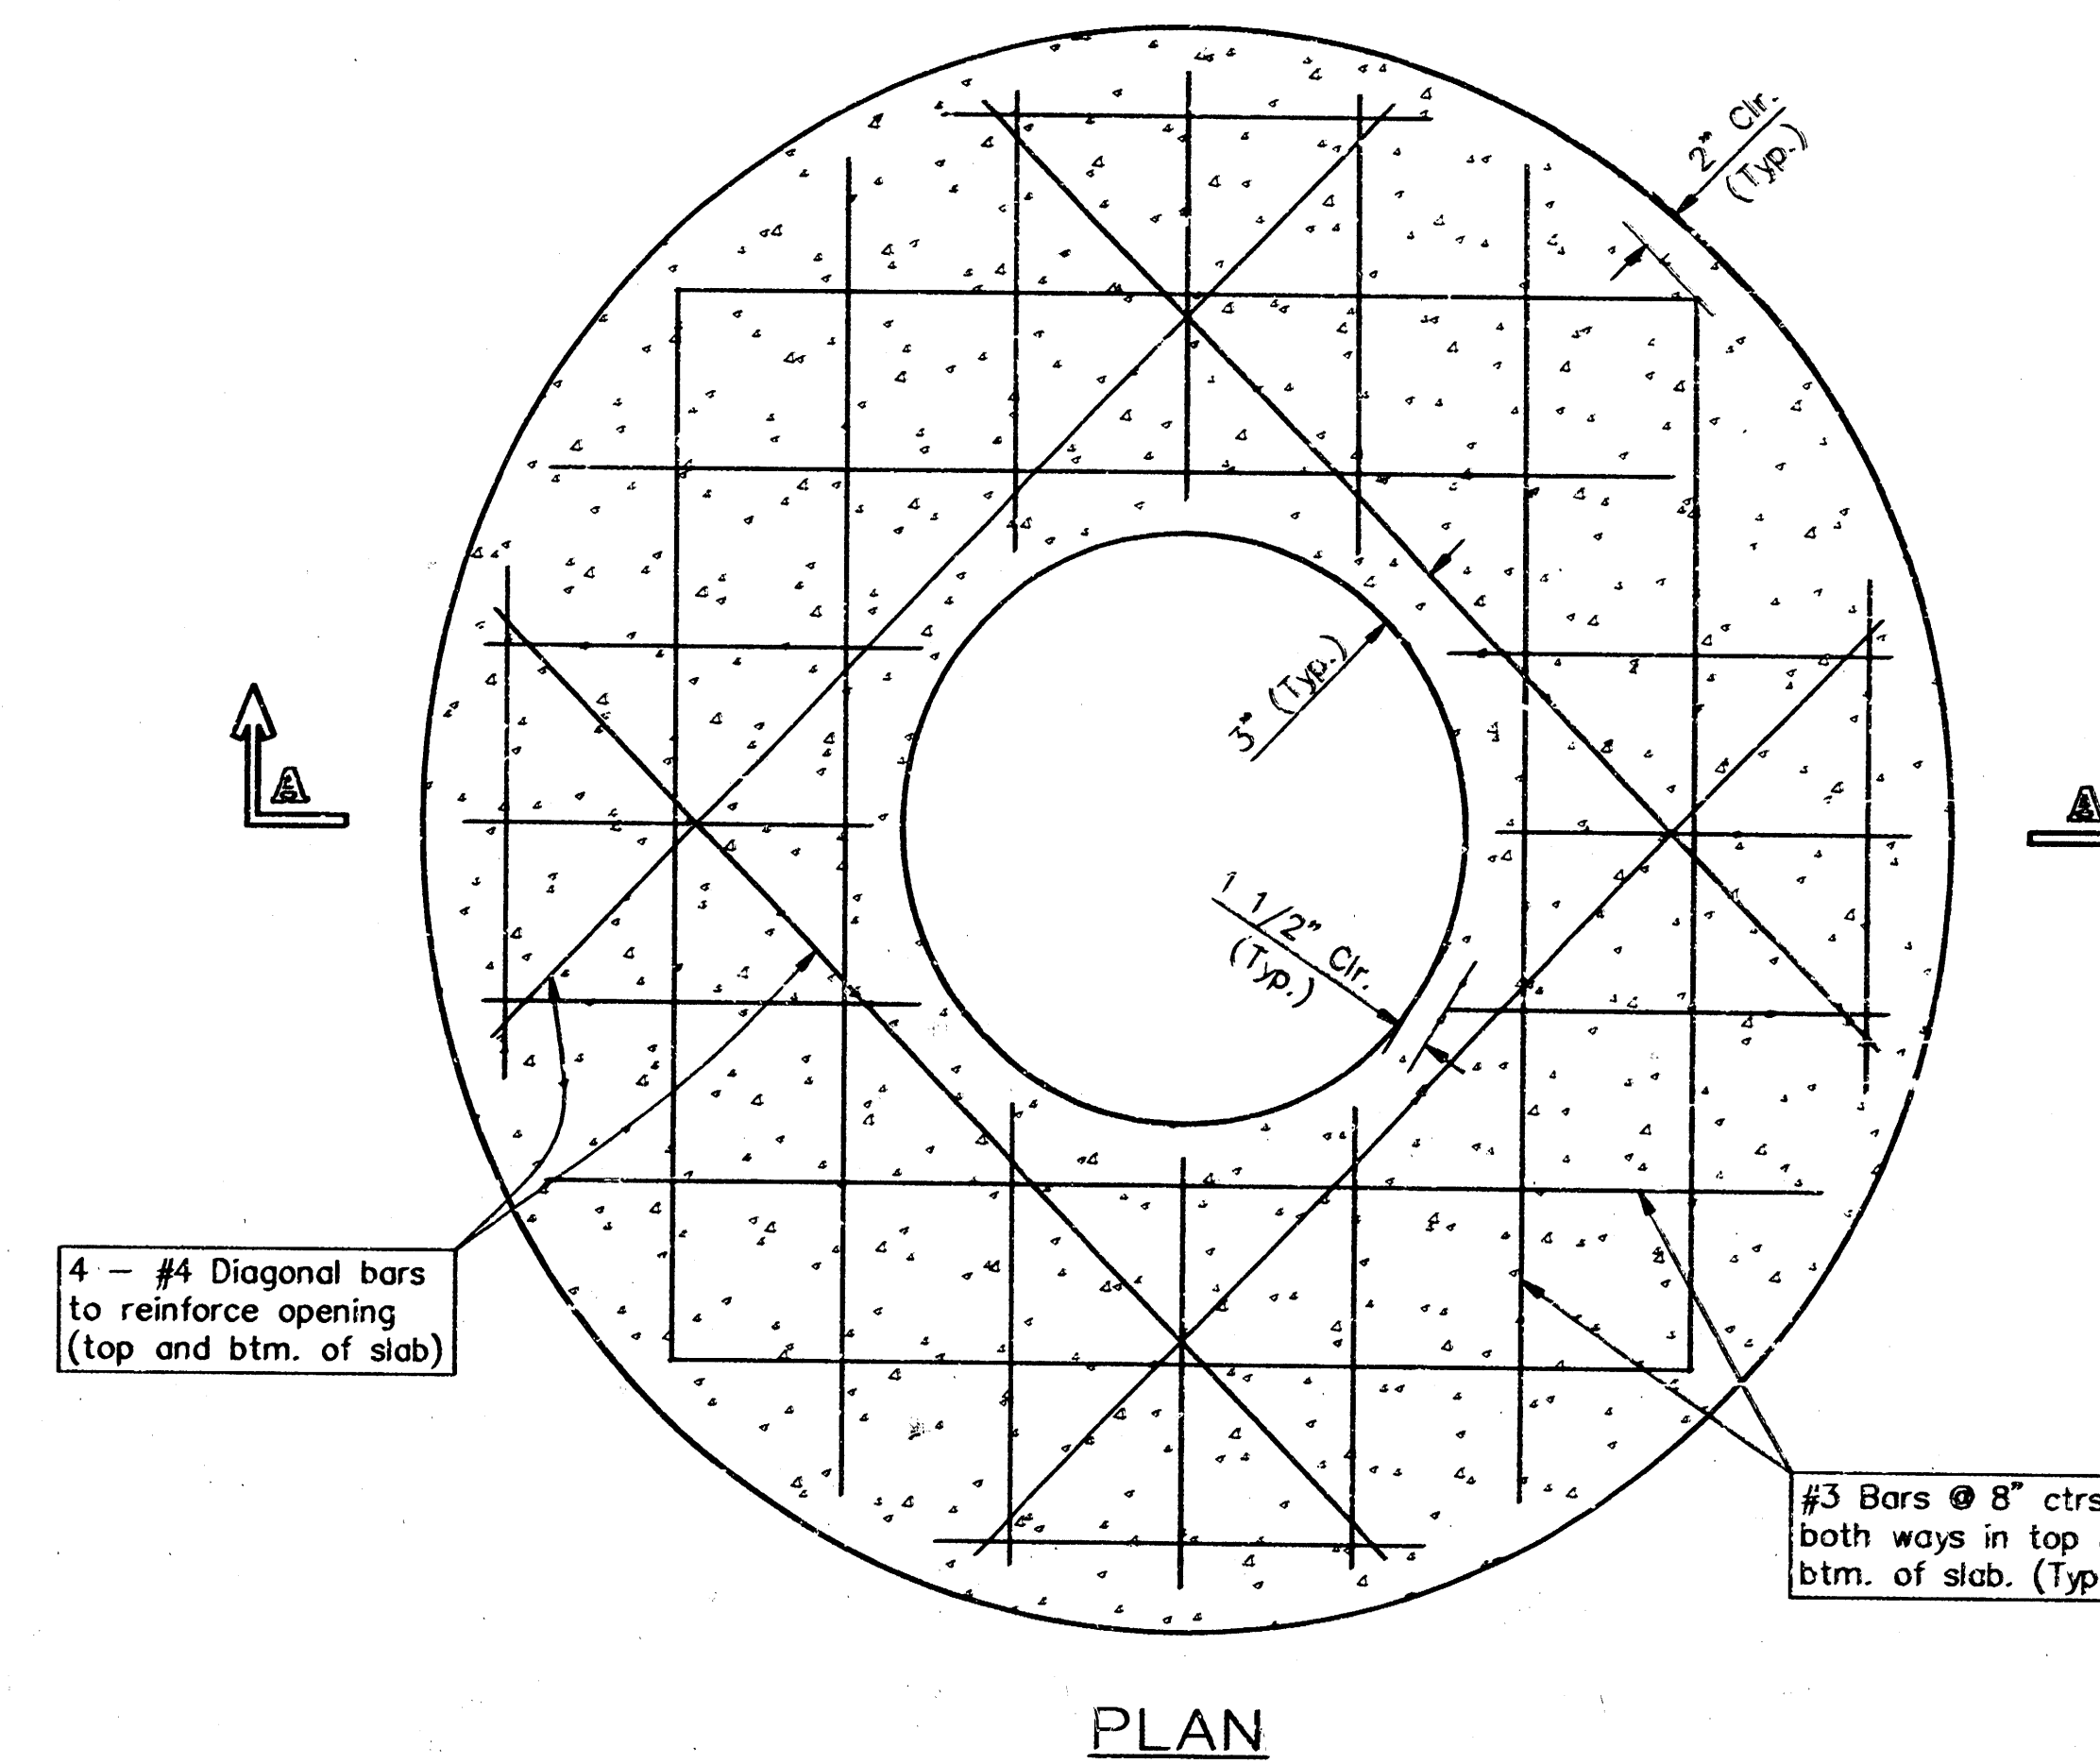

FLAT CONCRETE SLAB DETAILS


GENERAL NOTES

- Mortar used in masonry construction shall contain 8 sacks of cement per cubic yard. Concrete used in manhole bases shall conform to the requirements of concrete for concrete pavement construction as specified in the city standard paving specifications using city concrete cement mix without air entraining admixture. Mortar shall be placed around the manhole ring as shown on the drawings when manholes are constructed in unpaved areas. Manholes constructed where pipe sizes are smaller than 24" shall have an inside diameter of 4". Manholes constructed where pipe sizes are 24" or larger shall have an inside diameter of 5". Completed manhole shall be without leaks and water tight.
- Reinforcing steel shall be installed in the manhole bases and shall consist of no. 4 bars placed on 6" centers in both directions. The manhole base reinforcement shall be placed 6" above the bottom of the manhole base. All costs for furnishing and installing reinforcing steel shall be included in the unit price bid for the manhole.
- The floors of all manholes shall be shaped with flow channels such that the manholes will be self cleaning and free of areas where solids could be deposited as sewage flows through the manhole from all inlet pipes to the outlet pipe. Flow channels shall be formed to match the bottom halves of the inflowing pipes and the outflowing pipe as shown by the drawings. Manhole floors shall have slopes of 3 inches per foot in the areas outside of the flow channels sloped toward the flow channels. Pipes laid through manholes shall have the top half removed to neat lines for the full inside diameter of the manhole. Manhole floors shall then be shaped around the bottom half of the pipe which forms the flow channel.
- Pipes installed within the excavation made for the manhole shall be cradled with concrete to the limits of the manhole excavation. When clay pipe is used, the cradle shall extend to the first joint outside the manhole. The cradle shall be terminated at the clay pipe joint in a manner which will maintain the flexibility of the joint. Cost of cradle within manhole excavation or to clay pipe joints adjacent to manhole shall be included in the unit price bid for the manhole.
- Manhole cover castings and manhole frame castings shall conform to the requirements as indicated in the standard specifications and as shown in the standard detail drawings.
- The crowns of inflowing pipes shall never be set lower than the crown of the outflowing pipe.
- Standard shallow manholes shall be paid for at the unit price bid per each for the type and diameter indicated. All standard shallow manhole diameters will be 4' unless indicated otherwise.
- All brick used in manhole construction shall meet Grade SW of ASTM C652 or C62-87.


SECTION A-A

Type "P" & Type "C"			
Shallow Manhole			
Details			
BAUGHMAN COMPANY P. A.			
ENGINEERING, SURVEYING, & PLANNING			
316-262-7271 • 315 ELLIS • WICHITA, KANSAS 67211			
PROJECT NUMBER		SHEET	
488-78-245-82682-000-000-001		8	
DESIGN	DRAWN	APPROVED	DATE
C.O.W.	Staff		None
SCALE		None	
		11	


MANHOLE COVER
Weight = 180 Lbs.

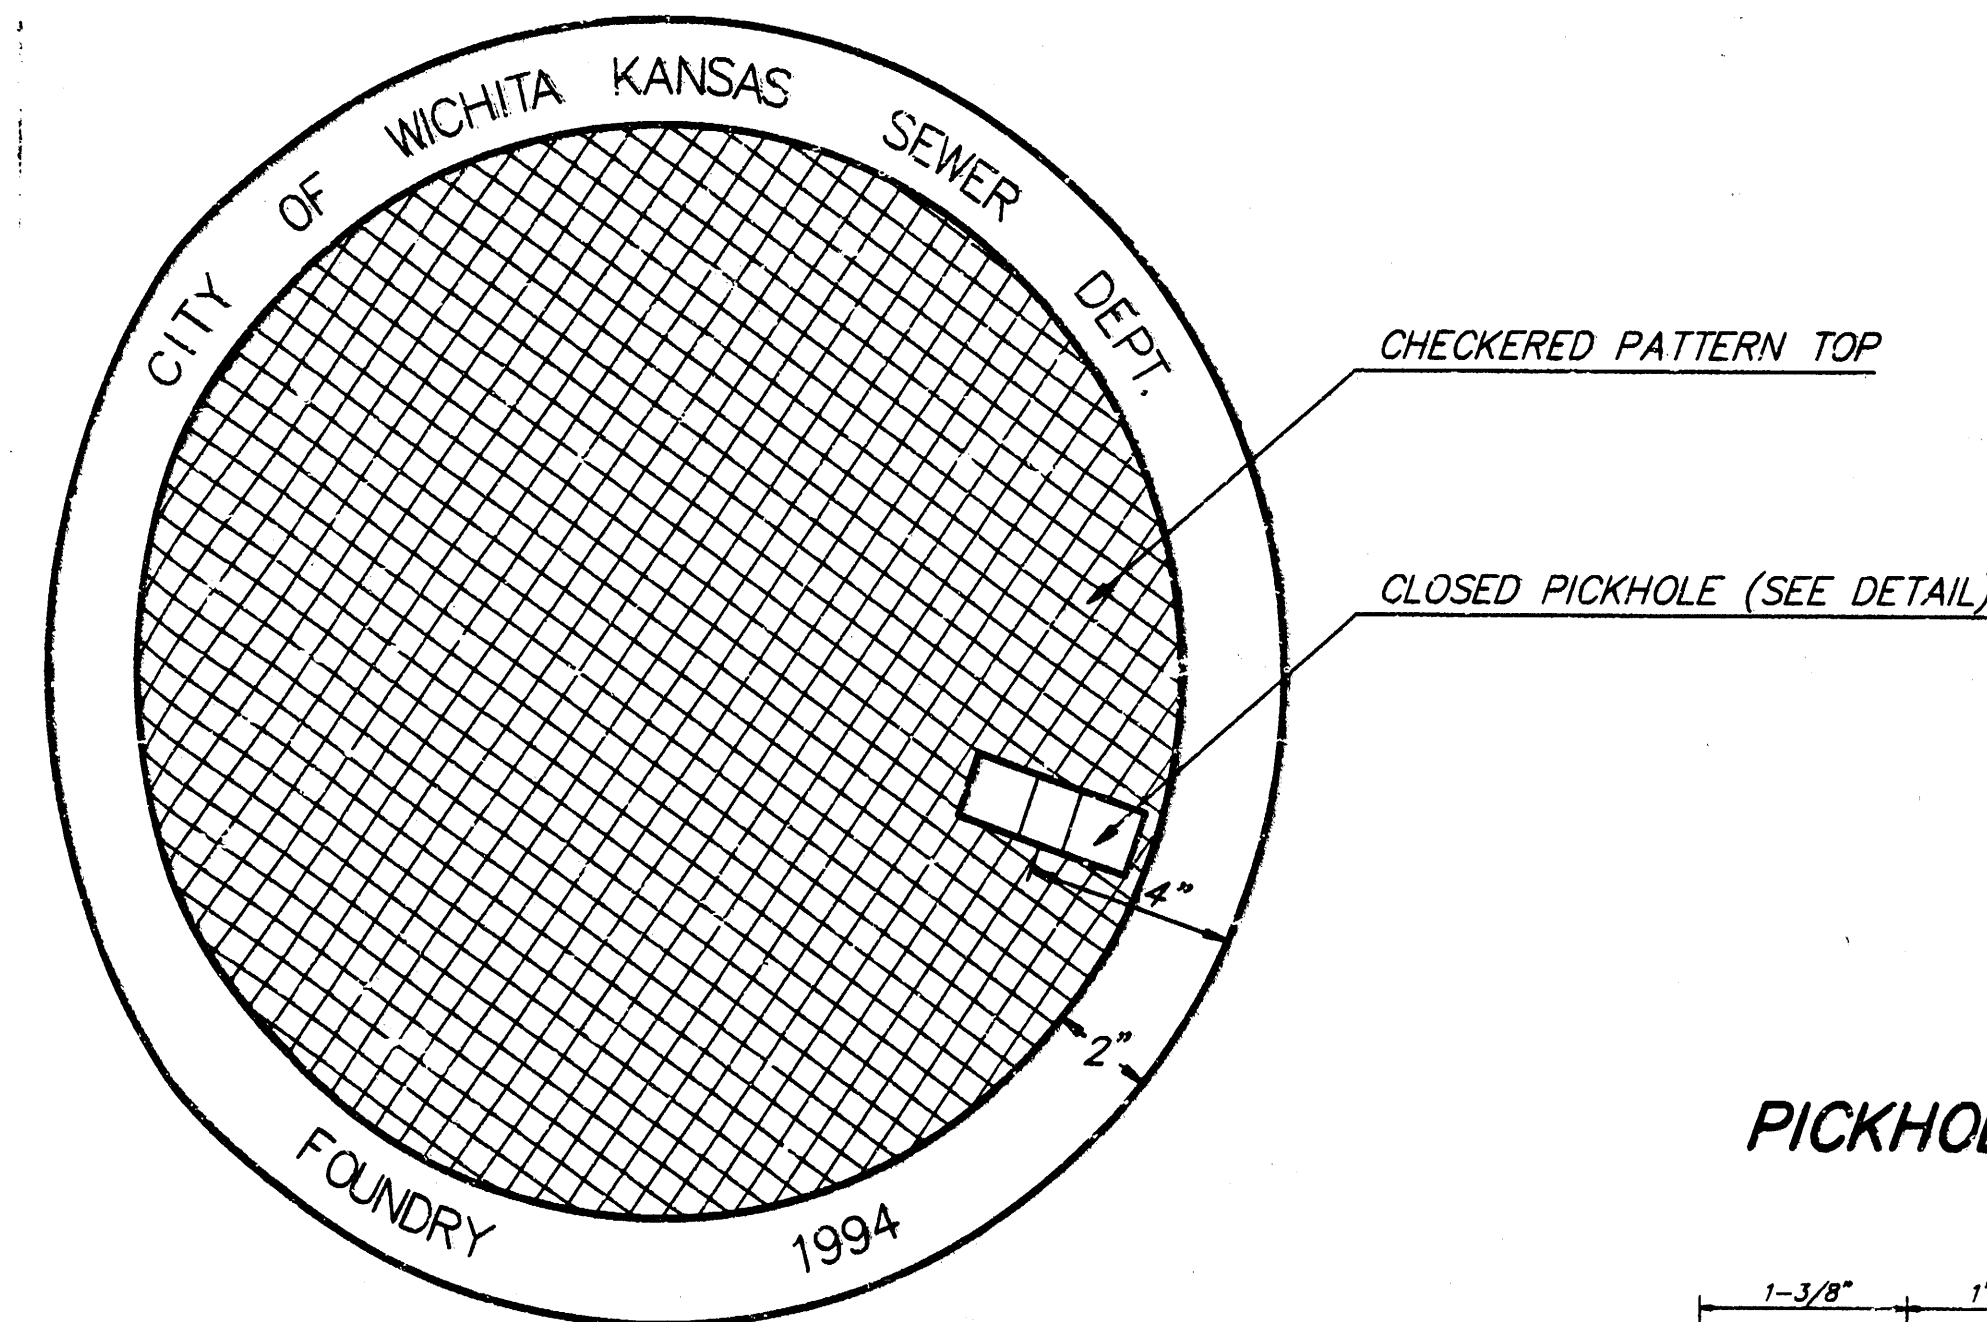

TOP VIEW

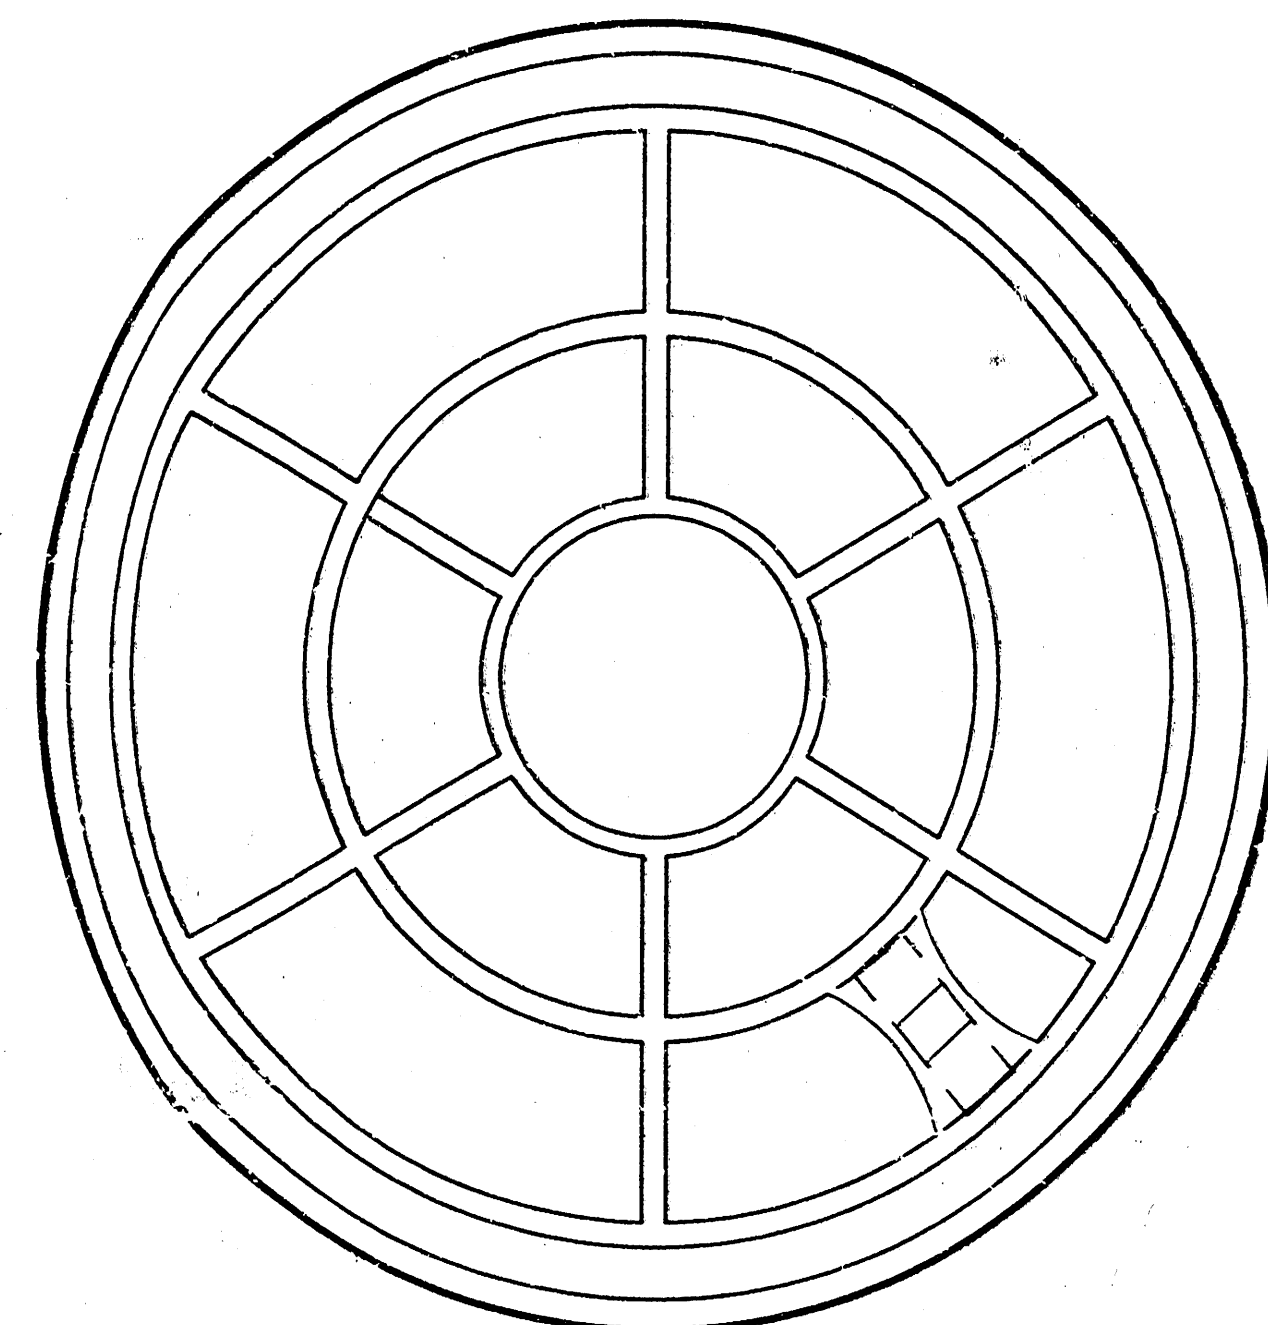


BOTTOM VIEW

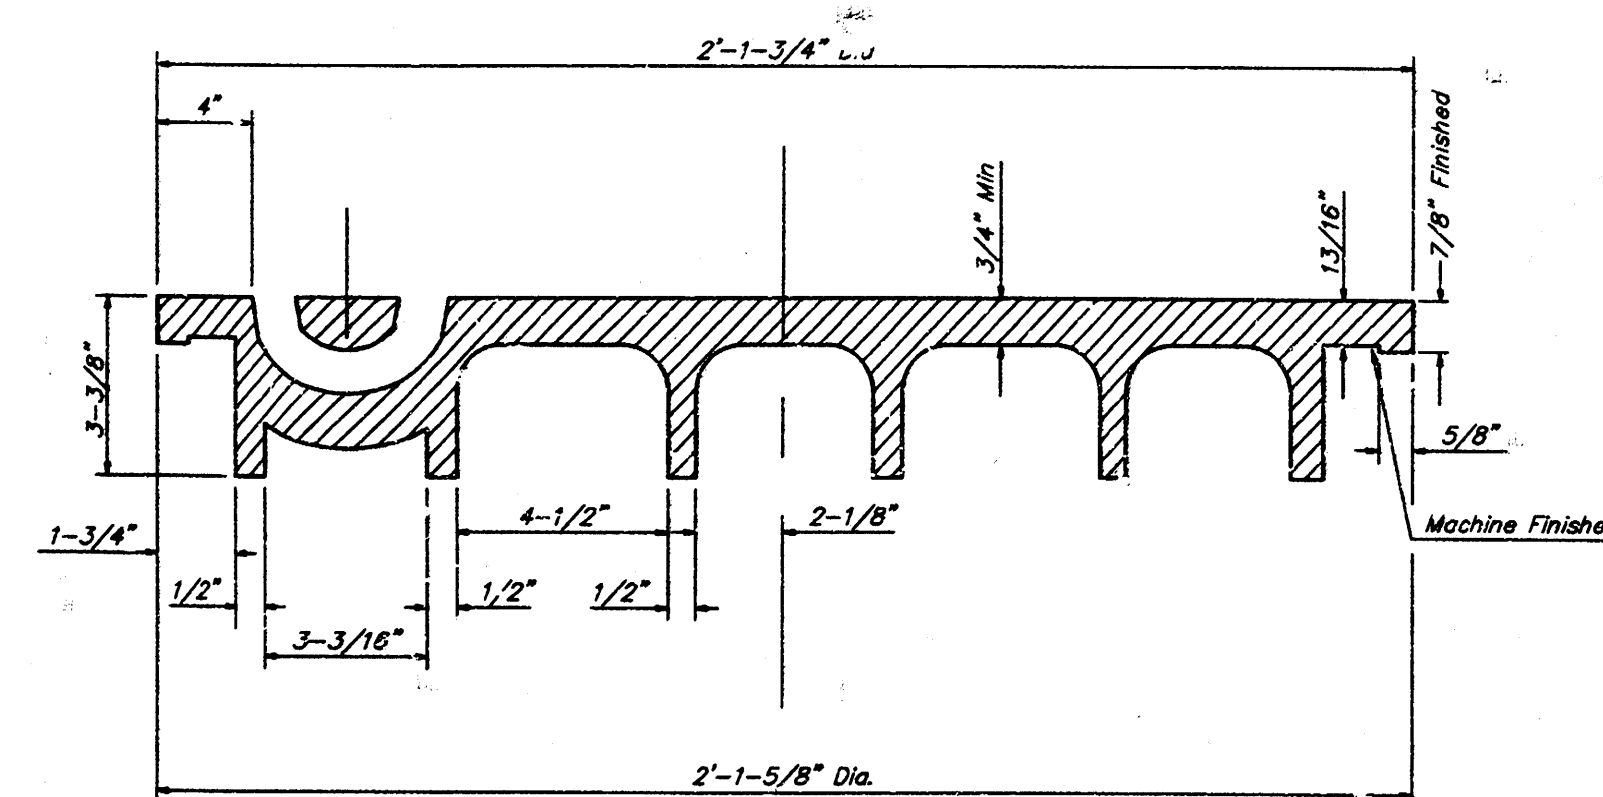


SECTION VIEW

PICKHOLE DETAIL

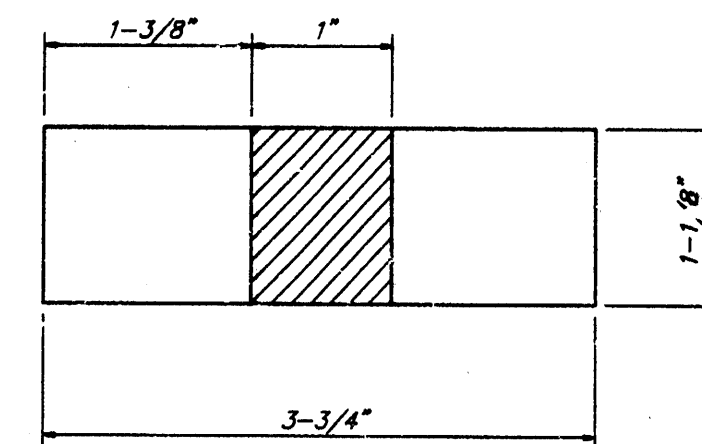

TOP VIEW

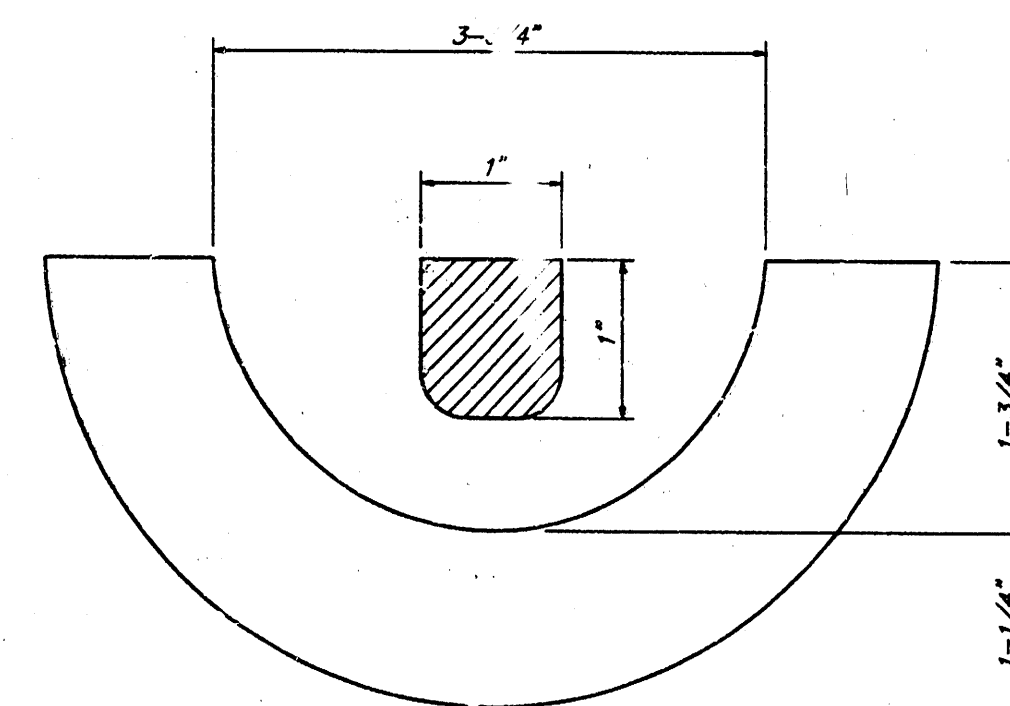


SECTION VIEW


MANHOLE FRAME AND COVER DETAIL

ADOPTED AS STANDARD DESIGN BY
CITY OF WICHITA, KANSAS

MANHOLE FRAME
Weight = 240 Lbs.

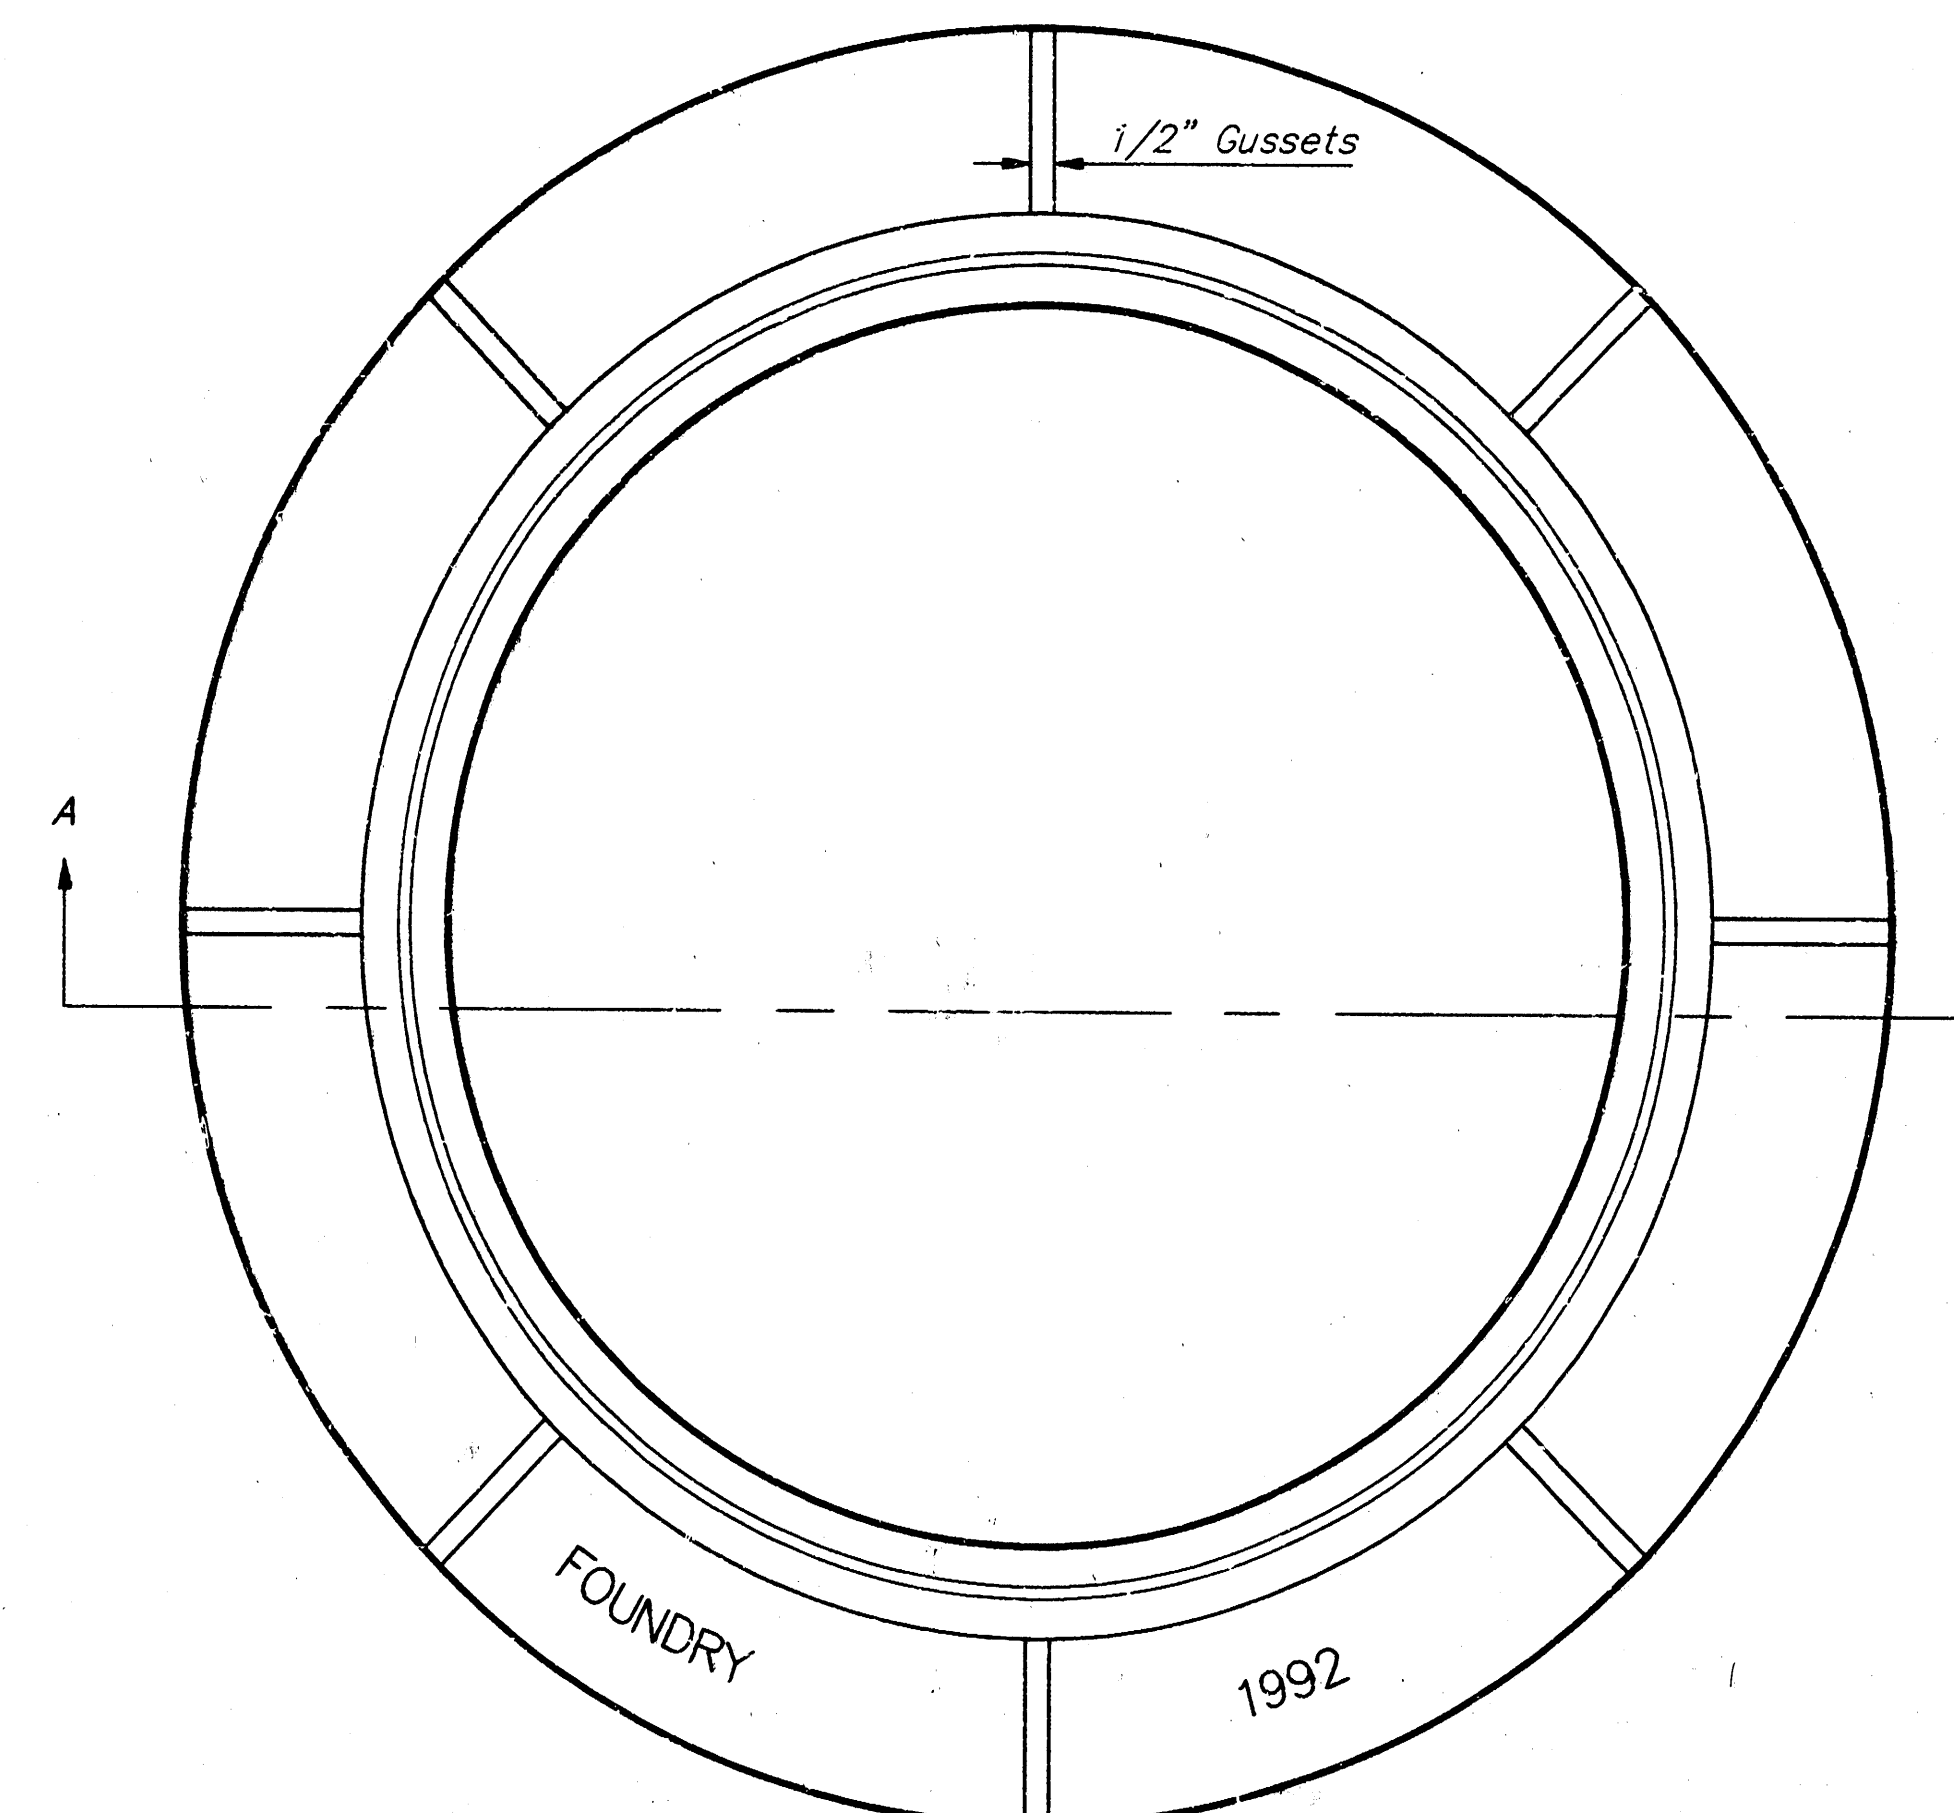

TOP VIEW

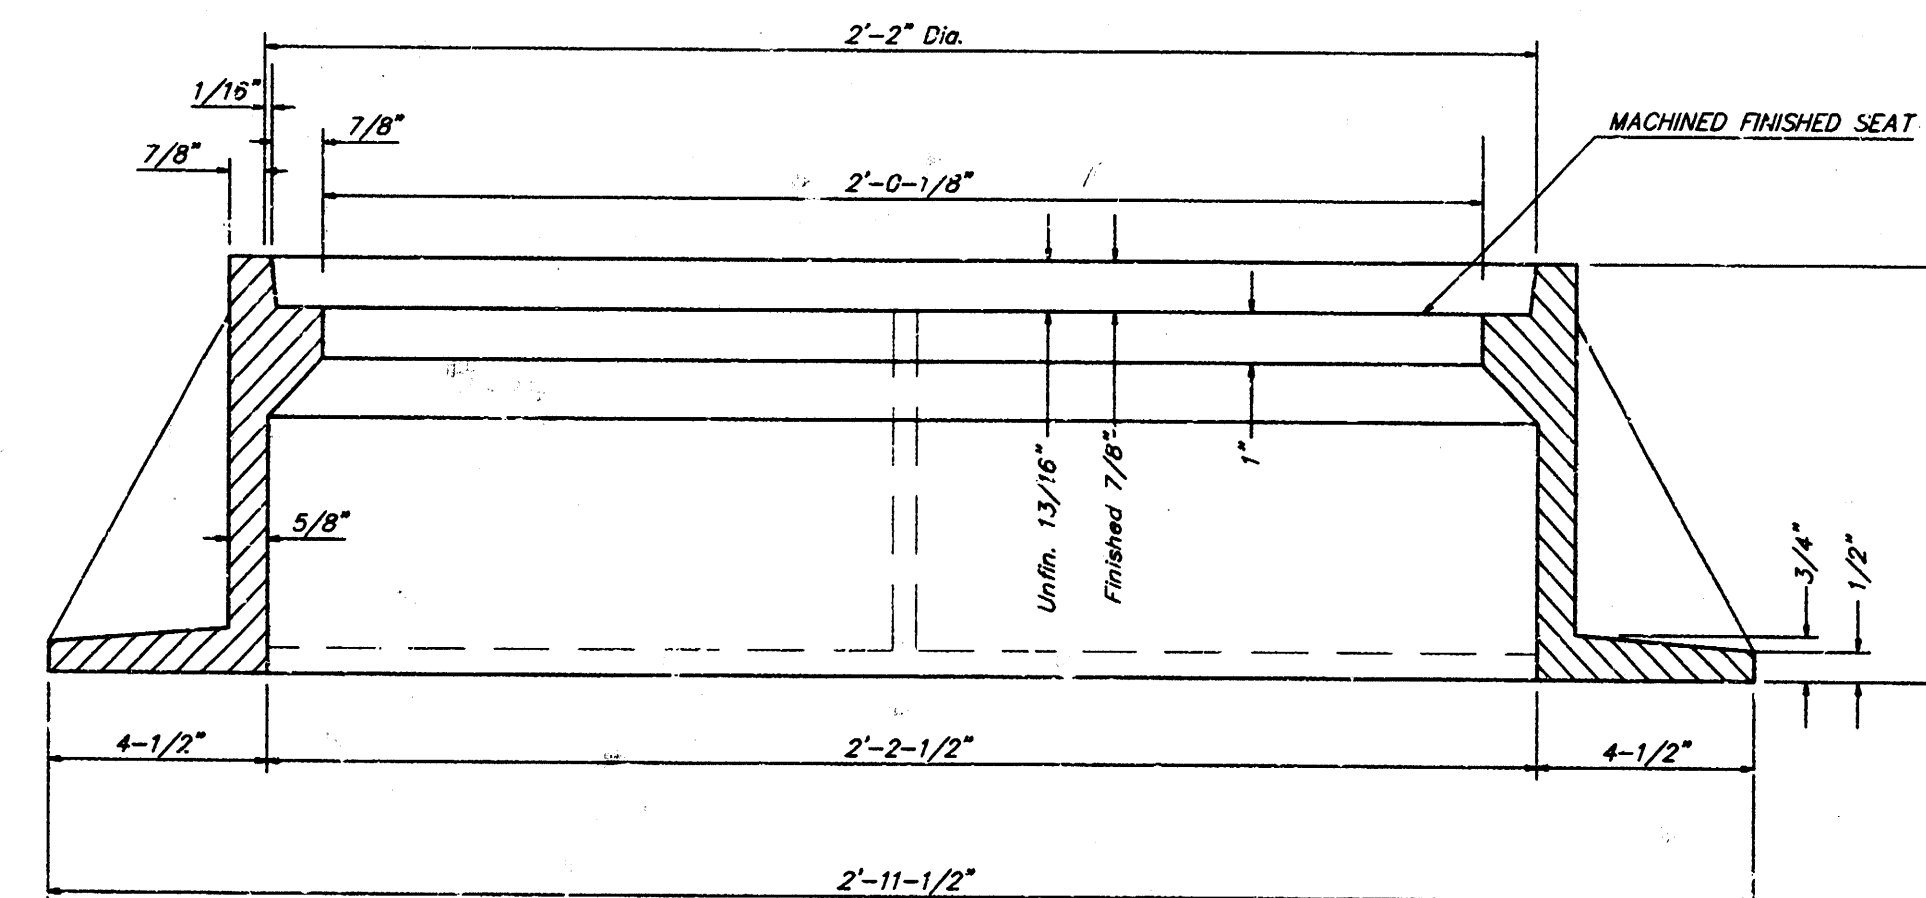

SECTION A-A

GENERAL NOTES

MANHOLE CASTINGS SHALL BE MANUFACTURED USING GOOD QUALITY GRAY IRON CONFORMING TO CLASS 30 OF A.S.T.M. DESIGNATION A-48. DIMENSIONS AND WEIGHTS SHOWN ON THE DETAILED DRAWINGS SHALL BE CONSIDERED AS MINIMUM REQUIREMENTS AND ANY DEVIATIONS FROM THE DIMENSIONS SHOWN MUST BE SPECIFICALLY APPROVED. THE FINISHED CASTINGS SHALL BE OF UNIFORM QUALITY, FREE FROM BLOWHOLES, POROSITY, HARD SPOTS, SHRINKAGE DISTORTIONS OR OTHER DEFECTS.

MANHOLE CASTINGS SHALL BE COATED WITH AN ASPHALT PAINT RESULTING IN A SMOOTH, TOUGH AND TENACIOUS COATING WHICH IS NOT BRITTLE OR TACKY.




MANHOLE CASTINGS SHALL BE MANUFACTURED SUCH THAT A COVER MANUFACTURED BY ANY ONE FOUNDRY WILL FIT INTERCHANGEABLY INTO A FRAME MANUFACTURED BY ANOTHER FOUNDRY AND STILL MEET ALLOWABLE CLEARANCES AND NON-ROCKING REQUIREMENTS. THIS WILL REQUIRE MANUFACTURING OF THE MATCHING FACES ON THE COVER AND THE FRAME TO CLOSE TOLERANCES.

THE OUTSIDE CIRCUMFERENCE OF THE VERTICAL FACE OF THE COVER AND THE INSIDE CIRCUMFERENCE OF THE VERTICAL FACE IN THE FRAME RECESS SHALL BE MANUFACTURED TO TOLERANCES SUCH THAT THE CLEARANCE BETWEEN THE COVER AND FRAME WILL NOT EXCEED 1/8\"/>


THE MANHOLE FRAME AND COVER SHALL BE MARKED WITH LETTERING INDICATING THE NAME OF THE MANUFACTURER AND THE YEAR WHEN THE COVER OR FRAME WAS CAST. THE COVER SHALL BE FURTHER IDENTIFIED WITH REGARDS TO OWNERSHIP USING LETTERS AT LEAST 1 INCH IN HEIGHT. THIS IDENTIFICATION SHALL BE "CITY OF WICHITA SEWER DEPARTMENT". THE WORD DEPARTMENT MAY BE ABBREVIATED. THE TEXTURE OF THE TOP SURFACE OF THE COVER SHALL BE MANUFACTURED IN A CHECKERED PATTERN DESIGN AS INDICATED ON THE DRAWINGS. SMOOTH BLOCKOUTS SHALL BE UTILIZED TO HIGHLIGHT THE LETTERING ON THE COVER SURFACE. THE TOTAL AREA OF SMOOTH SURFACE BLOCKOUT SHALL NOT EXCEED THE AREA AS INDICATED ON THE DRAWING. POSITIONING OF SMOOTH BLOCKOUTS AND LETTERING MAY VARY FROM THAT SHOWN ON THE DETAILED DRAWING.

RIDGE ROAD					
STD. MANHOLE RING & COVER					
BAUGHMAN COMPANY P. A.					
ENGINEERING, SURVEYING, & PLANNING					
315-262-7271 • 315 ELLIS • WICHITA, KANSAS 67211					
PROJECT NUMBER 488-78-245-82892-000-000-001					SHEET 9
DESIGN	DRAWN Staff	APPROVED	DATE	SCALE	OF 11


VERTICAL RISER DETAILS ADOPTED AS STANDARD DESIGN BY CITY OF WICHITA, KANSAS OCTOBER 1992

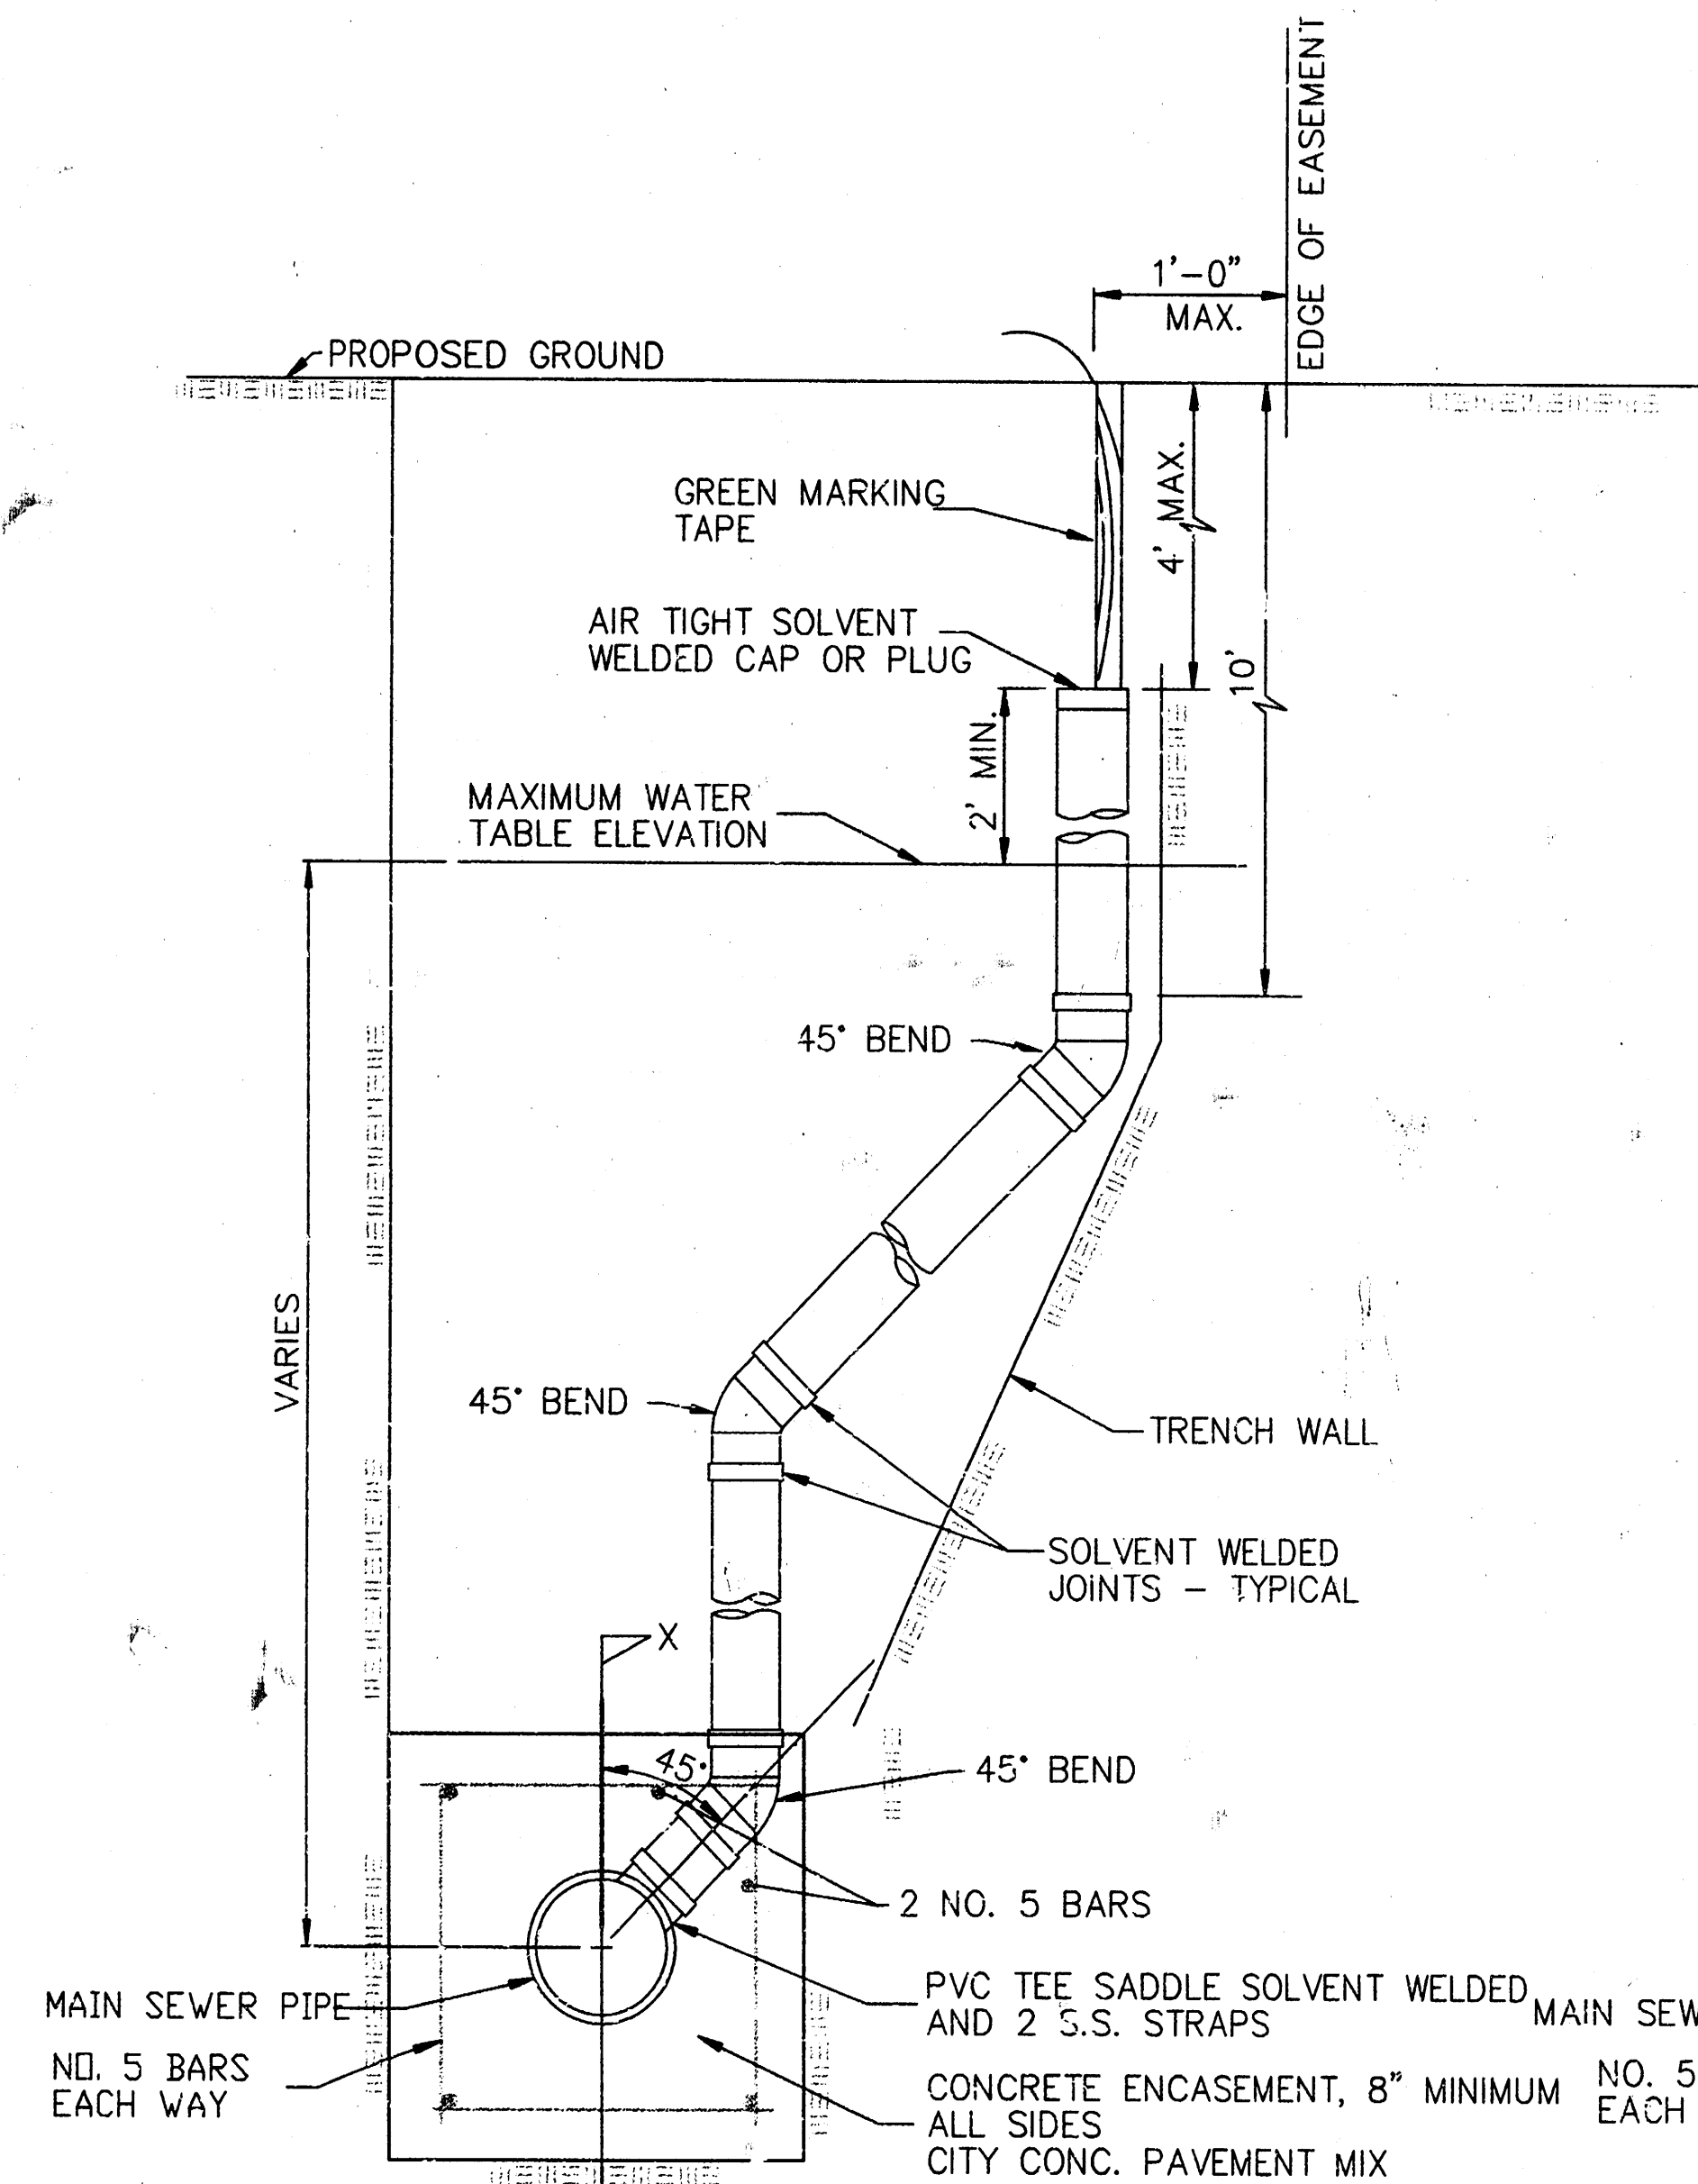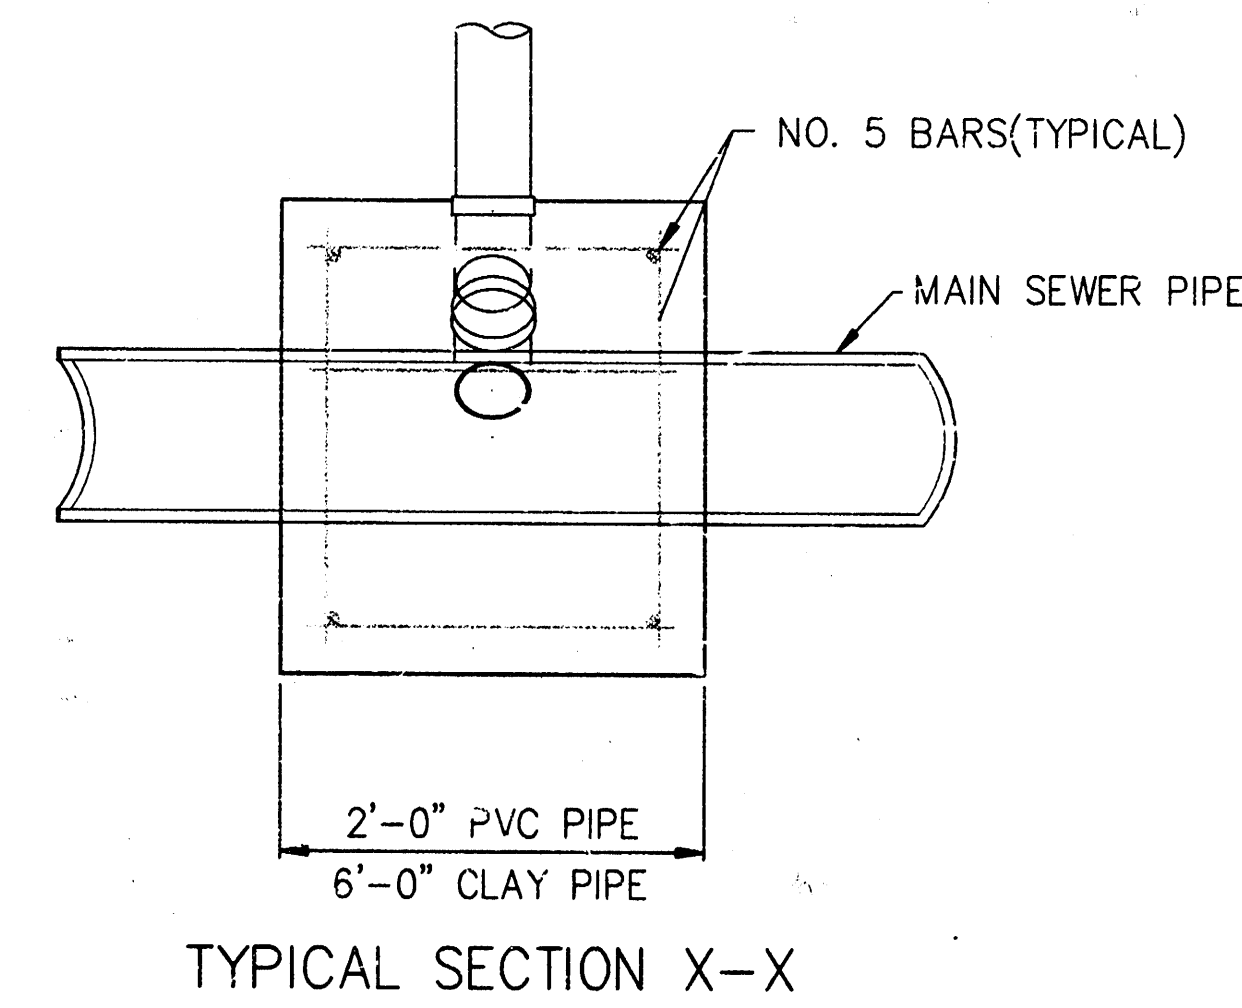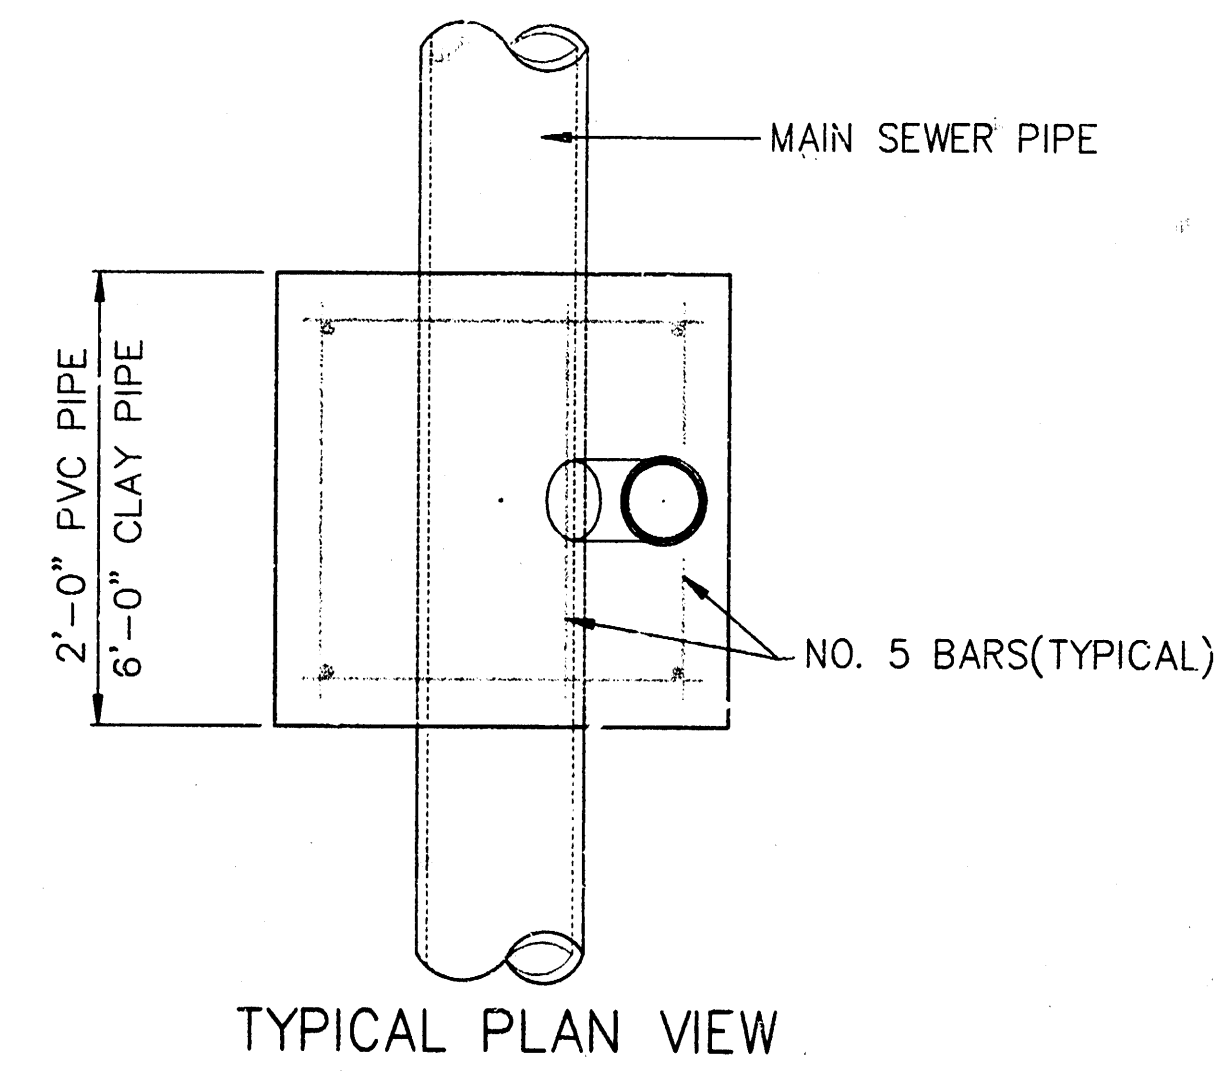

METHOD "A"

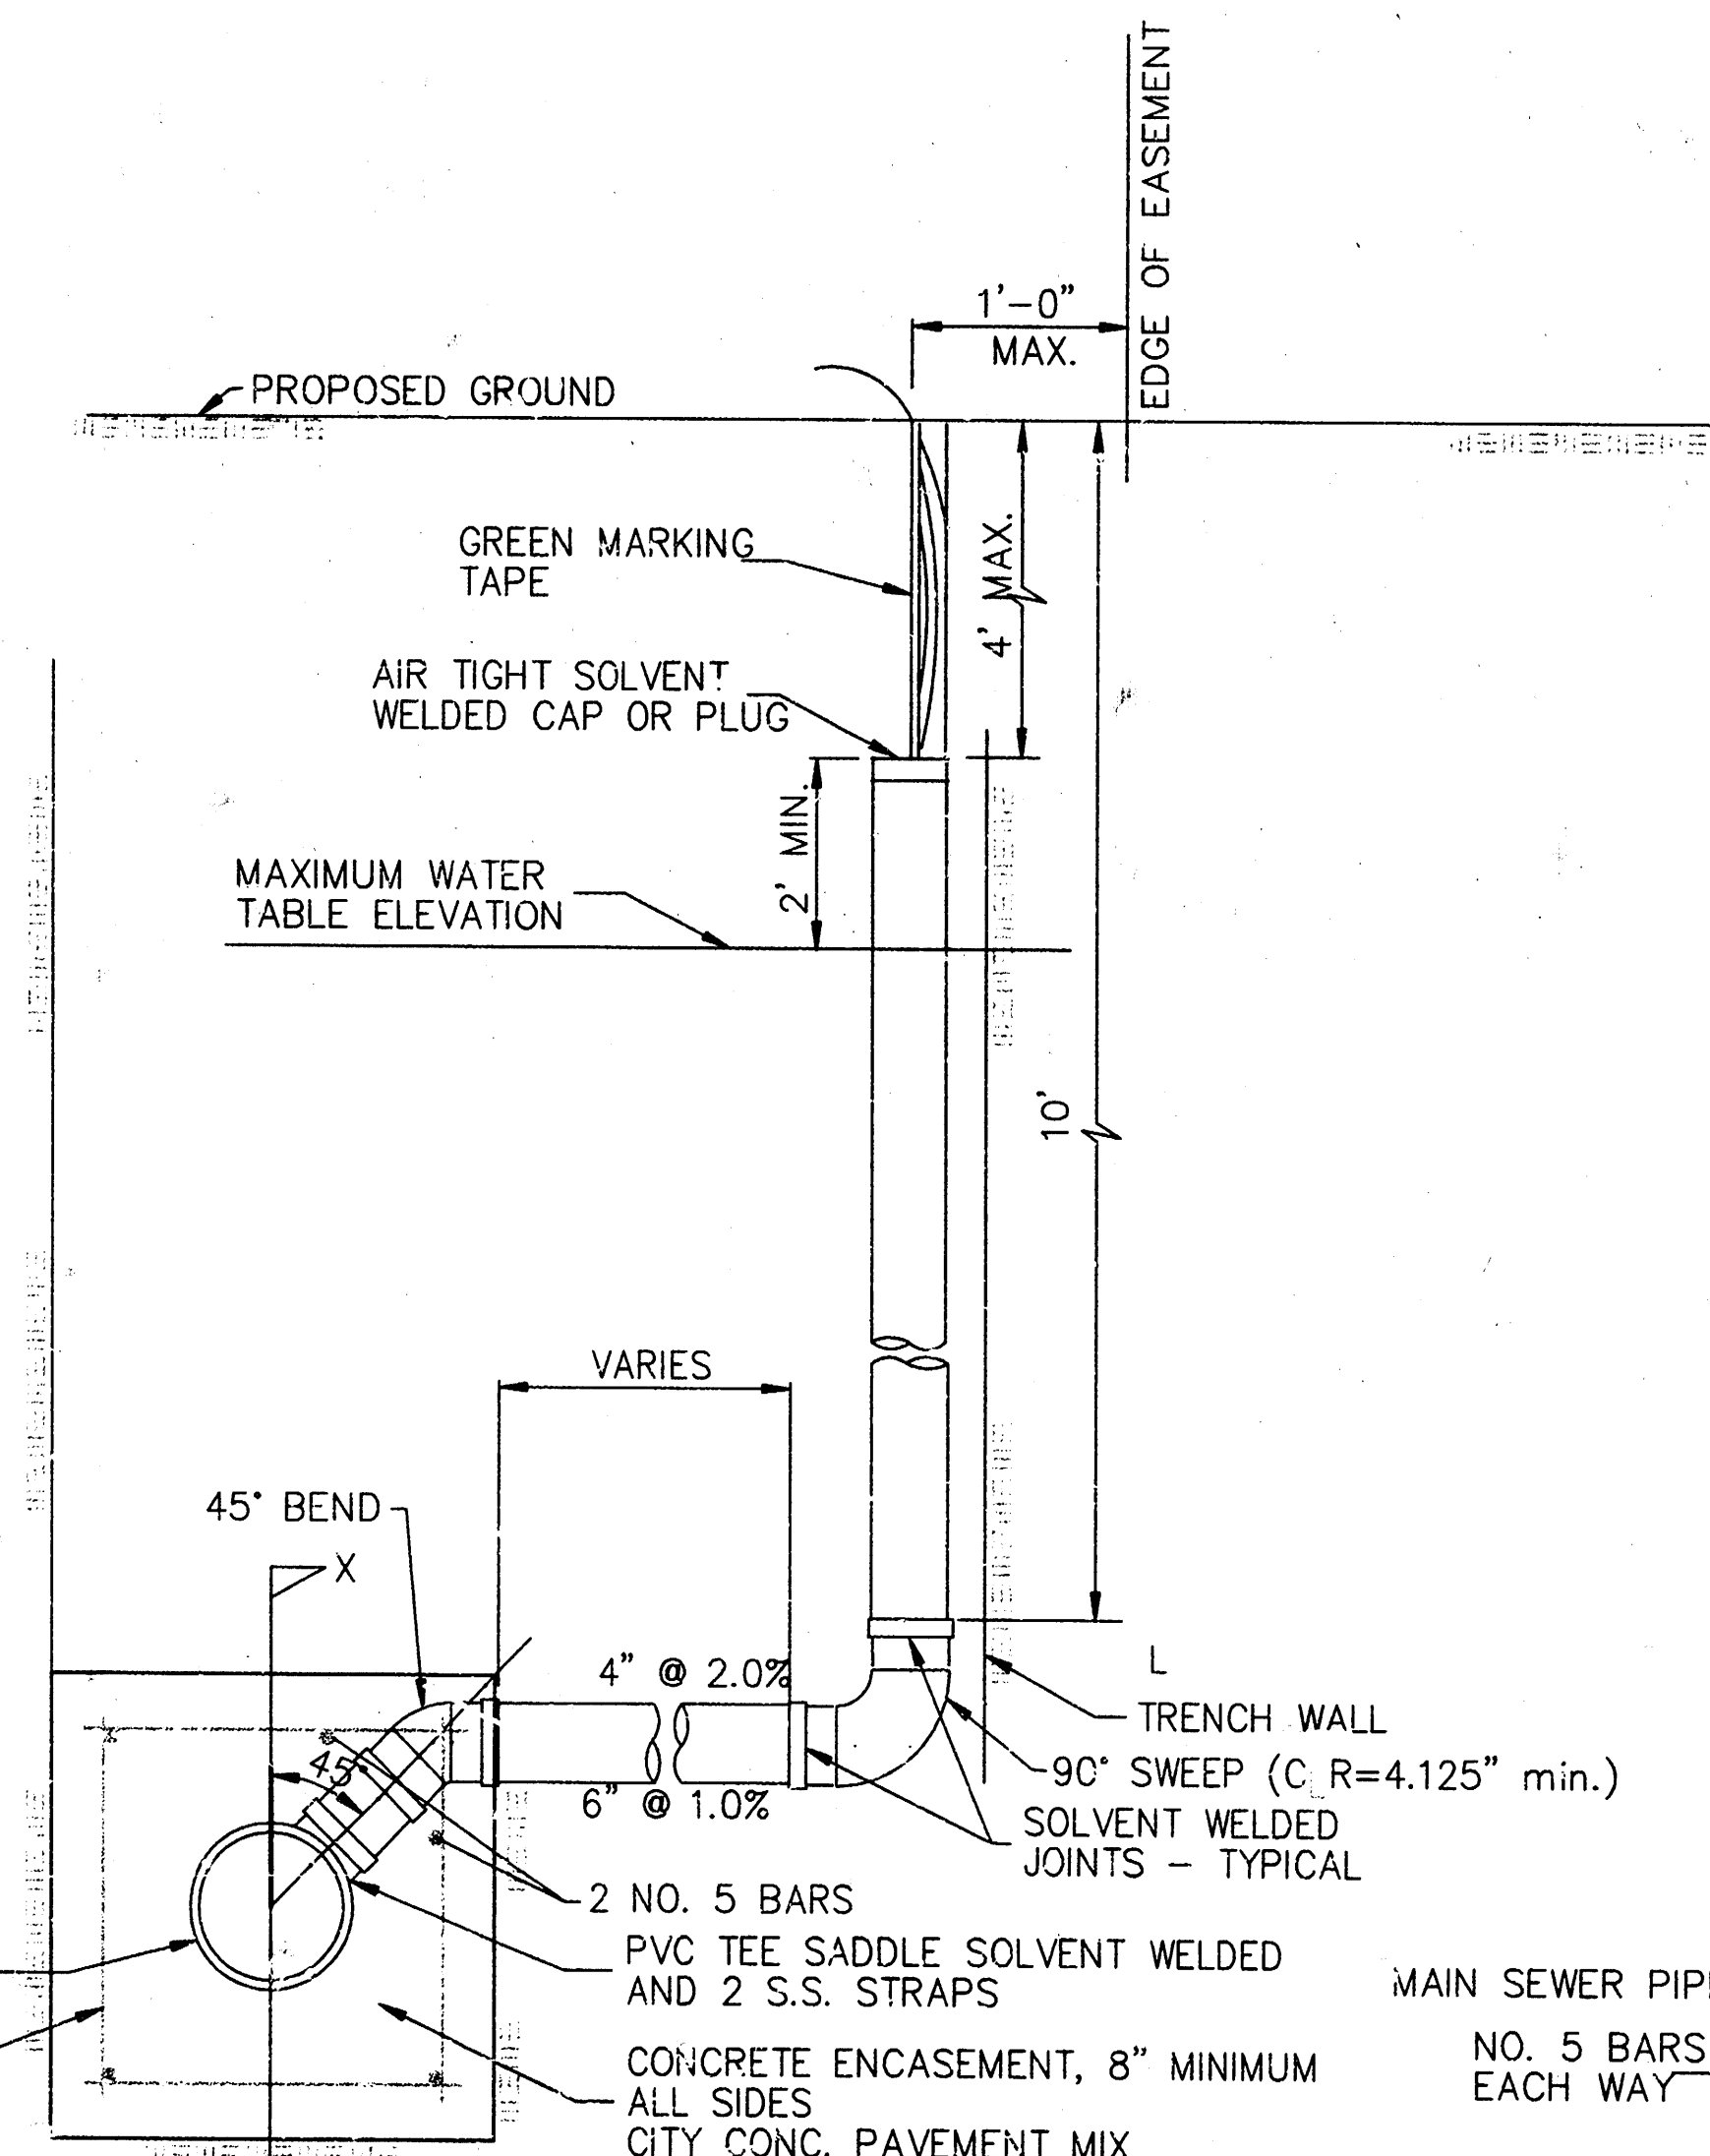

METHOD "B"

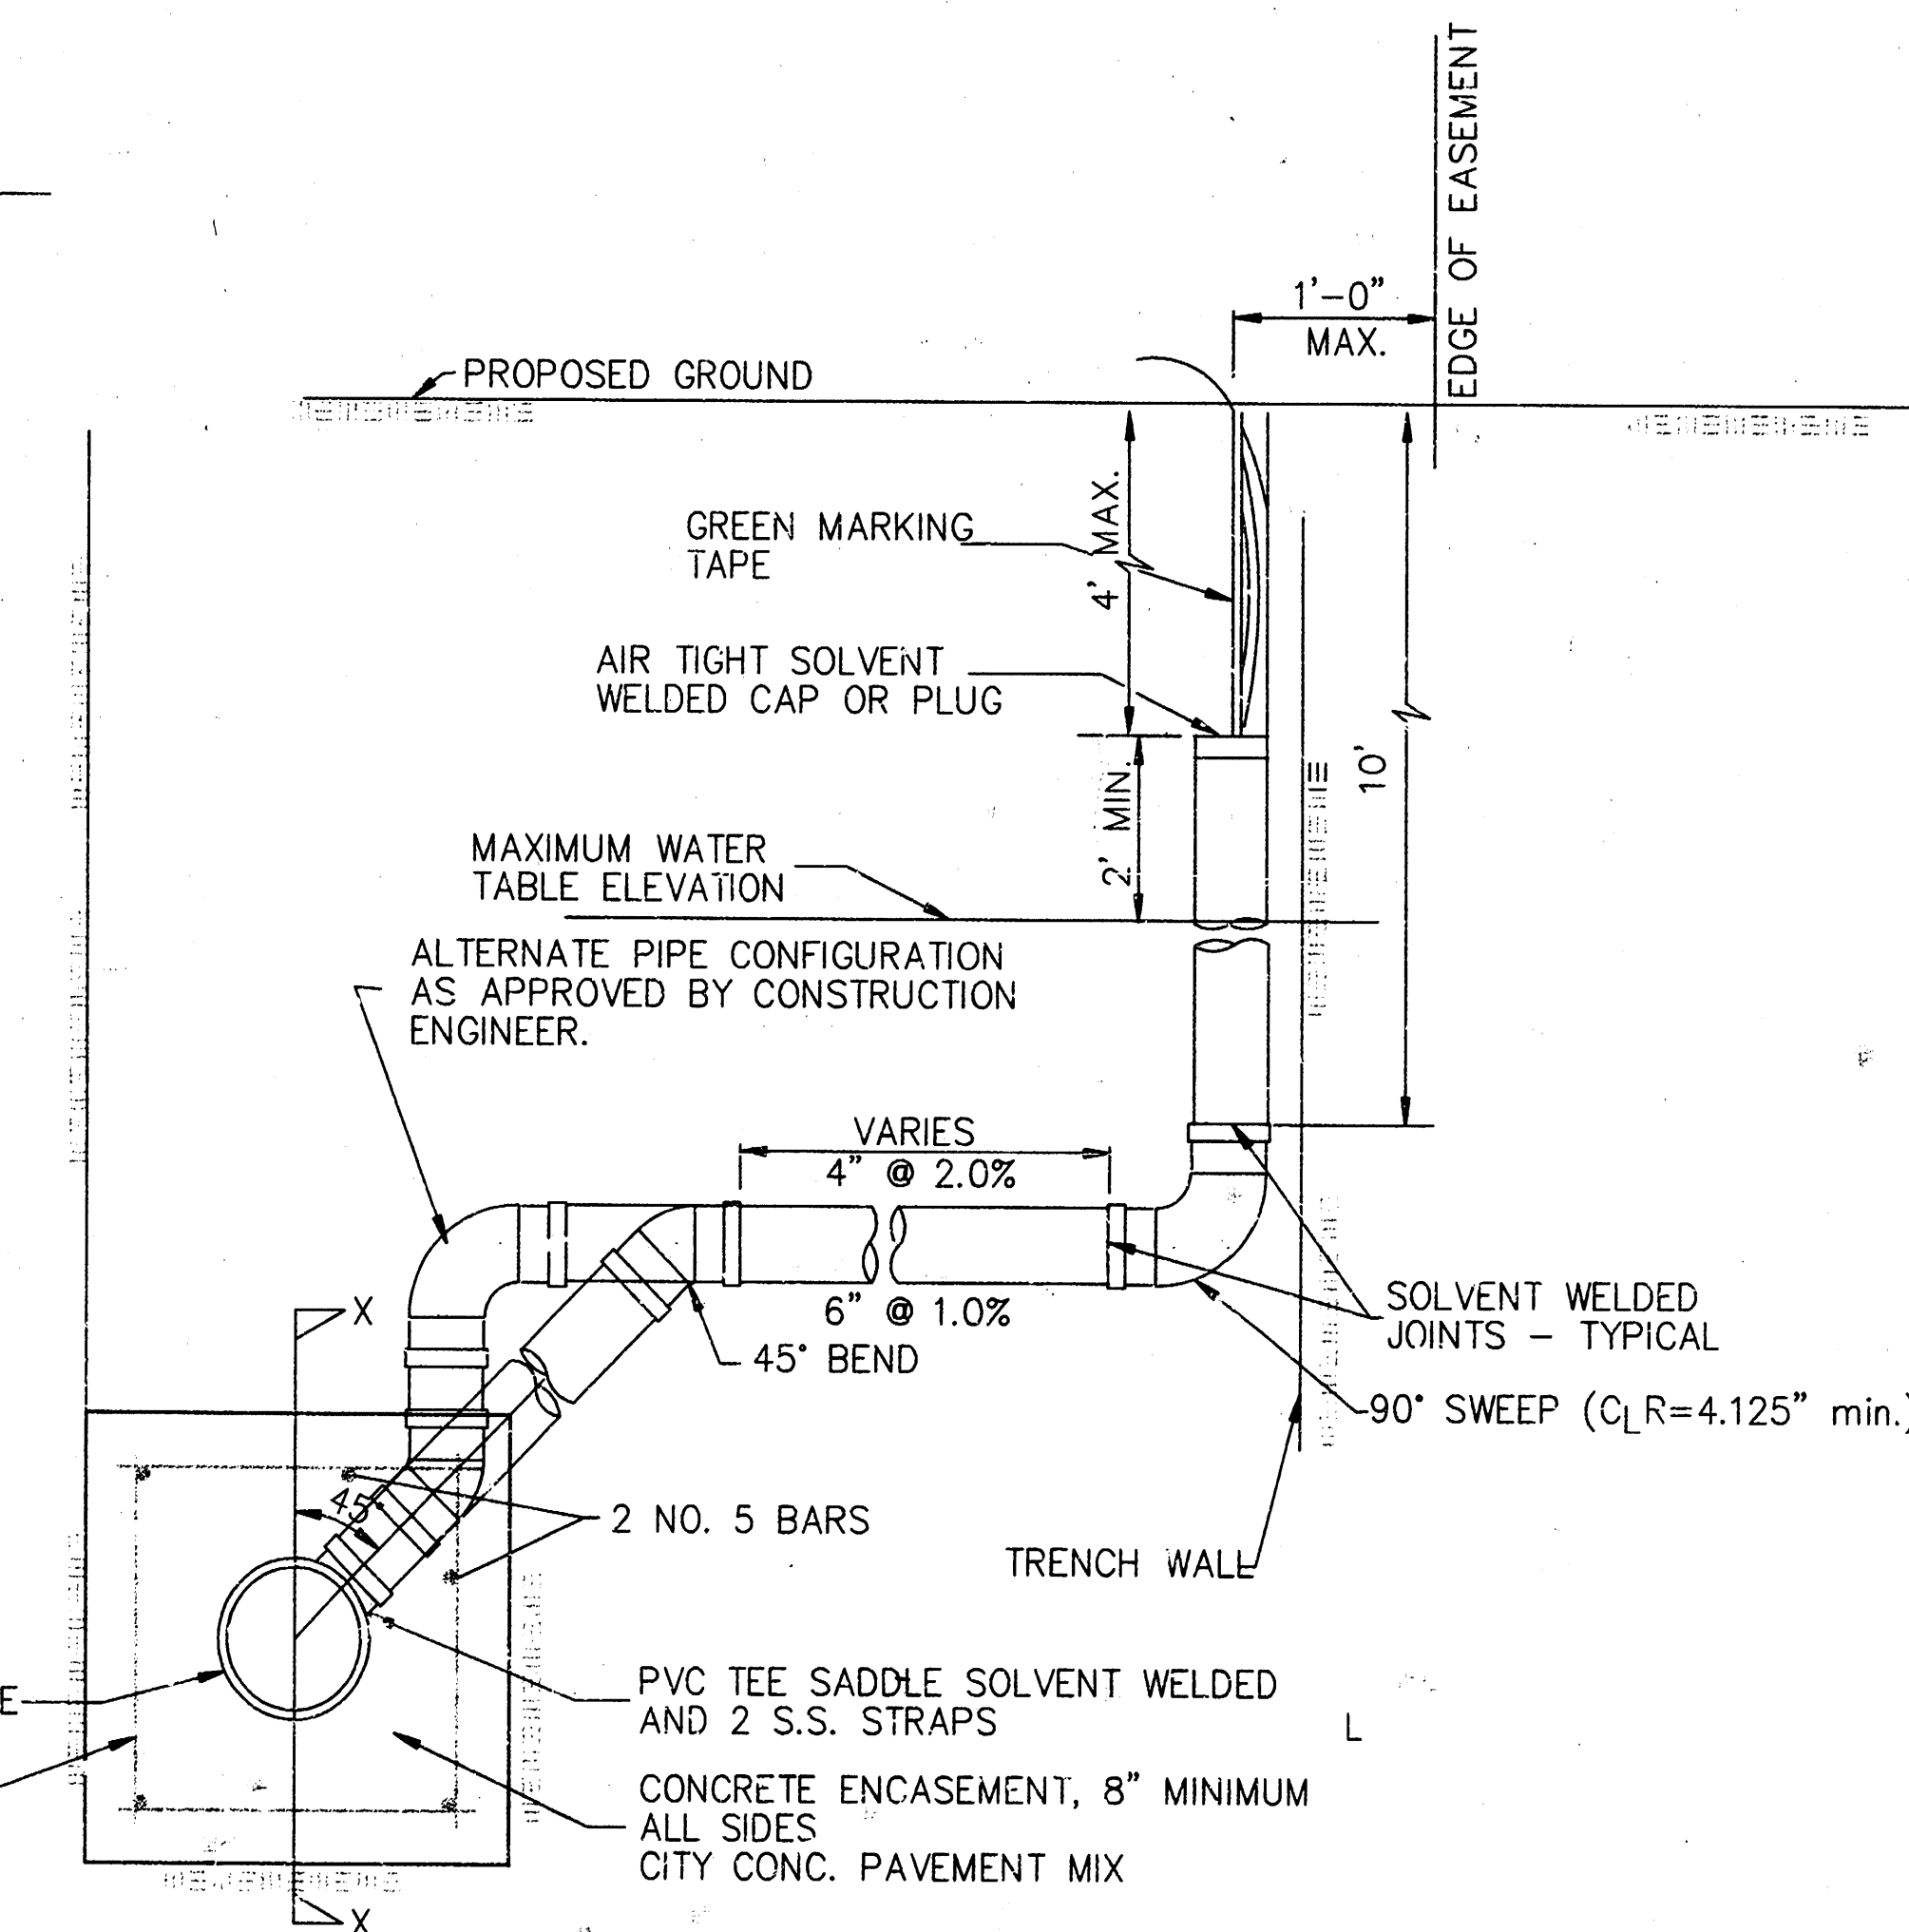

METHOD "C"

NOTE: RISER PIPE REQUIREMENTS AT MANHOLE STUBS SHALL BE SIMILAR TO THOSE SHOWN ABOVE.

GENERAL NOTES

1. RISERS. Risers shall be installed to serve all lots or tracts where the sanitary sewer main is below the water table. Risers shall also be installed to serve all lots and tracts where the sanitary sewer main depth is greater than 12 feet below the proposed ground elevation. Installation of risers because of field conditions shall be as approved by the Construction Engineer. The location of the risers to serve developed property shall be approved by the property owner and the Construction Engineer.
2. PIPE STUBS. Pipe stubs shall be installed in manholes where locations of manholes will provide satisfactory service connection as determined by the Construction Engineer. The vertical distance between the flowline of the manhole pipe stub and the flowline of the sanitary sewer main out of the manhole shall not exceed 2 feet. Risers shall be utilized at manhole pipe stubs as indicated in Note 1. Manhole pipe stubs shall be set such that the top of the stub is not lower than the top of the sanitary sewer main.
3. SIZING. Pipe stubs and risers shall be sized according to the plans and riser table where risers are indicated by the plans. Where risers or pipe stubs are required because of field conditions, the risers and stubs shall be six-inch diameter for commercial or industrial properties and 4" or 6" diameter for residential properties, based on lot size and sanitary sewer main depth. Sizing of risers and stubs shall be approved by the Construction Engineer prior to installation.
4. RISER OR STUB MATERIAL. Risers and stubs shall be constructed of SDR 35 PVC Pipe or Schedule 40 PVC Pipe, meeting the requirements of the latest revision of A.S.T.M. All pipe joints shall be solvent welded.
5. REINFORCED CONCRETE ENCASUREMENT. Riser connections to clay pipe sanitary sewers shall be reinforced concrete encased both ways from the riser centerline. The reinforced concrete encasement shall extend three feet from the riser centerline or stop at the first sanitary sewer pipe joint within three feet of the riser centerline. Riser connections to PVC Sanitary Sewer mains shall be reinforced concrete encased one foot each way from the riser centerline. The concrete encasement shall be reinforced using reinforcing steel as shown in the appropriate drawing. The concrete shall conform to the City Standard Specifications for concrete pavement.
6. BEDDING. Bedding around the sanitary sewer riser shall be compacted Pipe Bedding Type 1 or 2. The bedding shall be placed and compacted from the depth of the sanitary sewer main to the top of the sanitary sewer riser pipe. Compacted Pipe Bedding Type 1 or 2 shall be required for all risers whether constructed in vertical wall or sloped wall trenches. Bedding material and construction practices shall be approved by the Construction Engineer prior to installation.
7. SUPPORT OF RISERS. Sanitary sewer riser pipe shall be supported during trench backfill. The riser pipe shall be held in a vertical position at all times until trench backfill and compaction has been completed. Contractor's methods for supporting and backfilling the riser pipe shall be approved by the Construction Engineer.
8. PLUGGING. The ends of the riser pipes and manhole stubs shall be plugged using an airtight solvent welded cap or plug. Cap or plug fittings shall be approved by the Construction Engineer prior to installation. Caps or plugs which do not provide an airtight seal will not be accepted.
9. TOP OF THE RISER PIPE. The top elevation of the sanitary sewer riser pipe shall be built per plan elevations, unless otherwise directed by the Construction Engineer. Where riser elevations are not shown on the plans, the top of the risers shall be set at an elevation four feet below the proposed ground surface. If ground water is encountered, the top of the riser pipe shall be set at an elevation two feet (min.) above the maximum water table elevation, regardless of the riser elevation shown on the plans.
10. MARKING. Locations of the ends of the sanitary sewer riser pipe shall be marked by fastening green colored plastic tape to the end of the riser. The tape shall be supported by a length of wooden 2 x 4, extending from the top of the riser pipe to the proposed ground surface. The green tape shall be visible and extend one foot above the proposed ground surface. The green tape shall be 4 mil Polyethylene film with a minimum width of three inches, specifically manufactured for the purpose of identification of underground sewers.
11. LOCATION MEASURES. The project inspector shall record and document the location of all risers constructed as measured from the nearest manhole, indicating the direction from the manhole, the direction and distance from the main, riser size, and elevation of the top of the riser.
12. RISER LOCATION. The riser shall be located per plan if shown. If not shown on the plan, the riser shall be located at the center of the lot, within one foot of the property side of the easement for the lot being served. All riser locations shall be approved by the Construction Engineer prior to installation.
13. PAYMENT. "Sanitary sewer risers" shall be paid for at the contract unit price per each, which price shall be full compensation for all pipe, fittings, marking tape, length of wooden 2 x 4, reinforced concrete encasement, support during backfill, backfill, labor, site restoration, and any other items necessary to complete the work.

"Manhole stubs" shall be paid for at the contract unit price per each, which shall be full compensation for all labor, material, and incidentals necessary to complete the work including all pipe, fittings, reinforced concrete encasement, and all other items as required and listed for "Sanitary Sewer Risers".

City of Wichita Standard					
Riser Details					
BAUGHMAN COMPANY P.A.					
ENGINEERING, SURVEYING, & PLANNING					
316-262-7271 • 310 ELLIOT • WICHITA, KANSAS 67211					
PROJECT NUMBER					
488-78-245-82682-000-000-001					
DESIGN	DRAWN	APPROVED	DATE	SCALE	SHEET
					10
					11

HICKORY CREEK PLANNED WICHITA, SEDGWICK COUNTY, KANSAS

State of Kansas) SS We, Baughman Company, P.A., Surveyors in
Sedgewick County and state do hereby certify that we have surveyed and
divided the above described property into lots, blocks, streets and
reserves, and that the accompanying plat is a true and correct copy of the
property surveyed, described as follows: The E1/2 of the NW 1/4 of
Sec. 13, T19S, R2E, W of the 6th P.M., Sedgewick County, Kansas.
Existing public easements and dedications being received by
virtue of K.S.A. 12-512(b).

Baughman Company, P.A.

Gregory F. Seimons



Little Survey


Now all men of these presents that we
the undersigned have caused the land described in the surveyors to
be divided into lots, blocks, streets and reserves, and that the
accompanying plat is a true and correct copy of the property surveyed,
described as follows: The E1/2 of the NW 1/4 of Sec. 13, T19S, R2E, W of the
6th P.M., Sedgewick County, Kansas. Existing public easements and
dedications being received by virtue of K.S.A. 12-512(b).

Hickory Creek, LLC

Joy W. Russell

State of Kansas) SS The foregoing instrument acknowledged to
me, this day of January, 1996, by Joy W. Russell,
member of Hickory Creek, LLC on behalf of the company.

Notary Public

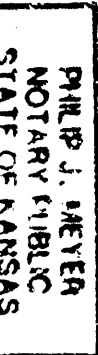

We, the undersigned, holders of a majority of the
Hickory Creek Estates, Wichita, Sedgewick County, Kansas,
Wichita Federal Savings and Loan Association

Sam E. Tamm

State of Kansas) SS The foregoing instrument acknowledged to
me, this day of January, 1996, by
Sam E. Tamm, Vice-President of Wichita Federal Savings and Loan
Association, on behalf of the association.

Notary Public

State of Kansas) SS This plat of HICKORY CREEK
Planned, Sedgewick County, Kansas has been submitted to and
approved by the Wichita-Sedgewick County Metropolitan Area Planning
Commission, Wichita, Kansas.
Dated this 14th day of November, 1996.

Secretary

This plat is void and all dedications
therein are null and void unless the City Council of the City of Wichita,
Kansas, has adopted it by resolution.

Mayor

State of Kansas) SS This is to certify that this plat has been
submitted to the office of the Register of Deeds, Sedgewick County,
Kansas, and is a true and correct copy of the original filed in the
office of the Register of Deeds, Sedgewick County, Kansas, on the
14th day of November, 1996, at 1:30 o'clock P.M. and is duly recorded.



Lot #	Area (Ac.)	City Block	#
1	1.21	1	1200
2	1.21	2	1200
3	1.21	3	1200
100	1.21	100	1200

