
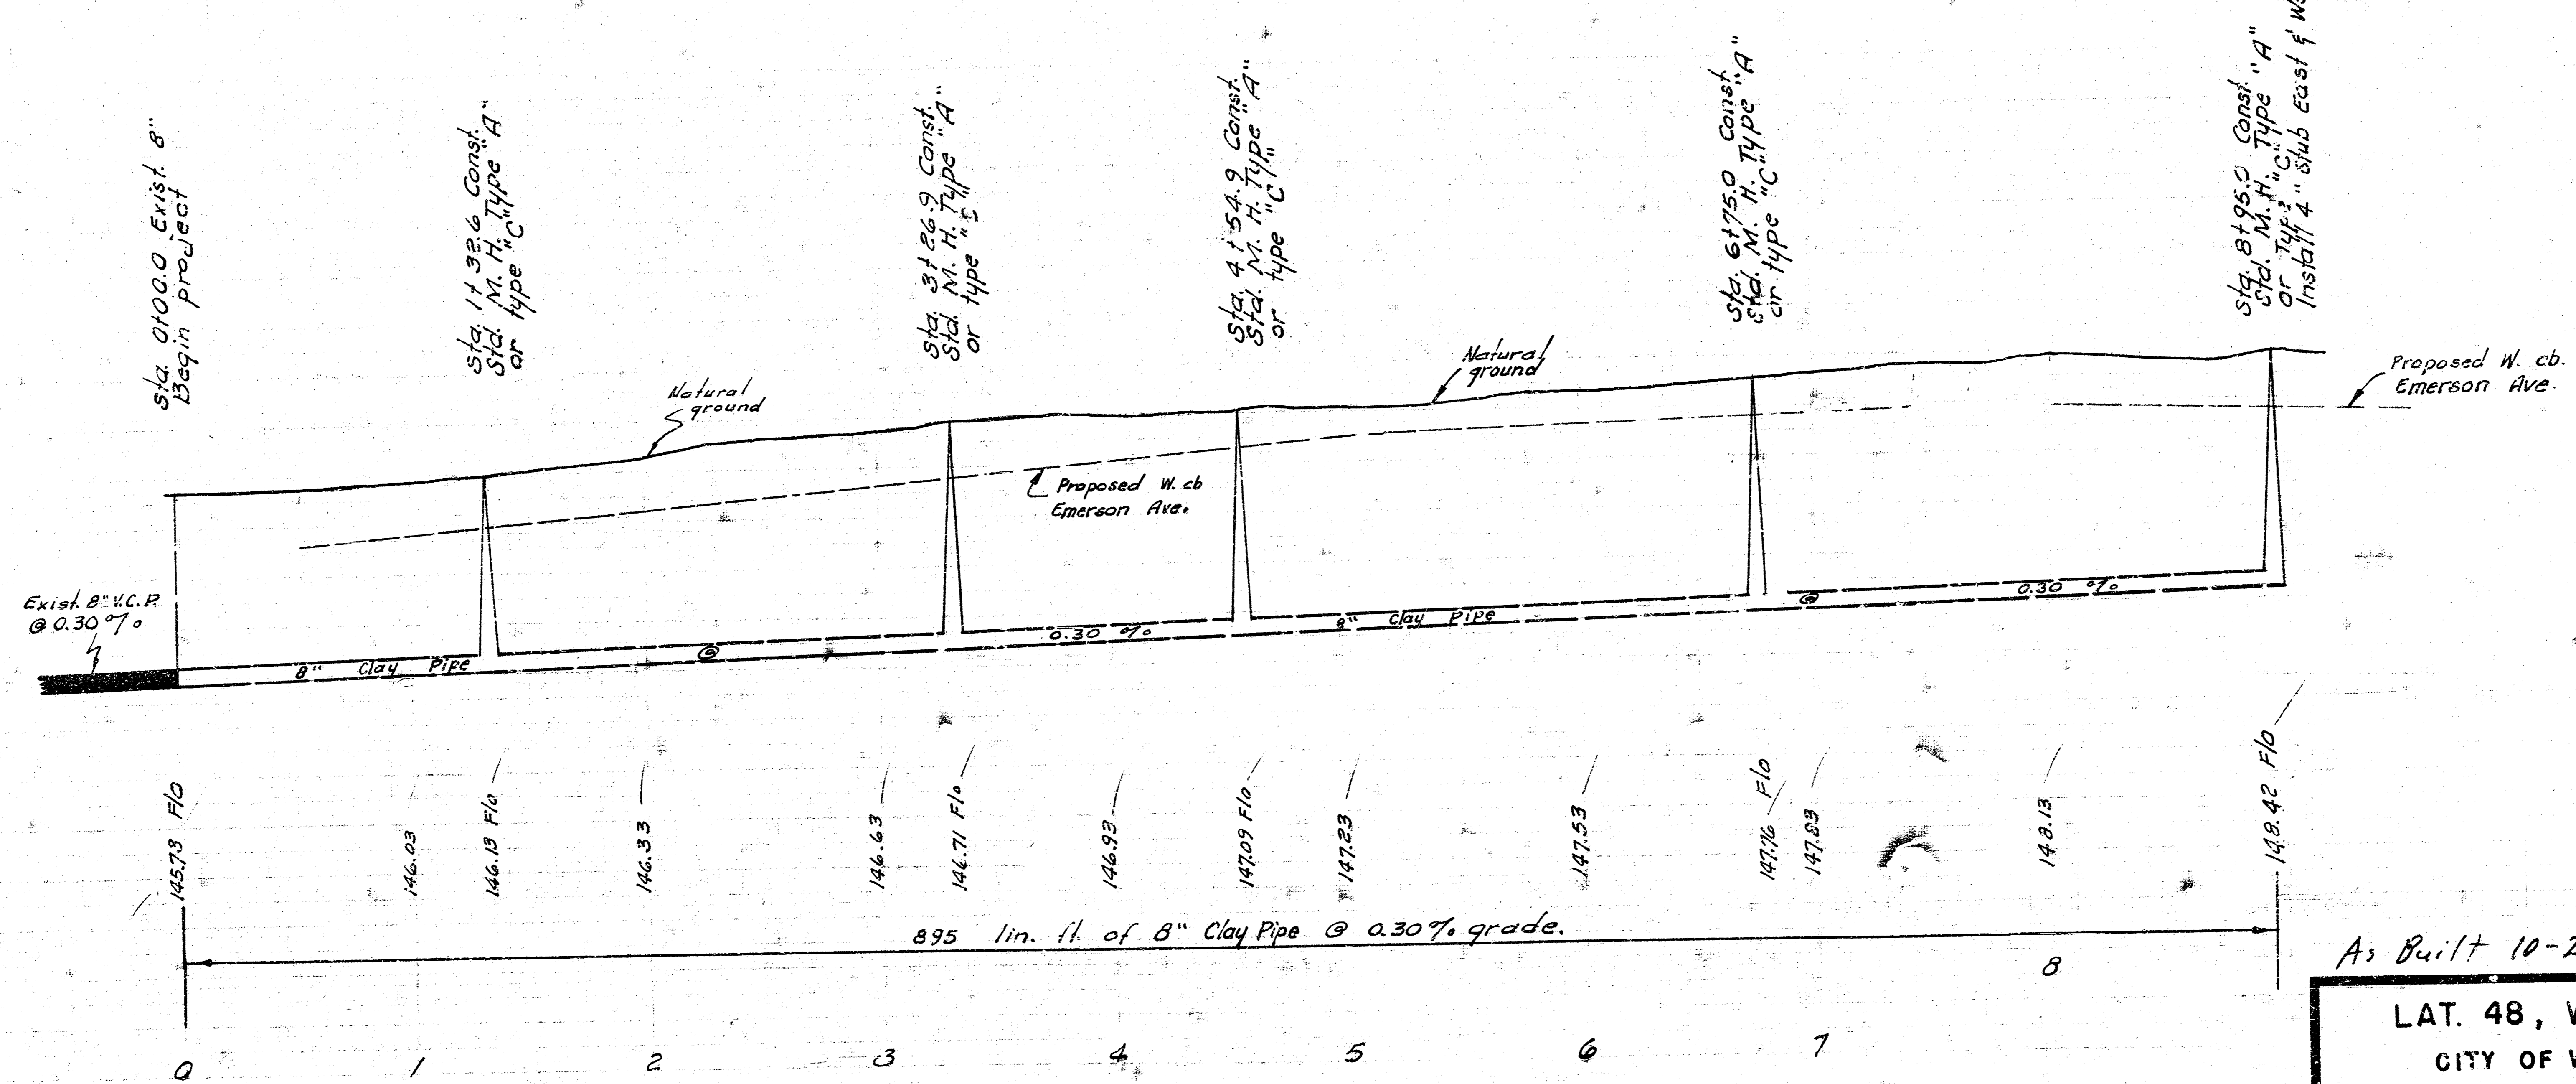


Plan Scale 1" = 40'  
 Profile Scale 1" = 40' Horiz.  
 1" = 4' Vert.

B. M. 150.19 "a" cut top west  
 curb Dunsworth at  
 S. L. Emerson.

T. P. 151.97 W. Rim M.H.  
 Sta. 0+00.0 Lat. 48,  
 Westlink Sewer  
 C28-68

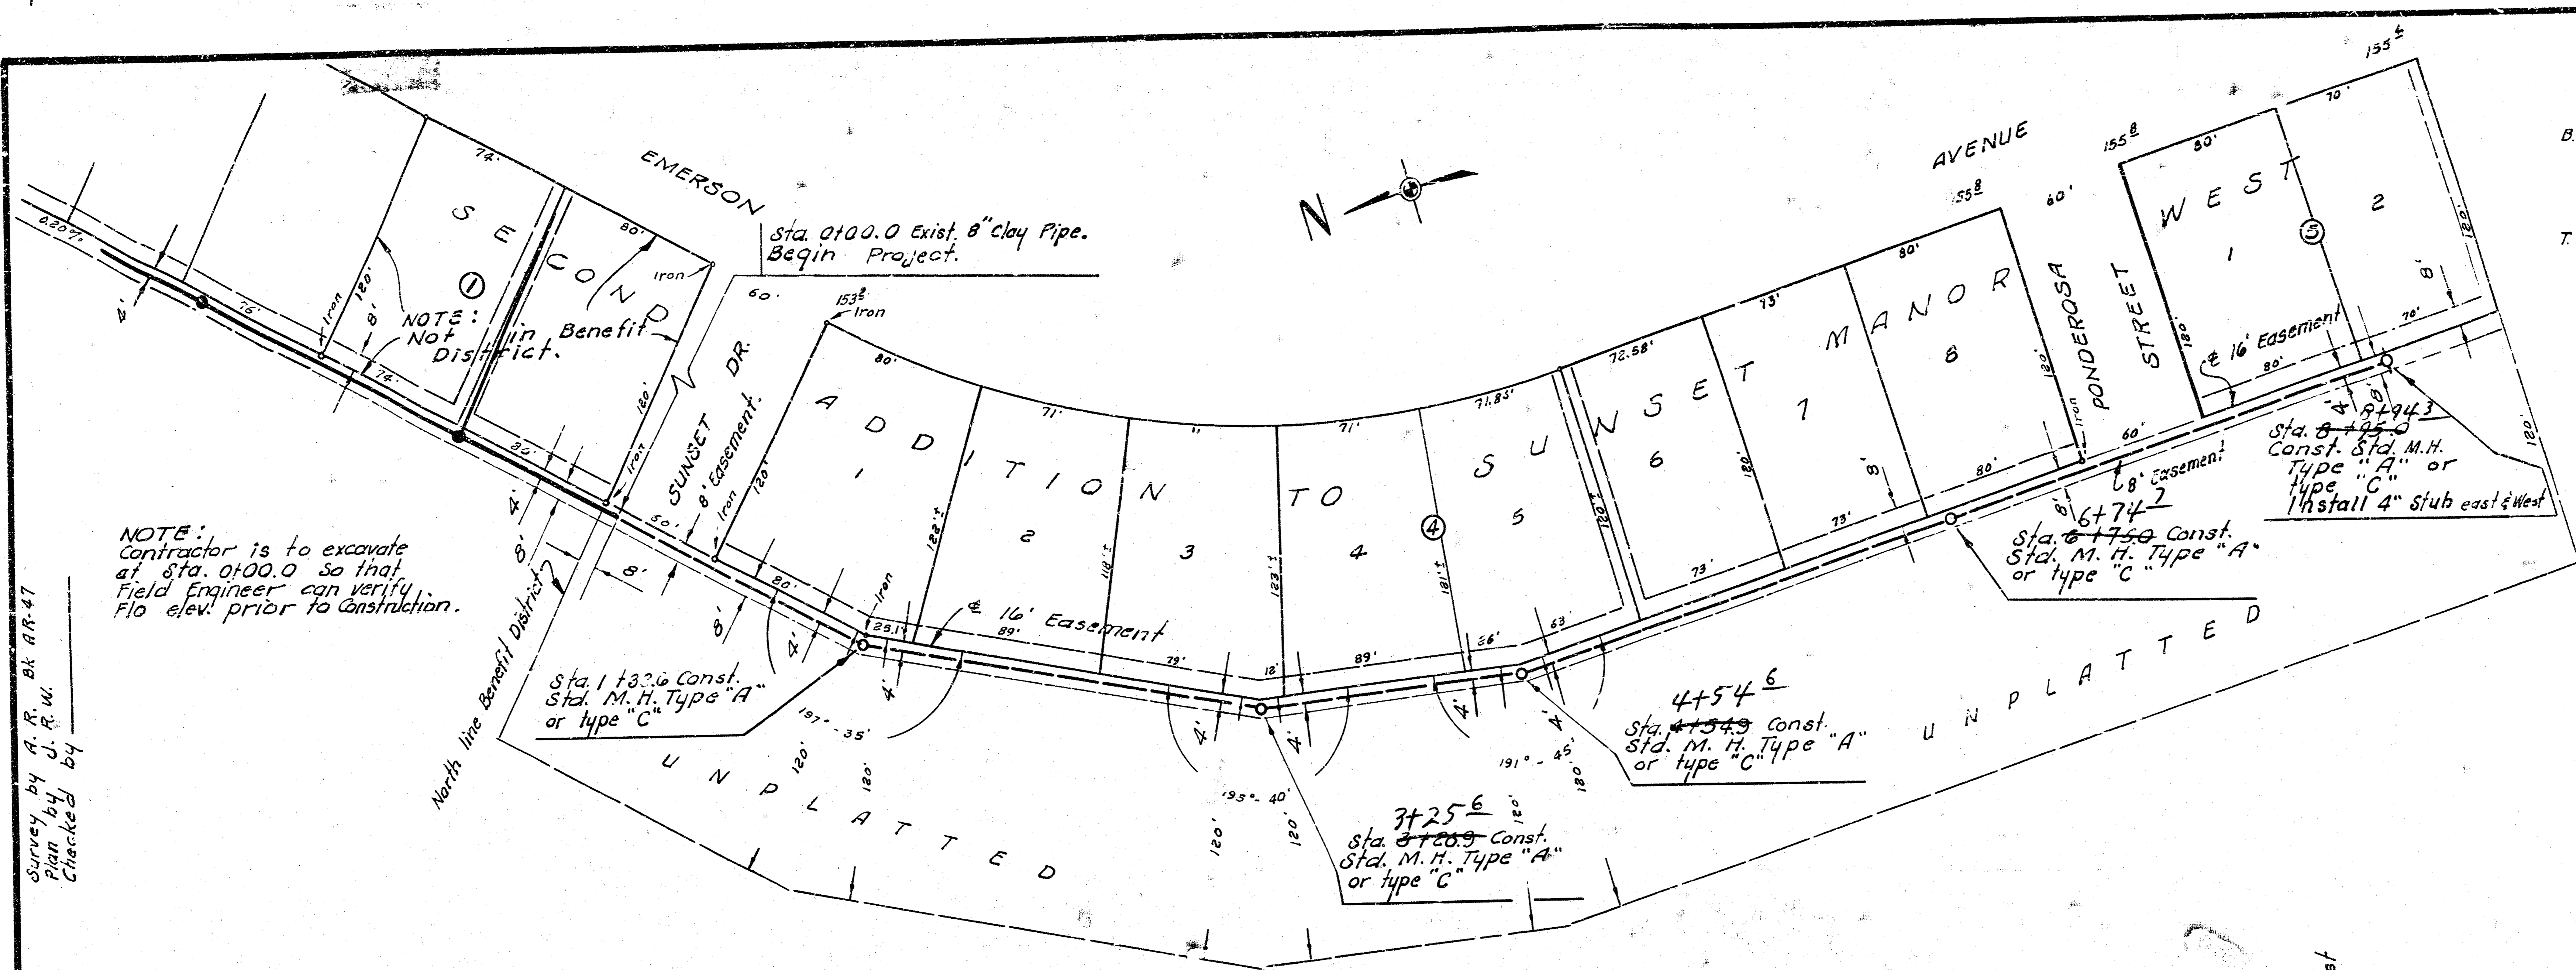

As Built 10-23-75

**LAT. 48, WESTLINK SEWER**  
 CITY OF WICHITA, KANSAS

R. W. LINN — CITY ENGINEER

DATE July 17, 1975 PROJECT NO. DBKLS 68068

Survey by A. R. Bak AR-47  
 Plan by J. R. W.  
 Checked by