


Survey by D.L.K. Bk. D.L.K. 89  
 Plans by J.R.W.  
 Checked by



B.M. 151.97 W. rim exist. M.H.  
 Sta. 0+00.0 Lat. 49.  
 Westlink Sewer. N. of  
 intersection of Emerson Ave.  
 and Wilbur Lane.

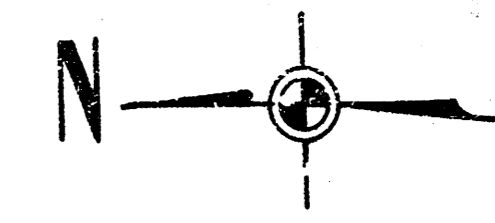

Plan Scale 1" = 40'  
 Profile Scale 1" = 4' Vert.

B.M. 155.17 Top W. rim exist. M.H.  
 44' W. & 3' S. of the S.C.  
 cor lot 2 Blk 6 Second Addn.  
 to Sunset Manor West.

Note: Reconstructed line to a  
 point 81.7 ft. N.E. of Sta. 0+00  
 as this line was out of  
 Easement

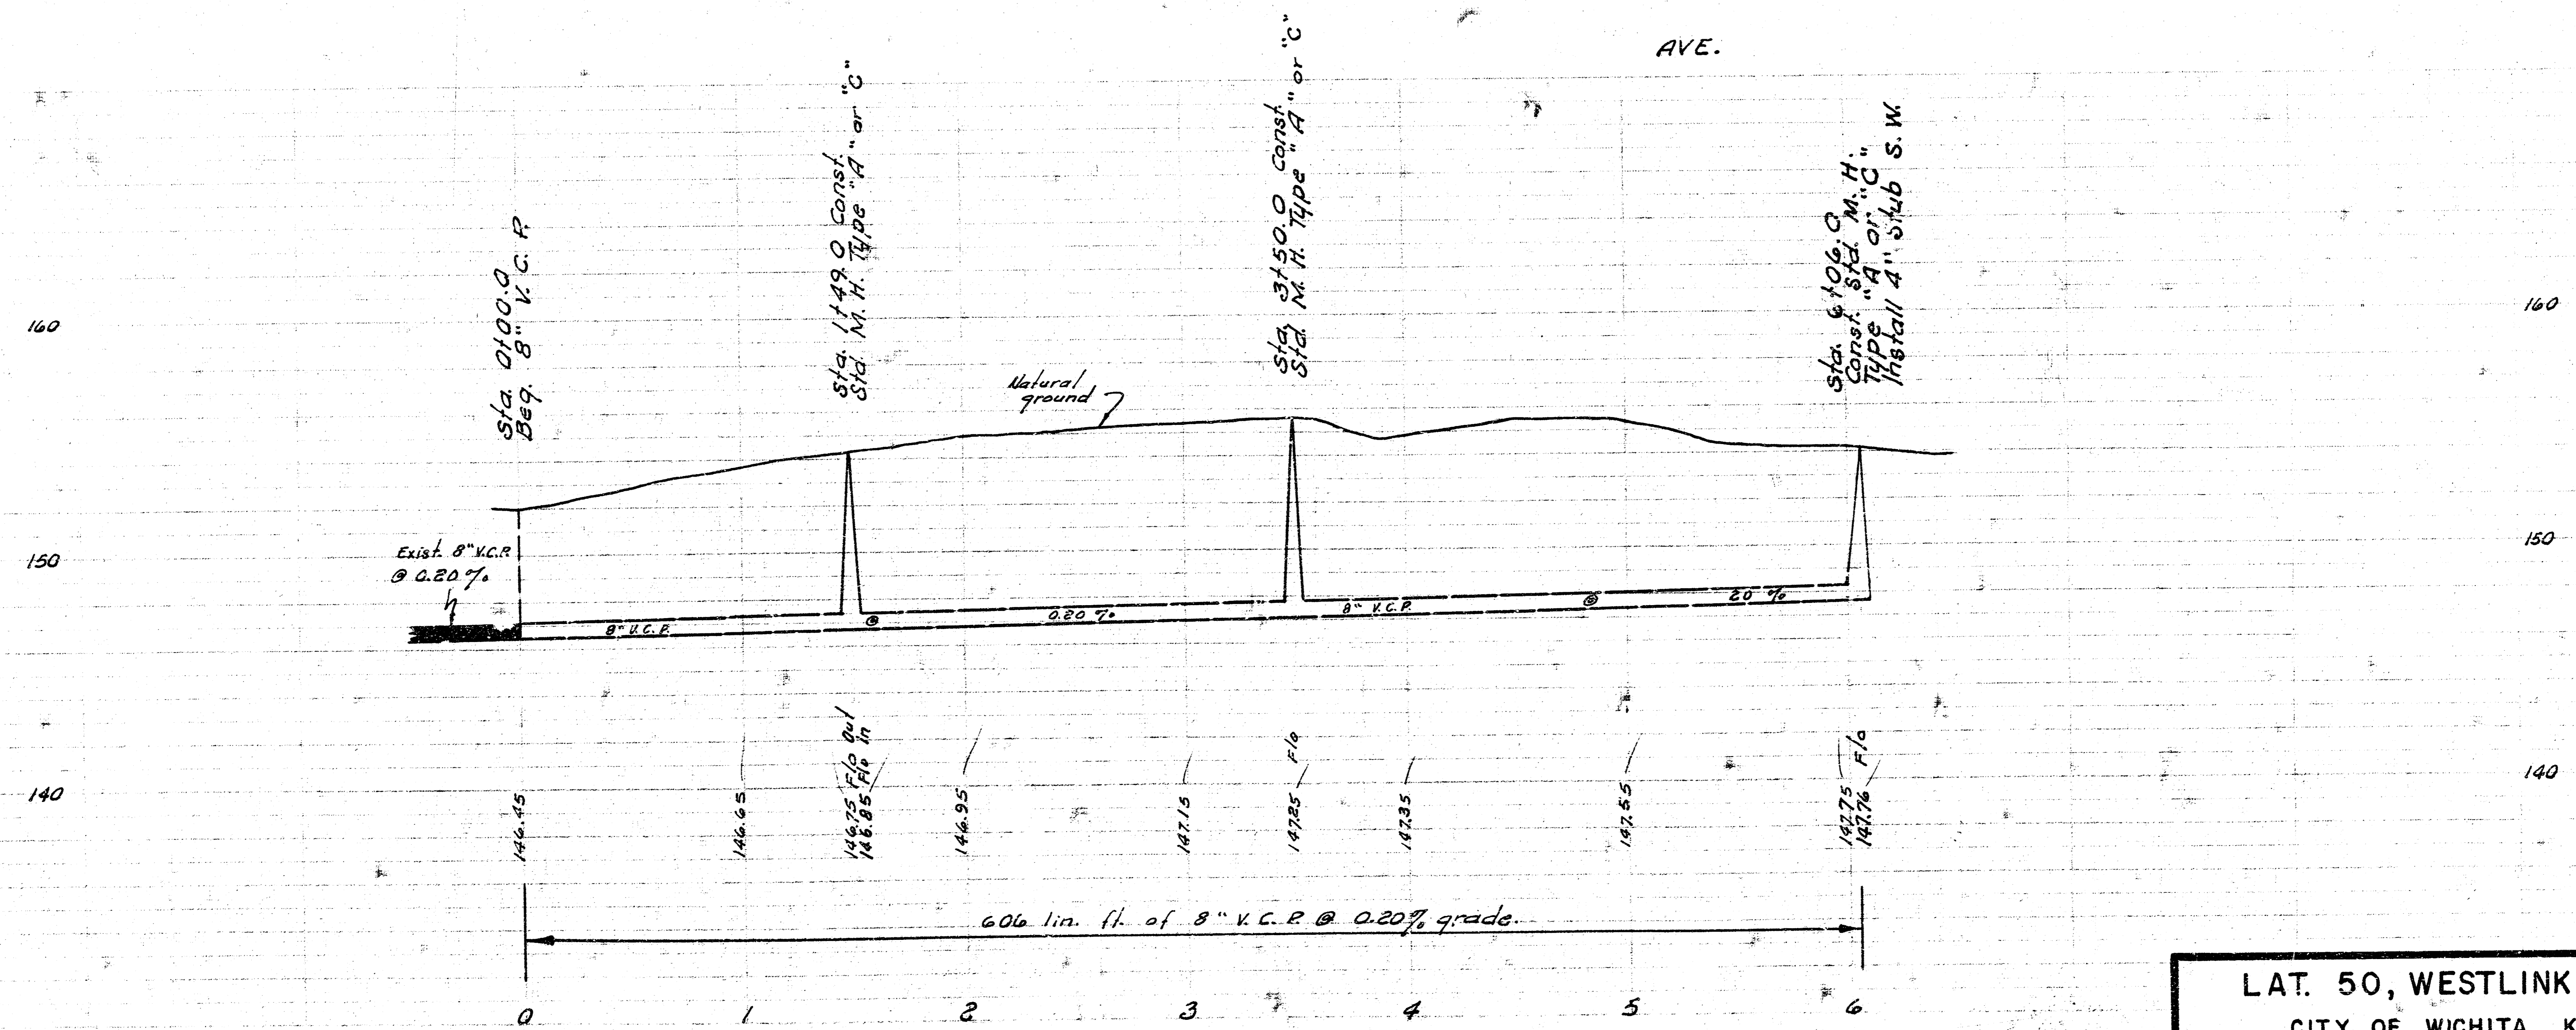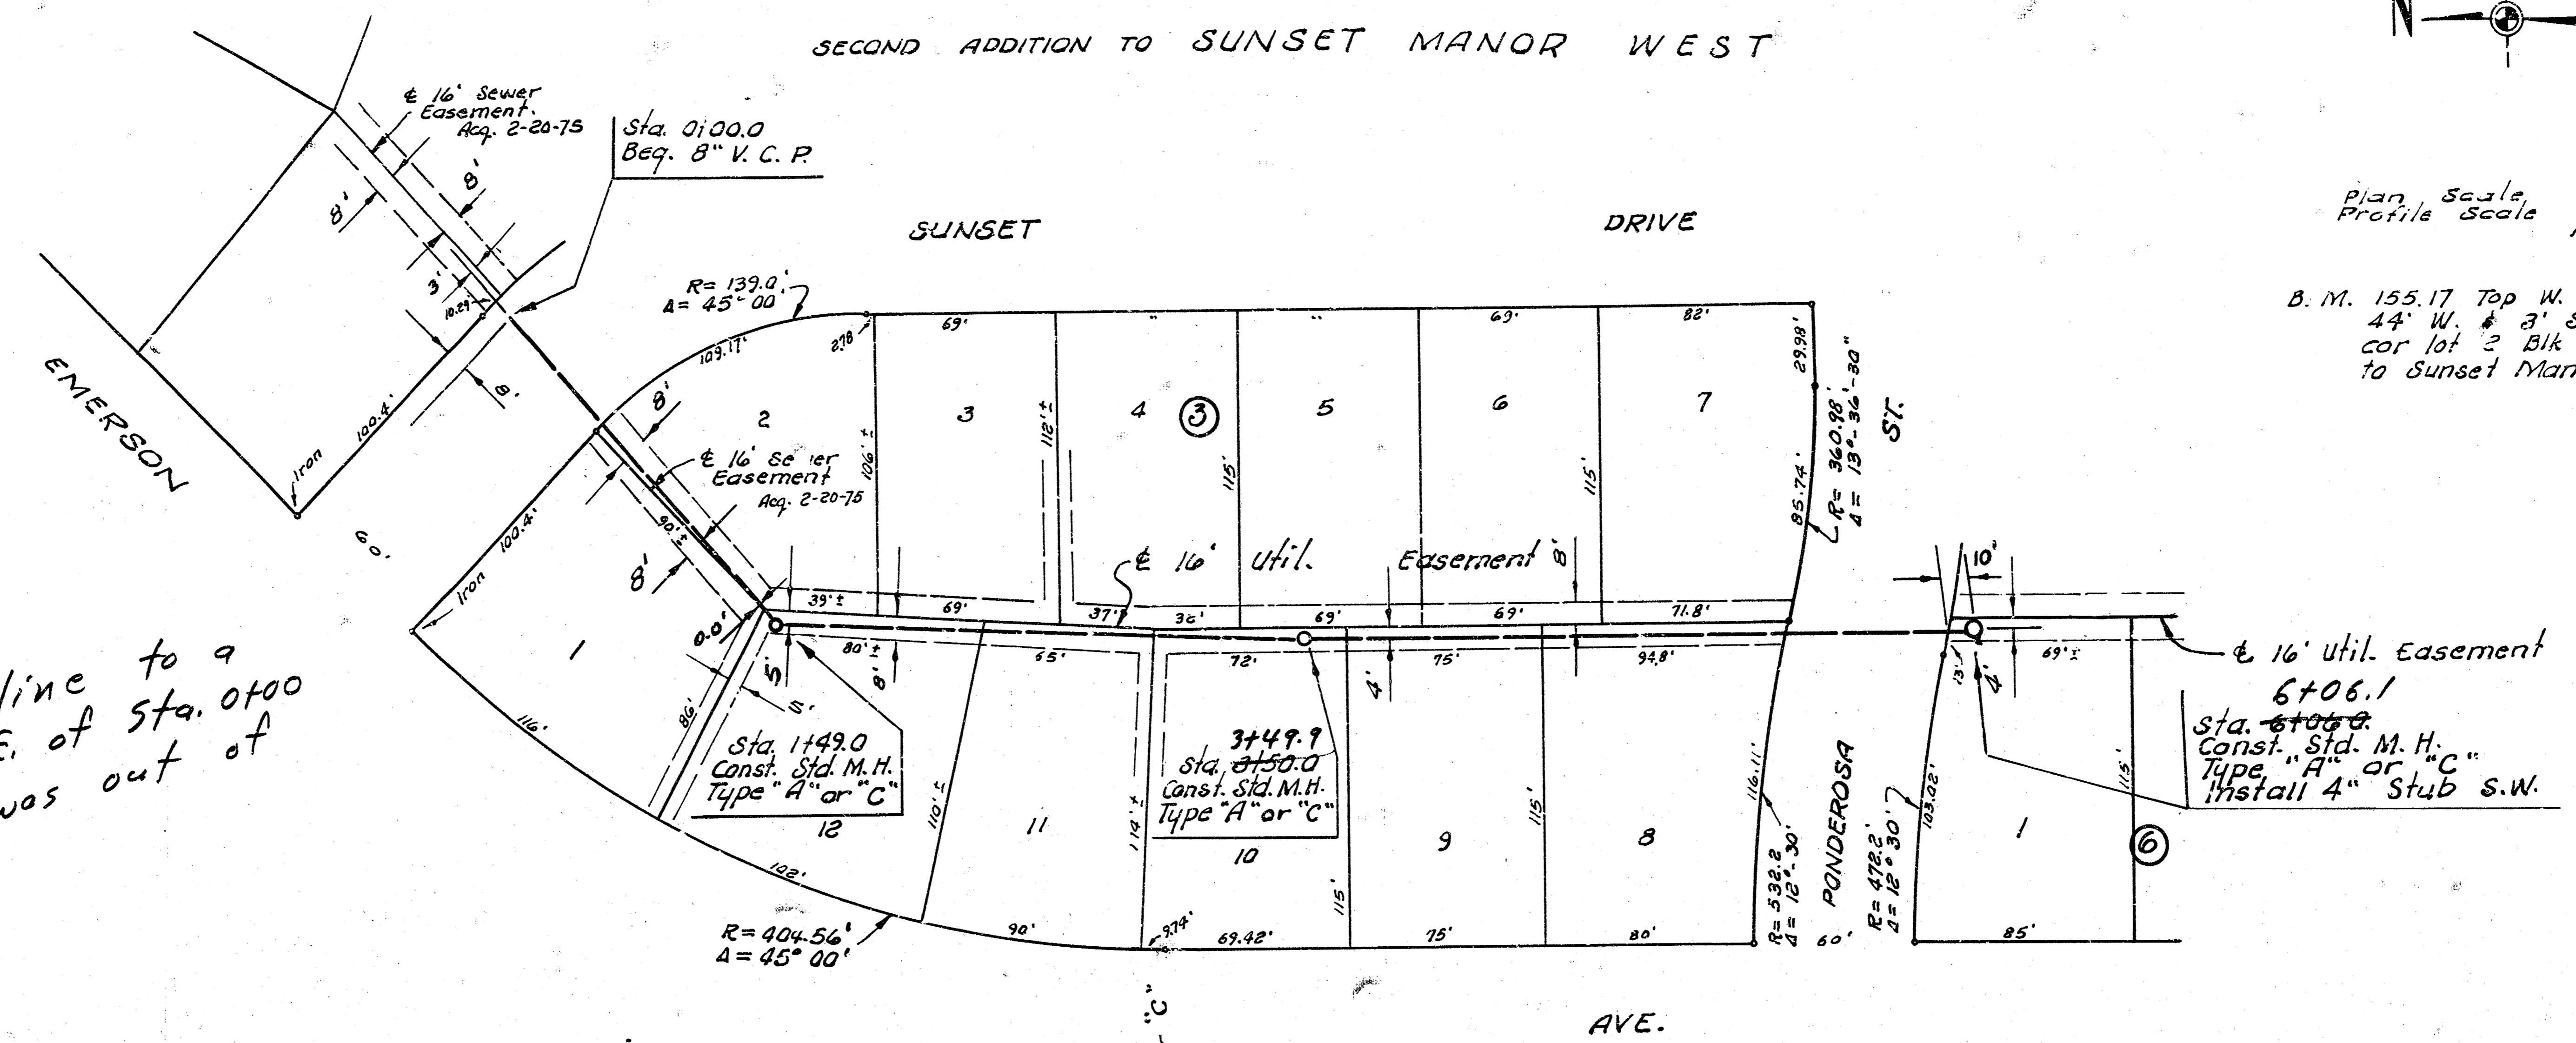

LAT. 50, WESTLINK SEWER  
 CITY OF WICHITA, KANSAS  
 R. W. LINN — CITY ENGINEER  
 1975 PROJECT NO. DBKL568070