


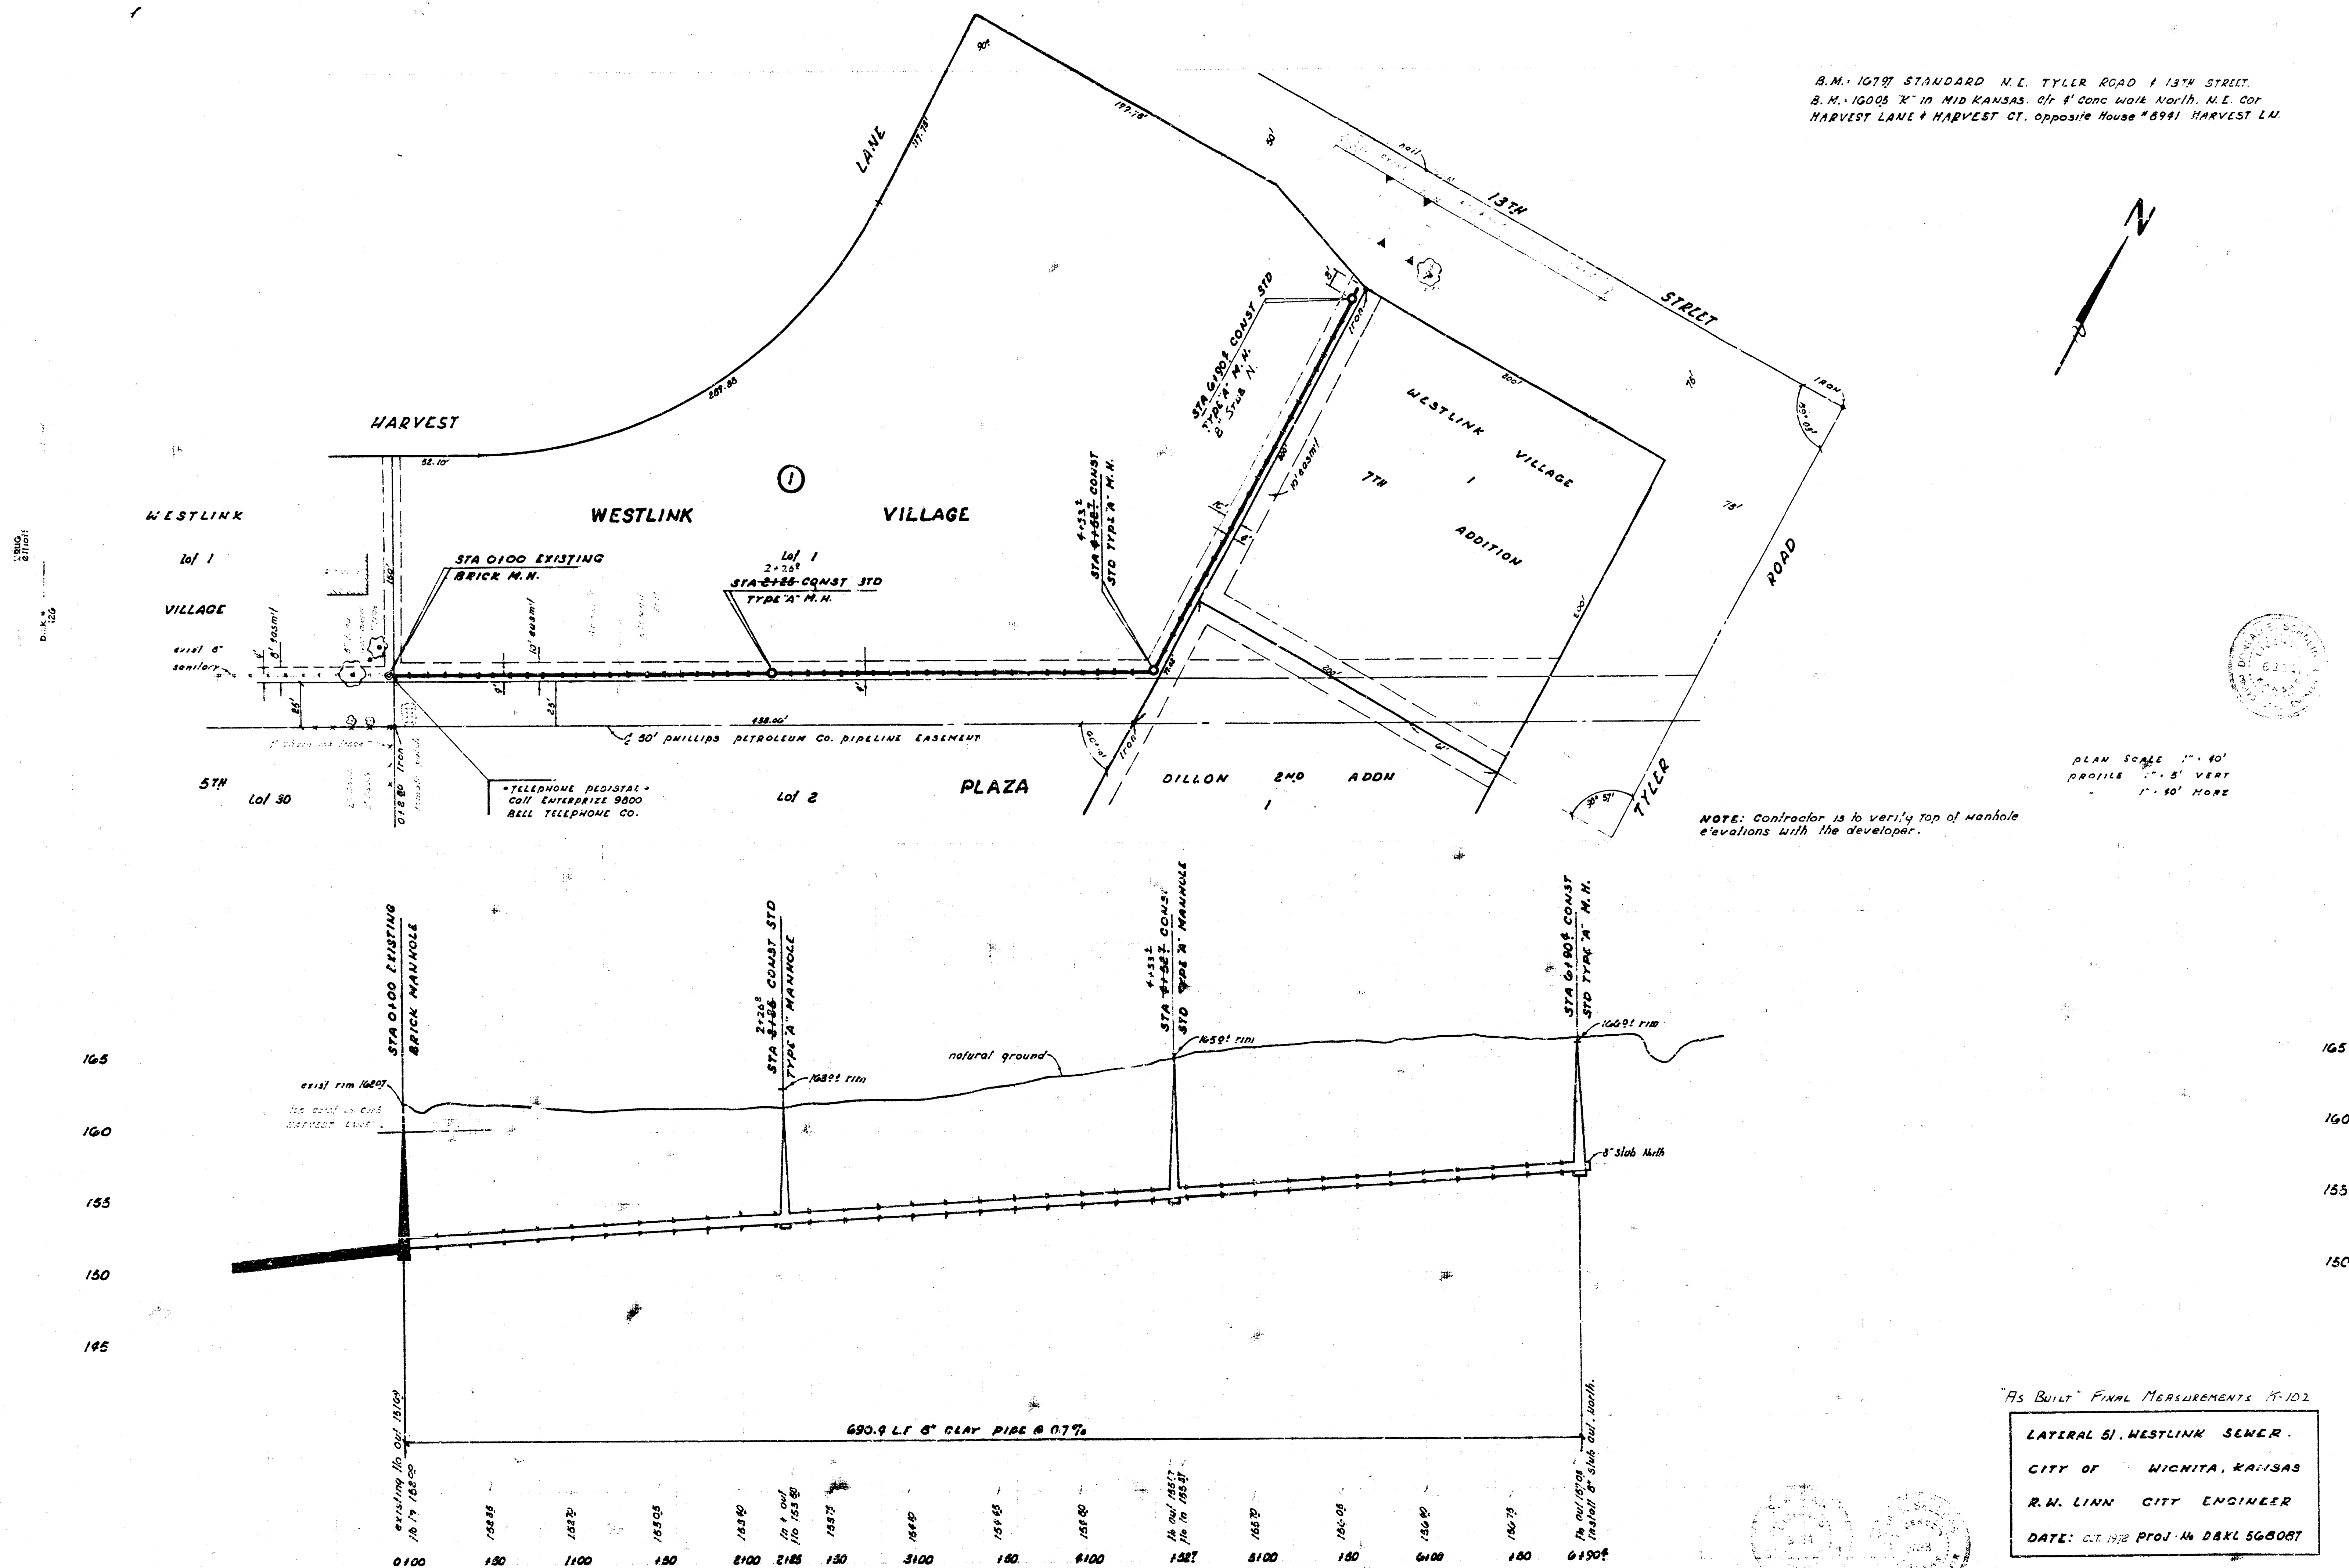

As Built Final Measurements 15-102

LATERAL SJ. WESTLINK SEWER.

CITY OF WICHITA, KANSAS

R.W. LINN CITY ENGINEER

DATE: OCT. 1912 PROJ. IN D&L 560087