


B.M. 16797 STANDARD N.E. CORNER 13TH STREET AND TYLER ROAD.
 B.M. 16095 "K" IN MID KANSAS CRT 1' CONC WALK N. North East Cor HARVEST COURT
 and HARVEST LAKE opposite 16# 891 HARVEST LAKE.

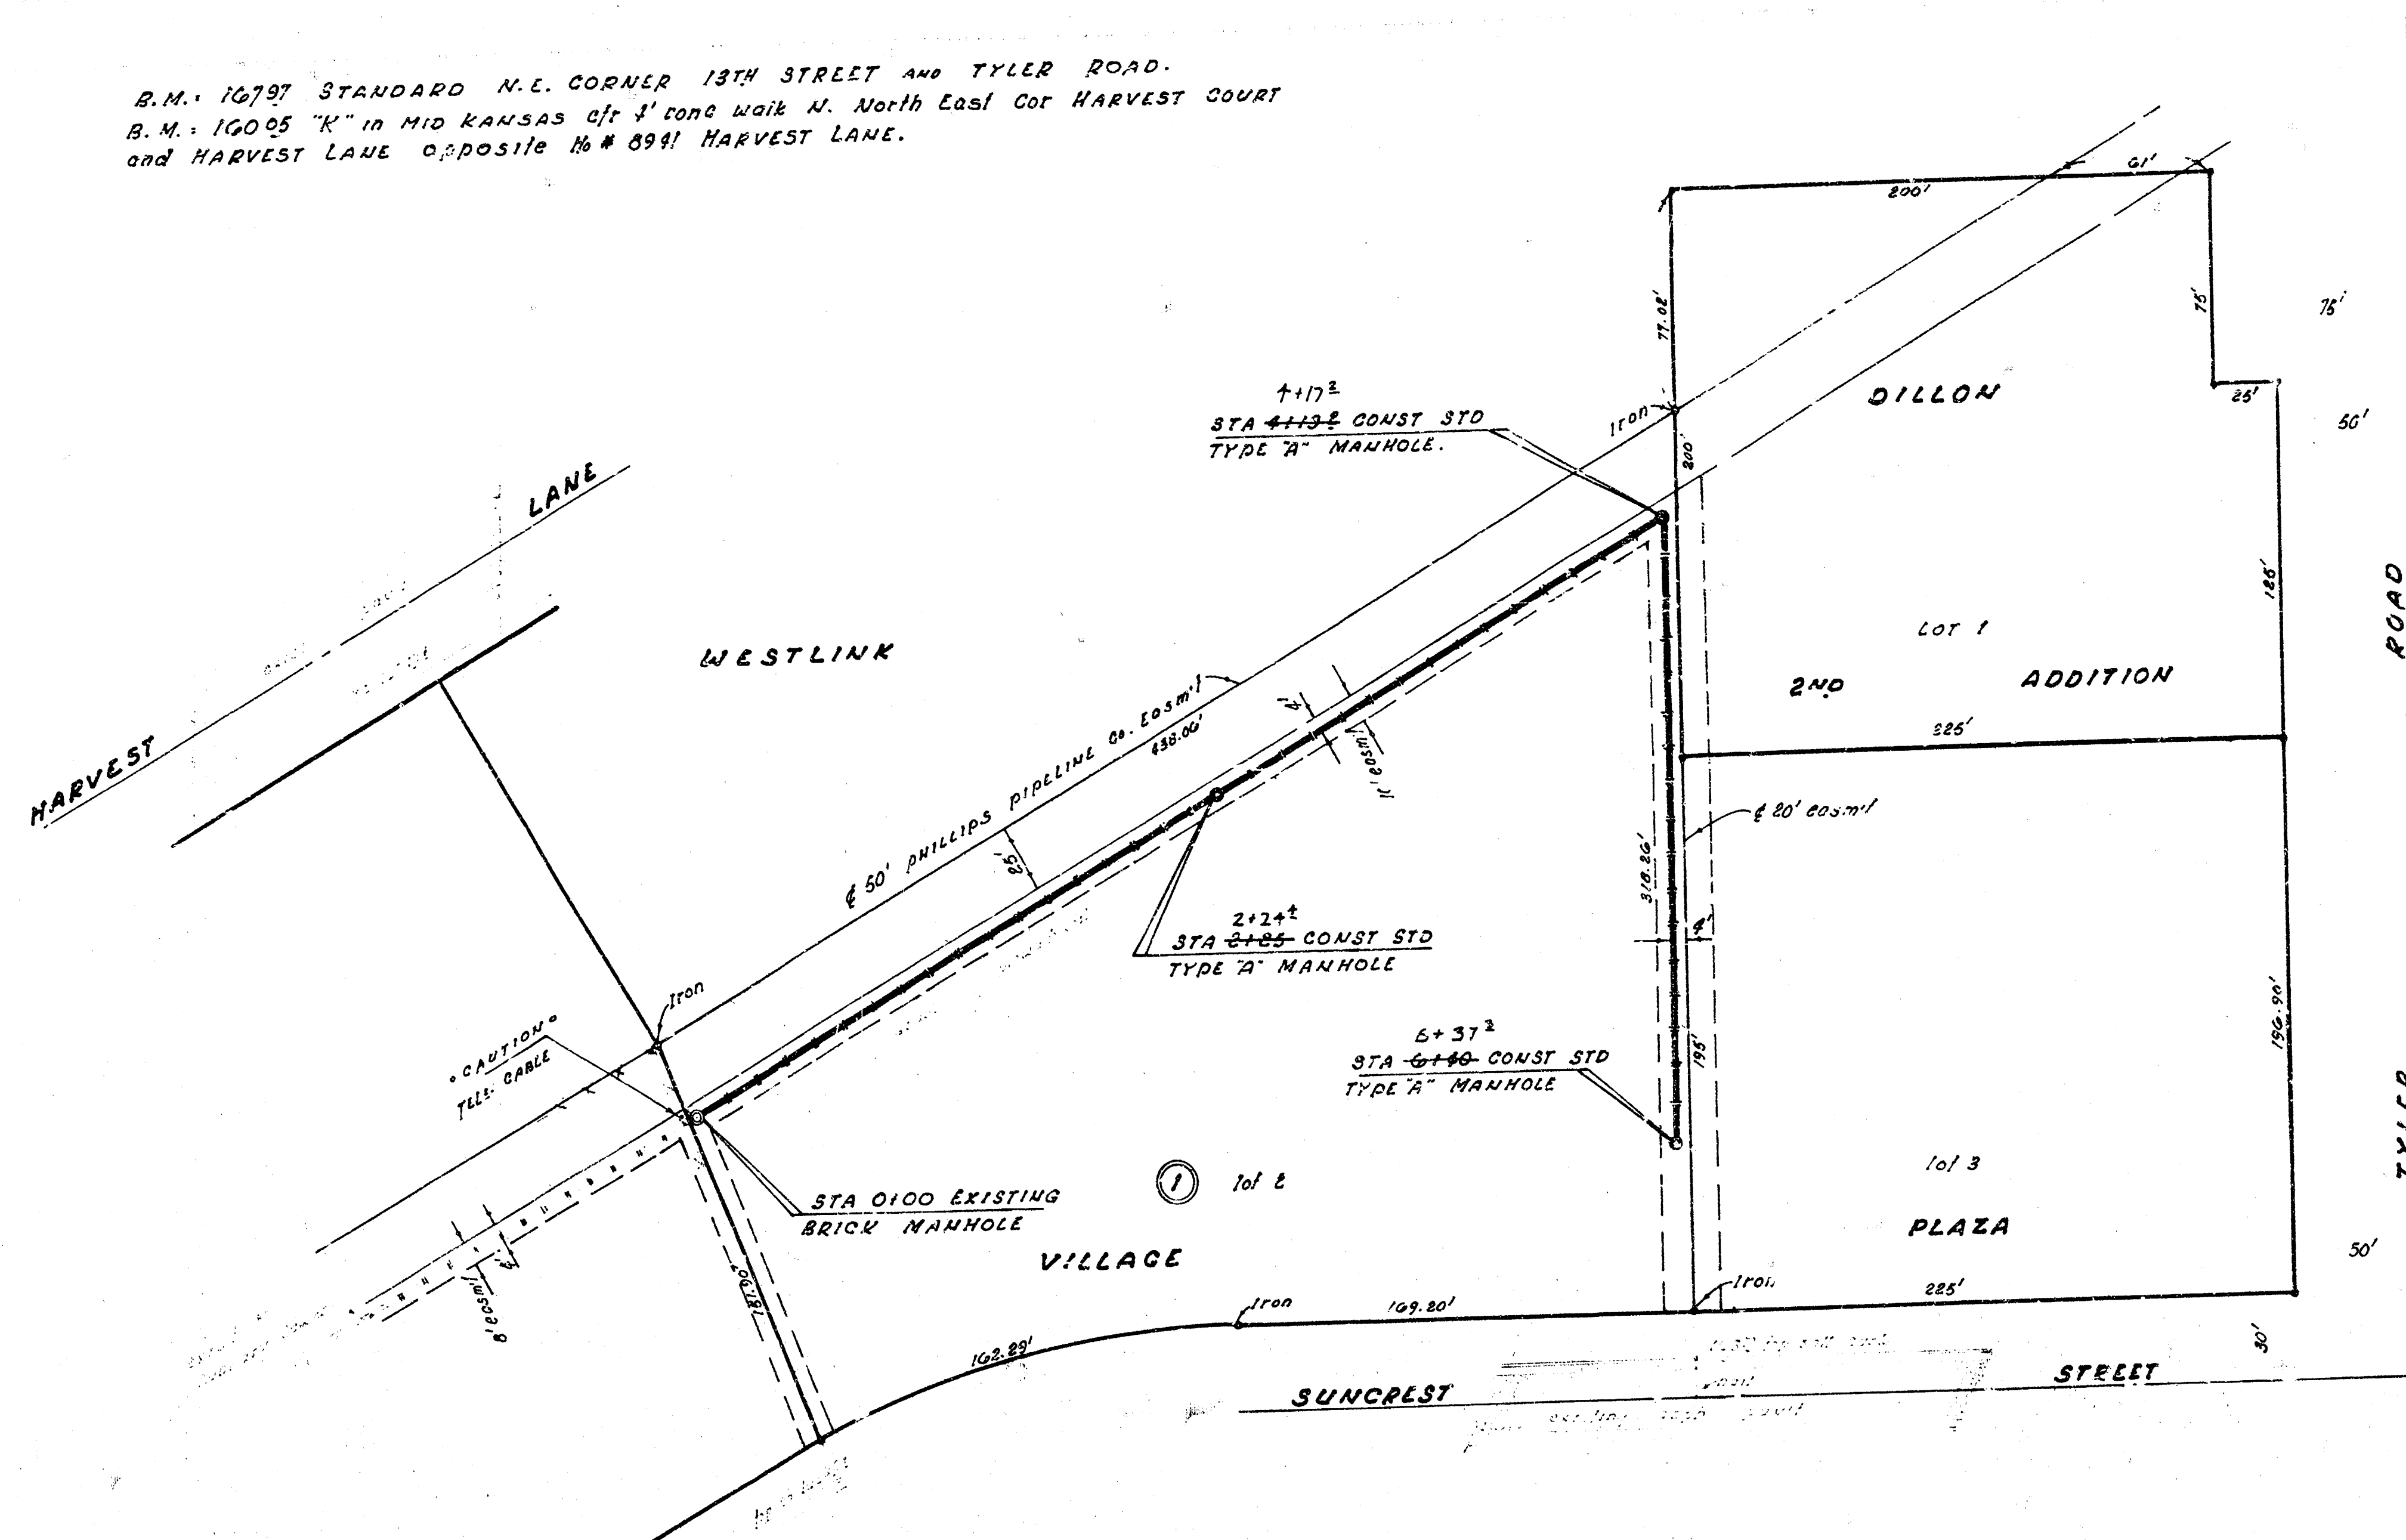


NOTE: Contractor is to verify Top of Manhole elevations with developer.

PLAN SCALE 1"=50'
 PROFILE 1"=5' VERT
 1"=90' HORIZ



165
160
155
150

165
160
155
150

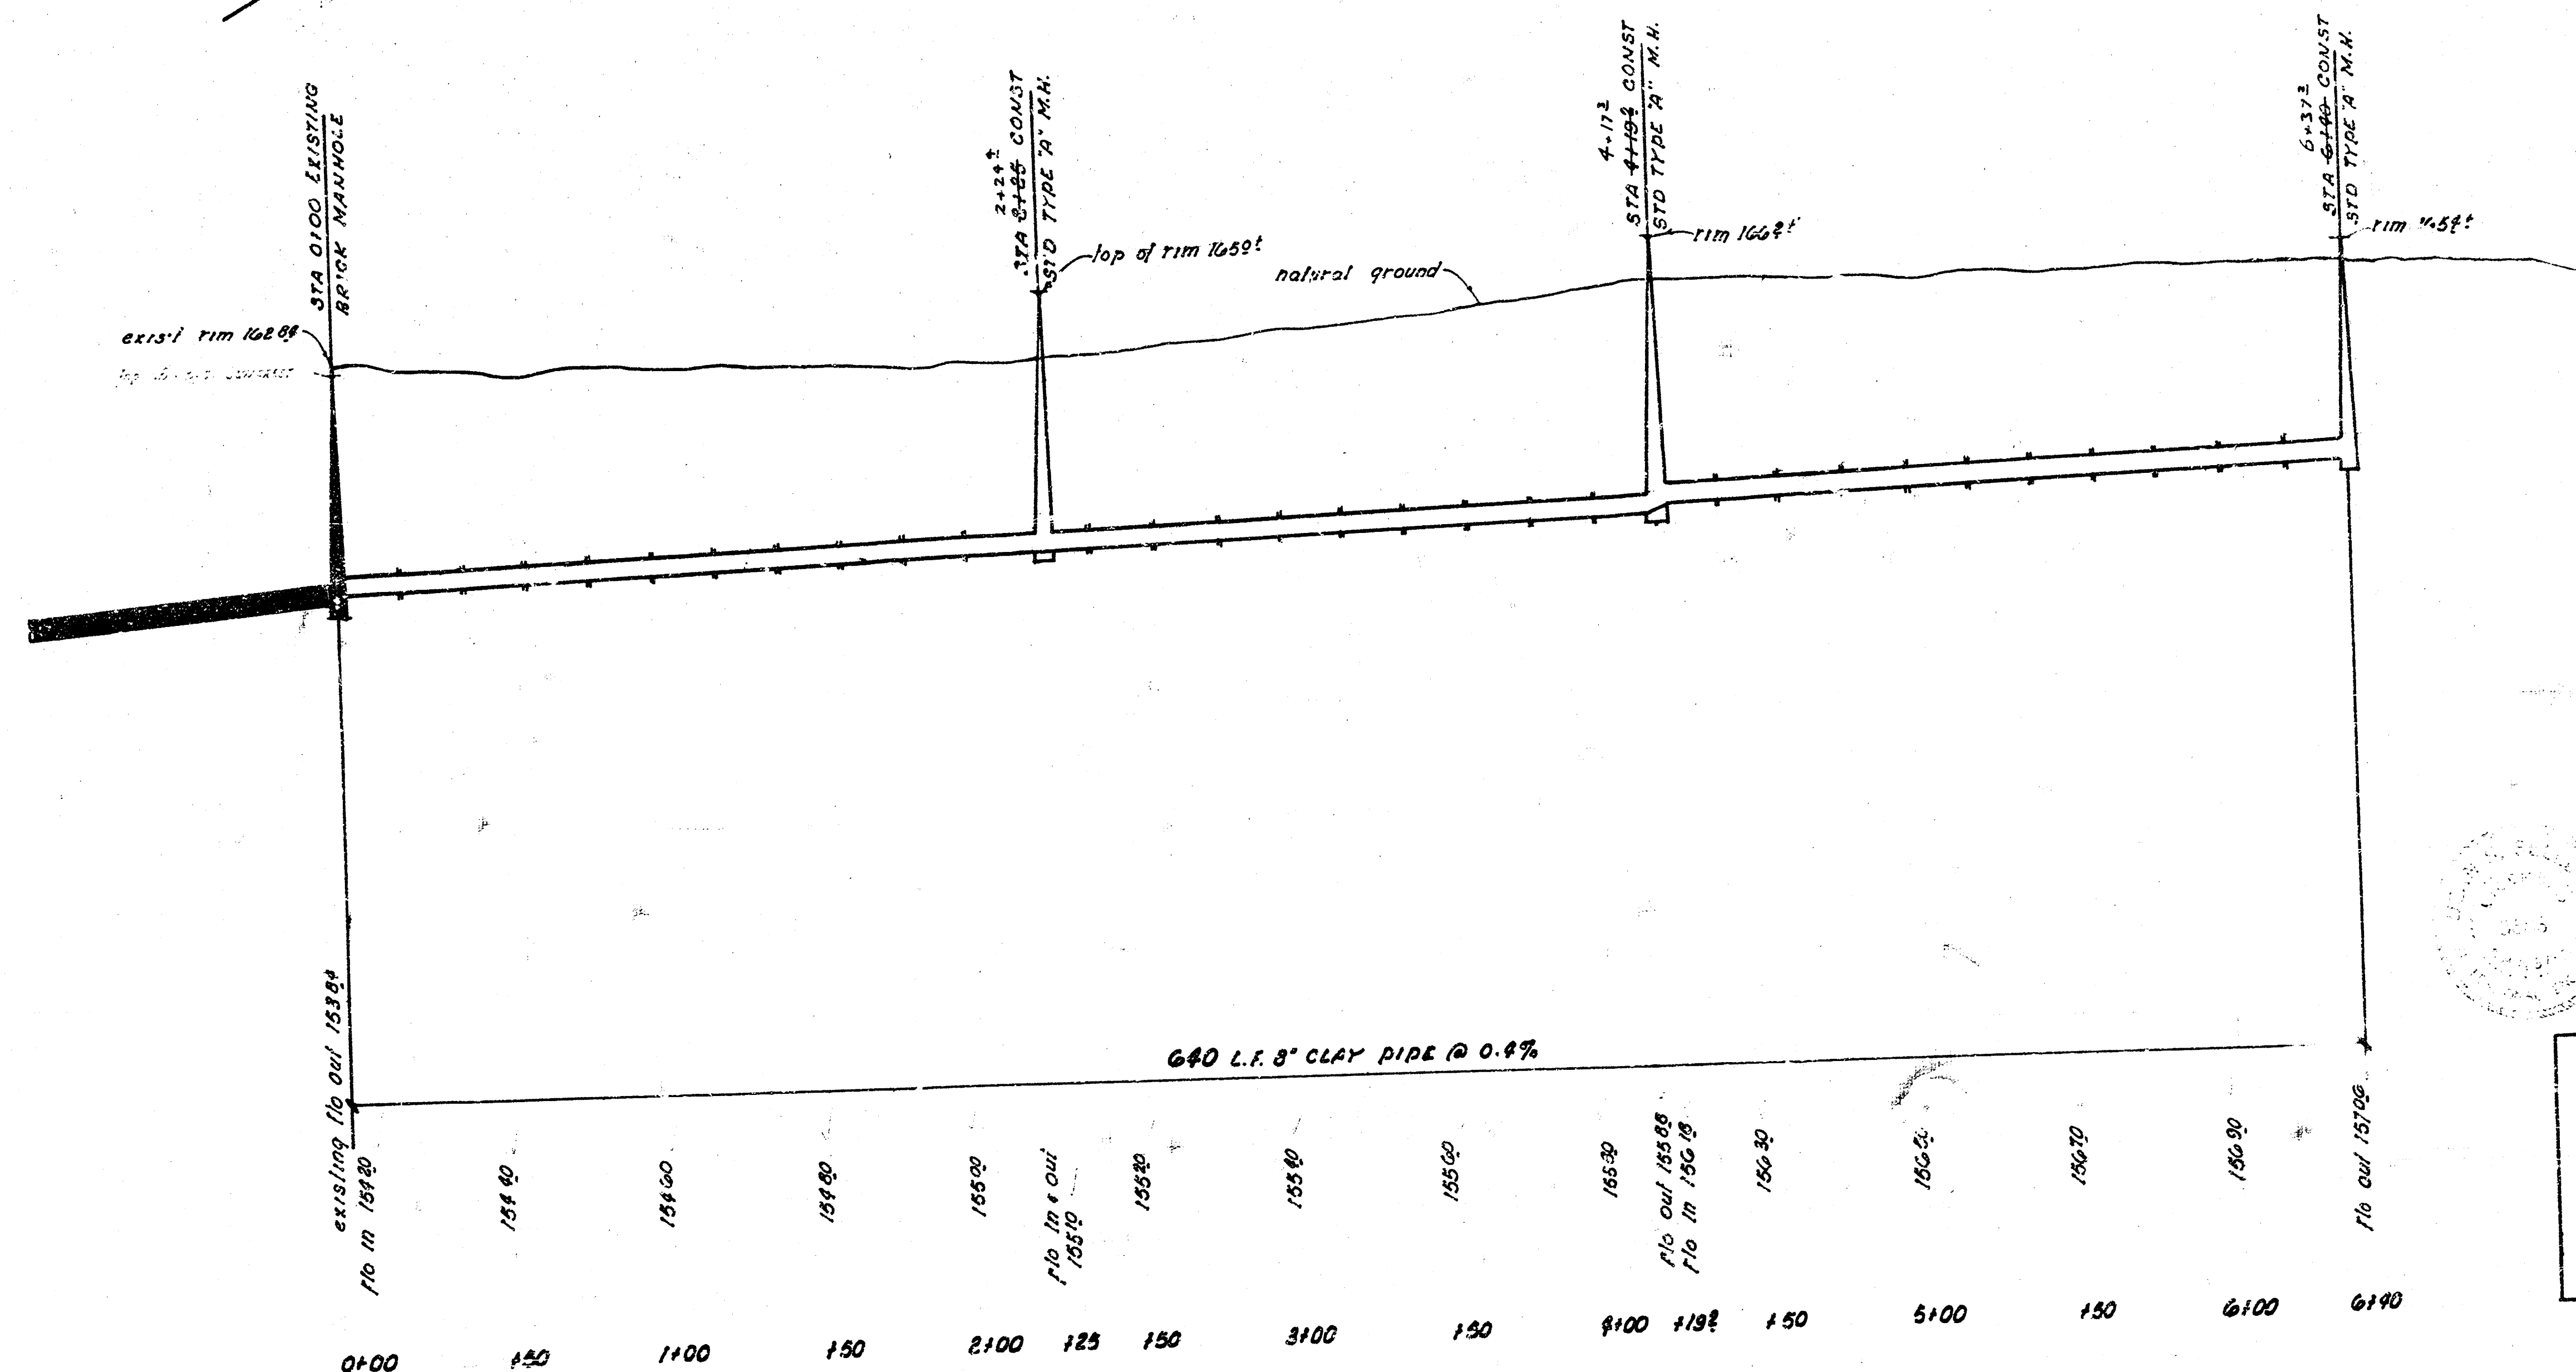

As BUILT FINAL
 MEASUREMENTS K-102

LATERAL 52, WESTLINK SEWER
 CITY OF WICHITA, KANSAS
 R.W. LINN CITY ENGINEER
 DATE OCT. 1972 PROJ. NO. DBKL 563069