

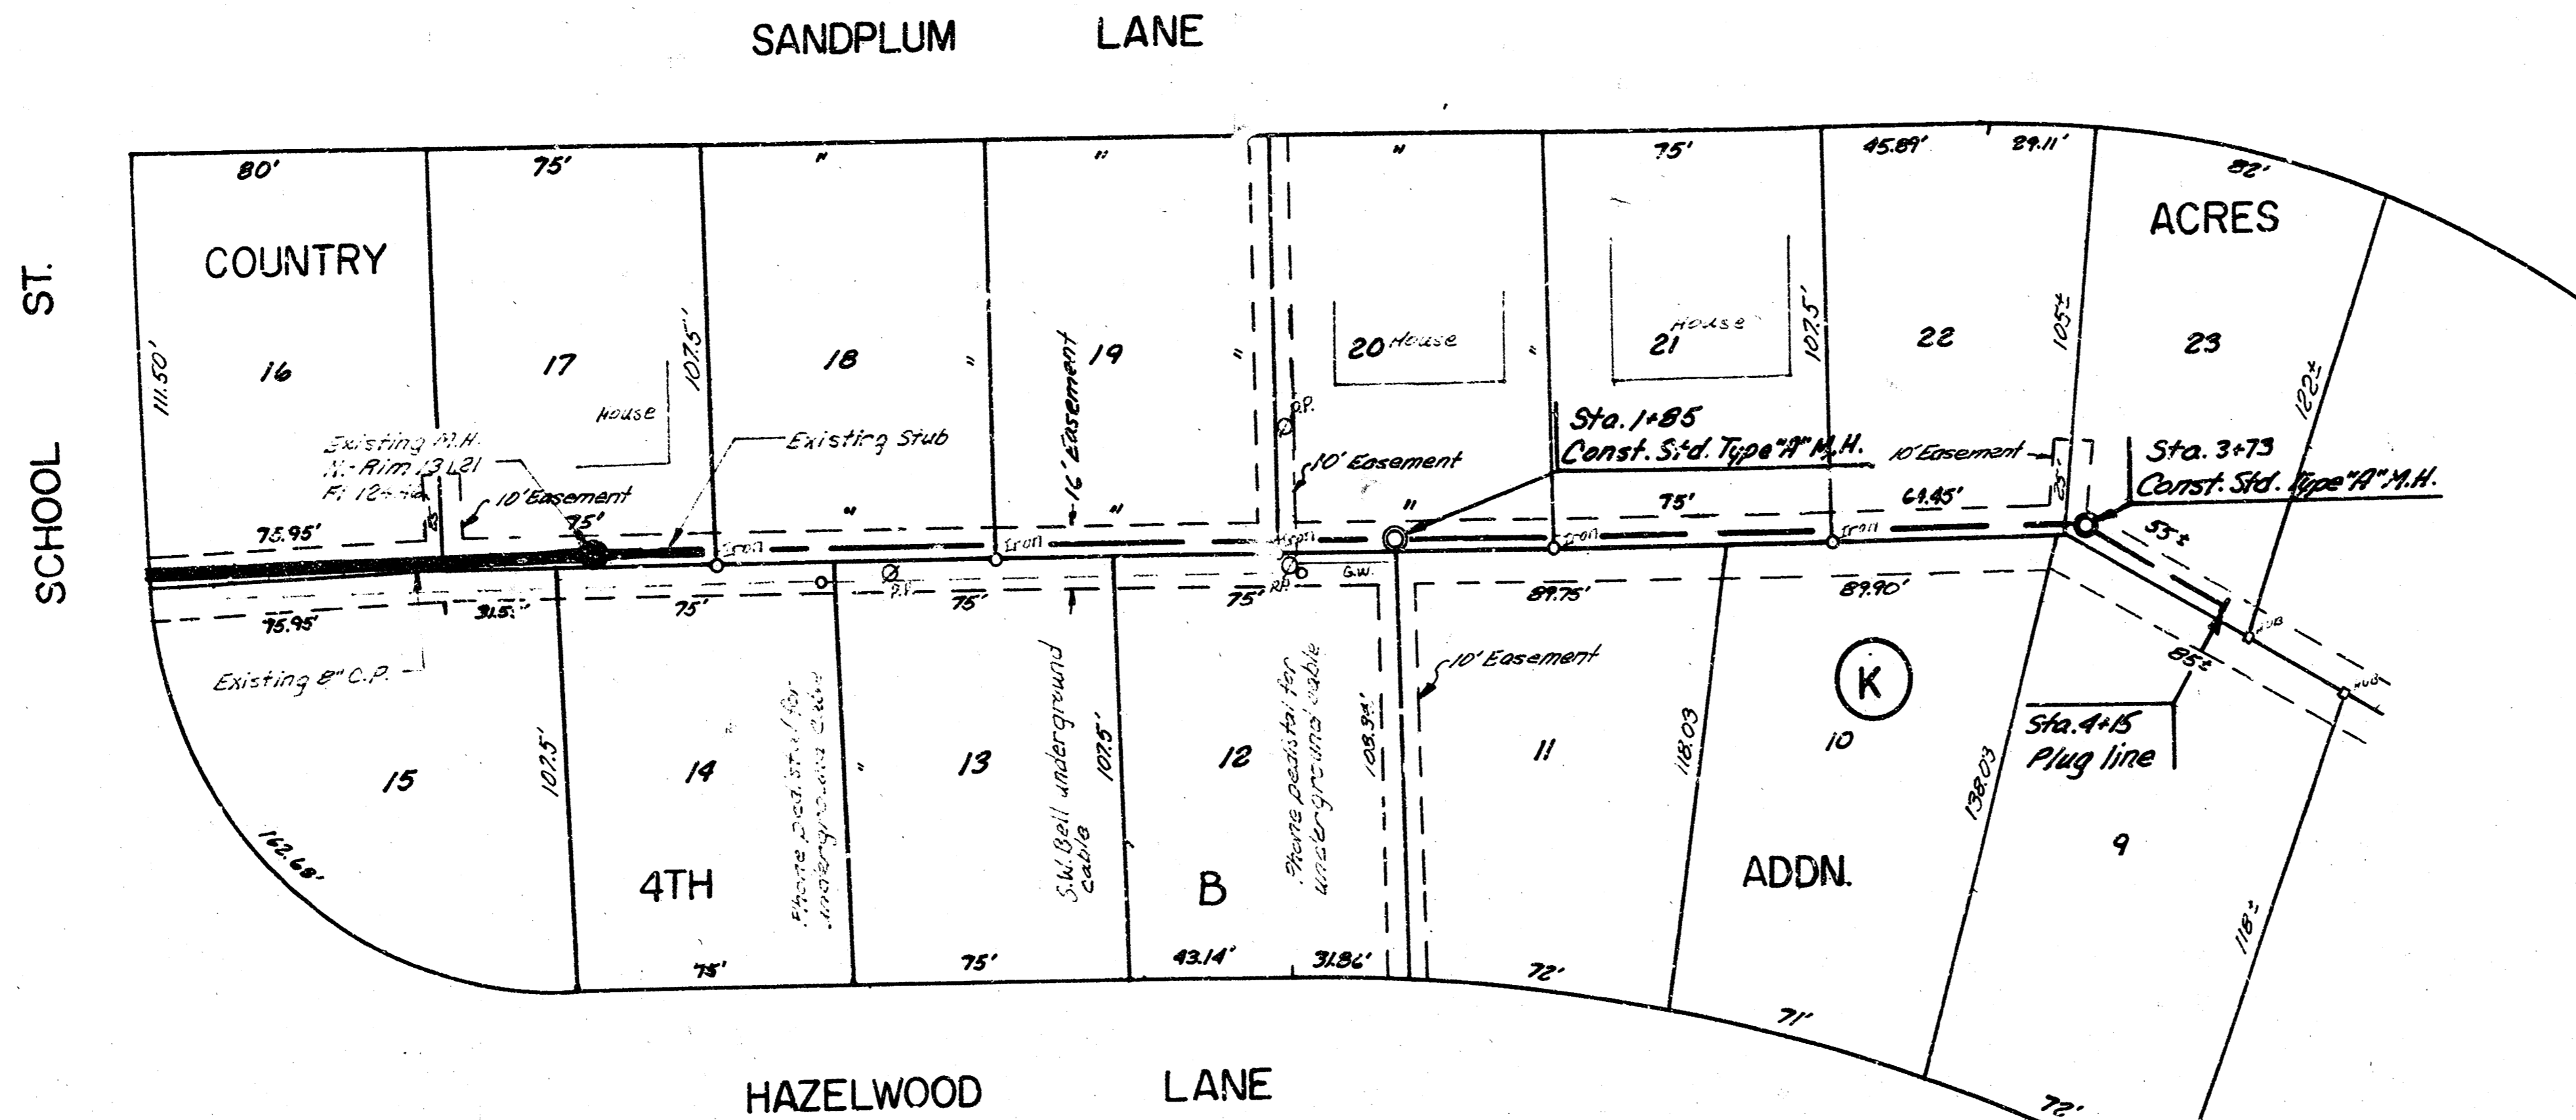


B.M. 132.19 City Std. School Street & Ridge Road, 49.2 W. & 34.0 S. of E both.
 B.M. 130.00 11' on top N. - cb. School Street of E.L. Sandplum.

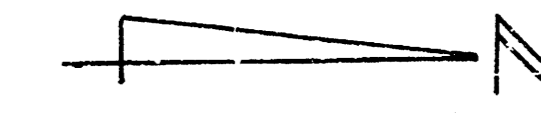

CAUTION
UNDERGROUND
UTILITIES
 Please check with K G & E or
 Southwestern Bell
 Telephone Co. for Location

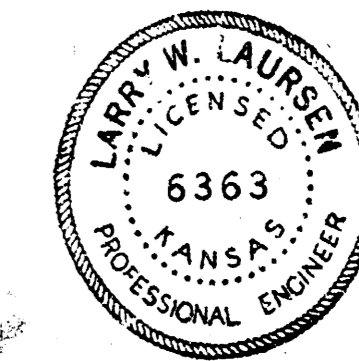


Note: Contractor shall excavate
 around stub so Engineer
 can check stub's flow elevation.

Note: Manhole at Sta. 1+85 shall be constructed to a minimum
 elevation of 131.4. Manhole at Sta. 3+73 shall be
 constructed to a minimum elevation of 132.2. For
 exact elevations of these manholes, contractor shall
 contact the developer of the land.

Plan Scale 1" = 40'
 Profile Scale 1/4" = 40'
 Profile Scale 1/8" = 2'

135
 130
 125
 120
 115

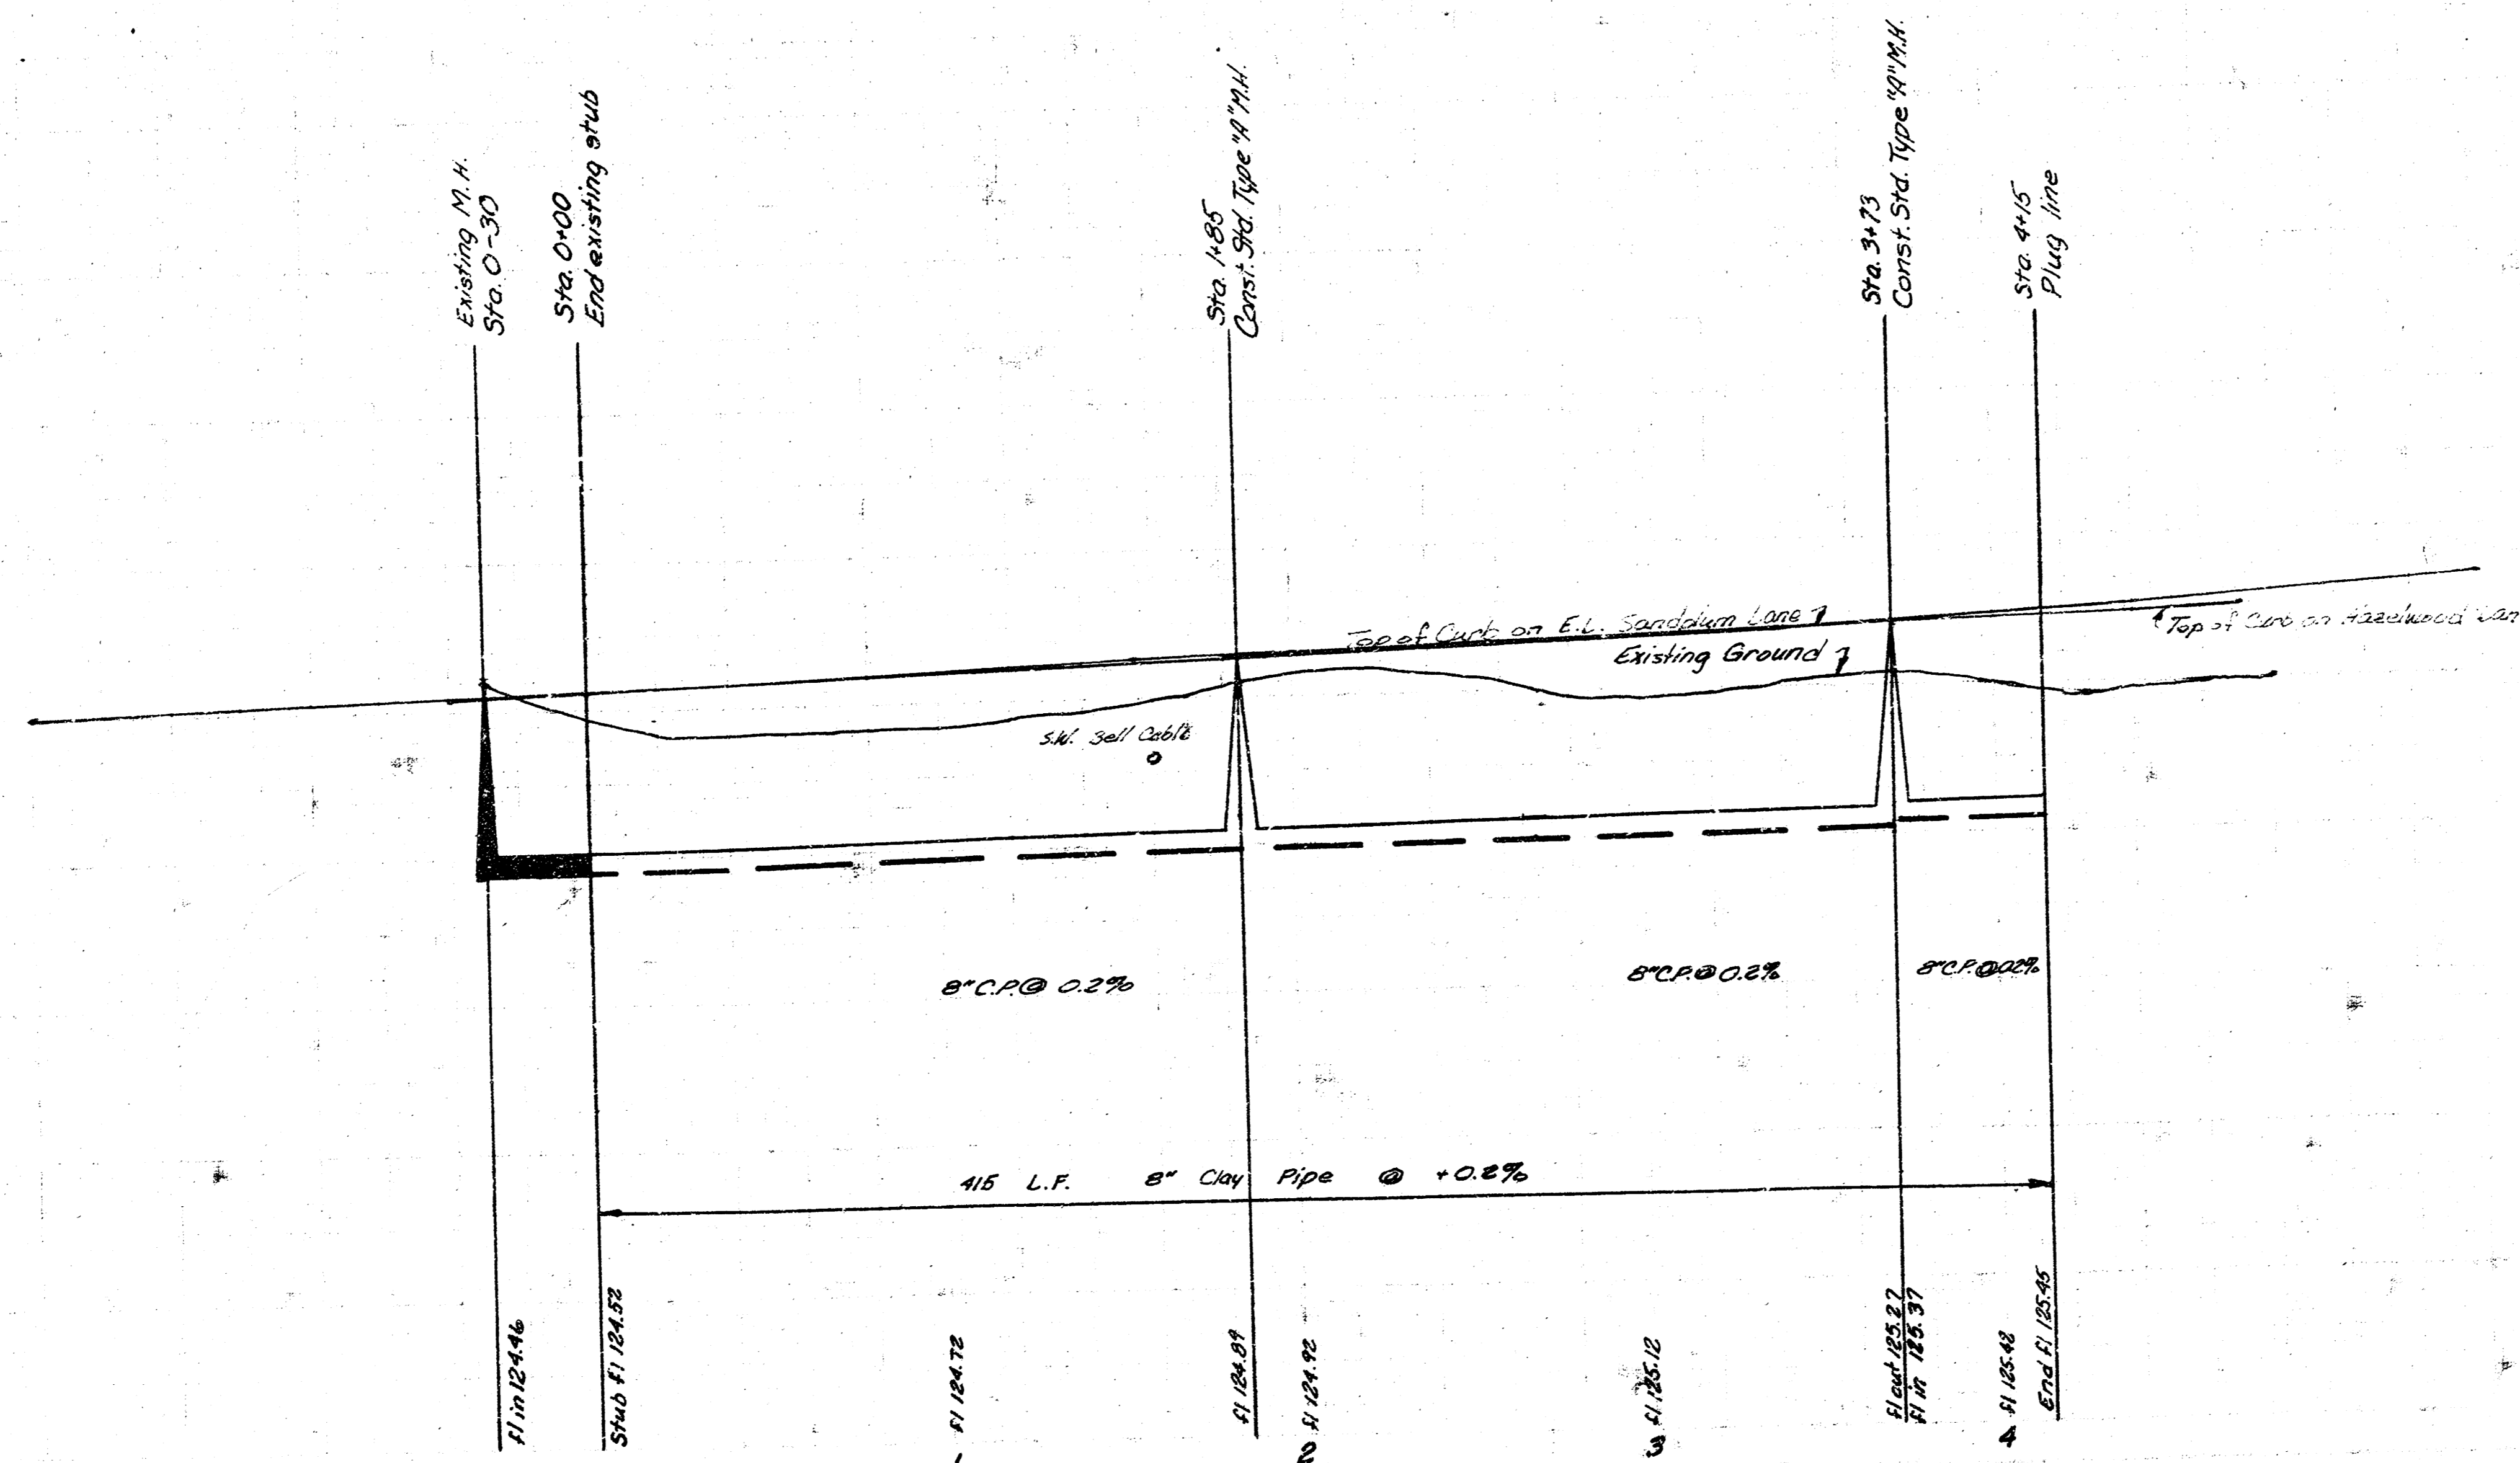

As Built
Aug 12

LAT. 54 WESTLINK SEWER
 R. W. LINN CITY ENGINEER
 CITY OF WICHITA, KS.
 PR. NO. DBKL572026 DATE 7-72

FILMED FROM THE BEST
 AVAILABLE COPY