



B.M. 155.470 + Top West curb Chipper Lane
at S. L. Briarwood.

3. M. 157.090 Top bolt SW cor. H.L.P. base
S-Side K & E. Westlink Sub station on 13th.

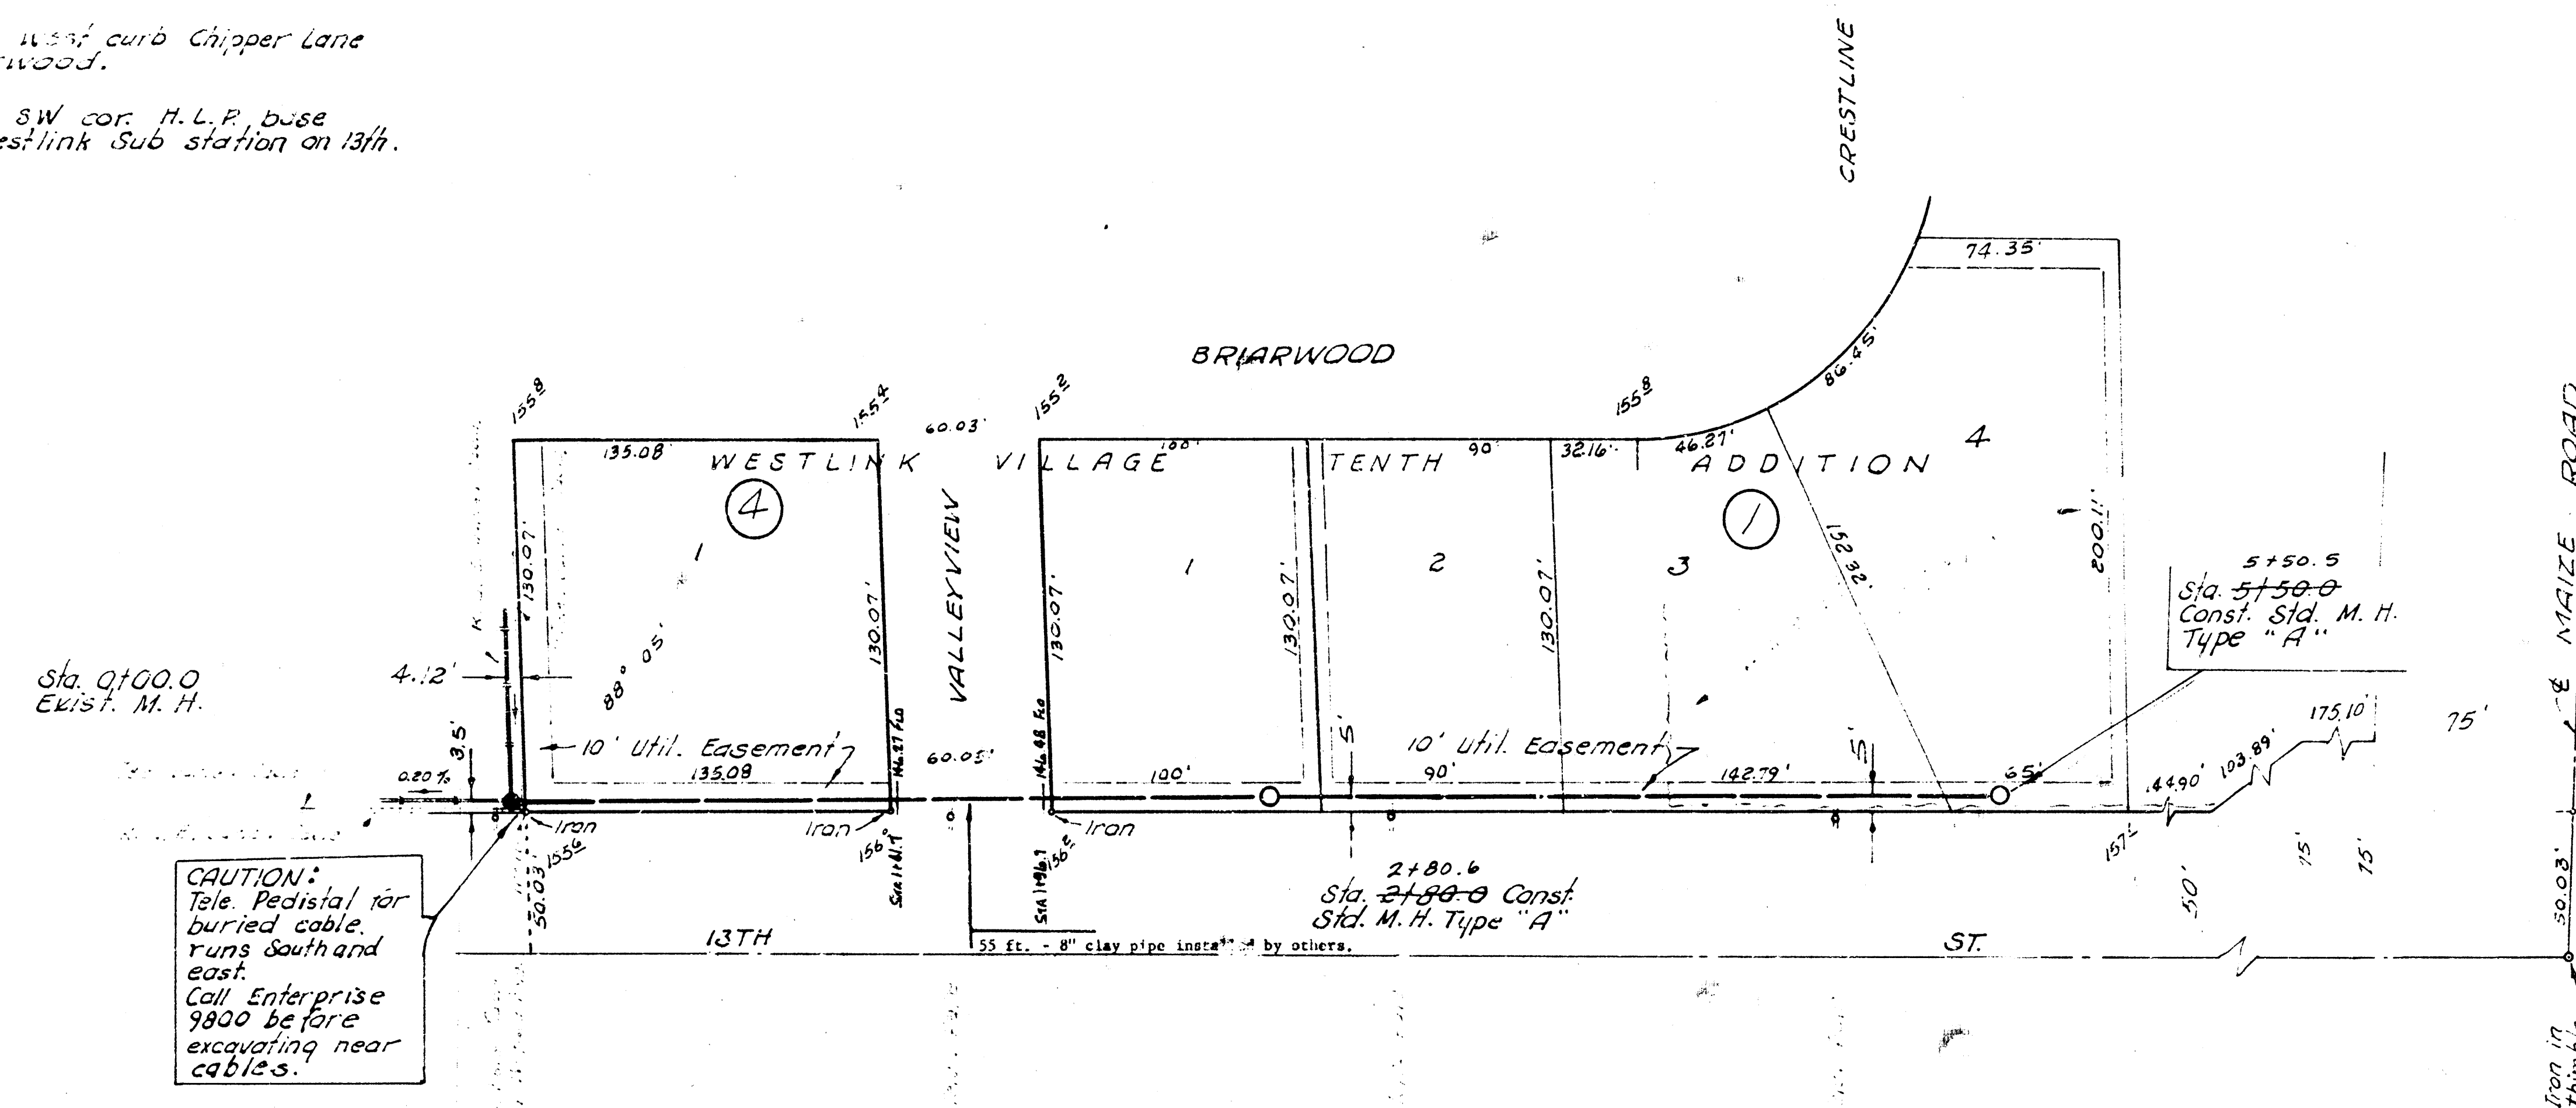

Plan Scale 1" = 40'
Profile Scale 1" = 40' Horiz.
1" = 5' Vert.

CAUTION:
Tele. Pedestal for
buried cable
runs south and
east.
Call Enterprise
9800 before
excavating near
cables.

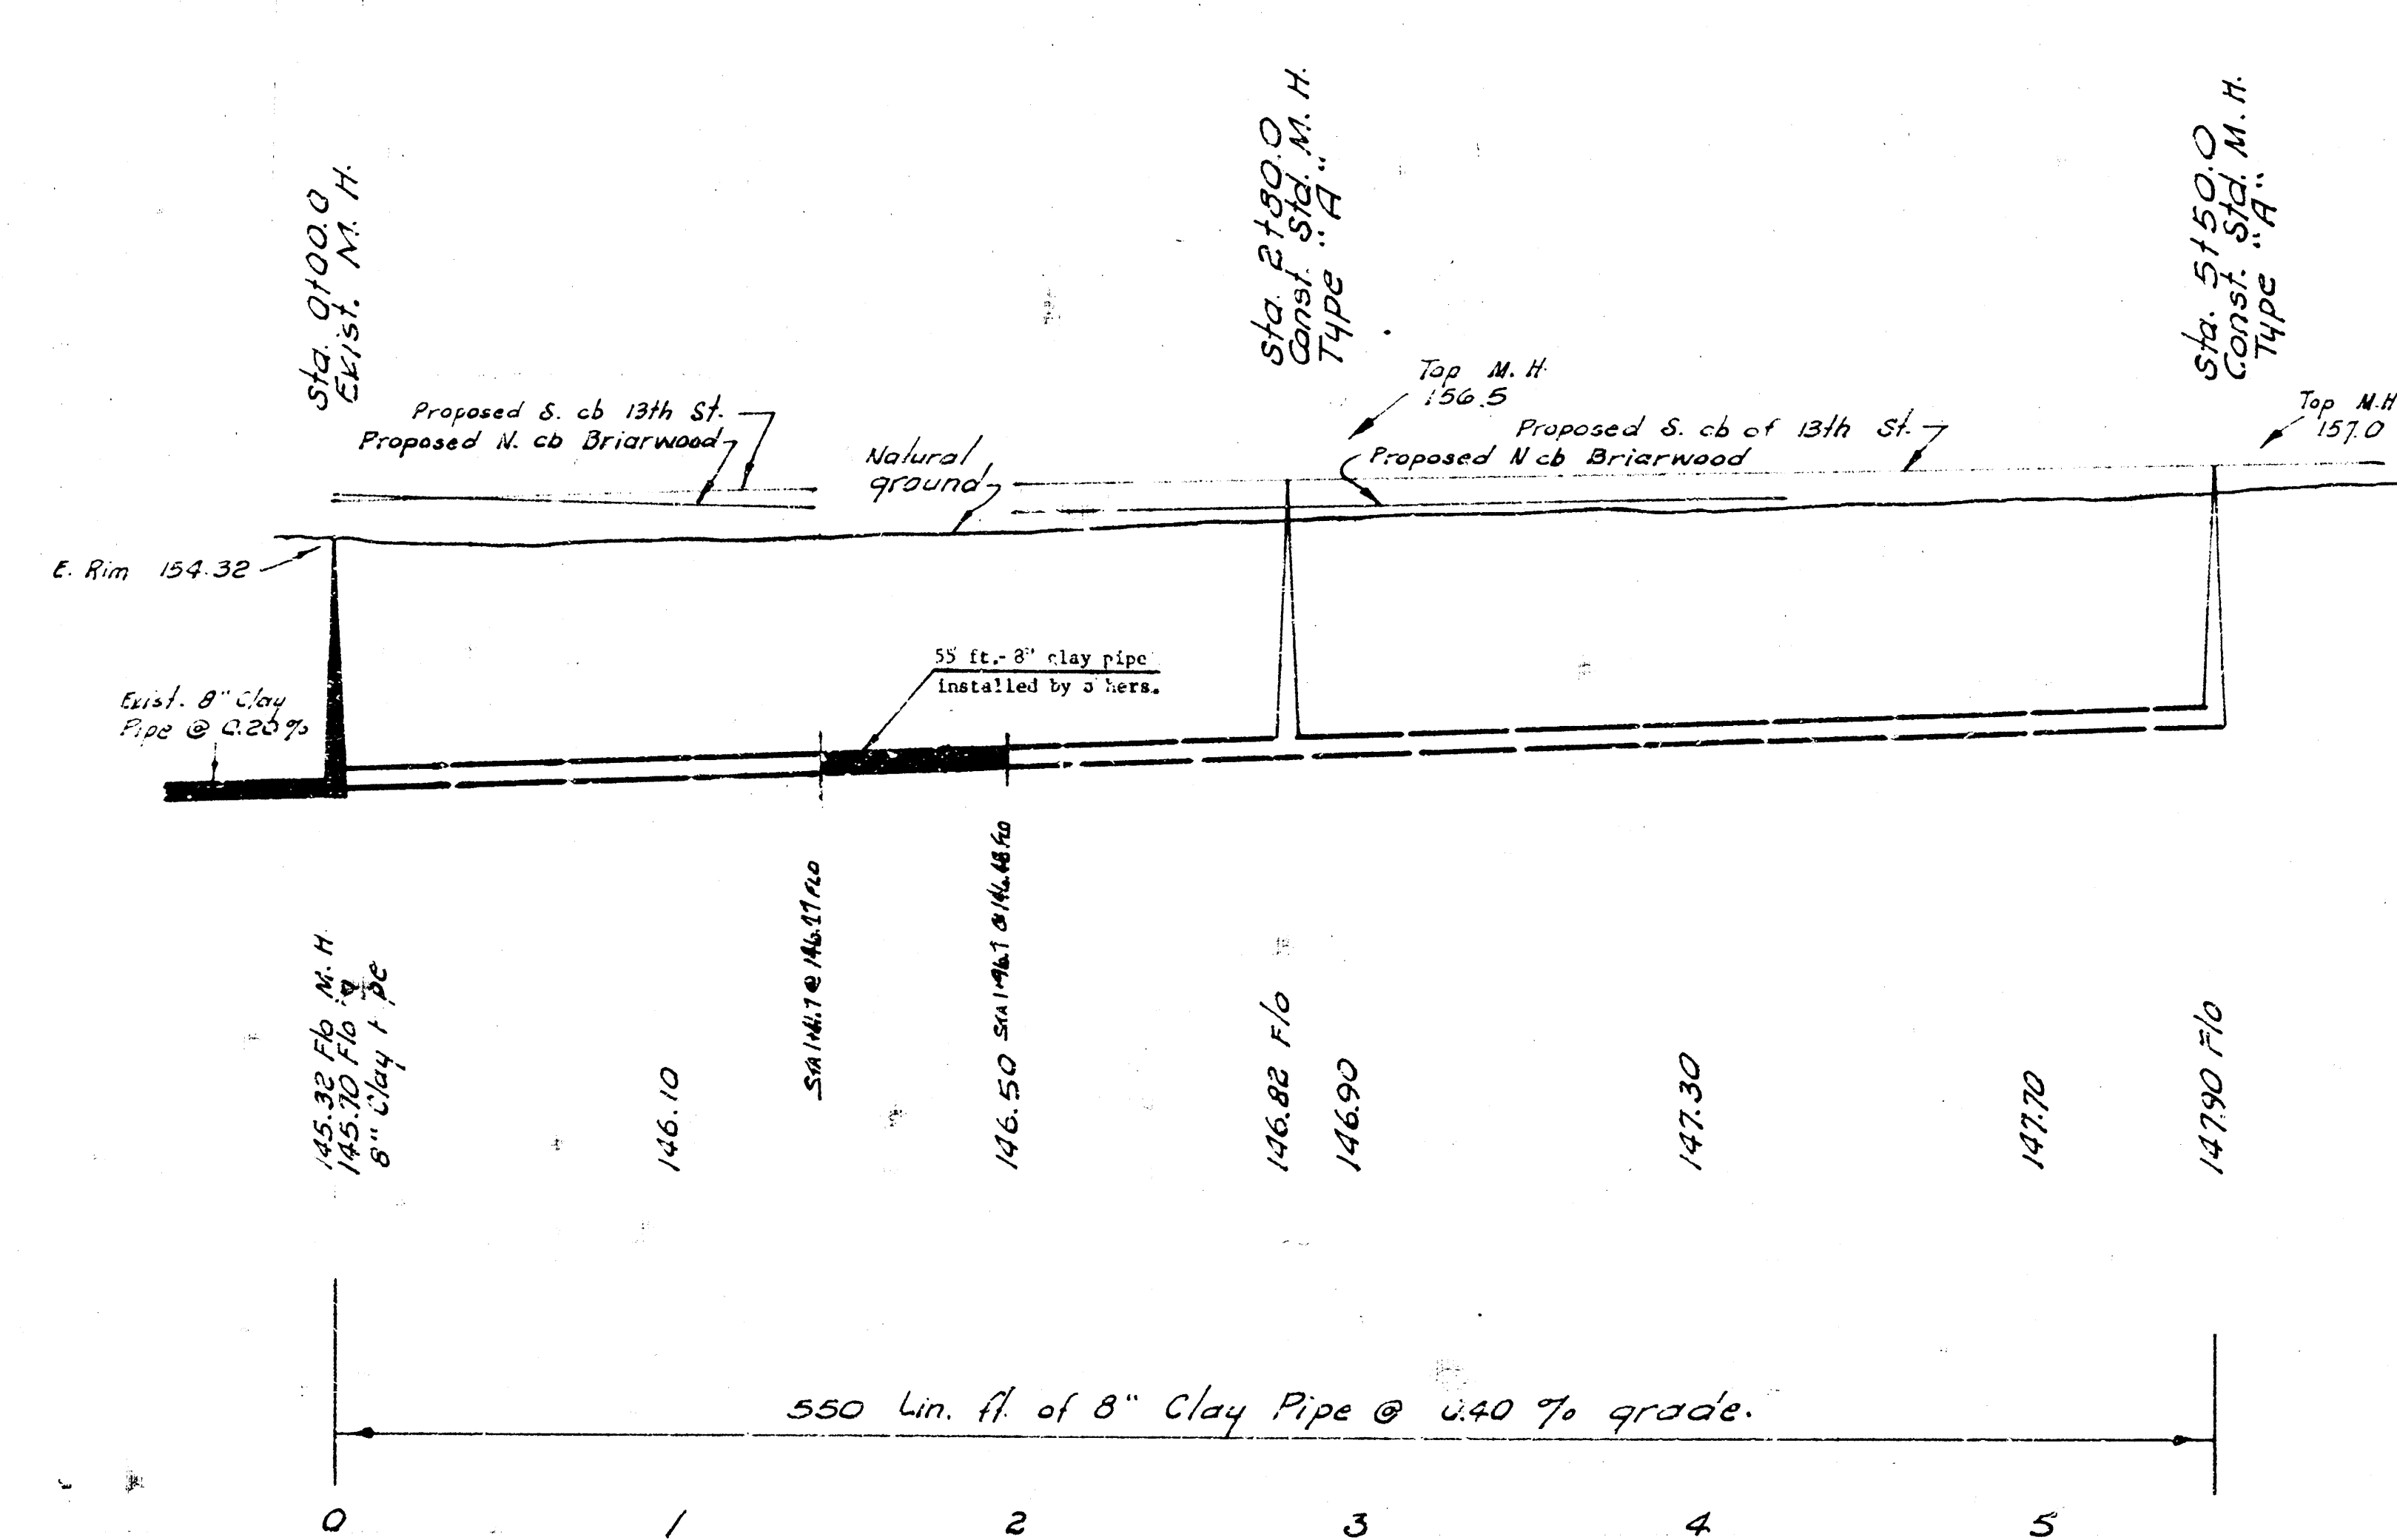

Final Plan, "As Built" & 100

LAT. 55, WESTLINK SEWER
CITY OF WICHITA, KANSAS
R. W. LINN - CITY ENGINEER
AUGUST 1973, PROJECT NO. DBKL572048