
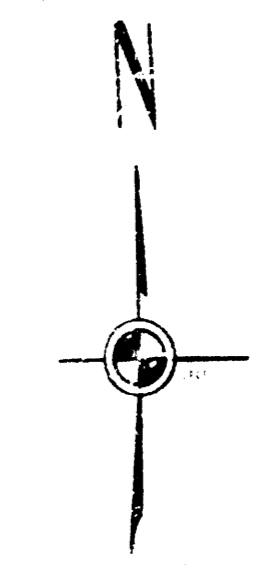


B. M. 148.10 City std @ Ridge Rd.
 4' 13th St.


B. M. 153.12 R. R. Spike W. side P. Pole
 2' E. of E. cb Holland approx.
 25' N. of N. Line 13th St.

u. f. w.
 L12

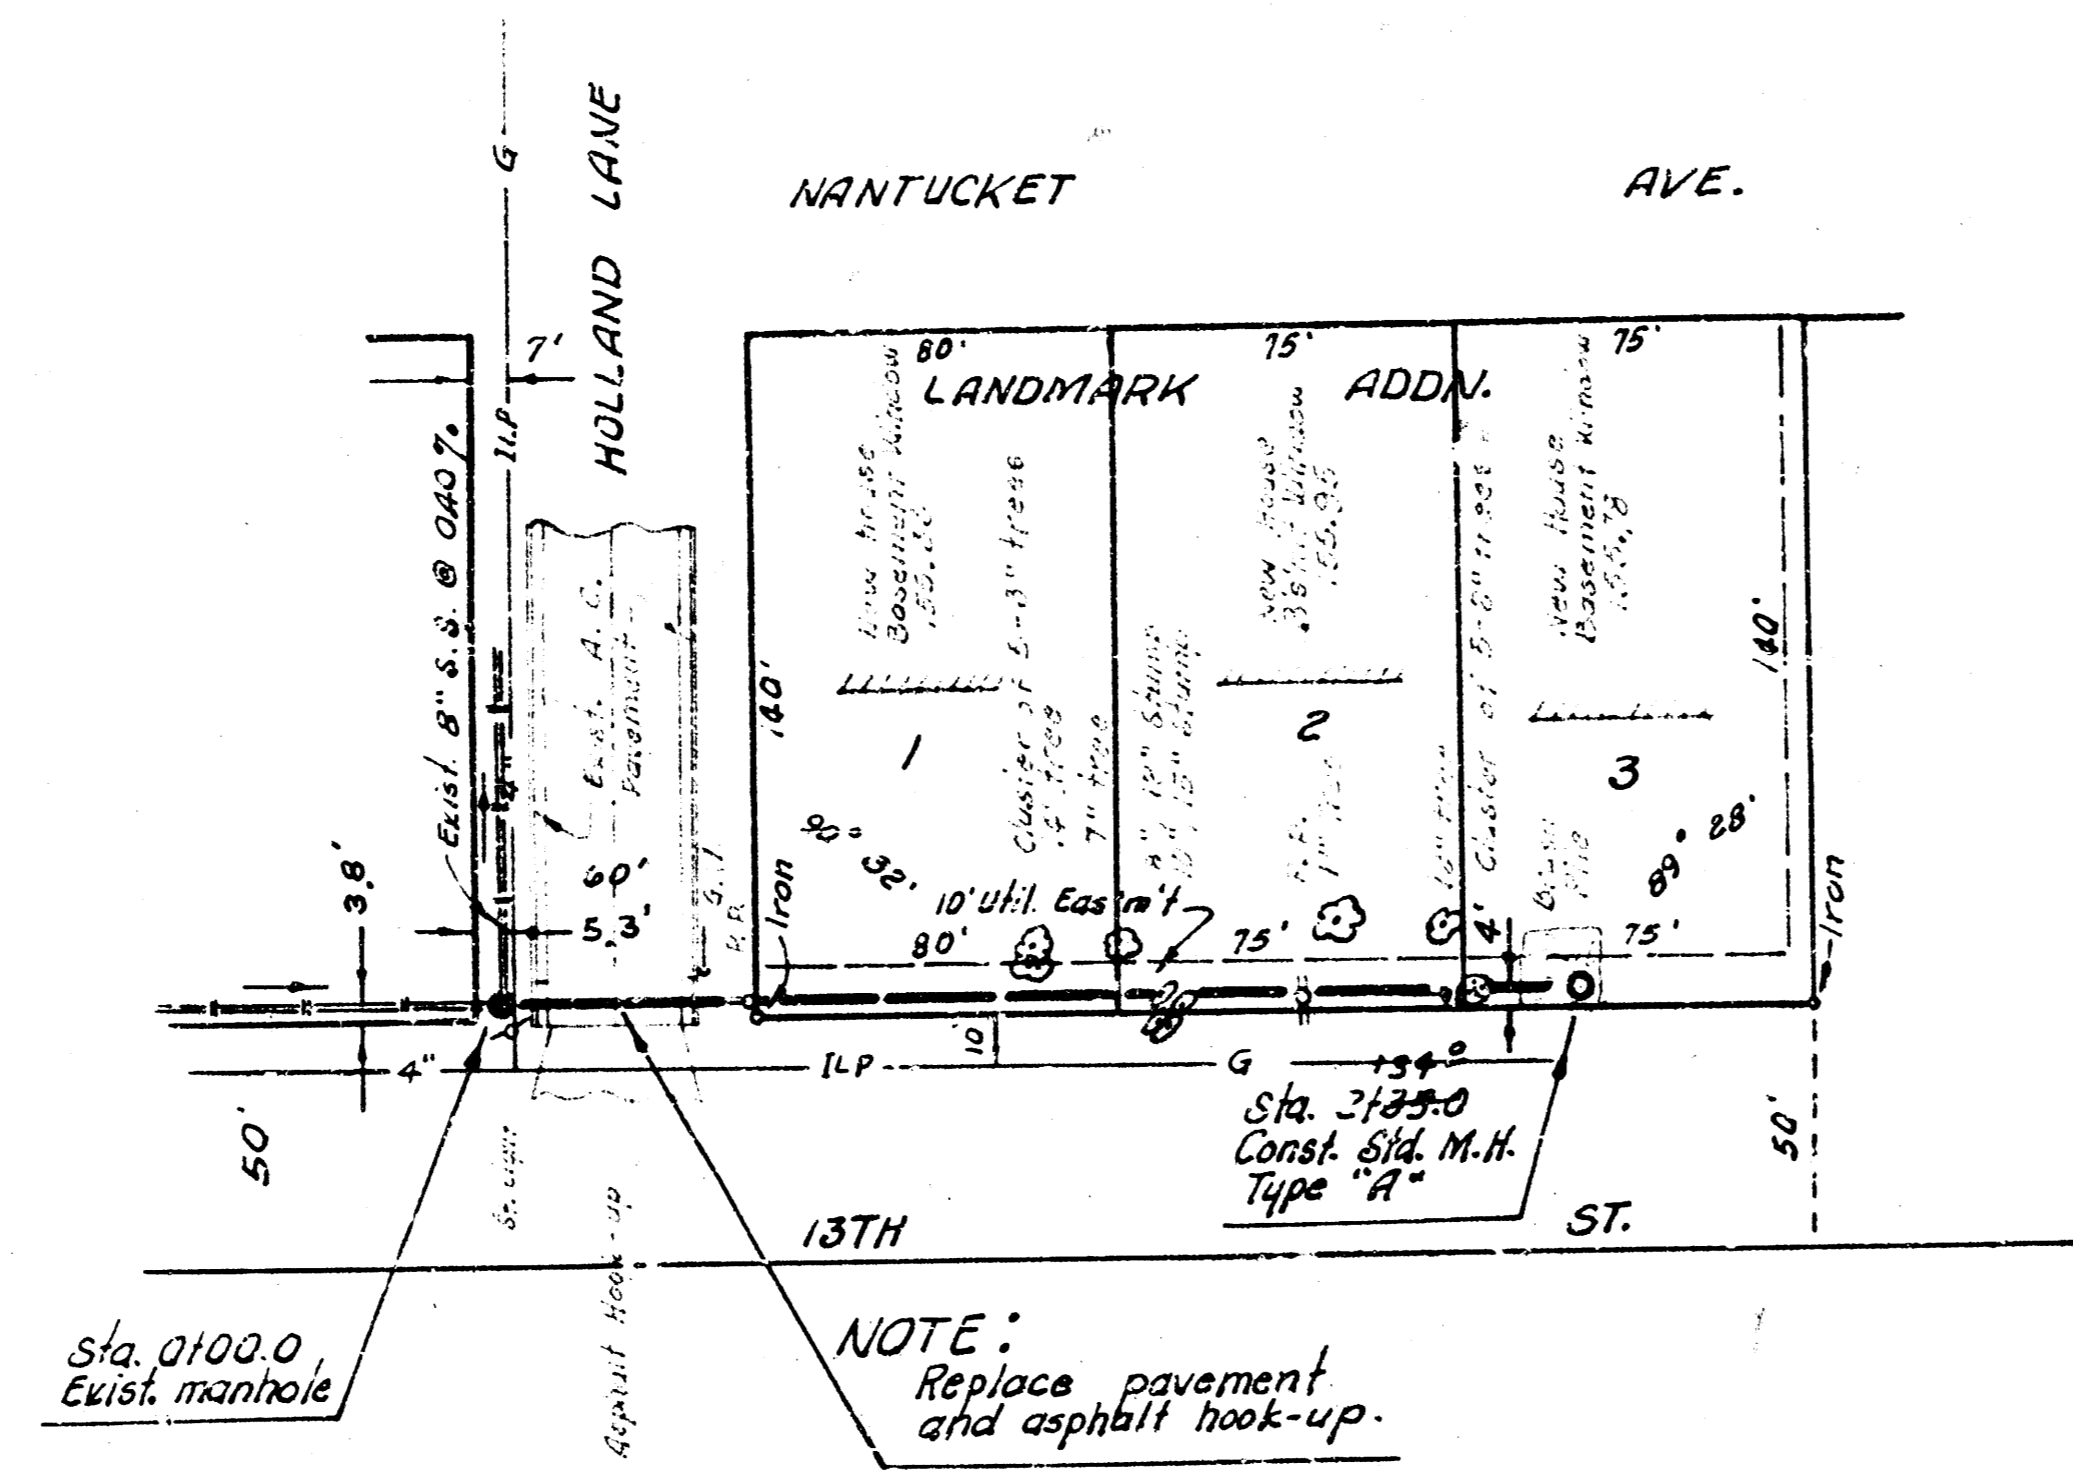


Plan Scale 1" = 40'
 Profile Scale 1" = 20' Horiz.
 1" = 5' Vert.

155
 150
 145
 140

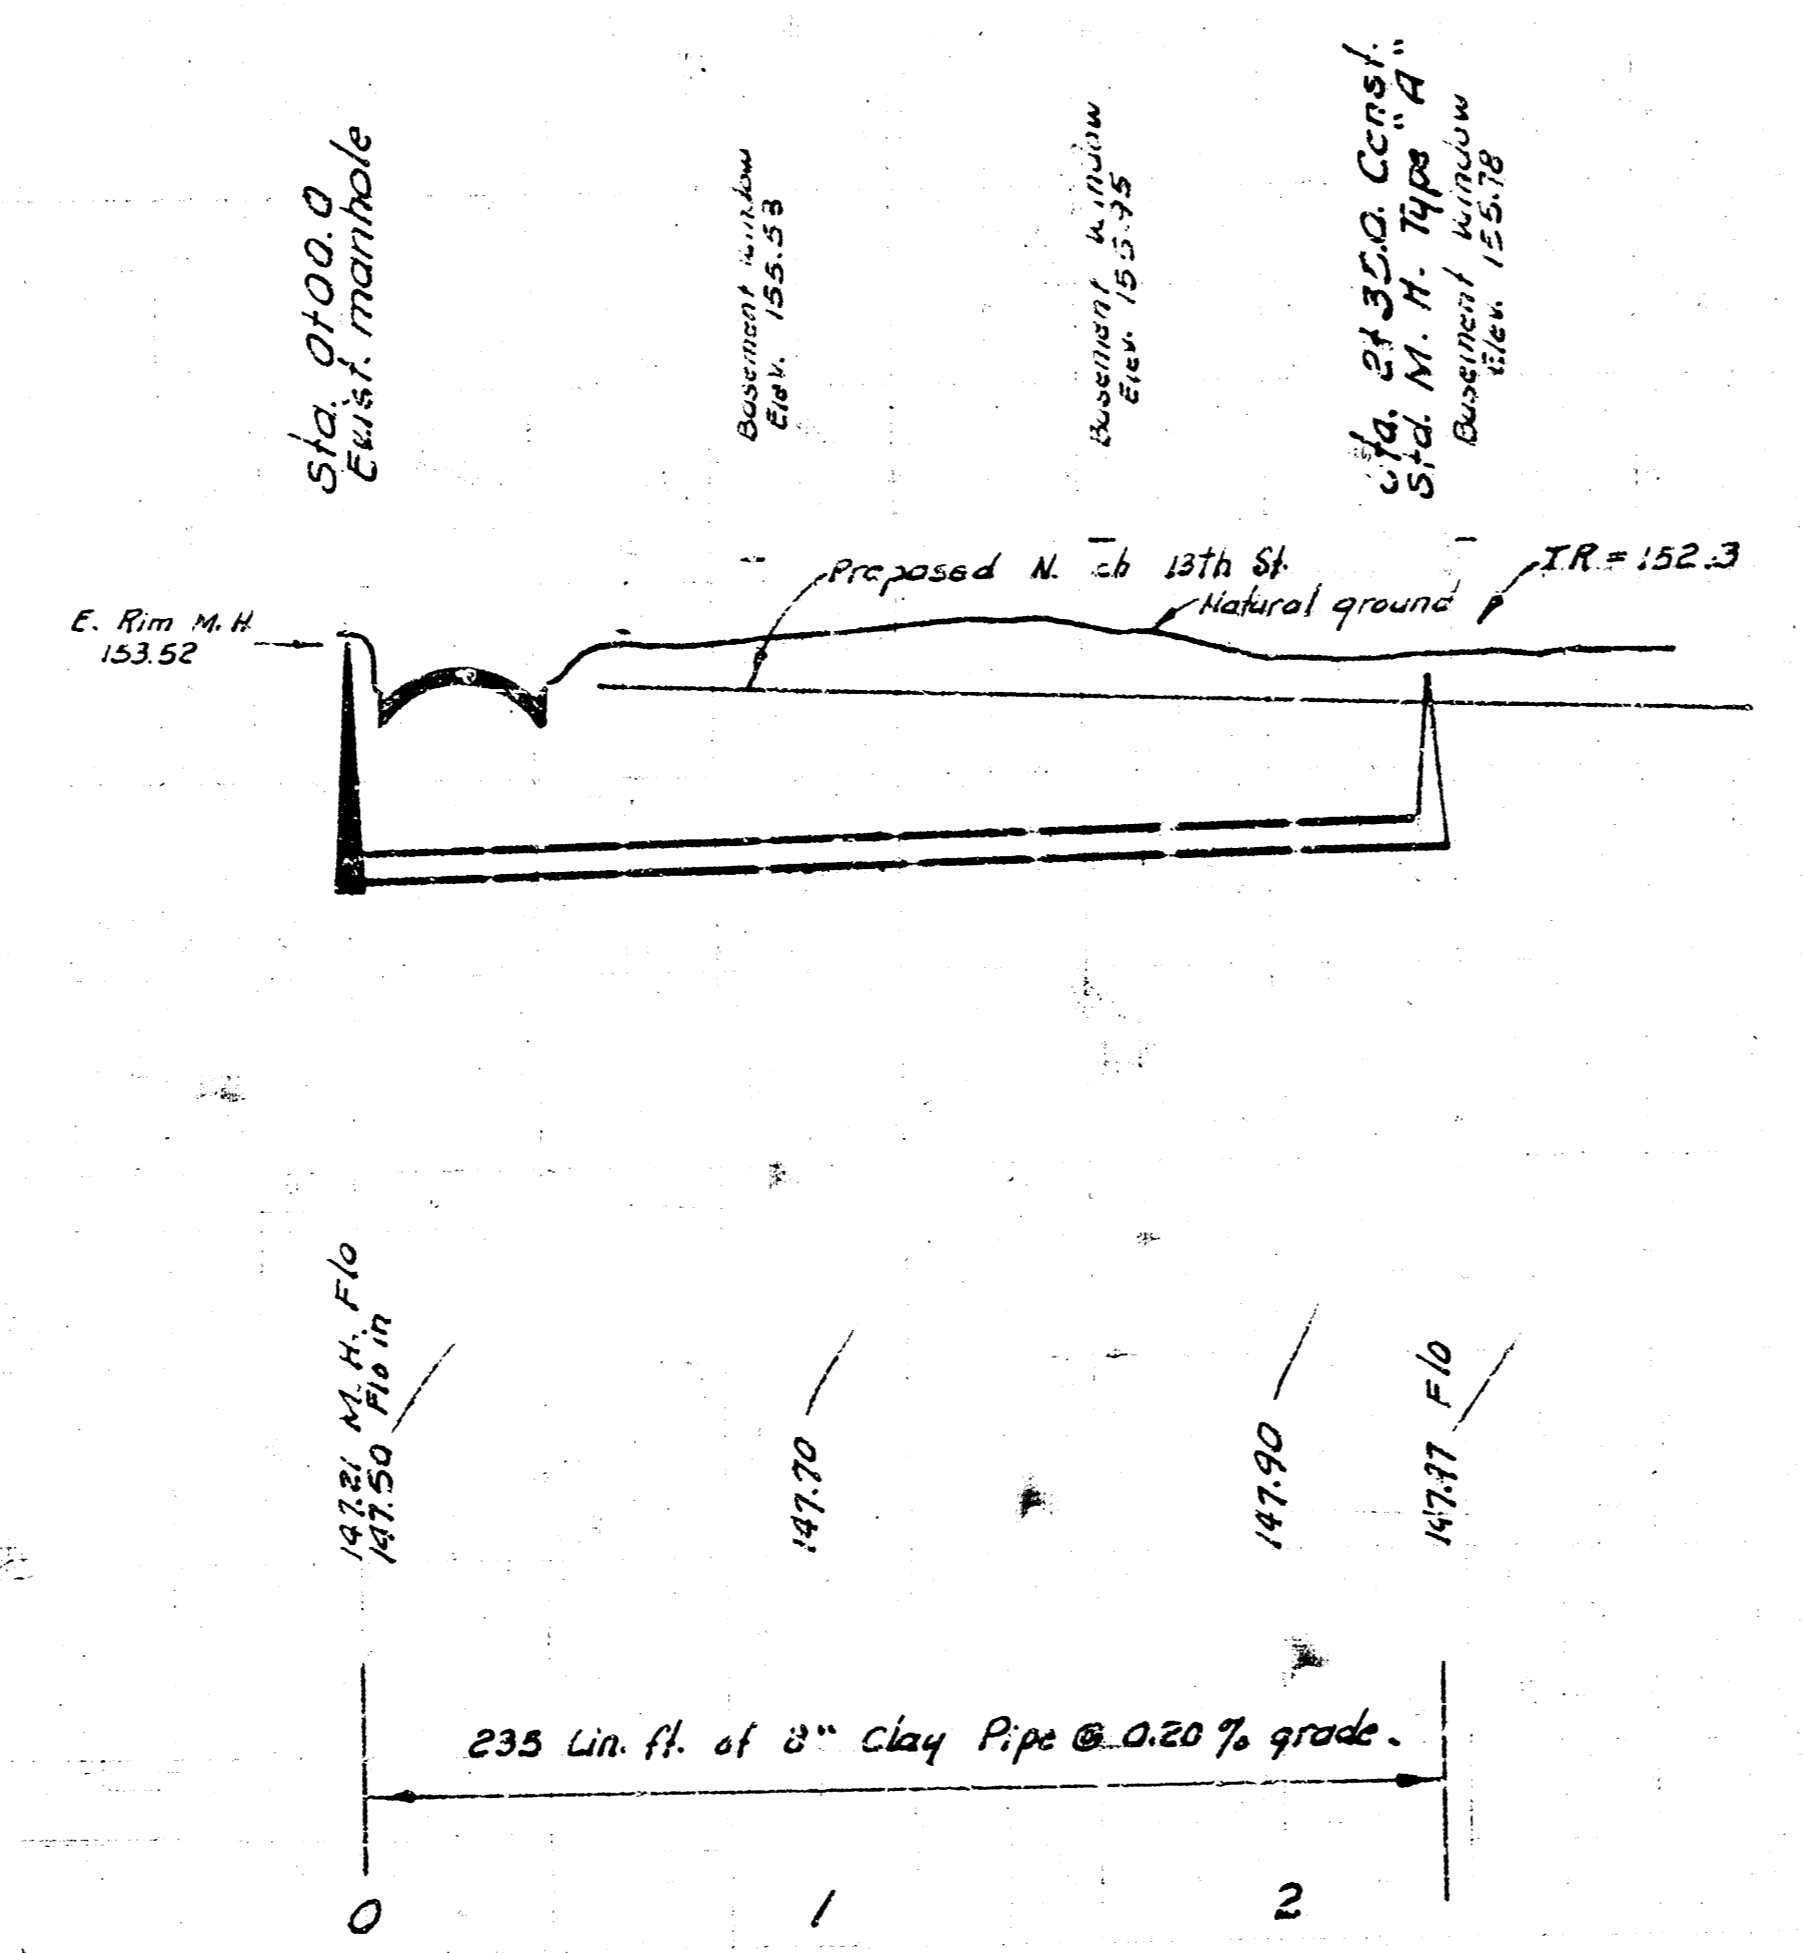

155
 150
 145
 140

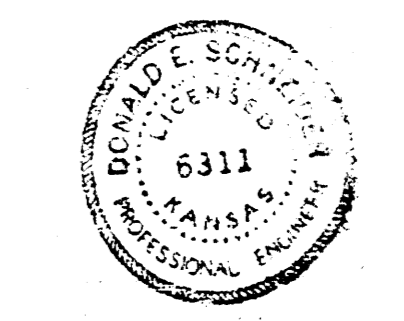

As Built Final Meas. 11-105

LAT. 57, WESTLINK SEWER
 CIT OF WICHITA, KANSAS
 R. W. LINN — CITY ENGINEER
 DEC. 1973 PROJECT NO. DBKL 573006