

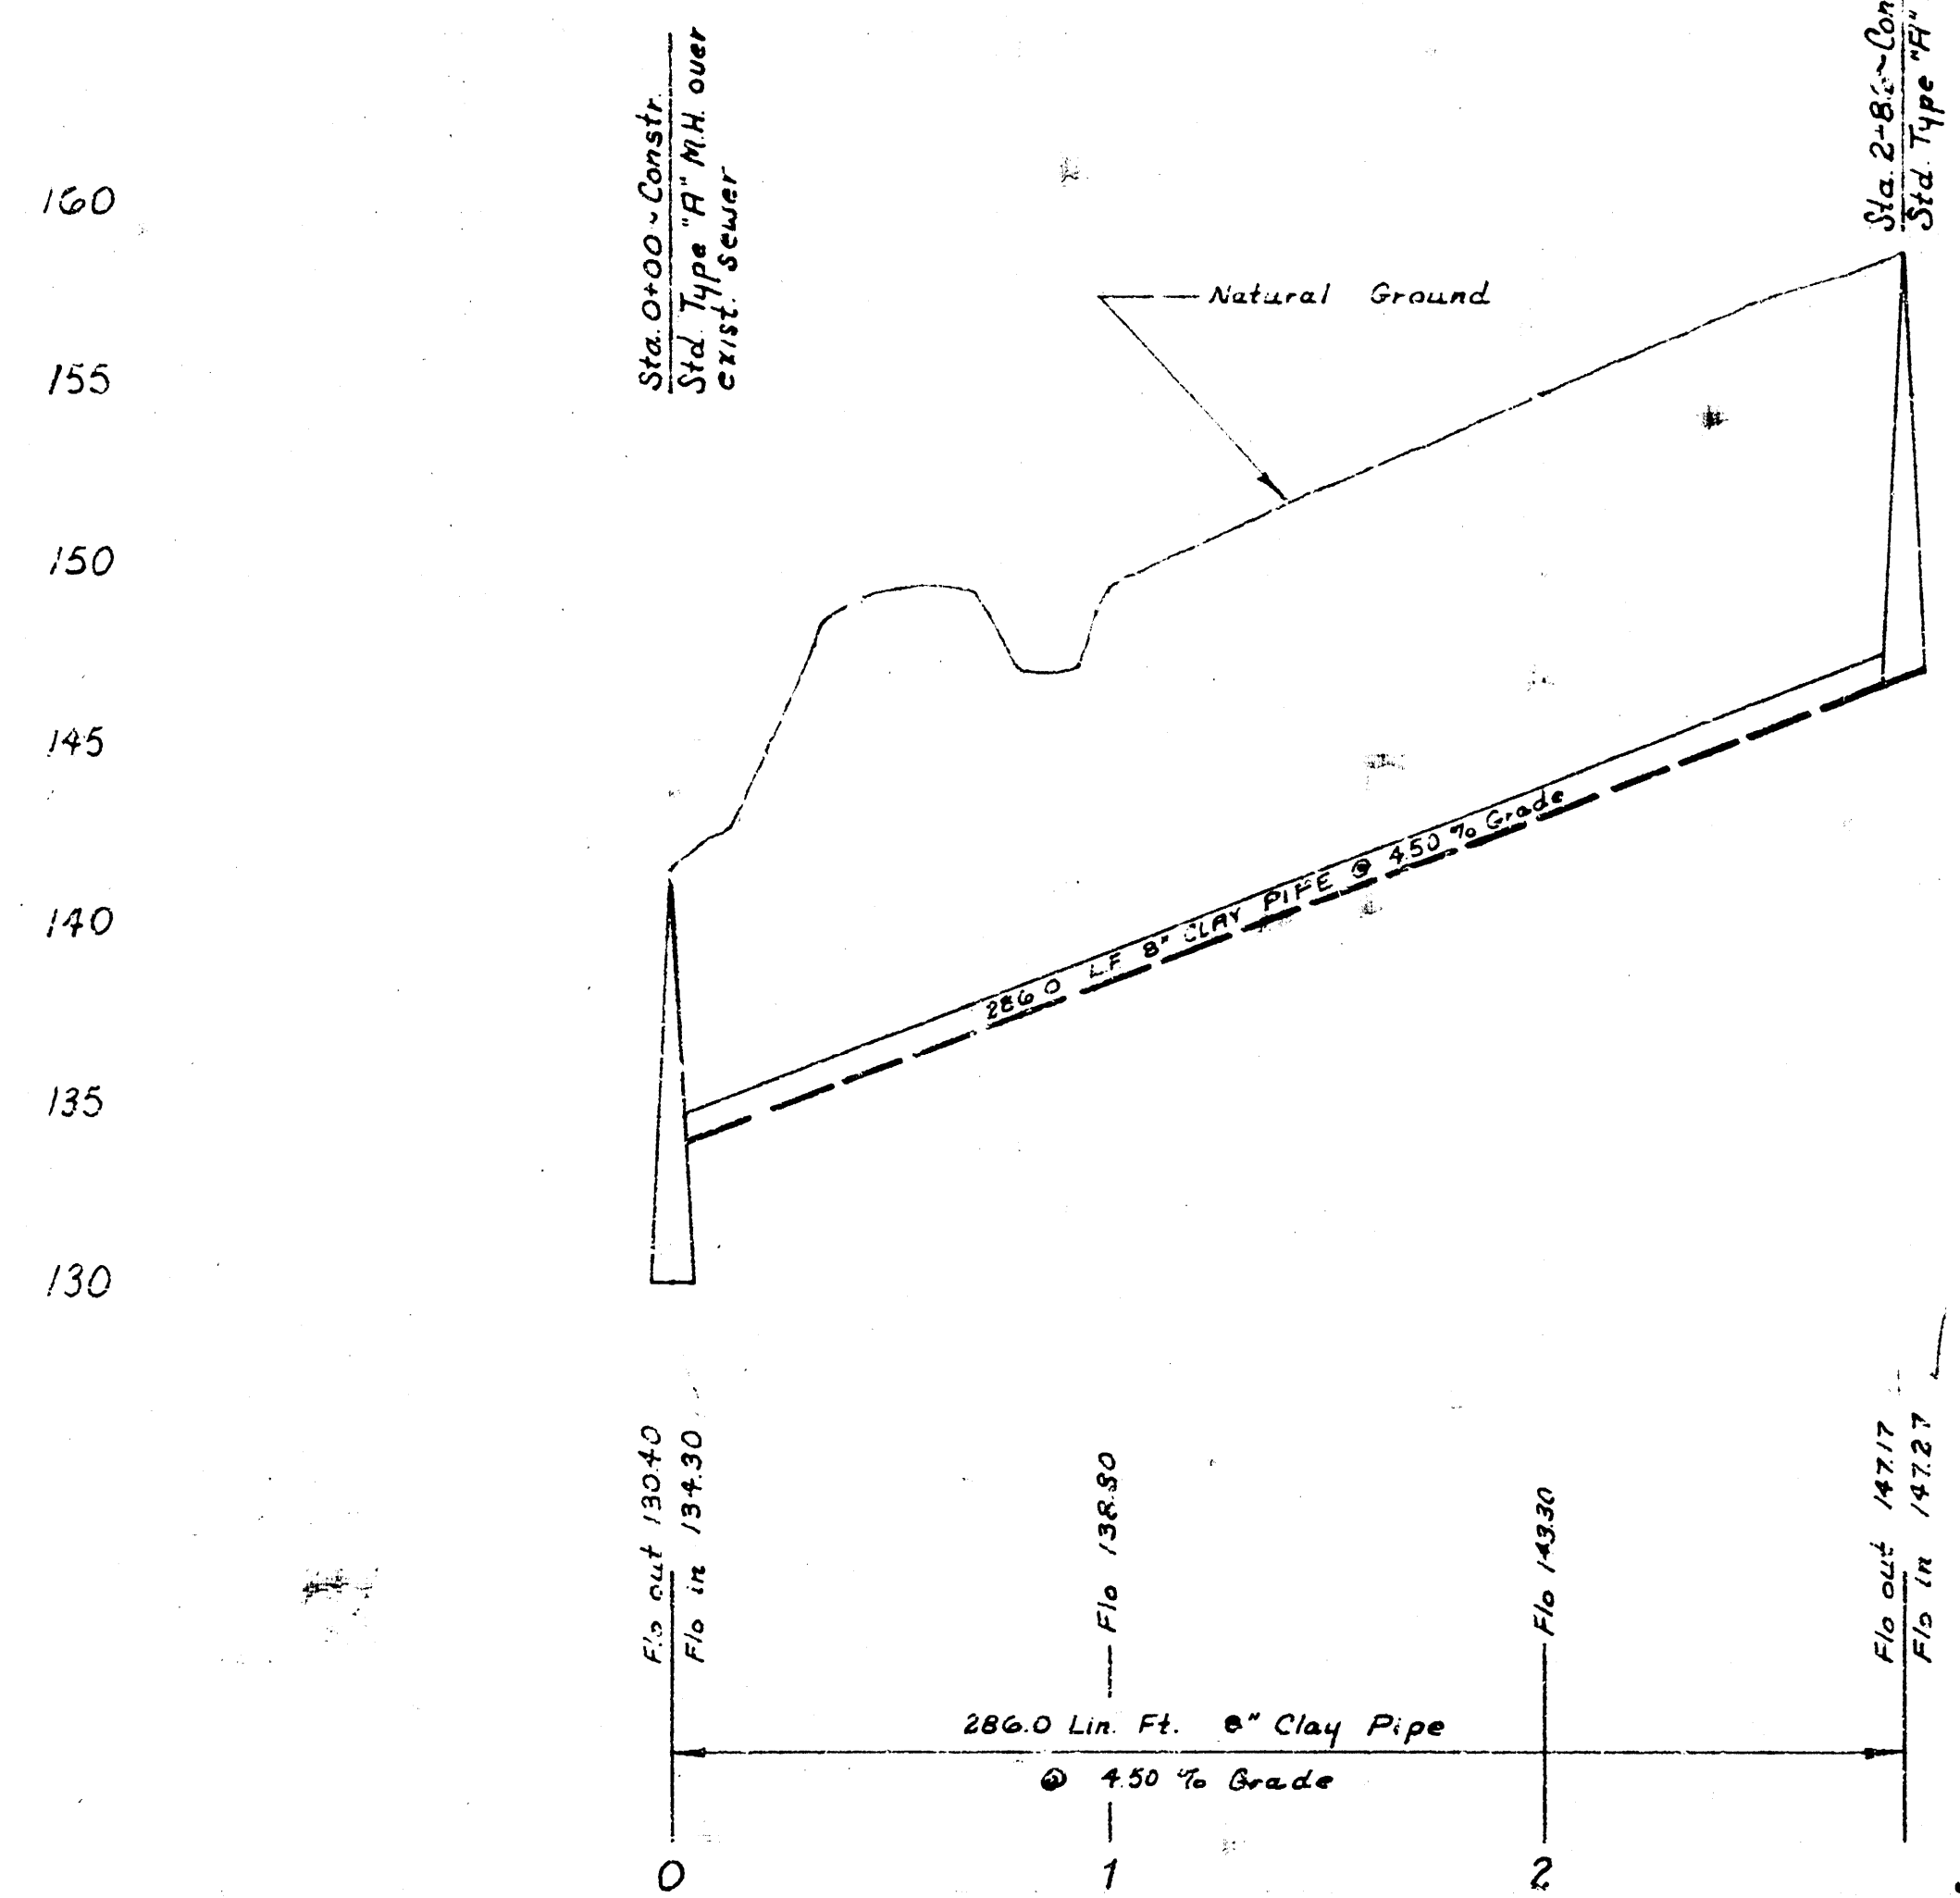


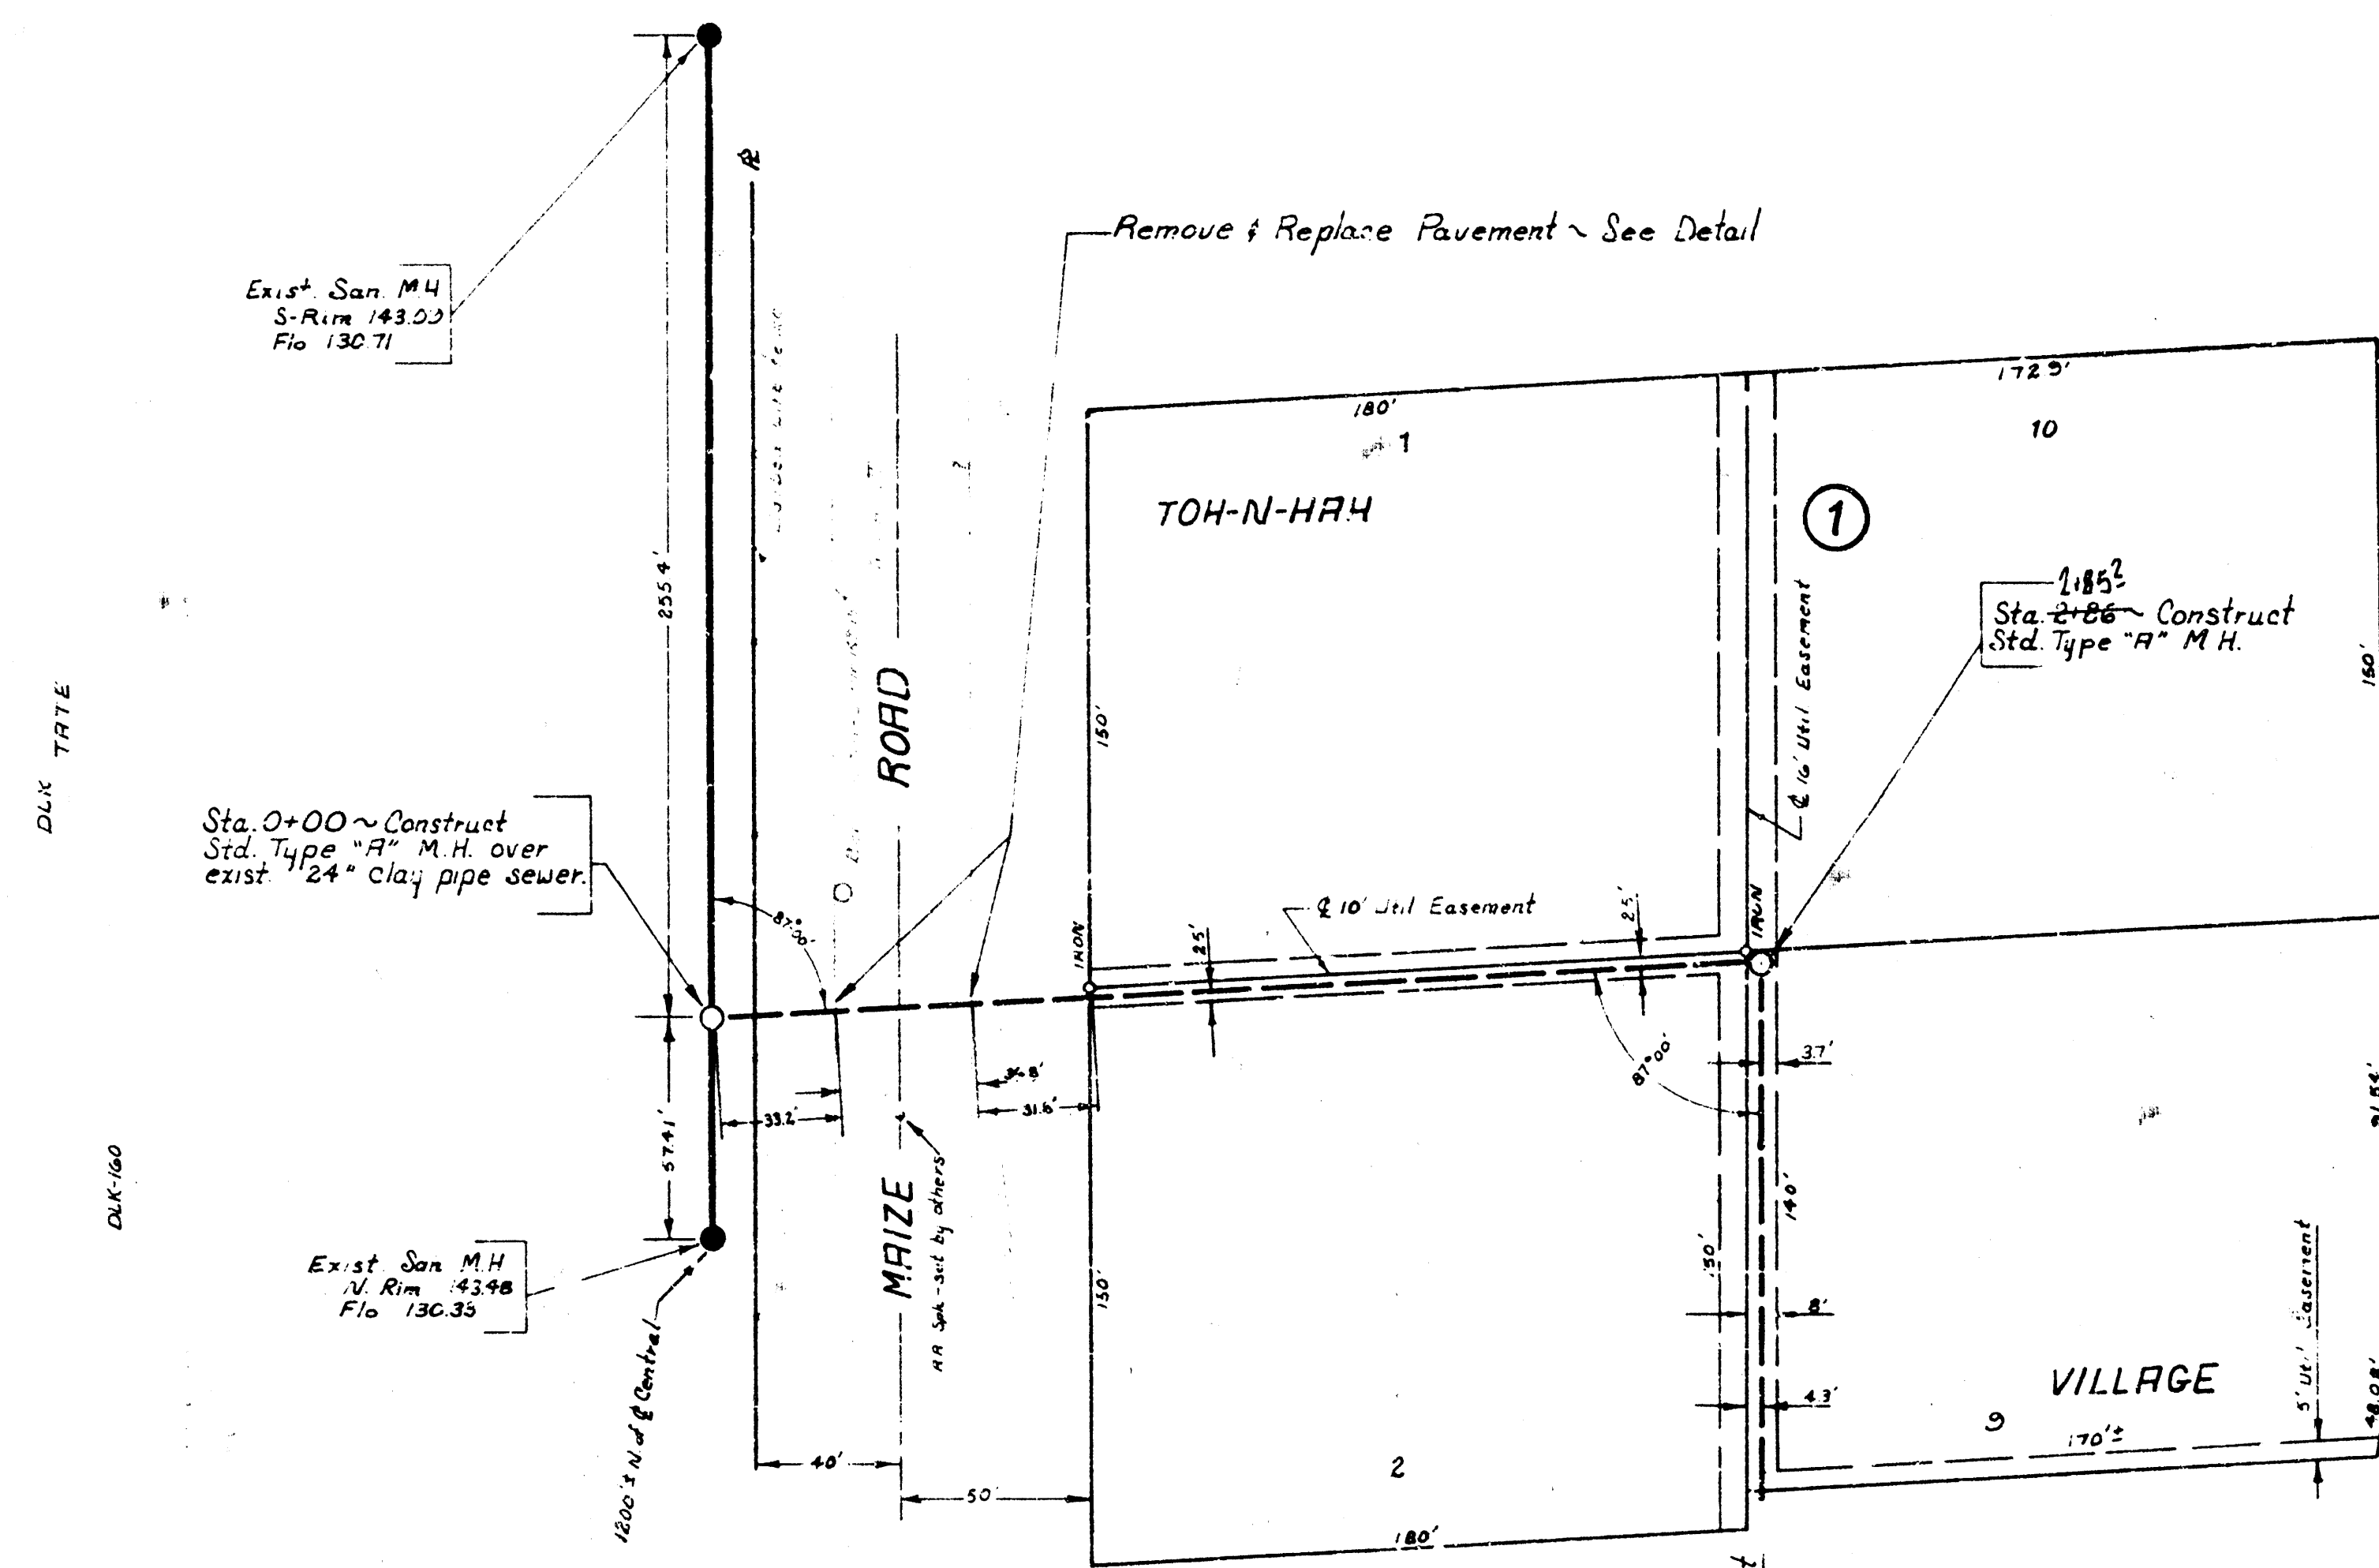

B.M. 14226 ~ Std. 4135 S + 525 E @ both Central & Maize
 B.M. 14357 ~ R.R. spt. S-face PP SW cor. lot 1, blk. 1, Toh-N-Han Village,
 being 3rd P.F. N. of Squaw Lane in ES Maize Road

Permits sold
 See Sheet #2

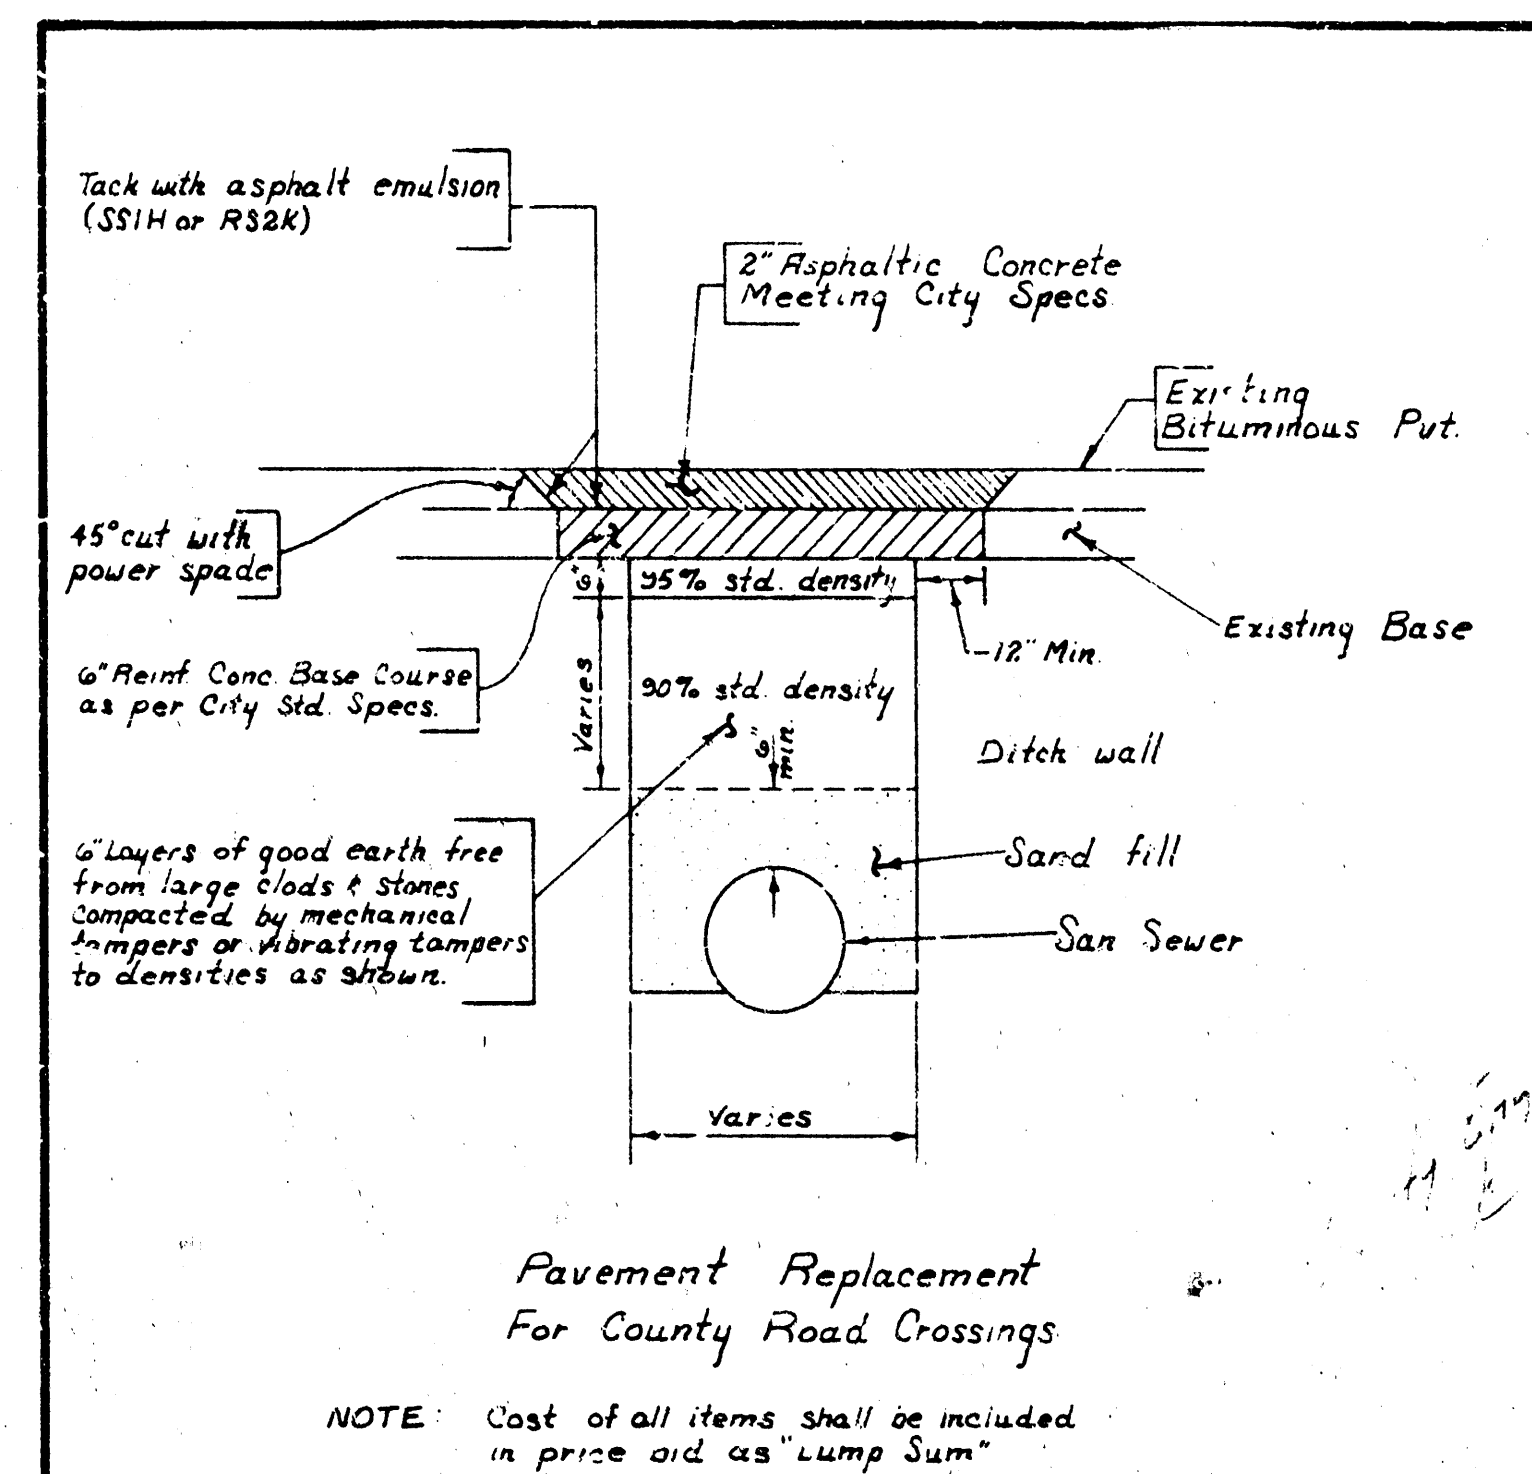

Plan Scale ~ 1" = 40'
 Profile Scale ~ Horiz 1" = 40'
 Vert 1" = 5'



As Built Plans 4 Sept 73 from K-106
LATERAL 58
WESTLINK INTERCEPTOR
CITY OF WICHITA
R.W. LINN-CITY ENGINEER
 DATE JULY 1973 PROJ. NO. DBKL 573028



②

17

2

5

10