


LAT 66 WESTLINK SEWER

CITY OF WICHITA

R.W.BRUGGEMAN - CITY ENGINEER

PROJECT NO. 468-76-245-80991-000-000-001

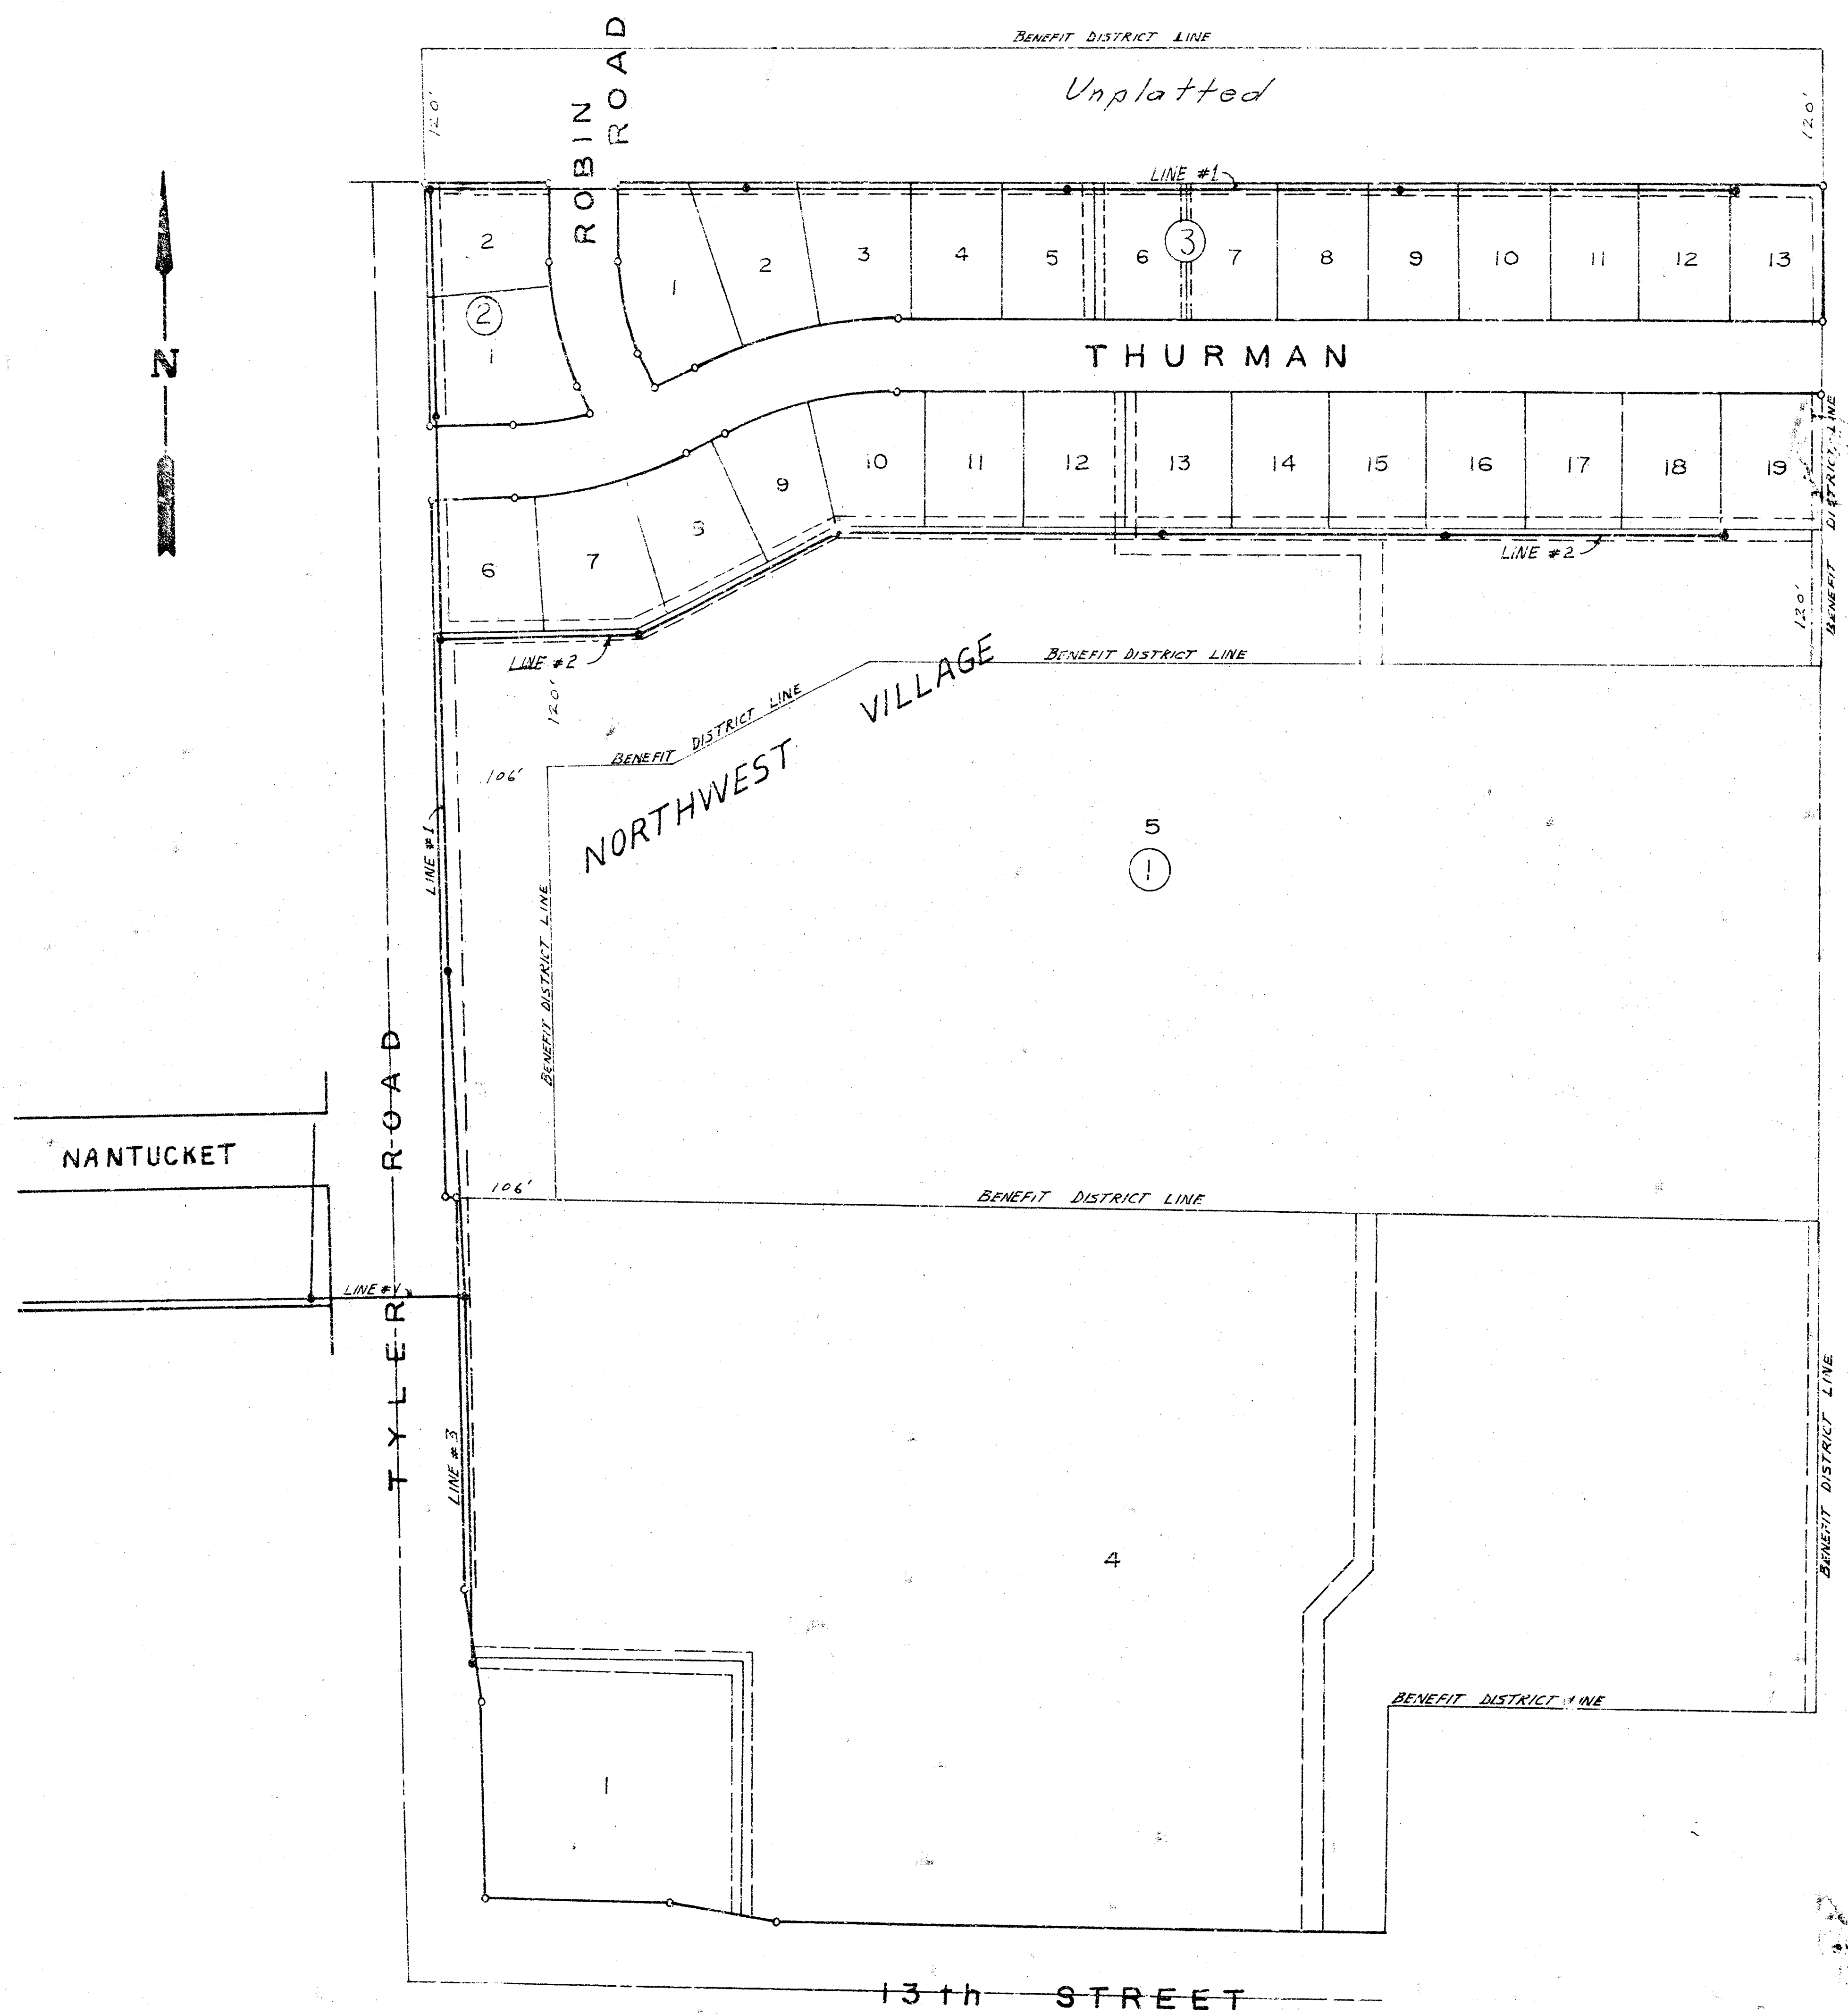


LINE #1	SHEETS	2-3
LINE #2	SHEETS	4-5
LINE #3	SHEET	5

As Built
5/81
JLL




CAUTION
UNDERGROUND
UTILITIES

—

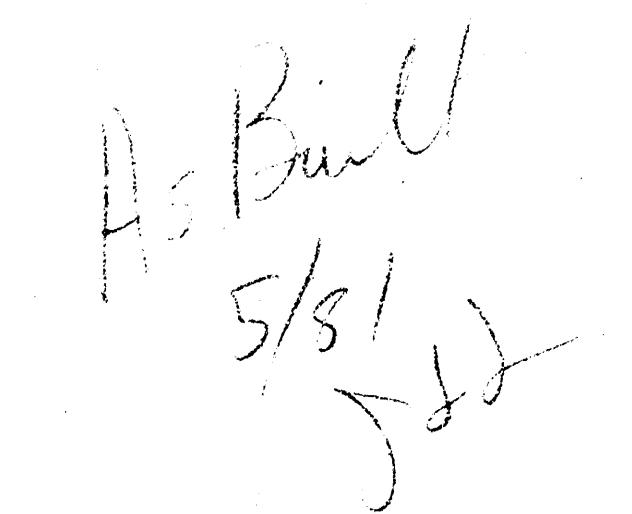


FILMED FROM THE BEST
AVAILABLE COPY

SCALE PLAN 1" = 40'
 PROFILE 1" = 40' VERT
 1" = 5' VERT

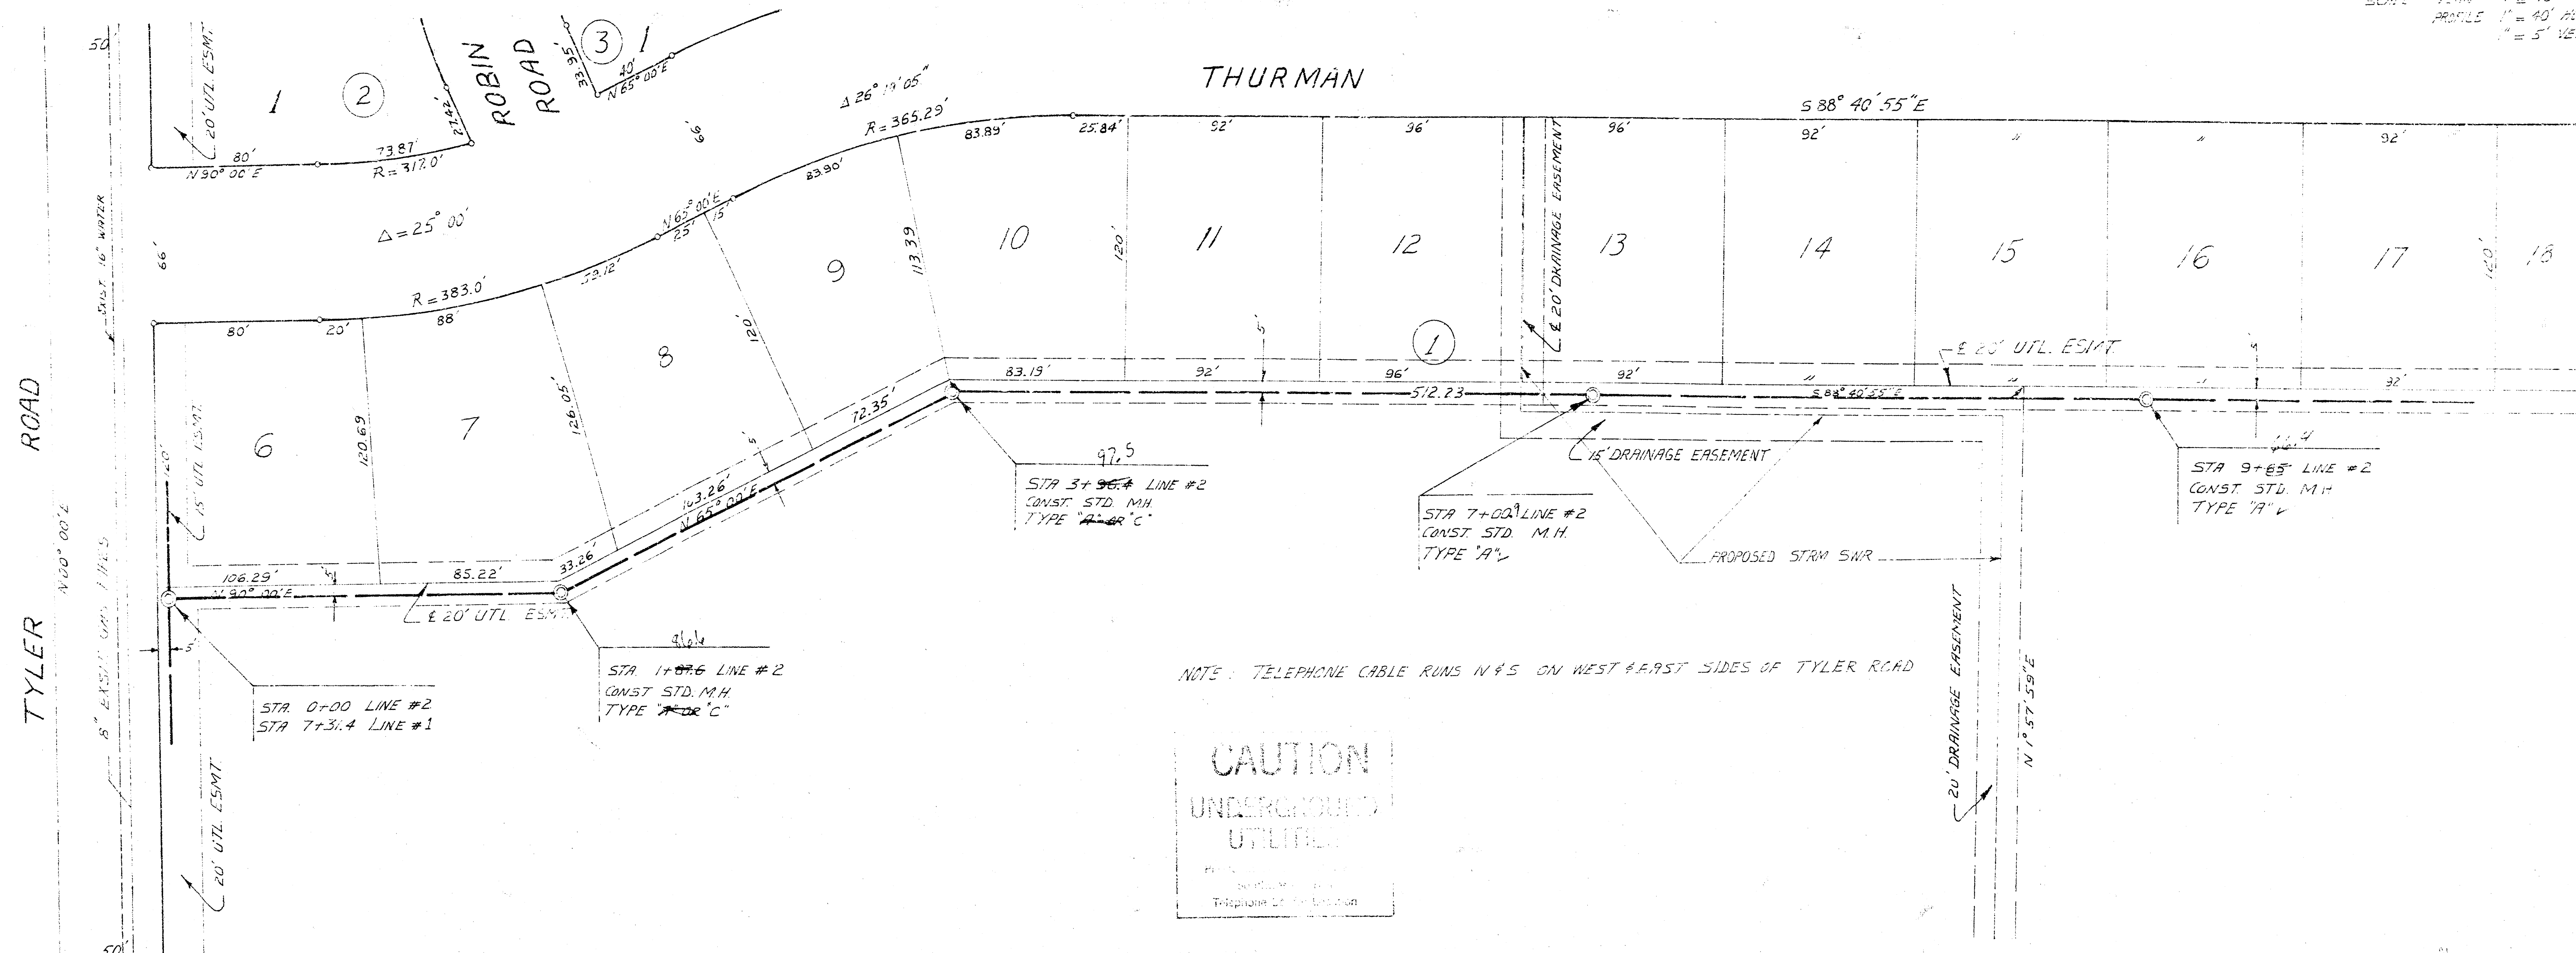

CAUTION
 UNDERGROUND
 UTILITIES

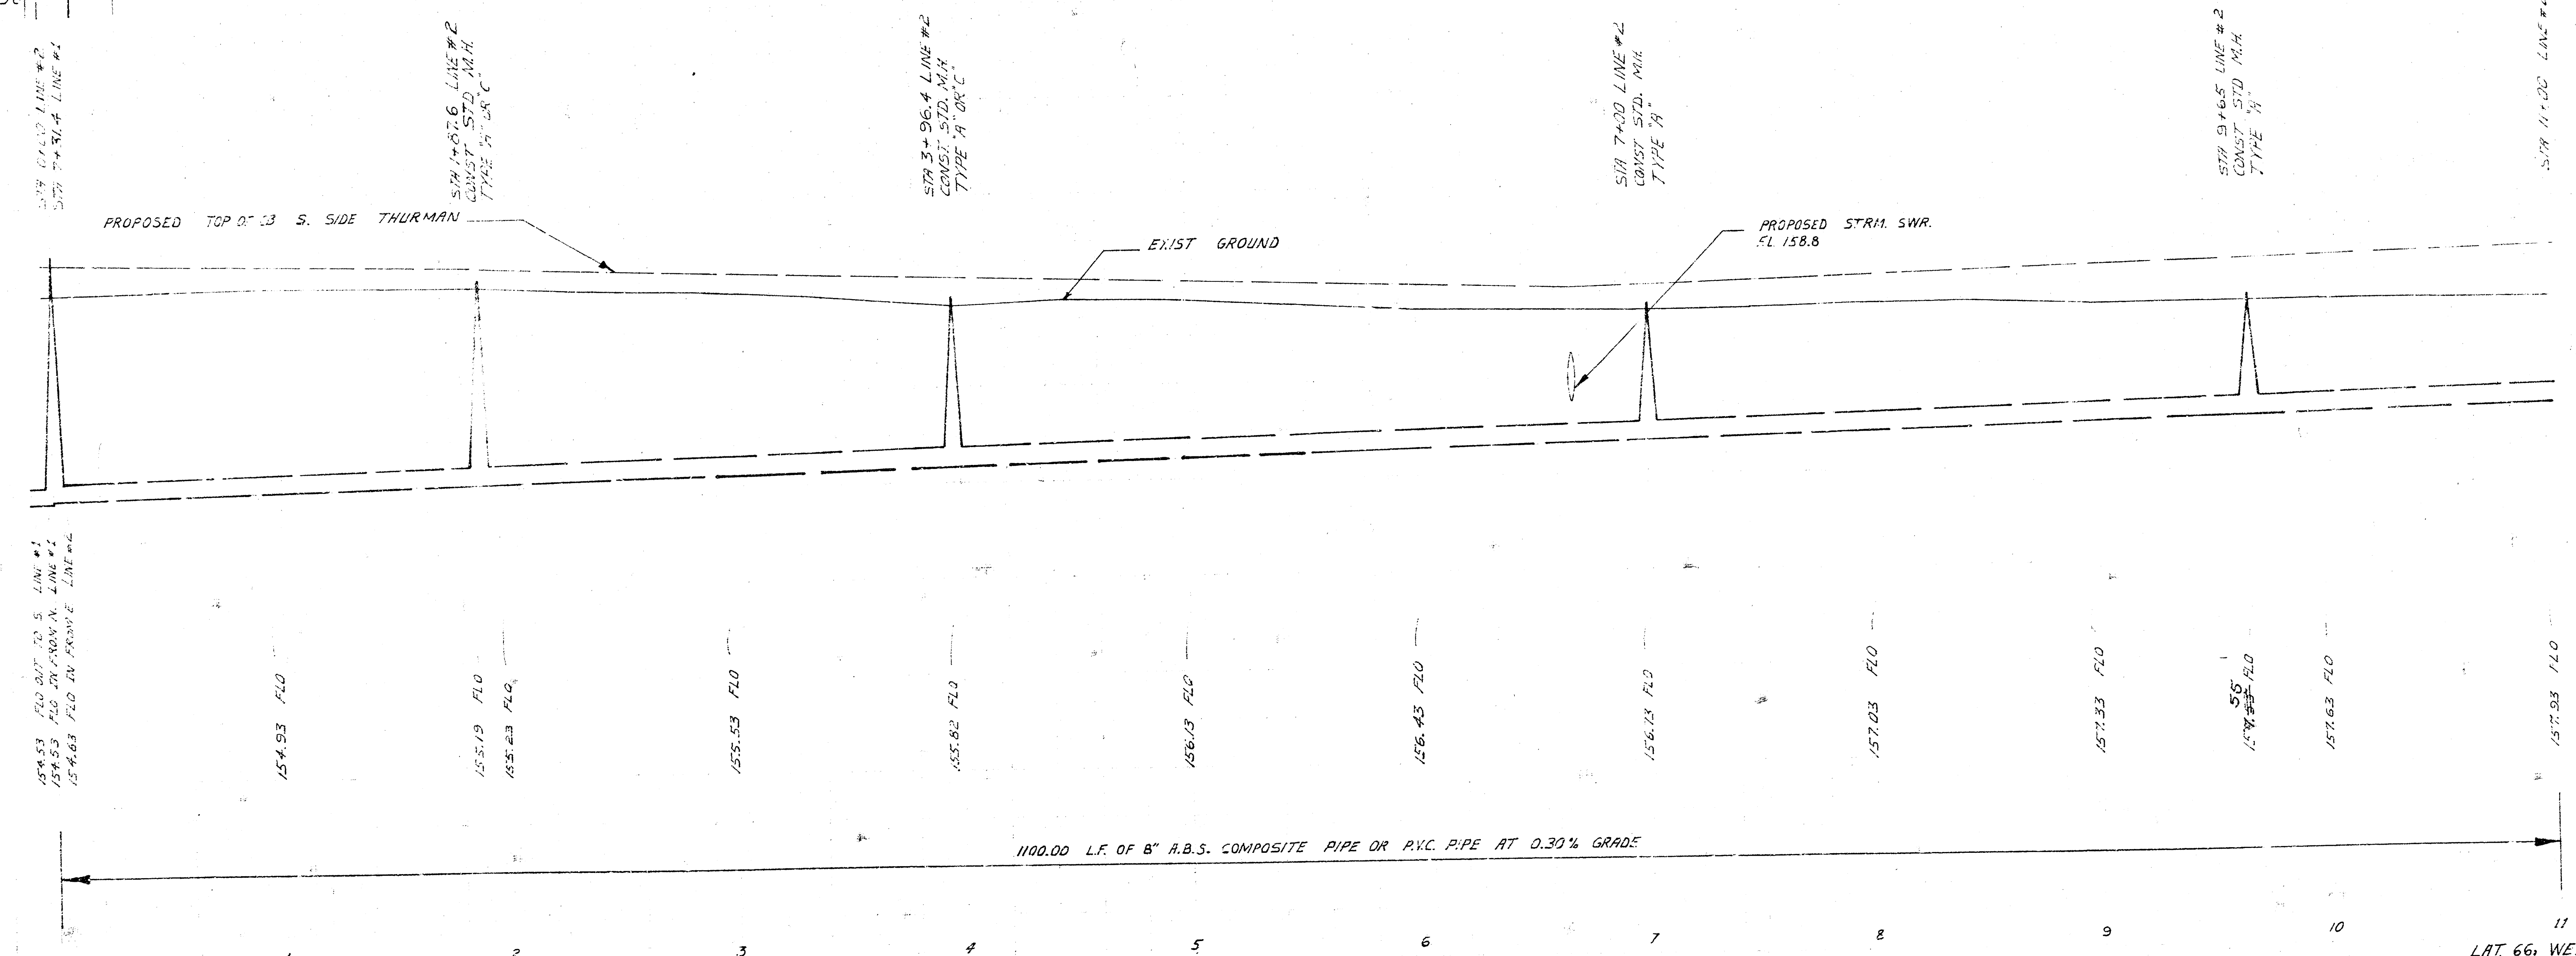

As Built
 5/8/1
 JJB

LAT. 66, WESTLINK SEWER
 PROJ. NO. 468.76.245.80991.000.000.007





FILMED FROM THE BEST
 AVAILABLE COPY

D. KESSLER
D. KESSLER
OCT 80
OCT 80

D.K.3

D. KESSLER
D. KESSLER
OCT 80
OCT 80


D.K.3

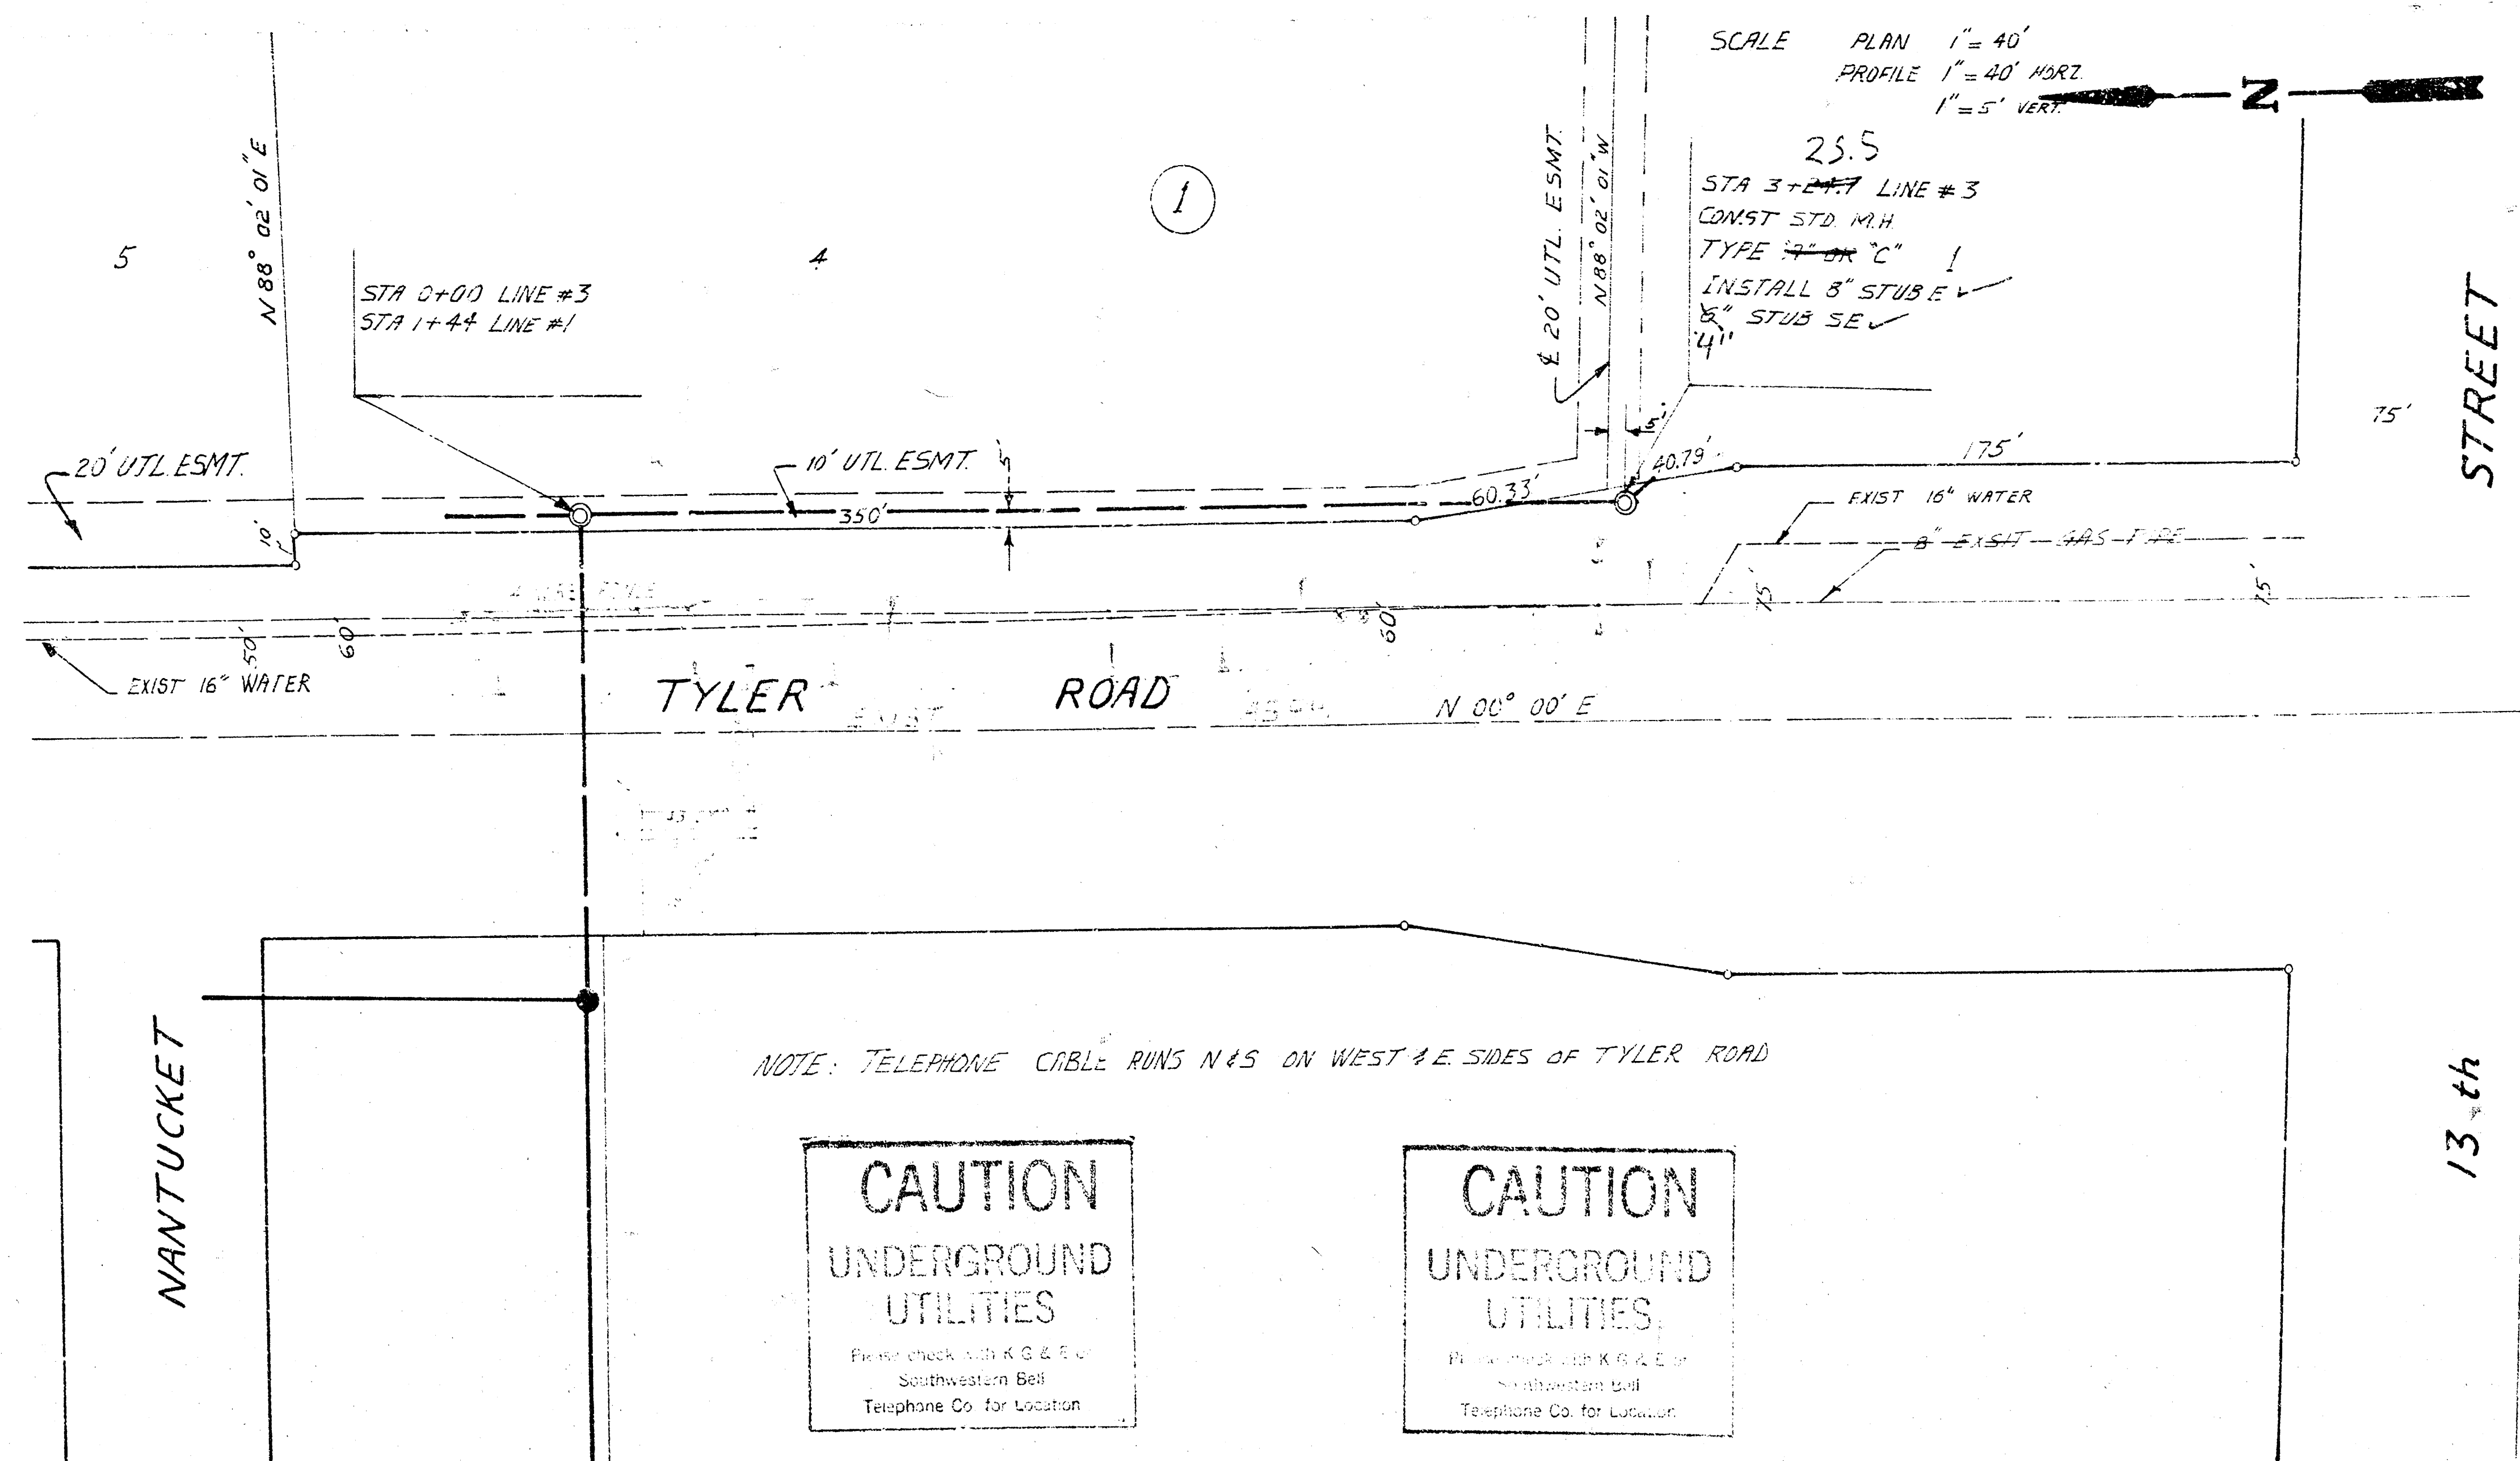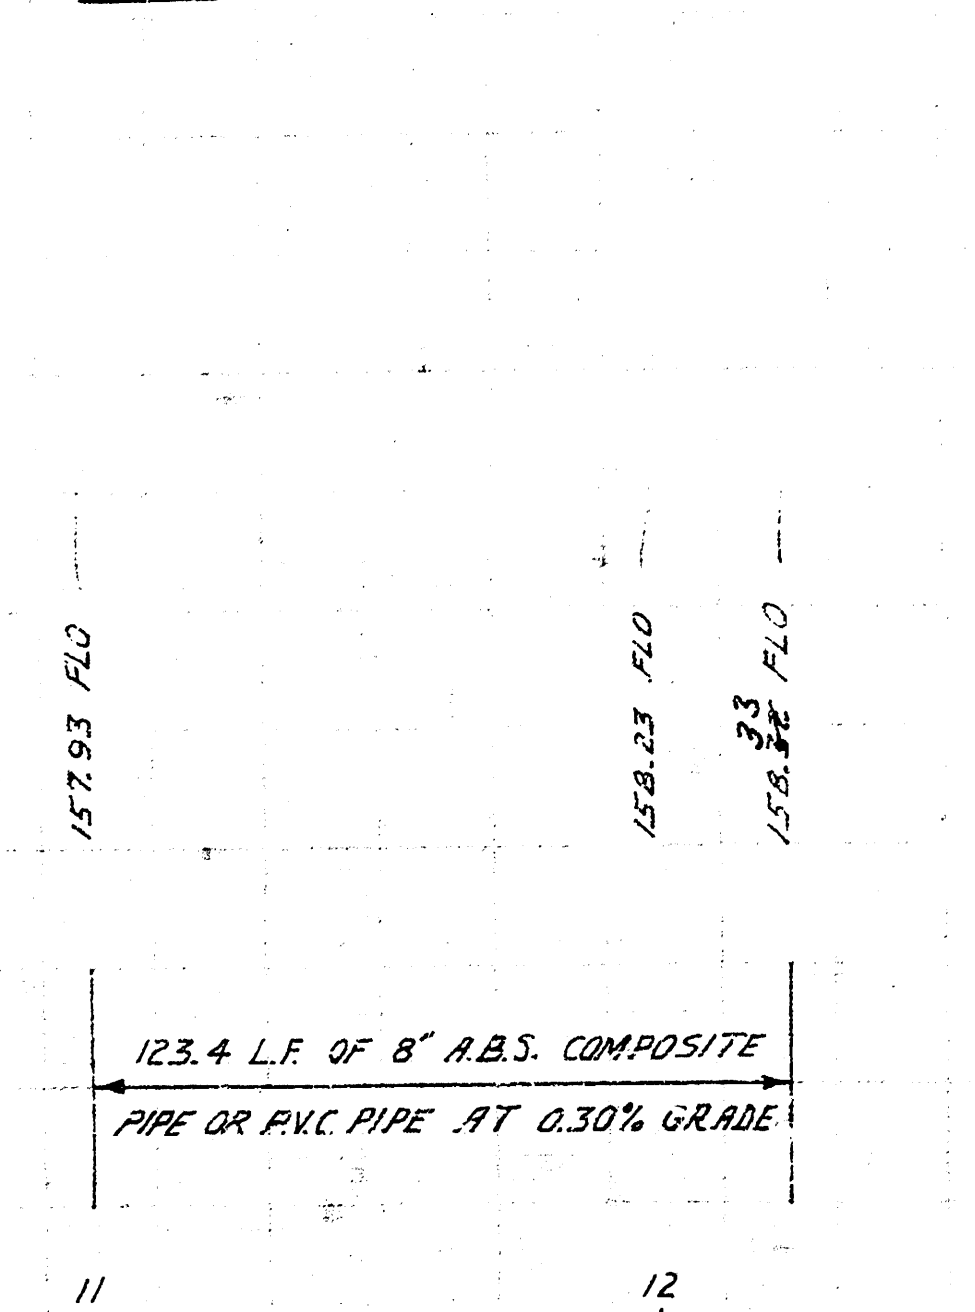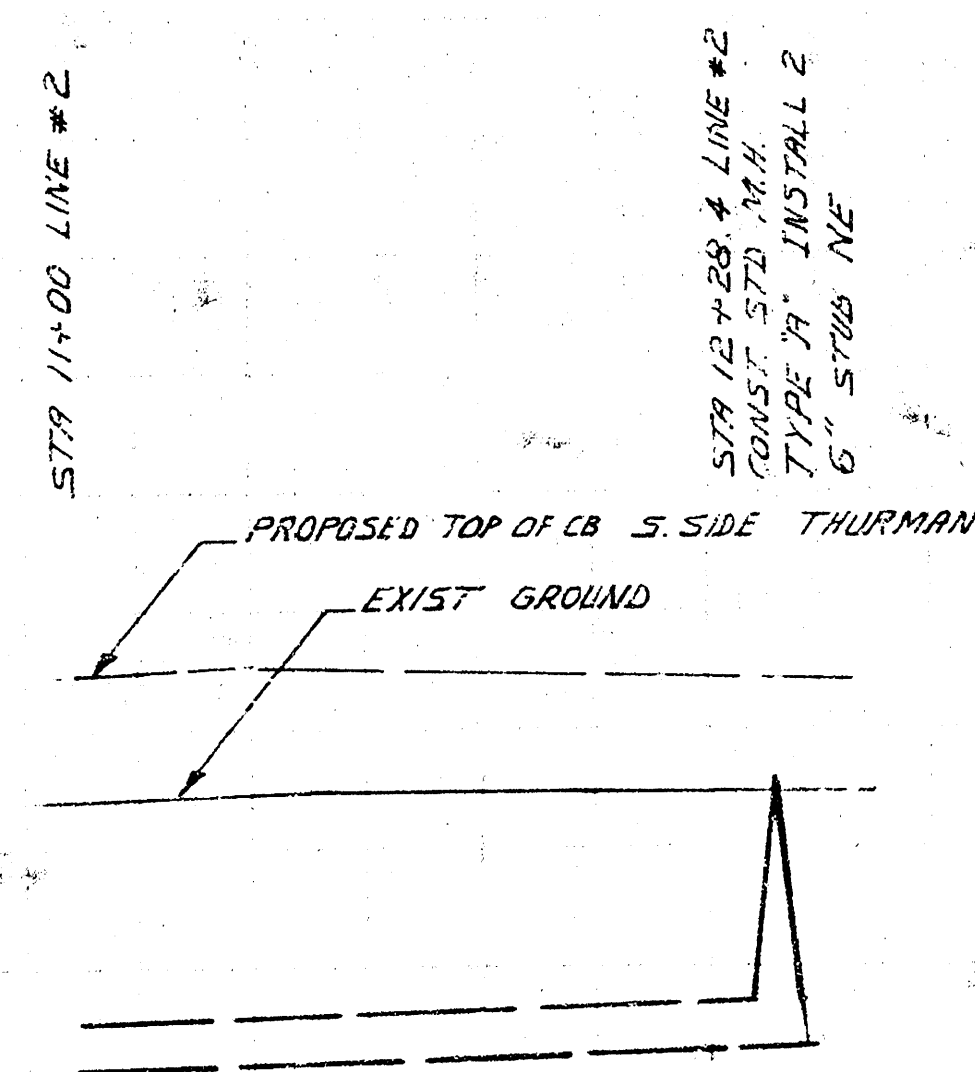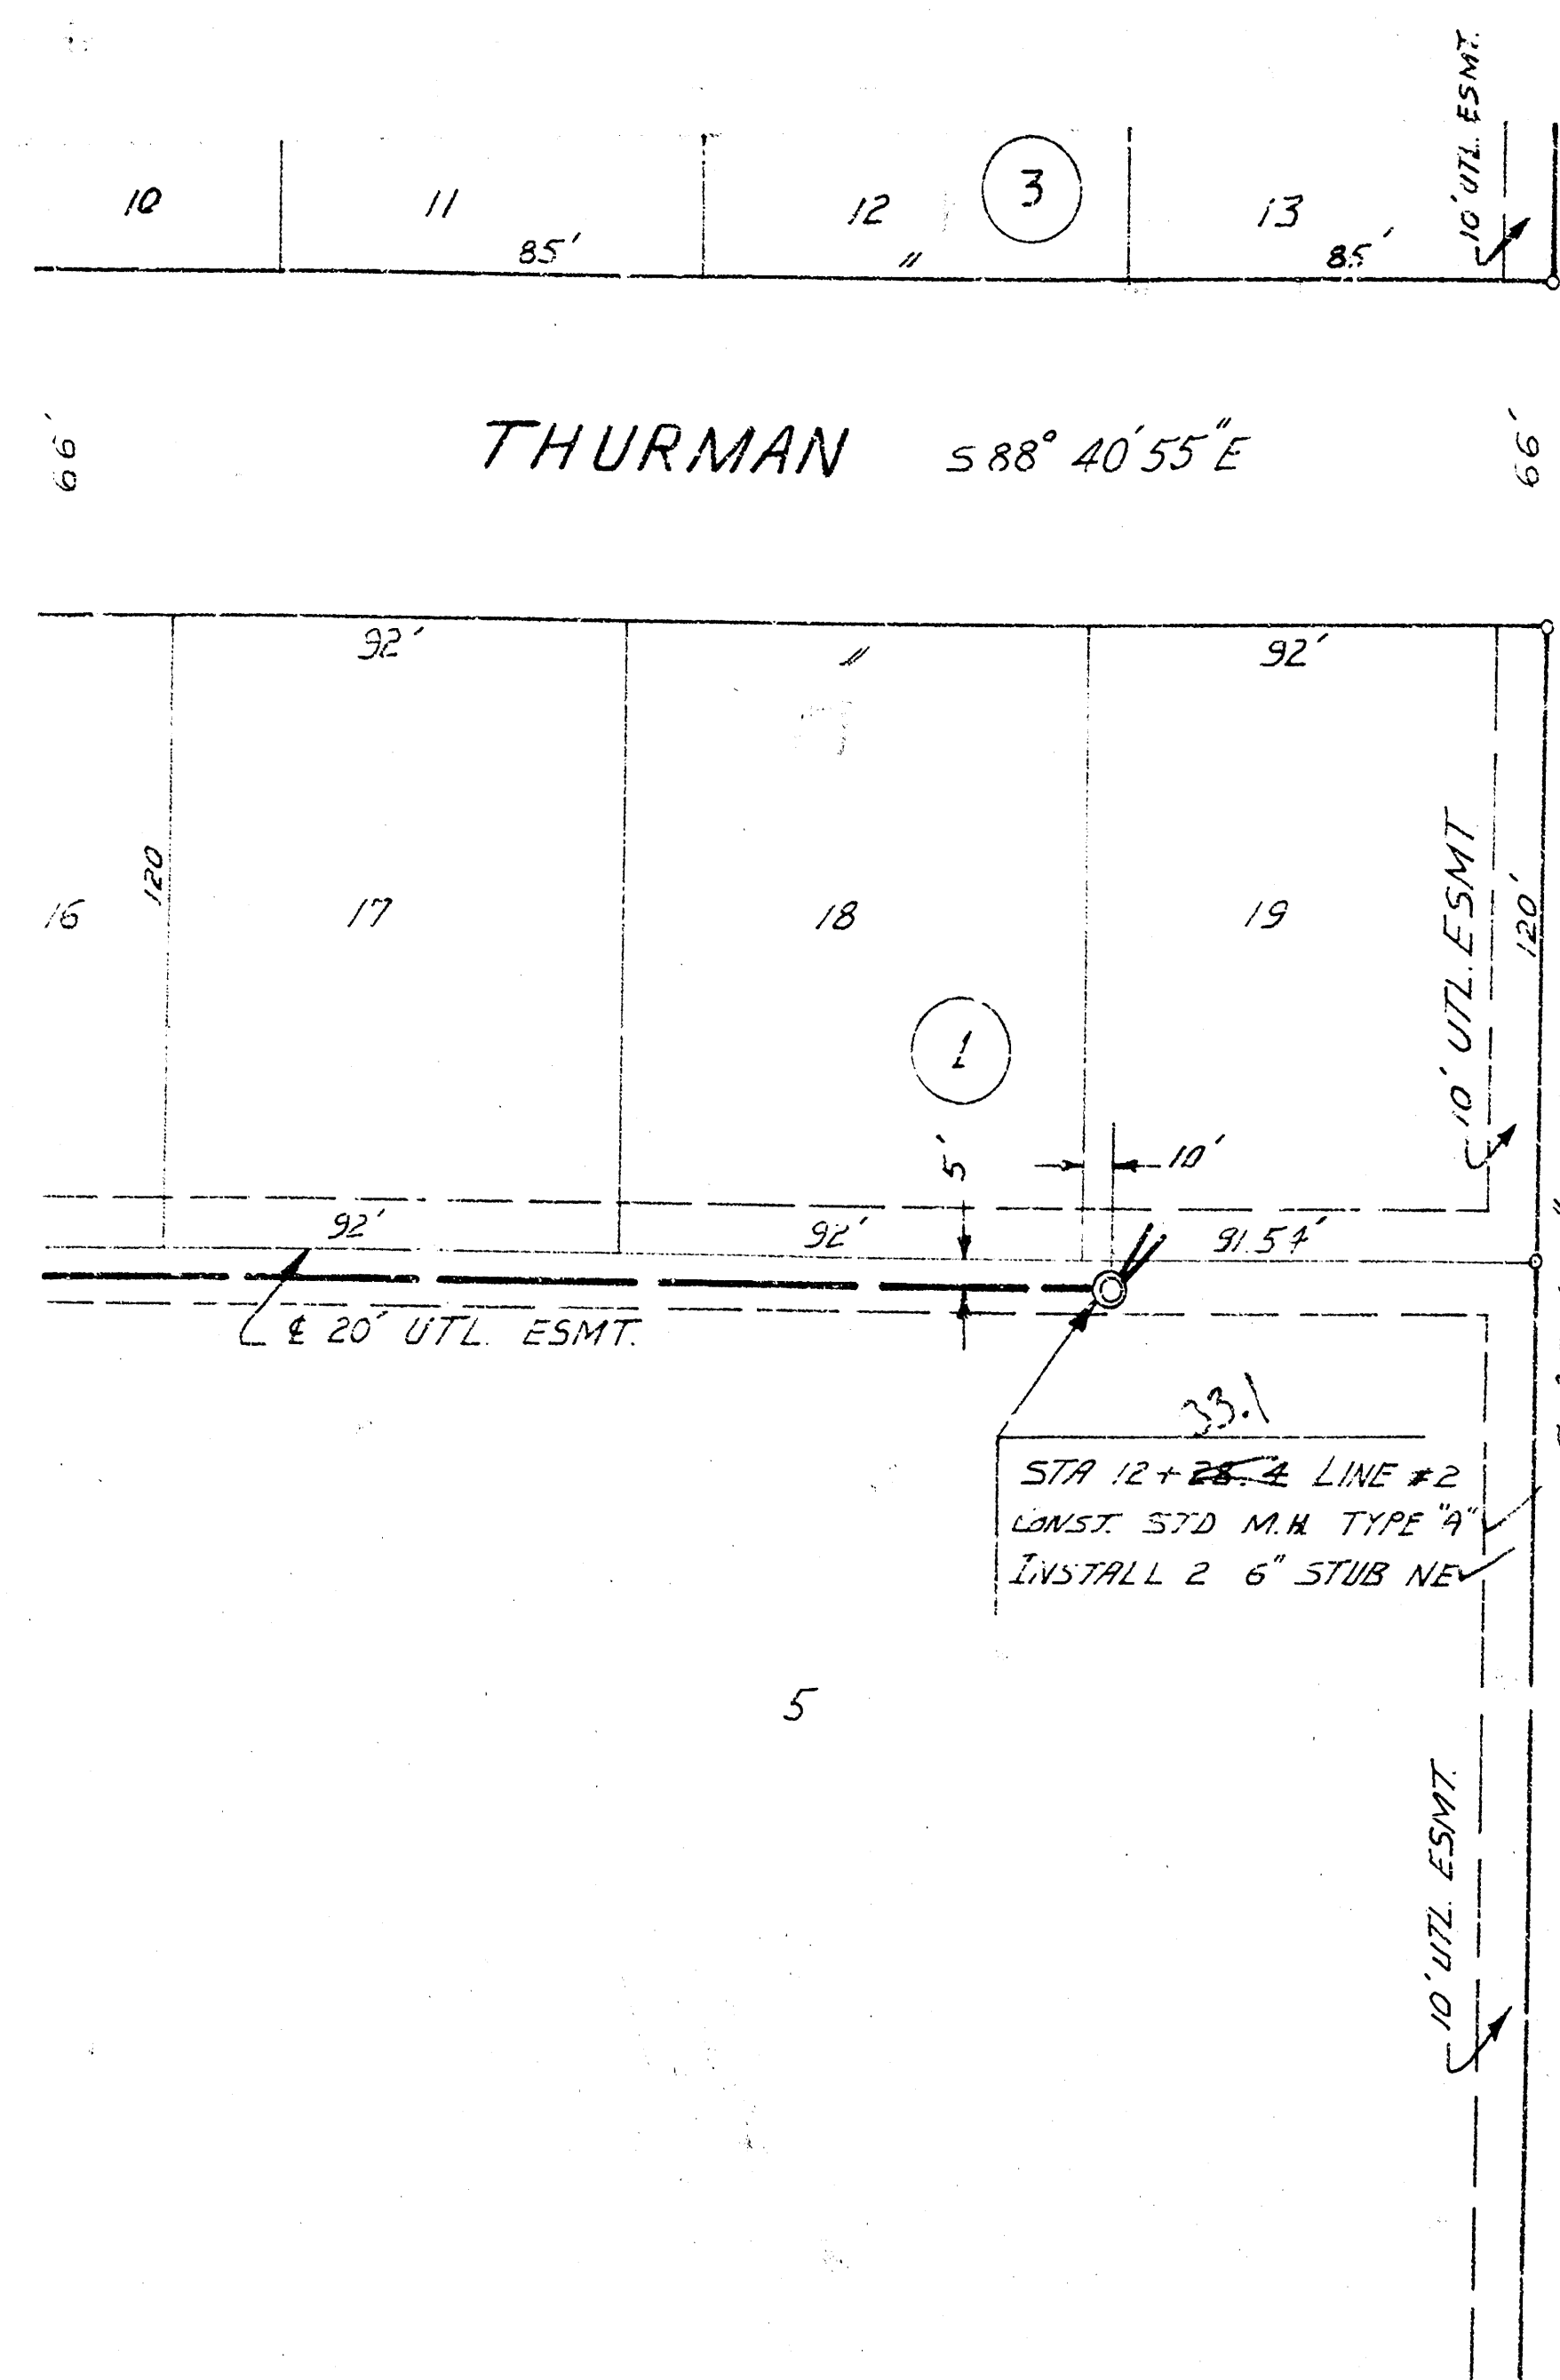

NOTE: TELEPHONE CABLE RUNS N+S ON WEST & E SIDES OF TYLER ROAD

CAUTION
UNDERGROUND
UTILITIES
Please check with 404 & 405
Southwestern Bell
Telephone Co. for location

CAUTION
UNDERGROUND
UTILITIES
Please check with 404 & 405
Southwestern Bell
Telephone Co. for location

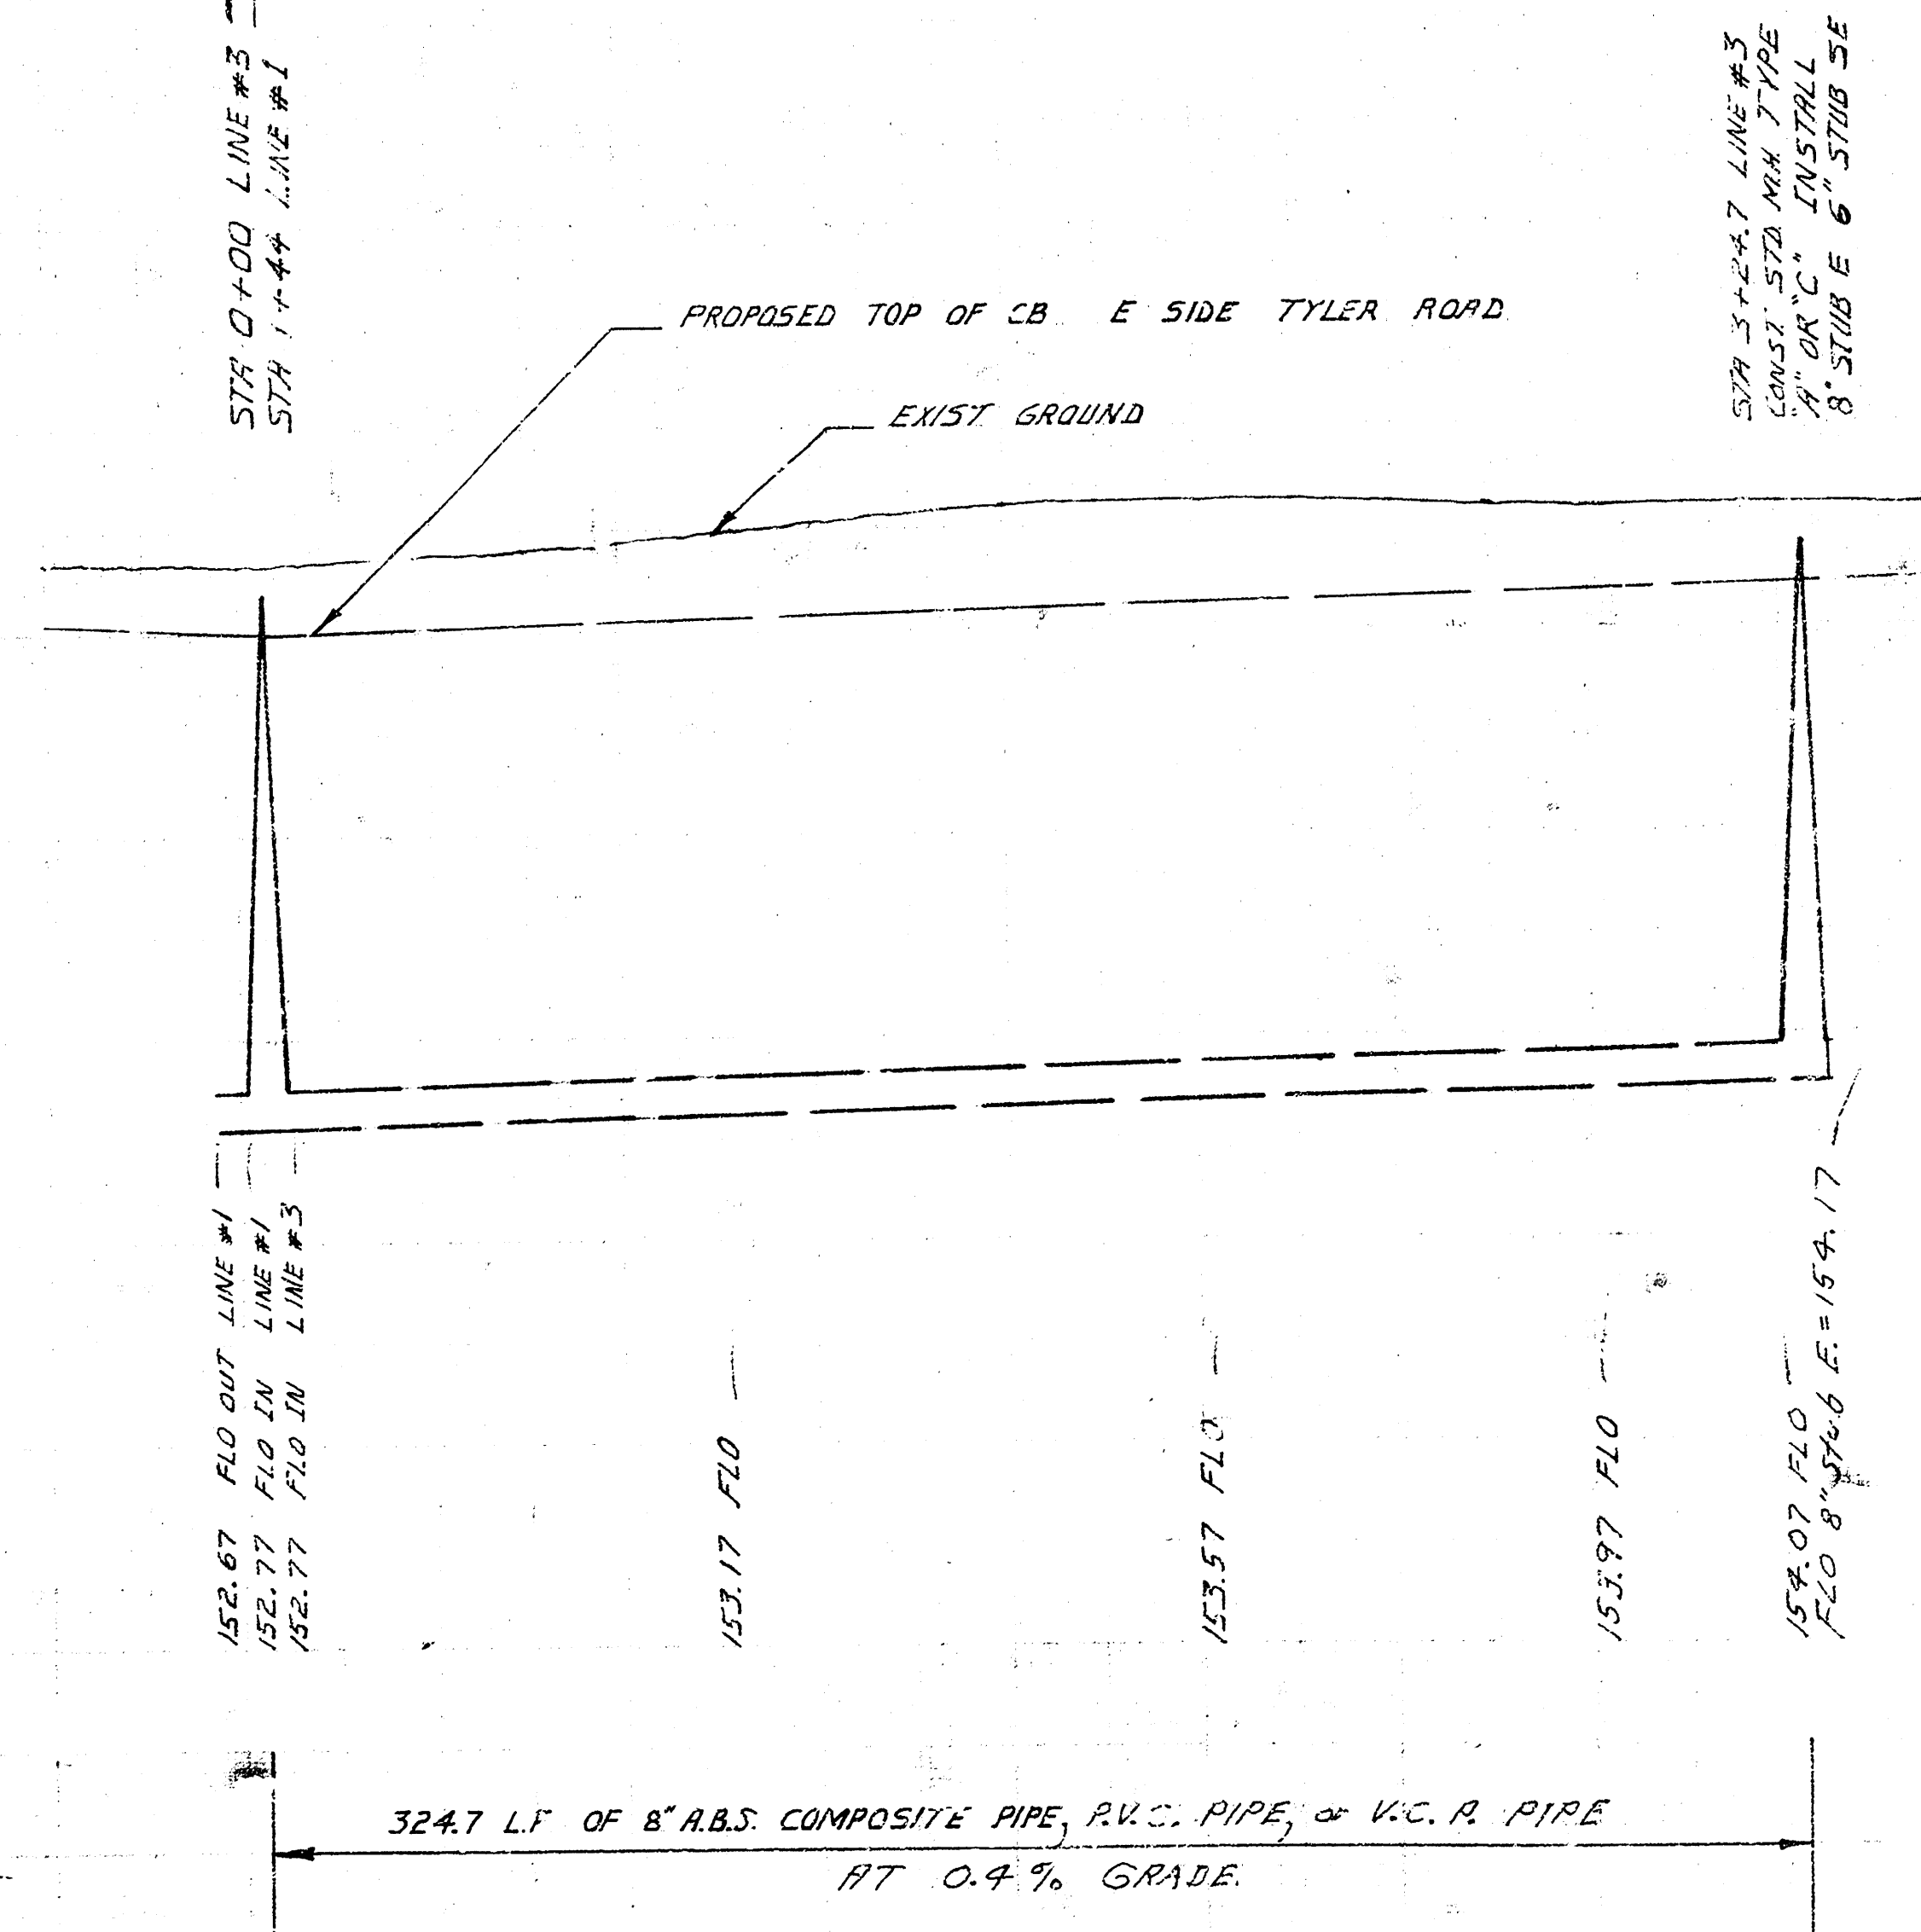

As Built
5/8/84
JGL

LAT 66, WESTLINK SEWER
PROJ NO. 468-76.245.80391.000.000.007

FILMED FROM THE BEST
AVAILABLE COPY