



PLAN
 LANE
 WOODCHUCK
 REDBARN
 SCHOOL ST.

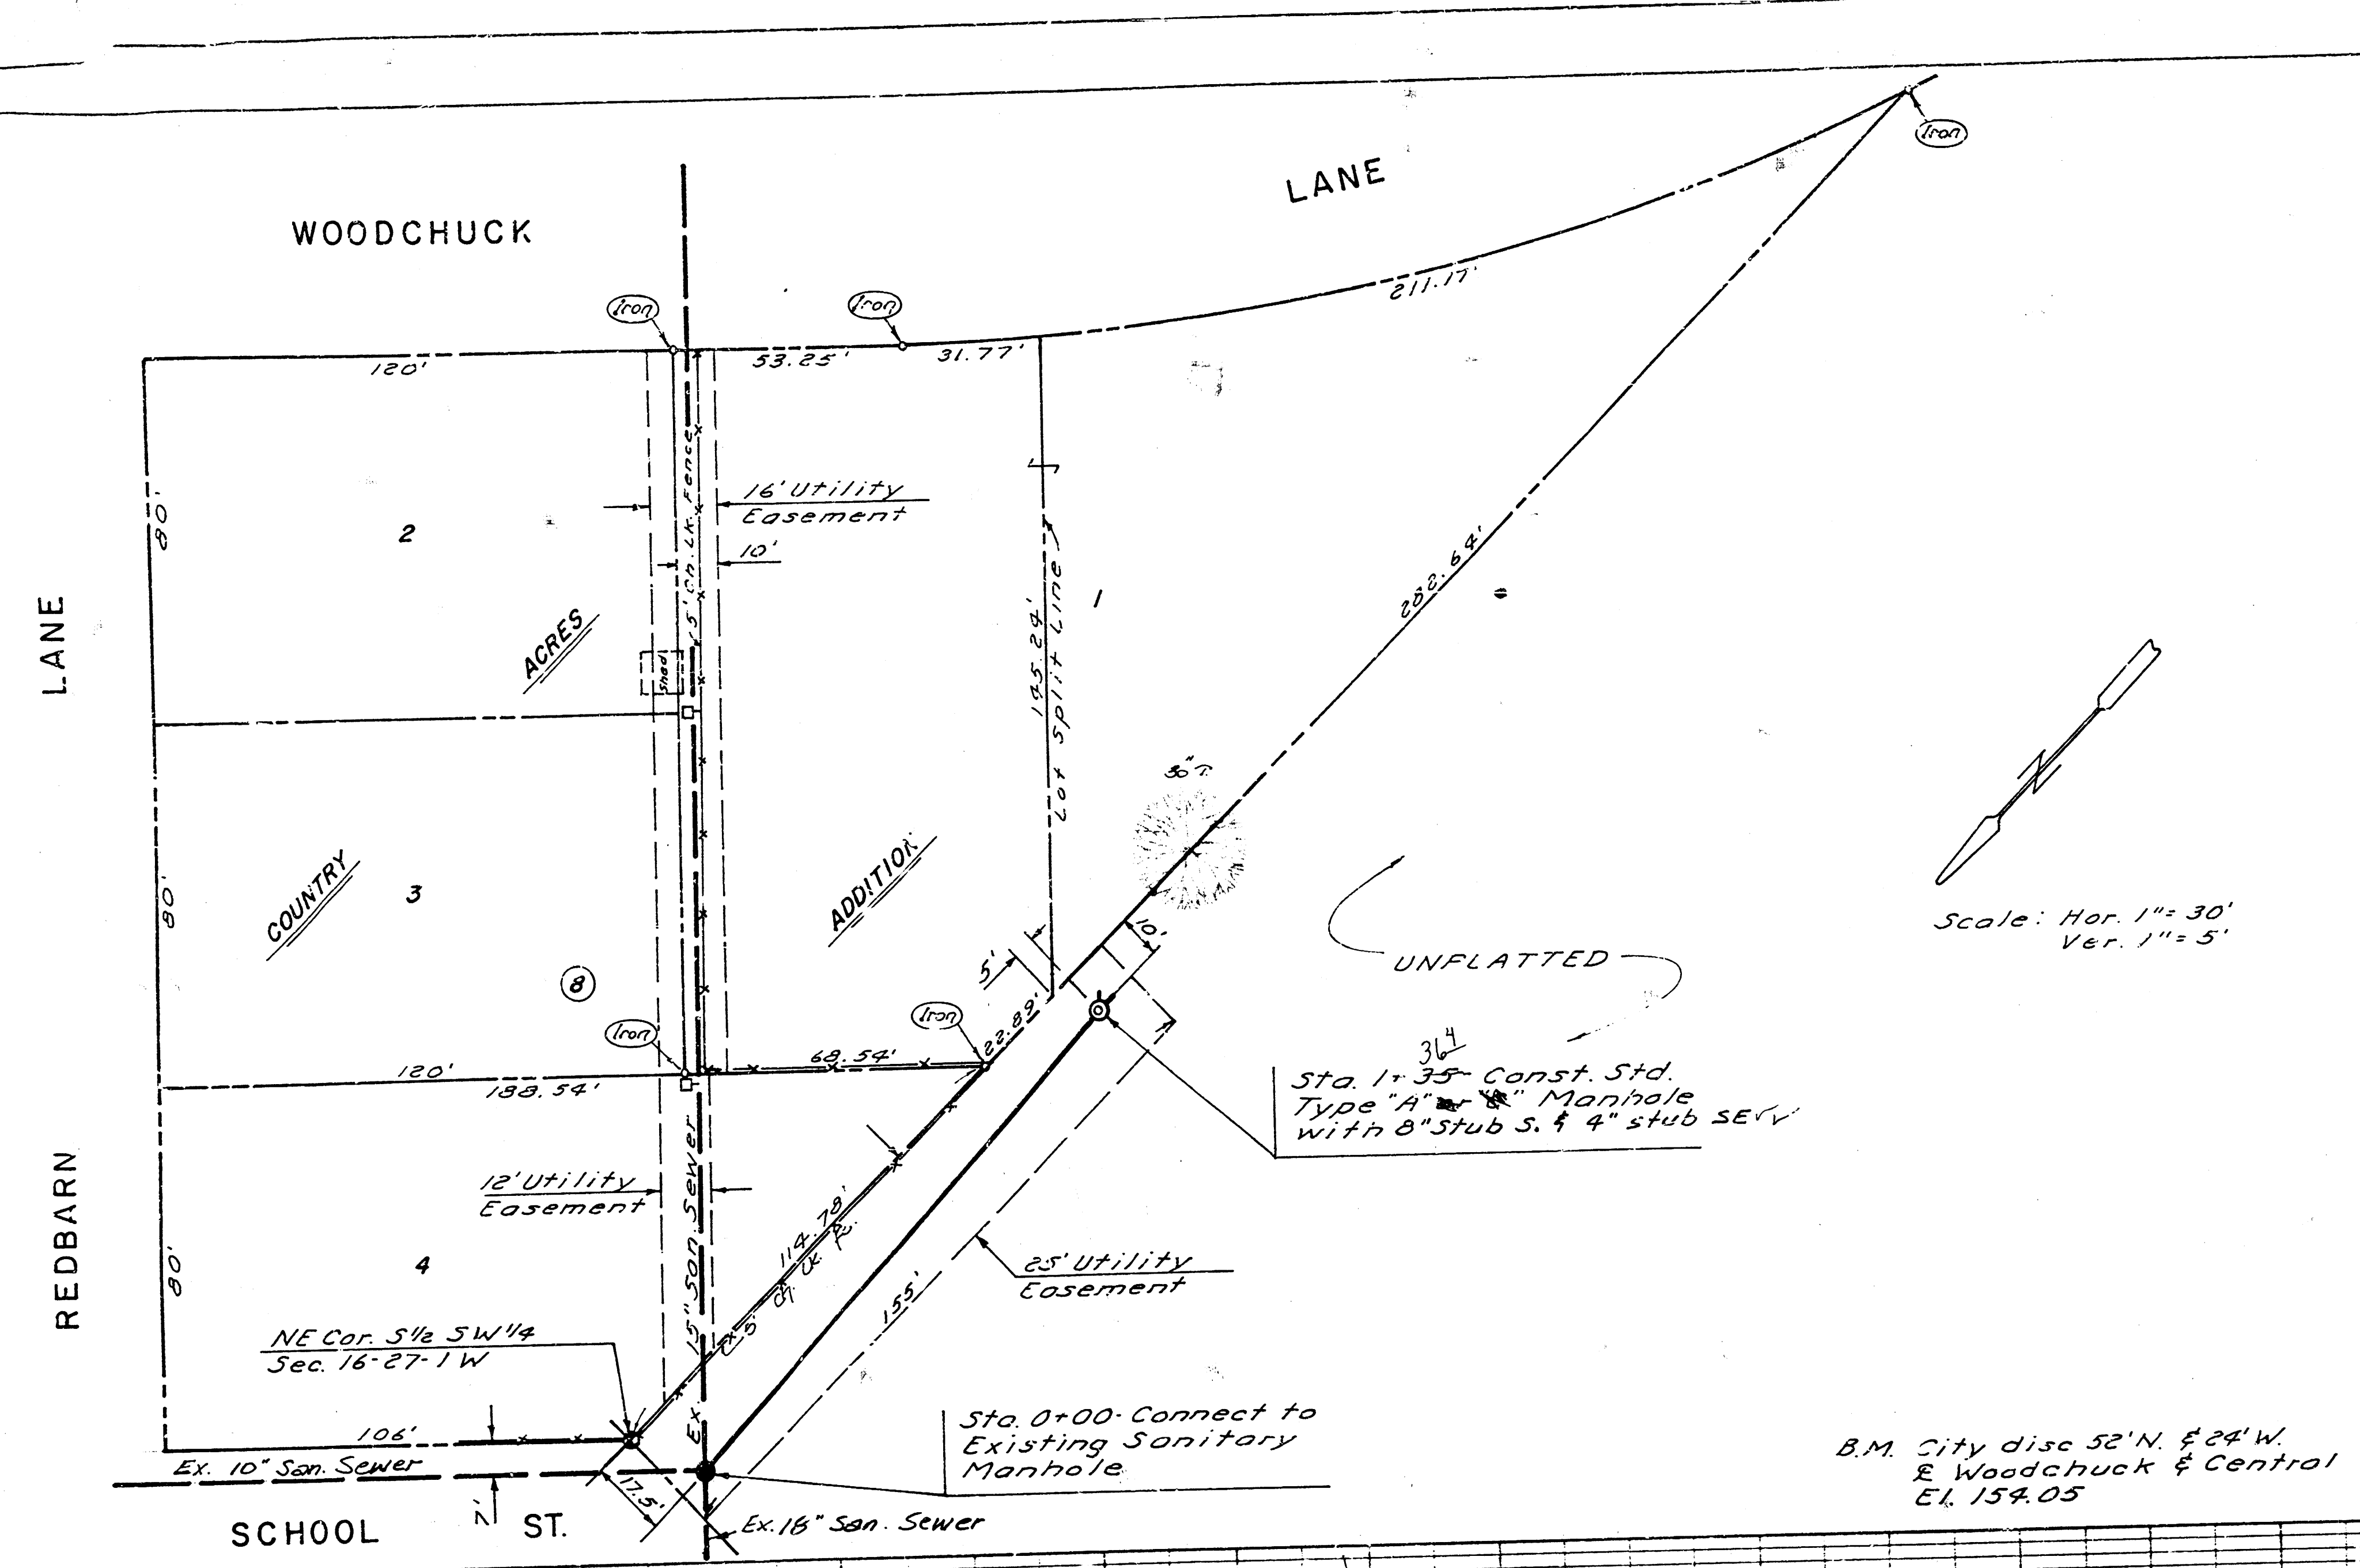



As BUILT
 J.L.L.
 12-82

Site Location

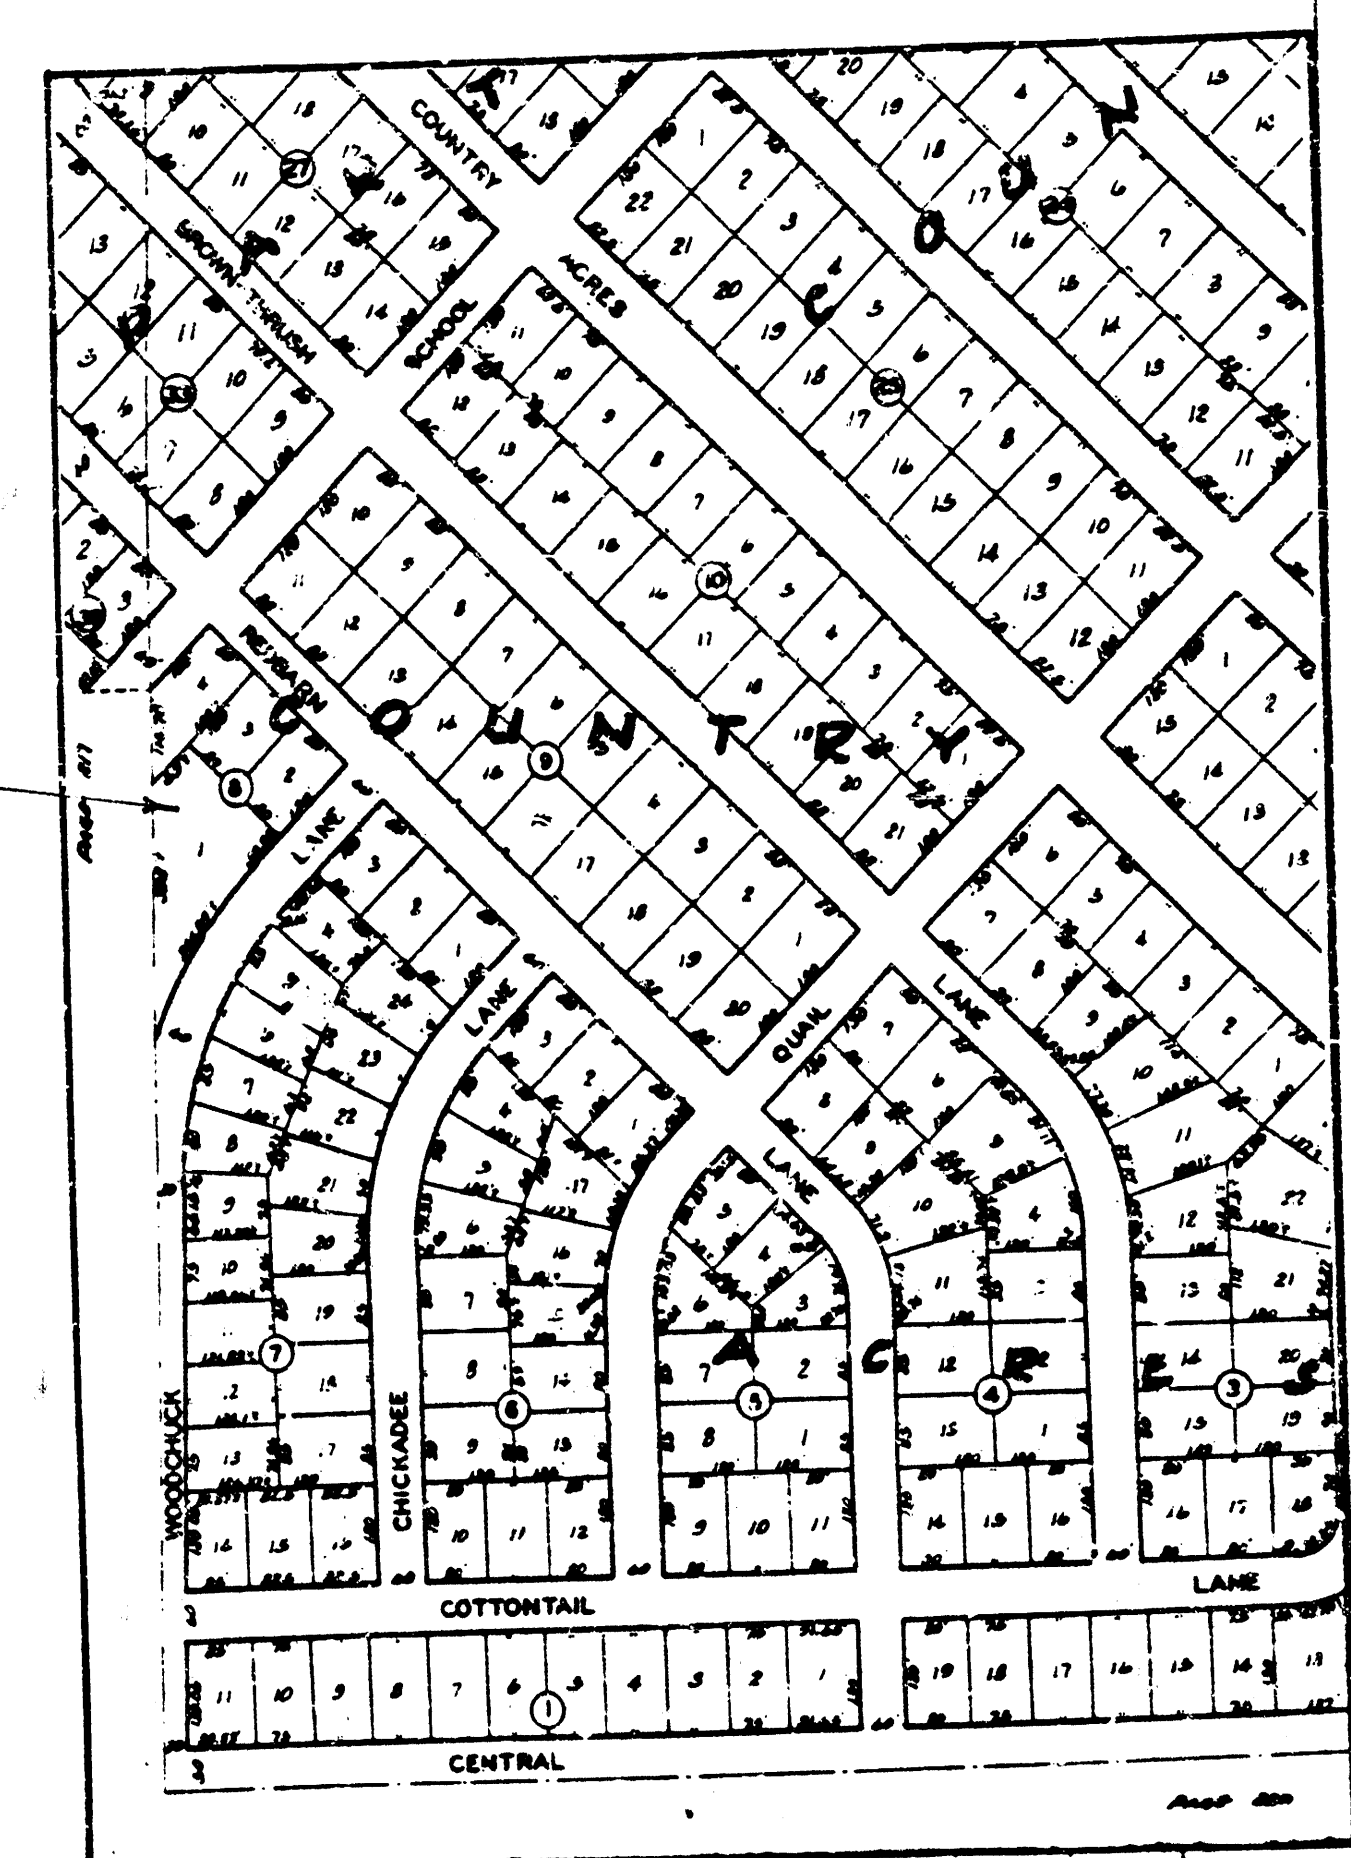

B.M. City disc 52' N. & 24' W.
 E Woodchuck & Central
 EL. 159.05

PROFILE
 LANE
 WOODCHUCK
 REDBARN
 SCHOOL ST.

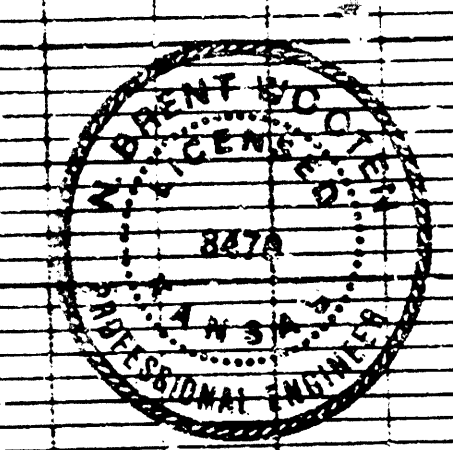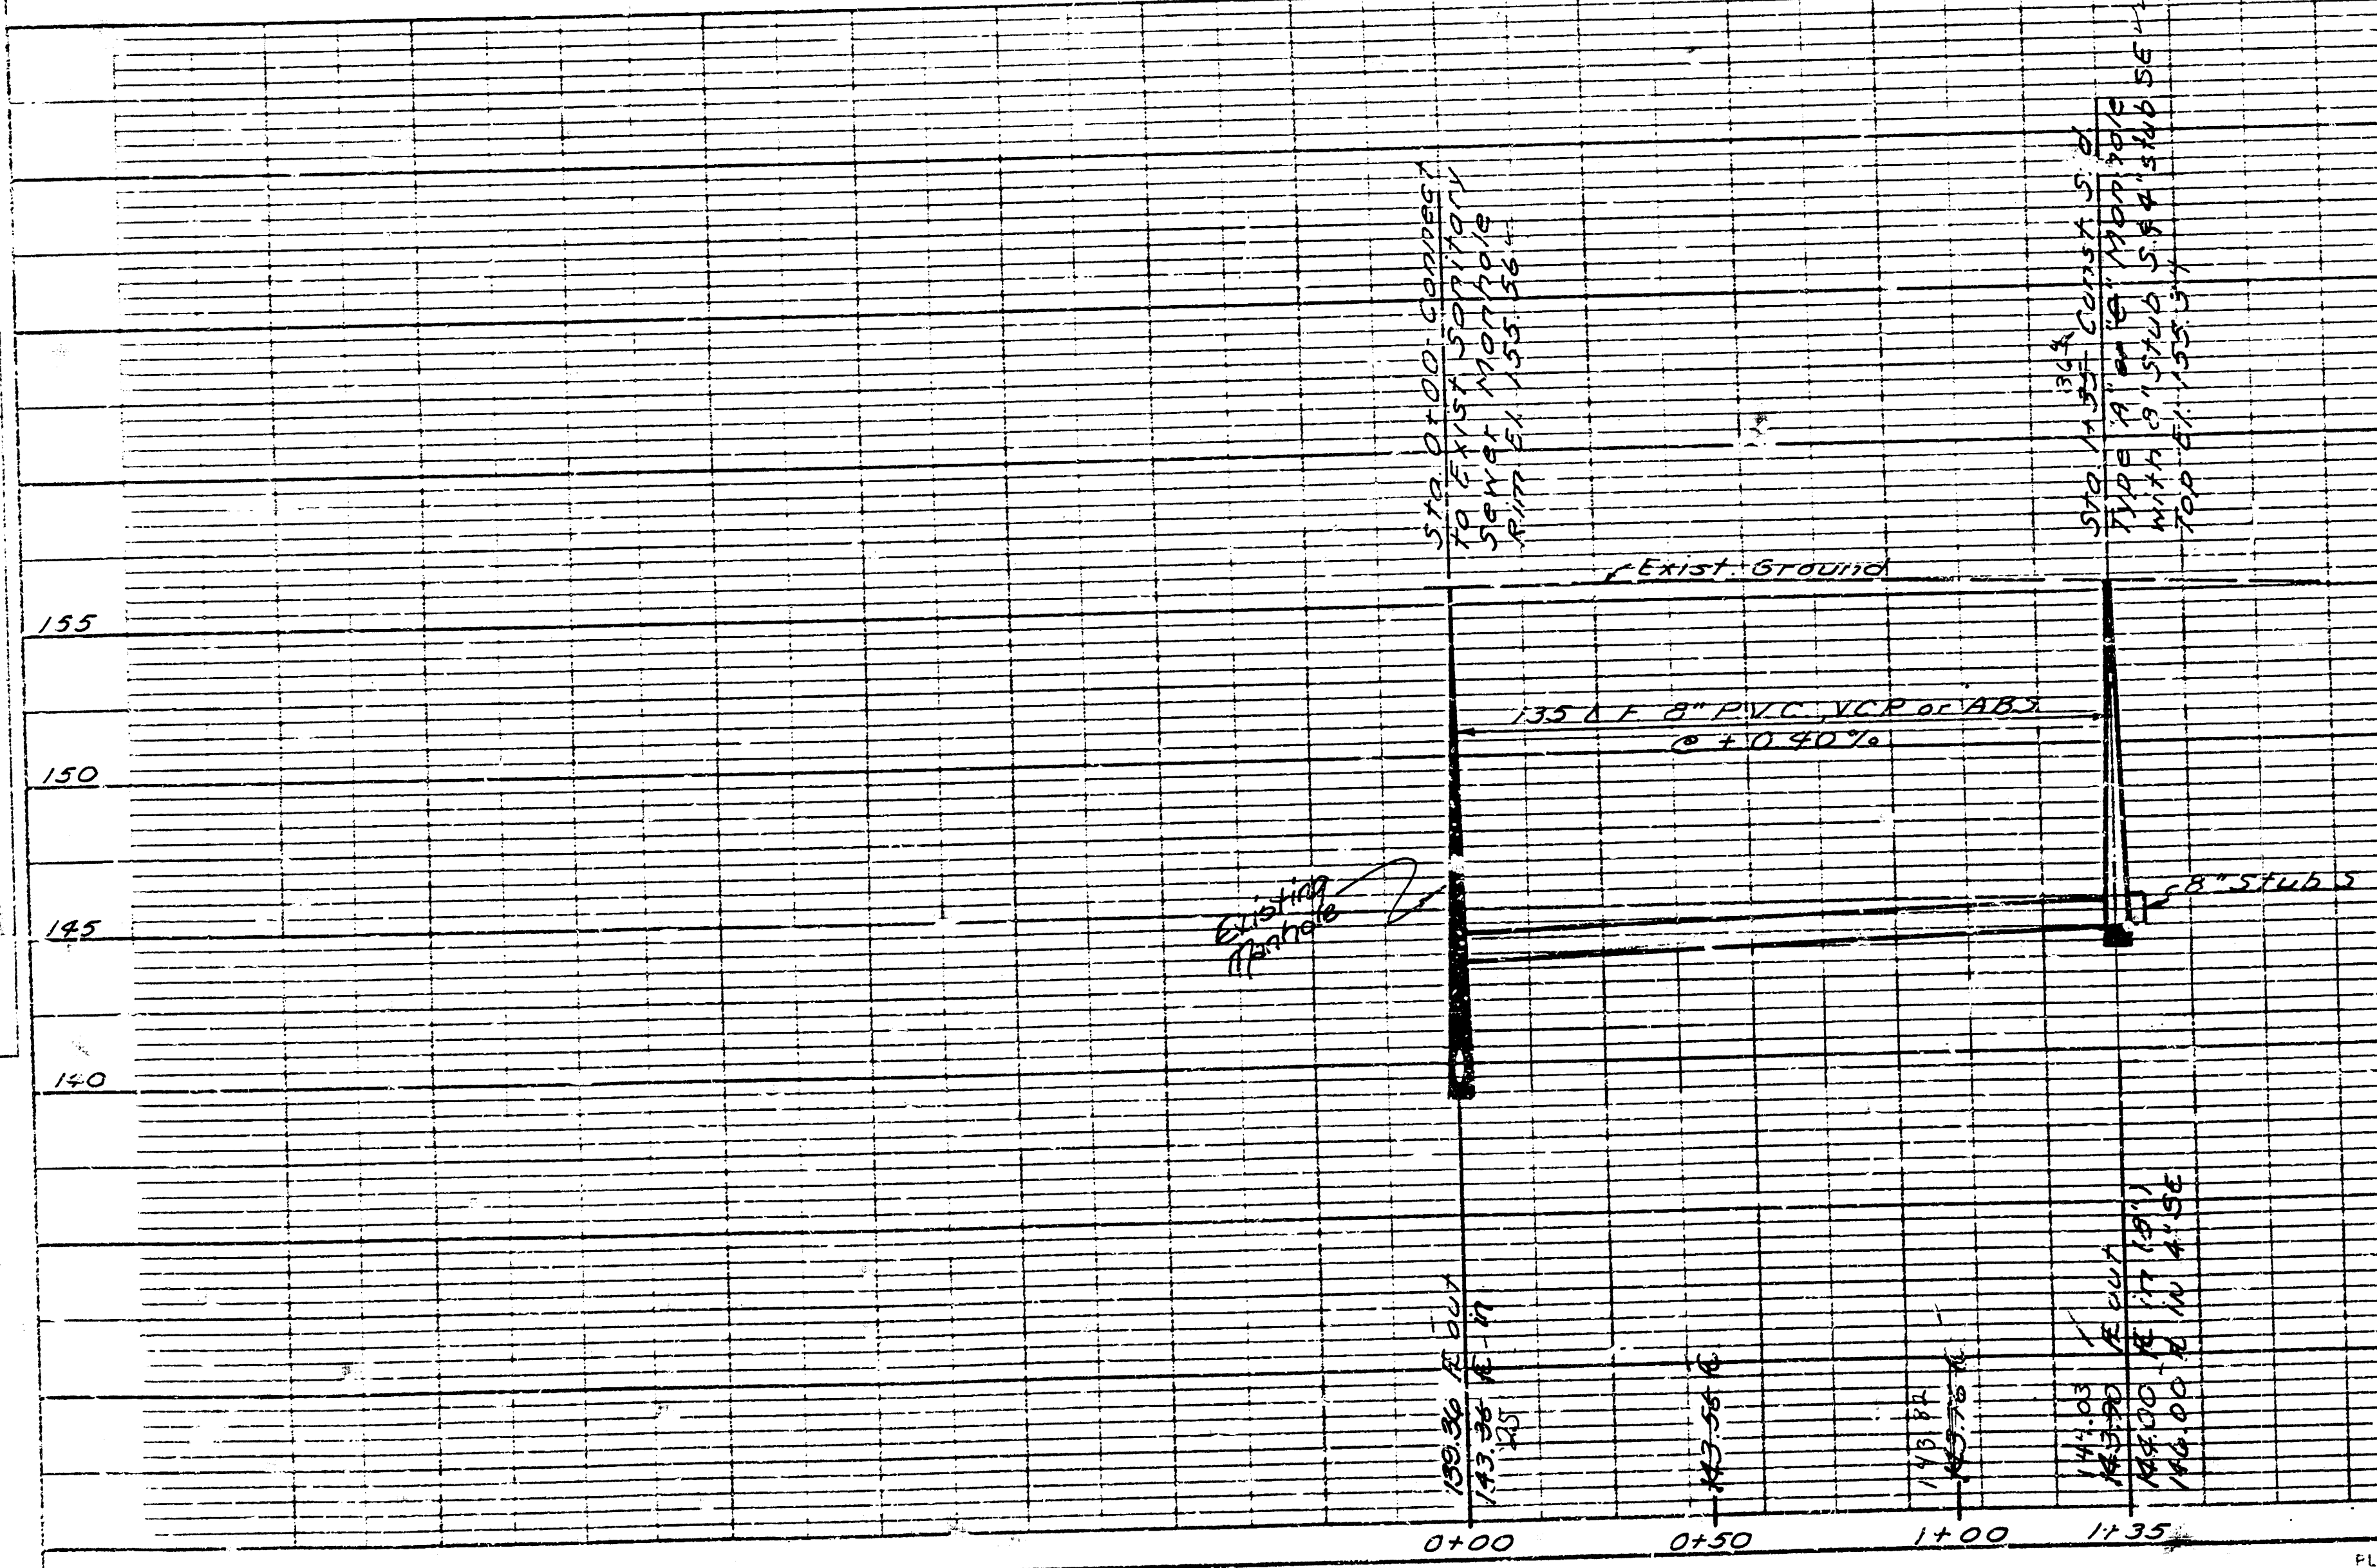

Revised 12-82

LATERAL 71, WESTLINK SANITARY SEWER
 TO SERVE LOT 1, BLK. 8, COUNTRY ACRES ADDN.
 PROJECT NO.
 468-76-245-81231-000-000-001
CITY OF WICHITA, KS
 R. W. BRUGGEMAN — DIR. ENGINEERING