




Scale: Hor. 1" = 40'  
Ver. 1" = 5'



As Built  
J.L.L.  
9-84

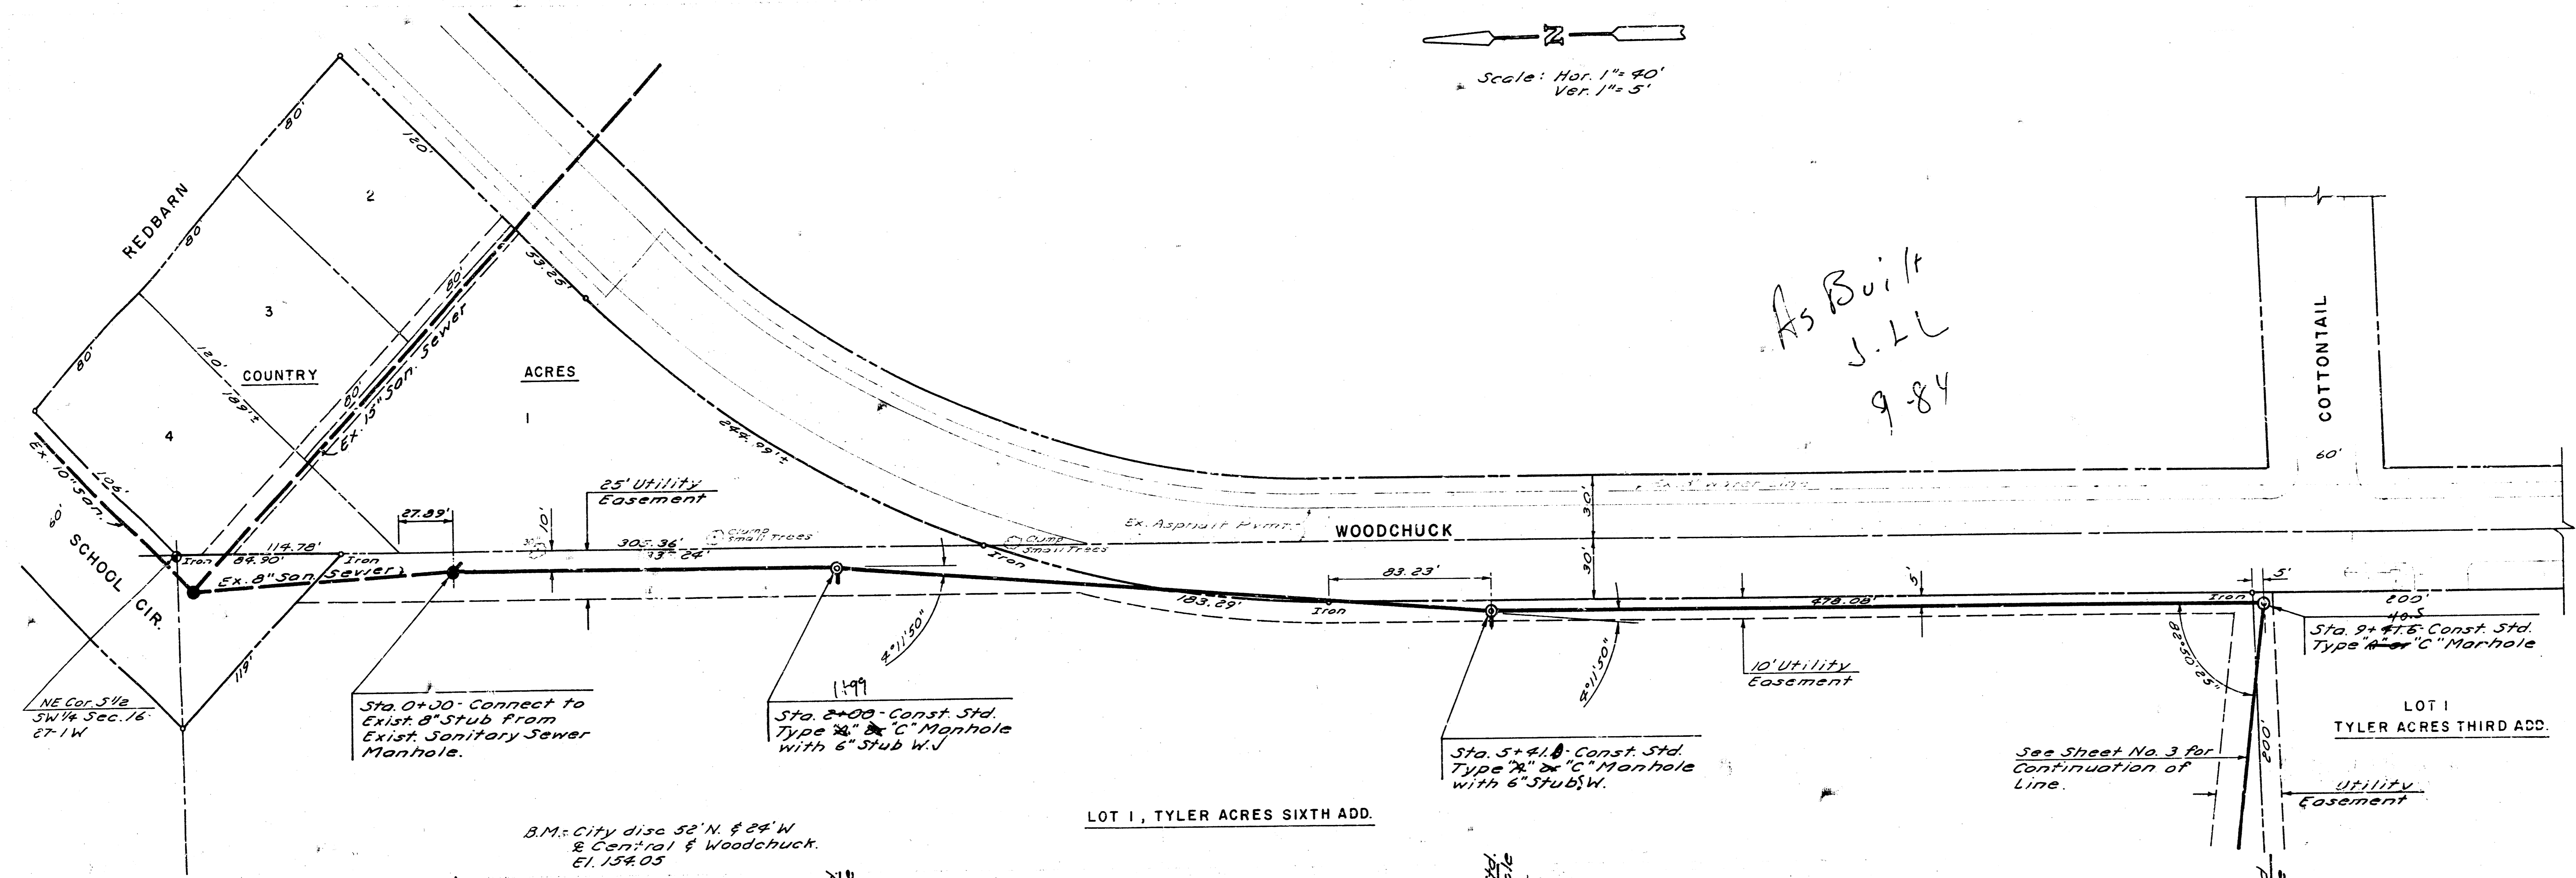


B.M. City disc 52' N. & 24' W  
& Central & Woodchuck.  
Elev. 152.05

LOT 1, TYLER ACRES SIXTH ADD.

See Sheet No. 3 for  
Continuation of  
Line.

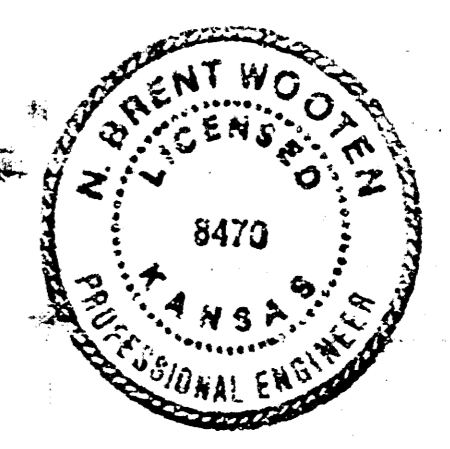
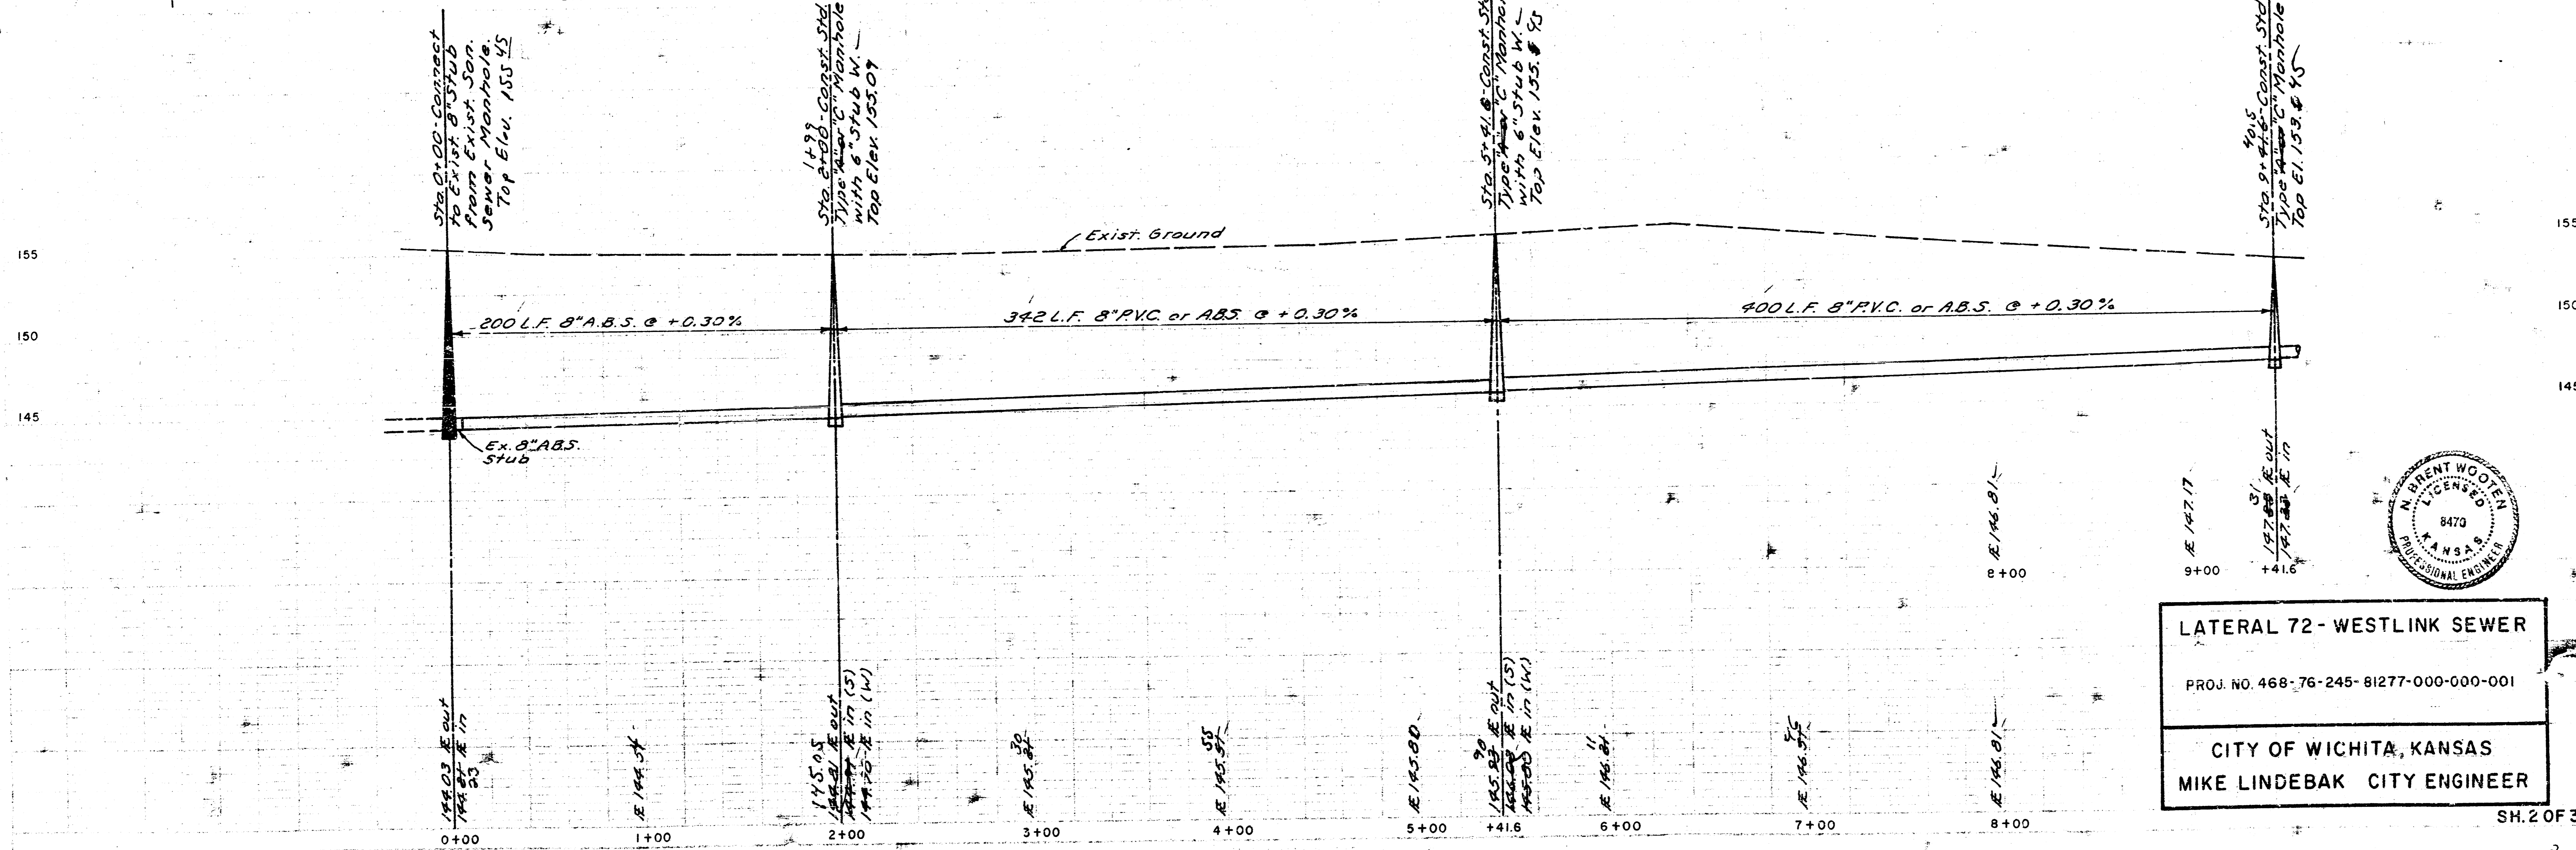


LATERAL 72 - WESTLINK SEWER  
 PROJ. NO. 468-76-245-81277-000-000-001  
 CITY OF WICHITA, KANSAS  
 MIKE LINDEBAK CITY ENGINEER

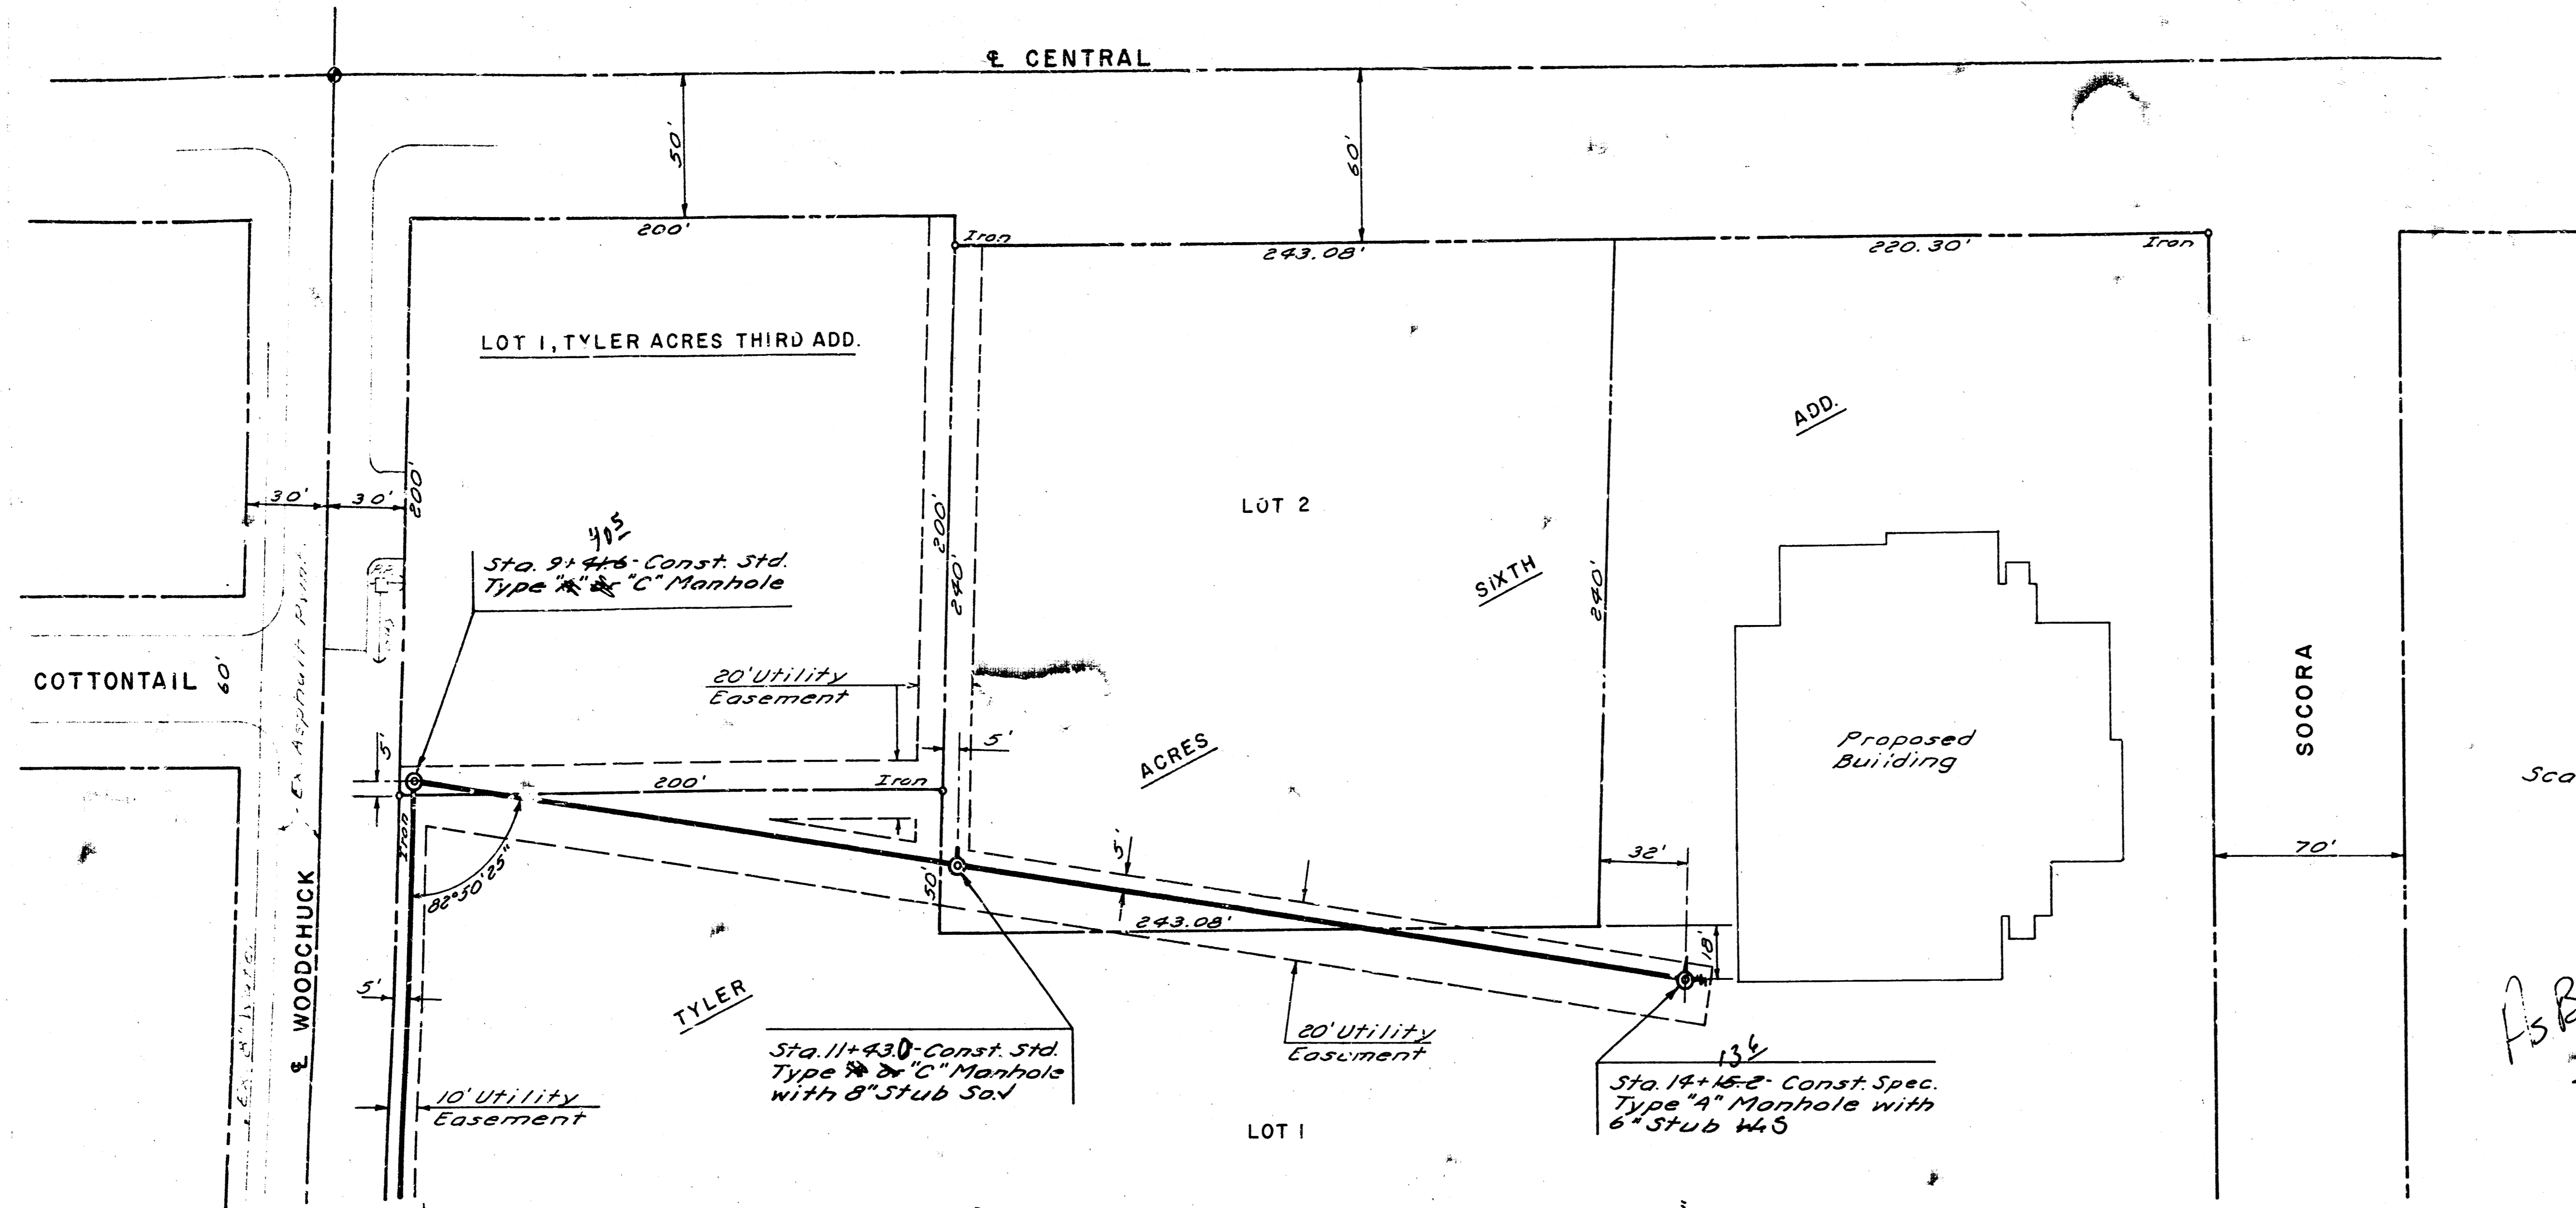

Scale: Hor. 1"=40'  
Ver. 1"=5'

As Built  
J.L.L.  
9-84

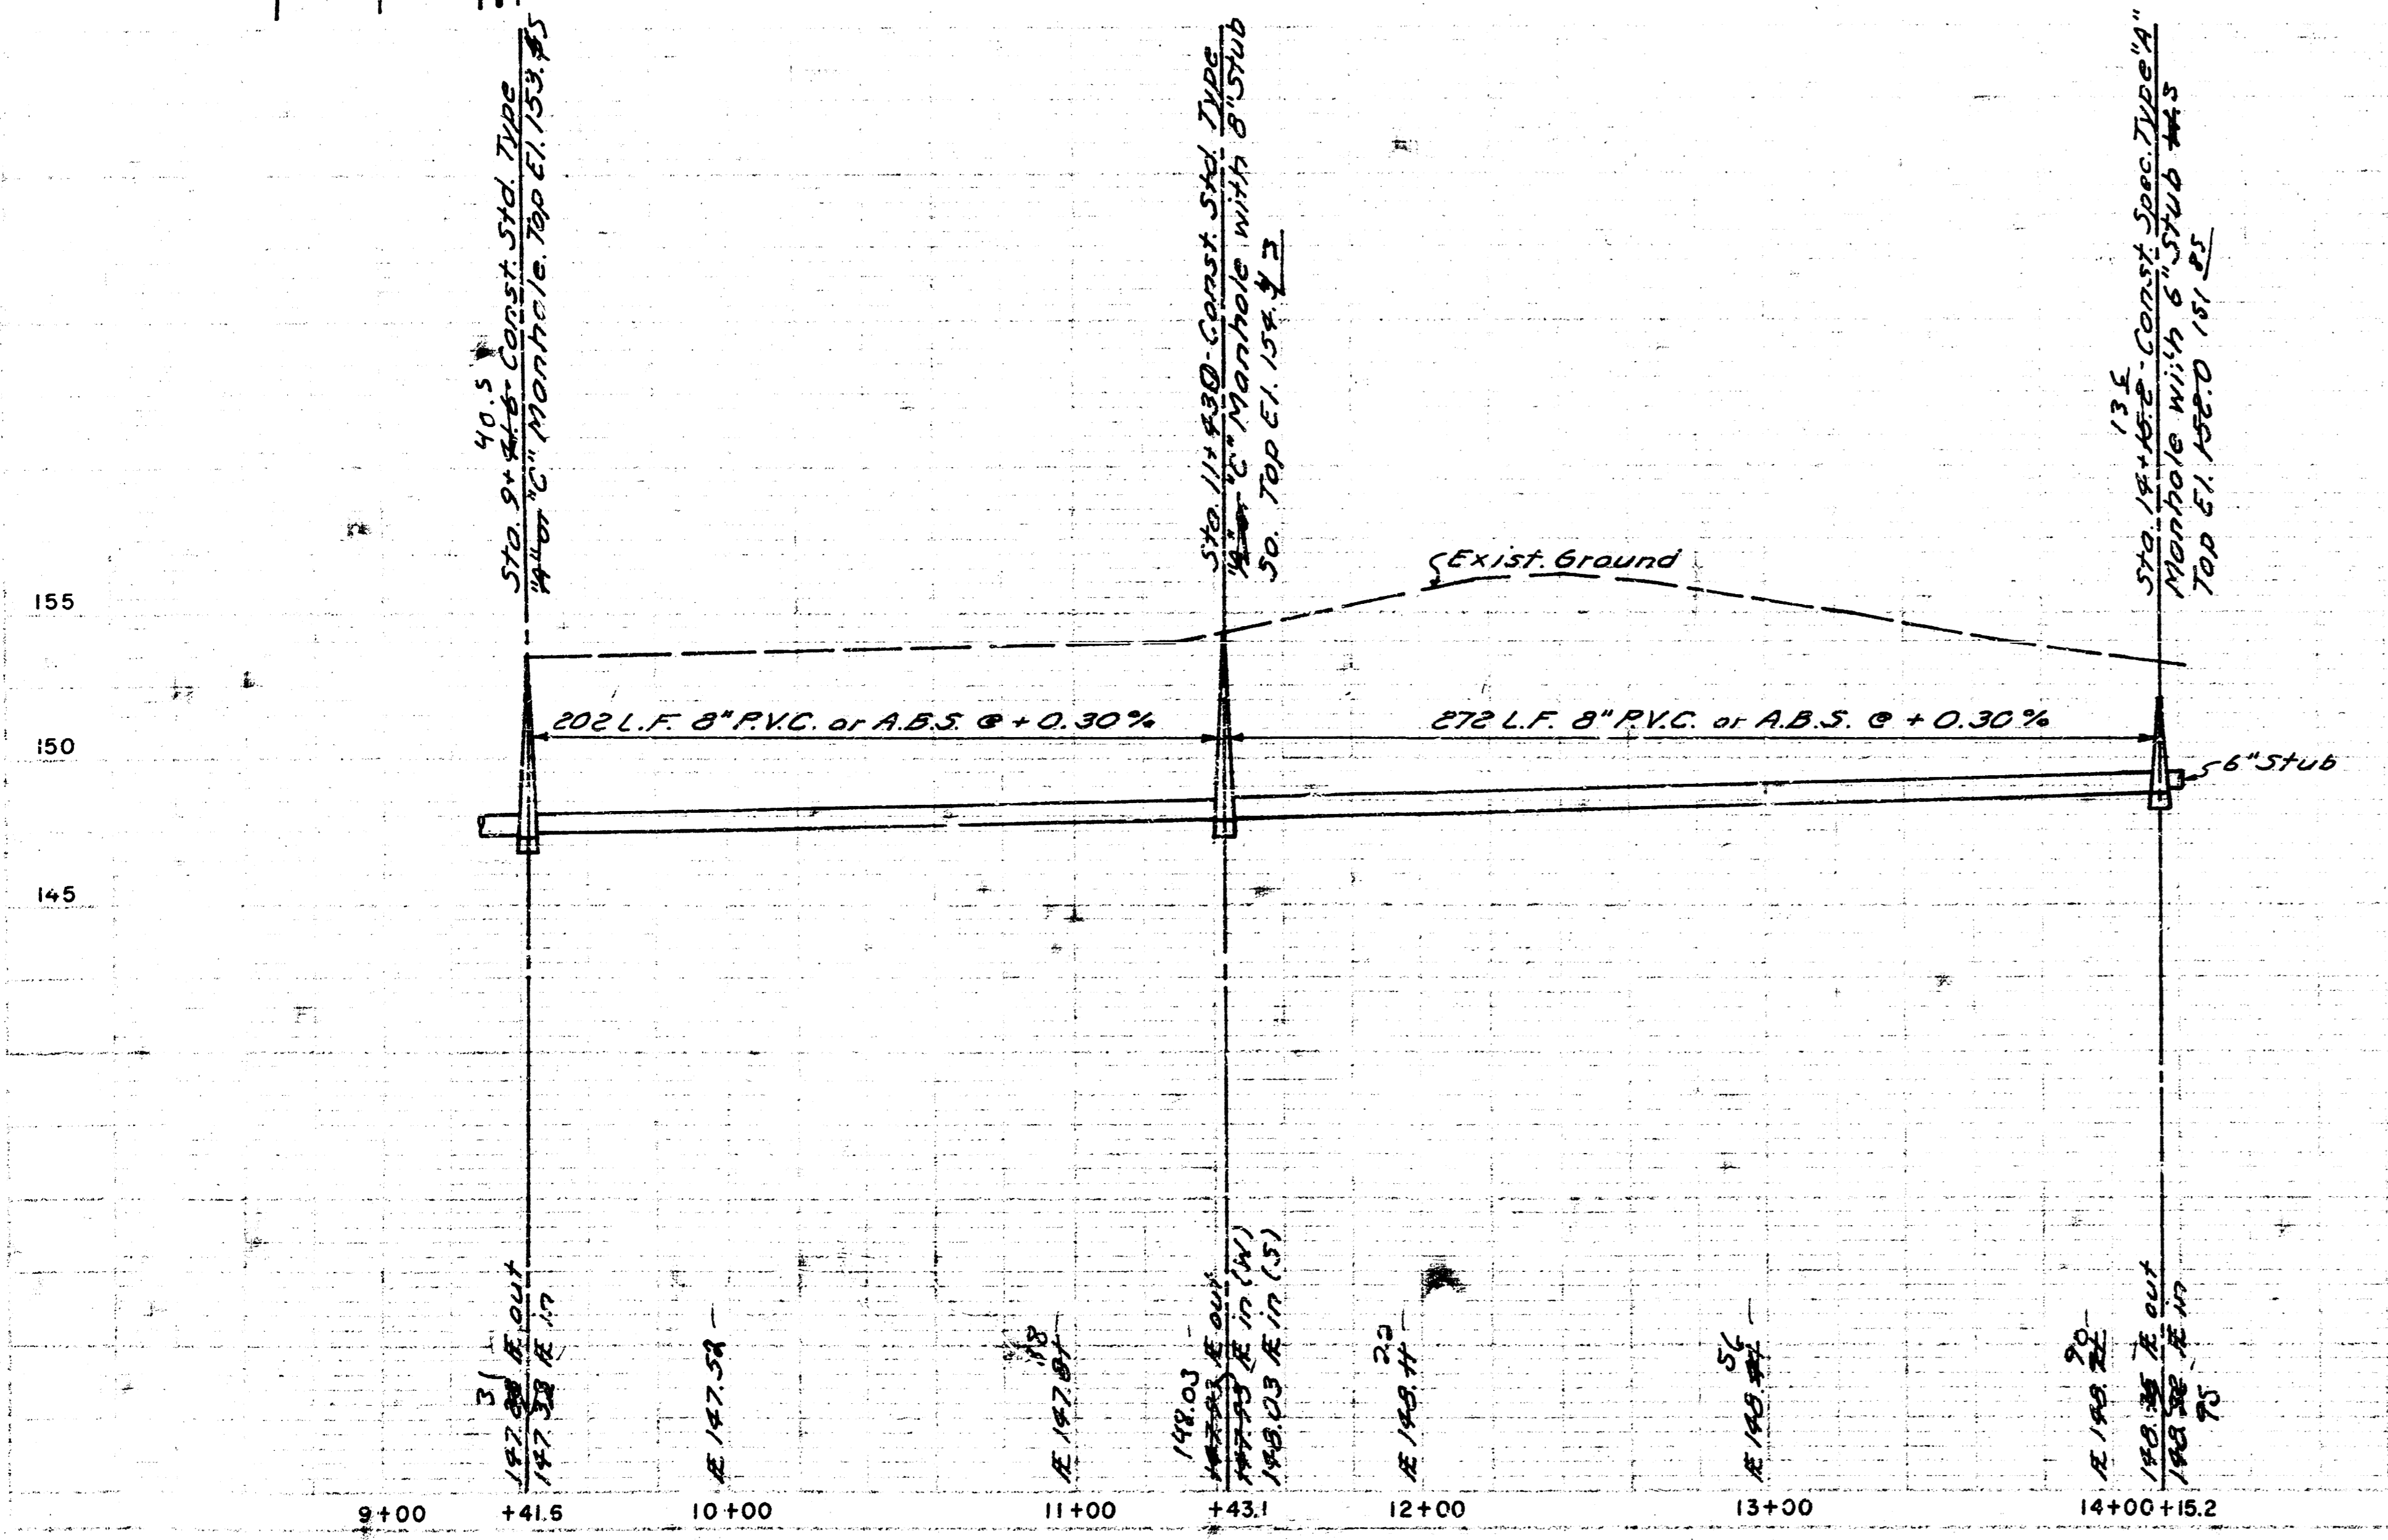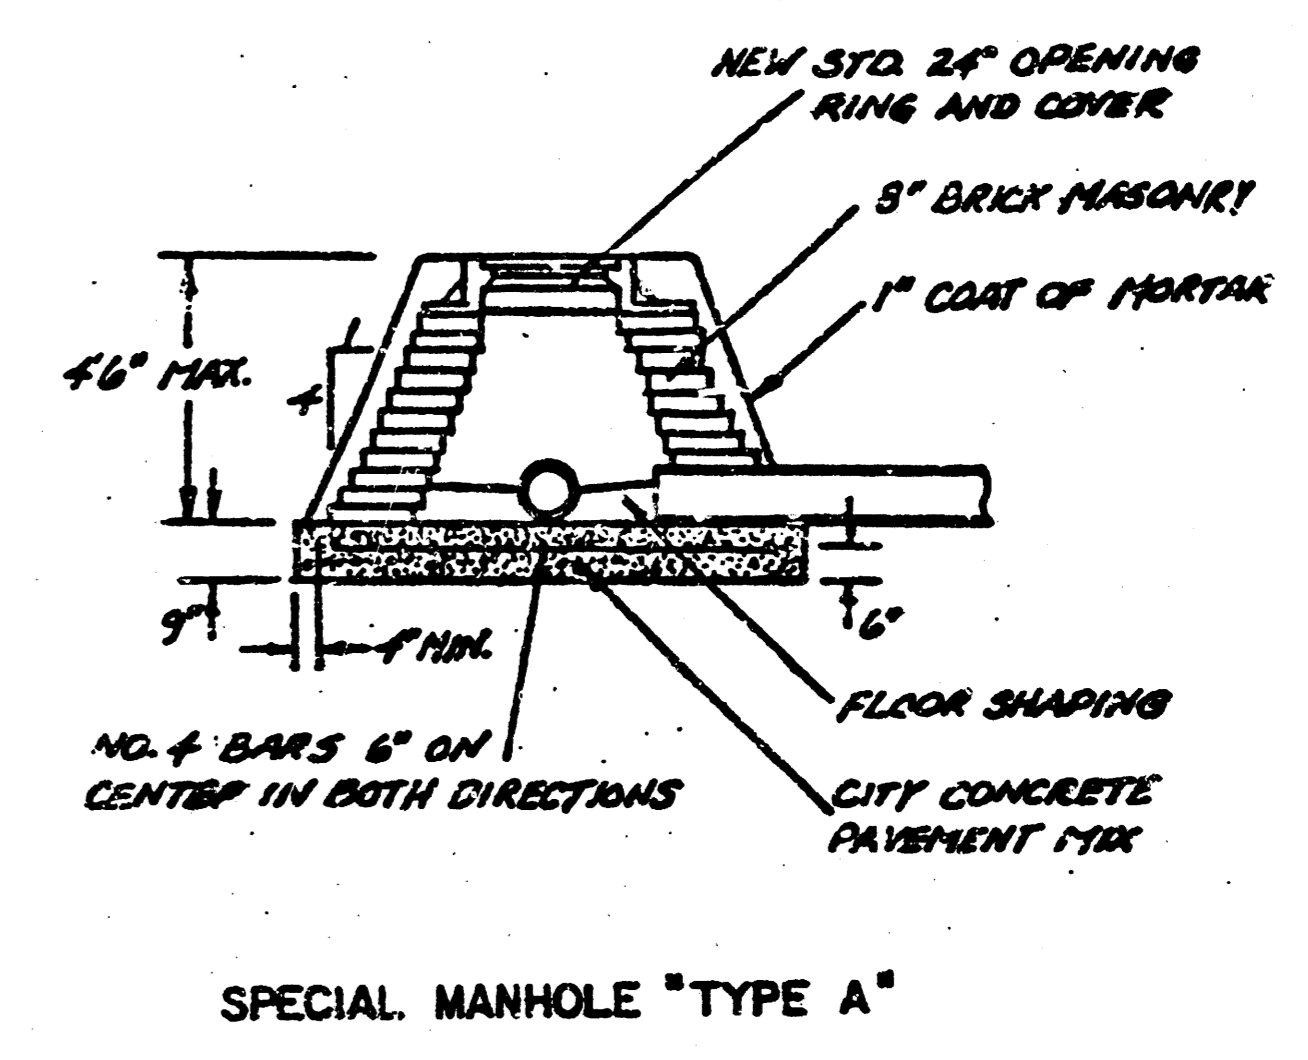

LATERAL 72 - WESTLINK SEWER  
 PROJ. NO. 468-76-245-81277-000-000-001  
 CITY OF WICHITA, KANSAS  
 MIKE LINDZBAK CITY ENGINEER

SH. 3 OF 3

14 8 3 0 3/3