



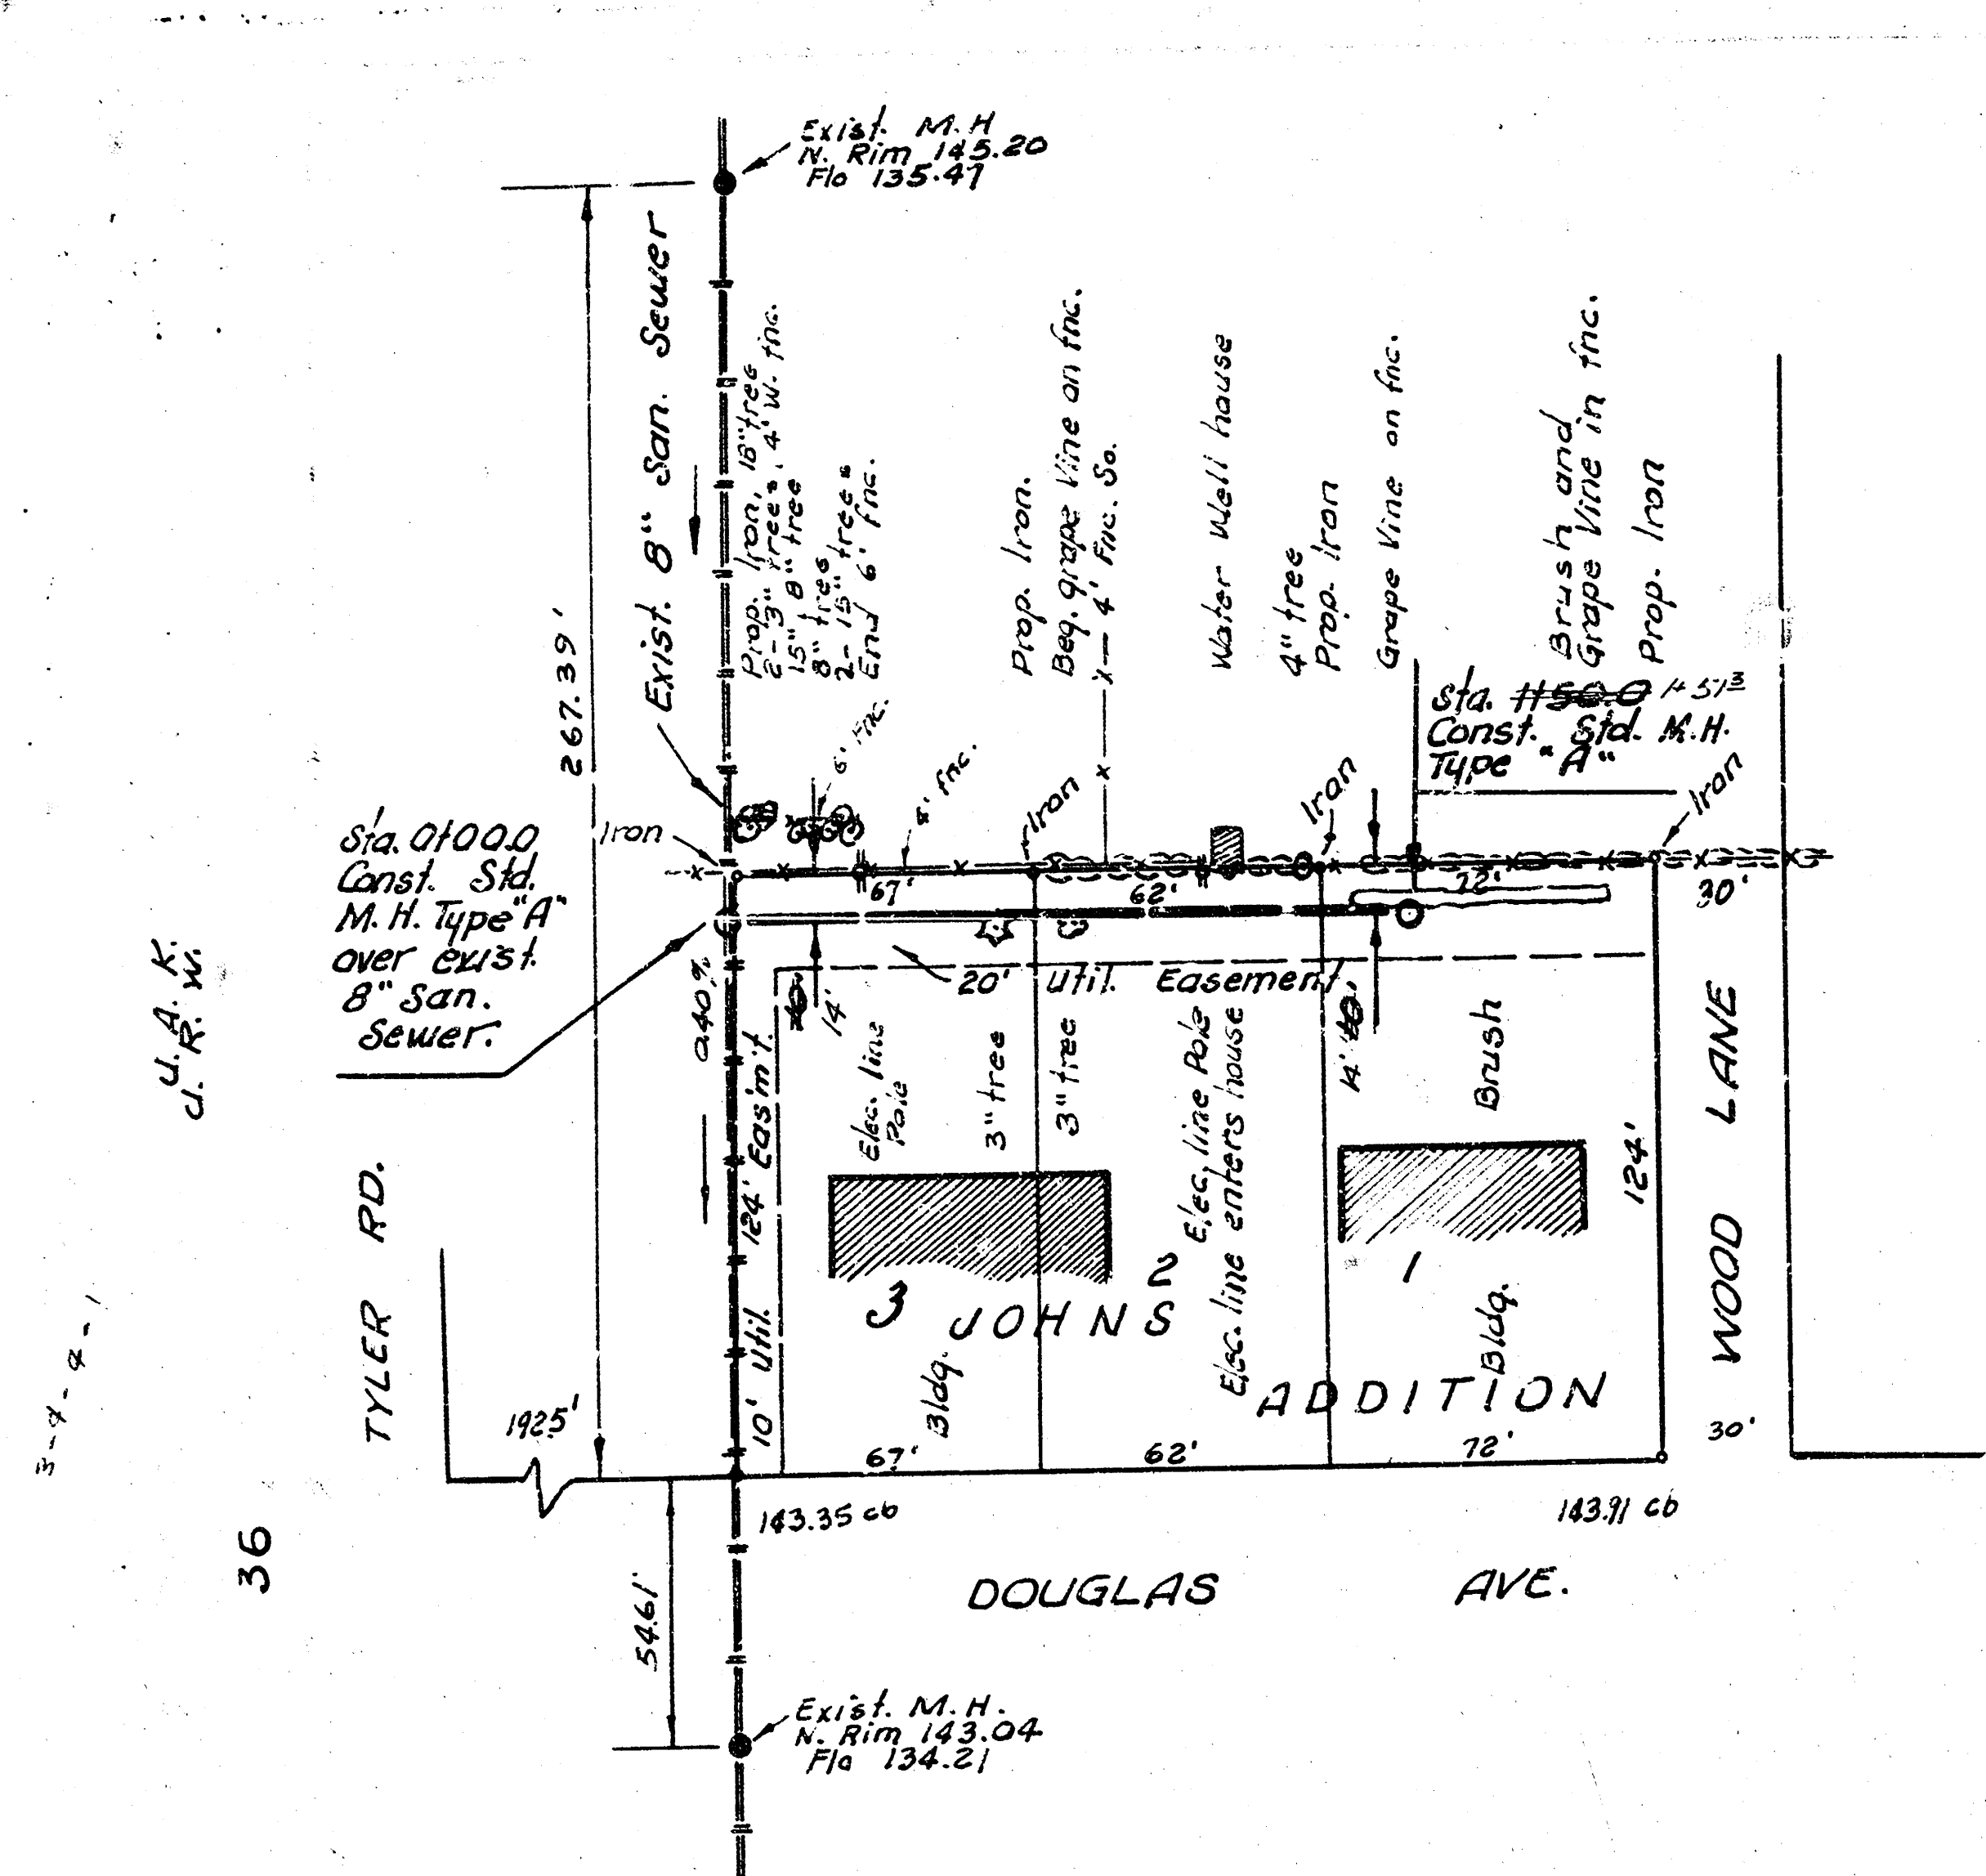

B.M. 144.04 R.R. Spike S.S.P.
Pole N. Side Douglas 2nd
Pole W. of Tyler Rd

Plan Scale 1" = 40'
Profile Scale 1" = 40' Horiz.
1" = 5' Vert.

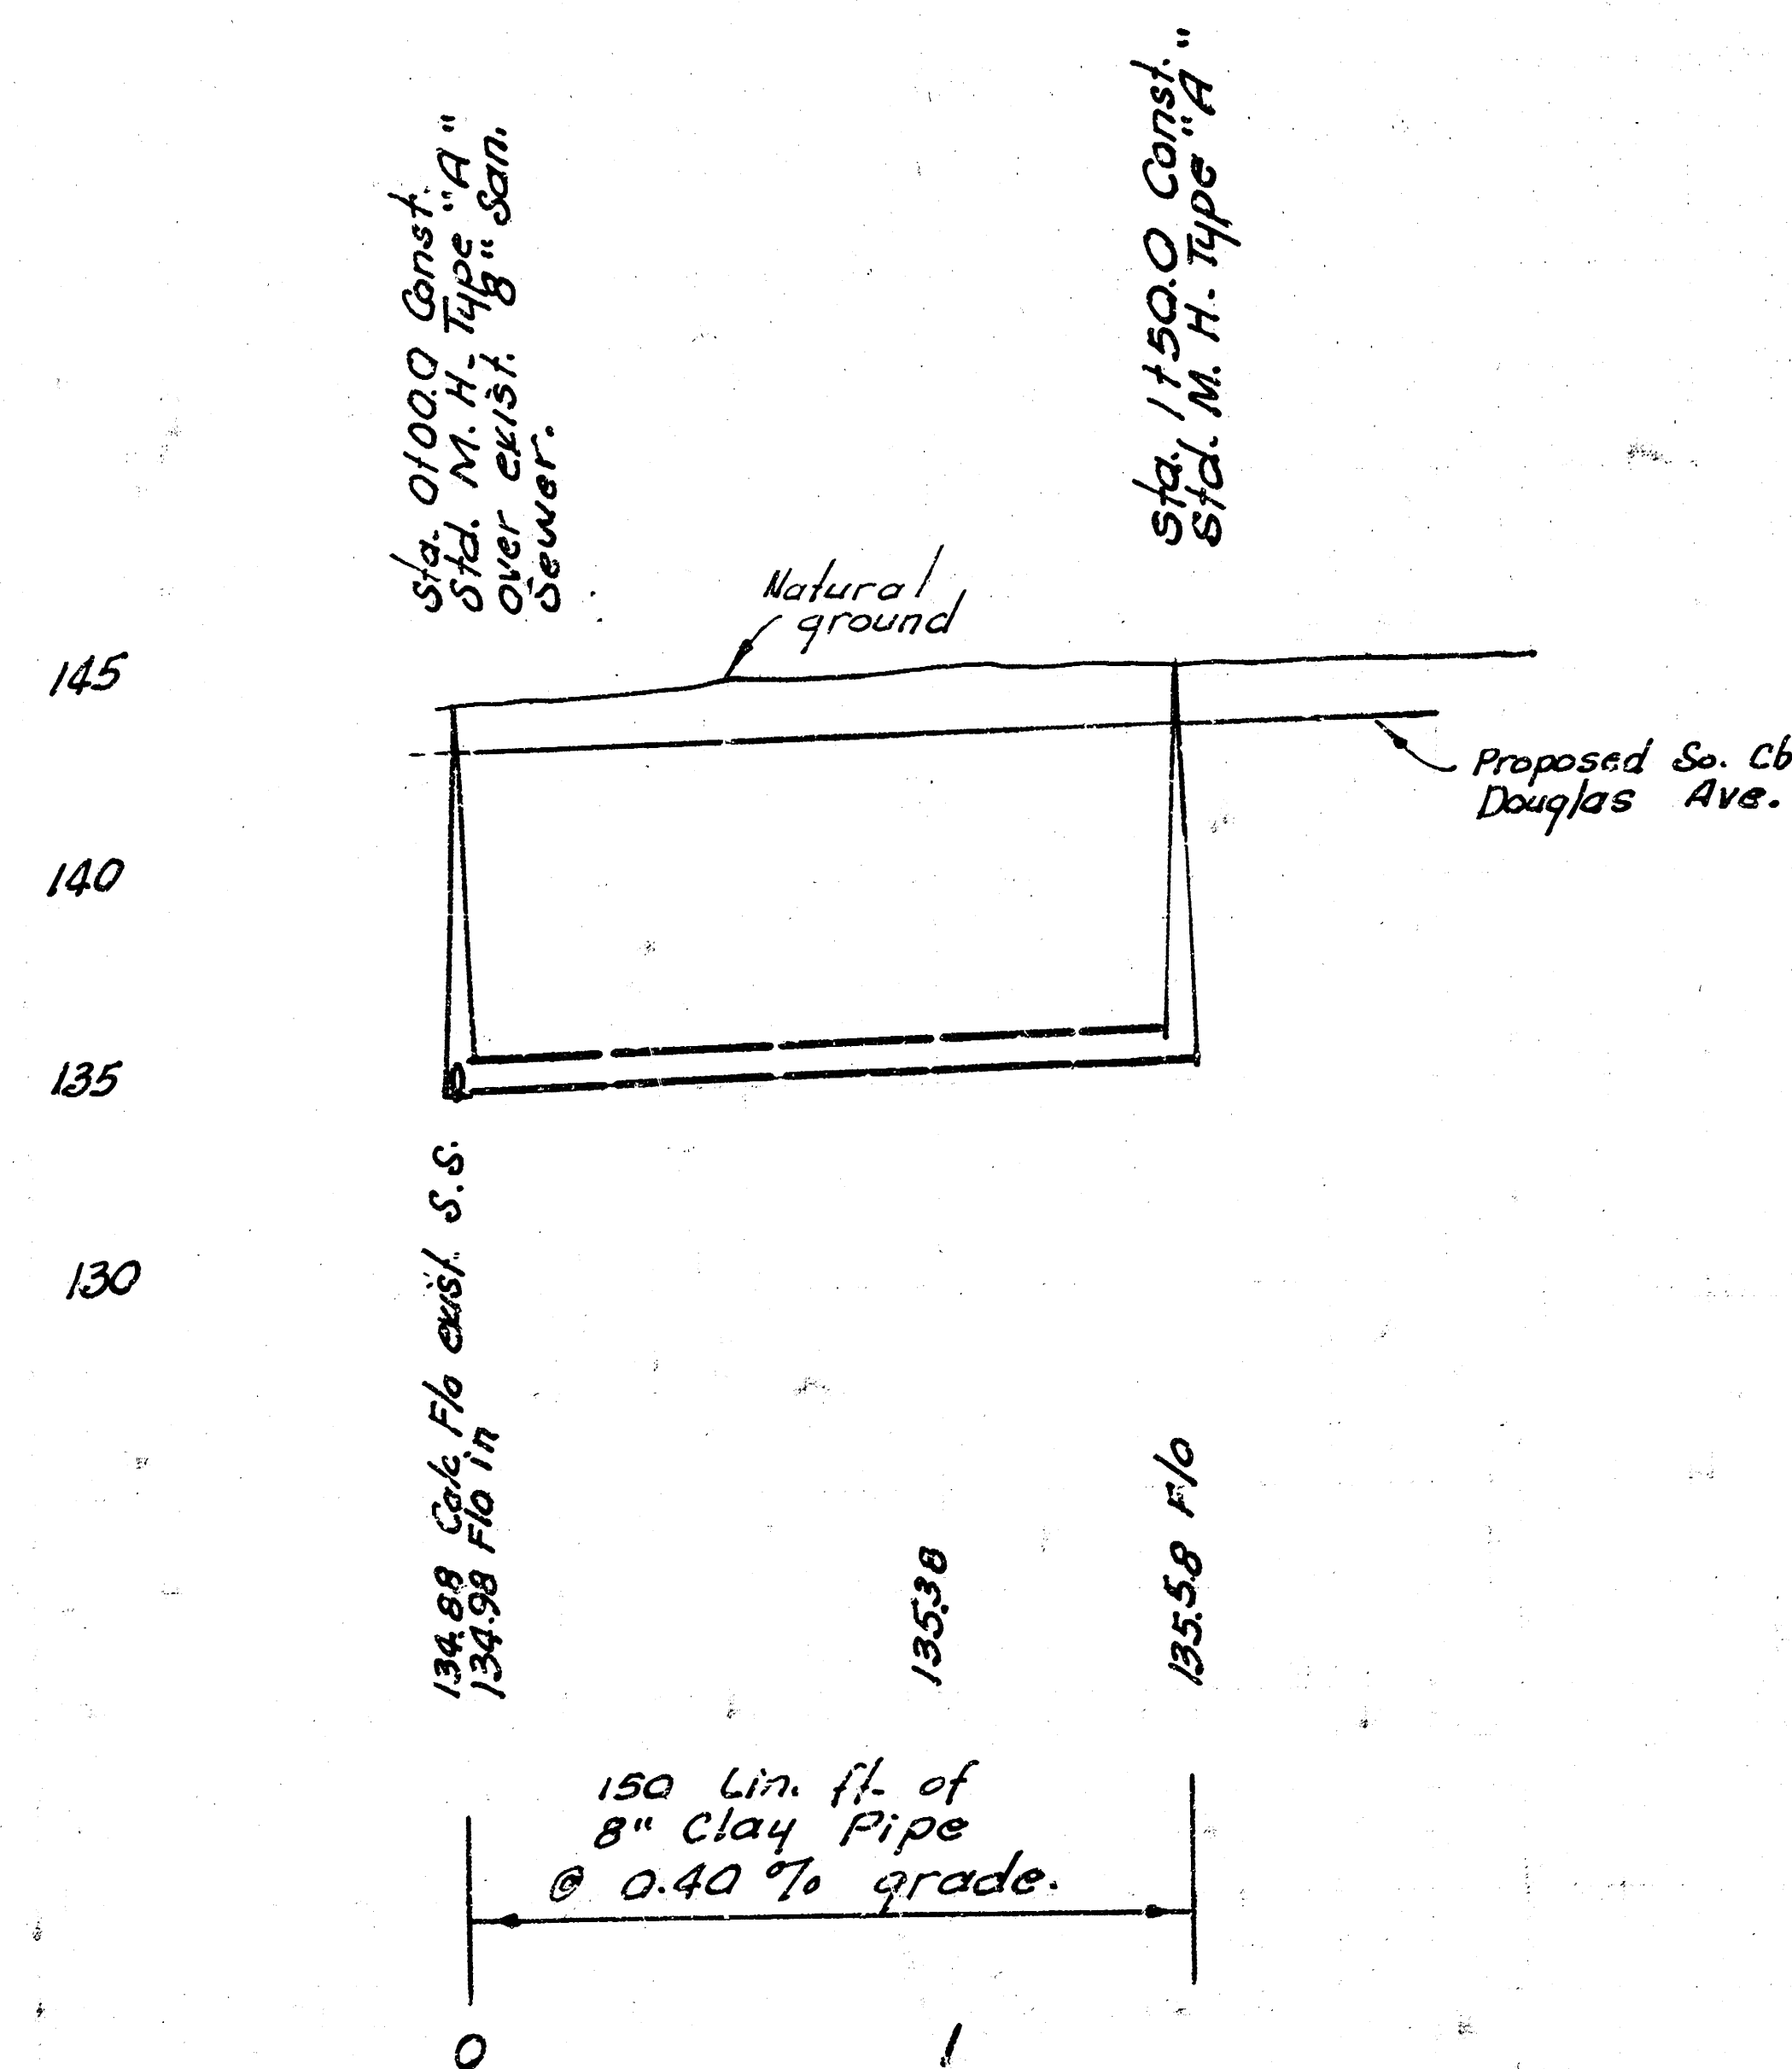

"AS BUILT" FINAL MEAS. 1/4-2

LAT. 14, MAIN 1, WESTLINK SEWER
CITY OF WICHITA, KANSAS
R. W. LINN — CITY ENGINEER
MAY 1974 PROJECT NO. DBKL573080

11-Engrs
1-Water

FILMED FROM THE BEST
AVAILABLE COPY