


372  
8 79  
15.0' Paved  
15.0' Paved

15.0' Paved

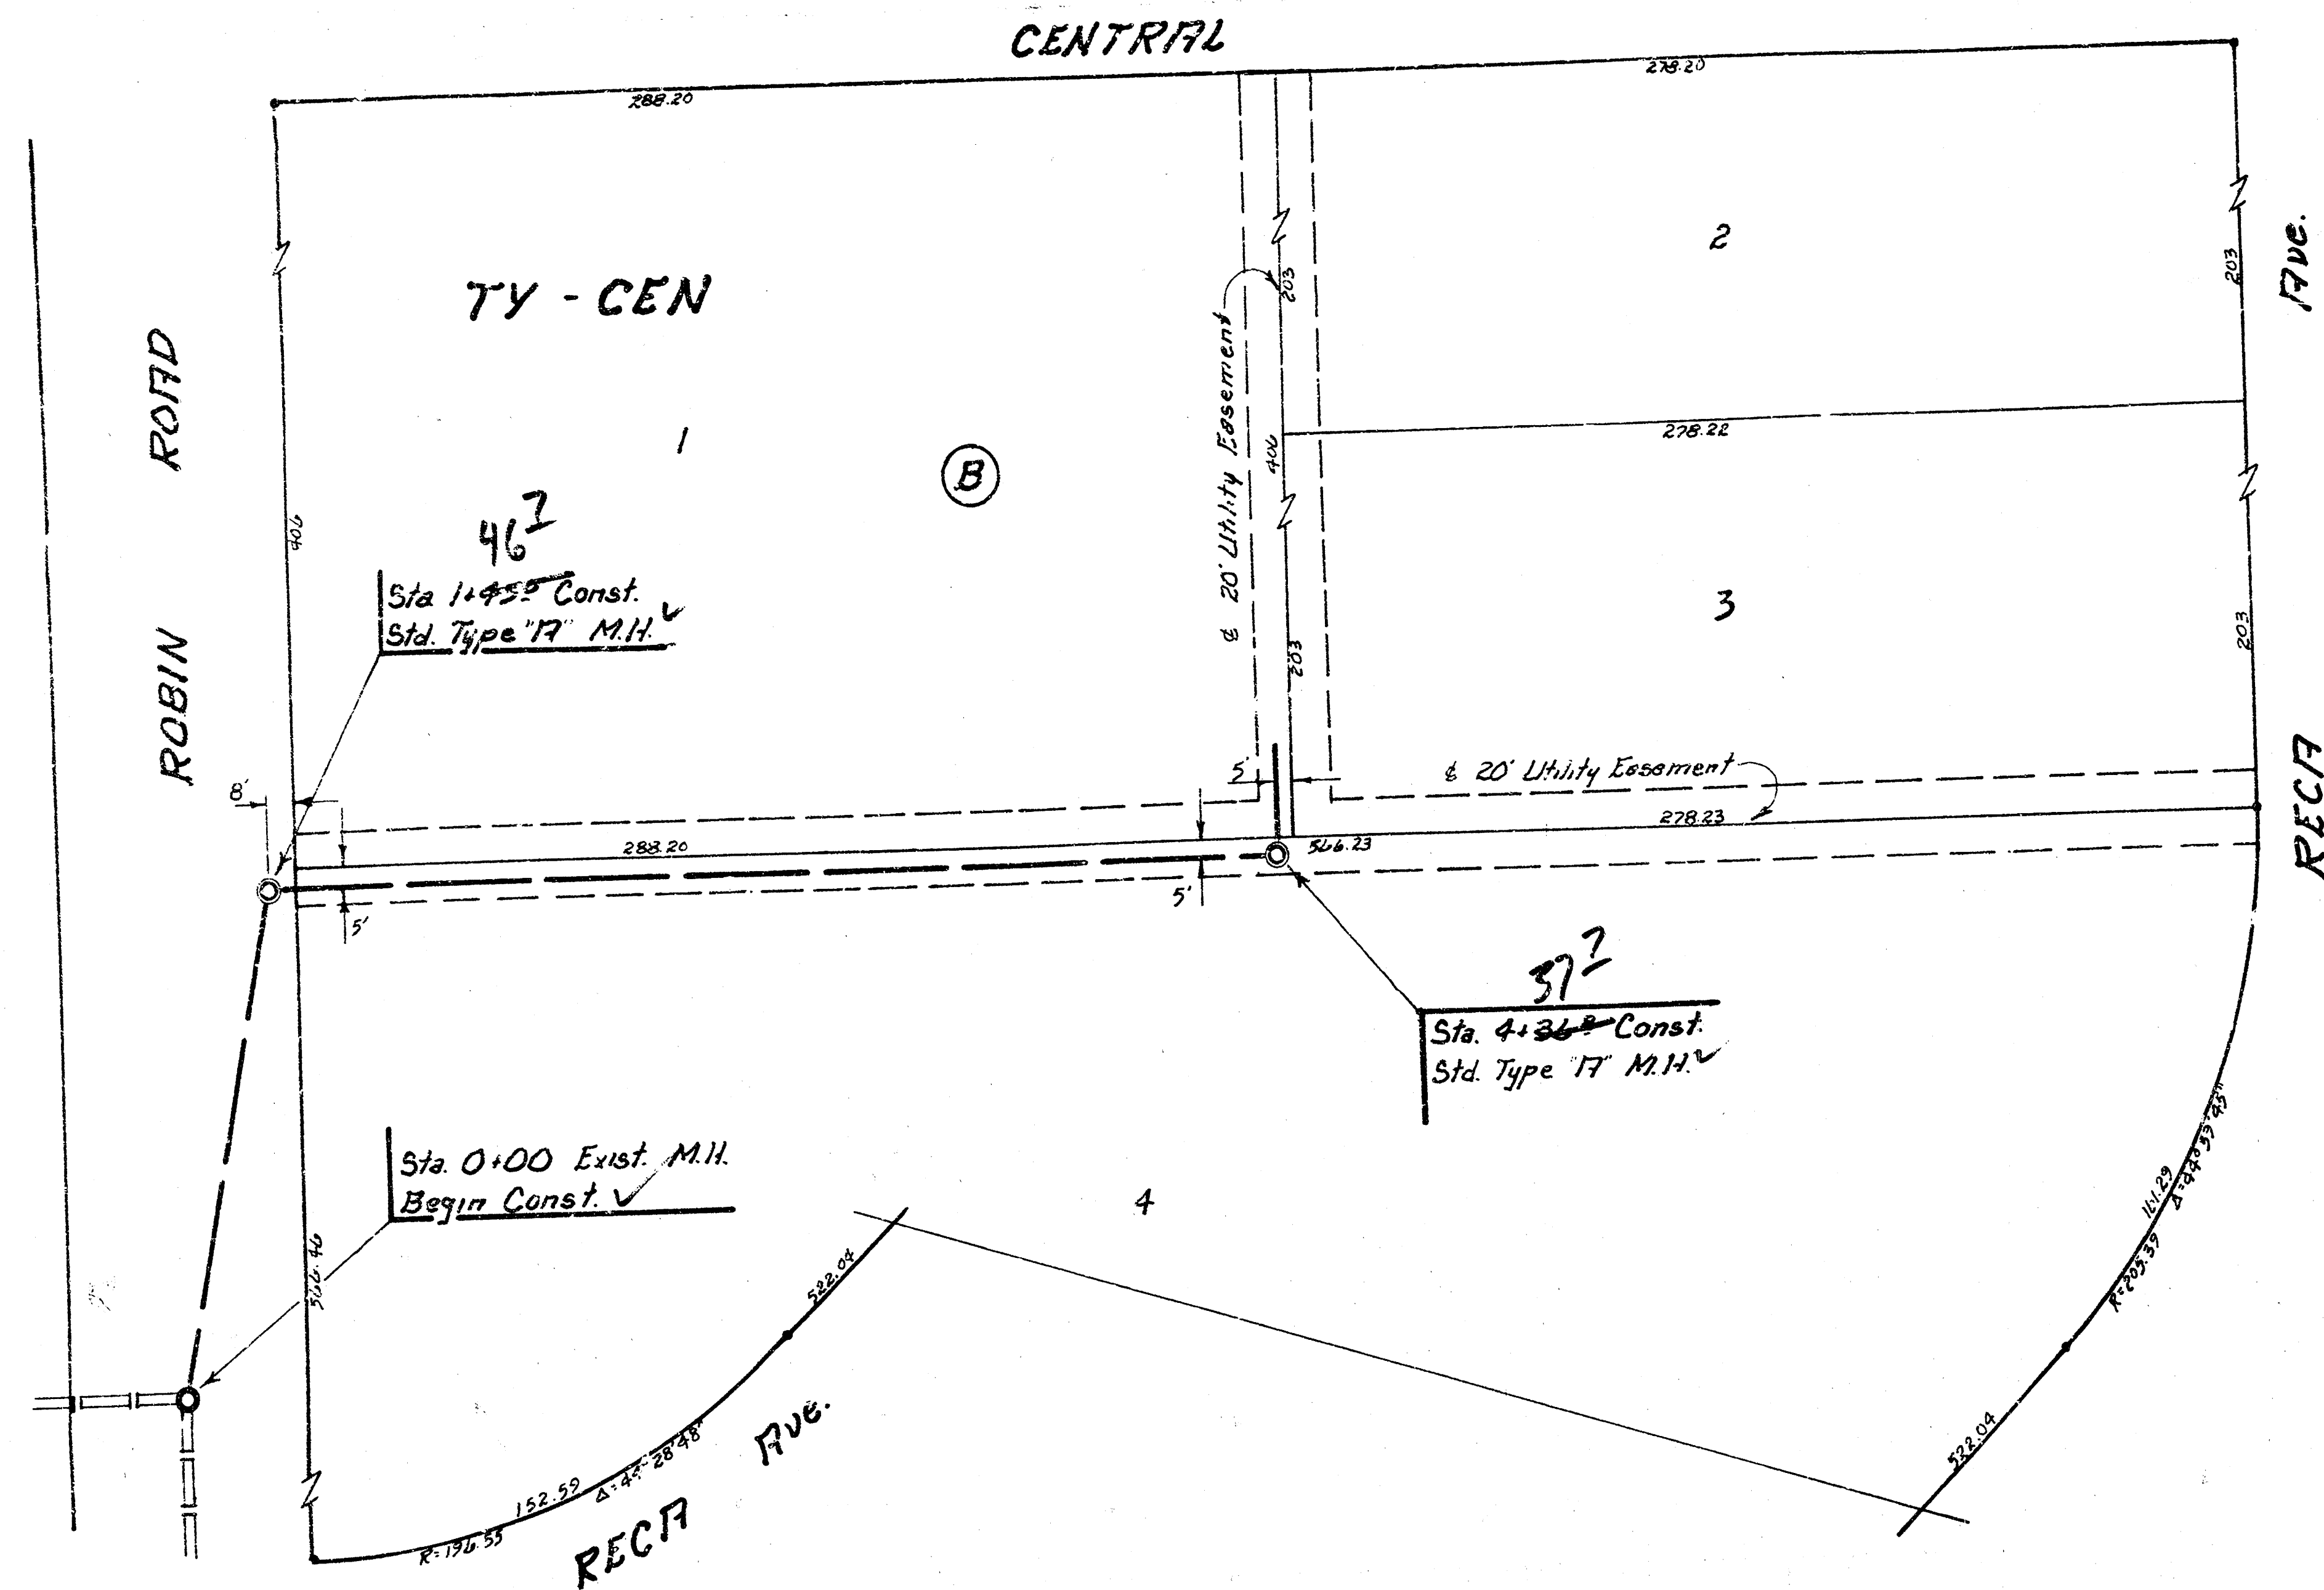


Sta. 0+00 Exist. M.H.  
Begin Const.

Sta. 1+43.5 Const.  
Std. Type 'T' M.H.

Sta. 4+36.8 Const.  
Std. Type 'T' M.H.


Sta. 4+54.8 Const.  
Std. Type 'T' M.H.  
6" Stub E. and W.

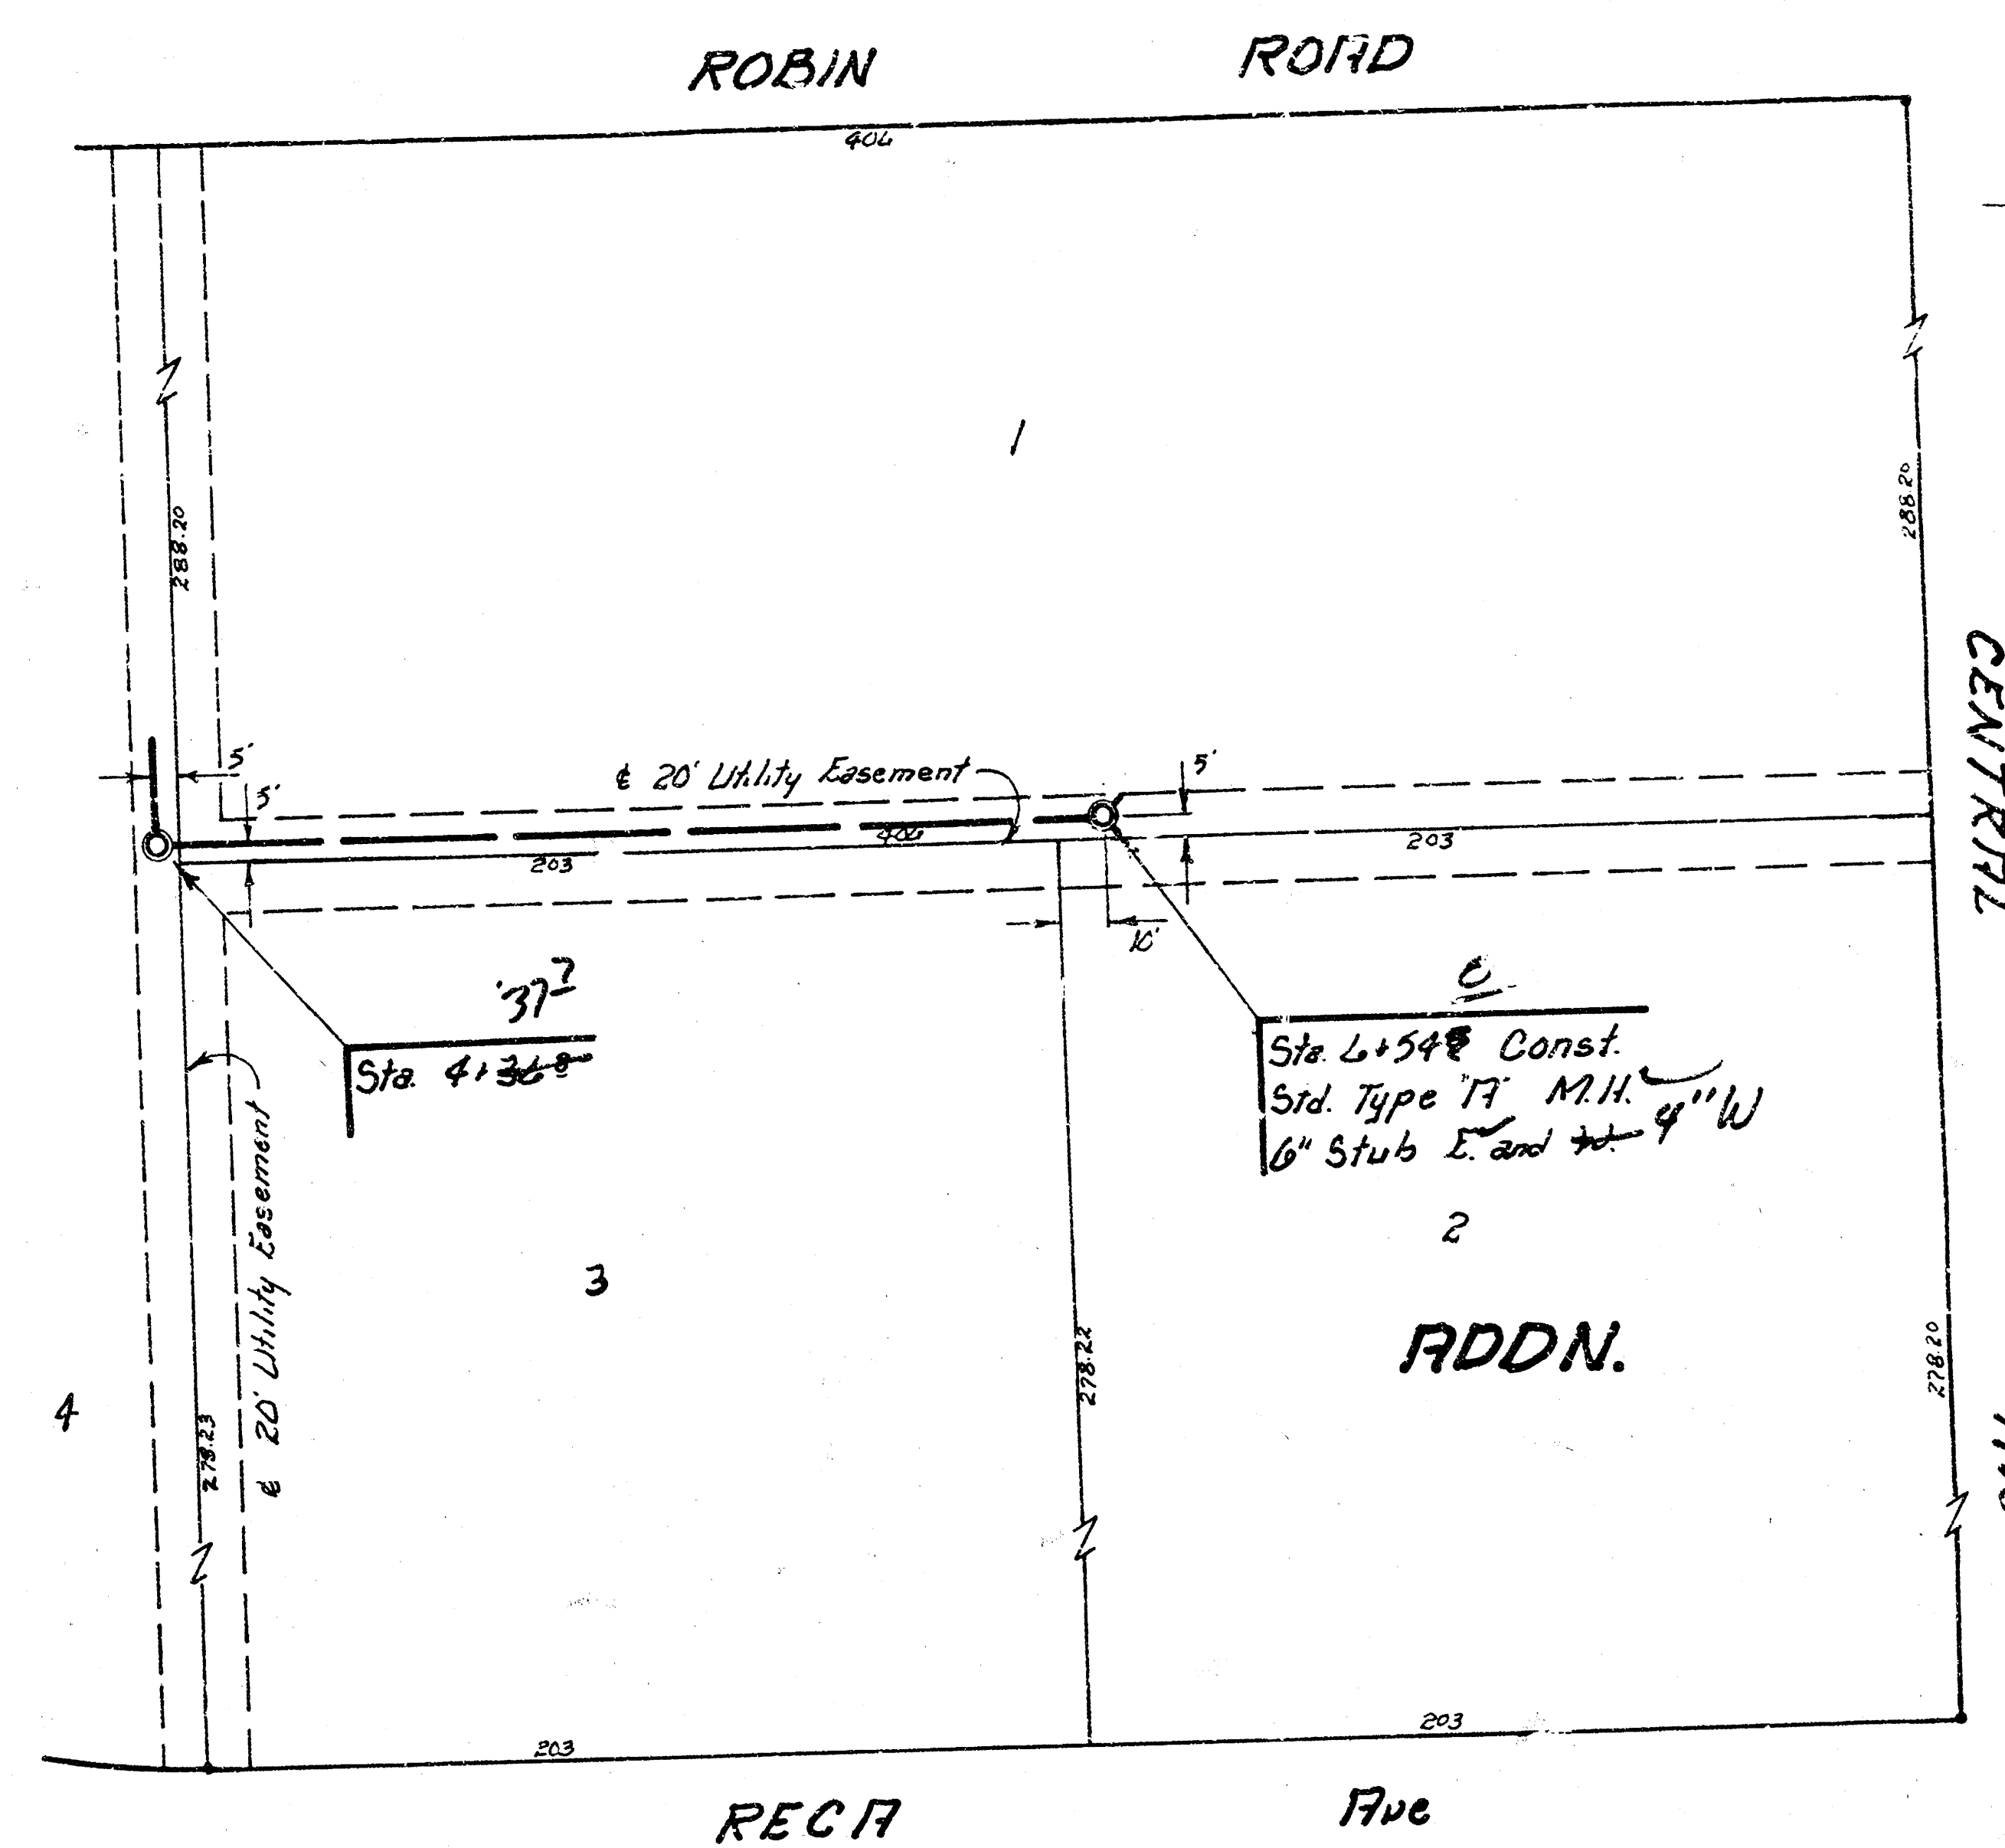

SCALE  
PLAN 1" = 40'  
PROFILE 1" = 40'  
Vert. 1" = 5'

NOTE: EXCESS EXCAVATED MATERIAL SHALL BE USED TO MAINTAIN A MINIMUM COVER OF 20" OVER THE SEWER WHERE NECESSARY ON THIS PROJECT.

As Built  
JSS  
11/8/1

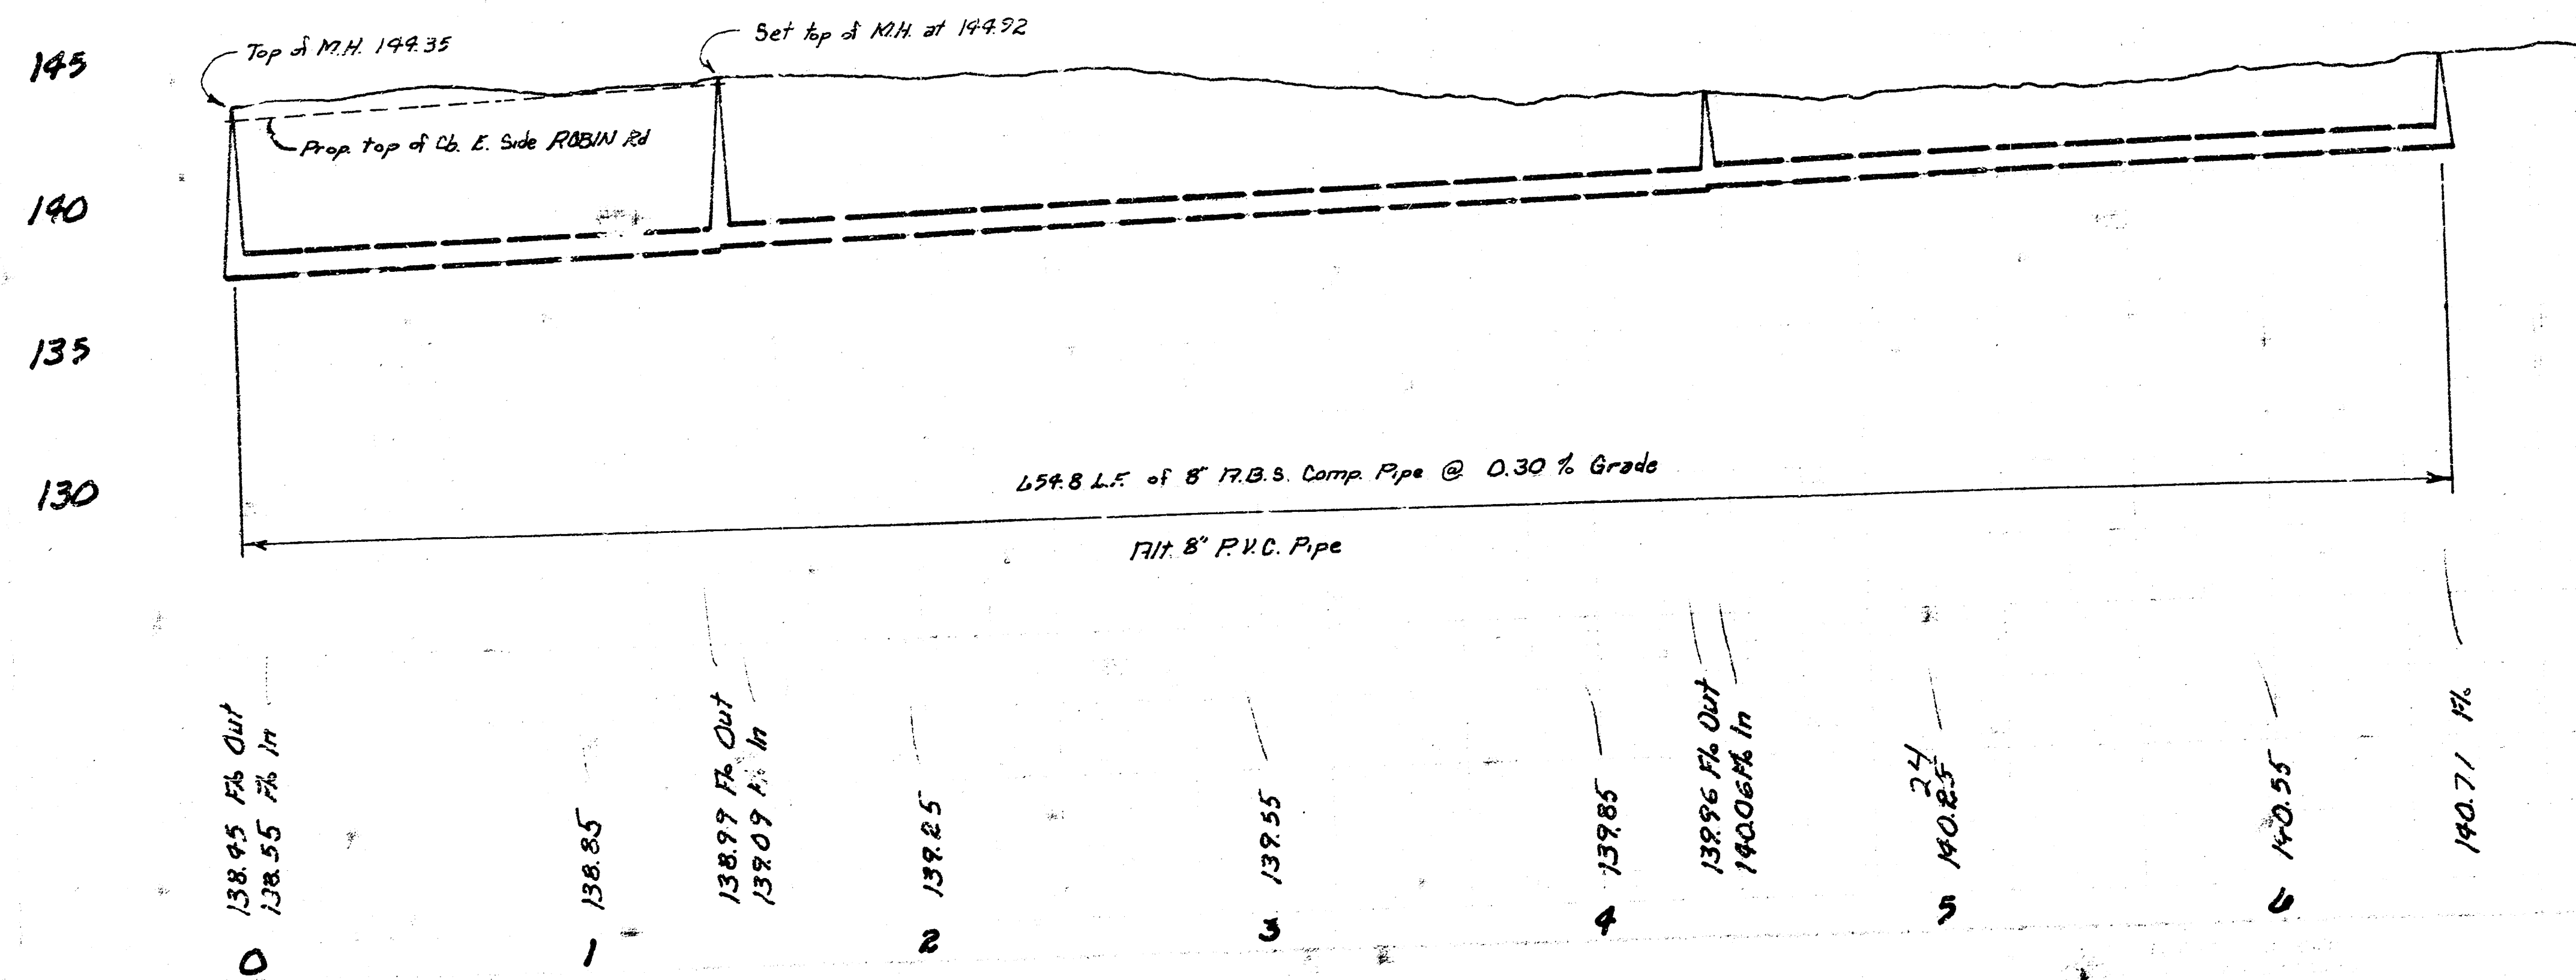

Lot 20, Main 1, WESTLINK SEWER  
City of Wichita, Kansas  
DEAN SELLERS CITY ENGINEER  
Proj. No. 468-76-245-80761-000-001  
Date

FILMED FROM THE BEST  
COPY