




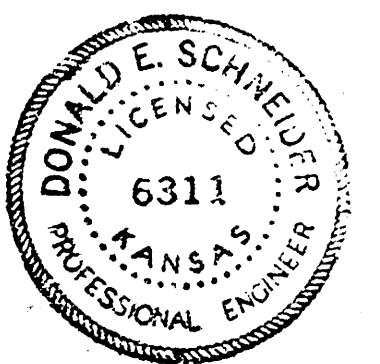

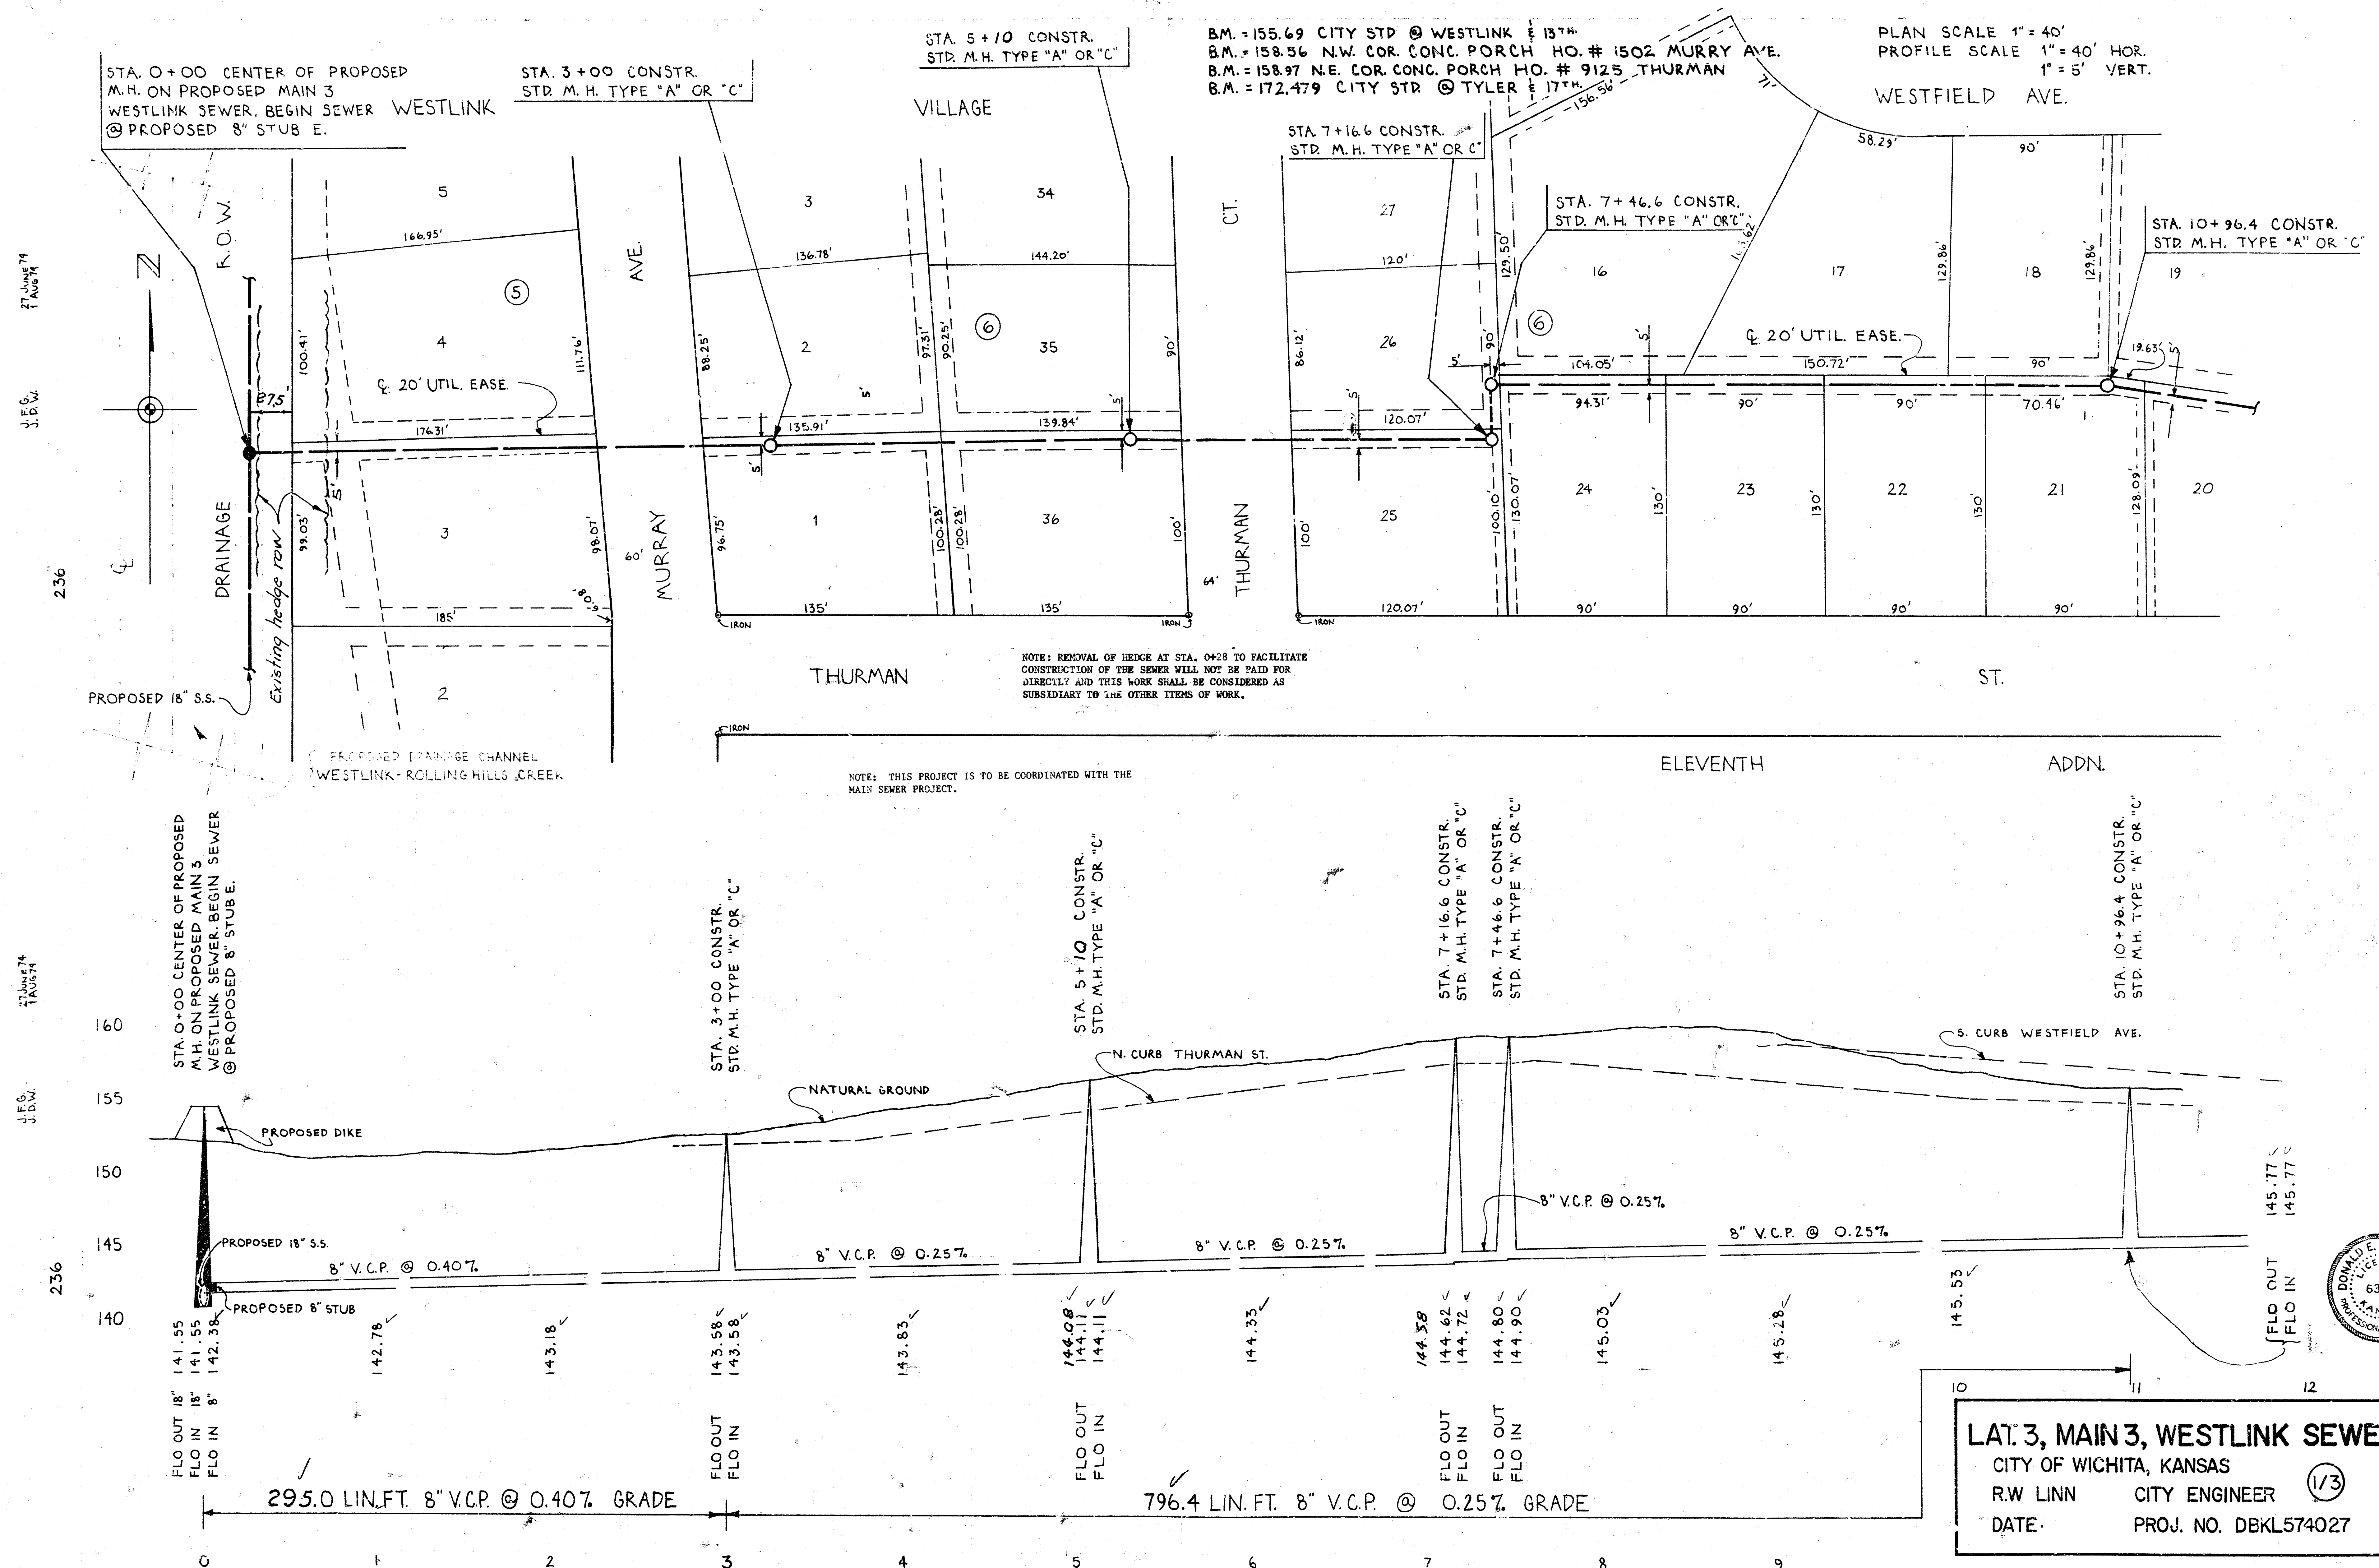

B.M. = 155.69 CITY STD. @ WESTLINK & 13TH.  
B.M. = 158.56 N.W. COR. CONC. PORCH HO. # 1502 MURRAY AVE.  
B.M. = 158.97 N.E. COR. CONC. PORCH HO. # 9125 THURMAN  
B.M. = 172.479 CITY STD. @ TYLER & 17TH.

**LAT. 3, MAIN 3, WESTLINK SEWER**  
CITY OF WICHITA, KANSAS (2/3)  
R.W. LINN CITY ENGINEER  
DATE: PROJ. NO. DBKL574027

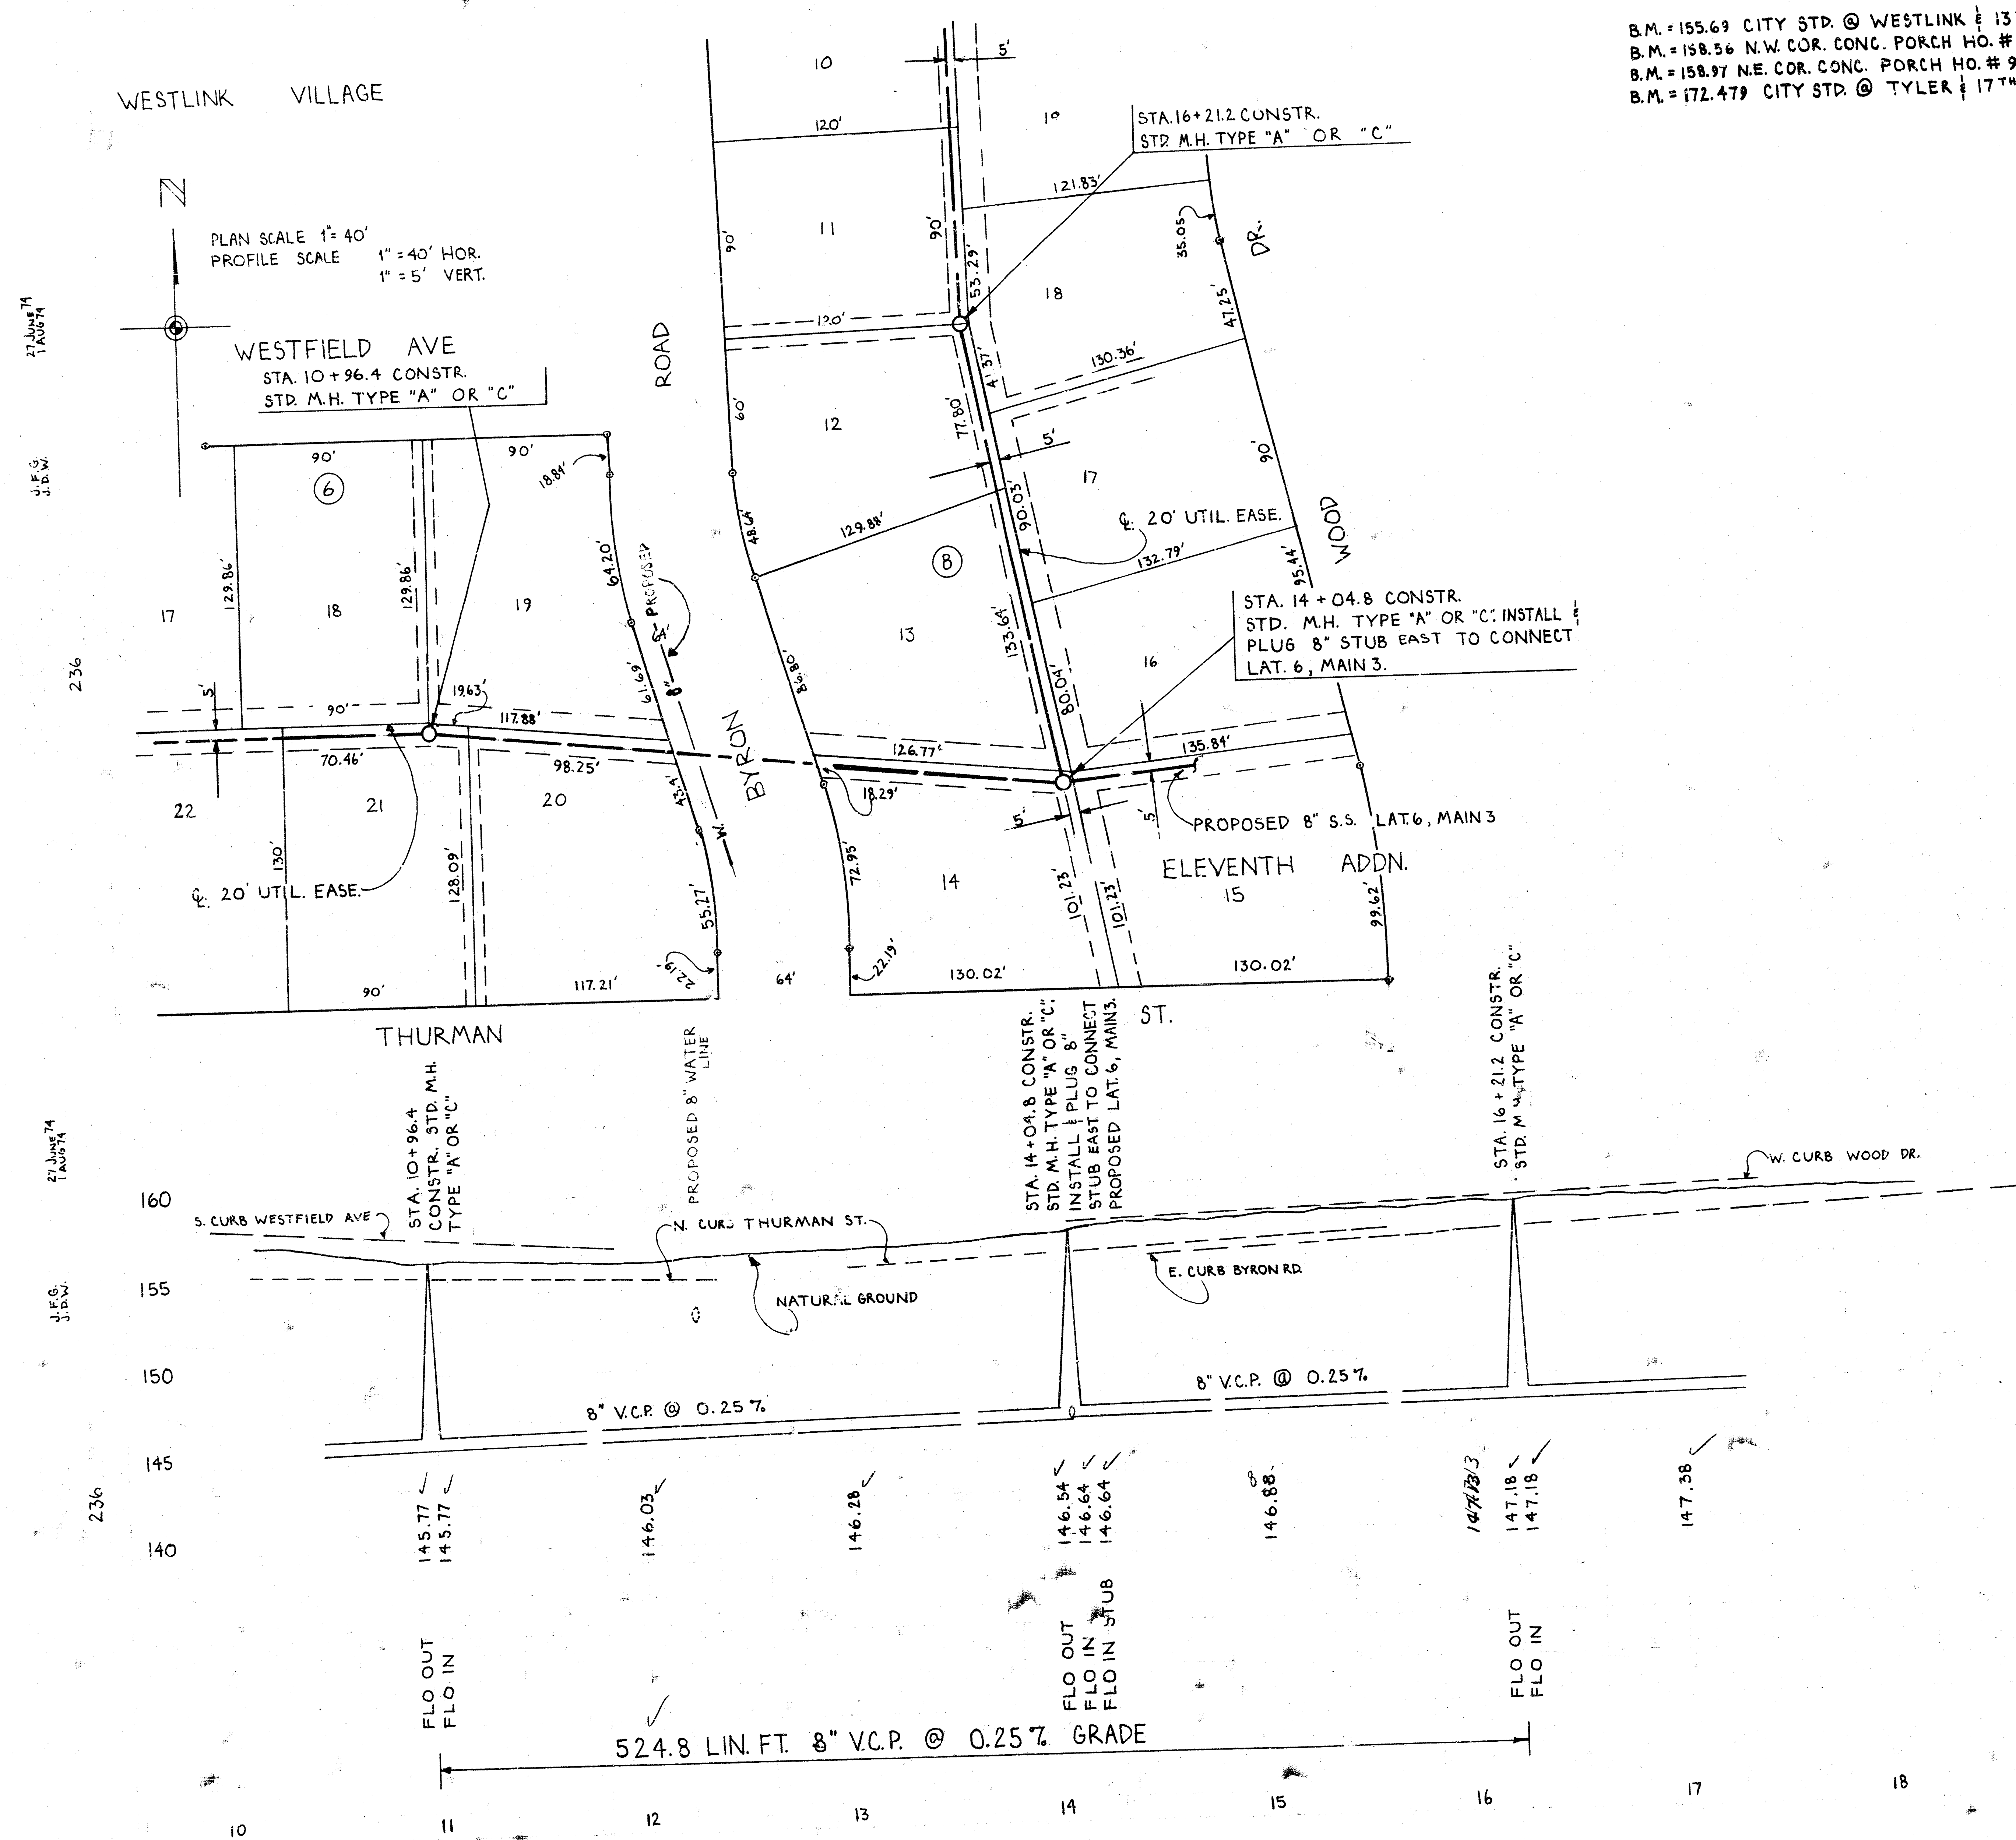